


GENERAL NOTES

- For Shed components this drawing set is to be considered integral with the provided 3D models and may not be considered independently from the models. The contractor is to base their bid upon the information provided in both the drawings and 3D models. In matters of form and geometry the three dimensional model takes precedence in the instance of a discrepancy between drawing and model. In all other matters the contractor shall seek the opinion of the Architect and Structural Engineer to resolve the discrepancy.
- Geometry, dimensions and surface contouring, blending and intersection of sections illustrated in the structural drawings are provided for reference and generation of the structural arrangement and details only. The 3D model issued by the Architect defines the exterior surface and shall be adhered to for the final geometry. It is the responsibility of the Contractor to identify any discrepancies or ambiguities for discussion, resolution and direction from the Architect and Structural Engineer.
- Typical N/S wall node:
The geometry created by the intersecting main verticals and diagonals shall be in accordance with the 3D model and follow, as a minimum, the quality exhibited in the approved mock-up. The general concept is that edges flow smoothly and continuously between the straight edge of a diagonal through a curve to the adjacent edge of the vertical and the interlying surfaces between these edges are blended and contoured to define a smooth, uninterrupted transition.
- Typical Node Elsewhere:
The geometry created by the intersecting elements shall be in accordance with the 3D model. The level of quality is to be similar to the approved mock-up for the typical node. The general concept is that edges flow smoothly and continuously between the edge of one element to the corresponding edge of the adjacent element and the interlying surfaces between these edges are blended and contoured to define a smooth, uninterrupted transition.
- This drawing should be considered integral with the written Specifications issued along with the drawings and 3D models. Refer to the Advanced procurement Bid Issue Specifications Table of Contents.
- Structural steel cladding enclosing selected areas of the Shed (referred to as EWS-1c) shall be in the scope of the steel contractor for continuity with adjacent primary steel members. Criteria for tolerance and flatness to match that of the structural steel (see structural drawings & specifications). Plate configuration, including thickness, internal stiffeners and diaphragms, to be proposed by the fabricator and subject to agreement with the Architect and Engineer to provide an enclosure which satisfies the aesthetic and structural requirements. Refer to 3D model for extent of EWS-1c.
- Visually exposed HVAC supply and return ducts in the Shed, shown herein, are to be in the scope of the steel contractor to ensure continuity of appearance with primary steel. Criteria for tolerance and flatness to match that of the structural steel (see structural drawings & specifications). Plate configuration, including thickness, internal stiffeners and diaphragms, to be proposed by the fabricator and subject to agreement with the Architect and Engineer to provide an enclosure which satisfies the aesthetic and structural requirements. The mechanical ductwork carries its own self-weight and is not a primary load-bearing element. Internal stiffening may not create interference with airflow requirements of the duct. Refer to 3D model.

KEY PLAN

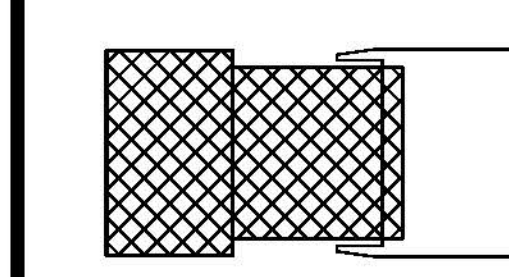

ISSUE	PRINTING	DATE
61	50	DOB AMENDMENT 7 06.18.2016
46	33	DOB AMENDMENT 5 04.28.2016
13	13	DOB AMENDMENT 1 08.20.2015
10	4	100% CONSTRUCTION DOCUMENTS 03.18.2015
9	9	90% CONSTRUCTION DOCUMENTS 02.18.2015
6	6	PRELIMINARY DOB SUBMISSION 12.02.2014
2	2	90% CONSTRUCTION DOCUMENTS 08.18.2014
1	1	ADV. PROCUREMENT BID SET 06.18.2014

STAMP

DRAWN BY
MO

CHECKED BY
CR

PROJECT NUMBER
11017

TITLE
Axonometrics
Deployable Shed


SCALE: NTS

DRAWING NO.
A-500.00

B-SCAN NO.

A-500.01

1 of 100

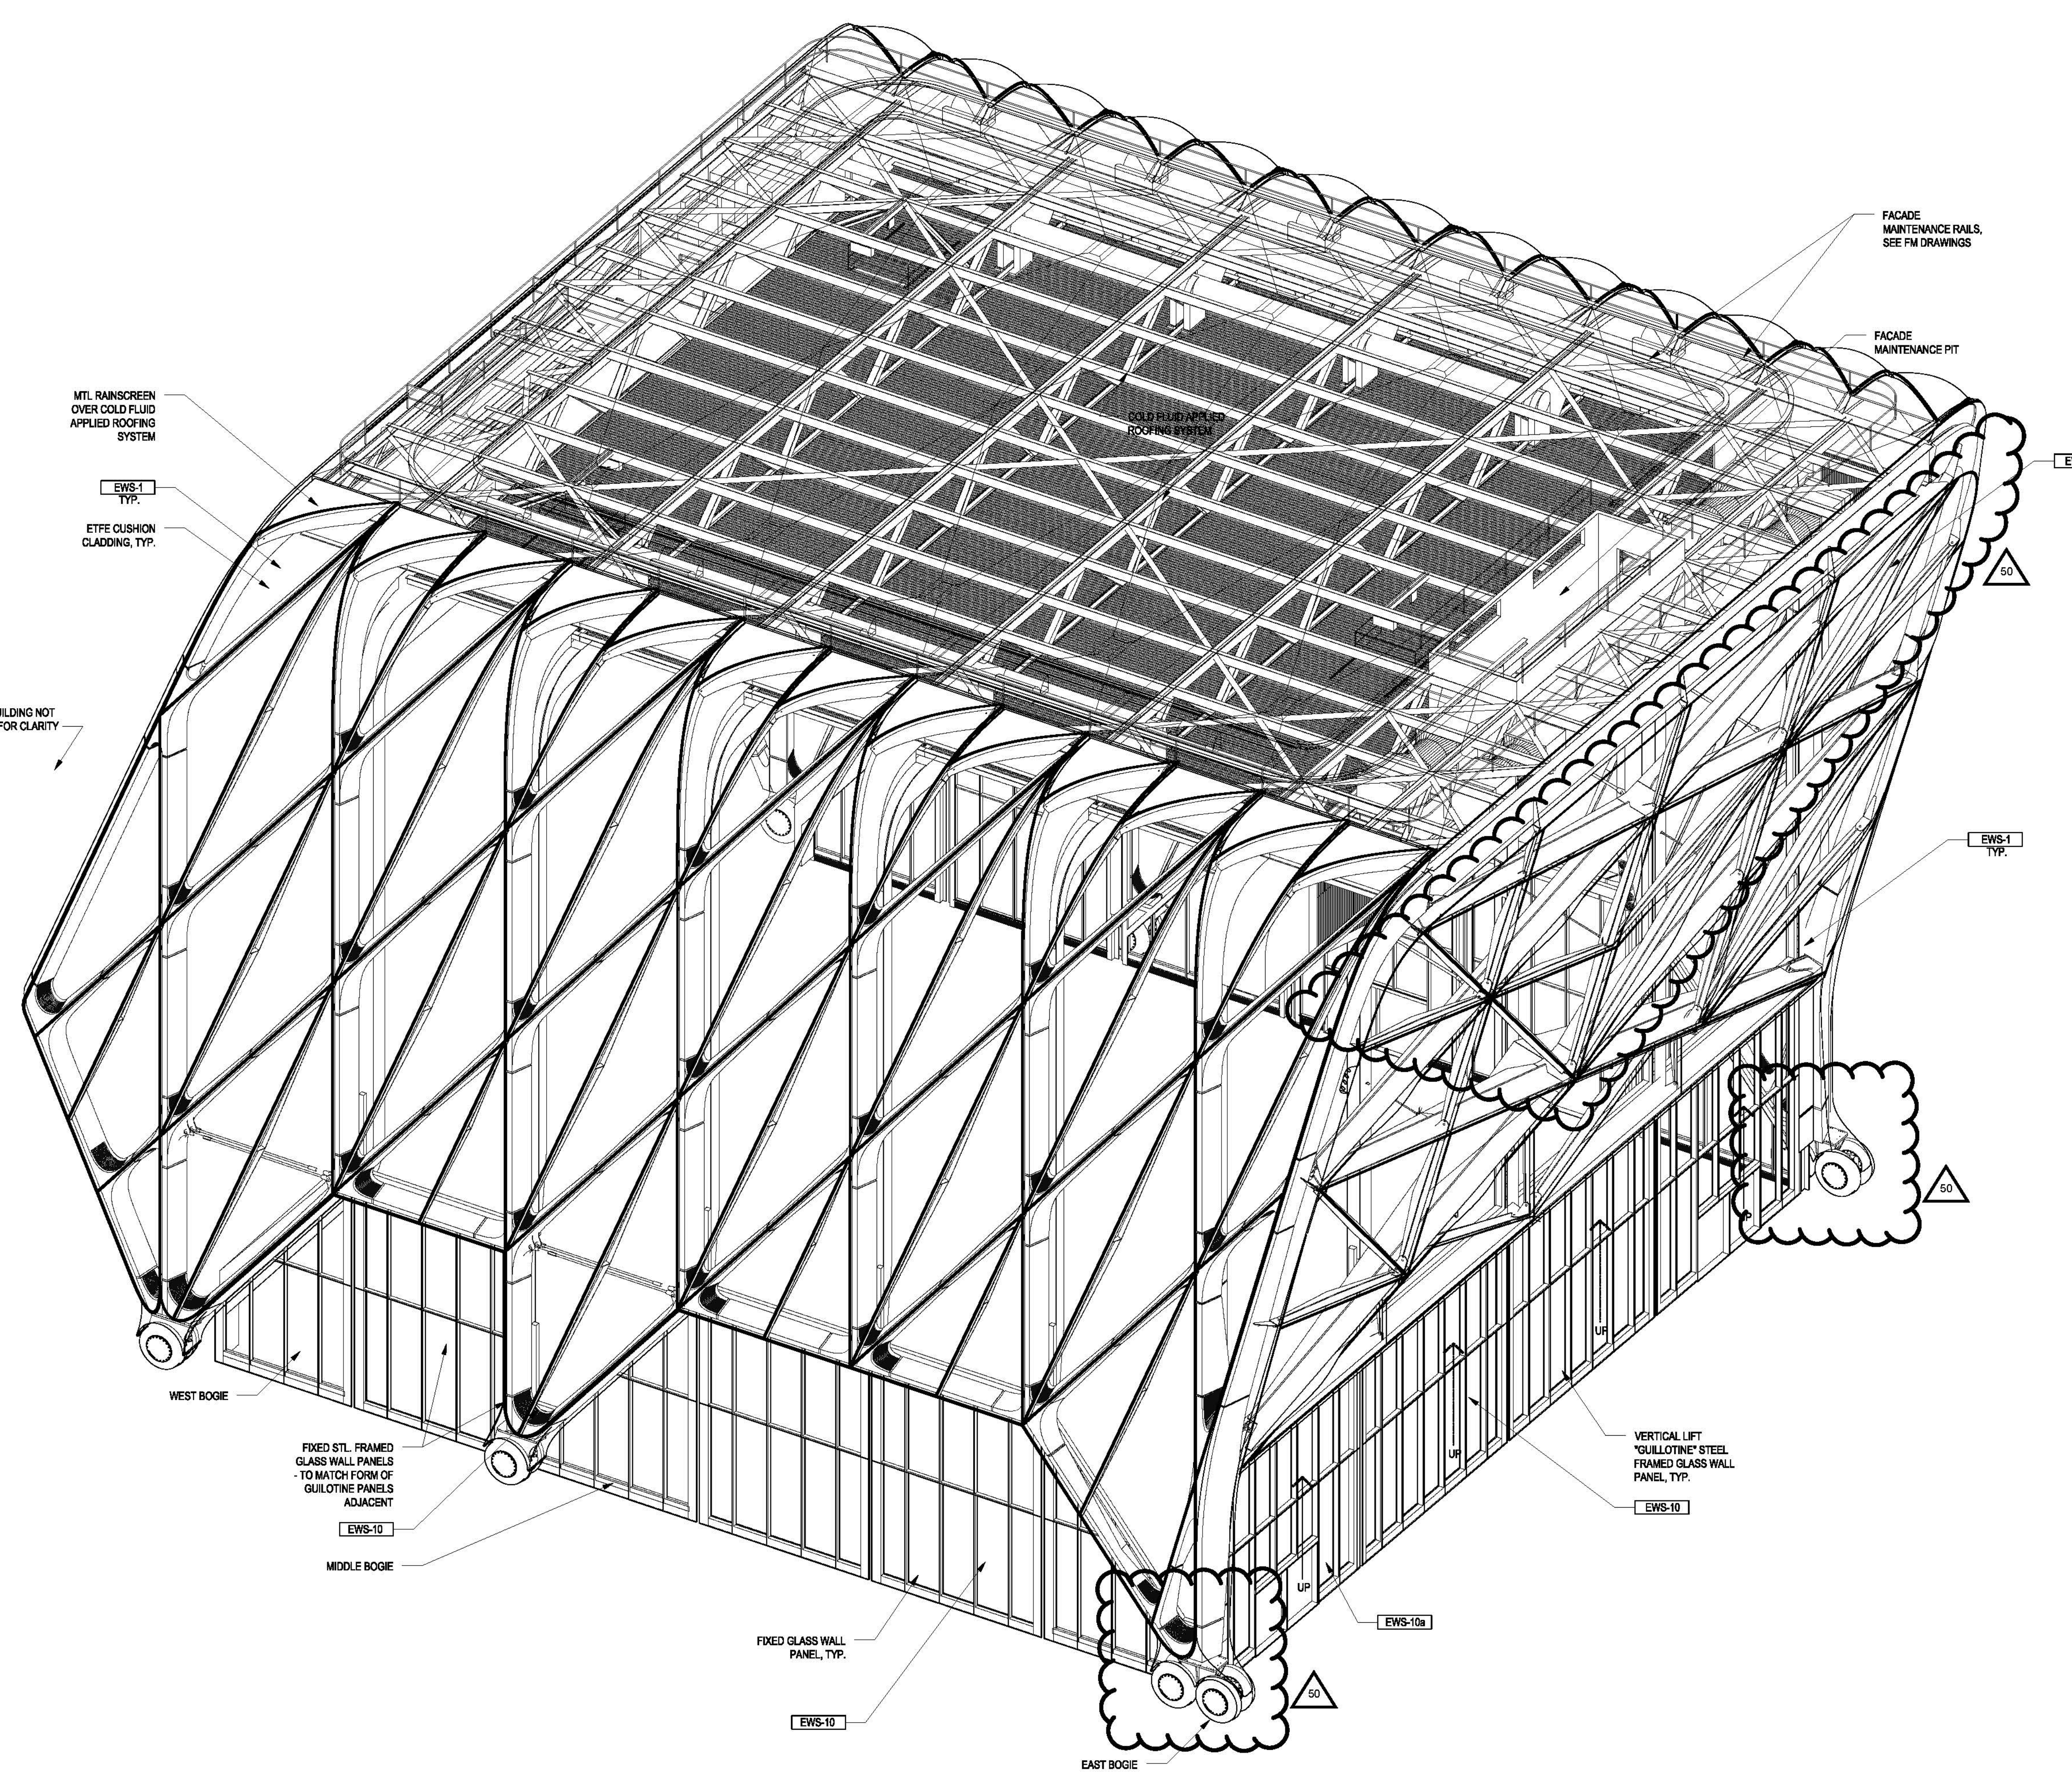


Damian Titus

APPROVED
Under Directive 1 of 1995
ADMINISTRATIVE
Date: 06/18/2016
NYC Development Hub


GENERAL NOTES

- For Shed components this drawing set is to be considered integral with the provided 3D models and may not be considered independently from the models. The contractor is to base their bid upon the information provided in both the drawings and 3D models. In matters of form and geometry the three dimensional model takes precedence in the instance of a discrepancy between drawing and model. In all other matters the contractor shall seek the opinion of the Architect and Structural Engineer to resolve the discrepancy.
- Geometry, dimensions and surface contouring, blending and intersection of sections illustrated in the structural drawings are provided for reference and generation of the structural arrangement and details only. The 3D model issued by the Architect defines the exterior surface and shall be adhered to for the final geometry. It is the responsibility of the Contractor to identify any discrepancies or ambiguities for discussion, resolution and direction from the Architect and Structural Engineer.
- Typical N/S wall node:
The geometry created by the intersecting main verticals and diagonals shall be in accordance with the 3D model and follow, as a minimum, the quality exhibited in the approved mock-up. The general concept is that edges flow smoothly and continuously between the straight edge of a diagonal through a curve to the adjacent edge of the vertical and the interlying surfaces between these edges are blended and contoured to define a smooth, uninterrupted transition.
- Typical Node Elsewhere:
The geometry created by the intersecting elements shall be in accordance with the 3D model. The level of quality is to be similar to the approved mock-up for the typical node. The general concept is that edges flow smoothly and continuously between the edge of one element to the corresponding edge of the adjacent element and the interlying surfaces between these edges are blended and contoured to define a smooth, uninterrupted transition.
- This drawing should be considered integral with the written Specifications issued along with the drawings and 3D models. Refer to the Advanced procurement Bid Issue Specifications Table of Contents.
- Structural steel cladding enclosing selected areas of the Shed (referred to as EWS-1c) shall be in the scope of the steel contractor for continuity with adjacent primary steel members. Criteria for tolerance and flatness to match that of the structural steel (see structural drawings & specifications). Plate configuration, including thickness, internal stiffeners and diaphragms, to be proposed by the fabricator and subject to agreement with the Architect and Engineer to provide an enclosure which satisfies the aesthetic and structural requirements. Refer to 3D model for extent of EWS-1c.
- Visually exposed HVAC supply and return ducts in the Shed, shown herein, are to be in the scope of the steel contractor to ensure continuity of appearance with primary steel. Criteria for tolerance and flatness to match that of the structural steel (see structural drawings & specifications). Plate configuration, including thickness, internal stiffeners and diaphragms, to be proposed by the fabricator and subject to agreement with the Architect and Engineer to provide an enclosure which satisfies the aesthetic and structural requirements. The mechanical ductwork carries its own self-weight and is not a primary load-bearing element. Internal stiffening may not create interference with airflow requirements of the duct. Refer to 3D model.

KEY PLAN

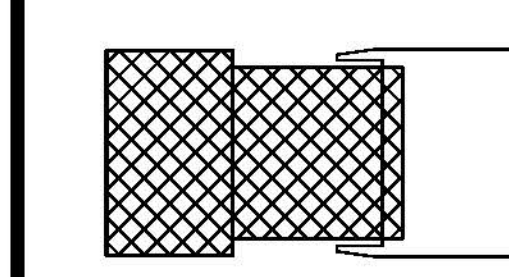

ISSUE	PRINTING	DATE
61	50	DOB AMENDMENT 7 08.18.2016
44	35	DOB AMENDMENT 5 04.28.2016
13		DOB AMENDMENT 1 08.20.2015
12	4	100% CONSTRUCTION DOCUMENTS 03.18.2015
9		90% CONSTRUCTION DOCUMENTS 02.18.2015
6		PRELIMINARY DOB SUBMISSION 12.10.2014
2		90% CONSTRUCTION DOCUMENTS 08.18.2014
1		ADV. PROCUREMENT BID SET 08.18.2014

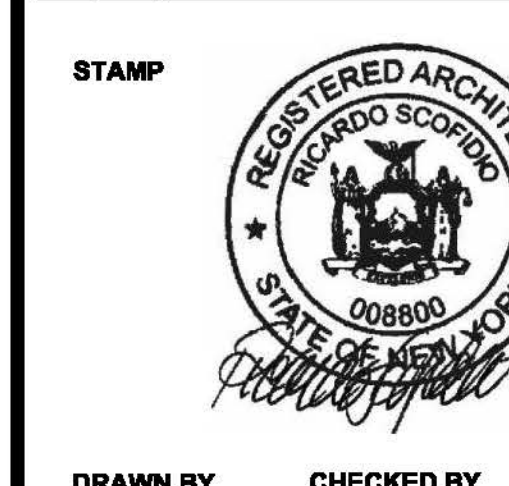

DRAWN BY
MO

CHECKED BY
CS

PROJECT NUMBER
11017



TITLE
Axonometrics
Deployable Shed

SCALE: NTS

DRAWING NO.
A-501.00

B-SCAN NO.
A-501.01

1 of 100

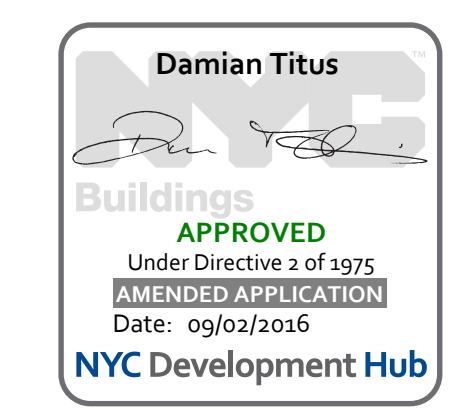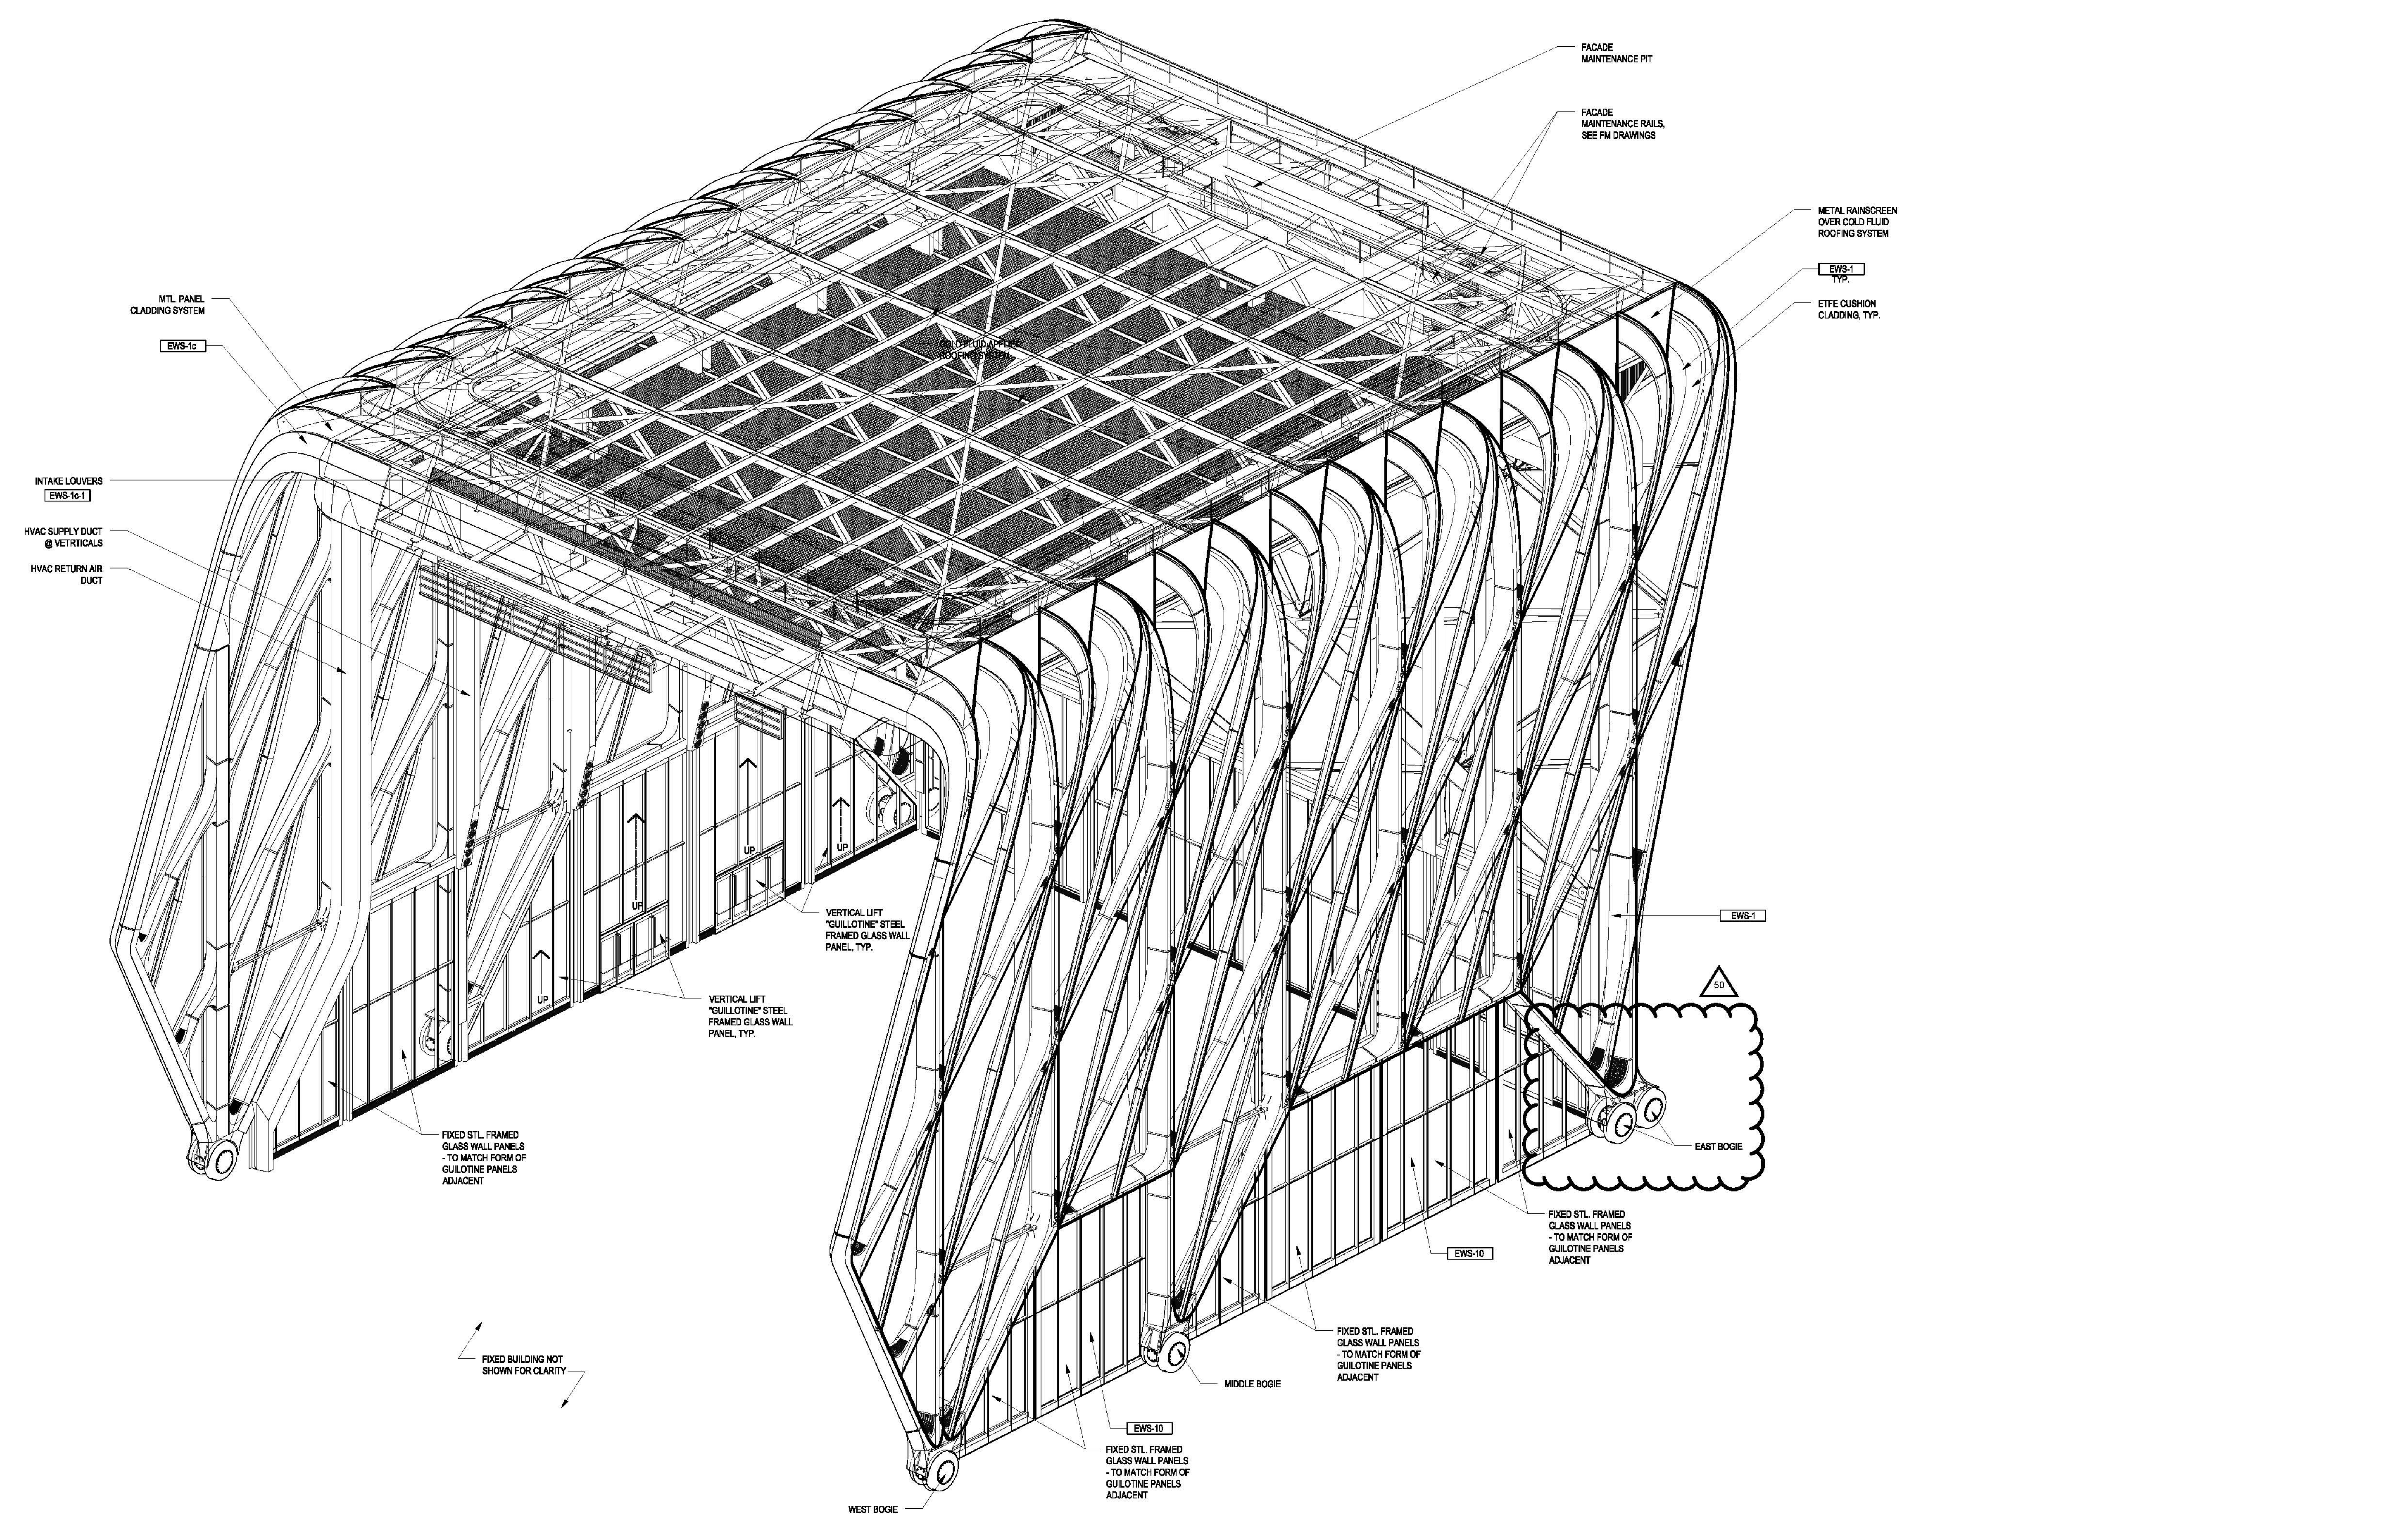

LEGEND

EWS-1c
Insulated ptd Structural Steel Cladding

CULTURE SHED

545 West 30th Street
New York, New York 10001

OWNER
CULTURE SHED INC

ARCHITECTS
Diller Scofidio + Renfro Architects, DPC
801 West 78 Street #815
New York, New York 10001
T: 212.260.7871

rockwellgroup
8 Union St, West, 8th Fl
New York, New York 10003
T: 212.463.0334
F: 212.463.0335

STRUCTURAL ENGINEER
Thornton Tomasetti
51 Madison Avenue
New York, New York 10010
T: 917.881.7800
F: 917.881.7801

MEP ENGINEER
Jaros Baum & Bolles
80 Pine Street
New York, New York 10005
T: 212.530.8200
F: 212.260.8584

FACADE CONSULTANT
Thornton Tomasetti
51 Madison Avenue
New York, New York 10010
T: 917.881.7800
F: 917.881.7801

KINETICS ENGINEER
Hardsy & Hanover
1001 Broadway
New York, New York 10003
T: 212.844.1150
F: 212.397.0297

LIGHTING DESIGNER
Tilston Design Associates
43 Worth Street #100
New York, New York 10013
T: 212.676.7760

THEATRE PLANNING & DESIGN
Fisher Dunin Associates
22 West 10th Street
New York, New York 10011
T: 212.951.3000

LFSE SAFETY
Code Consultants, Inc.
215 West 40th St, 10th Fl
New York, New York 10018
T: 212.216.9586

ENERGY MODEL/LEED
Virtidian
50 Washington Street
Norwalk, CT 06854
T: 203.298.1411

ACOUSTIC/AUDIO-VISUAL
Aluminate
90 North Main Street
South Norwalk, CT 06854
T: 347.210.5540

VERTICAL TRANSPORTATION
Van Dusen & Associates
5 Robert Street, Suite 524
Livingston, NJ 07039
T: 973.984.8220

SPECIFICATIONS
Construction Specifications Inc.
PO Box 489
22 Tenney Road
Mergentown, NJ 07751
T: 732.970.0700
F: 732.970.0700


SECURITY
Ducibella Venter & Sartore
1020 Sherman Avenue
Hartford, CT 06114
T: 203.288.6490

WATERPROOFING
James R. Gairfort AIA Consulting Architects PC
104 West 17th Street
New York, NY 10011
T: 212.736.3344

FACADE MAINTENANCE
Etnak Engineering PLLC
186 Avenue C
New York, NY 10005
T: 212.898.3000

BRANDING/GRAPHICS
234 Global Design Consultancy
180 York Street 15th Floor
New York, NY 10014
T: 212.847.1170


KEY PLAN

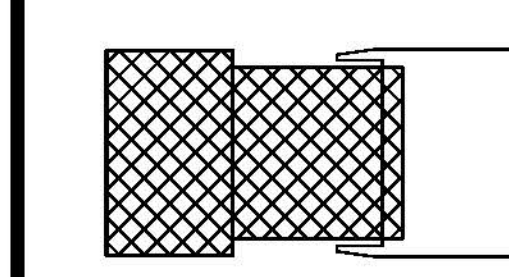

ISSUE/PRINTING DATE

Table with 3 columns: Issue/Printing, Date. Rows include DOB AMENDMENT 7 (08.18.2016), DOB AMENDMENT 5 (04.28.2016), DOB AMENDMENT 1 (08.23.2015), 100% CONSTRUCTION DOCUMENTS (03.18.2015), 90% CONSTRUCTION DOCUMENTS (02.18.2015), PRELIMINARY DOB SUBMISSION (12.23.2014), 50% CONSTRUCTION DOCUMENTS (08.19.2014), ADV. PROCUREMENT BID SET (06.18.2014).

STAMP

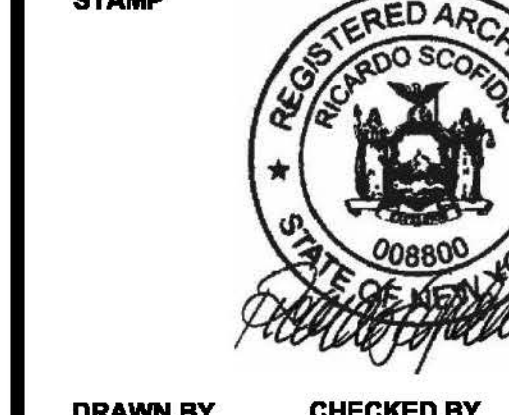


DRAWN BY: MO, CHECKED BY: CR

PROJECT NUMBER: 11017

TITLE: Axonometrics Deployable Shed

SCALE: NTS

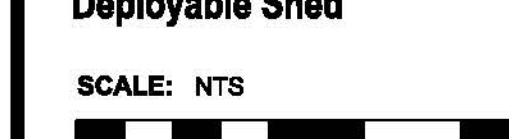


DRAWING NO. A-502.00

B-SCAN NO.

A-502.01

1 of 100

Copyright 2014, Diller Scofidio + Renfro Architects, D.P.C., in collaboration with Rockwell Group. All rights reserved.

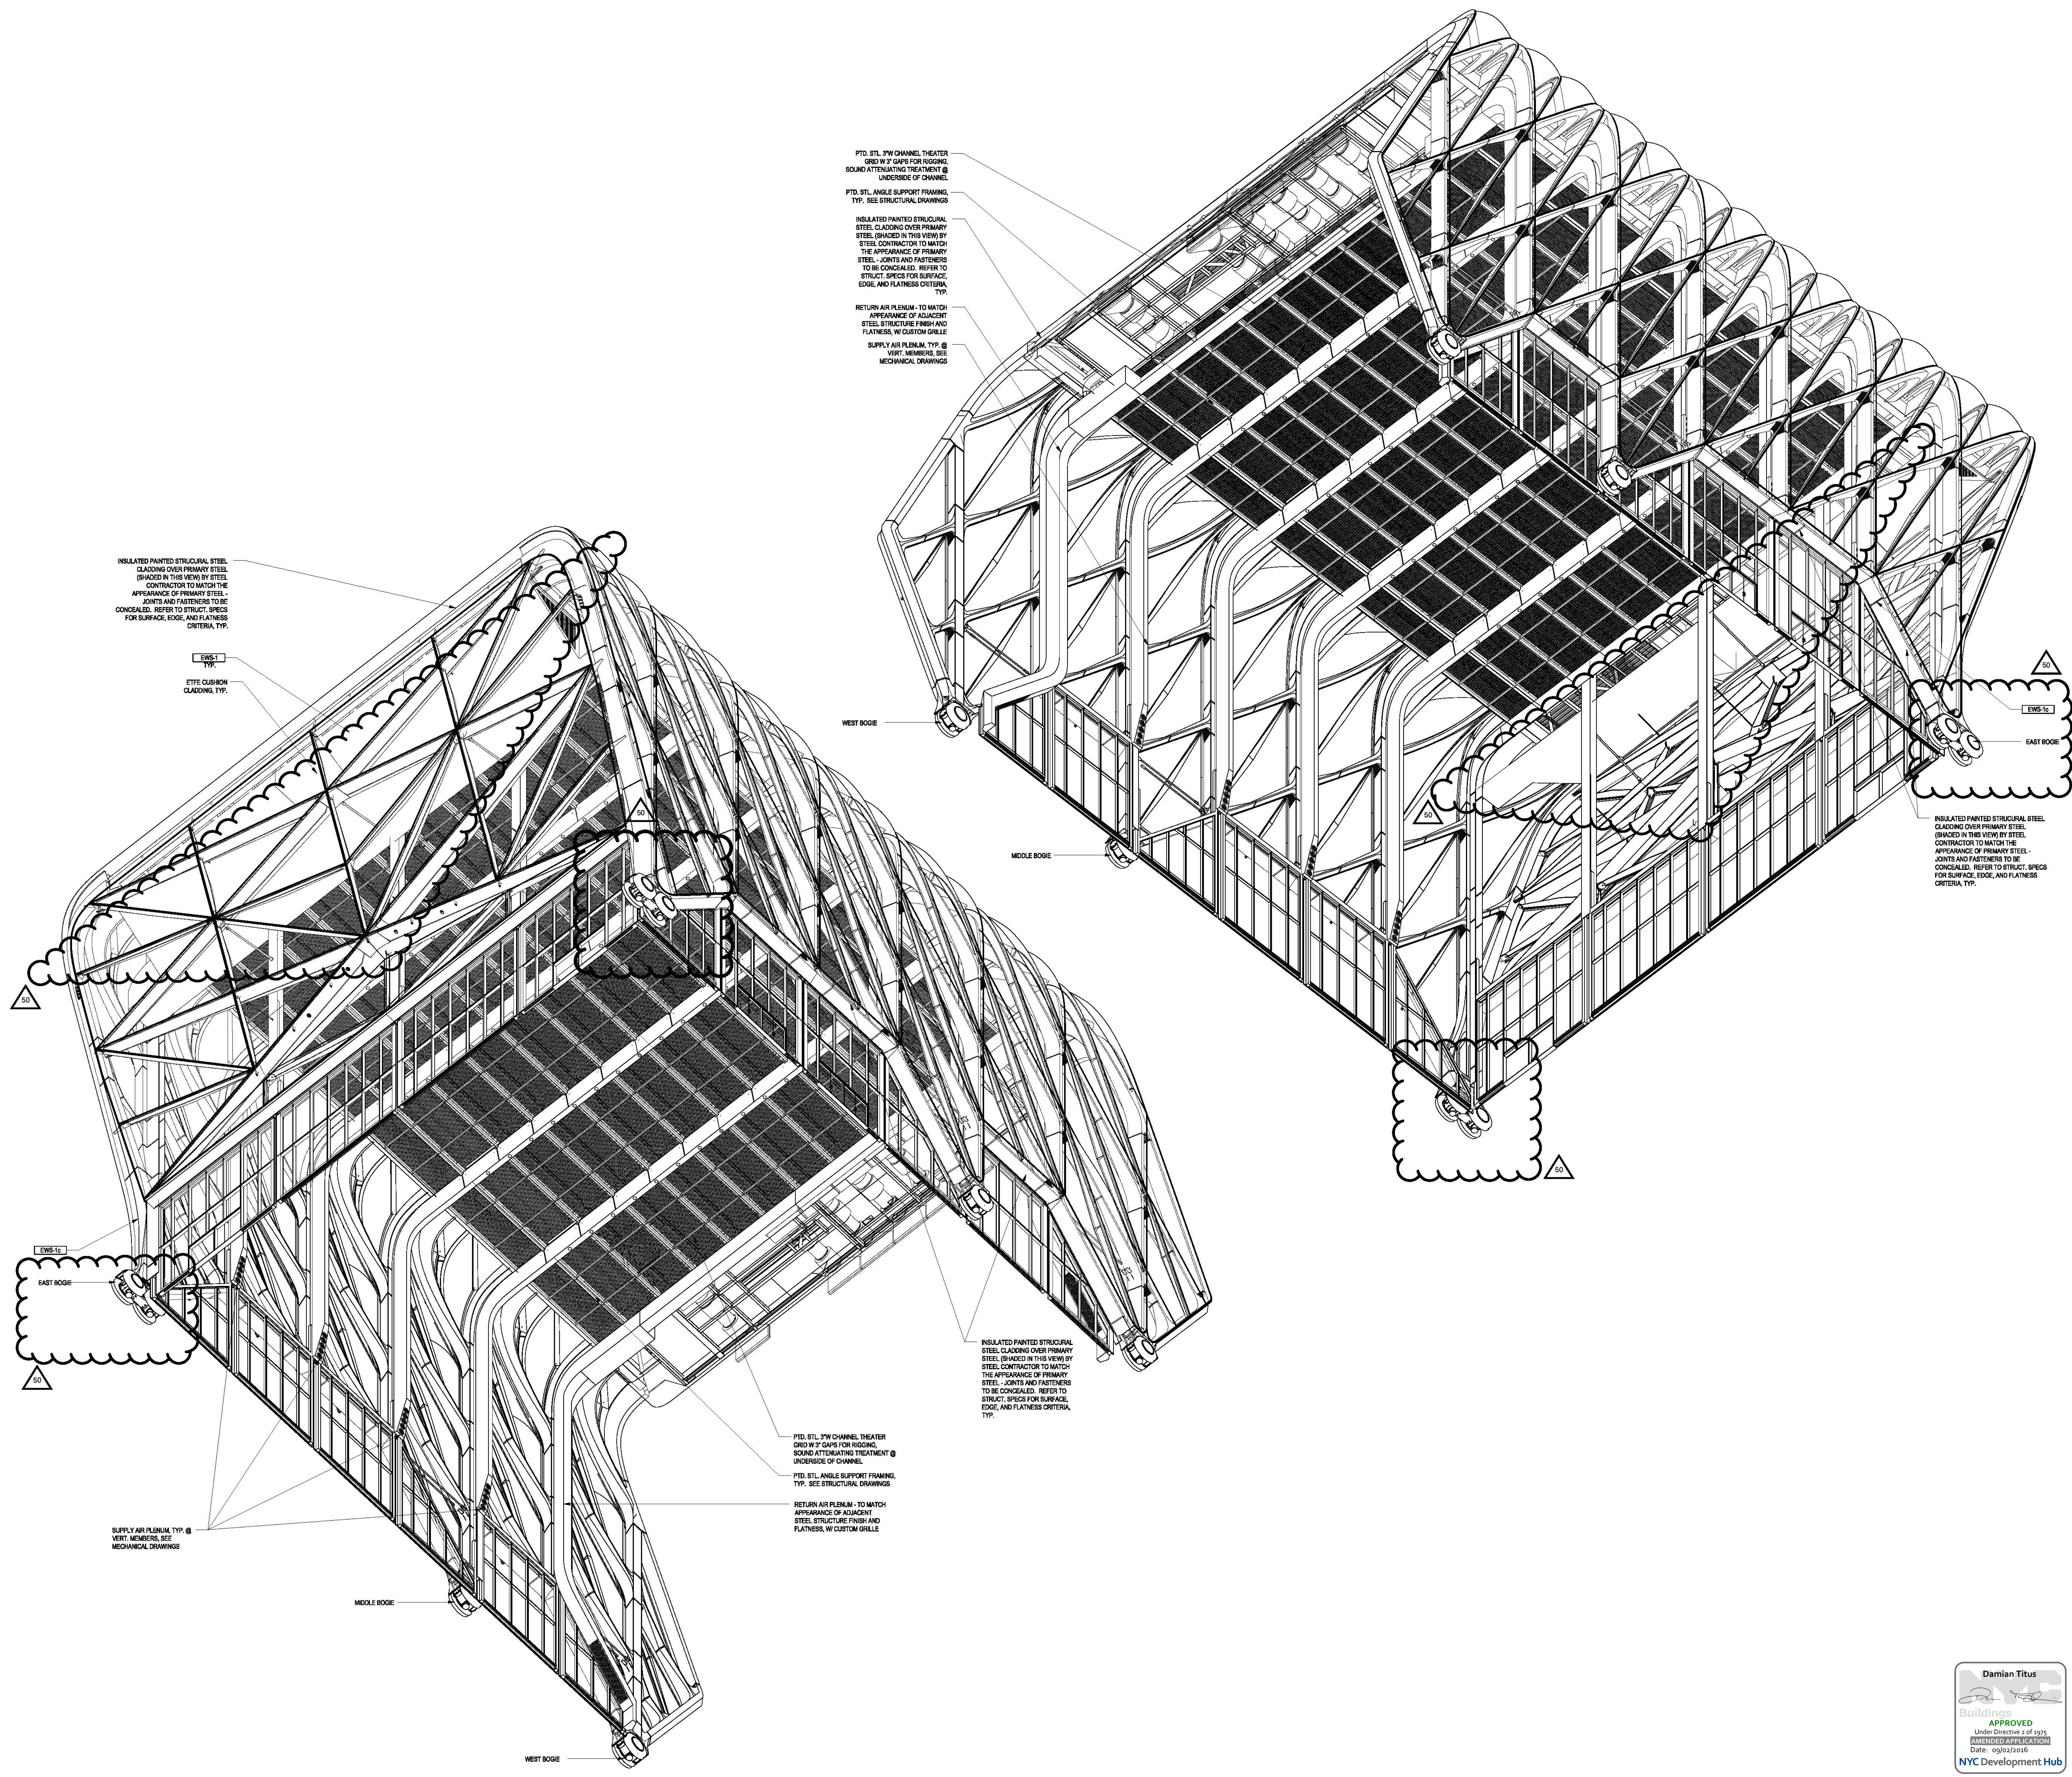

PTD. STL. 1/2" CHANNEL THEATER GRID W/ 7" GAPS FOR ROOFING, SOUND ATTENUATING TREATMENT @ UNDERSIDE OF CHANNEL
PTD. STL. ANGLE SUPPORT FRAMING, TYP. SEE STRUCTURAL DRAWINGS
INSULATED PAINTED STRUCTURAL STEEL CLADDING OVER PRIMARY STEEL. SHADEN IN THIS VIEW BY STEEL CONTRACTOR TO MATCH THE APPEARANCE OF PRIMARY STEEL. JOINTS AND FASTENERS TO BE CONCEALED. REFER TO STRUCT. SPECS FOR SURFACE, EDGE, AND FLATNESS CRITERIA, TYP.
RETURN AIR PLenum TO MATCH APPEARANCE OF ADJACENT STEEL. STRUCTURE FINISH AND FLATNESS, W/ CUSTOM GRILLE
SUPPLY AIR PLenum, TYP. @ VERT. MEMBERS, SEE MECHANICAL DRAWINGS


INSULATED PAINTED STRUCTURAL STEEL CLADDING OVER PRIMARY STEEL. SHADEN IN THIS VIEW BY STEEL CONTRACTOR TO MATCH THE APPEARANCE OF PRIMARY STEEL. JOINTS AND FASTENERS TO BE CONCEALED. REFER TO STRUCT. SPECS FOR SURFACE, EDGE, AND FLATNESS CRITERIA, TYP.
ETFE CURTAIN CLADDING, TYP.

EWS-1c
EAST BOGE

PTD. STL. 1/2" CHANNEL THEATER GRID W/ 7" GAPS FOR ROOFING, SOUND ATTENUATING TREATMENT @ UNDERSIDE OF CHANNEL
PTD. STL. ANGLE SUPPORT FRAMING, TYP. SEE STRUCTURAL DRAWINGS
INSULATED PAINTED STRUCTURAL STEEL CLADDING OVER PRIMARY STEEL. SHADEN IN THIS VIEW BY STEEL CONTRACTOR TO MATCH THE APPEARANCE OF PRIMARY STEEL. JOINTS AND FASTENERS TO BE CONCEALED. REFER TO STRUCT. SPECS FOR SURFACE, EDGE, AND FLATNESS CRITERIA, TYP.
RETURN AIR PLenum TO MATCH APPEARANCE OF ADJACENT STEEL. STRUCTURE FINISH AND FLATNESS, W/ CUSTOM GRILLE
SUPPLY AIR PLenum, TYP. @ VERT. MEMBERS, SEE MECHANICAL DRAWINGS

SHED 3D - AXON VIEW - EXTENT OF CLADDING DIAGRAM
GUILLOTINE DOORS AND FIXED GLAZING OMITTED FOR CLARITY

1
NTS

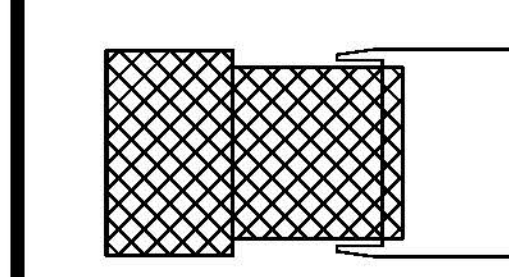

ISSUE	PRINTING	DATE
61	50 DOB AMENDMENT 7	06.18.2016
46	33 DOB AMENDMENT 5	04.28.2016
13	DOB AMENDMENT 1	08.23.2015
10	4 100% CONSTRUCTION DOCUMENTS	03.18.2015
9	90% CONSTRUCTION DOCUMENTS	02.18.2015
6	PRELIMINARY DOB SUBMISSION	12.16.2014
2	50% CONSTRUCTION DOCUMENTS	08.18.2014
1	ADV. PROCUREMENT BID SET	06.18.2014




DRAWN BY: MO
CHECKED BY: CB
PROJECT NUMBER: 11017


TITLE: East Bogle Axonometric Views

SCALE: NTS
DRAWING NO. A-505.00

B-SCAN NO. A-505.01

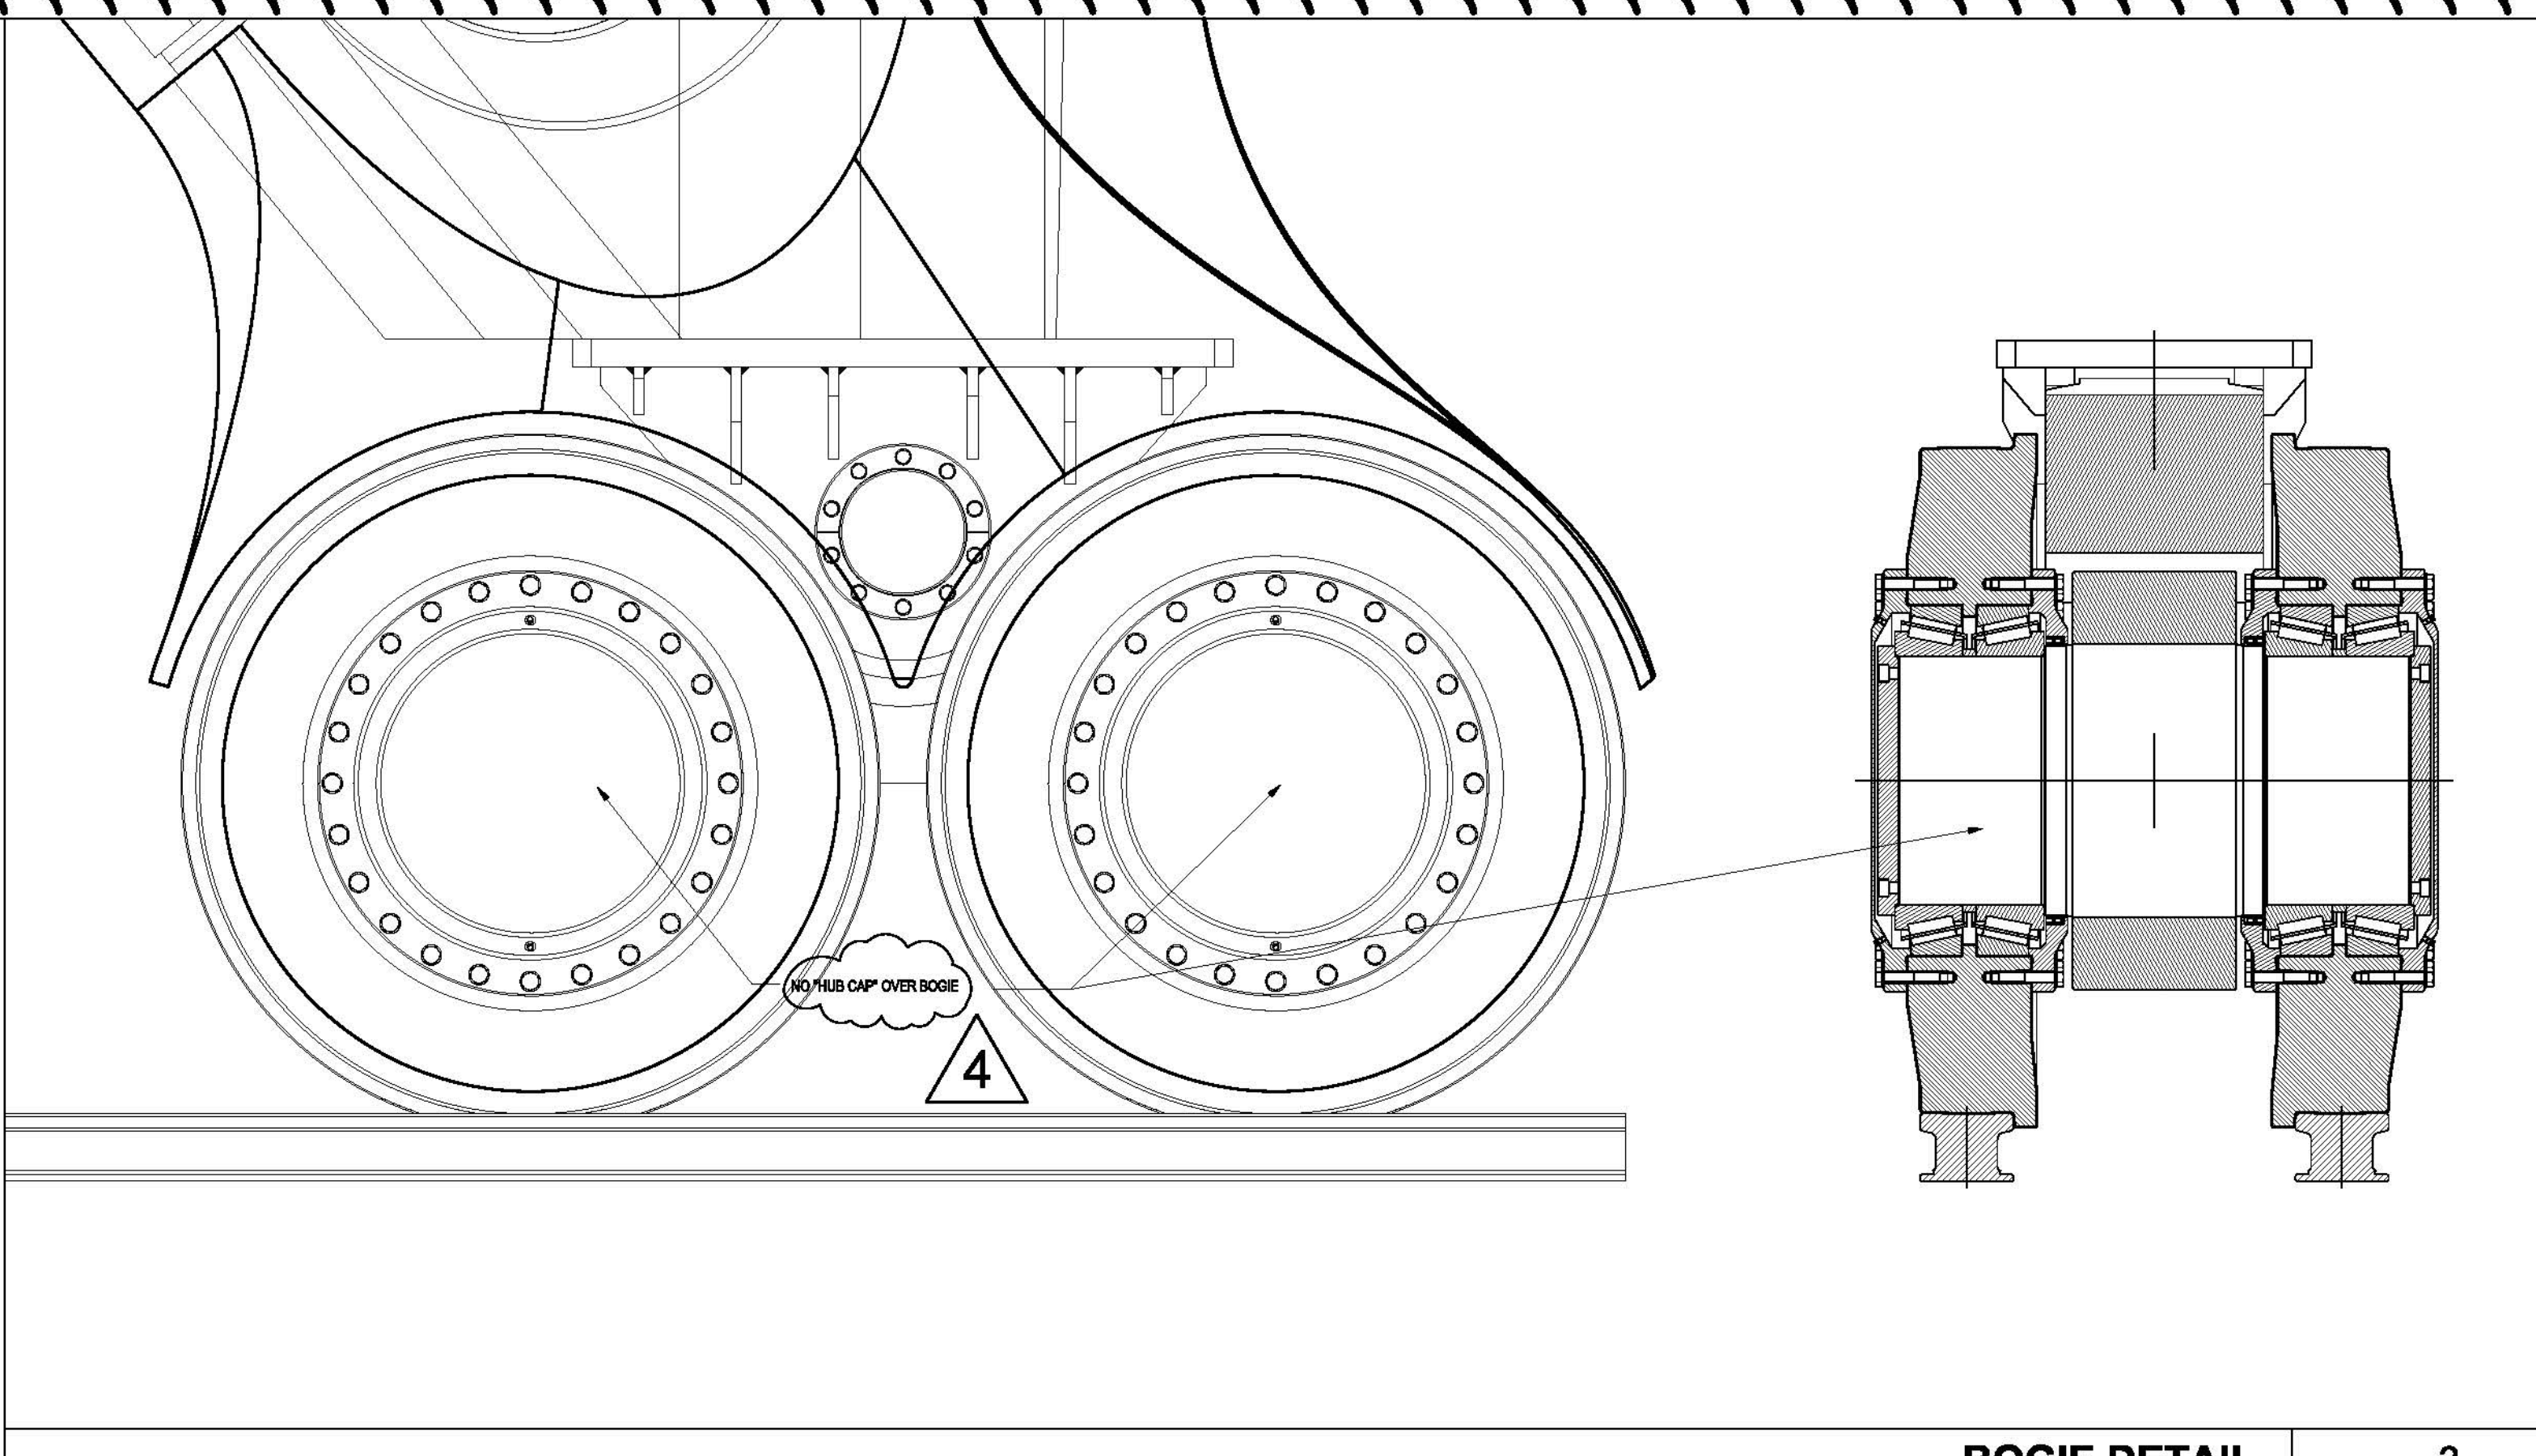


BOGIE DETAIL 3
3/4" = 1'-0"

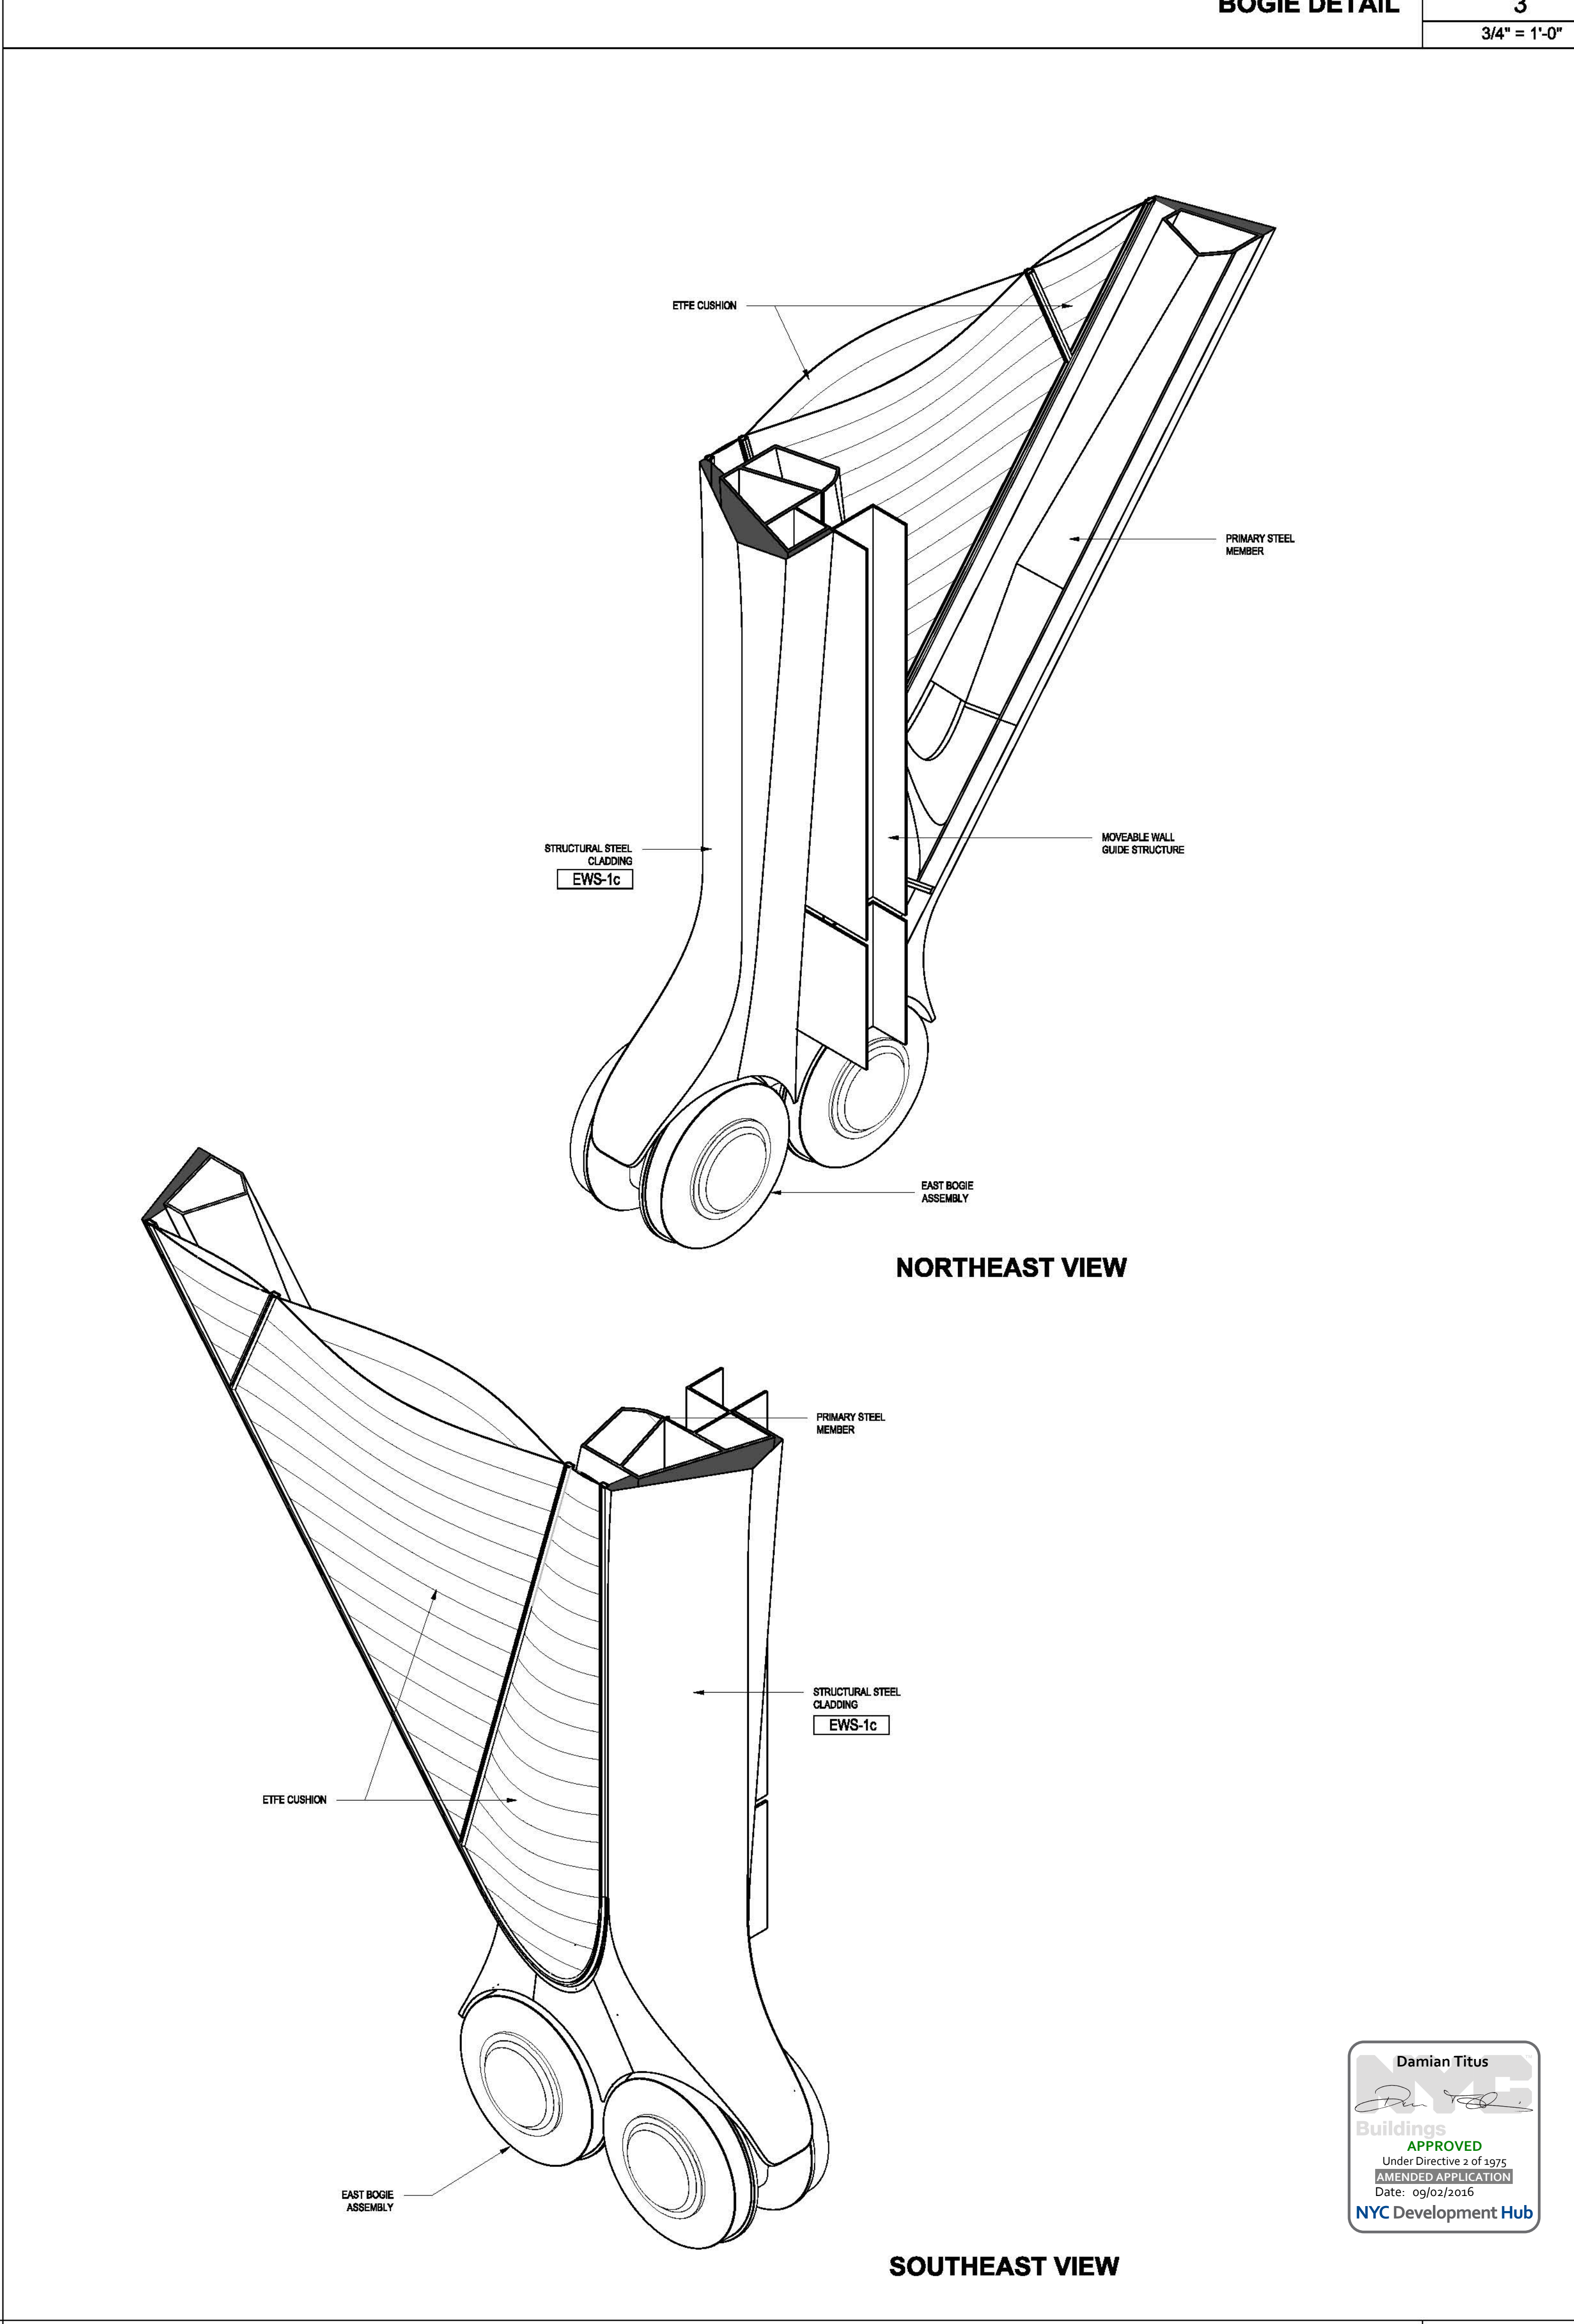

NORTHEAST VIEW

SOUTHEAST VIEW

EAST BOGIE AXONOMETRIC VIEWS 2
NTS

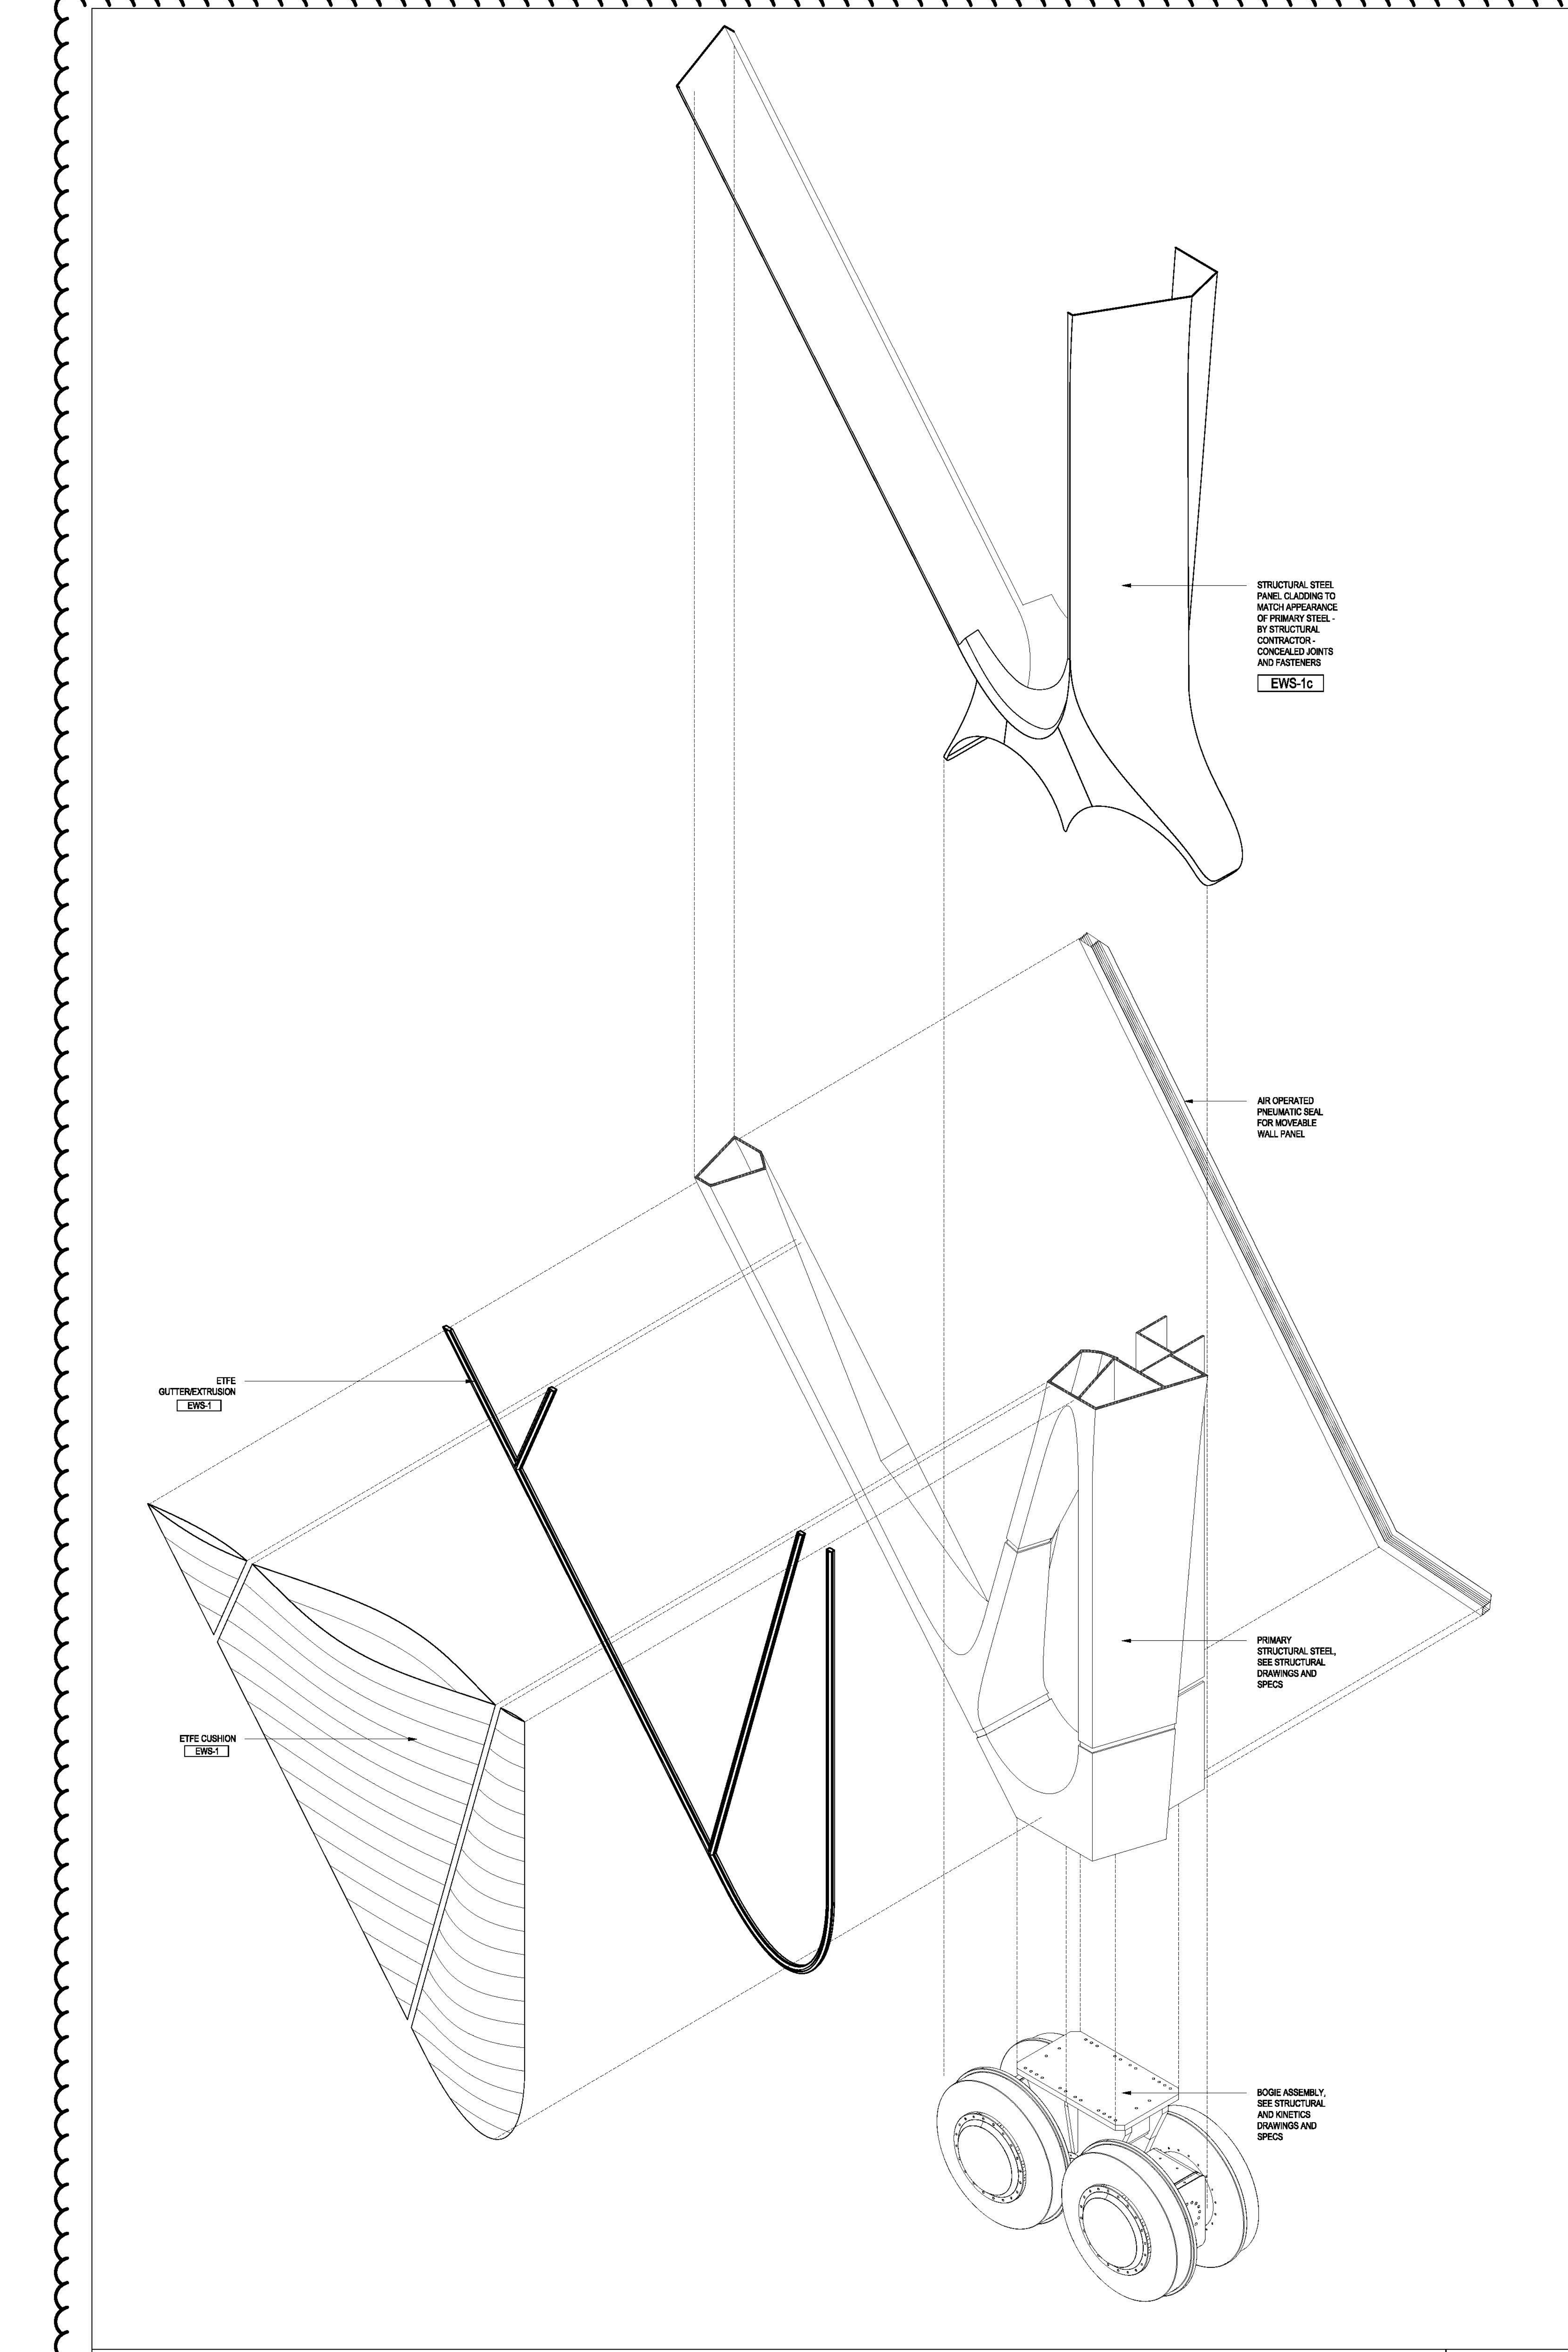

EAST BOGIE EXPLODED AXONOMETRIC VIEW 1
NTS

STRUCTURAL STEEL PANEL CLADDING TO MATCH APPEARANCE OF PRIMARY STEEL BY STRUCTURAL CONTRACTOR - CONCEALED JOINTS AND FASTENERS EWS-1c

AIR OPERATED PNEUMATIC SEAL FOR MOVABLE WALL PANEL

PRIMARY STRUCTURAL STEEL SEE STRUCTURAL DRAWINGS AND SPECS

BOGIE ASSEMBLY SEE STRUCTURAL AND KINETICS DRAWINGS AND SPECS

ETE CUSHION

STRUCTURAL STEEL CLADDING EWS-1c

ETE CUSHION EWS-1

STRUCTURAL STEEL CLADDING EWS-1c

ETE CUSHION

EAST BOGIE ASSEMBLY

4

3/4" = 1'-0"

CULTURE SHED

545 West 30th Street
New York, New York 10001

OWNER: CULTURE SHED INC

ARCHITECTS:
Diller Scofidio + Renfro Architects, D.P.C.
801 West 28 Street #815
New York, New York 10001
T: 212.260.7871

rockwellgroup
6 Union St. West, 8th Fl.
New York, New York 10003
T: 212.463.0334
F: 212.463.0335

STRUCTURAL ENGINEER
Thornton Tomasetti
51 Madison Avenue
New York, New York 10017
T: 917.891.7800
F: 917.891.7801

MEP ENGINEER
Jaros Baum & Bolles
80 Pine Street
New York, New York 10005
T: 212.530.8200
F: 212.260.9884

FACADE CONSULTANT
Thornton Tomasetti
51 Madison Avenue
New York, New York 10017
T: 917.891.7800
F: 917.891.7801

KINETICS ENGINEER
Hardisty & Hanover
1501 Broadway
New York, New York 10036
T: 212.844.1150
F: 212.397.0297

LIGHTING DESIGNER
Tilston Design Associates
40 Worth Street #190
New York, New York 10013
T: 212.675.7760

THEATRE PLANNING & DESIGN
Flaher Dachs Associates
22 West 19th Street
New York, New York 10011
T: 212.861.3020

LIFE SAFETY
Code Consultants, Inc.
215 West 40th St, 10th Fl.
New York, New York 10018
T: 212.216.9586

ENERGY MODEL/LEED
Viridian
50 Washington Street
Norwalk, CT 06854
T: 203.298.1411

ACOUSTIC/AUDIO-VISUAL
Alacritas
93 North Main Street
South Norwalk, CT 06854
T: 347.210.5540

VERTICAL TRANSPORTATION
Van Dusen & Associates
5 Regent Street, Suite 524
Livingston, NJ 07039
T: 973.994.9220

SPECIFICATIONS
Construction Specifications Inc.
PO Box 489
22 Tenney Road
Morgantown, NJ 07751
T: 732.970.0700
F: 732.970.0700


SECURITY
Duchella Venter & Santoro
1020 Sherman Avenue
Hamden, CT 06514
T: 203.288.6490

WATERPROOFING
James R. Gairford AIA Consulting Architects PC
104 West 17th Street
New York, NY 10011
T: 212.736.3344

FACADE MAINTENANCE
Erik Engineering PLLC
96 Avenue C
New York, NY 10009
T: 212.698.3000


BRANDING/GRAPHICS
204 Global Design Consultancy
180 York Street 15th Floor
New York, NY 10014
T: 212.647.1170

KEY PLAN

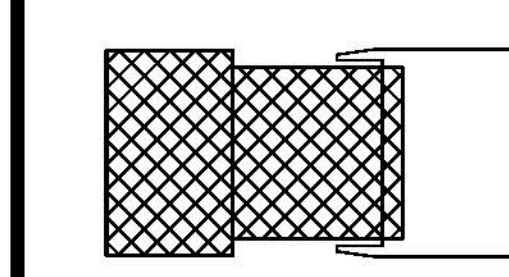

ISSUE/PRINTING DATE

NO.	DESCRIPTION	DATE
61	50 DOB AMENDMENT 7	06.18.2016
46	33 DOB AMENDMENT 5	04.28.2015
13	DOB AMENDMENT 1	08.20.2015
10	4 100% CONSTRUCTION DOCUMENTS	03.18.2015
9	80% CONSTRUCTION DOCUMENTS	02.18.2015
6	PRELIMINARY DOB SUBMISSION	12.16.2014
2	80% CONSTRUCTION DOCUMENTS	06.18.2014
1	ADV. PROCUREMENT BID SET	06.18.2014

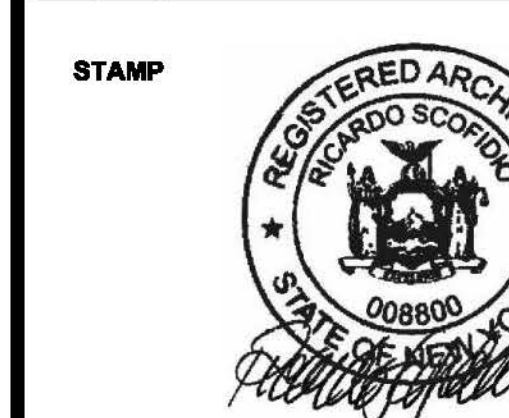

DRAWN BY: MO CHECKED BY: CB
PROJECT NUMBER: 11017

TITLE: EXTERIOR ELEVATION - SOUTH

SCALE: 1/8" = 1'-0"

DRAWING NO. A-507.00

B-SCAN NO. A-507.01

1 of 100


© Copyright 2014, Diller Scofidio + Renfro Architects, D.P.C. in collaboration with Rockwell Group. All rights reserved.

LEGEND


- EXTENT OF DEPLOYED SHED AT GRADE
- SHED OVERHANG EXTENTS
- INTEGRALLY COLORED PVC MEMBRANE ROOFING ON STRUCT STEEL PARAPET
- PAINTED STEEL RAILING - TYP
- SHED ROOF HP 16" x 16"
- T.O. COMPOSITE DECK 16" x 8 3/16"
- SHED - MECHANICAL DECK 16" x 3"
- T.O. PARAPET 14" x 3"
- FF ROOF MECH HP 14" x 6"
- EWS-1C STRUCT STL. CLADDING
- EWS-1 ETFE CUSHION TYP.
- EWS-2O AESS STEEL FRAMED MOVABLE WALL PANEL W/ INSULATED GLASS PANELS - TYPICAL
- FF 02 LEVEL 40' - 0"

GENERAL NOTES

1. For Shed components this drawing set is to be considered integral with the provided 3D models and may not be considered independently from the models. The contractor is to base their bid upon the information provided in both the drawings and 3D models. In matters of form and geometry the three dimensional model takes precedence in the instance of a discrepancy between drawing and model. In all other matters the contractor shall seek the opinion of the Architect and Structural Engineer to resolve the discrepancy.
2. Geometry, dimensions and surface contouring, blending and intersection of sections illustrated in the structural drawings are provided for reference and generation of the structural arrangement and details only. The 3D model issued by the Architect defines the exterior surface and shall be adhered to for the final geometry. It is the responsibility of the Contractor to identify any discrepancies or ambiguities for discussion, resolution and direction from the Architect and Structural Engineer.
3. Typical N/S wall node: The geometry created by the intersecting main verticals and diagonals shall be in accordance with the 3D model and follow, as a minimum, the quality exhibited in the approved mock-up. The general concept is that edges flow smoothly and continuously between the straight edge of a diagonal through a curve to the adjacent edge of the vertical and the interlying surfaces between these edges are blended and contoured to define a smooth, uninterrupted transition.
4. Typical Node Elsewhere: The geometry created by the intersecting elements shall be in accordance with the 3D model. The level of quality is to be similar to the approved mock-up for the typical node. The general concept is that edges flow smoothly and continuously between the edge of one element to the corresponding edge of the adjacent element and the interlying surfaces between these edges are blended and contoured to define a smooth, uninterrupted transition.
5. This drawing should be considered integral with the written Specifications issued along with the drawings and 3D models. Refer to the Advanced procurement Bid Issue Specifications Table of Contents.
6. Structural steel cladding enclosing selected areas of the Shed (referred to as EWS-1c) shall be in the scope of the steel contractor for continuity with adjacent primary steel members. Criteria for tolerance and flatness to match that of the structural steel (see structural drawings & specifications). Plate configuration, including thickness, internal stiffeners and diaphragms, to be proposed by the fabricator and subject to agreement with the Architect and Engineer to provide an enclosure which satisfies the aesthetic and structural requirements. Refer to 3D model for extent of EWS-1c.
7. Visually exposed HVAC supply and return ducts in the Shed, shown herein, are to be in the scope of the steel contractor to ensure continuity of appearance with primary steel. Criteria for tolerance and flatness to match that of the structural steel (see structural drawings & specifications). Plate configuration, including thickness, internal stiffeners and diaphragms, to be proposed by the fabricator and subject to agreement with the Architect and Engineer to provide an enclosure which satisfies the aesthetic and structural requirements. The mechanical ductwork carries its own self-weight and is not a primary load-bearing element. Internal stiffening may not create interference with airflow requirements of the duct. Refer to 3D model.

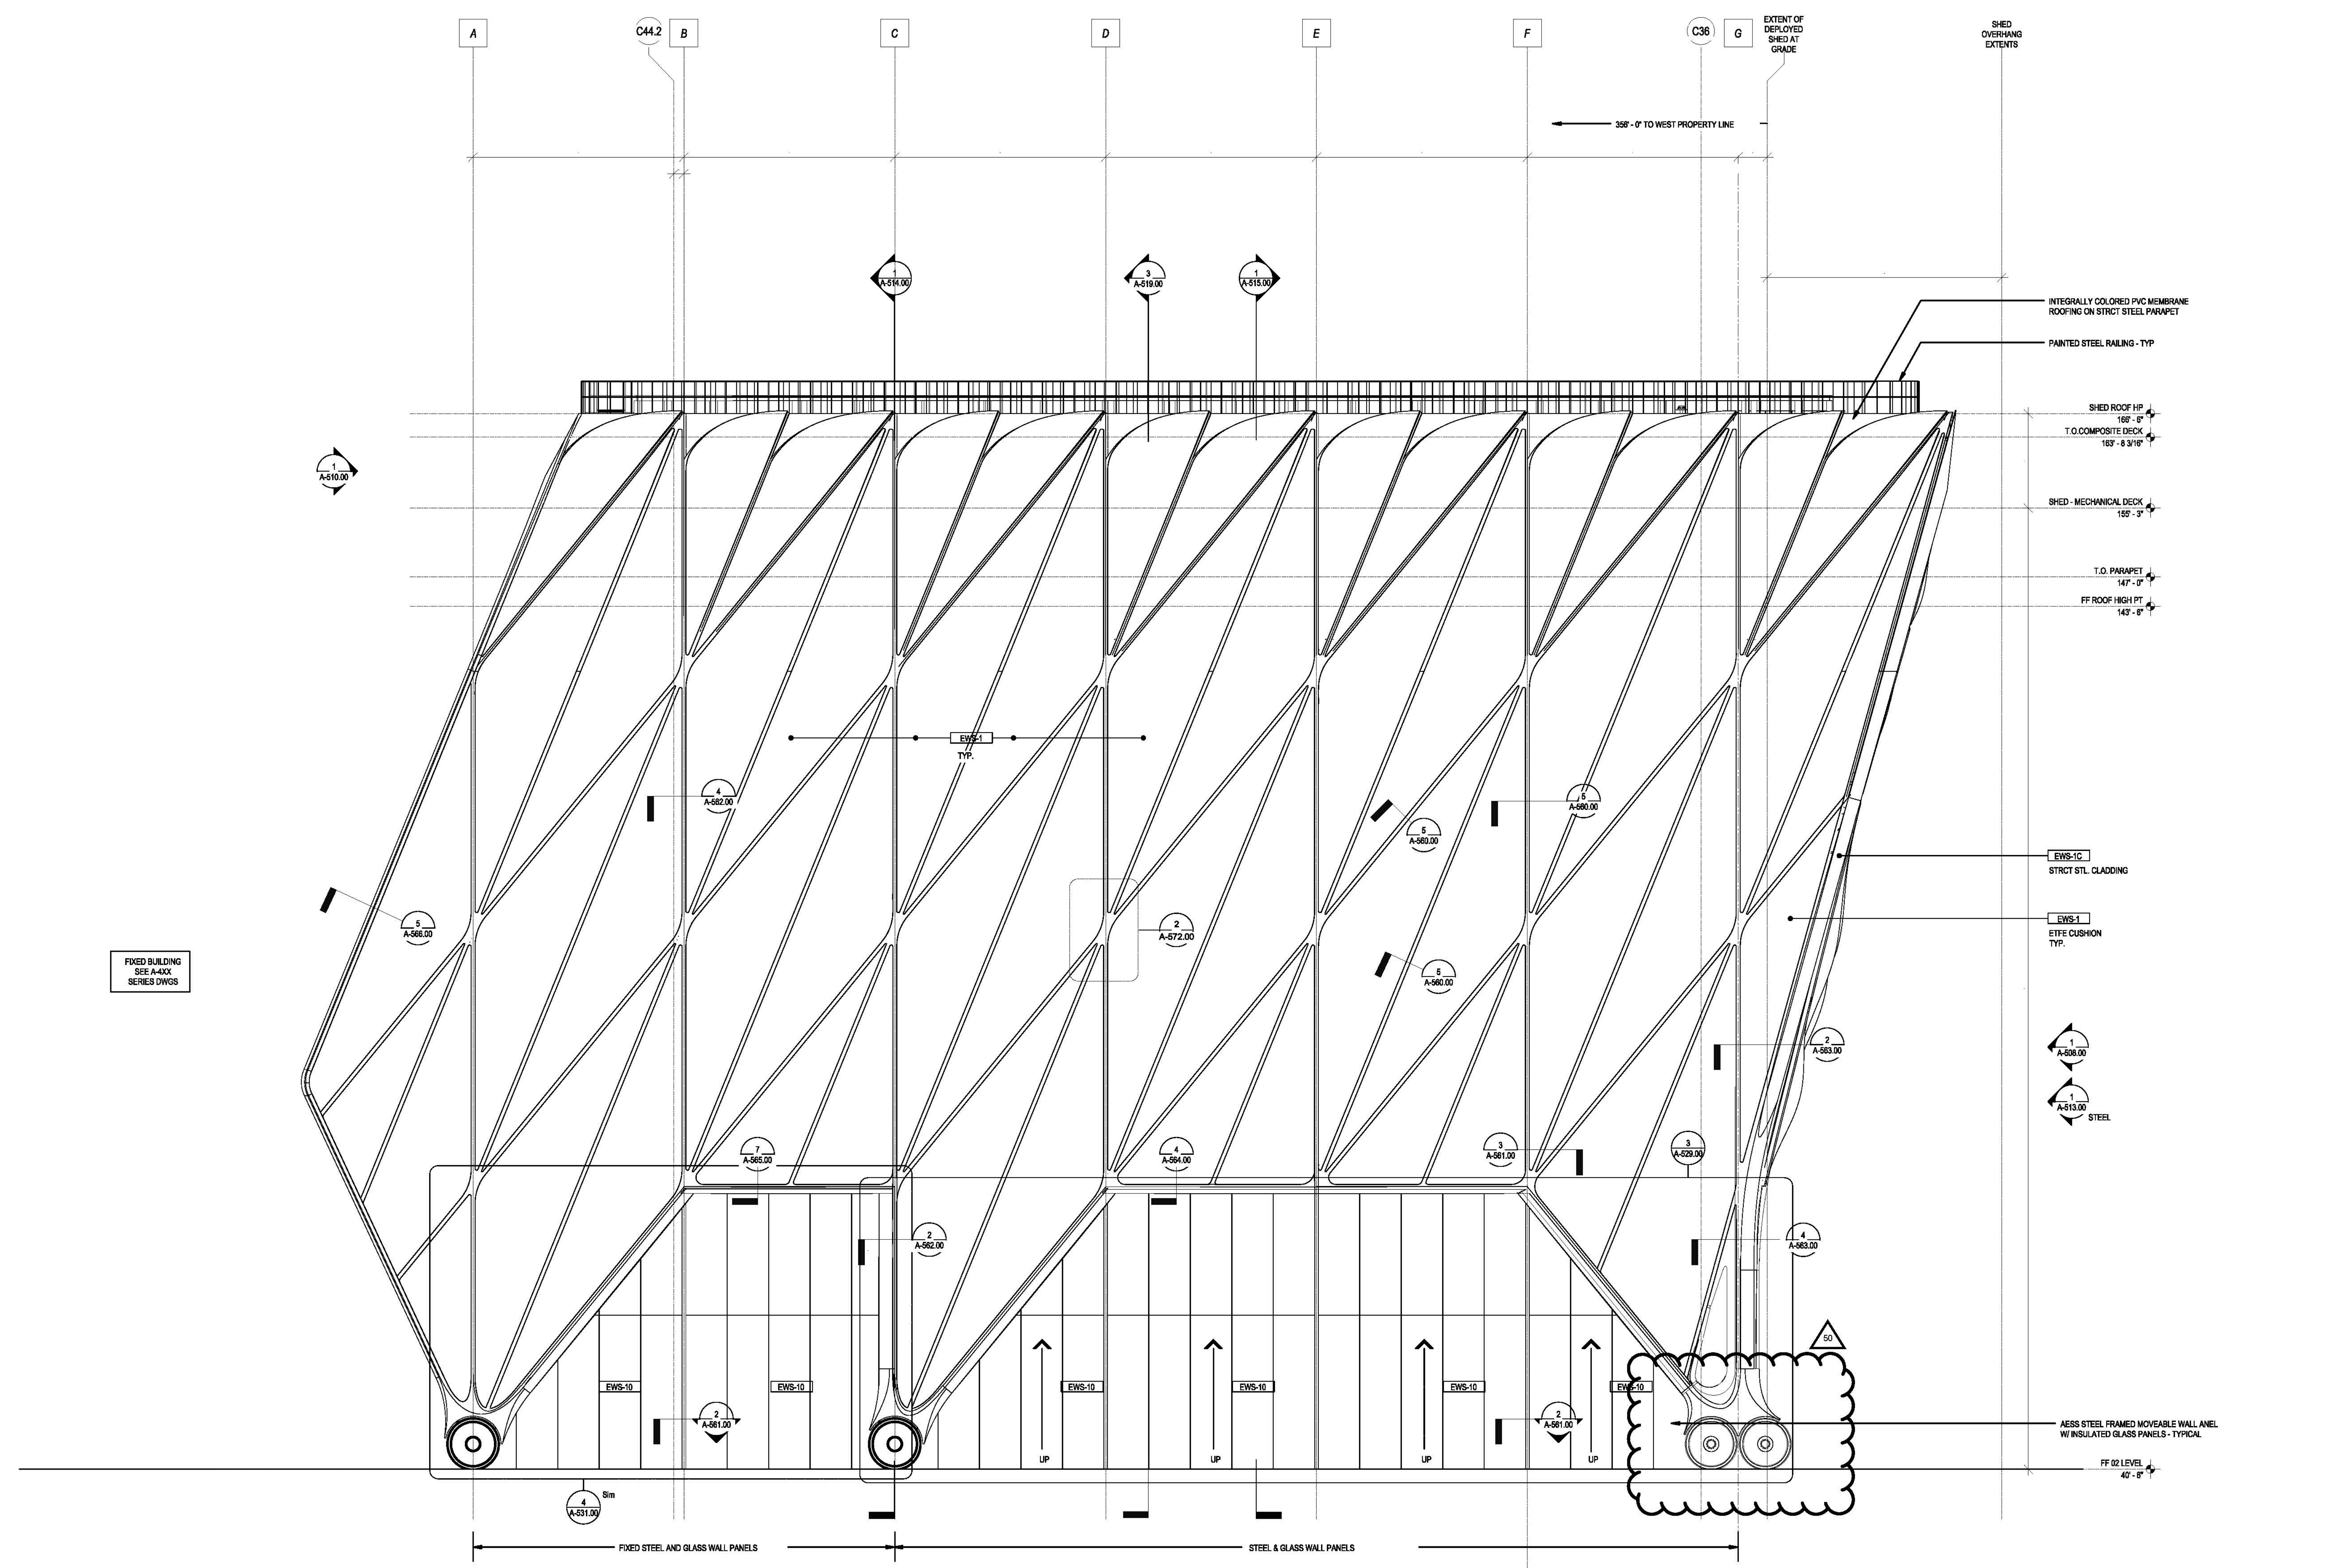

SHED ELEVATION - SOUTH STEEL 1
1/8" = 1'-0"

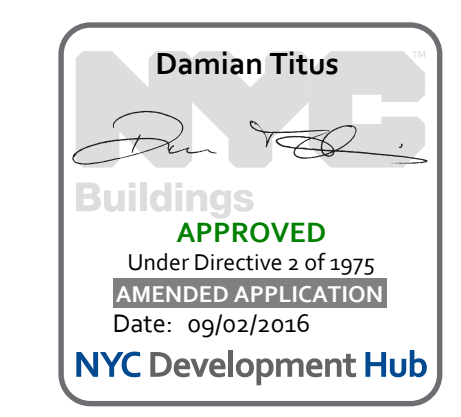

LEGEND

CULTURE SHED

545 West 30th Street
New York, New York 10001

OWNER
CULTURE SHED INC

ARCHITECTS
Diller Scofidio + Renfro Architects, DPC
801 West 28 Street #815
New York, New York 10001
T: 212.260.7871

rockwellgroup
8 Union St. West, 8th Fl
New York, New York 10003
T: 212.463.0334
F: 212.463.0335

STRUCTURAL ENGINEER
Thornton Tomasetti
51 Madison Avenue
New York, New York 10010
T: 917.891.7800
F: 917.891.7801

MEP ENGINEER
Jaros Baum & Bolles
80 Pine Street
New York, New York 10005
T: 212.530.8200
F: 212.260.0884

FACADE CONSULTANT
Thornton Tomasetti
51 Madison Avenue
New York, New York 10010
T: 917.891.7800
F: 917.891.7801

KINETICS ENGINEER
Hardsley & Hanover
1501 Broadway
New York, New York 10036
T: 212.844.1150
F: 212.397.0297

LIGHTING DESIGNER
Tilston Design Associates
40 Worth Street #190
New York, New York 10013
T: 212.675.7760

THEATRE PLANNING & DESIGN
Flahar Dachs Associates
22 West 19th Street
New York, New York 10011
T: 212.851.3000

LIFE SAFETY
Code Consultants, Inc.
215 West 40th St, 10th Fl
New York, New York 10018
T: 212.216.9586

ENERGY MODEL/LEED
Viridian
50 Washington Street
Norwalk, CT 06854
T: 203.298.1411

ACOUSTIC/AUDIO-VISUAL
Alucite
93 North Main Street
South Norwalk, CT 06854
T: 347.210.5540

VERTICAL TRANSPORTATION
Van Dusen & Associates
5 Regent Street, Suite 524
Livingston, NJ 07039
T: 973.984.9220

SPECIFICATIONS
Construction Specifications Inc.
PO Box 489
22 Tarent Road
Morganville, NJ 07071
T: 732.970.0700
F: 732.970.0700

SECURITY
Duchella Venter & Santoro
1020 Sherman Avenue
Hamden, CT 06514
T: 203.288.6490

WATERPROOFING
James R. Gairford AIA Consulting Architects PC
104 Regent Street
New York, NY 10001
T: 212.736.3544


FACADE MAINTENANCE
Etnak Engineering PLLC
186 Park Street
New York, NY 10005
T: 212.698.3000

BRANDING/GRAPHICS
24 Global Design Consultancy
180 York Street 15th Floor
New York, NY 10014
T: 212.647.1170


GENERAL NOTES

- For Shed components this drawing set is to be considered integral with the provided 3D models and may not be considered independently from the models. The contractor is to base their bid upon the information provided in both the drawings and 3D models. In matters of form and geometry the three dimensional model takes precedence in the instance of a discrepancy between drawing and model. In all other matters the contractor shall seek the opinion of the Architect and Structural Engineer to resolve the discrepancy.
- Geometry, dimensions and surface contouring, blending and intersection of sections illustrated in the structural drawings are provided for reference and generation of the structural arrangement and details only. The 3D model issued by the Architect defines the exterior surface and shall be adhered to for the final geometry. It is the responsibility of the Contractor to identify any discrepancies or ambiguities for discussion, resolution and direction from the Architect and Structural Engineer.
- Typical N/S wall node:
The geometry created by the intersecting main verticals and diagonals shall be in accordance with the 3D model and follow, as a minimum, the quality exhibited in the approved mock-up. The general concept is that edges flow smoothly and continuously between the straight edge of a diagonal through a curve to the adjacent edge of the vertical and the interlying surfaces between these edges are blended and contoured to define a smooth, uninterrupted transition.
- Typical Node Elsewhere:
The geometry created by the intersecting elements shall be in accordance with the 3D model. The level of quality is to be similar to the approved mock-up for the typical node. The general concept is that edges flow smoothly and continuously between the edge of one element to the corresponding edge of the adjacent element and the interlying surfaces between these edges are blended and contoured to define a smooth, uninterrupted transition.
- This drawing should be considered integral with the written Specifications issued along with the drawings and 3D models. Refer to the Advanced procurement Bid Issue Specifications Table of Contents.
- Structural steel cladding enclosing selected areas of the Shed (referred to as EWS-1c) shall be in the scope of the steel contractor for continuity with adjacent primary steel members. Criteria for tolerance and flatness to match that of the structural steel (see structural drawings & specifications). Plate configuration, including thickness, internal stiffeners and diaphragms, to be proposed by the fabricator and subject to agreement with the Architect and Engineer to provide an enclosure which satisfies the aesthetic and structural requirements. Refer to 3D model for extent of EWS-1c.
- Visually exposed HVAC supply and return ducts in the Shed, shown herein, are to be in the scope of the steel contractor to ensure continuity of appearance with primary steel. Criteria for tolerance and flatness to match that of the structural steel (see structural drawings & specifications). Plate configuration, including thickness, internal stiffeners and diaphragms, to be proposed by the fabricator and subject to agreement with the Architect and Engineer to provide an enclosure which satisfies the aesthetic and structural requirements. The mechanical ductwork carries its own self-weight and is not a primary load-bearing element. Internal stiffening may not create interference with airflow requirements of the duct. Refer to 3D model.

KEY PLAN

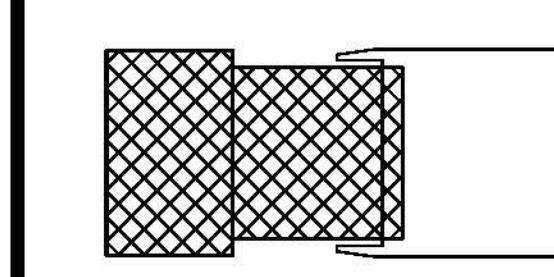

ISSUE	PRINTING	DATE	
61	50	DOB AMENDMENT 7	06.18.2016
46	33	DOB AMENDMENT 5	04.28.2016
13	3	DOB AMENDMENT 1	08.20.2015
10	4	100% CONSTRUCTION DOCUMENTS	03.18.2015
9	8	90% CONSTRUCTION DOCUMENTS	02.18.2015
6	6	PRELIMINARY DOB SUBMISSION	12.20.2014
2	2	90% CONSTRUCTION DOCUMENTS	06.19.2014
1	1	ADV. PROCUREMENT BID SET	06.18.2014

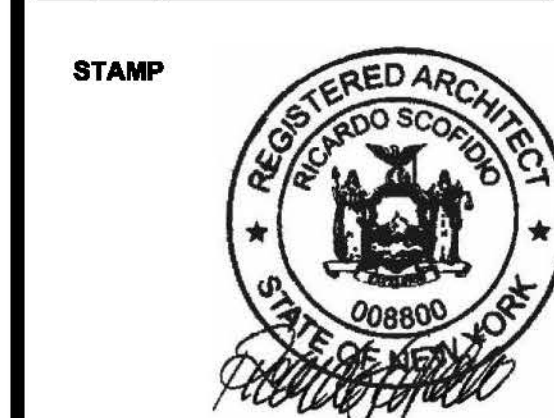

DRAWN BY: MO
CHECKED BY: CB
PROJECT NUMBER: 11017


TITLE: EXTERIOR ELEVATION - NORTH

SCALE: 1/8" = 1'-0"

DRAWING NO.: A-509.00

B-SCAN NO.: A-509.01


1 of 100

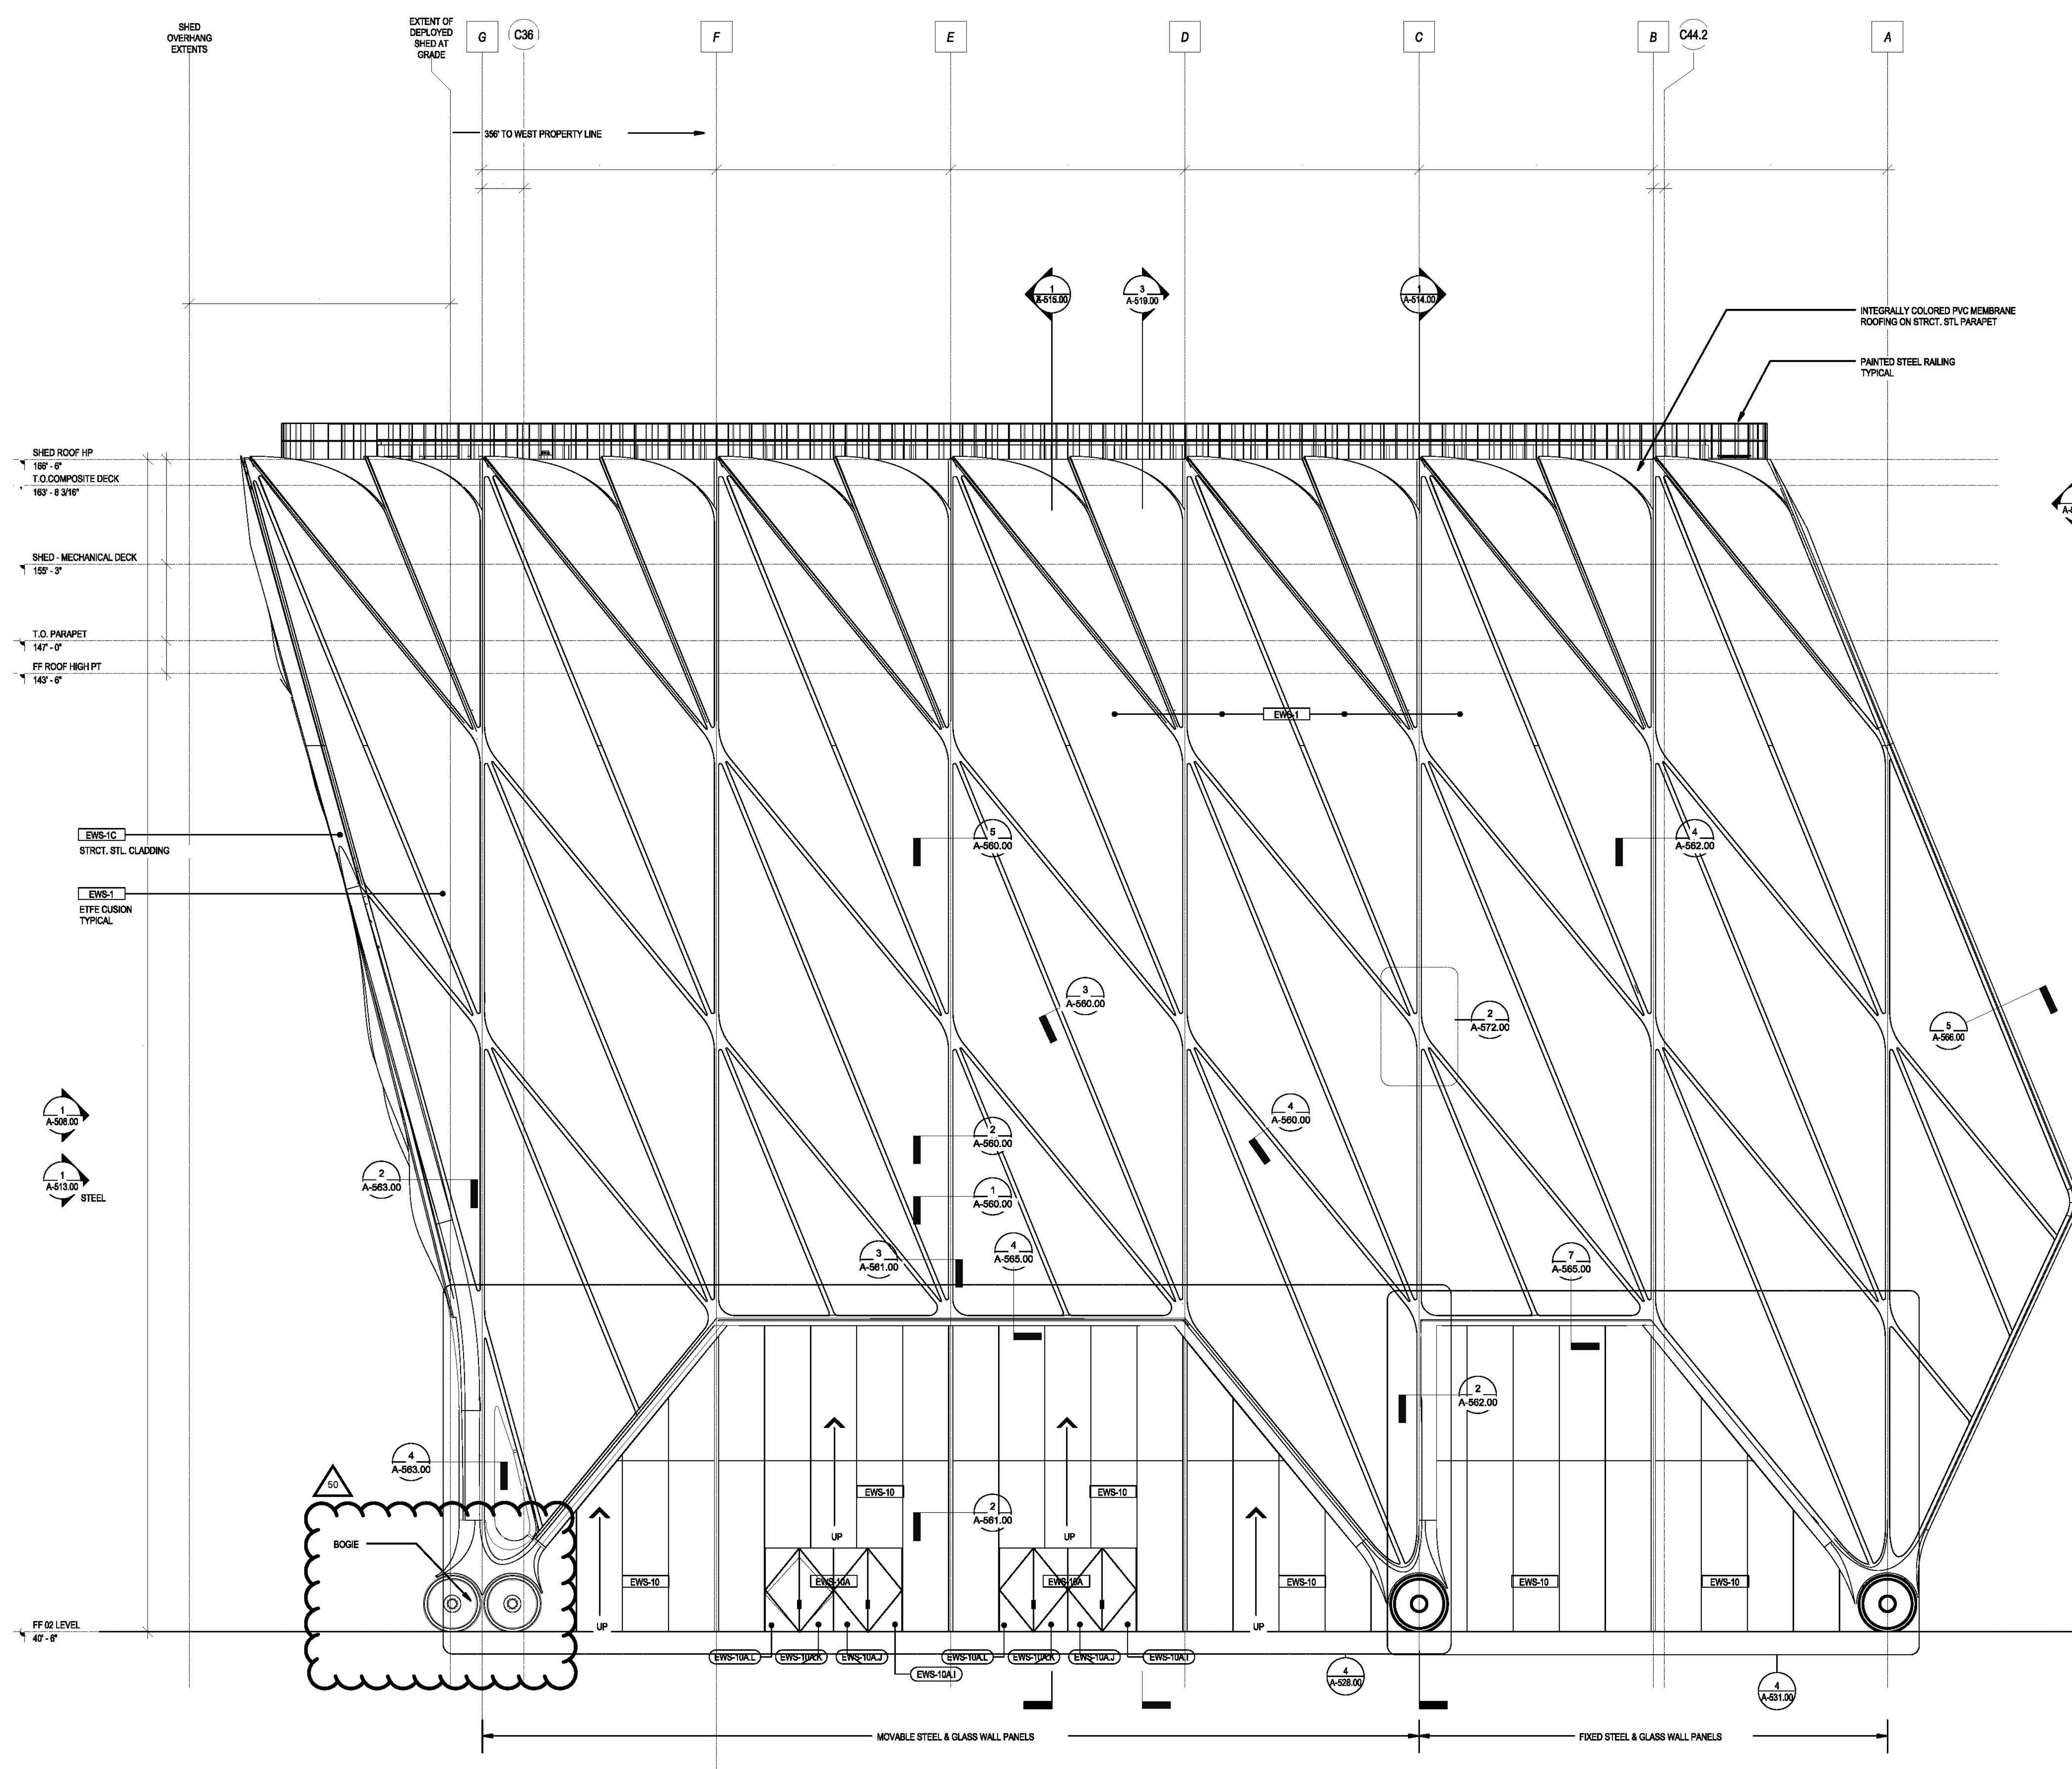

SHED ELEVATION - SOUTH STEEL


1

1/8" = 1'-0"

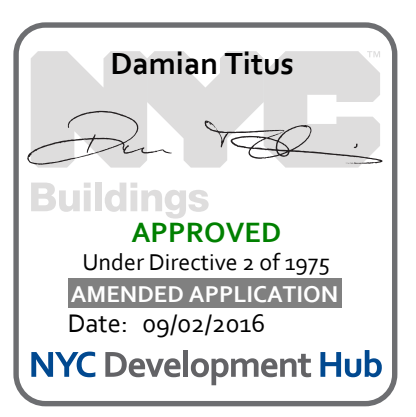

APPROVED
Under Directive 1 of 1995
ADMINISTRATIVE REGULATION
Date: 06/18/2016
NYC Development Hub

KEY PLAN

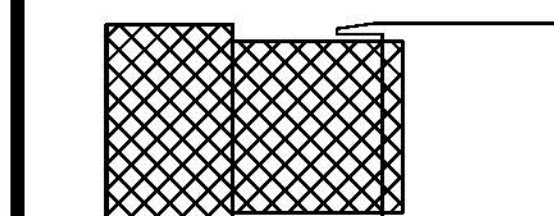

ISSUE/PRINTING DATE

ISSUE	PRINTING	DATE
61	50	DOB AMENDMENT 7 06.18.2016
46	33	DOB AMENDMENT 5 04.28.2016
13		DOB AMENDMENT 1 08.03.2015
10	4	100% CONSTRUCTION DOCUMENTS 03.18.2015
9		90% CONSTRUCTION DOCUMENTS 02.18.2015
6		PRELIMINARY DOB SUBMISSION 12.02.2014
2		90% CONSTRUCTION DOCUMENTS 06.18.2014
1		ADV. PROCUREMENT BID SET 06.18.2014

STAMP



DRAWN BY
MO

CHECKED BY
CT

PROJECT NUMBER
11017

TITLE
Elevation
Shed Steel North

SCALE: 1/8" = 1'-0"

DRAWING NO.
A-512.00


B-SCAN NO.

A-512.01

1 of 100

GENERAL NOTES


- For Shed components this drawing set is to be considered integral with the provided 3D models and may not be considered independently from the models. The contractor is to base their bid upon the information provided in both the drawings and 3D models. In matters of form and geometry the three dimensional model takes precedence in the instance of a discrepancy between drawing and model. In all other matters the contractor shall seek the opinion of the Architect and Structural Engineer to resolve the discrepancy.
- Geometry, dimensions and surface contouring, blending and intersection of sections illustrated in the structural drawings are provided for reference and generation of the structural arrangement and details only. The 3D model issued by the Architect defines the exterior surface and shall be adhered to for the final geometry. It is the responsibility of the Contractor to identify any discrepancies or ambiguities for discussion, resolution and direction from the Architect and Structural Engineer.
- Typical N/S wall node:
The geometry created by the intersecting main verticals and diagonals shall be in accordance with the 3D model and follow, as a minimum, the quality exhibited in the approved mock-up. The general concept is that edges flow smoothly and continuously between the straight edge of a diagonal through a curve to the adjacent edge of the vertical and the interlying surfaces between these edges are blended and contoured to define a smooth, uninterrupted transition.
- Typical Node Elsewhere:
The geometry created by the intersecting elements shall be in accordance with the 3D model. The level of quality is to be similar to the approved mock-up for the typical node. The general concept is that edges flow smoothly and continuously between the edge of one element to the corresponding edge of the adjacent element and the interlying surfaces between these edges are blended and contoured to define a smooth, uninterrupted transition.
- This drawing should be considered integral with the written Specifications issued along with the drawings and 3D models. Refer to the Advanced procurement Bid Issue Specifications Table of Contents.
- Structural steel cladding enclosing selected areas of the Shed (referred to as EWS-1c) shall be in the scope of the steel contractor for continuity with adjacent primary steel members. Criteria for tolerance and flatness to match that of the structural steel (see structural drawings & specifications). Plate configuration, including thickness, internal stiffeners and diaphragms, to be proposed by the fabricator and subject to agreement with the Architect and Engineer to provide an enclosure which satisfies the aesthetic and structural requirements. Refer to 3D model for extent of EWS-1c.
- Visually exposed HVAC supply and return ducts in the Shed, shown herein, are to be in the scope of the steel contractor to ensure continuity of appearance with primary steel. Criteria for tolerance and flatness to match that of the structural steel (see structural drawings & specifications). Plate configuration, including thickness, internal stiffeners and diaphragms, to be proposed by the fabricator and subject to agreement with the Architect and Engineer to provide an enclosure which satisfies the aesthetic and structural requirements. The mechanical ductwork carries its own self-weight and is not a primary load-bearing element. Internal stiffening may not create interference with airflow requirements of the duct. Refer to 3D model.

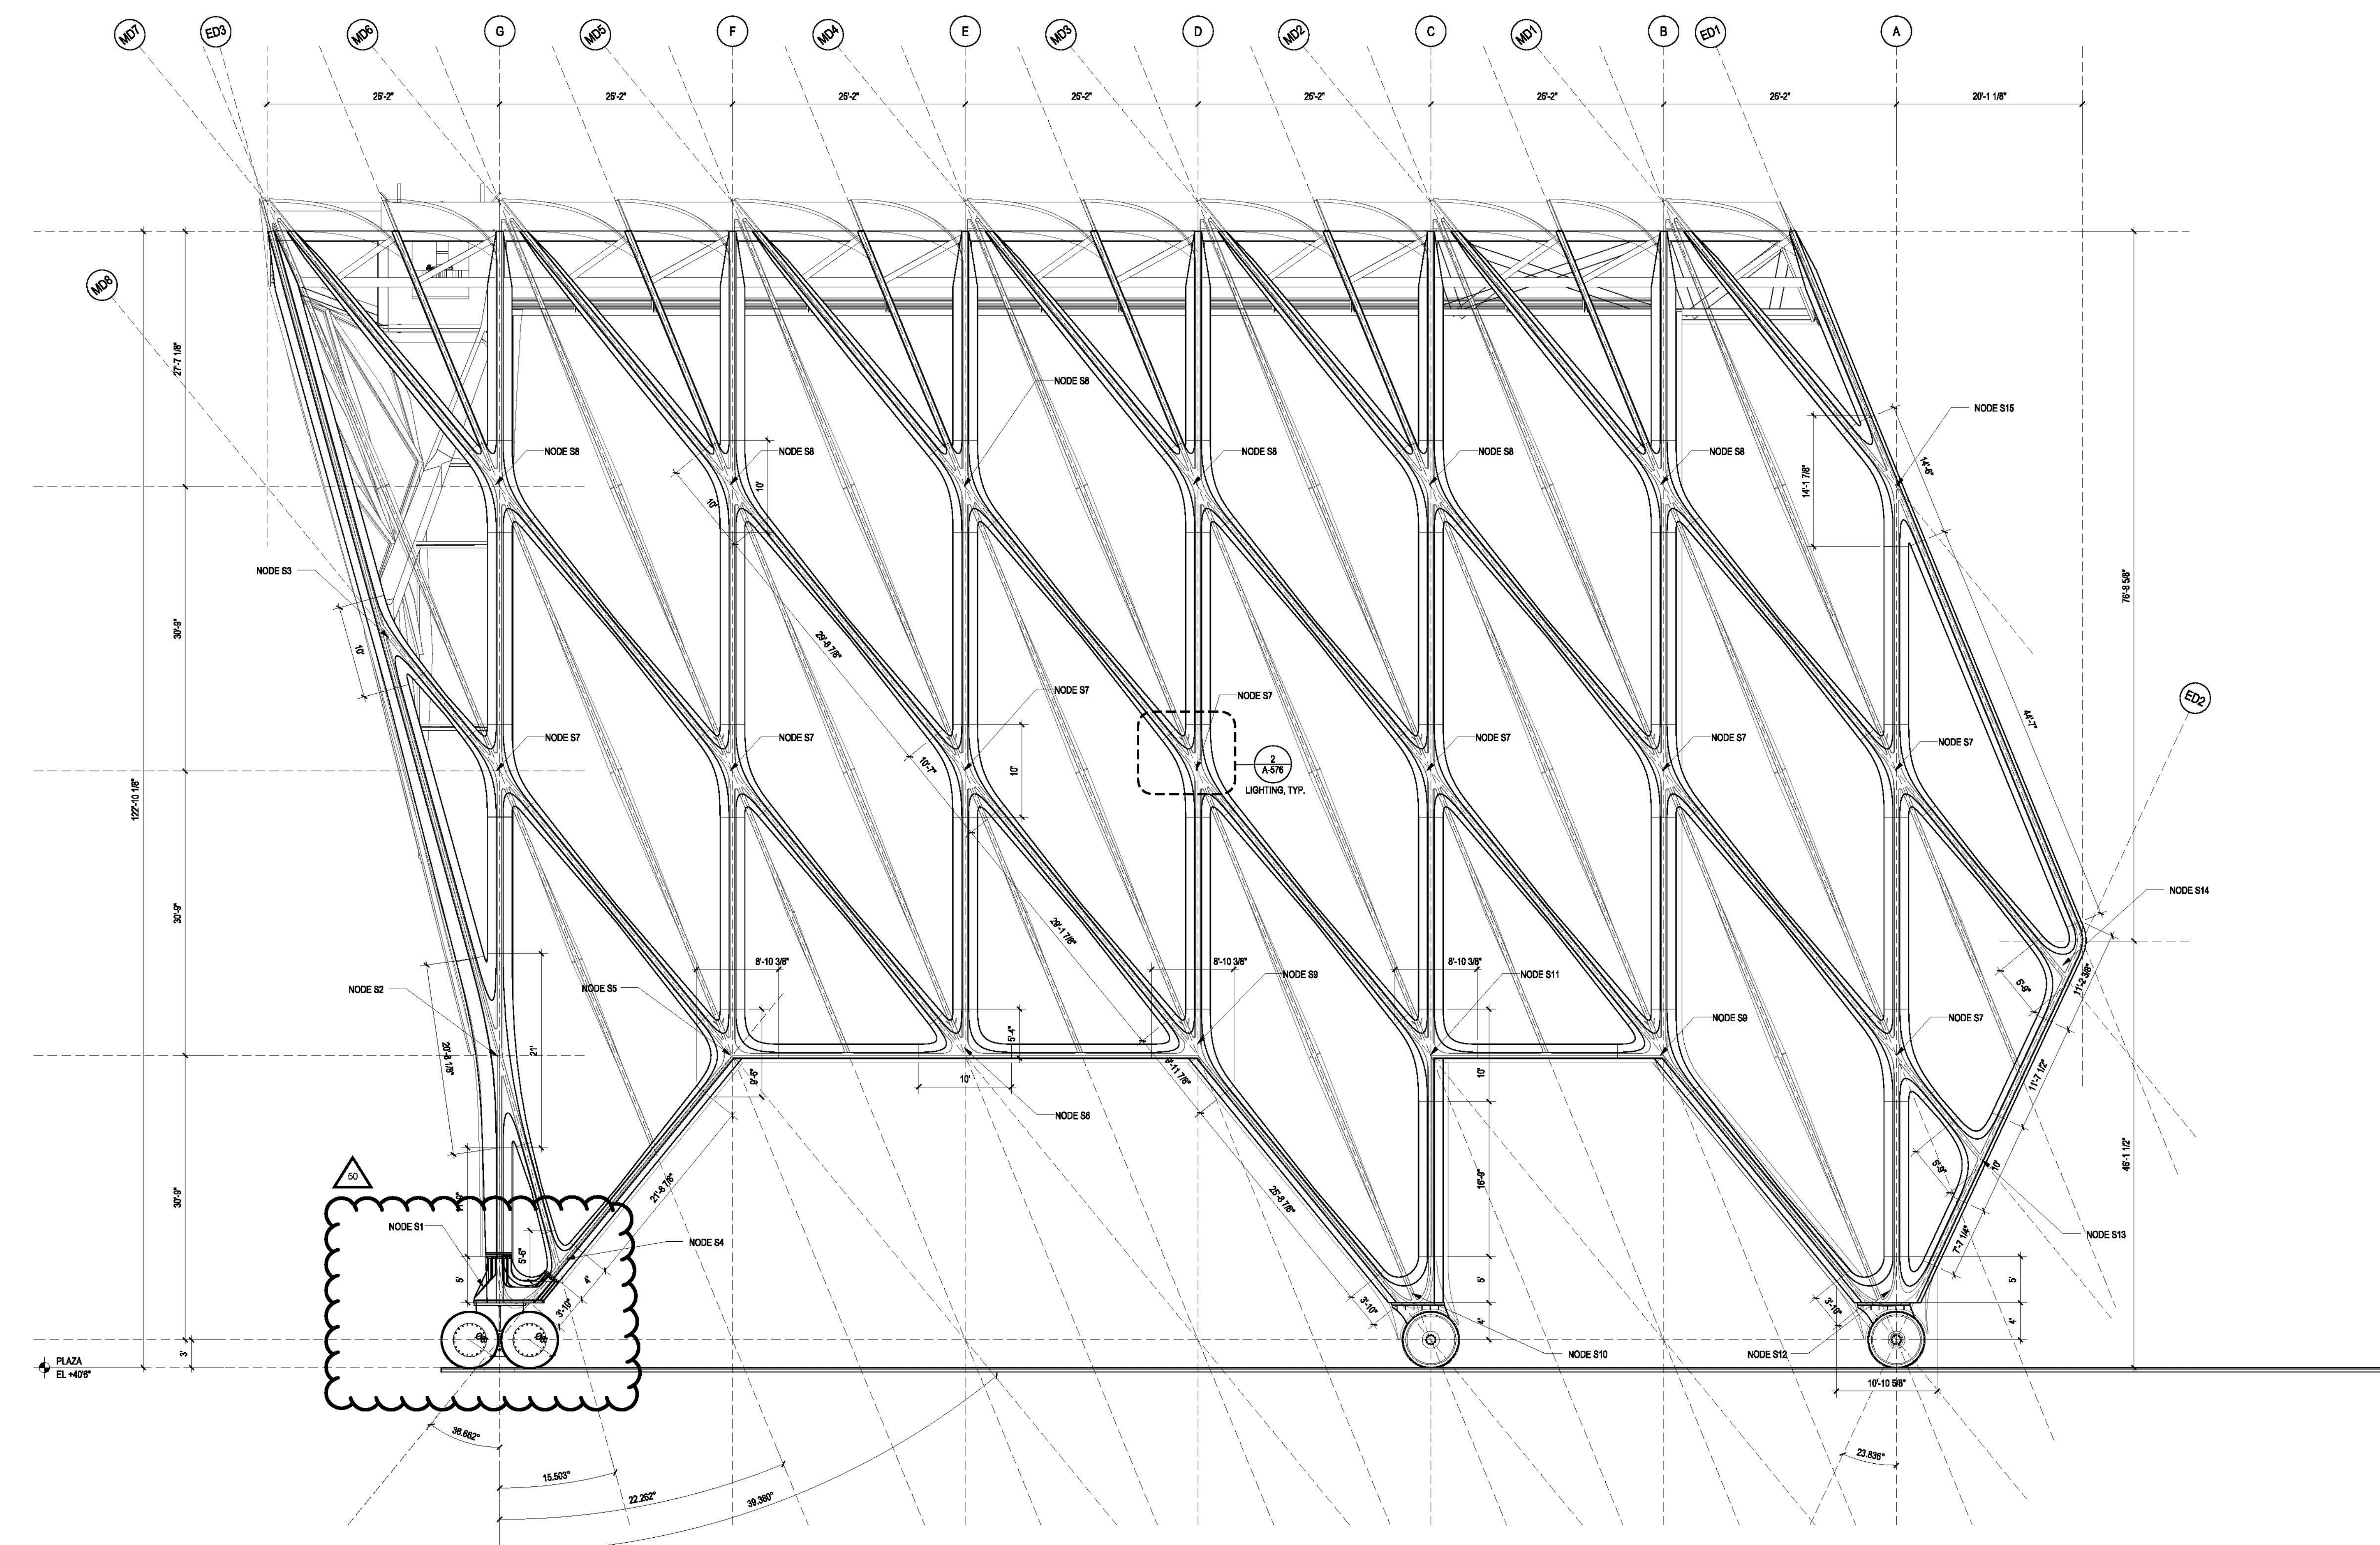

NODE SCHEDULE

TYPE	QUANTITY
NODE S1	1
NODE S2	1
NODE S3	1
NODE S4	1
NODE S5	1
NODE S6	1
NODE S7	8
NODE S8	8
NODE S9	2
NODE S10	1
NODE S11	1
NODE S12	1
NODE S13	1
NODE S14	1
NODE S15	1
TOTAL	28


REFER TO STRUCTURAL DRAWINGS FOR PLATE THICKNESS AND MEMBER SIZING

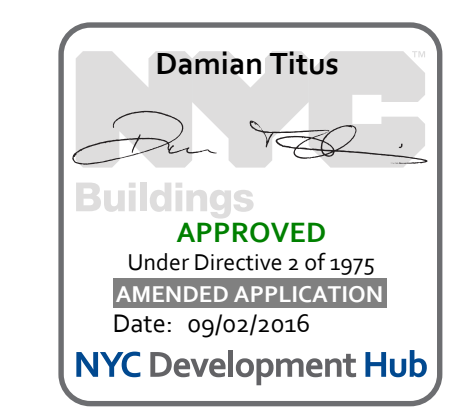

GENERAL NOTES


- For Shed components this drawing set is to be considered integral with the provided 3D models and may not be considered independently from the models. The contractor is to base their bid upon the information provided in both the drawings and 3D models. In matters of form and geometry the three dimensional model takes precedence in the instance of a discrepancy between drawing and model. In all other matters the contractor shall seek the opinion of the Architect and Structural Engineer to resolve the discrepancy.
- Geometry, dimensions and surface contouring, blending and intersection of sections illustrated in the structural drawings are provided for reference and generation of the structural arrangement and details only. The 3D model issued by the Architect defines the exterior surface and shall be adhered to for the final geometry. It is the responsibility of the Contractor to identify any discrepancies or ambiguities for discussion, resolution and direction from the Architect and Structural Engineer.
- Typical N/S wall node:
The geometry created by the intersecting main verticals and diagonals shall be in accordance with the 3D model and follow, as a minimum, the quality exhibited in the approved mock-up. The general concept is that edges flow smoothly and continuously between the straight edge of a diagonal through a curve to the adjacent edge of the vertical and the interlying surfaces between these edges are blended and contoured to define a smooth, uninterrupted transition.
- Typical Node Elsewhere:
The geometry created by the intersecting elements shall be in accordance with the 3D model. The level of quality is to be similar to the approved mock-up for the typical node. The general concept is that edges flow smoothly and continuously between the edge of one element to the corresponding edge of the adjacent element and the interlying surfaces between these edges are blended and contoured to define a smooth, uninterrupted transition.
- This drawing should be considered integral with the written Specifications issued along with the drawings and 3D models. Refer to the Advanced procurement Bid Issue Specifications Table of Contents.
- Structural steel cladding enclosing selected areas of the Shed (referred to as EWS-1c) shall be in the scope of the steel contractor for continuity with adjacent primary steel members. Criteria for tolerance and flatness to match that of the structural steel (see structural drawings & specifications). Plate configuration, including thickness, internal stiffeners and diaphragms, to be proposed by the fabricator and subject to agreement with the Architect and Engineer to provide an enclosure which satisfies the aesthetic and structural requirements. Refer to 3D model for extent of EWS-1c.
- Visually exposed HVAC supply and return ducts in the Shed, shown herein, are to be in the scope of the steel contractor to ensure continuity of appearance with primary steel. Criteria for tolerance and flatness to match that of the structural steel (see structural drawings & specifications). Plate configuration, including thickness, internal stiffeners and diaphragms, to be proposed by the fabricator and subject to agreement with the Architect and Engineer to provide an enclosure which satisfies the aesthetic and structural requirements. The mechanical ductwork carries its own self-weight and is not a primary load-bearing element. Internal stiffening may not create interference with airflow requirements of the duct. Refer to 3D model.

KEY PLAN

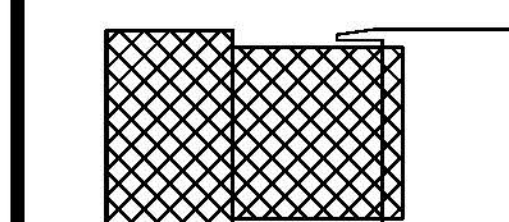

ISSUE/PRINTING DATE

ISSUE	PRINTING	DATE
61	50	DOB AMENDMENT 7 06.18.2016
46	33	DOB AMENDMENT 5 04.28.2016
13		DOB AMENDMENT 1 08.03.2015
10	4	100% CONSTRUCTION DOCUMENTS 03.18.2015
9		90% CONSTRUCTION DOCUMENTS 02.18.2015
6		PRELIMINARY DOB SUBMISSION 12.02.2014
2		90% CONSTRUCTION DOCUMENTS 08.19.2014
1		ADV. PROCUREMENT BID SET 06.18.2014

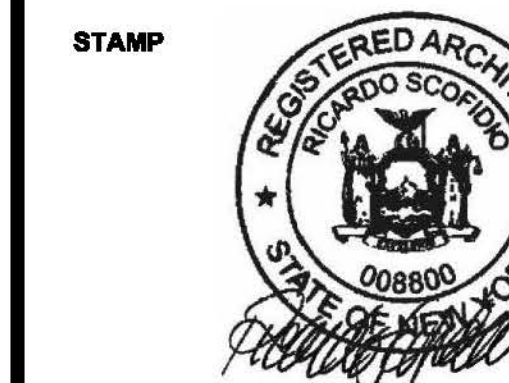

DRAWN BY
MO
11017

CHECKED BY
CS
PROJECT NUMBER
11017


TITLE
Elevation
Shed Steel East

SCALE: 1/8" = 1'-0"

DRAWING NO.
A-513.00

B-SCAN NO.
A-513.01


1 of 100

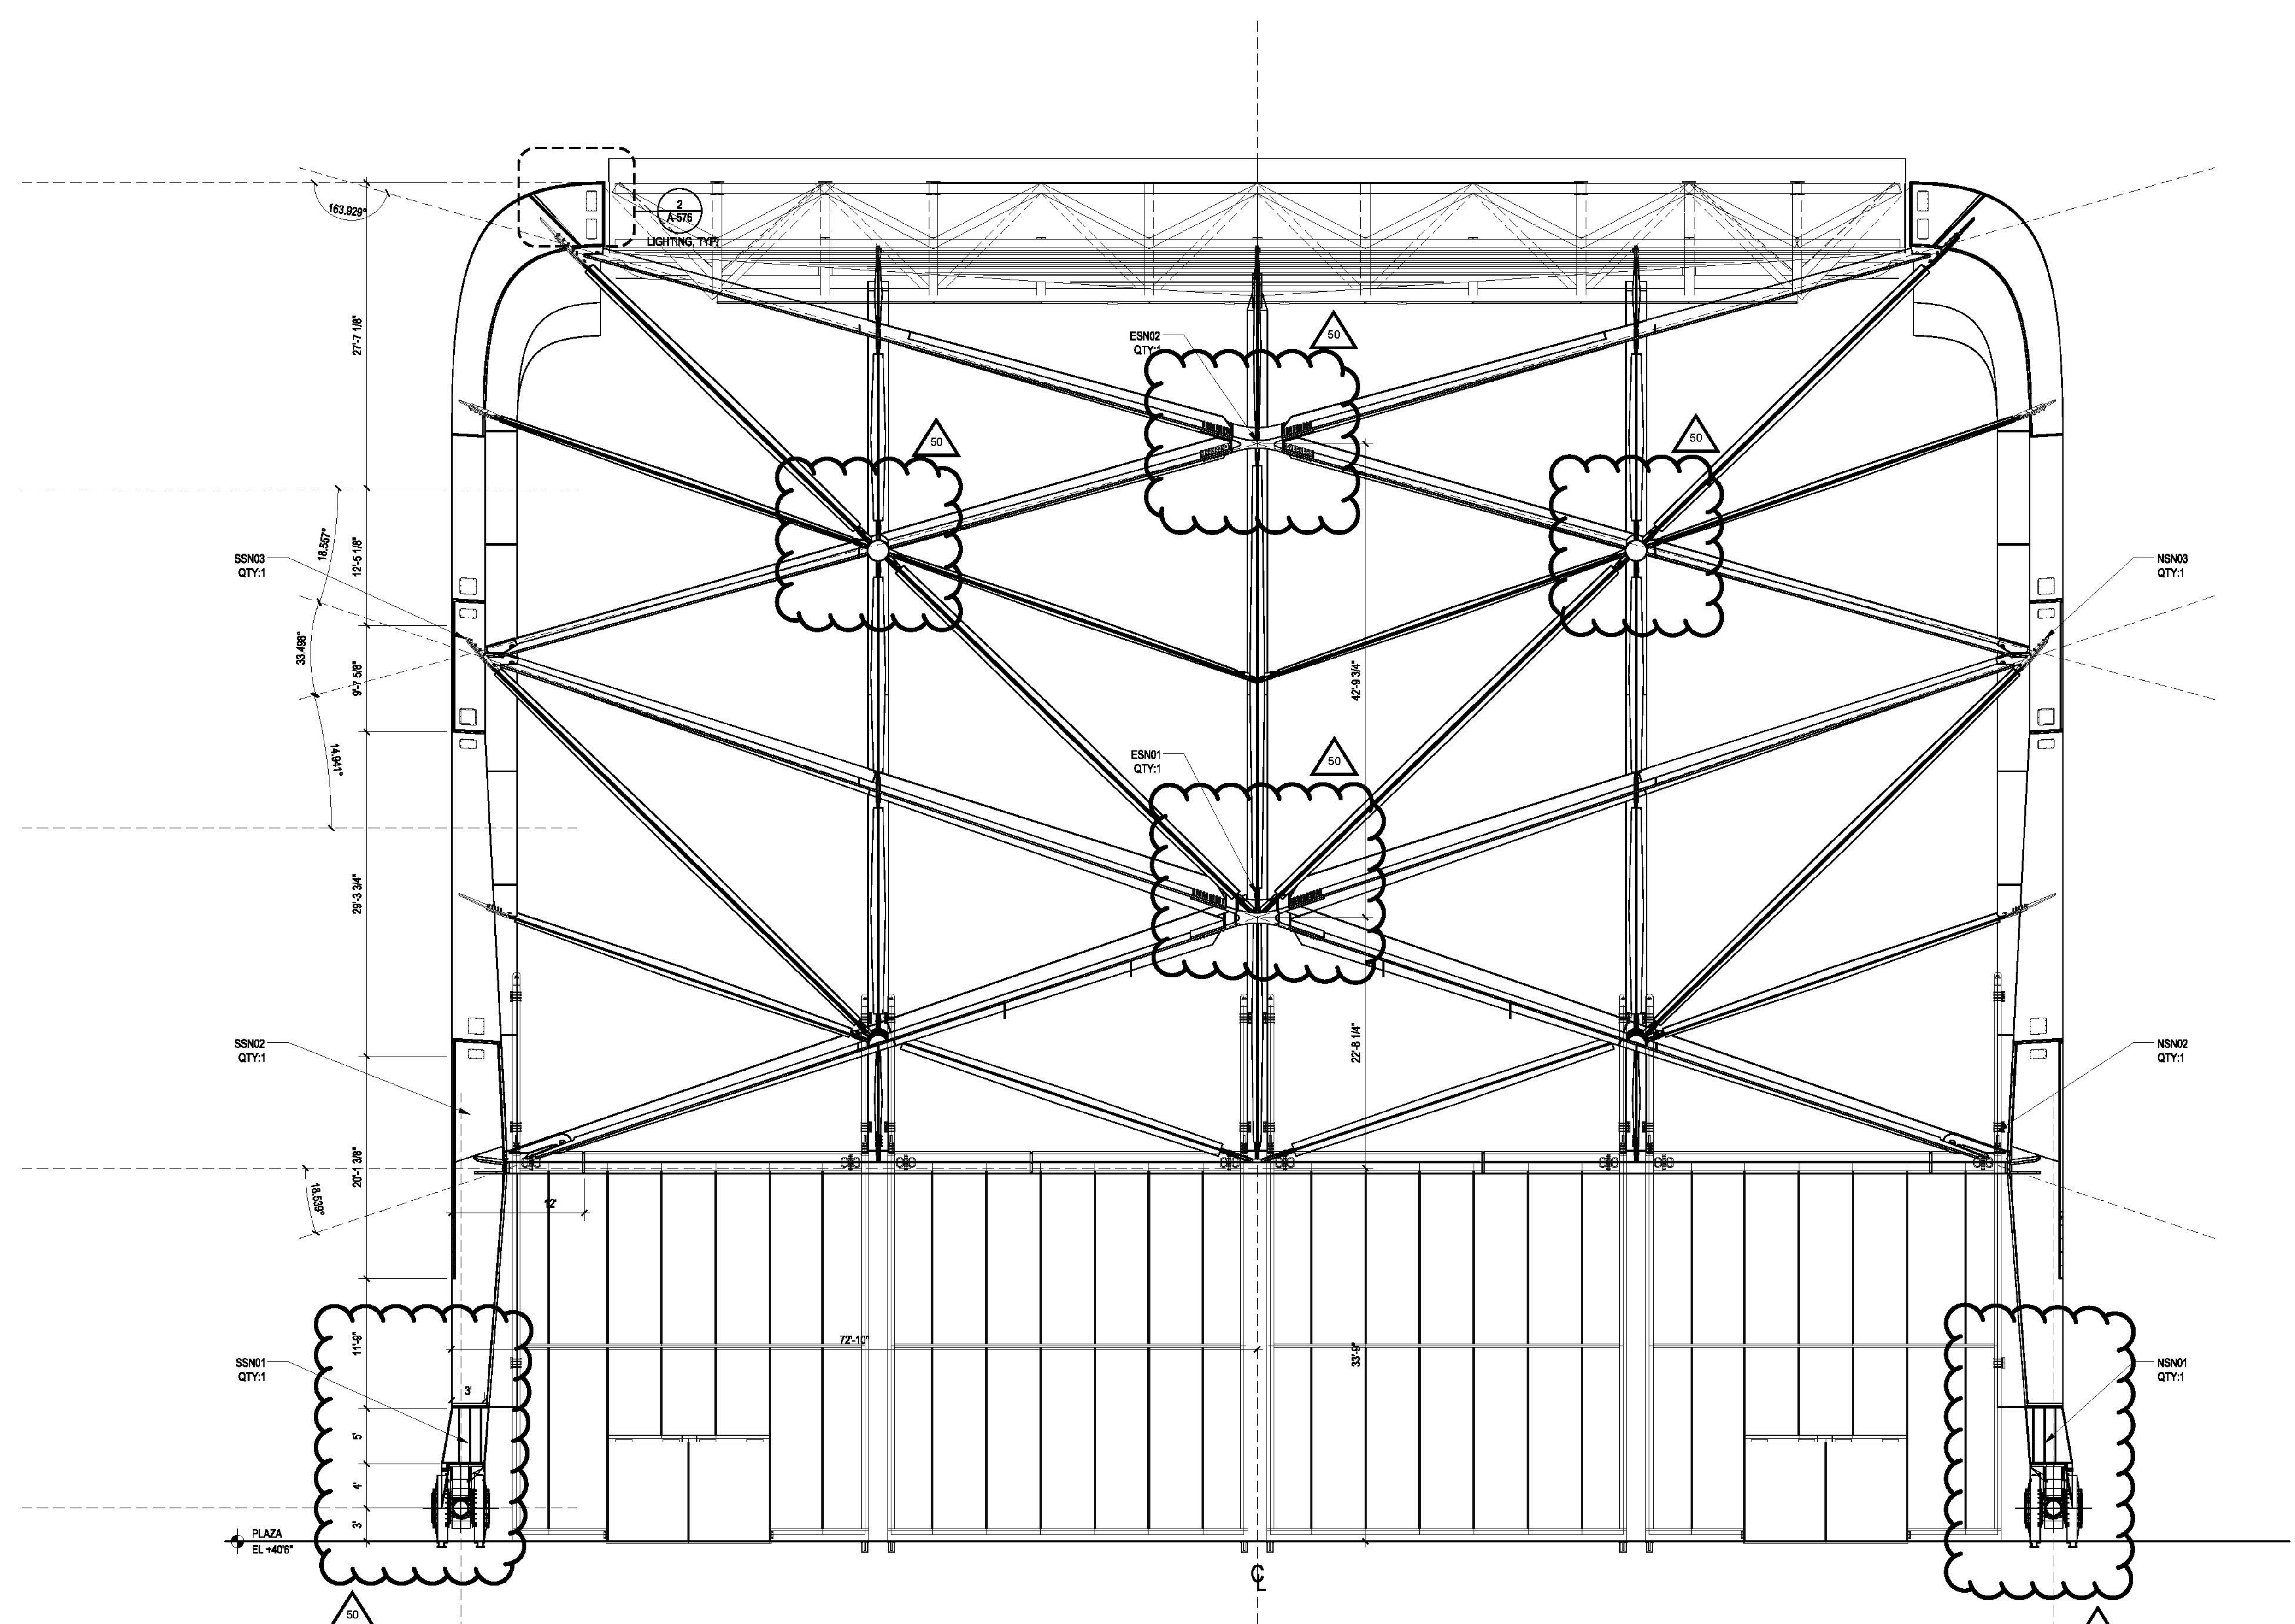


NODE SCHEDULE

TYPE	QUANTITY
NODE E1	1
NODE E2	1
LOCAL	2

REFER TO STRUCTURAL DRAWINGS FOR PLATE THICKNESS AND MEMBER SIZING


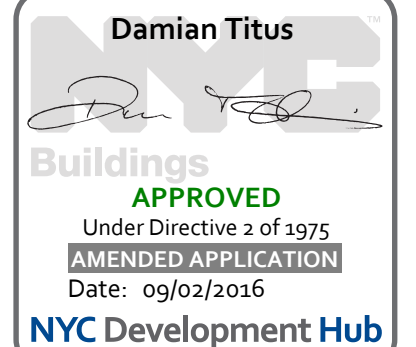


ISSUE	PRINTING	DATE
61	50	DOB AMENDMENT 7
44	39	DOB AMENDMENT 5
13	1	DOB AMENDMENT 1
10	4	100% CONSTRUCTION DOCUMENTS
9	4	90% CONSTRUCTION DOCUMENTS
6	4	80% CONSTRUCTION DOCUMENTS
1	1	PRELIMINARY DOCS/REVISIONS
1	1	ADV. PROCUREMENT BID SET

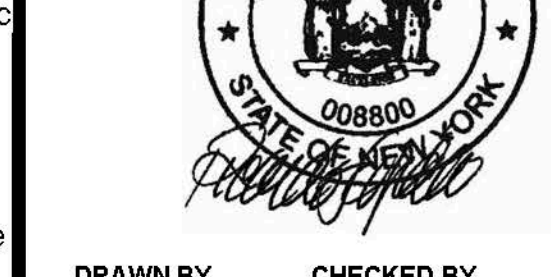

GENERAL NOTES

- For Shed components this drawing set is to be considered integral with the provided 3D models and may not be considered independently from the models. The contractor is to base their bid upon the information provided in both the drawings and 3D models. In matters of form and geometry the three dimensional model takes precedence in the instance of a discrepancy between drawing and model. In all other matters the contractor shall seek the opinion of the Architect and Structural Engineer to resolve the discrepancy.
- Geometry, dimensions and surface contouring, blending and intersection of sections illustrated in the structural drawings are provided for reference and generation of the structural arrangement and details only. The 3D model issued by the Architect defines the exterior surface and shall be adhered to for the final geometry. It is the responsibility of the Contractor to identify any discrepancies or ambiguities for discussion, resolution and direction from the Architect and Structural Engineer.
- Typical N/S wall node: The geometry created by the intersecting main verticals and diagonals shall be in accordance with the 3D model and follow, as a minimum, the quality exhibited in the approved mock-up. The general concept is that edges flow smoothly and continuously between the straight edge of a diagonal through a curve to the adjacent edge of the vertical and the interlying surfaces between these edges are blended and contoured to define a smooth, uninterrupted transition.
- Typical Node Elsewhere: The geometry created by the intersecting elements shall be in accordance with the 3D model. The level of quality is to be similar to the approved mock-up for the typical node. The general concept is that edges flow smoothly and continuously between the edge of one element to the corresponding edge of the adjacent element and the interlying surfaces between these edges are blended and contoured to define a smooth, uninterrupted transition.
- This drawing should be considered integral with the written Specifications issued along with the drawings and 3D models. Refer to the Advanced procurement Bid Issue Specifications Table of Contents.
- Structural steel cladding enclosing selected areas of the Shed (referred to as EWS-1c) shall be in the scope of the steel contractor for continuity with adjacent primary steel members. Criteria for tolerance and fitness to match that of the structural steel (see structural drawings & specifications). Plate configuration, including thickness, internal stiffeners and diaphragms, to be proposed by the fabricator and subject to agreement with the Architect and Engineer to provide an enclosure which satisfies the aesthetic and structural requirements. Refer to 3D model for extent of EWS-1c.
- Visually exposed HVAC supply and return ducts in the Shed, shown herein, are to be in the scope of the steel contractor to ensure continuity of appearance with primary steel. Criteria for tolerance and fitness to match that of the structural steel (see structural drawings & specifications). Plate configuration, including thickness, internal stiffeners and diaphragms, to be proposed by the fabricator and subject to agreement with the Architect and Engineer to provide an enclosure which satisfies the aesthetic and structural requirements. The mechanical ductwork carries its own self-weight and is not a primary load-bearing element. Internal stiffening may not create interference with airflow requirements of the duct. Refer to 3D model.

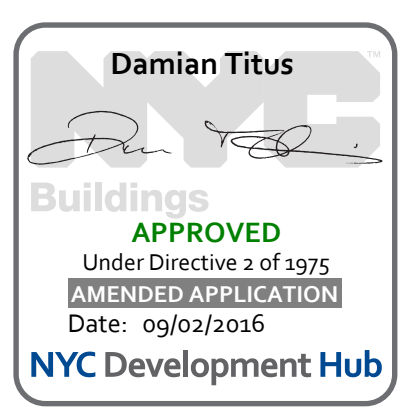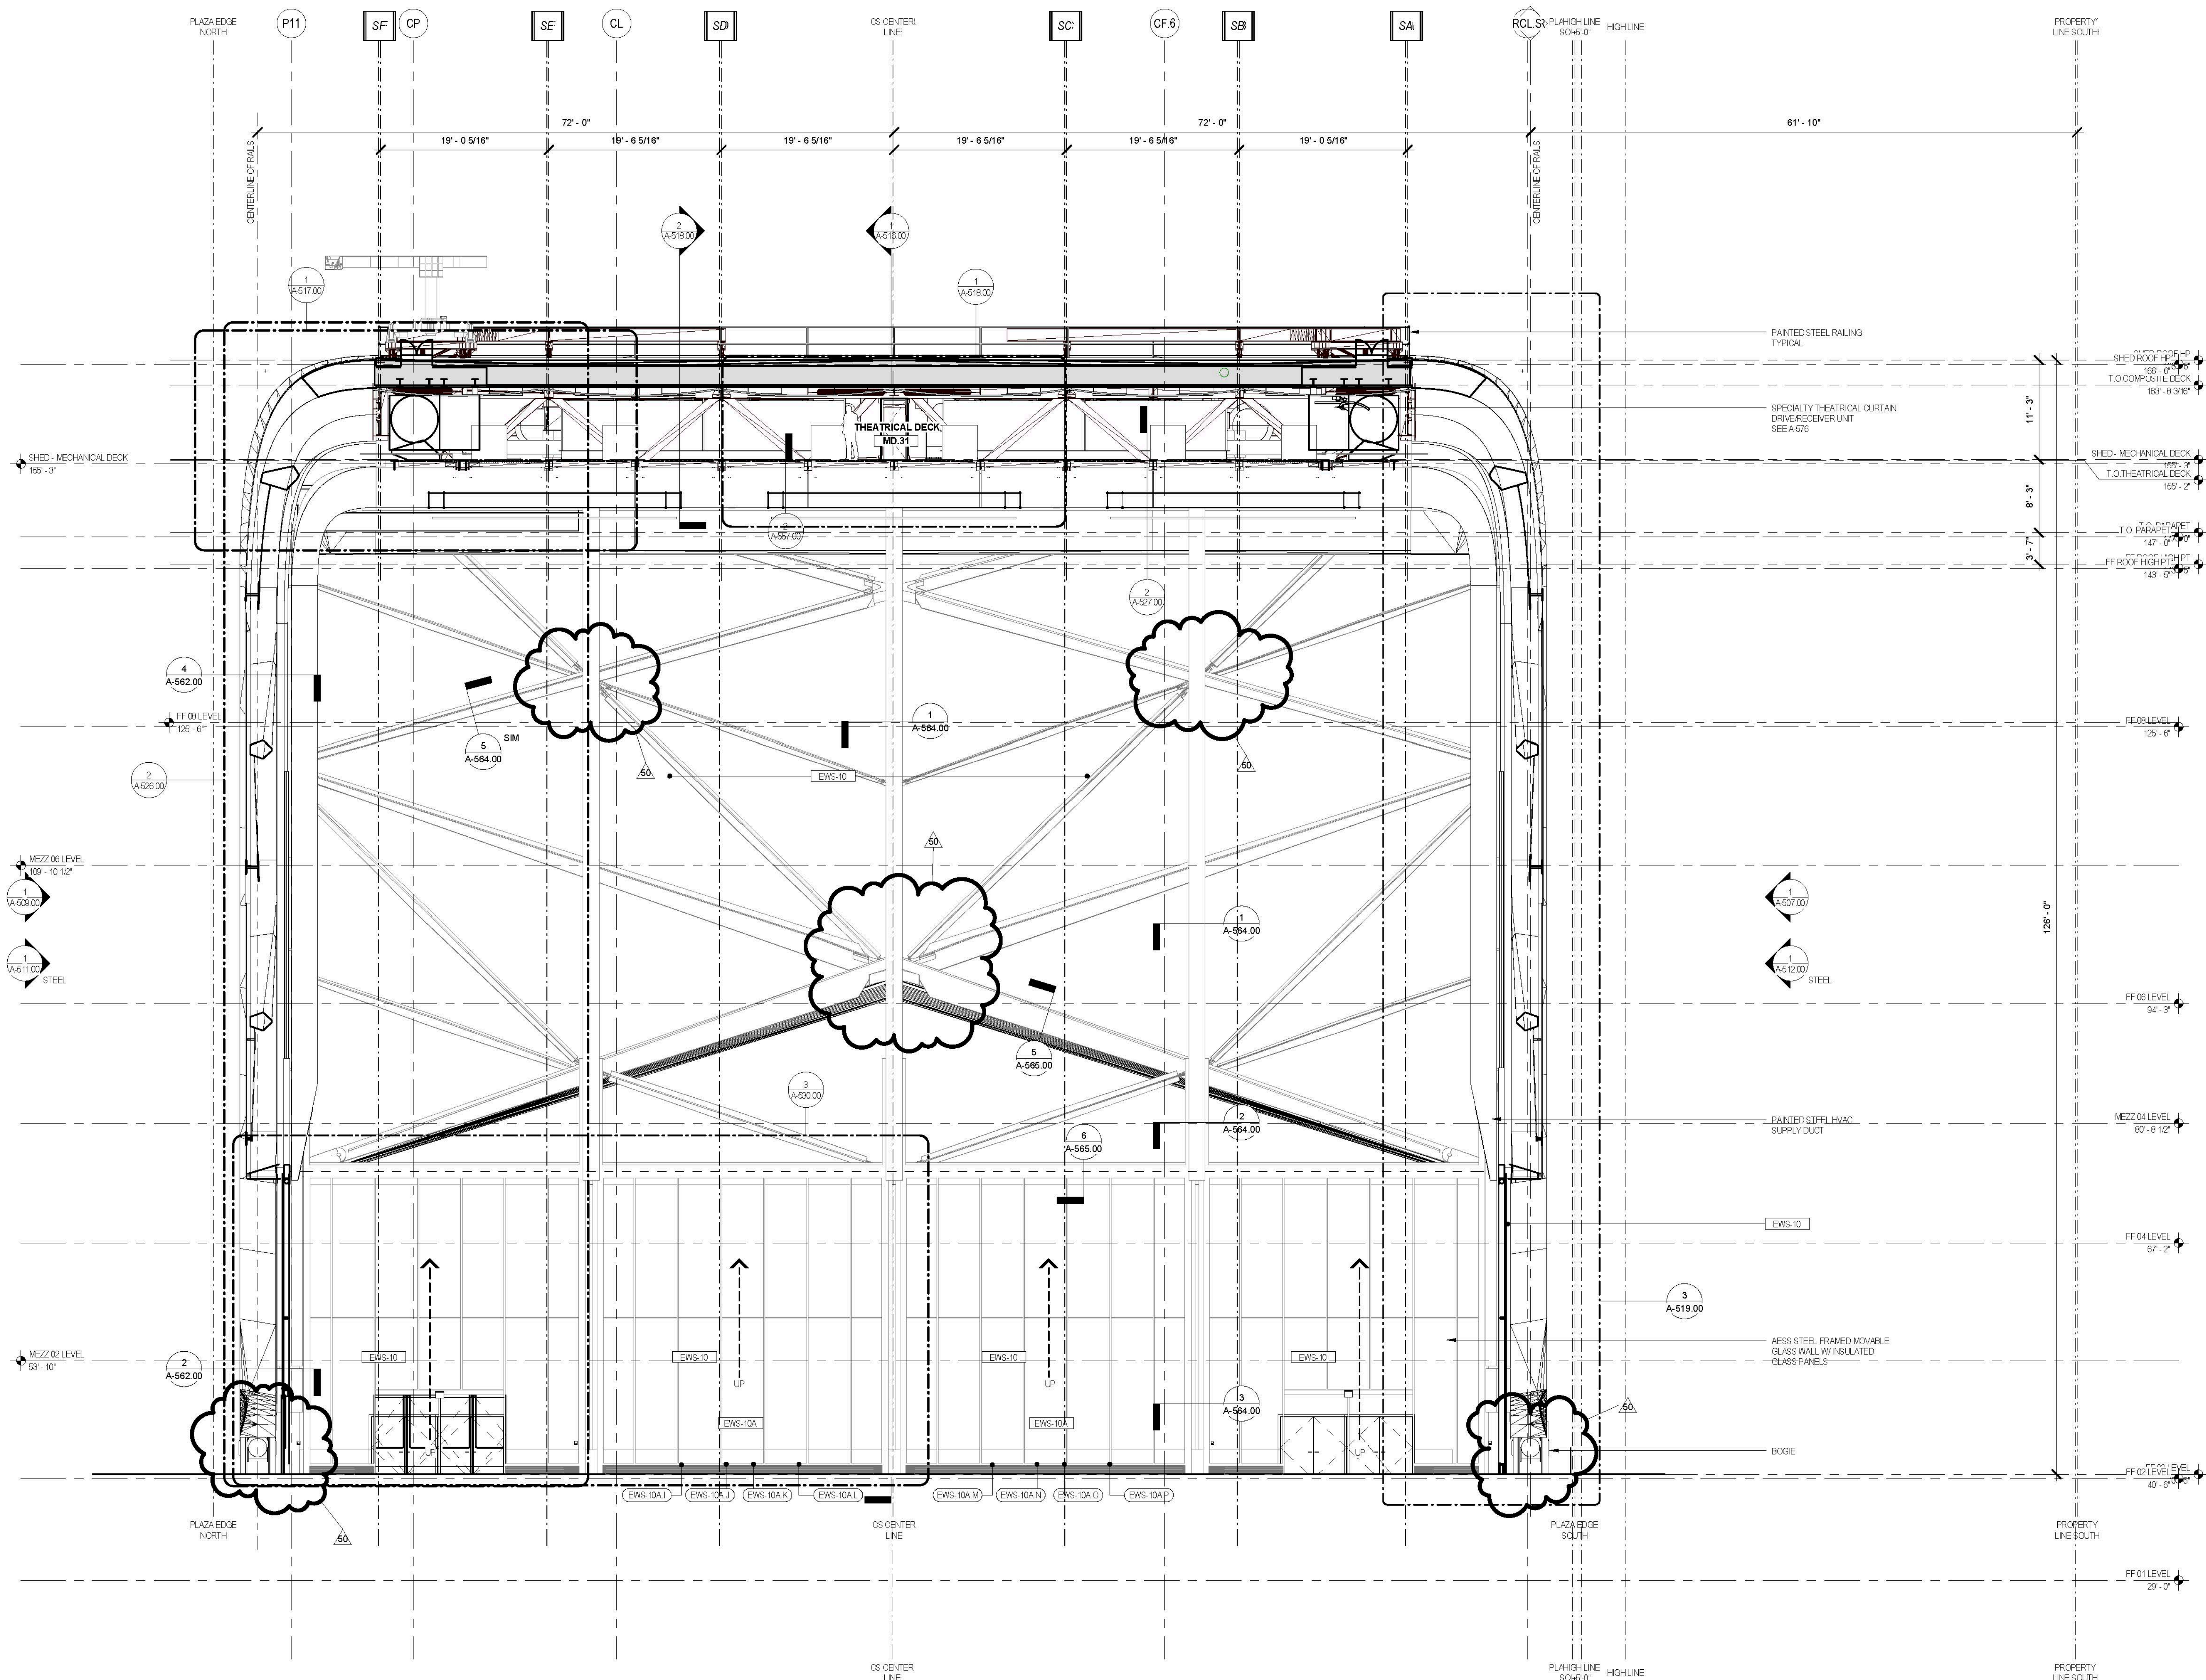

LEGEND

- ARCHITECTS**
Diller Scofidio + Renfro Architects, D.P.C.
601 West 28 Street #815
New York, New York 10001
T: 212.463.0334
F: 212.463.0335
- STRUCTURAL ENGINEER**
Thornton Tomasetti
51 Madison Avenue
New York, New York 10010
T: 917.661.7800
F: 917.661.7861
- MEP ENGINEER**
Janus Baum & Bolles
63 Pine Street
New York, New York 10005
T: 212.530.9300
F: 212.269.9884
- FACADE CONSULTANT**
Thornton Tomasetti
51 Madison Avenue
New York, New York 10010
T: 917.661.7800
F: 917.661.7861
- KINETICS ENGINEER**
Hardisty & Hanover
1501 Broadway
New York, New York 10036
T: 212.844.1150
F: 212.391.0287
- LIGHTING DESIGNER**
Tilston Design Associates
40 Ninth Street #180
New York, New York 10013
T: 212.875.7760
- THEATRE PLANNING & DESIGN**
Pruitt Duchs Associates
22 West 16th Street
New York, New York 10011
T: 212.875.7760
- LIFE SAFETY**
Code Consultants, Inc.
215 West 40th St, 16th Flr
New York, New York 10018
T: 212.216.9596
- ENERGY MODEL/LEED**
Vridan
50 Washington Street
Norwalk, CT 06854
T: 203.298.1411
- ACOUSTIC/AUDIO-VISUAL**
Alvarez
93 North Main Street
South Norwalk, CT 06854
T: 347.210.5540
- VERTICAL TRANSPORTATION**
Van Dusen & Associates
5 Regent Street, Suite 524
Livingston, NJ 07039
T: 973.984.9220
- SPECIFICATIONS**
Construction Specifications Inc.
PO Box 488
27 Tenney Road
Morgantown, NJ 07951
T: 732.870.0700
F: 732.870.0700
- SECURITY**
Duchella Venter & Santoro
1020 Sherman Avenue
Hamden, CT 06514
T: 203.288.6490
- WATERPROOFING**
James R. Gierfort AIA Consulting Architects PC
104 West 27th Street
New York, NY 10001
T: 212.736.3344
- FACADE MAINTENANCE**
Etek Engineering PLLC
196 Ave. Street
New York, NY 10005
T: 212.898.3000
- BRANDING/GRAPHICS**
24 Global Design Consultancy
180 Varck Street 15th Floor
New York, NY 10014
T: 212.647.1170

GENERAL NOTES

- For Shed components this drawing set is to be considered integral with the provided 3D models and may not be considered independently from the models. The contractor is to base their bid upon the information provided in both the drawings and 3D models. In matters of form and geometry the three dimensional model takes precedence in the instance of a discrepancy between drawing and model. In all other matters the contractor shall seek the opinion of the Architect and Structural Engineer to resolve the discrepancy.
- Geometry, dimensions and surface contouring, blending and intersection of sections illustrated in the structural drawings are provided for reference and generation of the structural arrangement and details only. The 3D model issued by the Architect defines the exterior surface and shall be adhered to for the final geometry. It is the responsibility of the Contractor to identify any discrepancies or ambiguities for discussion, resolution and direction from the Architect and Structural Engineer.
- Typical N/S wall node:
The geometry created by the intersecting main verticals and diagonals shall be in accordance with the 3D model and follow, as a minimum, the quality exhibited in the approved mock-up. The general concept is that edges flow smoothly and continuously between the straight edge of a diagonal through a curve to the adjacent edge of the vertical and the interlying surfaces between these edges are blended and contoured to define a smooth, uninterrupted transition.
- Typical Node Elsewhere:
The geometry created by the intersecting elements shall be in accordance with the 3D model. The level of quality is to be similar to the approved mock-up for the typical node. The general concept is that edges flow smoothly and continuously between the edge of one element to the corresponding edge of the adjacent element and the interlying surfaces between these edges are blended and contoured to define a smooth, uninterrupted transition.
- This drawing should be considered integral with the written Specifications issued along with the drawings and 3D models. Refer to the Advanced procurement Bid Issue Specifications Table of Contents.
- Structural steel cladding enclosing selected areas of the Shed (referred to as EWS-1c) shall be in the scope of the steel contractor for continuity with adjacent primary steel members. Criteria for tolerance and flatness to match that of the structural steel (see structural drawings & specifications). Plate configuration, including thickness, internal stiffeners and diaphragms, to be proposed by the fabricator and subject to agreement with the Architect and Engineer to provide an enclosure which satisfies the aesthetic and structural requirements. Refer to 3D model for extent of EWS-1c.
- Visually exposed HVAC supply and return ducts in the Shed, shown herein, are to be in the scope of the steel contractor to ensure continuity of appearance with primary steel. Criteria for tolerance and flatness to match that of the structural steel (see structural drawings & specifications). Plate configuration, including thickness, internal stiffeners and diaphragms, to be proposed by the fabricator and subject to agreement with the Architect and Engineer to provide an enclosure which satisfies the aesthetic and structural requirements. The mechanical ductwork carries its own self-weight and is not a primary load-bearing element. Internal stiffening may not create interference with airflow requirements of the duct. Refer to 3D model.

CULTURE SHED
545 West 30th Street
New York, New York 10001
OWNER: CULTURE SHED INC.

ARCHITECTS
Diller Scofidio + Renfro Architects, D.P.C.
601 West 28 Street #815
New York, New York 10001
T: 212.463.0334
F: 212.463.0335

STRUCTURAL ENGINEER
Thornton Tomasetti
51 Madison Avenue
New York, New York 10010
T: 917.661.7800
F: 917.661.7861

MEP ENGINEER
Janus Baum & Bolles
63 Pine Street
New York, New York 10005
T: 212.530.9300
F: 212.269.9884

FACADE CONSULTANT
Thornton Tomasetti
51 Madison Avenue
New York, New York 10010
T: 917.661.7800
F: 917.661.7861

KINETICS ENGINEER
Hardisty & Hanover
1501 Broadway
New York, New York 10036
T: 212.844.1150
F: 212.391.0287

LIGHTING DESIGNER
Tilston Design Associates
40 Ninth Street #180
New York, New York 10013
T: 212.875.7760

THEATRE PLANNING & DESIGN
Pruitt Duchs Associates
22 West 16th Street
New York, New York 10011
T: 212.875.7760

LIFE SAFETY
Code Consultants, Inc.
215 West 40th St, 16th Flr
New York, New York 10018
T: 212.216.9596

ENERGY MODEL/LEED
Vridan
50 Washington Street
Norwalk, CT 06854
T: 203.298.1411

ACOUSTIC/AUDIO-VISUAL
Alvarez
93 North Main Street
South Norwalk, CT 06854
T: 347.210.5540

VERTICAL TRANSPORTATION
Van Dusen & Associates
5 Regent Street, Suite 524
Livingston, NJ 07039
T: 973.984.9220

SPECIFICATIONS
Construction Specifications Inc.
PO Box 488
27 Tenney Road
Morgantown, NJ 07951
T: 732.870.0700
F: 732.870.0700

SECURITY
Duchella Venter & Santoro
1020 Sherman Avenue
Hamden, CT 06514
T: 203.288.6490

WATERPROOFING
James R. Gierfort AIA Consulting Architects PC
104 West 27th Street
New York, NY 10001
T: 212.736.3344

FACADE MAINTENANCE
Etek Engineering PLLC
196 Ave. Street
New York, NY 10005
T: 212.898.3000


BRANDING/GRAPHICS
24 Global Design Consultancy
180 Varck Street 15th Floor
New York, NY 10014
T: 212.647.1170

KEY PLAN

ISSUE	PRINTING	DATE
01	50	DOB AMENDMENT 7
02	30	DOB AMENDMENT 5
03	15	DOB AMENDMENT 1
04	4	100% CONSTRUCTION DOCUMENTS
05	9	90% CONSTRUCTION DOCUMENTS
06	6	PRELIMINARY CONSTRUCTION
07	1	ADV. PROCUREMENT BID SET

STAMP
DILLER SCOFIDIO + RENFRO ARCHITECTS
DATE: 09/02/2015

DRAWN BY MW
CHECKED BY CS
PROJECT NUMBER 10117
TITLE BUILDING SECTION - EAST / WEST
SCALE: 1/8" = 1'-0"
DRAWING NO. A-516.00
B-SCAN NO.

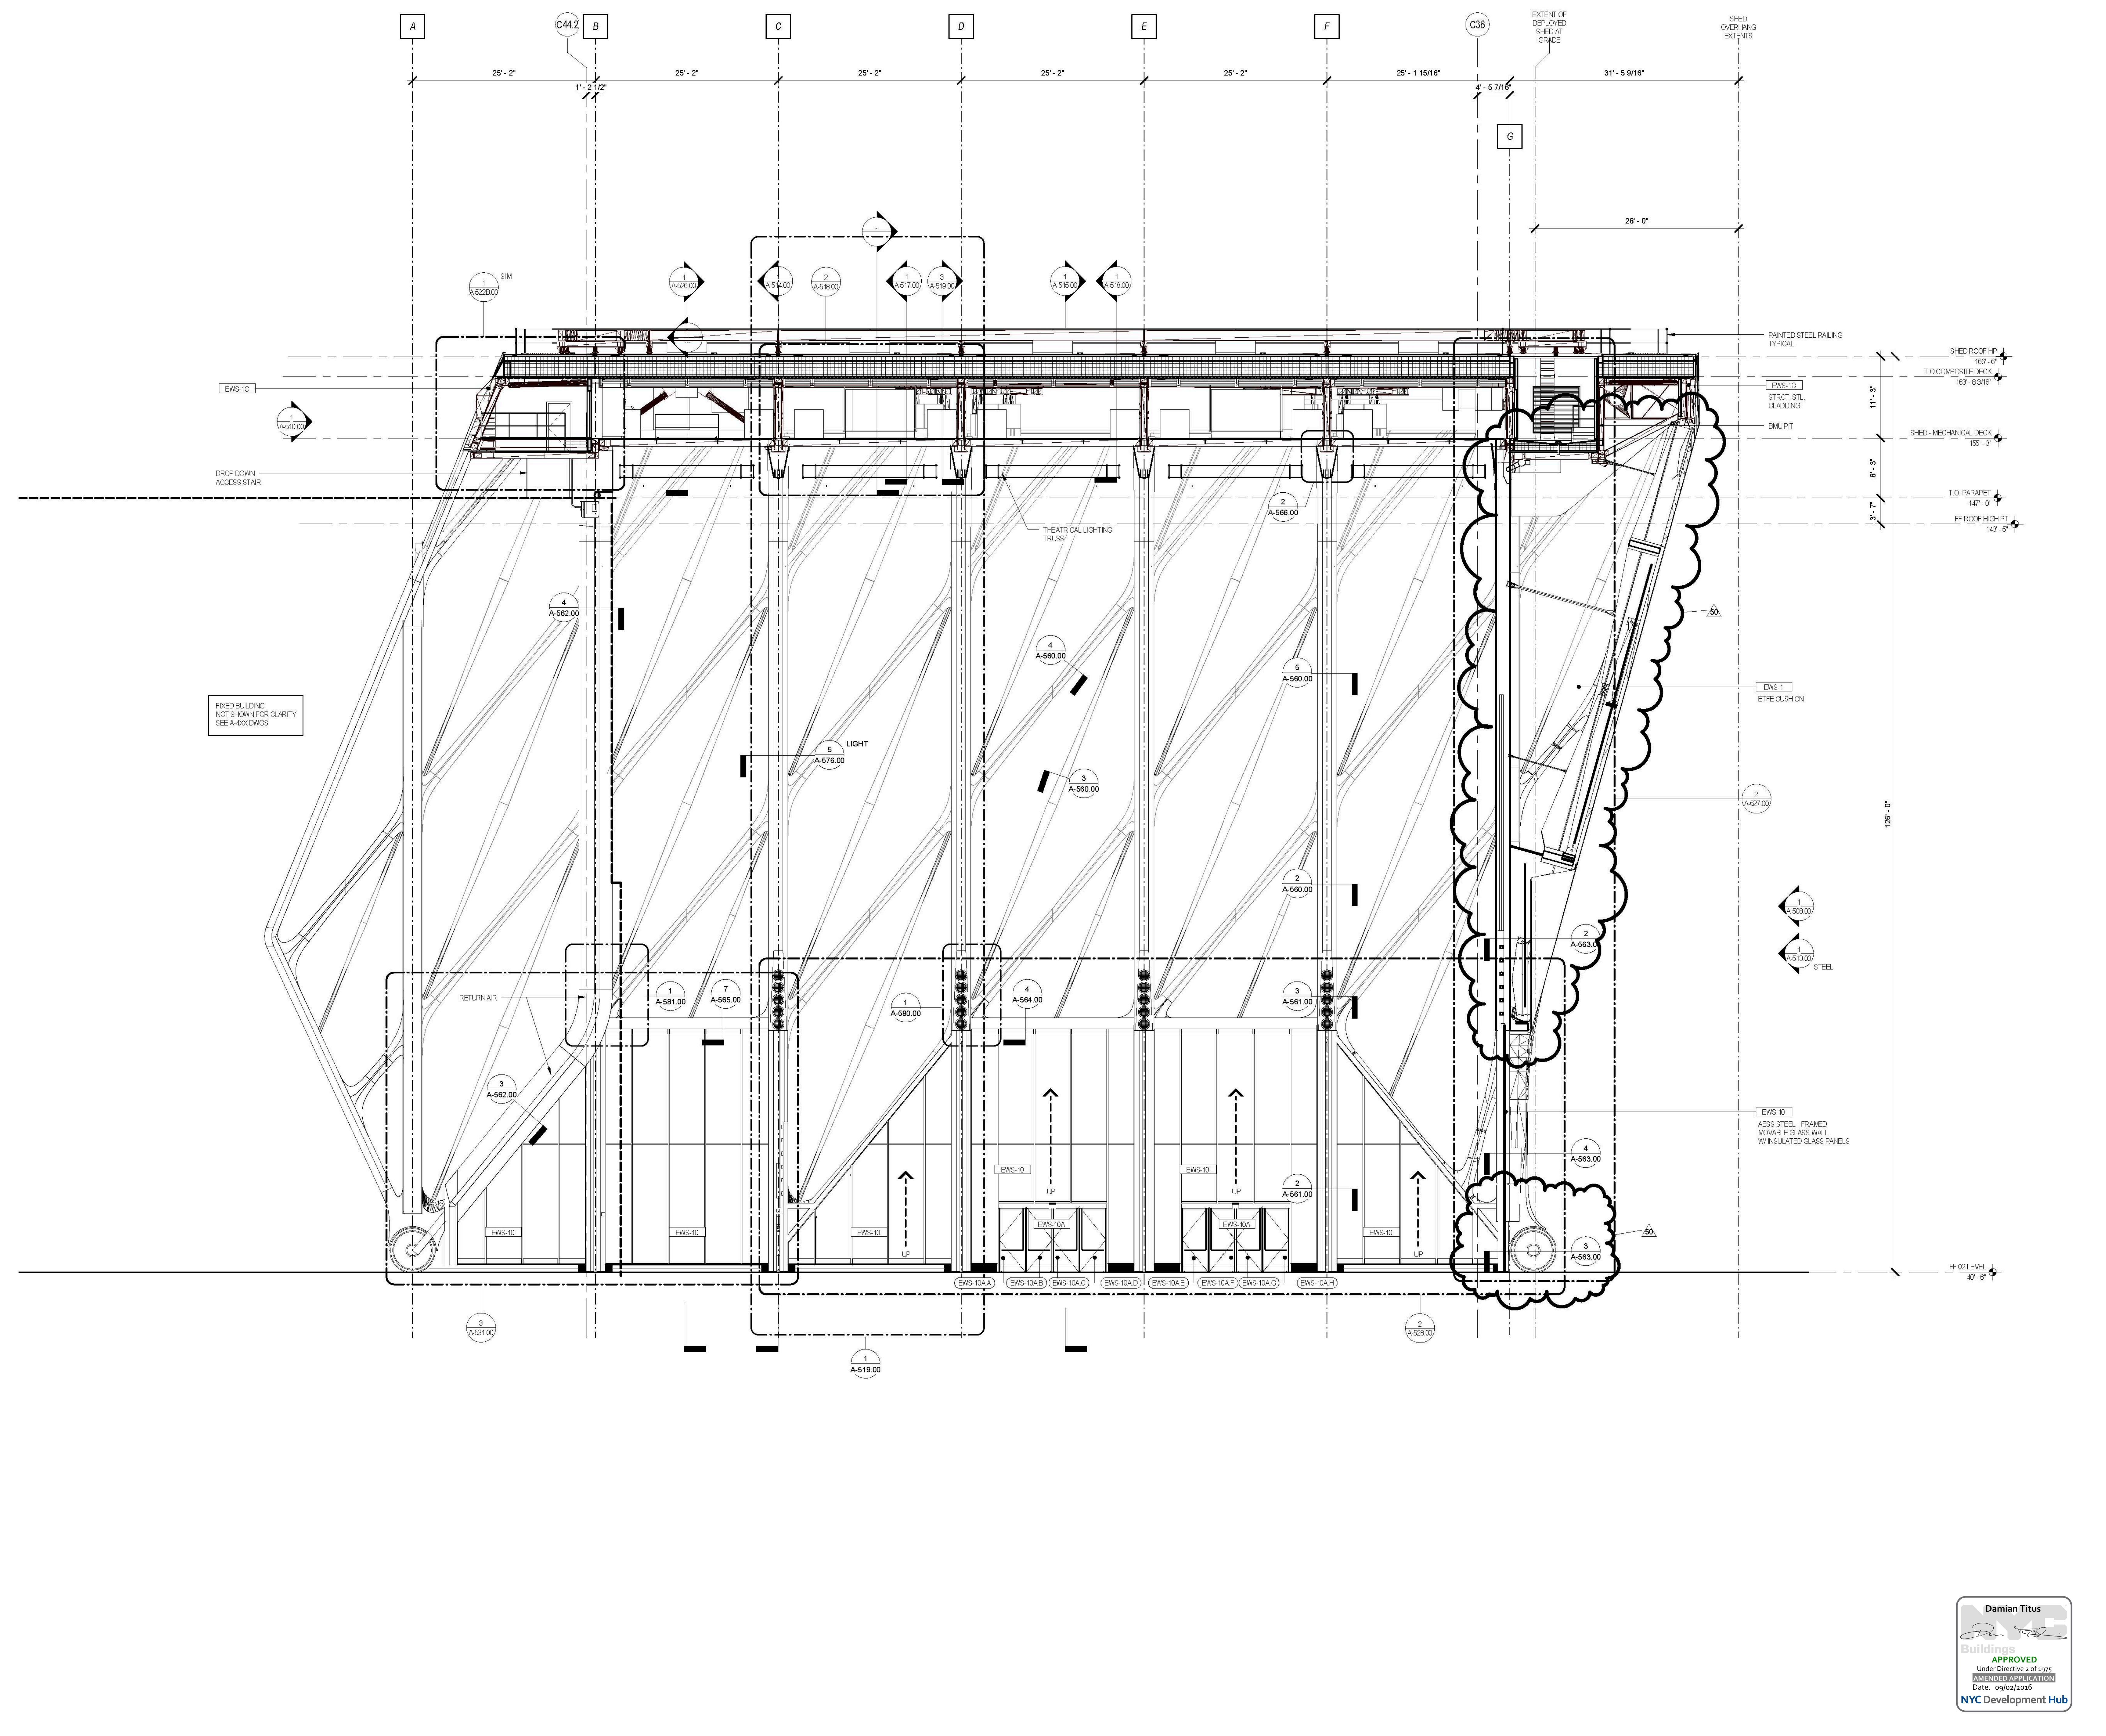

BUILDING SECTION - E/W

1
1/8" = 1'-0"

A-516.01

CULTURE SHED
 545 West 30th Street
 New York, New York 10001
 OWNER: CULTURE SHED INC.

ARCHITECTS:
 Oller Scifield + Renfro Architects, D.P.C.
 601 West 28 Street #1815
 New York, New York 10001
 T: 212.260.7971

rockwellgroup
 5 Union Sq West, 8th Flr
 New York, New York 10003
 T: 212.463.0334
 F: 212.463.0335

STRUCTURAL ENGINEER:
 Thornton Tomasetti
 57 Madison Avenue
 New York, New York 10010
 T: 917.861.7800
 F: 917.861.7801

MEP ENGINEER:
 Janus Baum & Bolles
 80 Pine Street
 New York, New York 10005
 T: 212.530.9300
 F: 212.260.9884

FACADE CONSULTANT:
 Thornton Tomasetti
 57 Madison Avenue
 New York, New York 10010
 T: 917.861.7800
 F: 917.861.7801

KINETICS ENGINEER:
 Hardisty & Hanover
 1501 Broadway
 New York, New York 10036
 T: 212.844.1150
 F: 212.381.0287

LIGHTING DESIGNER:
 Tiltson Design Associates
 40 Ninth Street #1890
 New York, New York 10013
 T: 212.875.7760

THEATRE PLANNING & DESIGN:
 Filmer Dachs Associates
 22 West 16th Street
 New York, New York 10011
 T: 212.691.3100

LIFE SAFETY:
 Code Consultants, Inc.
 215 West 40th St, 16th Flr
 New York, New York 10018
 T: 212.216.9596

ENERGY MODEL/LEED:
 Viridan
 50 Washington Street
 Norwalk, CT 06854
 T: 203.298.1411

ACOUSTIC/AUDIO-VISUAL:
 Alankis
 93 North Main Street
 South Norwalk, CT 06854
 T: 347.210.5540

VERTICAL TRANSPORTATION:
 Van Dusen & Associates
 5 Regent Street, Suite 504
 Livingston, NJ 07039
 T: 973.984.8220


CONSTRUCTION SPECIFICATIONS INC.:
 PO Box 489
 22 Tenney Road
 Morganville, NJ 07875
 T: 732.870.0700
 F: 732.870.0700

SECURITY:
 Duchella Venter & Santore
 1020 Sherman Avenue
 Hamden, CT 06514
 T: 203.288.6490

WATERPROOFING:
 James R. Gairford AIA Consulting Architects PC
 104 West 77th Street
 New York, NY 10001
 T: 212.736.3344

FACADE MAINTENANCE:
 Eitek Engineering PLLC
 166 Ames Street
 New York, NY 10005
 T: 212.898.3000


BRANDING/GRAPHICS:
 214 Global Design Consultancy
 180 Vande Street 15th Floor
 New York, NY 10014
 T: 212.647.1170

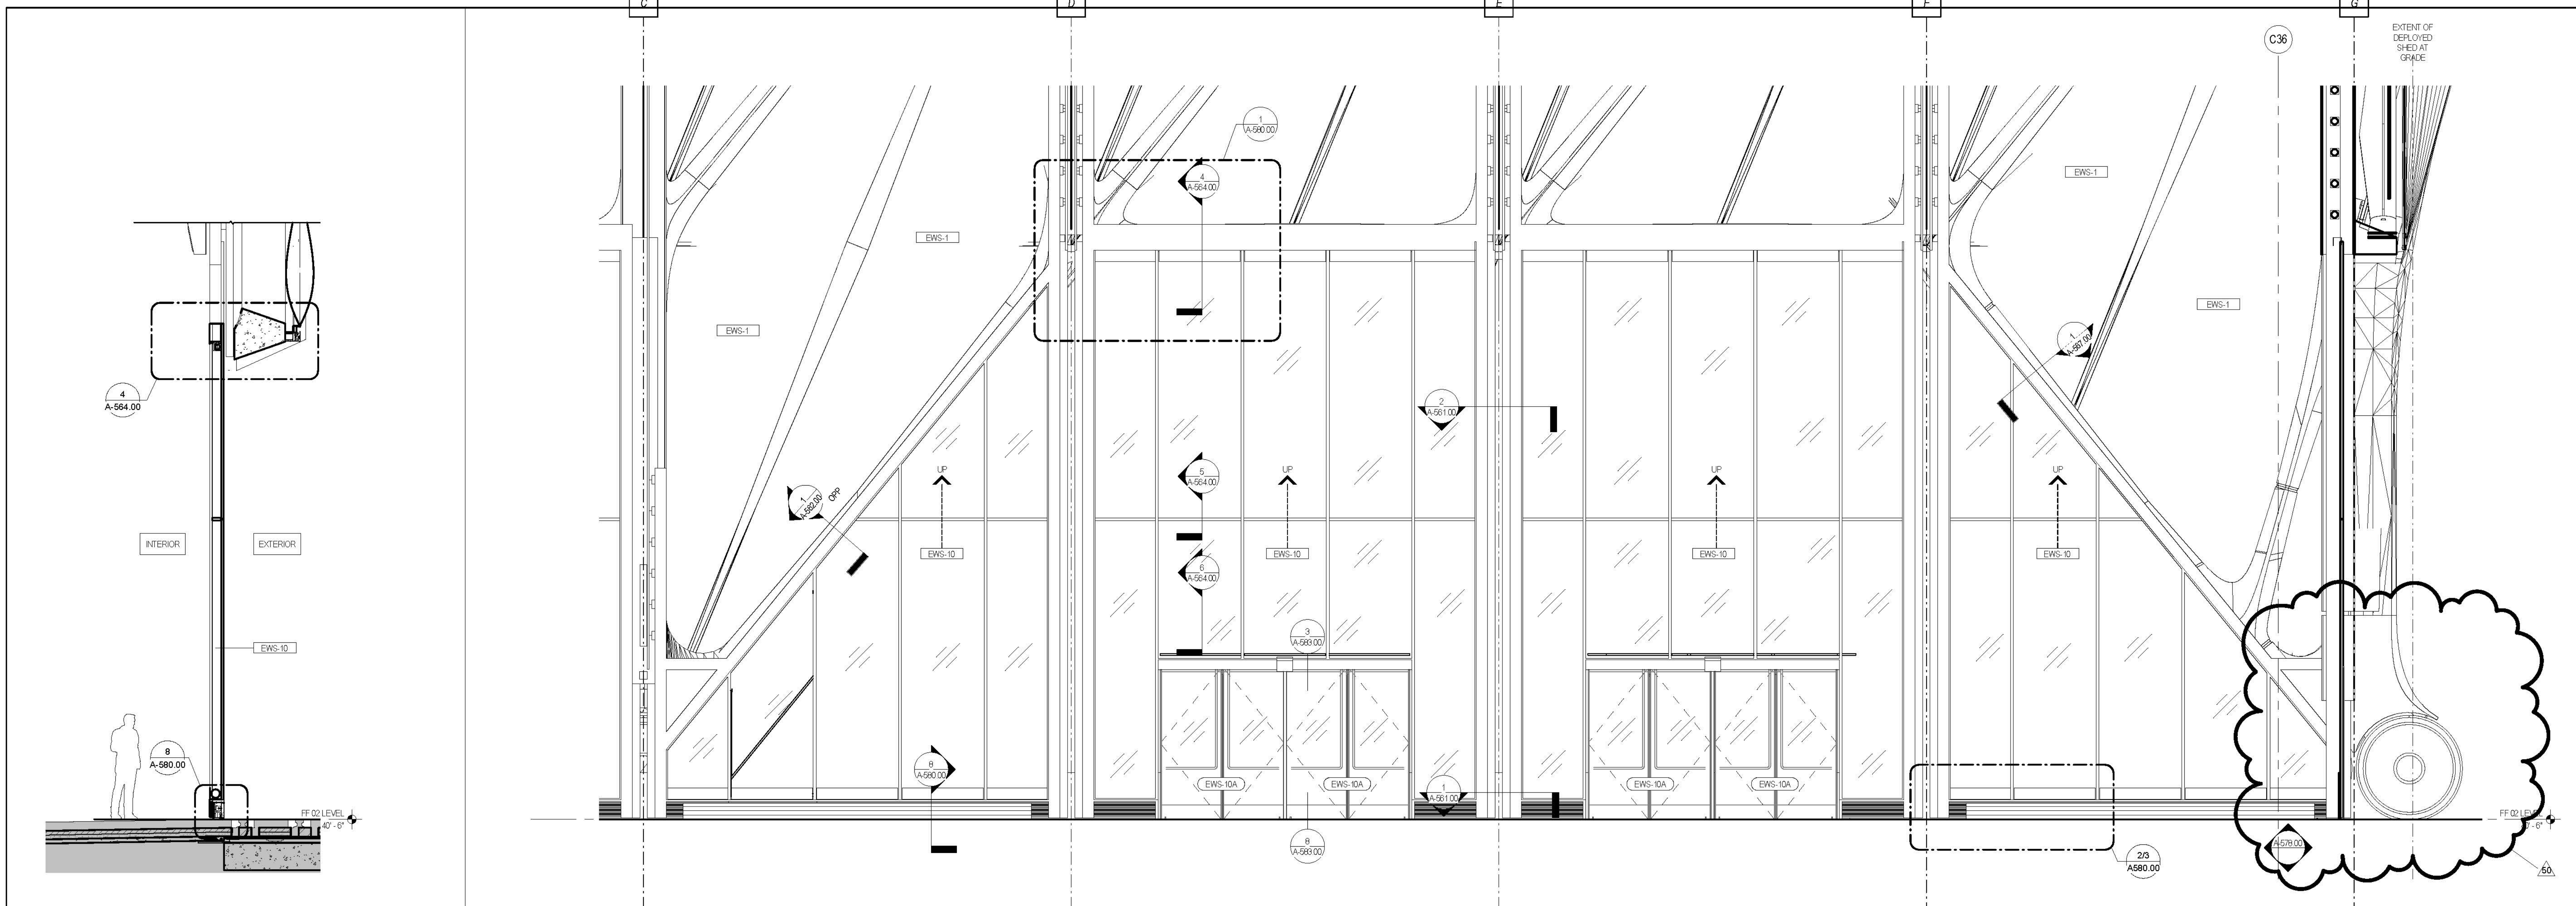

SECTION 2 @ N OPERABLE WALL 1
 1/4" = 1'-0"

INTERIOR ELEVATION @ NORTH OPERABLE WALL 2
 1/4" = 1'-0"

GENERAL NOTES

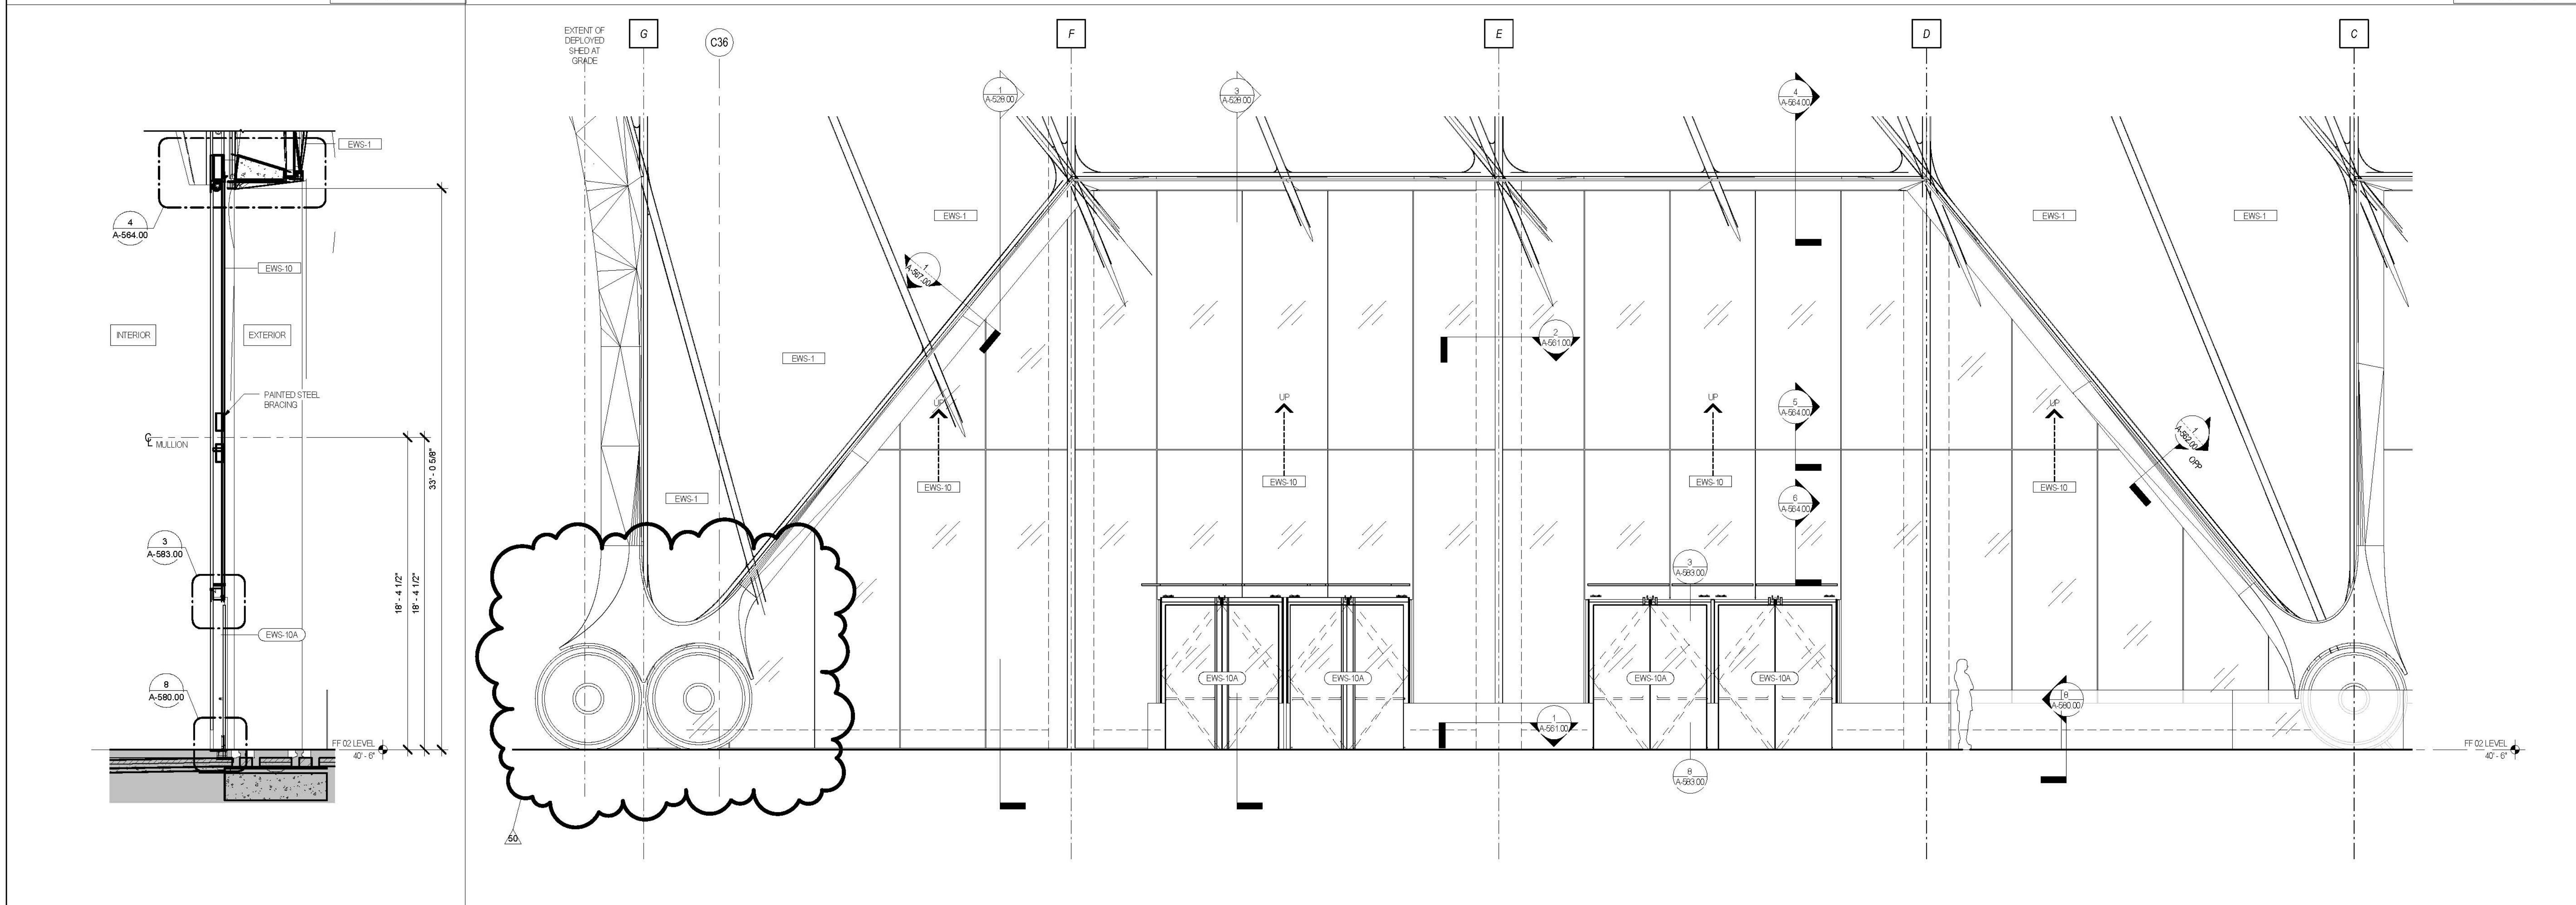

SECTION 1 @ N OPERABLE WALL 3
 1/4" = 1'-0"

ENLARGED ELEVATION @ NORTH OPERABLE WALL 4
 1/4" = 1'-0"

1. For Shed components this drawing set is to be considered integral with the provided 3D models and may not be considered independently from the models. The contractor is to base their bid upon the information provided in both the drawings and 3D models. In matters of form and geometry the three dimensional model takes precedence in the instance of a discrepancy between drawing and model. In all other matters the contractor shall seek the opinion of the Architect and Structural Engineer to resolve the discrepancy.

2. Geometry, dimensions and surface contouring, blending and intersection of sections illustrated in the structural drawings are provided for reference and generation of the structural arrangement and details only. The 3D model issued by the Architect defines the exterior surface and shall be adhered to for the final geometry. It is the responsibility of the Contractor to identify any discrepancies or ambiguities for discussion, resolution and direction from the Architect and Structural Engineer.


3. Typical N/S wall node: The geometry created by the intersecting main verticals and diagonals shall be in accordance with the 3D model and follow, as a minimum, the quality exhibited in the approved mock-up. The general concept is that edges flow smoothly and continuously between the straight edge of a diagonal through a curve to the adjacent edge of the vertical and the interfering surfaces between these edges are blended and contoured to define a smooth, uninterrupted transition.

4. Typical Node Elsewhere: The geometry created by the intersecting elements shall be in accordance with the 3D model. The level of quality is to be similar to the approved mock-up for the typical node. The general concept is that edges flow smoothly and continuously between the edge of one element to the corresponding edge of the adjacent element and the interfering surfaces between these edges are blended and contoured to define a smooth, uninterrupted transition.

5. This drawing should be considered integral with the written Specifications issued along with the drawings and 3D models. Refer to the Advanced procurement Bid Issue Specifications Table of Contents.

6. Structural steel cladding enclosing selected areas of the Shed (referred to as EWS-1c) shall be in the scope of the steel contractor for continuity with adjacent primary steel members. Criteria for tolerance and flatness to match that of the structural steel (see structural drawings & specifications). Plate configuration, including thickness, internal stiffeners and diaphragms, to be proposed by the fabricator and subject to agreement with the Architect and Engineer to provide an enclosure which satisfies the aesthetic and structural requirements. Refer to 3D model for extent of EWS-1c.

7. Visually exposed HVAC supply and return ducts in the Shed, shown herein, are to be in the scope of the steel contractor to ensure continuity of appearance with primary steel. Criteria for tolerance and flatness to match that of the structural steel (see structural drawings & specifications). Plate configuration, including thickness, internal stiffeners and diaphragms, to be proposed by the fabricator and subject to agreement with the Architect and Engineer to provide an enclosure which satisfies the aesthetic and structural requirements. The mechanical ductwork carries its own self-weight and is not a primary load-bearing element. Internal stiffening may not create interference with airflow requirements of the duct. Refer to 3D model.

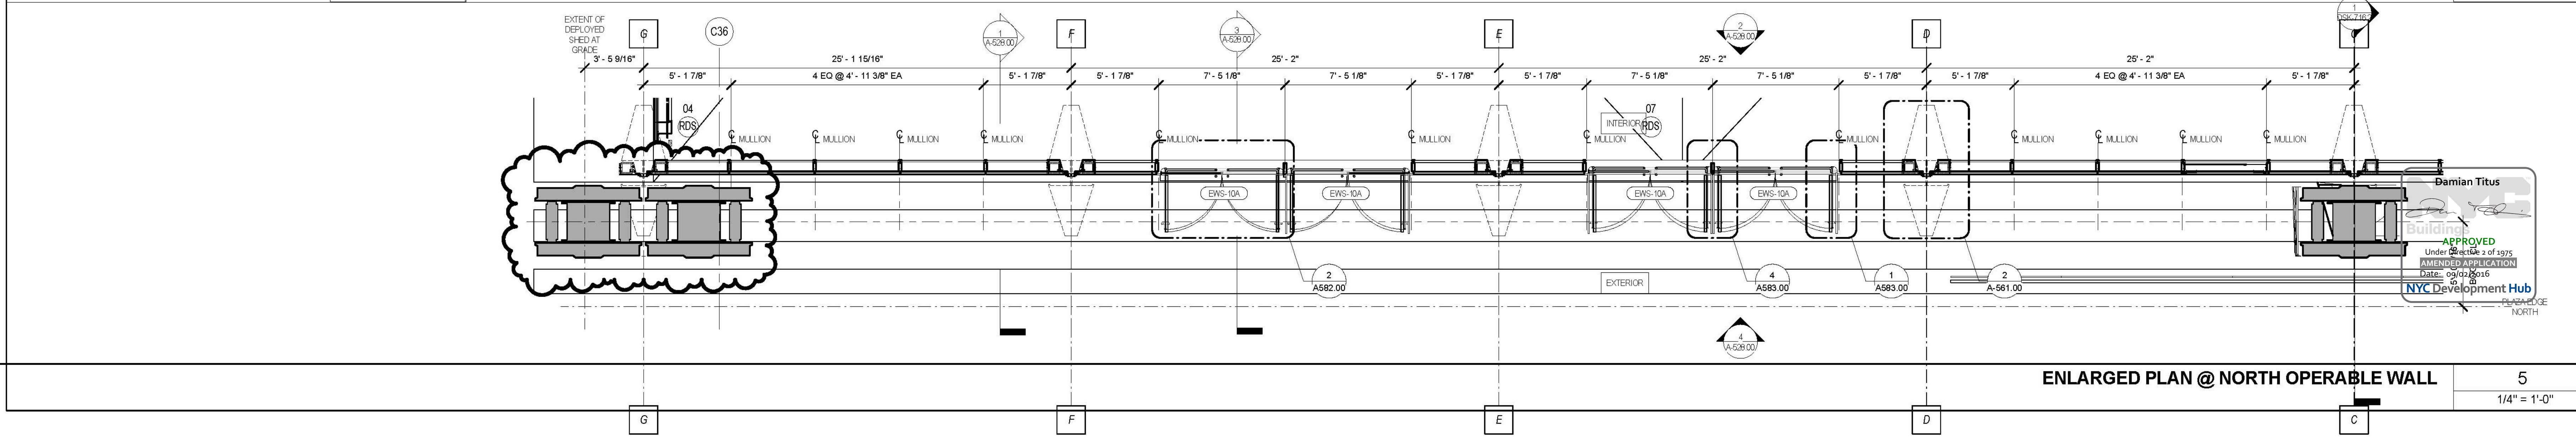

SECTION 1 @ N OPERABLE WALL 3
 1/4" = 1'-0"

ENLARGED PLAN @ NORTH OPERABLE WALL 5
 1/4" = 1'-0"

KEY PLAN

ISSUE / PRINTING / DATE

ISSUE	PRINTING	DATE
01	50	DOB AMENDMENT 7
02	30	DOB AMENDMENT 5
03	15	DOB AMENDMENT 1
04	4	100% CONSTRUCTION DOCUMENTS
05	0	90% CONSTRUCTION DOCUMENTS
06	0	PRELIMINARY CONSTRUCTION DOCUMENTS
07	1	ADV. PROCUREMENT BID SET

STAMP

DRAWN BY / **CHECKED BY**

PROJECT NUMBER 11017

TITLE ENLARGED DRAWINGS - NORTH OPERABLE WALL

SCALE: 1/4" = 1'-0"

DRAWING NO. A-528.00

B-SCAN NO. A-528.01

CULTURE SHED
 545 West 30th Street
 New York, New York 10001
 OWNER: CULTURE SHED INC.

ARCHITECTS:
 Oller Scifield + Renfro Architects, D.P.C.
 601 West 28 Street #1815
 New York, New York 10001
 T: 212.260.7971

rockwellgroup
 5 Union Sq West, 8th Flr
 New York, New York 10003
 T: 212.463.0334
 F: 212.463.0335

STRUCTURAL ENGINEER:
 Thornton Tomasetti
 57 Madison Avenue
 New York, New York 10010
 T: 917.861.7800
 F: 917.861.7801

MEP ENGINEER:
 Janus Baum & Bolles
 80 Pine Street
 New York, New York 10005
 T: 212.530.9300
 F: 212.260.9884

FACADE CONSULTANT:
 Thornton Tomasetti
 57 Madison Avenue
 New York, New York 10010
 T: 917.861.7800
 F: 917.861.7801

KINETICS ENGINEER:
 Hardisty & Hanover
 1501 Broadway
 New York, New York 10036
 T: 212.844.1150
 F: 212.381.0287

LIGHTING DESIGNER:
 Tiltson Design Associates
 40 Ninth Street #1890
 New York, New York 10013
 T: 212.875.7760

THEATRE PLANNING & DESIGN:
 Filmer Dachs Associates
 22 West 16th Street
 New York, New York 10011
 T: 212.691.3100

LIFE SAFETY:
 Code Consultants, Inc.
 215 West 40th St, 16th Flr
 New York, New York 10018
 T: 212.216.9596

ENERGY MODEL/LEED:
 Viridan
 50 Washington Street
 Norwalk, CT 06854
 T: 203.298.1411

ACOUSTIC/AUDIO-VISUAL:
 Alankis
 93 North Main Street
 South Norwalk, CT 06854
 T: 347.210.5540

VERTICAL TRANSPORTATION:
 Van Dusen & Associates
 5 Regent Street, Suite 504
 Livingston, NJ 07039
 T: 973.984.8220

CONSTRUCTION SPECIFICATIONS INC.:
 PO Box 489
 22 Tenney Road
 Morganville, NJ 07875
 T: 732.870.0700
 F: 732.870.0700

SECURITY:
 Duchella Venter & Santore
 1020 Sherman Avenue
 Hamden, CT 06514
 T: 203.288.6490

WATERPROOFING:
 James R. Gairford AIA Consulting Architects PC
 104 West 77th Street
 New York, NY 10001
 T: 212.736.3344

FACADE MAINTENANCE:
 Eitek Engineering PLLC
 166 Ames Street
 New York, NY 10005
 T: 212.898.3000

BRANDING/GRAPHICS:
 214 Global Design Consultancy
 180 Vande Street 15th Floor
 New York, NY 10014
 T: 212.647.1170

CULTURE SHED
 545 West 30th Street
 New York, New York 10001
 OWNER: CULTURE SHED INC

ARCHITECTS
 Oller Scifidio + Renfro Architects, D.P.C.
 601 West 28 Street #815
 New York, New York 10001
 T: 212.463.0334
 F: 212.463.0335

STRUCTURAL ENGINEER
 Thornton Tomasetti
 51 Madison Avenue
 New York, New York 10010
 T: 917.861.7800
 F: 917.861.7801

MEP ENGINEER
 Janus Baum & Bolles
 83 Pine Street
 New York, New York 10005
 T: 212.530.9300
 F: 212.289.9884

FACADE CONSULTANT
 Thornton Tomasetti
 51 Madison Avenue
 New York, New York 10010
 T: 917.861.7800
 F: 917.861.7801

KINETICS ENGINEER
 Hardisty & Hanover
 1501 Broadway
 New York, New York 10036
 T: 212.844.1150
 F: 212.381.0287

LIGHTING DESIGNER
 Trilsson Design Associates
 40 South Street #180
 New York, New York 10013
 T: 212.875.7760

THEATRE PLANNING & DESIGN
 Filmer Dachs Associates
 22 West 16th Street
 New York, New York 10011
 T: 212.891.3000

LIFE SAFETY
 Code Consultants, Inc.
 215 West 40th St, 16th Flr
 New York, New York 10018
 T: 212.216.9596

ENERGY MODEL/LEED
 Viridan
 50 Washington Street
 Norwalk, CT 06854
 T: 203.298.1411

ACOUSTIC/AUDIO-VISUAL
 Alavivik
 93 North Main Street
 South Norwalk, CT 06854
 T: 347.210.5540

VERTICAL TRANSPORTATION
 Van Dusen & Associates
 5 Regent Street, Suite 524
 Livingston, NJ 07039
 T: 973.984.8220

SPECIFICATIONS
 Construction Specifications Inc.
 PO Box 489
 22 Tenney Road
 Morganville, NJ 07751
 T: 732.870.0700
 F: 732.870.0700

SECURITY
 Duchella Venter & Santoro
 1020 Sherman Avenue
 Hamden, CT 06514
 T: 203.288.6490

WATERPROOFING
 James R. Gairford AIA Consulting Architects PC
 104 West 27th Street
 New York, NY 10001
 T: 212.736.3344

FACADE MAINTENANCE
 Eriek Engineering PLLC
 66 Ames Street
 New York, NY 10005
 T: 212.898.3000

BRANDING/GRAPHICS
 214 Global Design Consultancy
 180 Vank Street 15th Floor
 New York, NY 10014
 T: 212.647.1170

KEY PLAN

ISSUE / PRINTING / DATE

ISSUE	PRINTING	DATE
01	50	DOB AMENDMENT 7
02	30	DOB AMENDMENT 5
03	15	DOB AMENDMENT 1
04	4	100% CONSTRUCTION DOCUMENTS
05	0	90% CONSTRUCTION DOCUMENTS
06	0	PRELIMINARY CONSTRUCTION
07	1	ADV. PROCUREMENT BID SET



DRAWN BY / **CHECKED BY**
 MIM / CS

PROJECT NUMBER
 11017

TITLE
 ENLARGED DRAWINGS - SOUTH OPERABLE WALL


SCALE: 1/4" = 1'-0"

DRAWING NO.
 A-529.00

B-SCAN NO.
 A-529.01

LEGEND

[Symbol]	EXTENT OF DEPLOYED SHED AT GRADE
[Symbol]	PLAZA EDGE SOUTH
[Symbol]	WATERPROOFING
[Symbol]	MEP DUCTS
[Symbol]	INTERNAL STIFFENERS AND DIAPHRAGMS
[Symbol]	CLADDING
[Symbol]	OPERABLE WALL
[Symbol]	VIEWING PLATFORM
[Symbol]	NYC DEVELOPMENT HUB

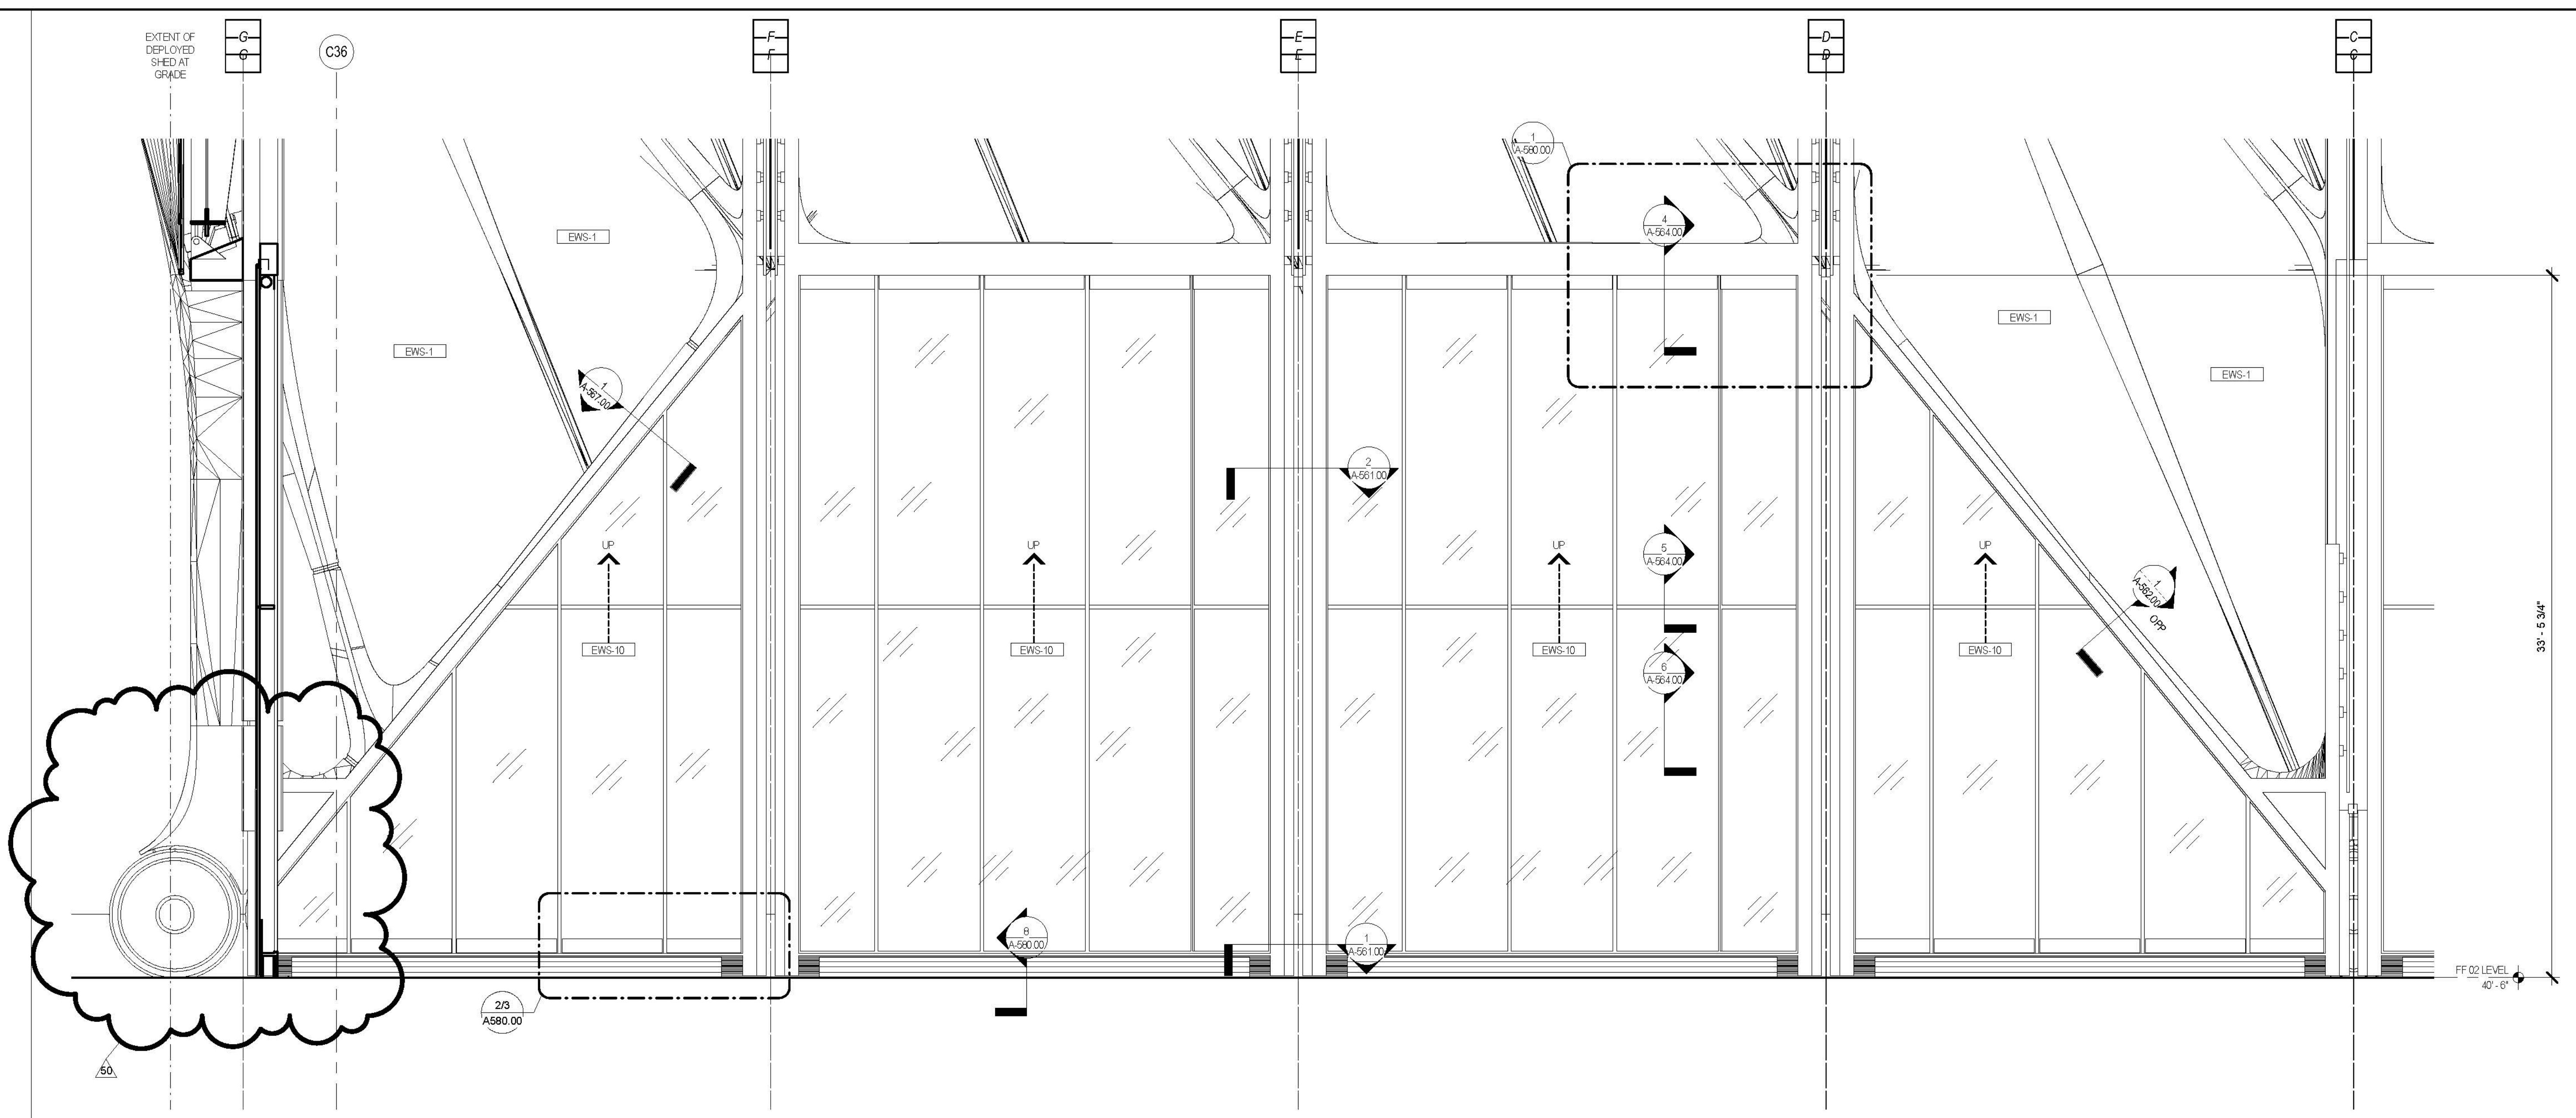


INTERIOR ELEVATION @ SOUTH OPERABLE WALL

1
1/4" = 1'-0"


GENERAL NOTES

- For Shed components this drawing set is to be considered integral with the provided 3D models and may not be considered independently from the models. The contractor is to base their bid upon the information provided in both the drawings and 3D models. In matters of form and geometry the three dimensional model takes precedence in the instance of a discrepancy between drawing and model. In all other matters the contractor shall seek the opinion of the Architect and Structural Engineer to resolve the discrepancy.
- Geometry, dimensions and surface contouring, blending and intersection of sections illustrated in the structural drawings are provided for reference and generation of the structural arrangement and details only. The 3D model issued by the Architect defines the exterior surface and shall be adhered to for the final geometry. It is the responsibility of the Contractor to identify any discrepancies or ambiguities for discussion, resolution and direction from the Architect and Structural Engineer.
- Typical N/S wall node: The geometry created by the intersecting main verticals and diagonals shall be in accordance with the 3D model and follow, as a minimum, the quality exhibited in the approved mock-up. The general concept is that edges flow smoothly and continuously between the straight edge of a diagonal through a curve to the adjacent edge of the vertical and the interfing surfaces between these edges are blended and contoured to define a smooth, uninterrupted transition.
- Typical Node Elsewhere: The geometry created by the intersecting elements shall be in accordance with the 3D model. The level of quality is to be similar to the approved mock-up for the typical node. The general concept is that edges flow smoothly and continuously between the edge of one element to the corresponding edge of the adjacent element and the interfing surfaces between these edges are blended and contoured to define a smooth, uninterrupted transition.
- This drawing should be considered integral with the written Specifications issued along with the drawings and 3D models. Refer to the Advanced procurement Bid Issue Specifications Table of Contents.
- Structural steel cladding enclosing selected areas of the Shed (referred to as EWS-1c) shall be in the scope of the steel contractor for continuity with adjacent primary steel members. Criteria for tolerance and flatness to match that of the structural steel (see structural drawings & specifications). Plate configuration, including thickness, internal stiffeners and diaphragms, to be proposed by the fabricator and subject to agreement with the Architect and Engineer to provide an enclosure which satisfies the aesthetic and structural requirements. Refer to 3D model for extent of EWS-1c.
- Visually exposed HVAC supply and return ducts in the Shed, shown herein, are to be in the scope of the steel contractor to ensure continuity of appearance with primary steel. Criteria for tolerance and flatness to match that of the structural steel (see structural drawings & specifications). Plate configuration, including thickness, internal stiffeners and diaphragms, to be proposed by the fabricator and subject to agreement with the Architect and Engineer to provide an enclosure which satisfies the aesthetic and structural requirements. The mechanical ductwork carries its own self-weight and is not a primary load-bearing element. Internal stiffening may not create interference with airflow requirements of the duct. Refer to 3D model.

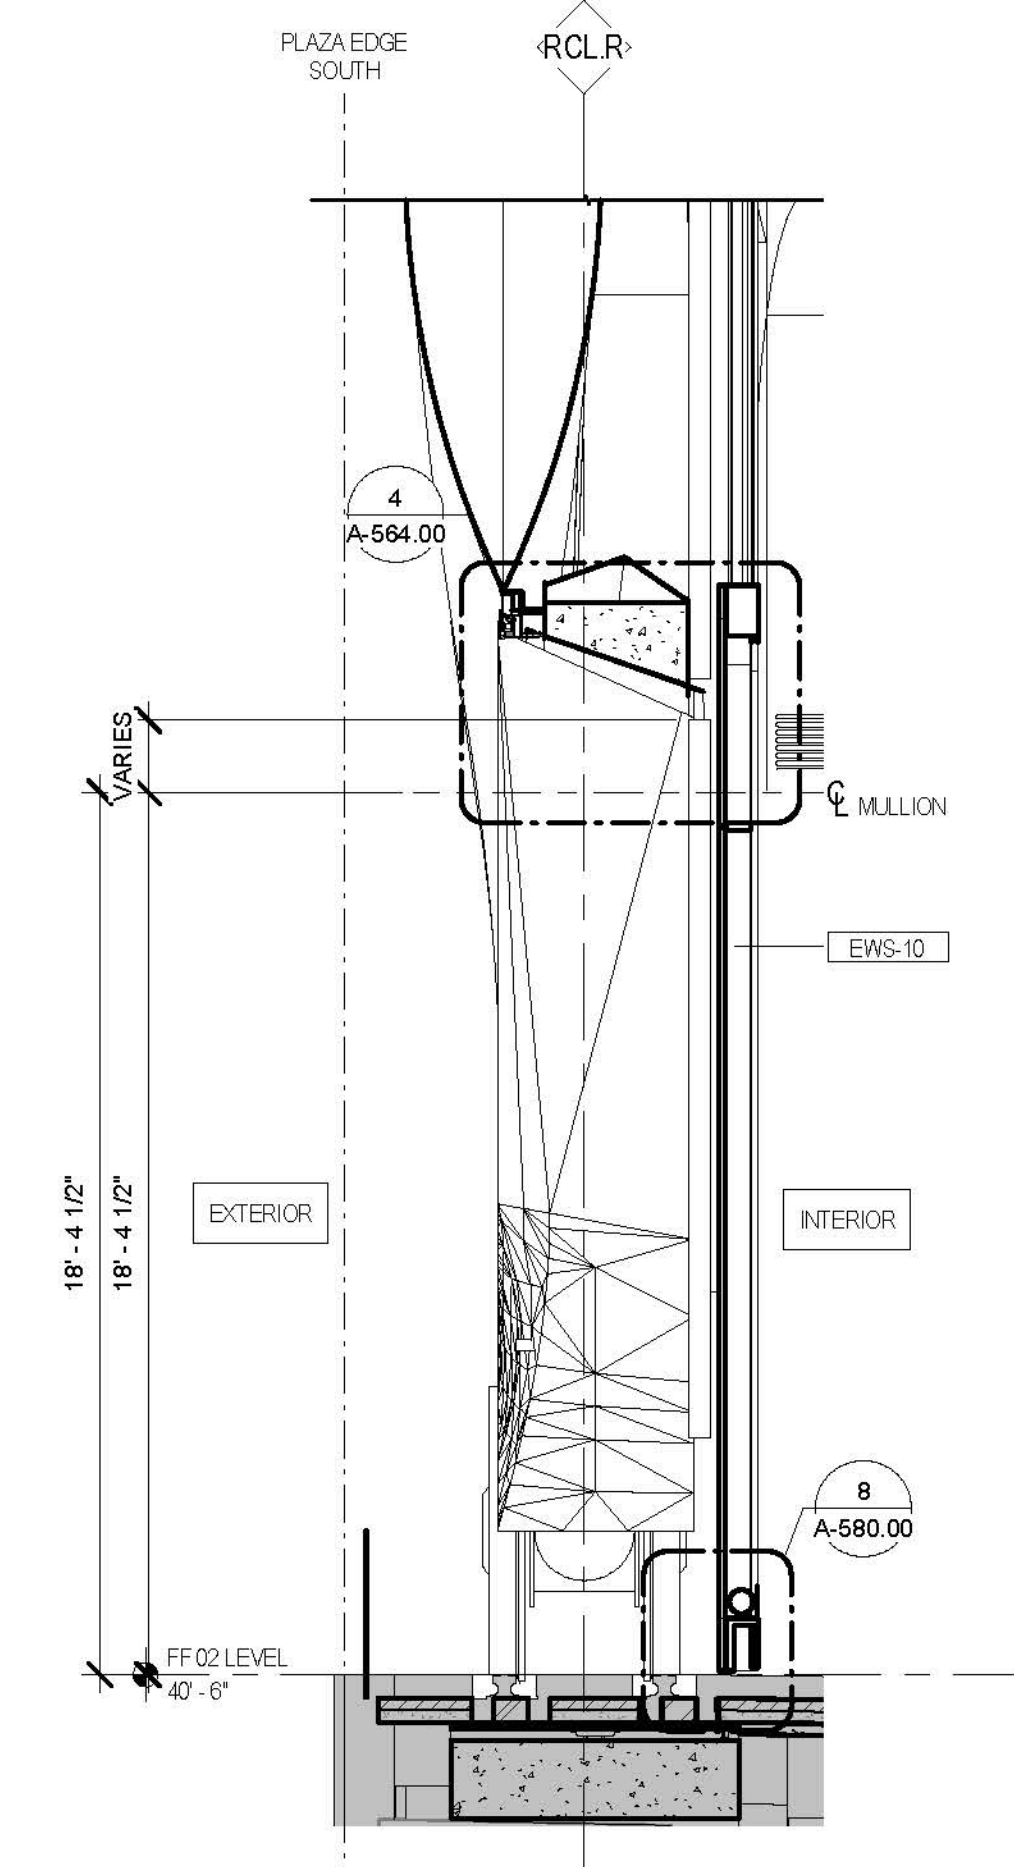


SECTION @ S OPERABLE WALL

2
1/4" = 1'-0"

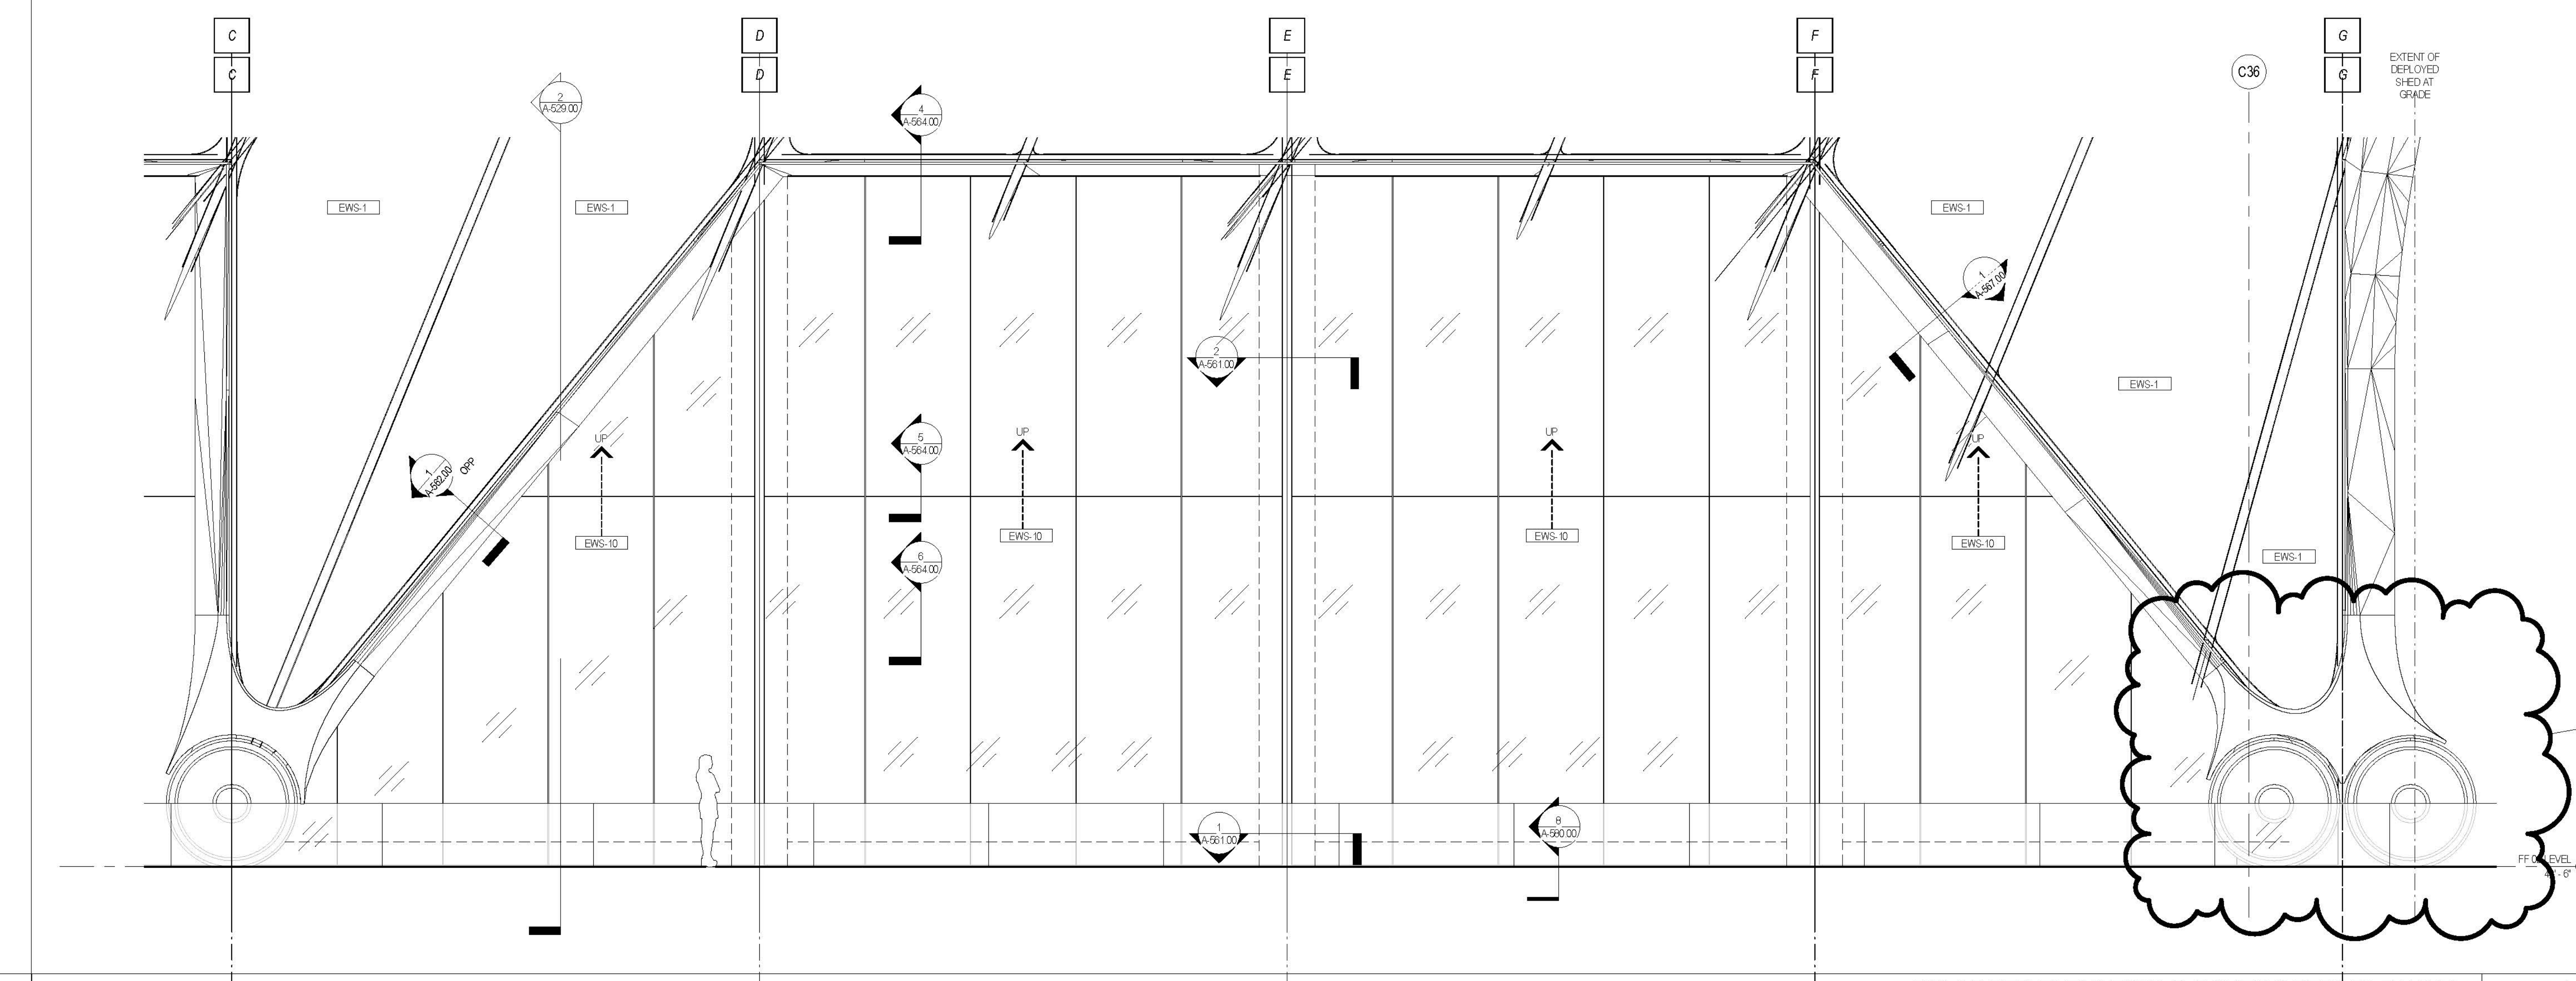

ENLARGED ELEVATION @ SOUTH OPERABLE WALL

3
1/4" = 1'-0"

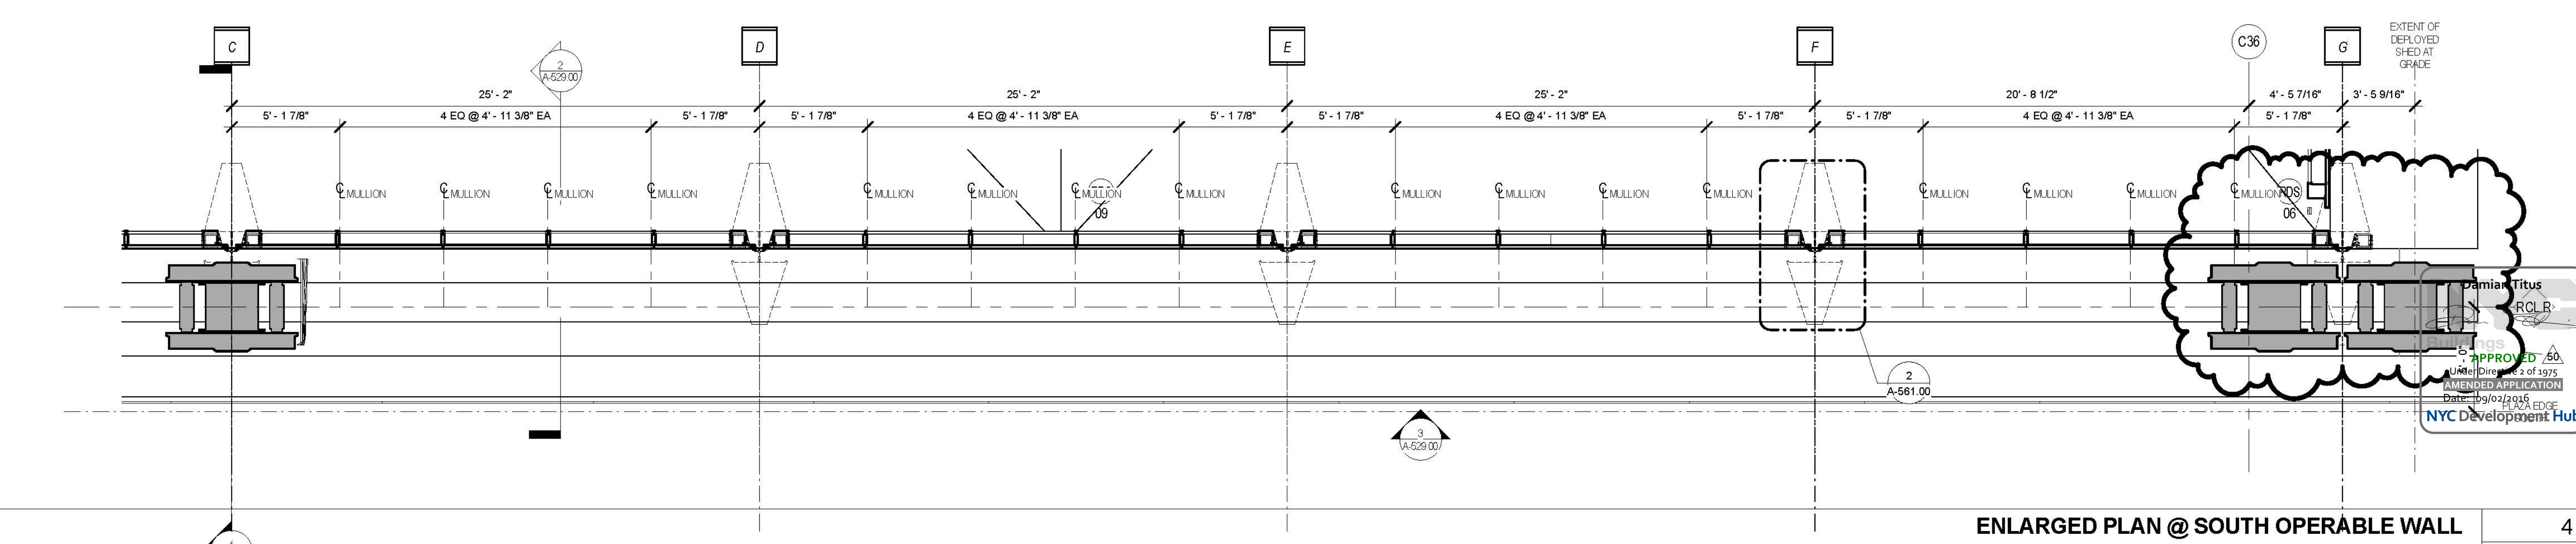

ENLARGED PLAN @ SOUTH OPERABLE WALL

4
1/4" = 1'-0"

CULTURE SHED AT HUDSON YARDS

DOB AMENDMENT 7

DATE: 08/19/2016

STRUCTURAL DRAWING LIST

SHEET NO	SHEET NAME	SHEET NO	SHEET NAME
S-000 SERIES: GENERAL			
S-001.02	COVER SHEET & DRAWING LIST	S-502A.00	MODIFICATION PART PLANS AND DETAILS, FIXED BUILDING LEVEL 00 - III
S-002.01	STRUCTURAL GENERAL NOTES	S-503.01	MODIFICATION PART PLANS AND DETAILS, FIXED BUILDING LEVEL 00 AND 01
S-003.00	STRUCTURAL GENERAL NOTES II	S-504.01	MODIFICATION PART PLANS AND DETAILS, FIXED BUILDING LEVEL 02 - I
S-005.01	STEEL TOLERANCES - GLOBAL	S-505.00	MODIFICATION PART PLANS AND DETAILS, FIXED BUILDING LEVEL 02 - II
S-006.01	N/S WALL_ELEMENTS - STEEL TOLERANCES	S-508.00	MODIFICATION PART PLANS AND DETAILS, FIXED BUILDING LEVEL 02 - V
S-007.00	EAST WALL_ELEMENTS - STEEL TOLERANCES	S-600 SERIES: MASONRY SCHEDULES, SECTIONS AND DETAILS	
S-008.00	TYPICAL SECTIONS - STEEL TOLERANCES	S-601.00	TYPICAL MASONRY NON-BEARING WALL SCHEDULES
S-009.01	STEEL TOLERANCES - BOGIES	S-602.00	TYPICAL MASONRY NON-BEARING WALL DETAILS
S-010.01	STEEL TOLERANCES - NODES	S-603.00	TYPICAL MASONRY NON-BEARING WALL TO STEEL DETAILS
S-020.00	LAP SPLICE SCHEDULES	S-604.00	TYPICAL MASONRY NON-BEARING WALL TO CONCRETE DETAILS
S-030.00	LOAD DIAGRAMS I	S-700 SERIES: STEEL SUPERSTRUCTURE SECTIONS AND DETAILS	
S-031.00	LOAD DIAGRAMS II	S-701.00	TYPICAL STEEL BEAM DETAILS I
S-032.01	LOADING DIAGRAMS III	S-702.01	TYPICAL STEEL BEAM DETAILS II
S-050.00	AXONOMETRIC - FIXED BUILDING (SE)	S-703.01	TYPICAL STEEL BEAM DETAILS III
S-051.00	AXONOMETRIC - FIXED BUILDING (NW)	S-704.00	TYPICAL STEEL BEAM DETAILS IV
S-052.01	AXONOMETRIC - DEPLOYED SHED (SE)	S-710.00	TYPICAL COMPOSITE STEEL DECK DETAILS I
S-053.01	AXONOMETRIC - DEPLOYED SHED (NW)	S-711.00	TYPICAL COMPOSITE STEEL DECK DETAILS II
S-D100 SERIES: DEMOLITION PLANS			
S-D100.01	DEMOLITION AND INFILL PLAN, FIXED BUILDING LEVEL 00	S-712.00	TYPICAL COMPOSITE STEEL DECK DETAILS III
S-D101.01	DEMOLITION AND INFILL PLAN, FIXED BUILDING LEVEL 01	S-713.00	TYPICAL COMPOSITE STEEL DECK DETAILS IV
S-D102.01	DEMOLITION AND INFILL PLAN, FIXED BUILDING LEVEL 02	S-720.01	SECTIONS AND DETAILS, FIXED BUILDING LEVEL 00 AND 01 - I
S-100 SERIES: STRUCTURAL PLANS			
S-1C1.01	FRAMING PLAN, FIXED BUILDING - CELLAR LEVEL	S-720B.00	SECTIONS AND DETAILS, FIXED BUILDING LEVEL 00 AND 01 - II
S-100.01	FRAMING PLAN, FIXED BUILDING - LEVEL 00	S-721A.01	SECTIONS AND DETAILS, FIXED BUILDING LOBBY I
S-101.01	FRAMING PLAN, FIXED BUILDING - LEVEL 01	S-721B.01	SECTIONS AND DETAILS, FIXED BUILDING LOBBY II
S-102.01	FRAMING PLAN, FIXED BUILDING - LEVEL 02	S-722.01	SECTIONS AND DETAILS, FIXED BUILDING LEVEL 02 - I
S-104.01	FRAMING PLAN, FIXED BUILDING - LEVEL 04	S-723.01	SECTIONS AND DETAILS, FIXED BUILDING LEVEL 02 - II
S-106.01	FRAMING PLAN, FIXED BUILDING - LEVEL 06	S-724.01	SECTIONS AND DETAILS, FIXED BUILDING L04 TO L08 - I
S-108.01	FRAMING PLAN, FIXED BUILDING - LEVEL 08	S-725.01	SECTIONS AND DETAILS, FIXED BUILDING L04 TO L08 - II
S-109.01	FRAMING PLAN, FIXED BUILDING - LEVEL 09/ROOF	S-726.01	SECTIONS AND DETAILS, FIXED BUILDING LEVEL 09/ROOF
S-110.01	FRAMING PLAN, FIXED BUILDING SLED DRIVE AND BMU TRACK	S-727.01	SECTIONS AND DETAILS, FIXED BUILDING ROOF II
S-152.01	FRAMING PLAN, DEPLOYED SHED - MECHANICAL DECK	S-730.00	RAIL BASE DETAILS L02
S-153.01	FRAMING PLAN, DEPLOYED SHED - ROOF	S-750.01	DETAILS, DEPLOYED SHED NORTH/SOUTH TYPICAL WALL SECTIONS
S-154.01	FRAMING PLAN, DEPLOYED SHED - BMU TRACK	S-751.01	TYPICAL WALL PLATE THICKNESSES I
S-200 SERIES: FOUNDATION SCHEDULES, SECTIONS AND DETAILS			
S-201.00	TYPICAL SLAB ON GRADE DETAILS	S-752.01	TYPICAL WALL PLATE THICKNESSES II
S-210.00	FOUNDATION SECTIONS	S-753.01	MAIN VERTICAL WELD DETAILS
S-300 SERIES: ELEVATIONS AND BRACING DETAILS			
S-301.01	BRACING ELEVATIONS FIXED BUILDING I	S-754.01	MAIN DIAGONAL WELD DETAILS
S-302.01	BRACING ELEVATIONS FIXED BUILDING II	S-755.00	DETAILS, DEPLOYED SHED NORTH/SOUTH WALL NODES - I
S-303.01	BRACING ELEVATIONS FIXED BUILDING III	S-757.01	DEPLOYED SHED NORTH/SOUTH WALL - ATYPICAL ELEMENTS
S-304.01	BRACING ELEVATIONS FIXED BUILDING IV	S-758.01	DEPLOYED SHED NORTH/SOUTH WALL - TERTIARY ELEMENTS
S-310.00	SECTIONS FIXED BUILDING I	S-760.01	DETAILS, DEPLOYED SHED NORTH/SOUTH WALL - CURVED SECTIONS
S-311.00	SECTIONS FIXED BUILDING II	S-761.01	DETAILS, DEPLOYED SHED NORTH/SOUTH WALLS - CURVED SECTION DETAILS
S-312.00	SECTIONS, FIXED BUILDING III	S-763.01	DETAILS, DEPLOYED SHED NORTH/SOUTH WALLS - E-W TRUSSES
S-320.00	TYPICAL BRACED FRAME CONNECTION DETAILS I	S-764.01	DETAILS, DEPLOYED SHED DRIVE CONNECTION
S-321.00	TYPICAL BRACED FRAME CONNECTION DETAILS II	S-765.01	SHED TO BOGIE CONNECTION
S-351.01	ELEVATIONS, DEPLOYED SHED	S-766.01	SHED TO BOGIE DETAILS
S-352.01	SECTIONS, DEPLOYED SHED	S-768.01	DETAILS, DEPLOYED SHED NORTH/SOUTH WALLS - N-S TRUSSES
S-354.01	TRUSS SECTIONS	S-770.01	DETAILS DEPLOYED SHED EAST WALL I
S-355.01	TRUSS SECTIONS	S-771.01	DETAILS DEPLOYED SHED EAST WALL II
S-400 SERIES: TRUSS, CASTELLATED BEAM AND STRONG POINT DETAILS			
S-401.01	FIXED BUILDING TRUSS ELEVATIONS AND DETAILS	S-772.01	DETAILS, DEPLOYED SHED EAST WALL
S-402.01	CASTELLATED BEAM ELEVATIONS AND DETAILS	S-773.01	DETAILS, DEPLOYED SHED EAST PORTAL TYPICAL SECTIONS
S-403.00	SOUTH LEVEL 02 CABLE WALL SUPPORT BEAM	S-774.01	DETAILS, DEPLOYED SHED EAST PORTAL - NODES
S-410.01A	STRONG POINT SUPPORT FRAMING PLAN, FIXED BUILDING LEVEL 04	S-785.01	DETAILS, DEPLOYED SHED - MECHANICAL DECK
S-410.01B	STRONG POINT SUPPORT FRAMING PLAN, FIXED BUILDING LEVEL 06	S-786.00	DETAILS, DEPLOYED SHED MECHANICAL DUCTWORK
S-411.01	STRONG POINT SUPPORT FRAMING PLAN, FIXED BUILDING LEVEL 08	S-790.01	DEPLOYED SHED NORTH/SOUTH WALL - QUAD MEMBERS
S-412.01	TYPICAL STRONG POINT SUPPORT FRAMING DETAILS	S-791.00	DEPLOYED SHED NORTH/SOUTH WALL - QUAD CONNECTIONS
S-413.00	TYPICAL DETAILS FOR MOVABLE PARTITION SUPPORTS AT GALLERY 2	S-794.01	DEPLOYED SHED EAST WALL - QUAD MEMBER
S-421.01	BRIDGING ELEVATIONS AND DETAILS	S-798.01	DEPLOYED SHED -DEAD LOAD DEFLECTIONS I
S-500 SERIES: STRUCTURAL MODIFICATION PART PLANS AND DETAILS			
S-500.01	DEMOLITION AND INFILL PLAN, FIXED BUILDING LEVEL 00	S-799.01	DEPLOYED SHED -DEAD LOAD DEFLECTIONS II
S-501.01	MODIFICATION PART PLANS AND DETAILS, FIXED BUILDING LEVEL 00 - I	S-800 SERIES: DOORS AND KINETICS	
S-502.01	MODIFICATION PART PLANS AND DETAILS, FIXED BUILDING LEVEL 00 - II	S-801.00	DEPLOYED SHED NORTH & SOUTH DOORS - LAYOUT
		S-802.01	DEPLOYED SHED NORTH & SOUTH DOORS - FRAMING
		S-803.01	DEPLOYED SHED NORTH & SOUTH DOORS - DETAILS I
		S-804.00	DEPLOYED SHED NORTH AND SOUTH DOORS - CONNECTION FORCES
		S-811.00	DEPLOYED SHED EAST DOORS - LAYOUT
		S-812.01	DEPLOYED SHED EAST DOORS - FRAMING
		S-813.00	DEPLOYED SHED EAST DOORS - DETAILS I
S-900 SERIES: COLUMN SCHEDULES AND DETAILS			
S-901.01	FIXED BUILDING COLUMN SCHEDULE		
S-902.01	TYPICAL STEEL COLUMN DETAILS		

ARCHITECTS
Olin Scaife + Renfro Architects, PC
601 West 26 Street #815
New York, New York 10001
T: 212.260.7971

STRUCTURAL ENGINEER
Thornton Tomasetti
51 Madison Avenue
New York, New York 10010
T: 917.661.7800
F: 917.661.7801

MEP ENGINEER
Jans Baum & Bolles
60 Park Street
New York, New York 10005
T: 212.530.9300
F: 212.260.6964

MEP ENGINEER
Jans Baum & Bolles
60 Park Street
New York, New York 10005
T: 212.530.9300
F: 212.260.6964


MEP ENGINEER
Jans Baum & Bolles
60 Park Street
New York, New York 10005
T: 212.530.9300
F: 212.260.6964

MEP ENGINEER
Jans Baum & Bolles
60 Park Street
New York, New York 10005
T: 212.530.9300
F: 212.260.6964

MEP ENGINEER
Jans Baum & Bolles
60 Park Street
New York, New York 10005
T: 212.530.9300
F: 212.260.6964

MEP ENGINEER
Jans Baum & Bolles
60 Park Street
New York, New York 10005
T: 212.530.9300
F: 212.260.6964

KEY PLAN

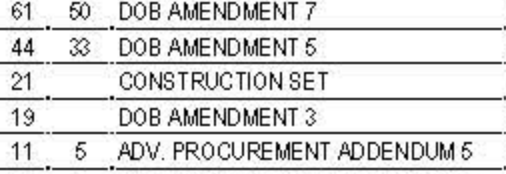

ISSUE	PRINTING	DATE
01	01	08/19/2016
02	02	08/19/2016
03	03	08/19/2016
100	100	08/19/2016

STAMP



GEOMETRY, DIMENSIONS AND SURFACE CONTOURING, BLENDING AND INTERSECTION OF SECTIONS ILLUSTRATED IN THE STRUCTURAL DRAWINGS ARE PROVIDED FOR REFERENCE AND GENERATION OF STRUCTURAL ARRANGEMENT AND DETAILS ONLY. THE 3D MODEL ISSUED BY THE ARCHITECT DEFINES THE EXTERIOR SURFACE AND SHALL BE ADHERED TO FOR THE FINAL GEOMETRY. FOR DETAILS OF SECONDARY STEEL, INCLUDING STRUCTURAL CLADDING REFER TO ARCHITECTURE DRAWINGS. IT IS THE RESPONSIBILITY OF THE CONTRACTOR TO IDENTIFY ANY DISCREPANCIES OR AMBIGUITIES FOR DISCUSSION, RESOLUTION AND DIRECTION FROM THE ARCHITECT AND SER.

ARCHITECTS
Oller Scaffolds + Renfro Architects, DPC
601 West 26 Street #815
New York, New York 10001
T: 212.260.7971

rockwellgroup
5 Union St. West, 6th Fl.
New York, New York 10003
T: 212.463.0334
F: 212.463.0335

STRUCTURAL ENGINEER
Thornton Tomasetti
51 Madison Avenue
New York, New York 10010
T: 917.661.7800
F: 917.661.7801

MEP ENGINEER
Jans Baum & Bolles
63 Park Street
New York, New York 10005
T: 212.530.9300
F: 212.265.6944

FACADE CONSULTANT
Thornton Tomasetti
51 Madison Avenue
New York, New York 10010
T: 917.661.7800
F: 917.661.7801

KINETICS ENGINEER
Hardisty & Hancock
1501 Broadway
New York, New York 10036
T: 212.944.1150
F: 212.391.0297

LIGHTING DESIGNER
Tilston Design Associates
40 North Street #1650
New York, New York 10013
T: 212.675.7760

THEATRE PLANNING & DESIGN
Fisher Dodge Associates
22 West 15th Street
New York, New York 10011
T: 212.691.3000

LIFE SAFETY
Code Consultants, Inc.
215 West 43rd St, 15th Fl.
New York, New York 10018
T: 212.216.9596

ENERGY MODEL/LEED
Vindian
63 Washington Street
Norwalk, CT 06854
T: 203.298.1411

ACOUSTIC/AUDIO-VISUAL
Avalon
93 North Main Street
South Norwalk, CT 06854
T: 347.210.5540

VERTICAL TRANSPORTATION
Van Duusen & Associates
5 Regent Street, Suite 524
Lakewood, NJ 07038
T: 973.994.9220

SPECIFICATIONS
Construction Specifications Inc.
PO Box 489
227 Avenue Road
Morganville, NJ 07751
T: 732.970.0700
F: 732.970.0700


SECURITY
Duchella Venter & Santoro
100 Sherman Avenue
Hartford, CT 06214
T: 203.286.6490

WATERPROOFING
James R. Galford AIA Consulting Architects PC
104 West 27th Street
New York, NY 10001
T: 212.736.3344

FACADE MAINTENANCE
Erick Engineering PLLC
166 Ave. Street
New York, NY 10005
T: 212.698.3000

BRANDING GRAPHICS
2nd Global Design Consultancy
180 York Street 15th Floor
New York, NY 10014
T: 212.647.1170

KEY PLAN

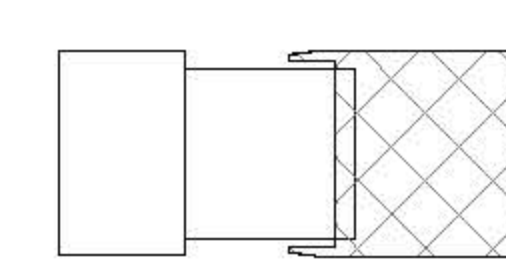

ISSUE

NO.	DESCRIPTION	DATE
01	ISSUE	
02	DOB AMENDMENT 7	03.29.2016
03	DOB AMENDMENT 6	04.09.2016
04	CONSTRUCTION SET	10.08.2015
05	100% CONSTRUCTION DOCUMENTS	03.18.2015
06	90% CONSTRUCTION DOCUMENTS	02.16.2015
07	PRELIMINARY DOB SUBMISSION	12.16.2014
08	ADVANCED PROCUREMENT BID SET	06.16.2014

STAMP



DRAWN BY
Autum

CHECKED BY
Chris


PROJECT NUMBER
N1318.00

TITLE
STEEL TOLERANCES - GLOBAL


DRAWING NO.
S-005.01

B.SCAN NO.
S-005.01


4 of 123

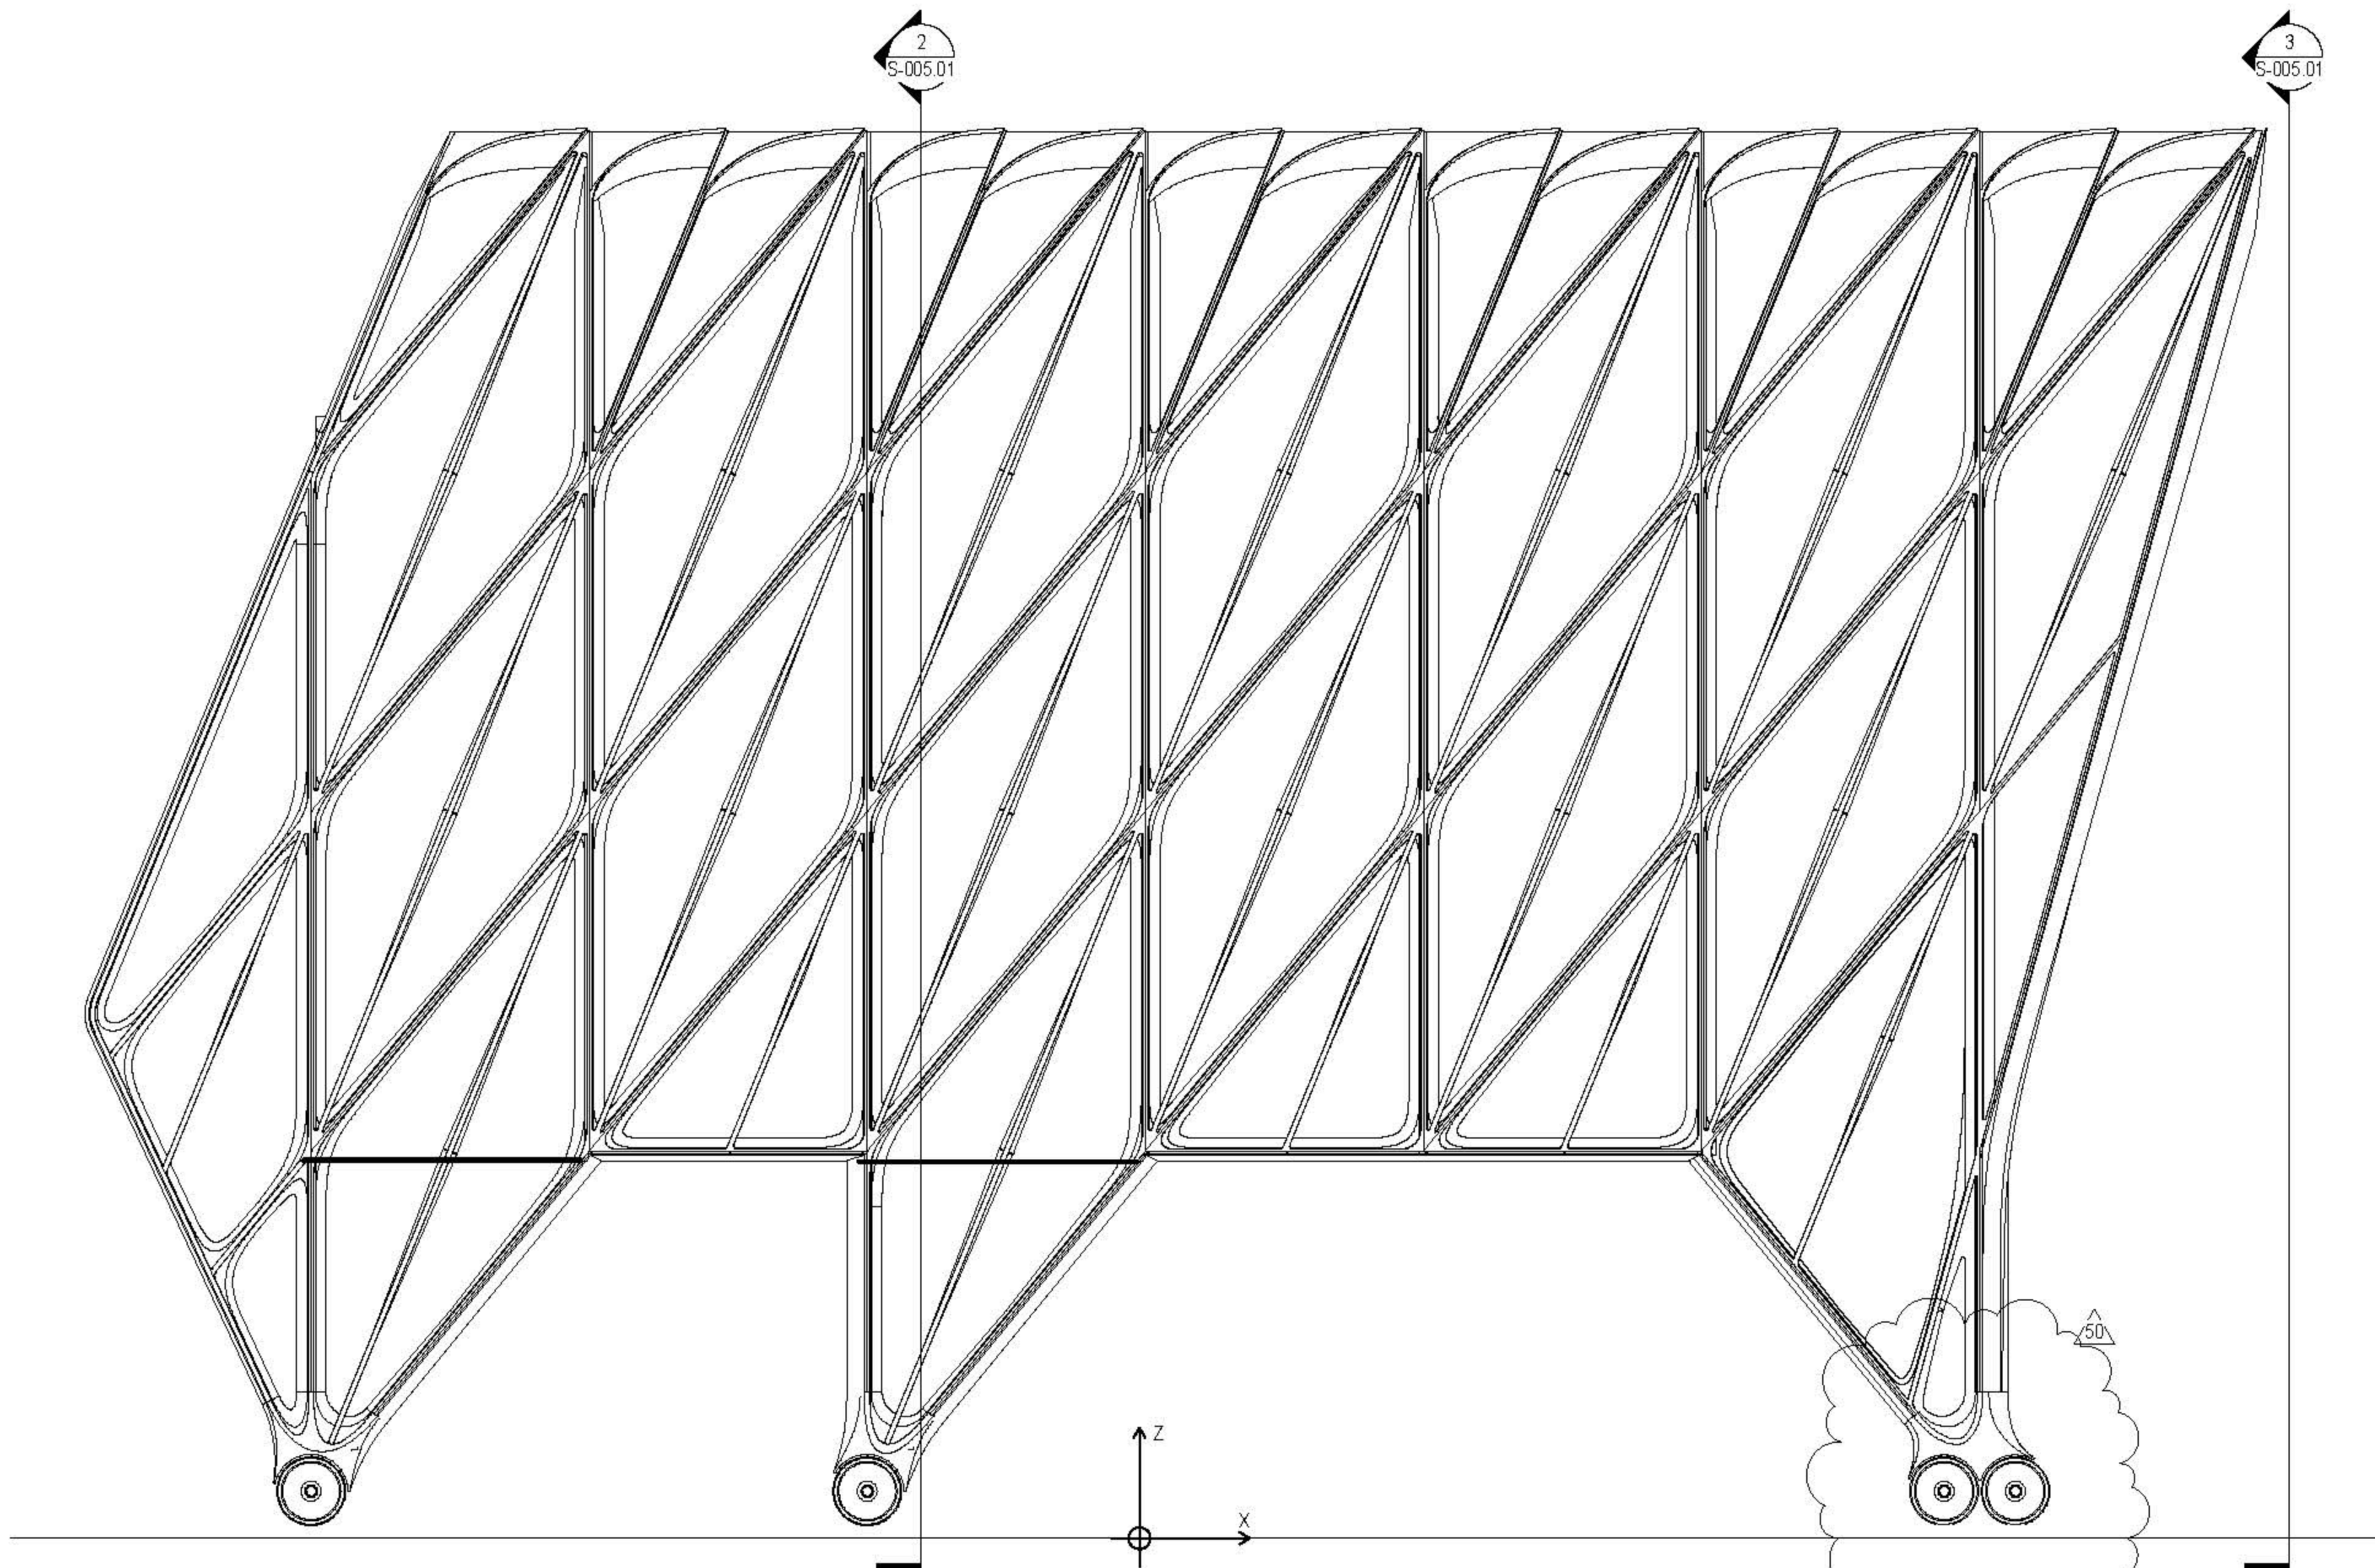

1 SOUTH ELEVATION
3/32" = 1'-0"

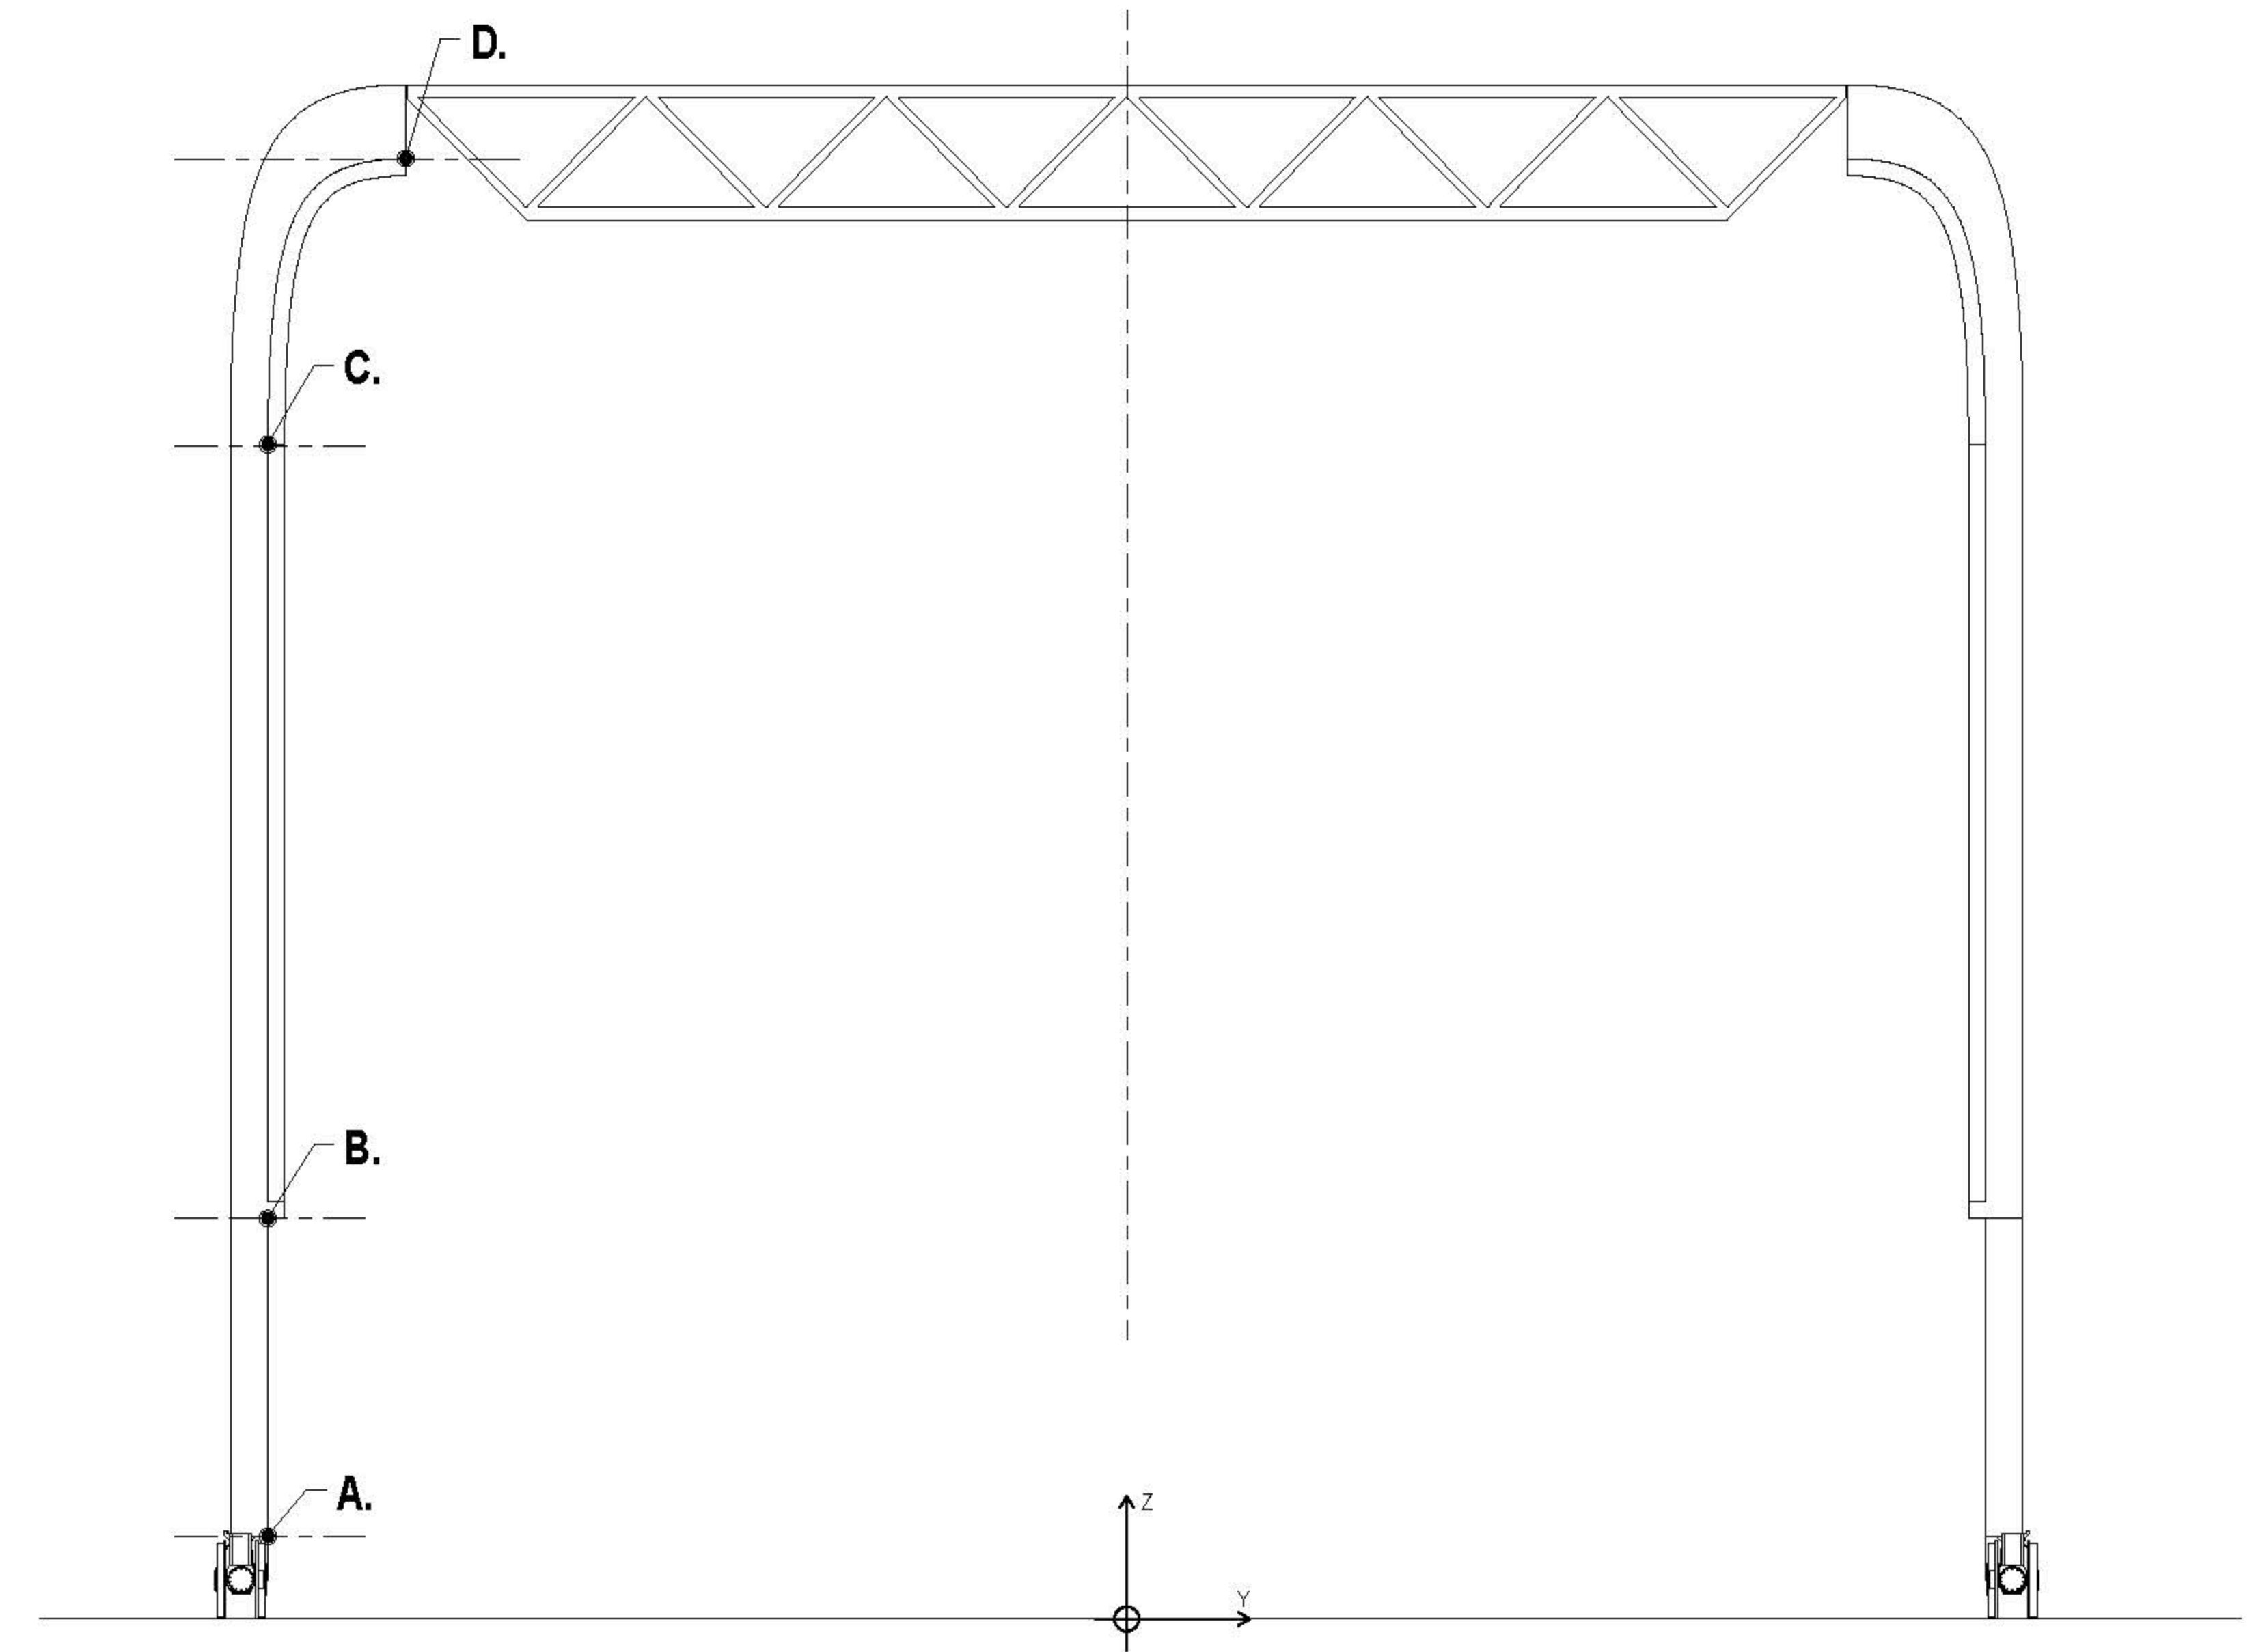

2 SECTION 01
3/32" = 1'-0"

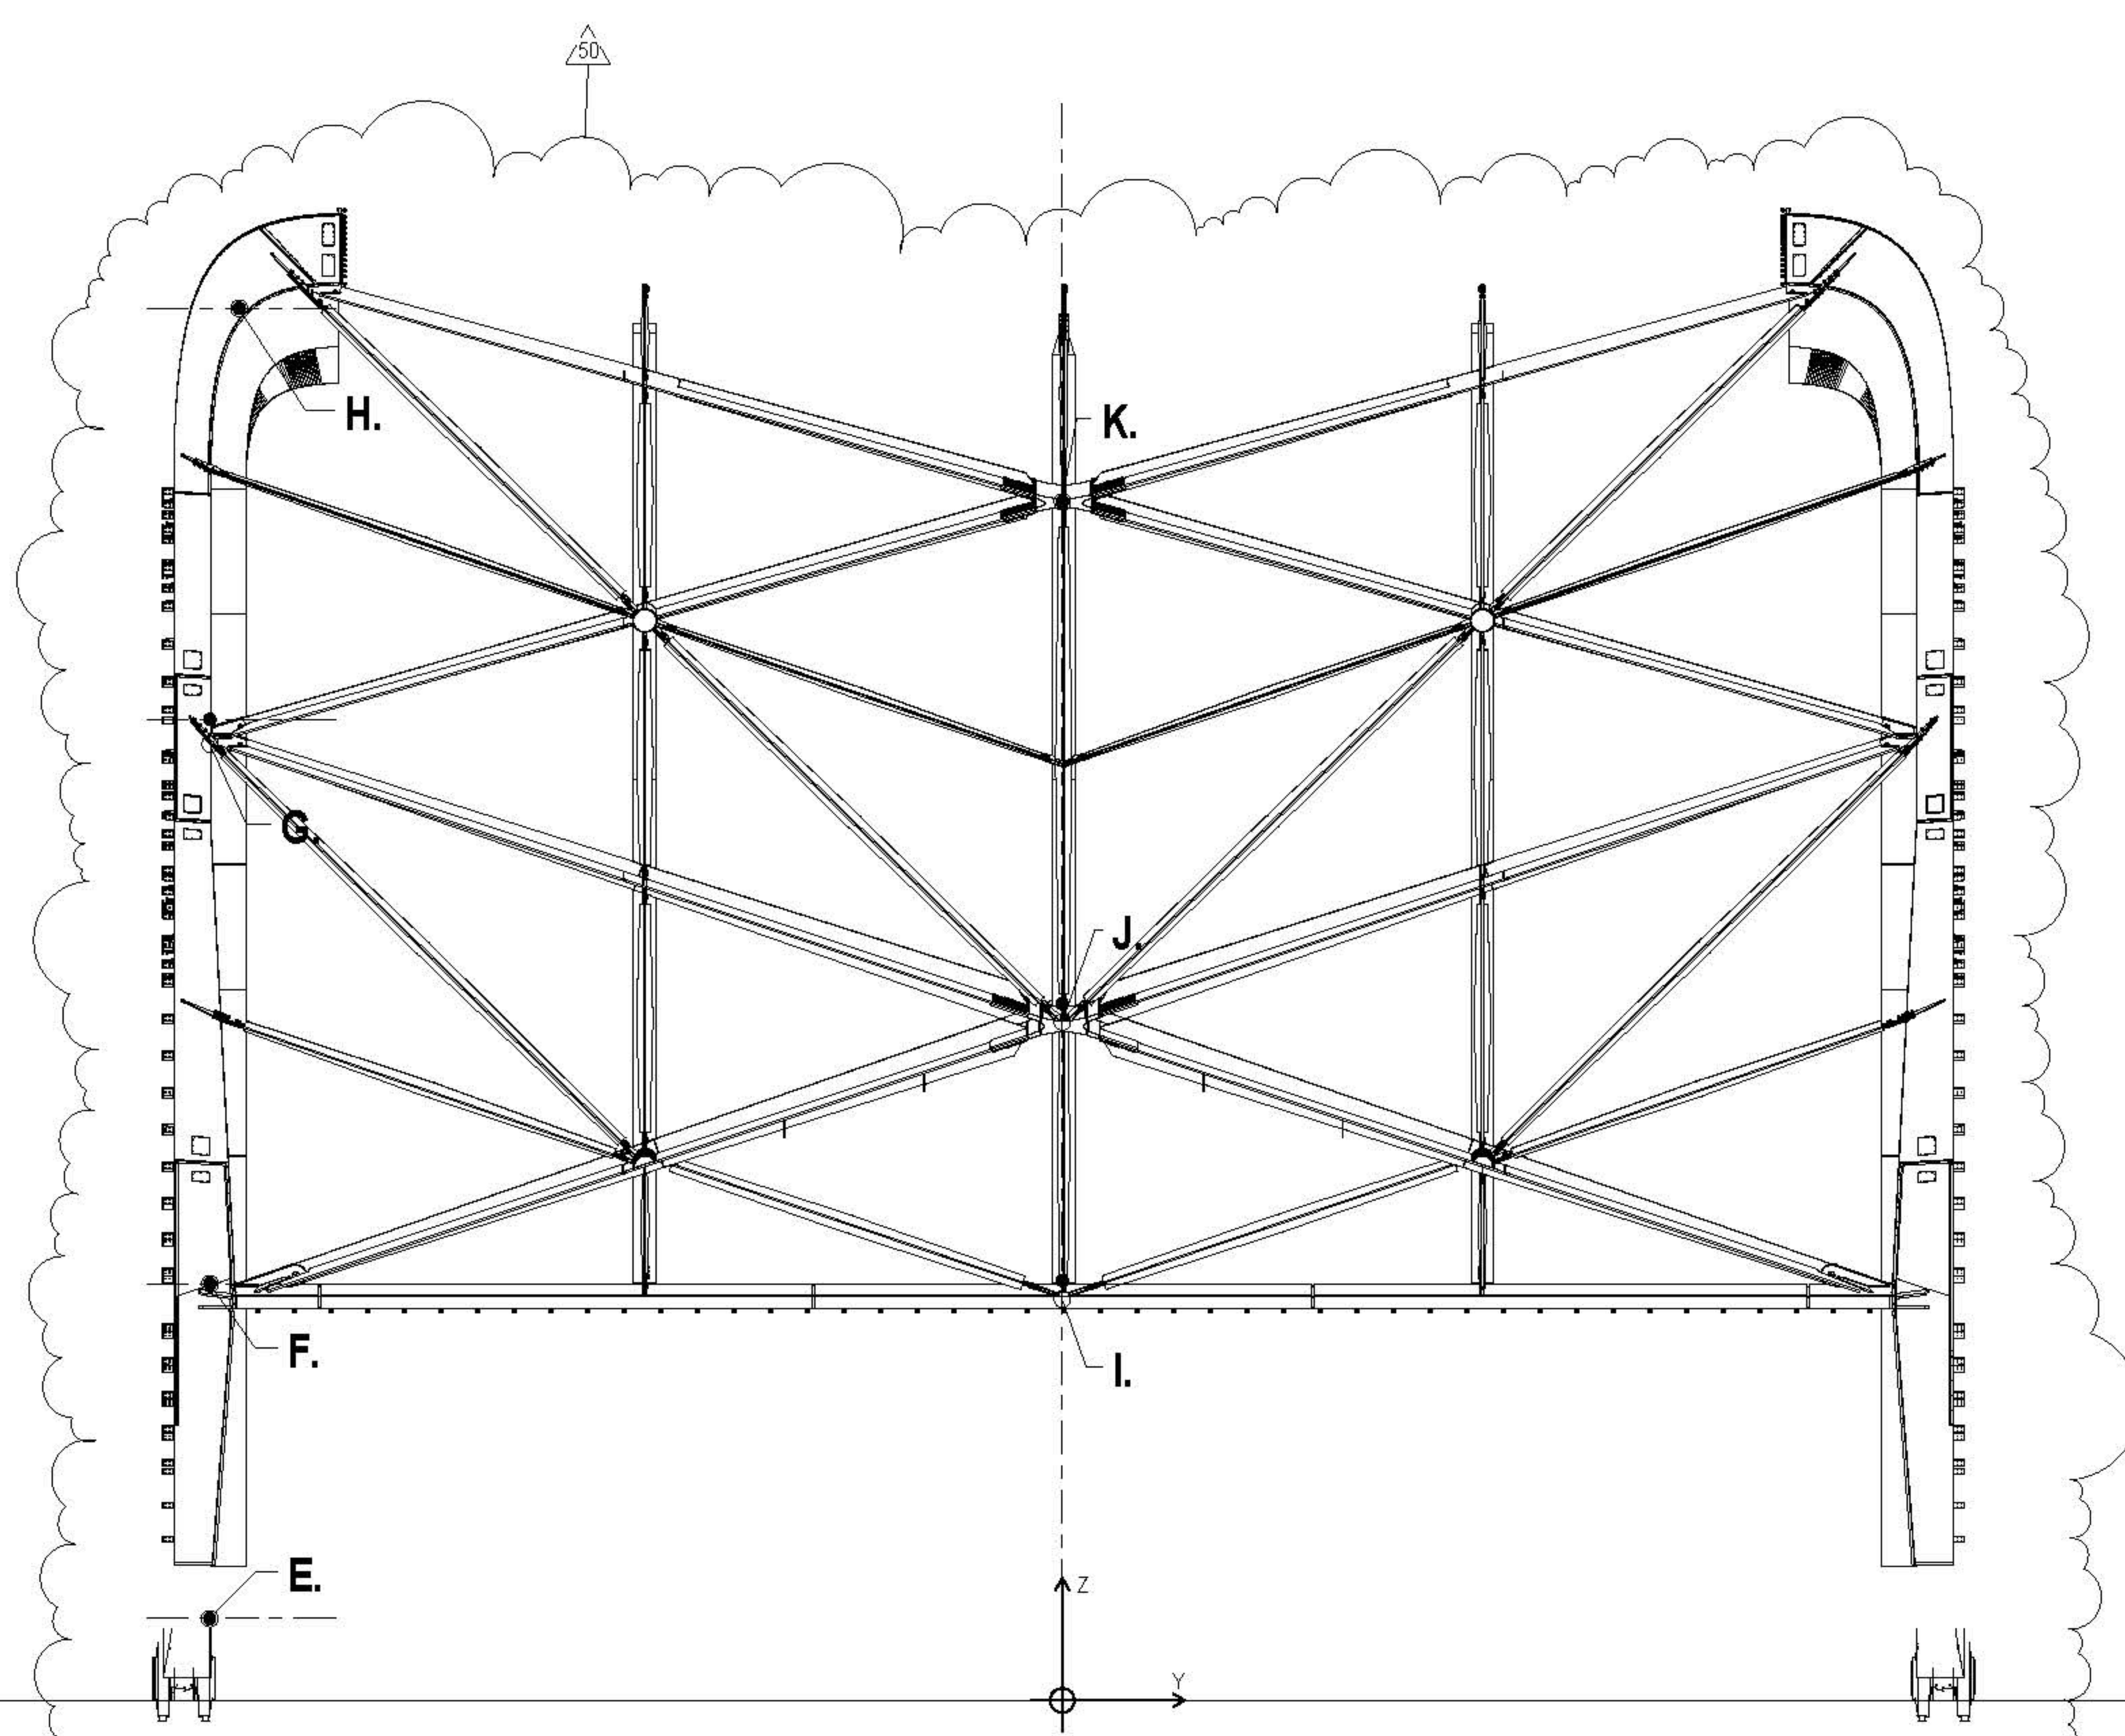


3 EAST PORTAL
3/32" = 1'-0"

GLOBAL TOLERANCE (in)				
POINT	X	Y	Z	ABSOLUTE
A	0.1	0.1	0.1	0.16
B	0.35	0.35	0.30	0.60
C	1.25	1.0	1.25	2.0
D	1.50	1.0	1.50	2.25
E	0.1	0.1	0.1	0.16
F	0.35	0.35	0.30	0.60
G	1.25	1.0	1.25	2.0
H	1.50	1.0	1.50	2.25
I	0.35	0.35	0.30	0.60
J	0.75	0.75	0.75	1.25
K	1.0	1.0	1.0	1.50

- NOTES**
1. GLOBAL TOLERANCE ASSUMED TO BE SYMMETRIC
 2. ASSUME LINEAR VARIATION BETWEEN POINTS
 3. REFER TO TOLERANCE SHEETS S-005.00 - S-010.00 FOR LOCAL TOLERANCES
 4. GLOBAL AND LOCAL TOLERANCES ARE NOT CUMULATIVE
 5. TOLERANCES ARE TOTAL TO FABRICATION AND ERECTION

GENERAL NOTES

- Sheets S-005 through S-009 illustrate project specific tolerances for the fabrication and installation of Shed steelwork.
- These drawings are to be read in conjunction with the steel specification and supersede the main specification where a tighter tolerance is specified. In the event the main specification exhibits tighter control the main specification then supersedes these drawings.
- Any discrepancies or ambiguities are to be raised by the contractor for discussion with the Architect and EIR.
- The drawings provide general tolerances for the global structure, element tolerances between nodes and local tolerances for each typical section.
- Typical sections are drawn for the North & South Wall main verticals, diagonals and East Wall and Portal.
- Unless otherwise stated the specified tolerances for the main diagonals will apply to all sections on the North & South Walls.
- Unless otherwise stated the specified tolerances for the typical East Wall and Portal section will apply to all sections on the North & South Walls.
- Steelwork in the mechanical deck and roof is considered within the main specification and standard code of practice however we note that ornamental steelwork/mechanical ductwork steelwork attached to the underside of the trusses shall follow the specified tolerances of the mechanical ductwork shown in the typical main vertical section.

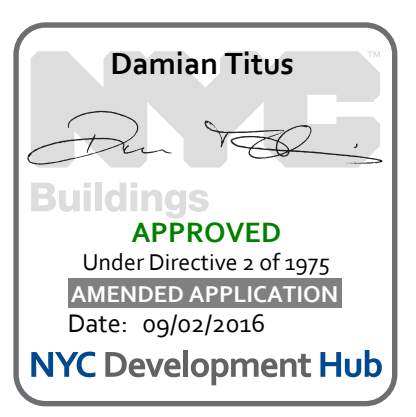

CULTURE SHED
545 West 30th Street
New York, New York 10001

OWNER
CULTURE SHED INC

ARCHITECTS
Oller Scifidio + Renfro Architects, D.P.C.
601 West 28 Street #815
New York, New York 10001
T: 212.260.7971

rockwellgroup
5 Union Sq West, 8th Flr
New York, New York 10003
T: 212.463.0334
F: 212.463.0335

STRUCTURAL ENGINEER
Thornton Tomasetti
51 Madison Avenue
New York, New York 10010
T: 917.861.7800
F: 917.861.7801

MEP ENGINEER
Jaros Baum & Bolles
60 Pine Street
New York, New York 10005
T: 212.530.8300
F: 212.260.9864

FACADE CONSULTANT
Thornton Tomasetti
51 Madison Avenue
New York, New York 10010
T: 917.861.7800
F: 917.861.7801

KINETICS ENGINEER
Hardisty & Hanover
1501 Broadway
New York, New York 10036
T: 212.844.1150
F: 212.391.0297

LIGHTING DESIGNER
Tilston Design Associates
40 Worth Street #190
New York, New York 10013
T: 212.875.7760

THEATRE PLANNING & DESIGN
Fisher Dachs Associates
22 West 18th Street
New York, New York 10011
T: 212.691.3000

LIFE SAFETY
Code Consultants, Inc.
215 West 40th St, 16th Flr
New York, New York 10018
T: 212.216.9596

ENERGY MODEL/LEED
Veridian
50 Washington Street
Norwalk, CT 06854
T: 203.298.1411

ACOUSTIC/AUDIO-VISUAL
Akoustiks
93 North Main Street
South Norwalk, CT 06854
T: 347.210.5540

VERTICAL TRANSPORTATION
Van Dusen & Associates
5 Regent Street, Suite 524
Livingston, NJ 07039
T: 973.994.9220

SPECIFICATIONS
Construction Specifications Inc.
PO Box 489
22 Tennell Road
Morganville, NJ 07751
T: 732.870.0700
F: 732.870.0700


SECURITY
Ducibella Venter & Santore
1020 Sherman Avenue
Hamden, CT 06514
T: 203.288.6490

WATERPROOFING
James R. Gairfort AIA Consulting Architects PC
104 West 27th Street
New York, NY 10001
T: 212.736.3344

FACADE MAINTENANCE
Erick Engineering PLLC
166 Area Street
New York, NY 10005
T: 212.898.3000

BRANDING/GRAPHICS
2nd Global Design Consultancy
180 Vande Street 15th Floor
New York, NY 10014
T: 212.647.1170

KEY PLAN

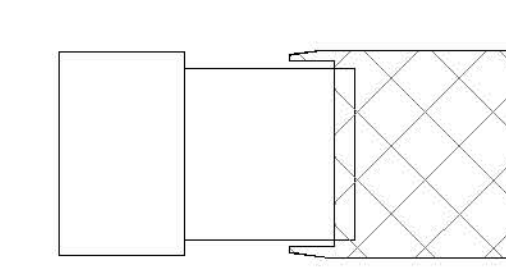

ISSUE PRINTING DATE

ISSUE	PRINTING	DATE	
61	50	DOB AMENDMENT 7	09/19/2018
48	38	DOB AMENDMENT 5	04/29/2018
21		CONSTRUCTION SET	10/29/2015
10	4	100% CONSTRUCTION DOCUMENTS	03/18/2015
9		90% CONSTRUCTION DOCUMENTS	02/10/2015
6		PRELIMINARY DESIGN SUBMISSION	12/10/2014
1		ADVANCED PROCUREMENT BID SET	06/18/2014

STAMP



DRAWN BY
Autrey

CHECKED BY
Checker

PROJECT NUMBER
N11318.00


TITLE
NIS WALL ELEMENTS - STEEL TOLERANCES

DRAWING NO.
S-006.01


B-SCAN NO.
S-006.01

5 of 123


GEOMETRY, DIMENSIONS AND SURFACE CONTOURING, BLENDING AND INTERSECTION OF SECTIONS ILLUSTRATED IN THE STRUCTURAL DRAWINGS ARE PROVIDED FOR REFERENCE AND GENERATION OF STRUCTURAL ARRANGEMENT AND DETAILS ONLY. THE 3D MODEL ISSUED BY THE ARCHITECT, DEFINES THE EXTERIOR SURFACE AND SHALL BE ADHERED TO FOR THE FINAL GEOMETRY. FOR DETAILS OF SECONDARY STEEL, INCLUDING STRUCTURAL CLADDING REFER TO ARCHITECTURE DRAWINGS. IT IS THE RESPONSIBILITY OF THE CONTRACTOR TO IDENTIFY ANY DISCREPANCIES OR AMBIGUITIES FOR DISCUSSION, RESOLUTION AND DIRECTION FROM THE ARCHITECT AND SER.

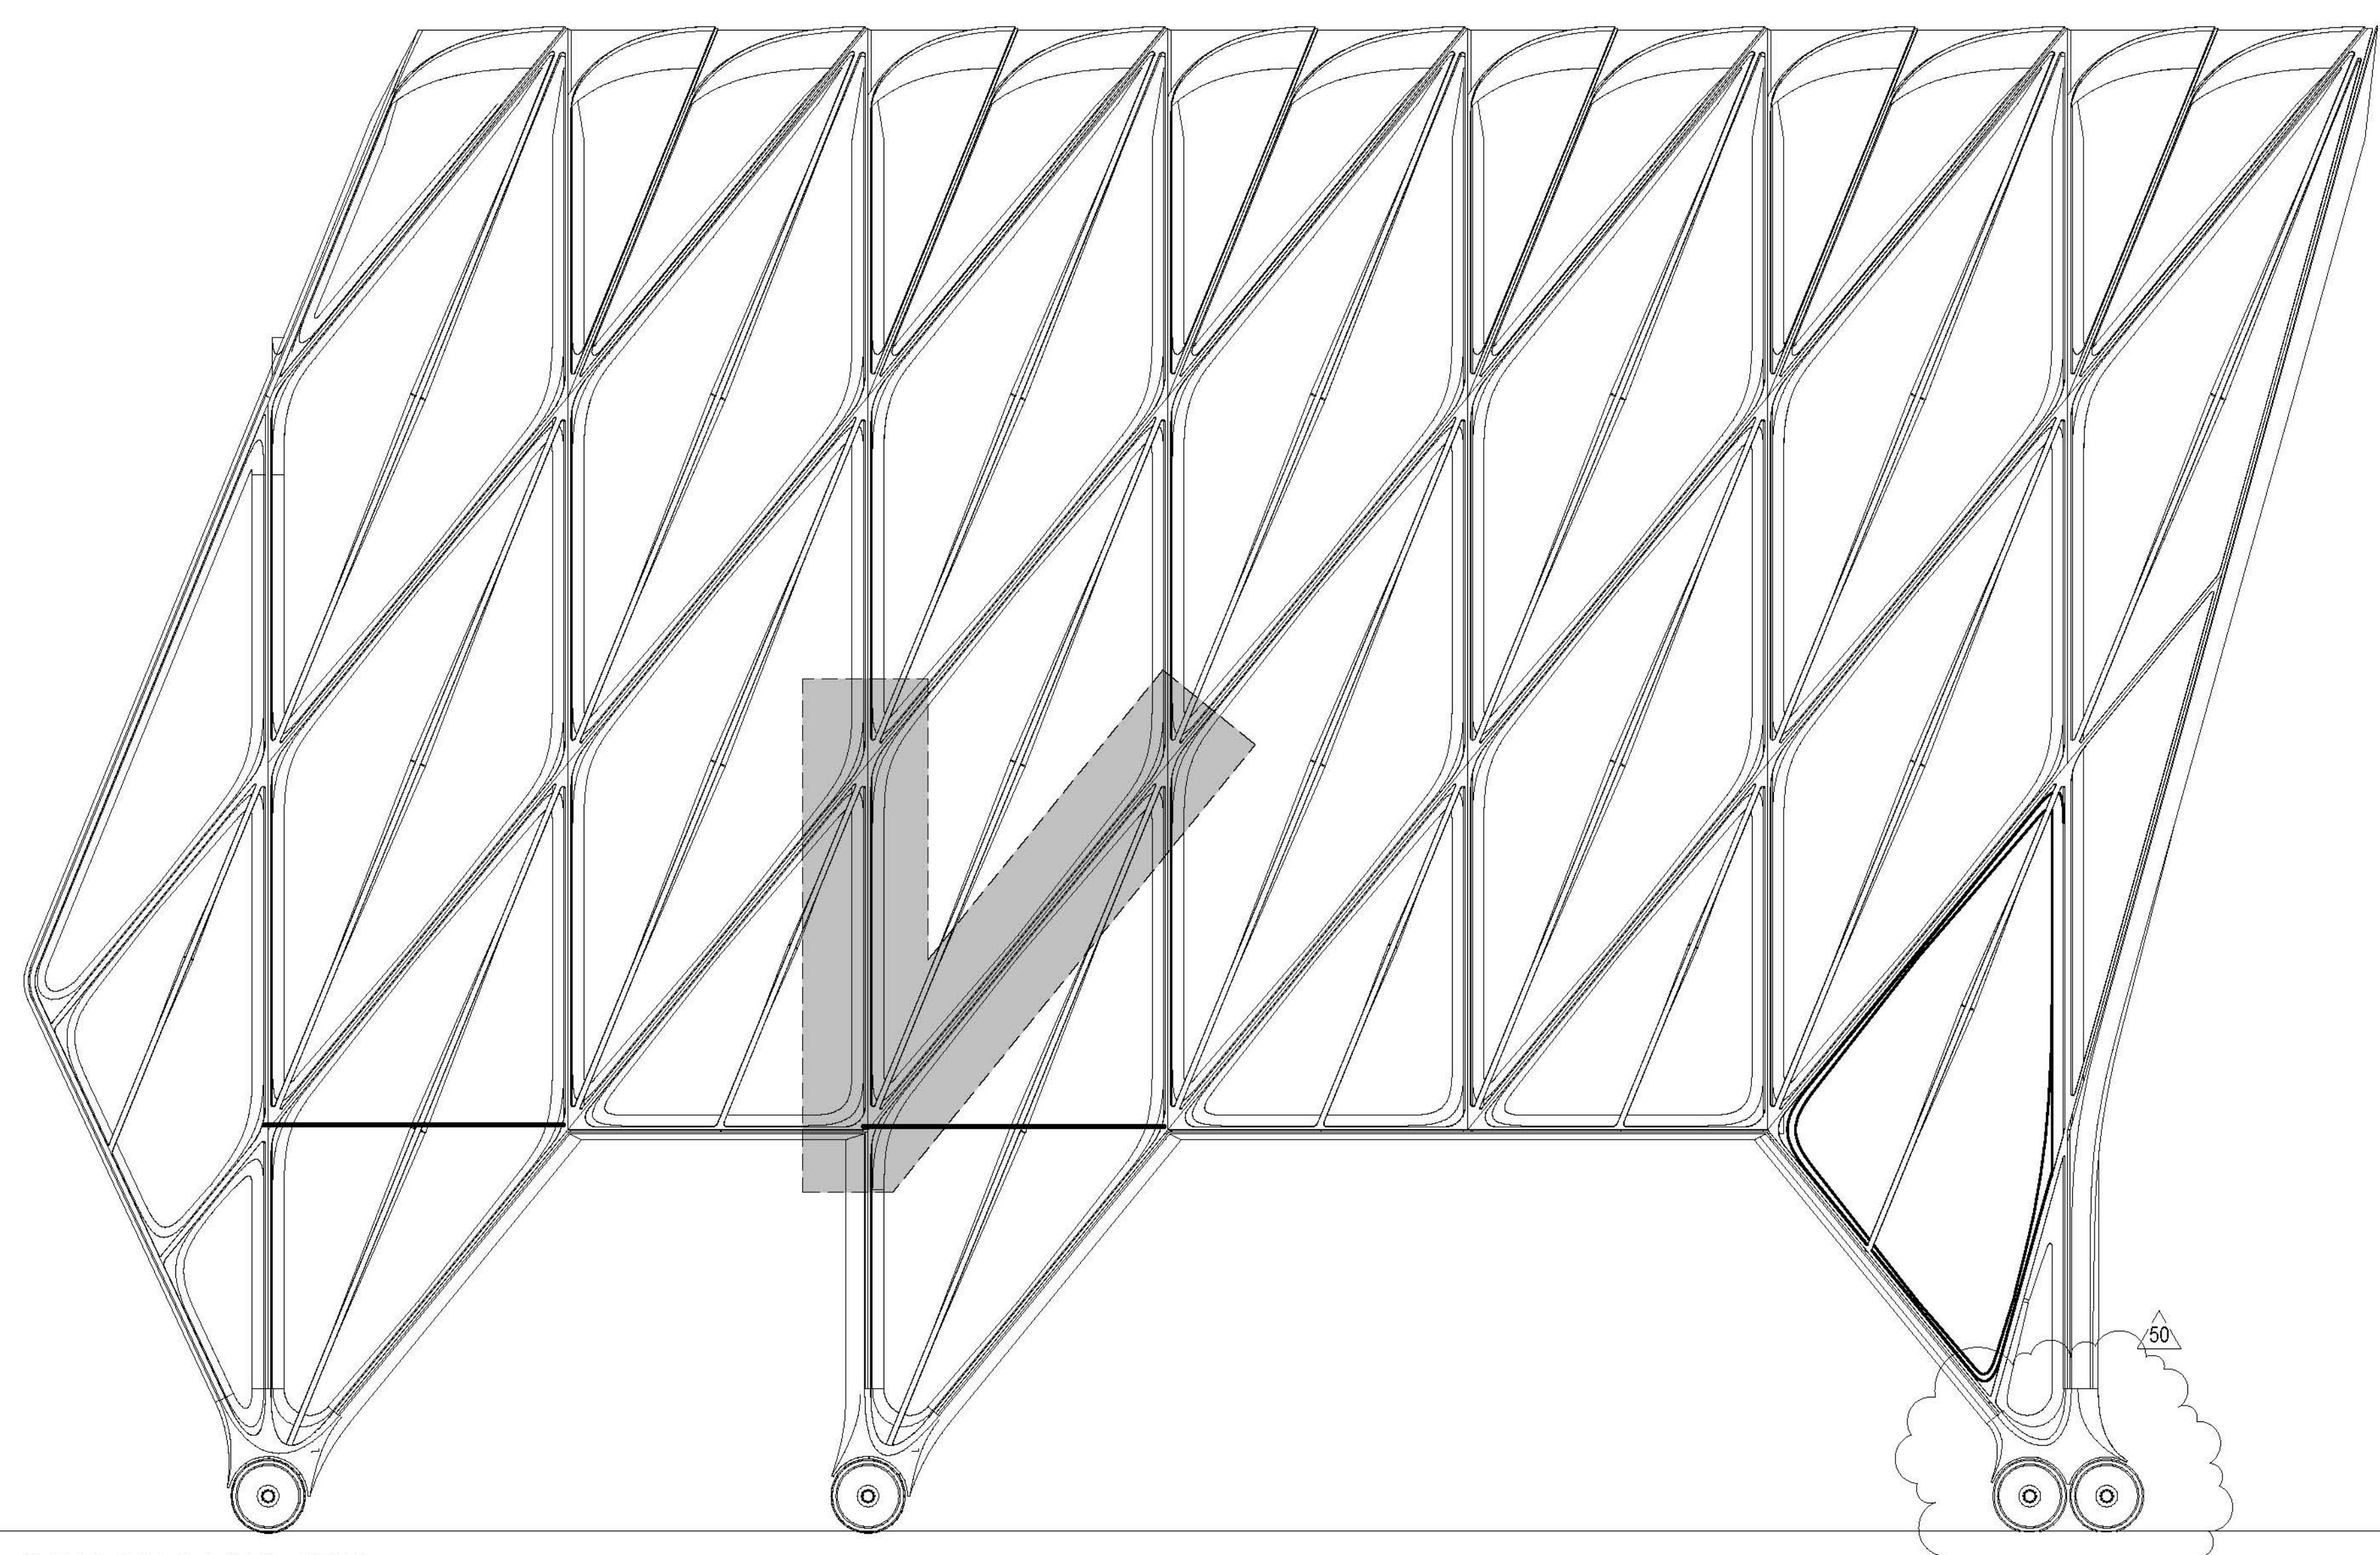

1 SOUTH ELEVATION
3/32" = 1'-0"


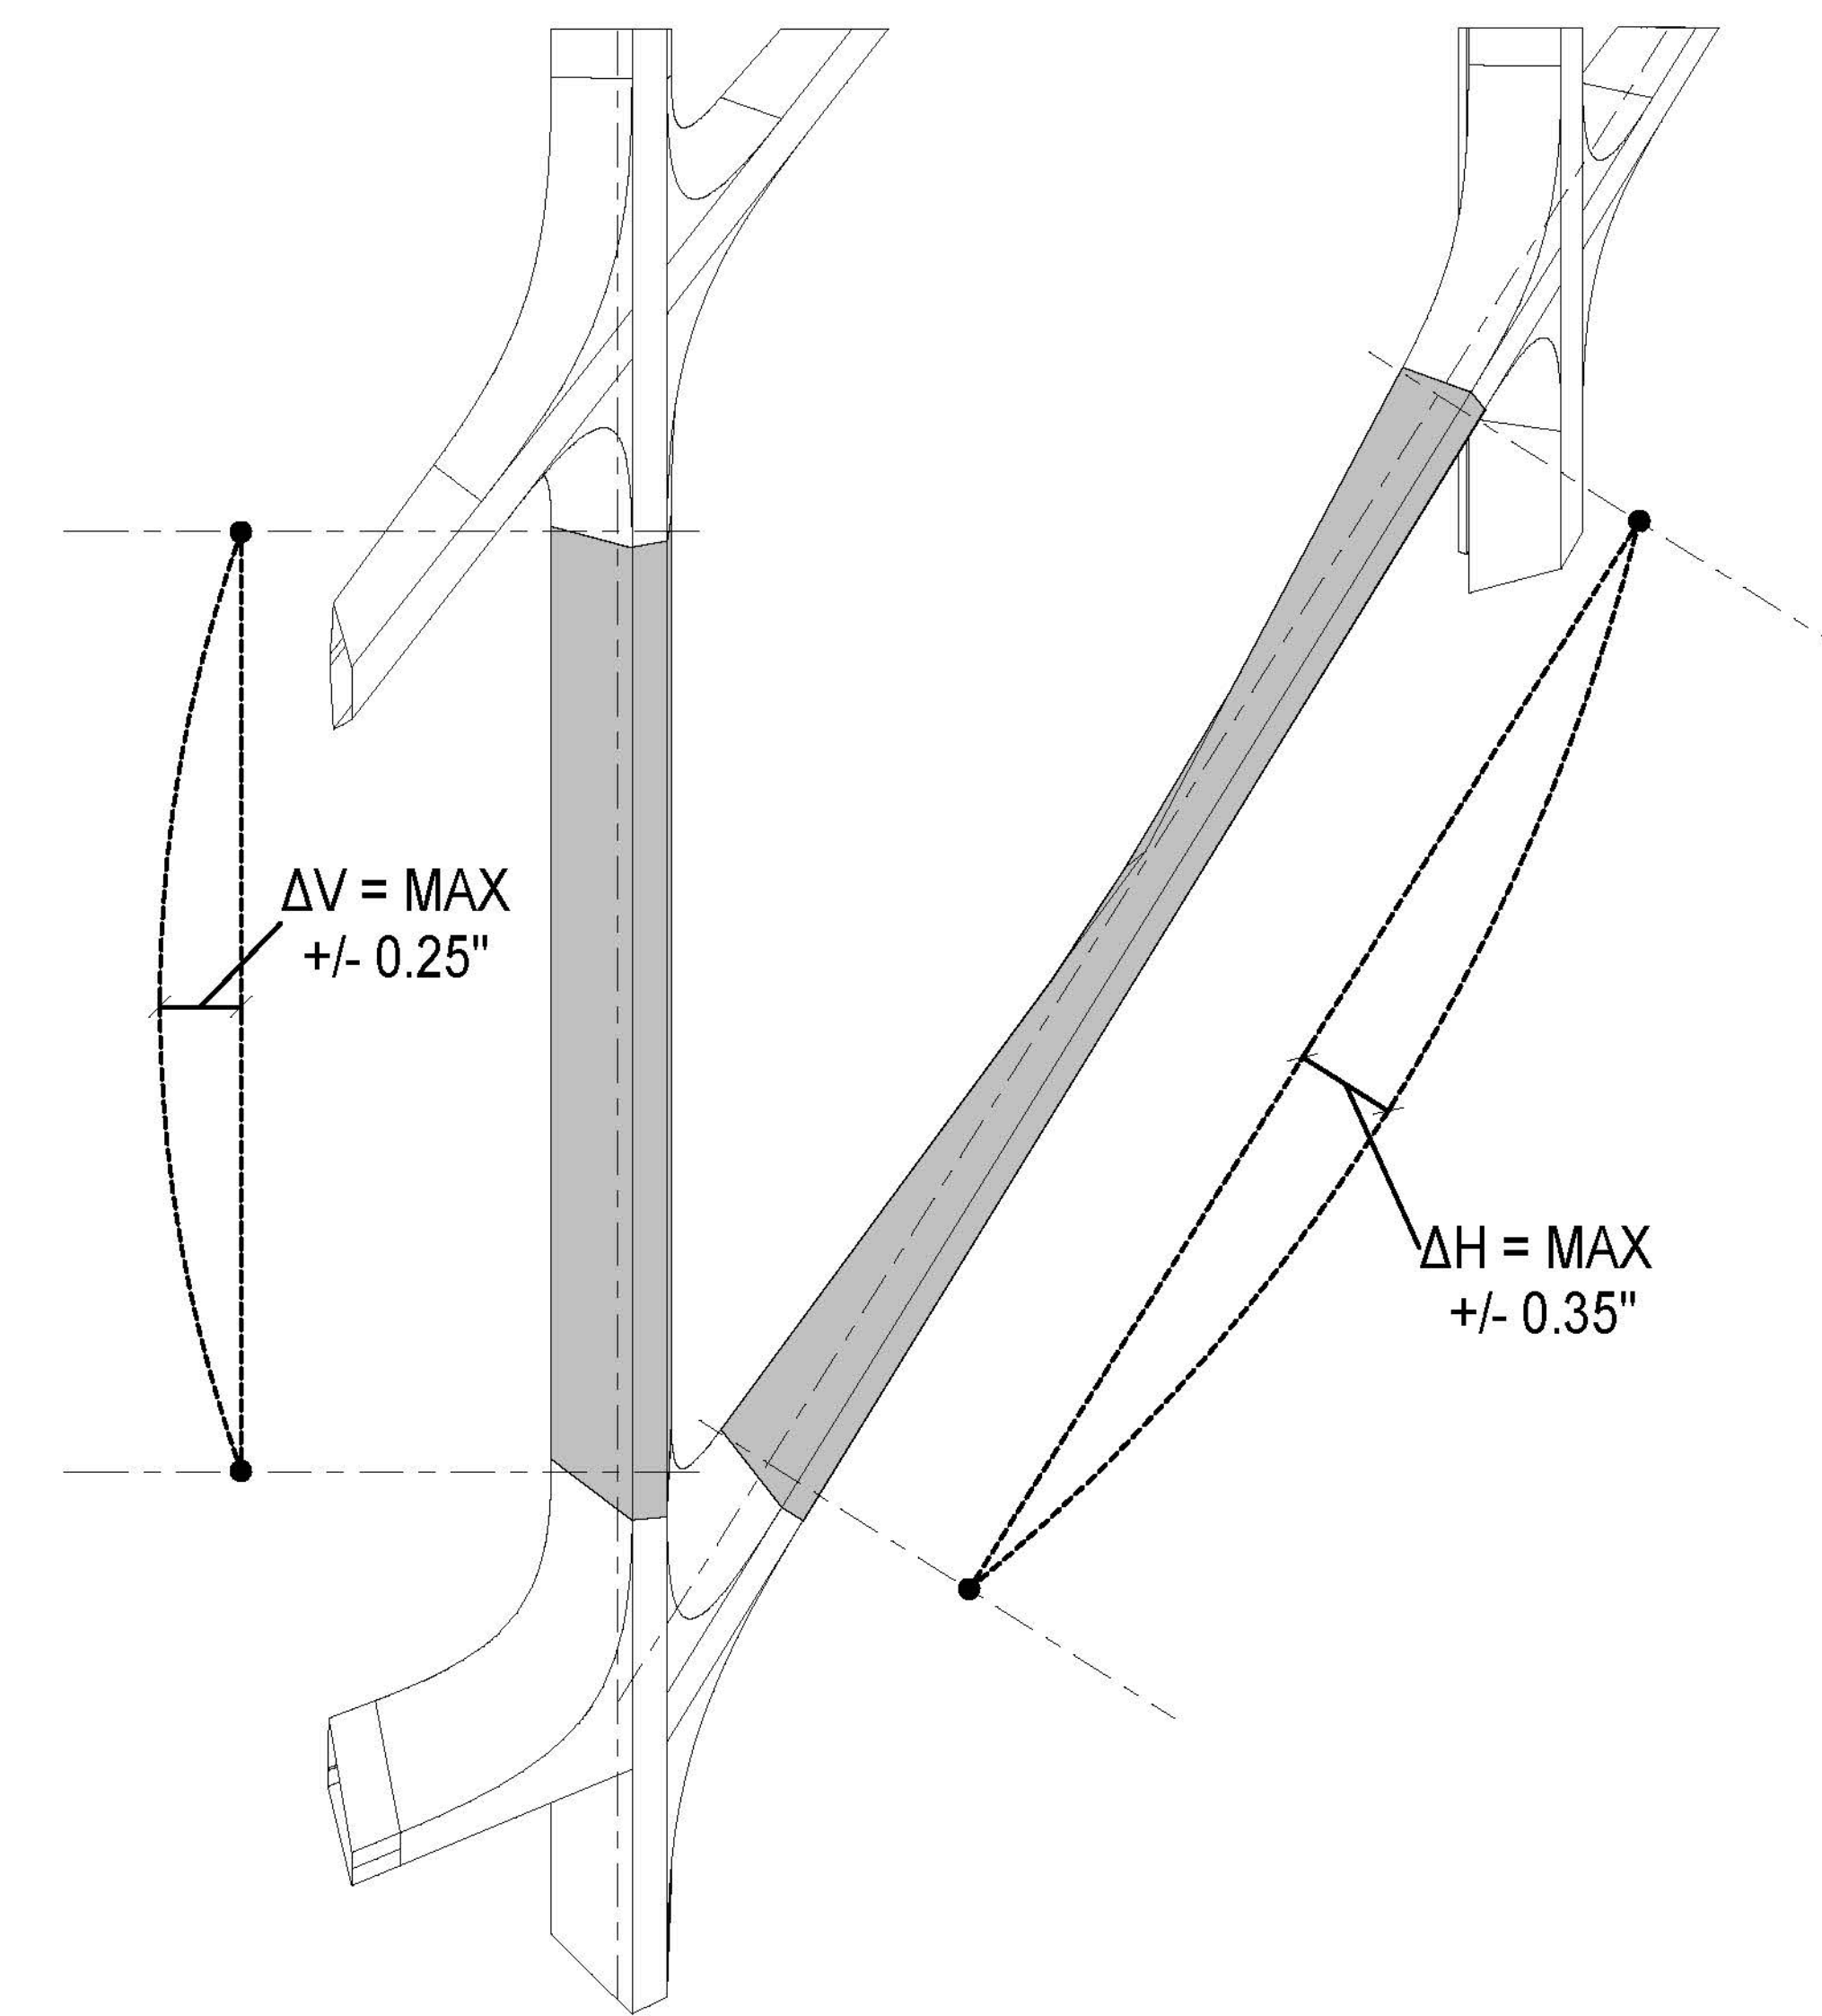


3 ELEMENTS BETWEEN NODES (TYP)
STRAIGHTNESS TOLERANCE
NOT TO SCALE

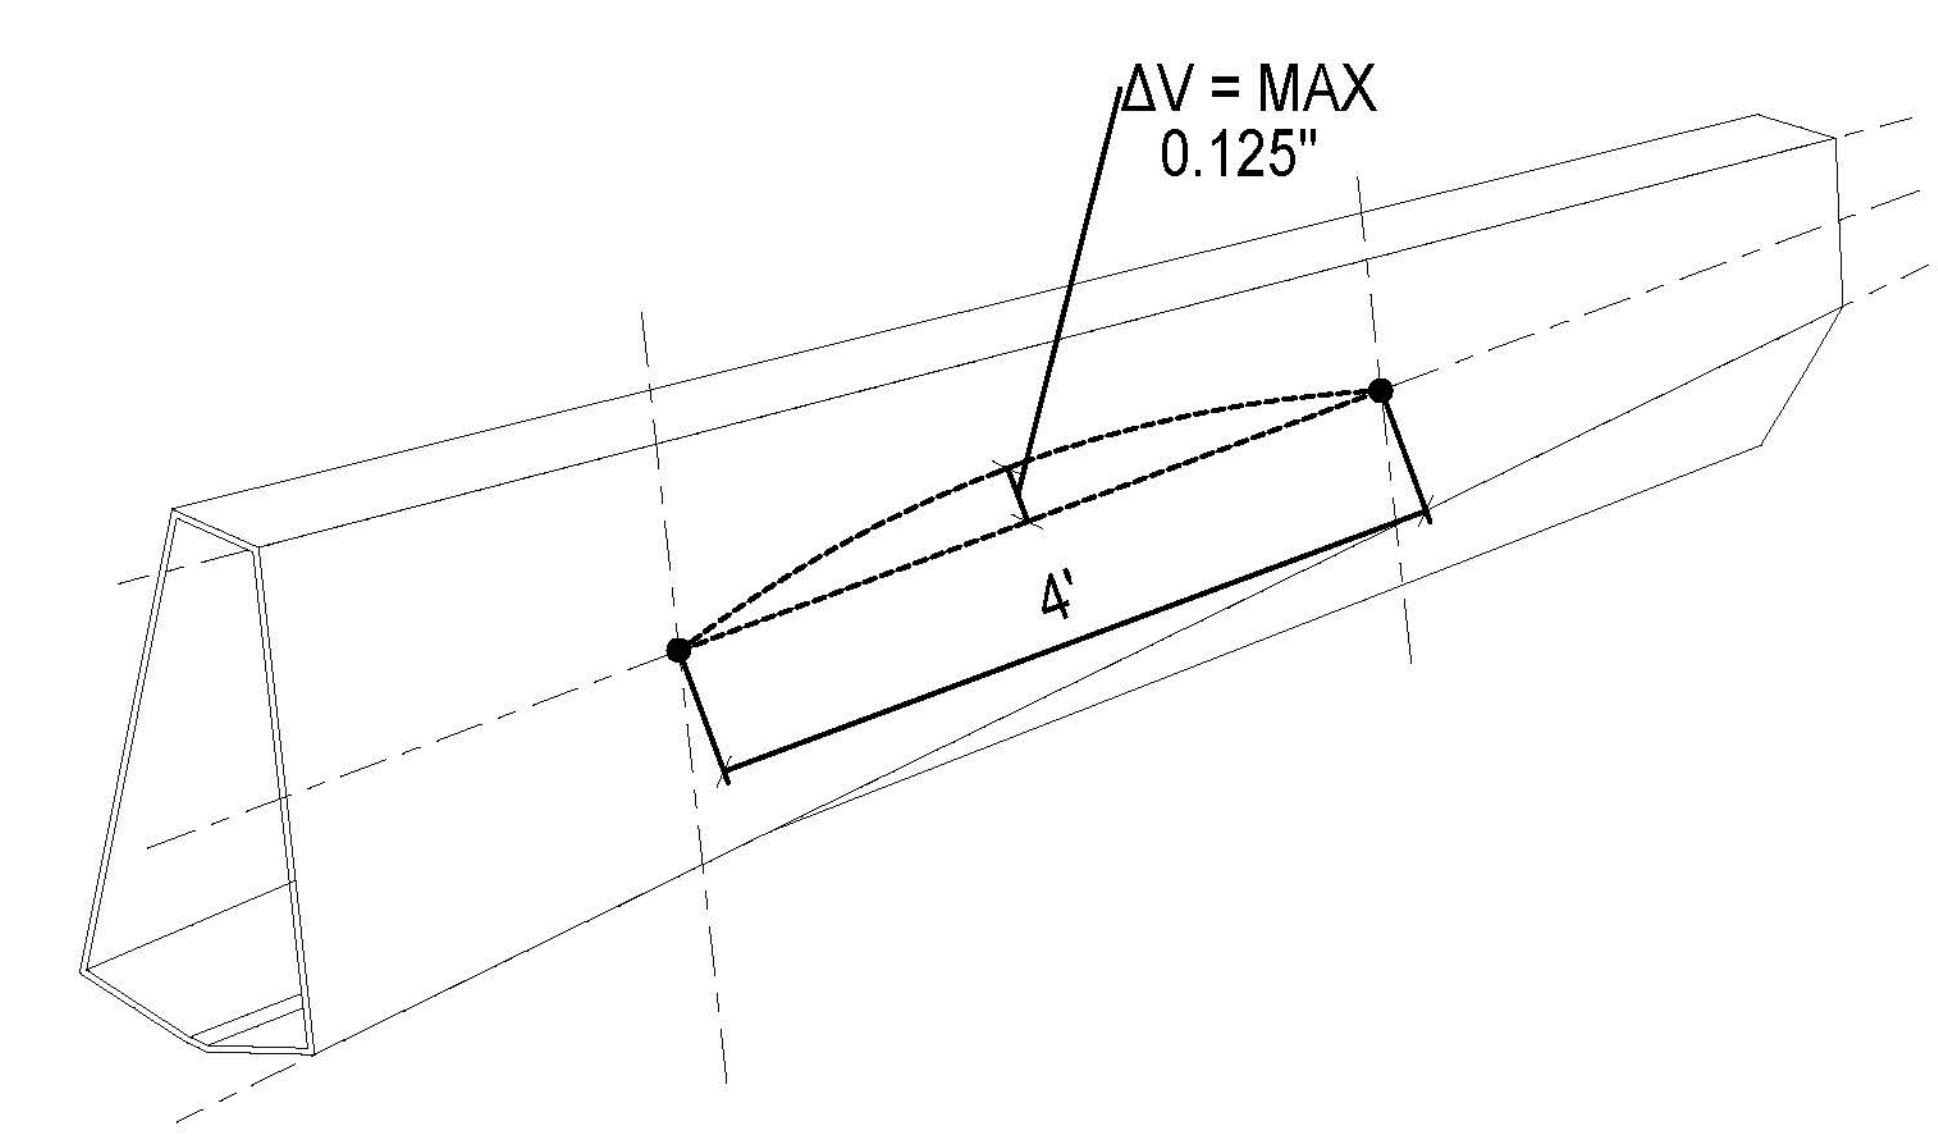

2 LOCAL PANEL TOLERANCE (TYP.)
3/8" = 1'-0"

NOTES:
1. INDEPENDENT OF LENGTH TOLERANCE EACH SEGMENT MUST BLENDED IN A SMOOTH AND CONSISTENT MANNER TO ADJACENT NODES TO ENSURE
a) CONTINUITY OF MAIN STRUCTURAL PLATES
b) NO VISIBLE MIS- ALIGNMENT, FACETING, STEPS OR KINKS OR SHARP CHANGES IN EXTERIOR GEOMETRY

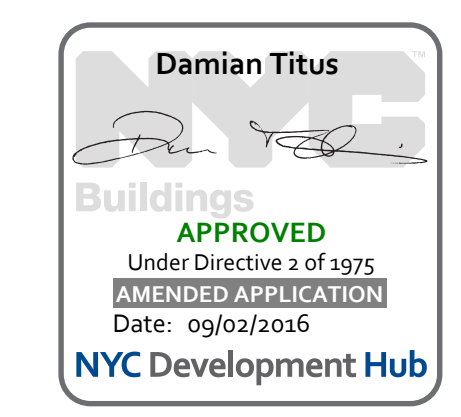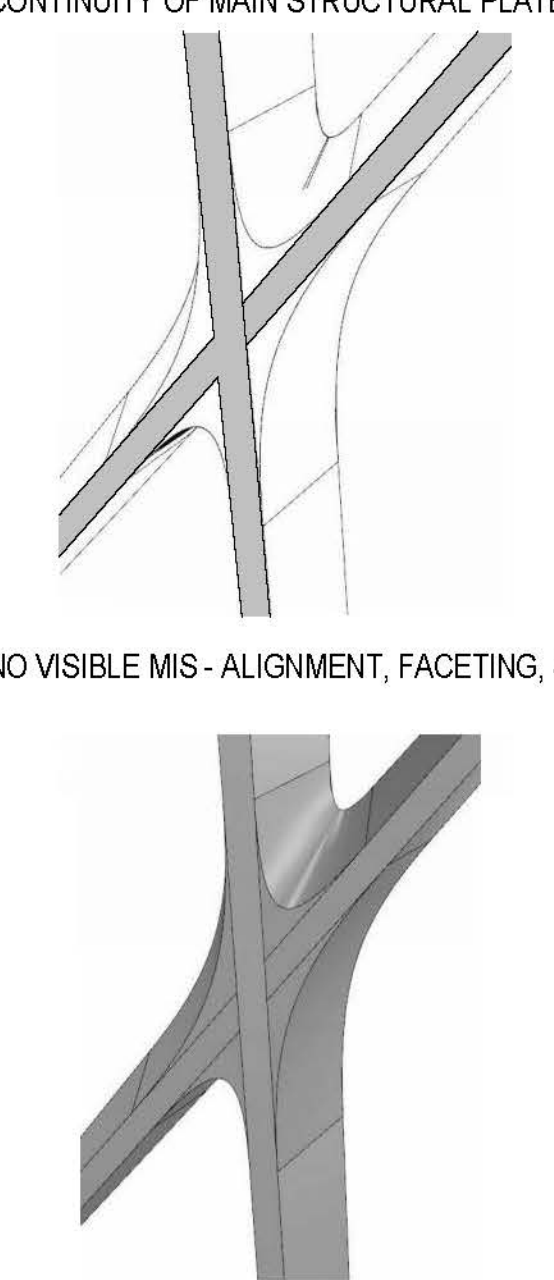

APPROVED
Under Directive 1 of 1975
DATE: 09/19/2018
NYC Development Hub

CULTURE SHED
 545 West 30th Street
 New York, New York 10001

OWNER
 CULTURE SHED INC.

ARCHITECTS
 Oller Sclafano + Renfro Architects, PC
 601 West 26 Street #815
 New York, New York 10001
 T: 212.260.7971

STRUCTURAL ENGINEER
 Thornton Tomasetti
 51 Madison Avenue
 New York, New York 10010
 T: 917.981.7800
 F: 917.981.7811

MEP ENGINEER
 Jans Baum & Bolles
 60 Pine Street
 New York, New York 10005
 T: 212.530.9300
 F: 212.265.6564

FACADE CONSULTANT
 Thornton Tomasetti
 51 Madison Avenue
 New York, New York 10010
 T: 917.981.7800
 F: 917.981.7811

KINETICS ENGINEER
 Hardisty & Hanover
 1501 Broadway
 New York, New York 10036
 T: 212.944.1150
 F: 212.391.0297

LIGHTING DESIGNER
 Tilston Design Associates
 40 North Street #160
 New York, New York 10013
 T: 212.675.7760

THEATRE PLANNING & DESIGN
 Fisher Dodge Associates
 22 West 15th Street
 New York, New York 10011
 T: 212.691.3000

LIFE SAFETY
 Code Consultants, Inc.
 215 West 40th St, 15th Fl.
 New York, New York 10018
 T: 212.216.9596

ENERGY MODEL/LEED
 Viditan
 50 Washington Street
 Norwalk, CT 06854
 T: 203.298.1411

ACOUSTIC/AUDIO-VISUAL
 Auralite
 93 North Main Street
 South Norwalk, CT 06854
 T: 347.210.5540

VERTICAL TRANSPORTATION
 Van Dusen & Associates
 5 Regent Street, Suite 524
 Livingston, NJ 07039
 T: 973.994.9220

SPECIFICATIONS
 Construction Specifications Inc.
 PO Box 489
 227 Emmet Road
 Morganville, NJ 07751
 T: 732.970.0700
 F: 732.970.0700

SECURITY
 Duchella Venter & Santoro
 1100 Sherman Avenue
 Hamden, CT 06514
 T: 203.286.6490


WATERPROOFING
 James R. Gahfort AIA Consulting Architects PC
 104 West 27th Street
 New York, NY 10001
 T: 212.736.3344

FACADE MAINTENANCE
 Frank Engineering PLLC
 166 Arden Street
 New York, NY 10005
 T: 212.986.3000


BRANDING GRAPHICS
 2nd Global Design Consultancy
 180 York Street 15th Floor
 New York, NY 10014
 T: 212.647.1170

GEOMETRY, DIMENSIONS AND SURFACE CONTOURING, BLENDING AND INTERSECTION OF SECTIONS ILLUSTRATED IN THE STRUCTURAL DRAWINGS ARE PROVIDED FOR REFERENCE AND GENERATION OF STRUCTURAL ARRANGEMENT AND DETAILS ONLY. THE 3D MODEL ISSUED BY THE ARCHITECT DEFINES THE EXTERIOR SURFACE AND SHALL BE ADHERED TO FOR THE FINAL GEOMETRY. FOR DETAILS OF SECONDARY STEEL, INCLUDING STRUCTURAL CLADDING REFER TO ARCHITECTURE DRAWINGS. IT IS THE RESPONSIBILITY OF THE CONTRACTOR TO IDENTIFY ANY DISCREPANCIES OR AMBIGUITIES FOR DISCUSSION, RESOLUTION AND DIRECTION FROM THE ARCHITECT AND SER.


NOTES:
 ANY GIVEN POINT MAY BE OUT OF TOLERANCE BY +/- 0.125". PLEASE NOTE HOWEVER THAT NO KINKS OR SHARP CHANGES IN ANGLE ARE PERMITTED AND SURFACES ARE TO BE BLENDED/CONTOURED TO PROVIDE A SMOOTH AND CONTINUOUS ARRANGEMENT.

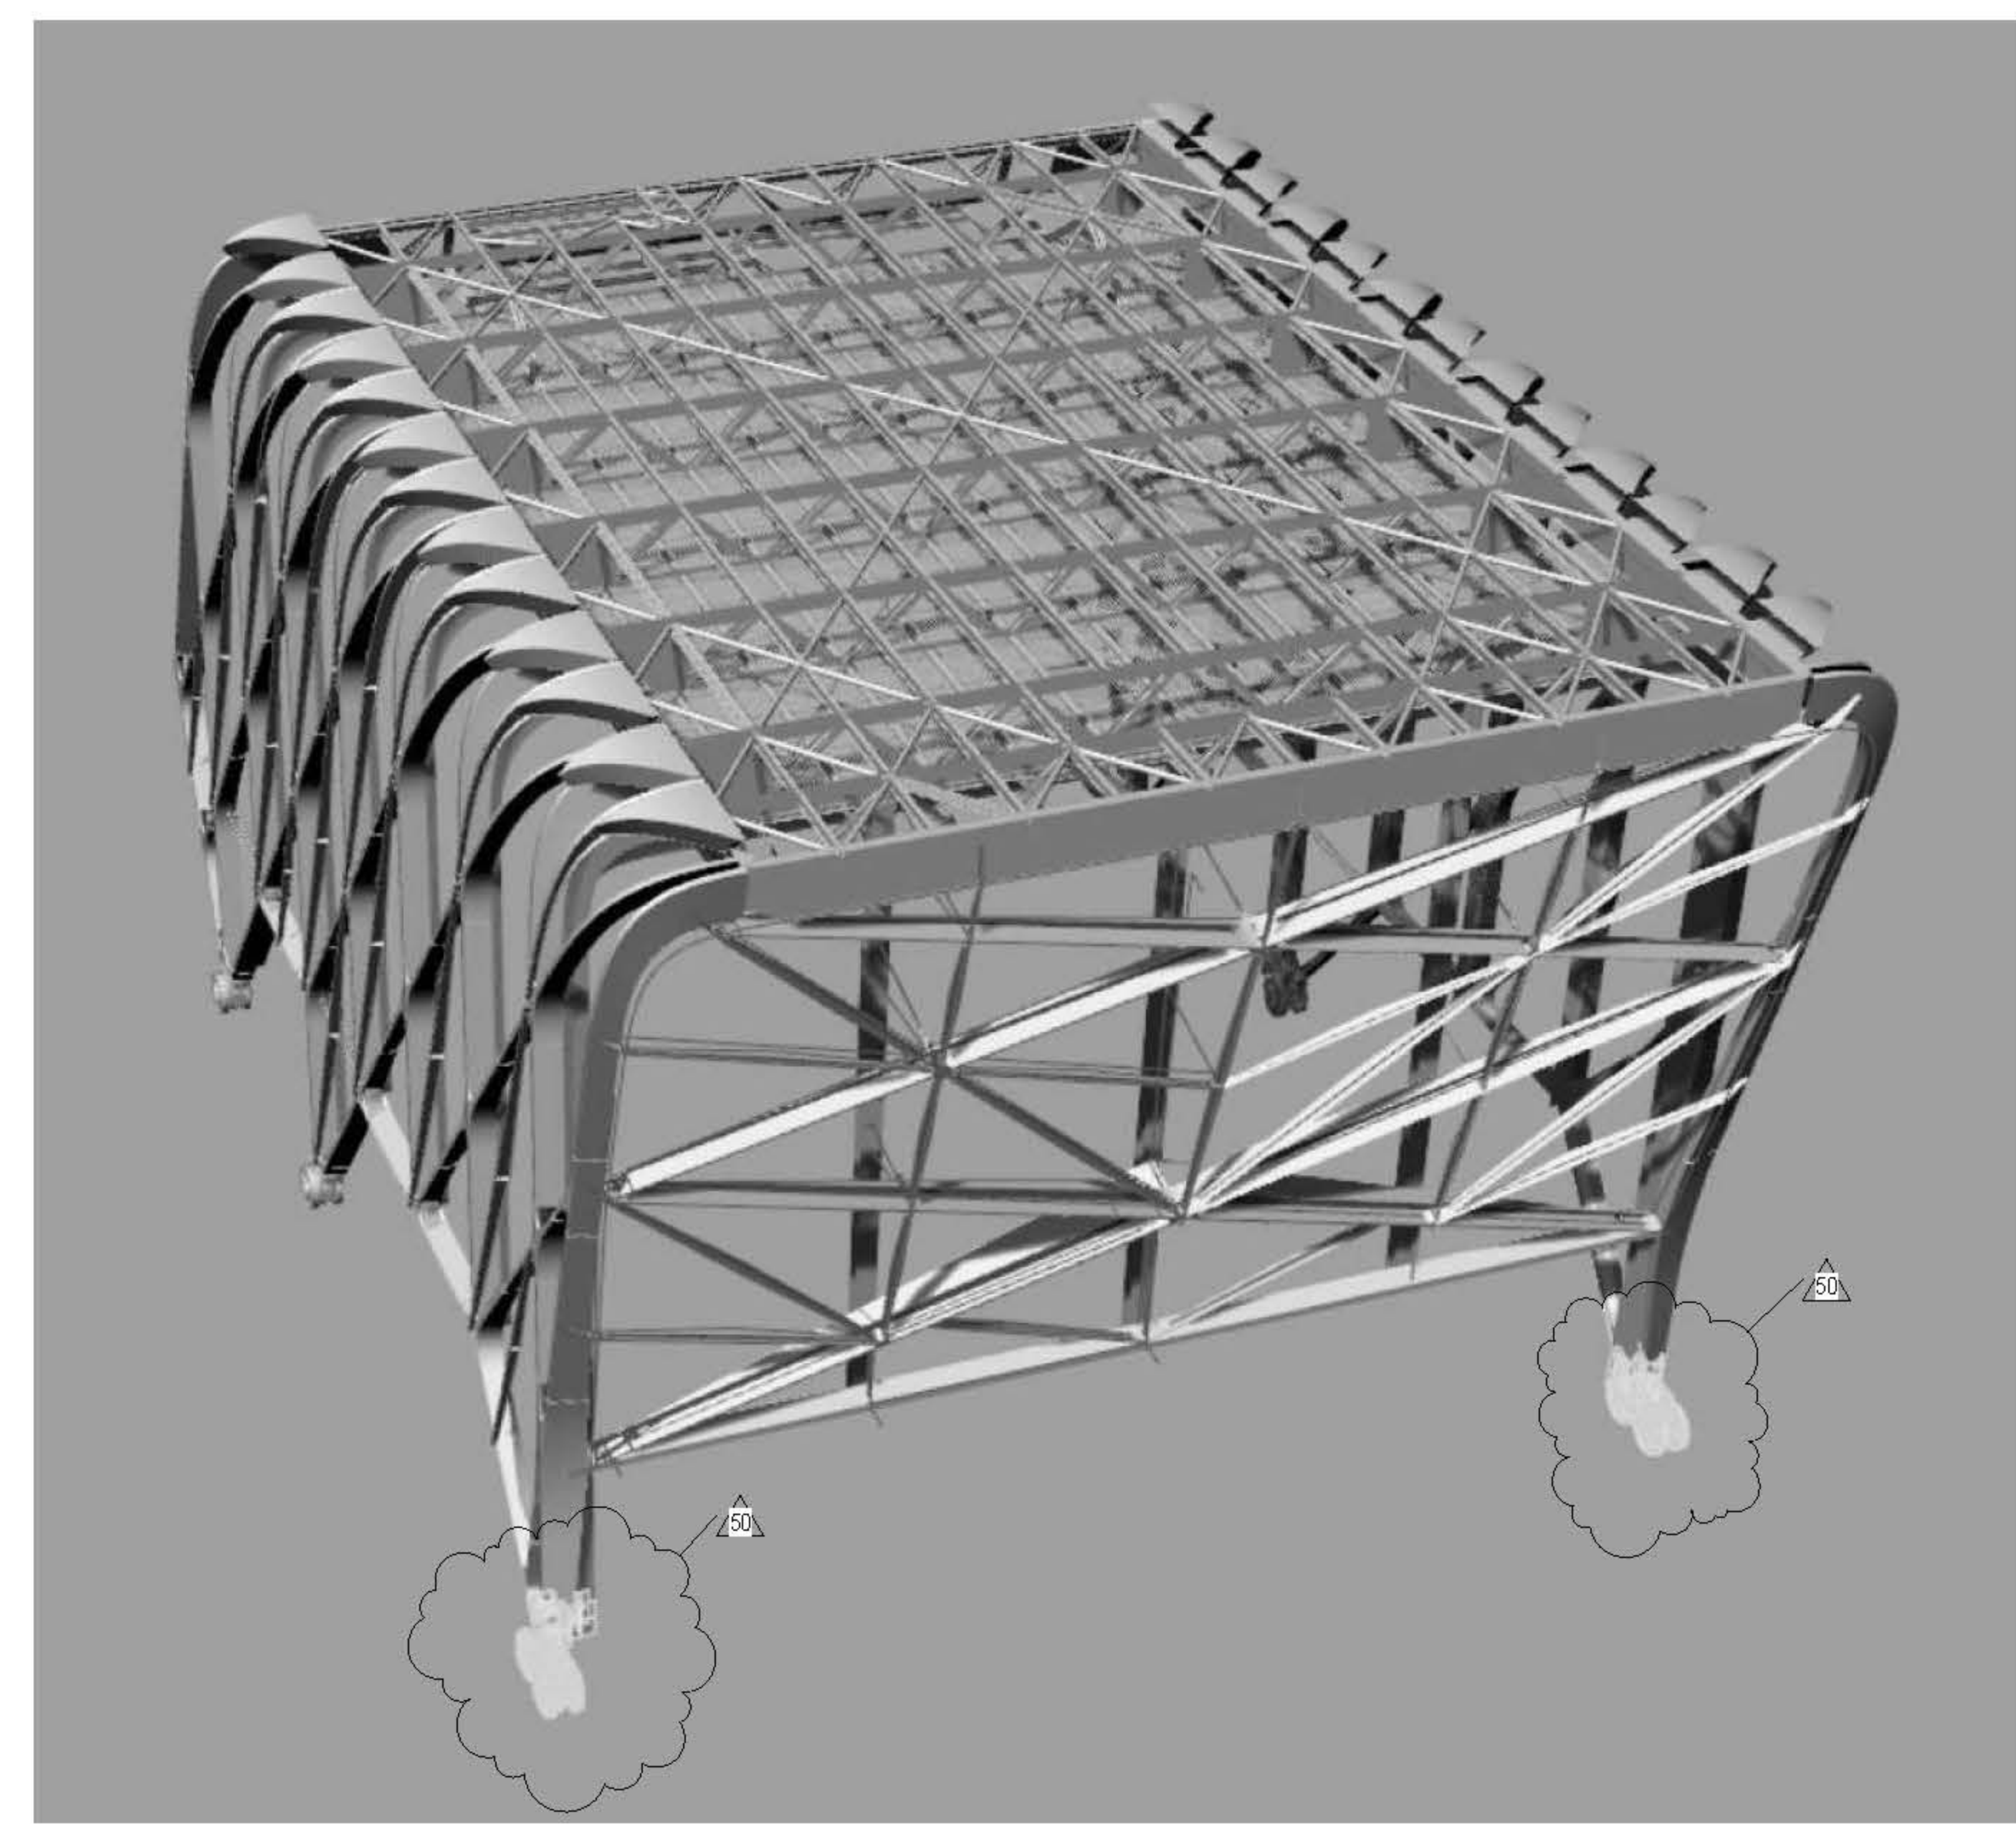

1 BOGIE - CONTEXT
 1/4" = 1'-0"

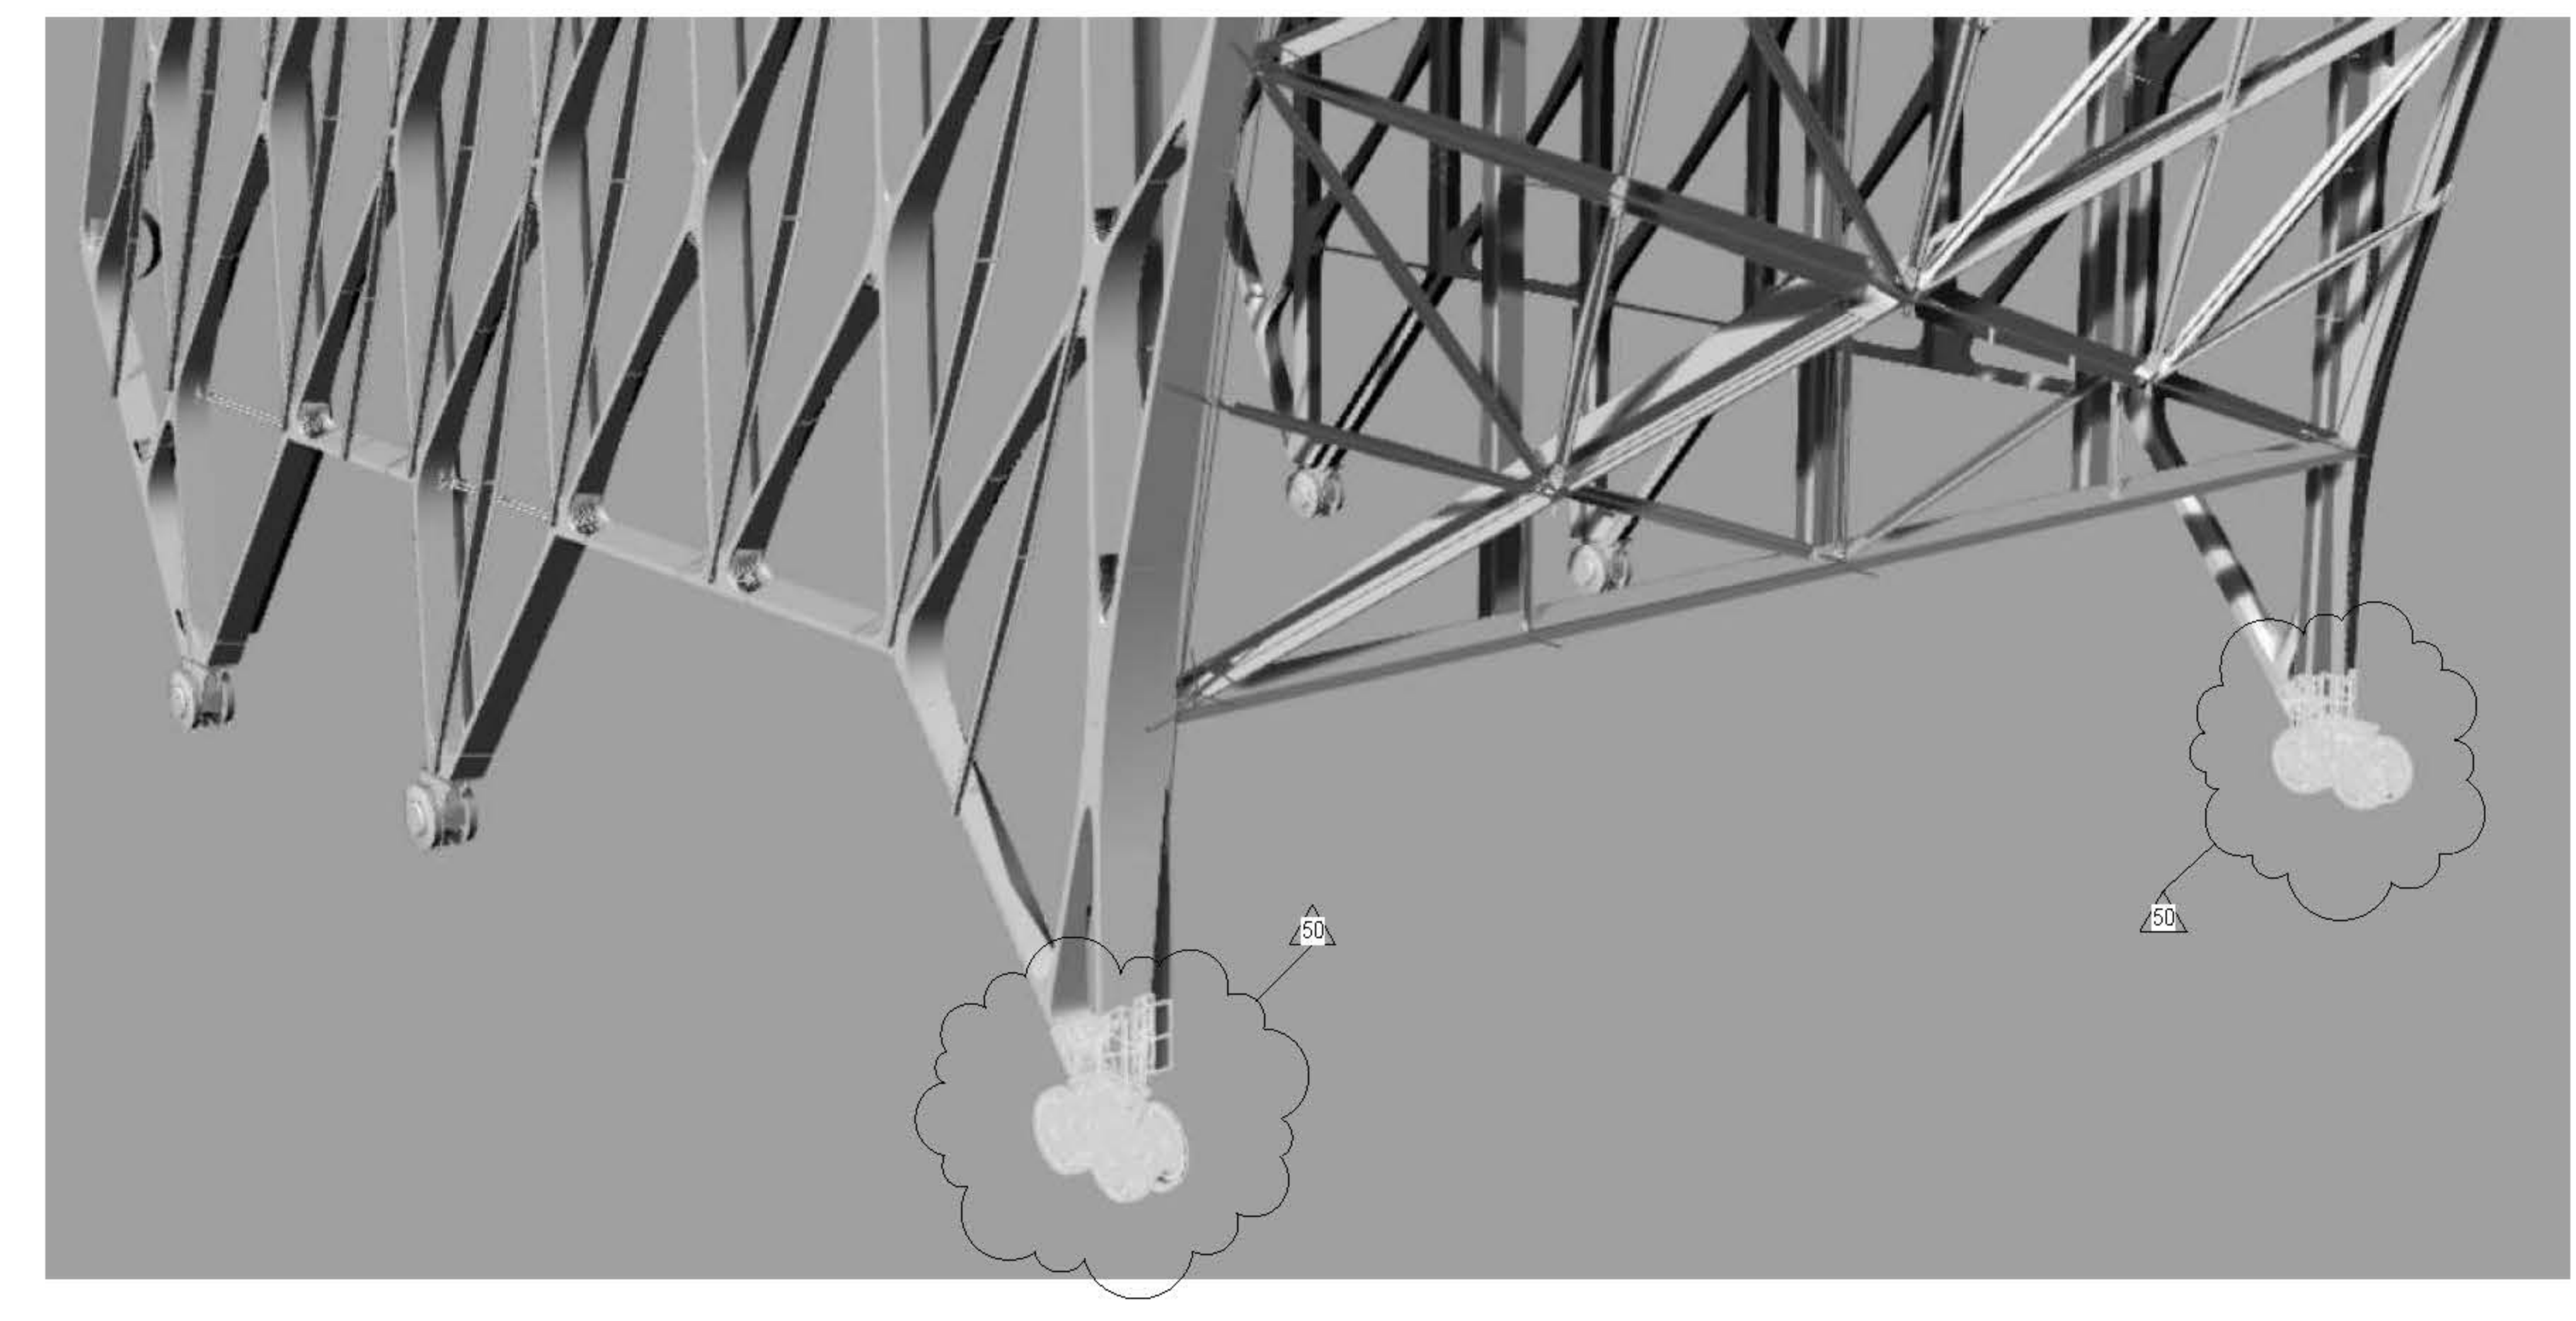


2 BOGIE - LOCATION
 3/16" = 1'-0"

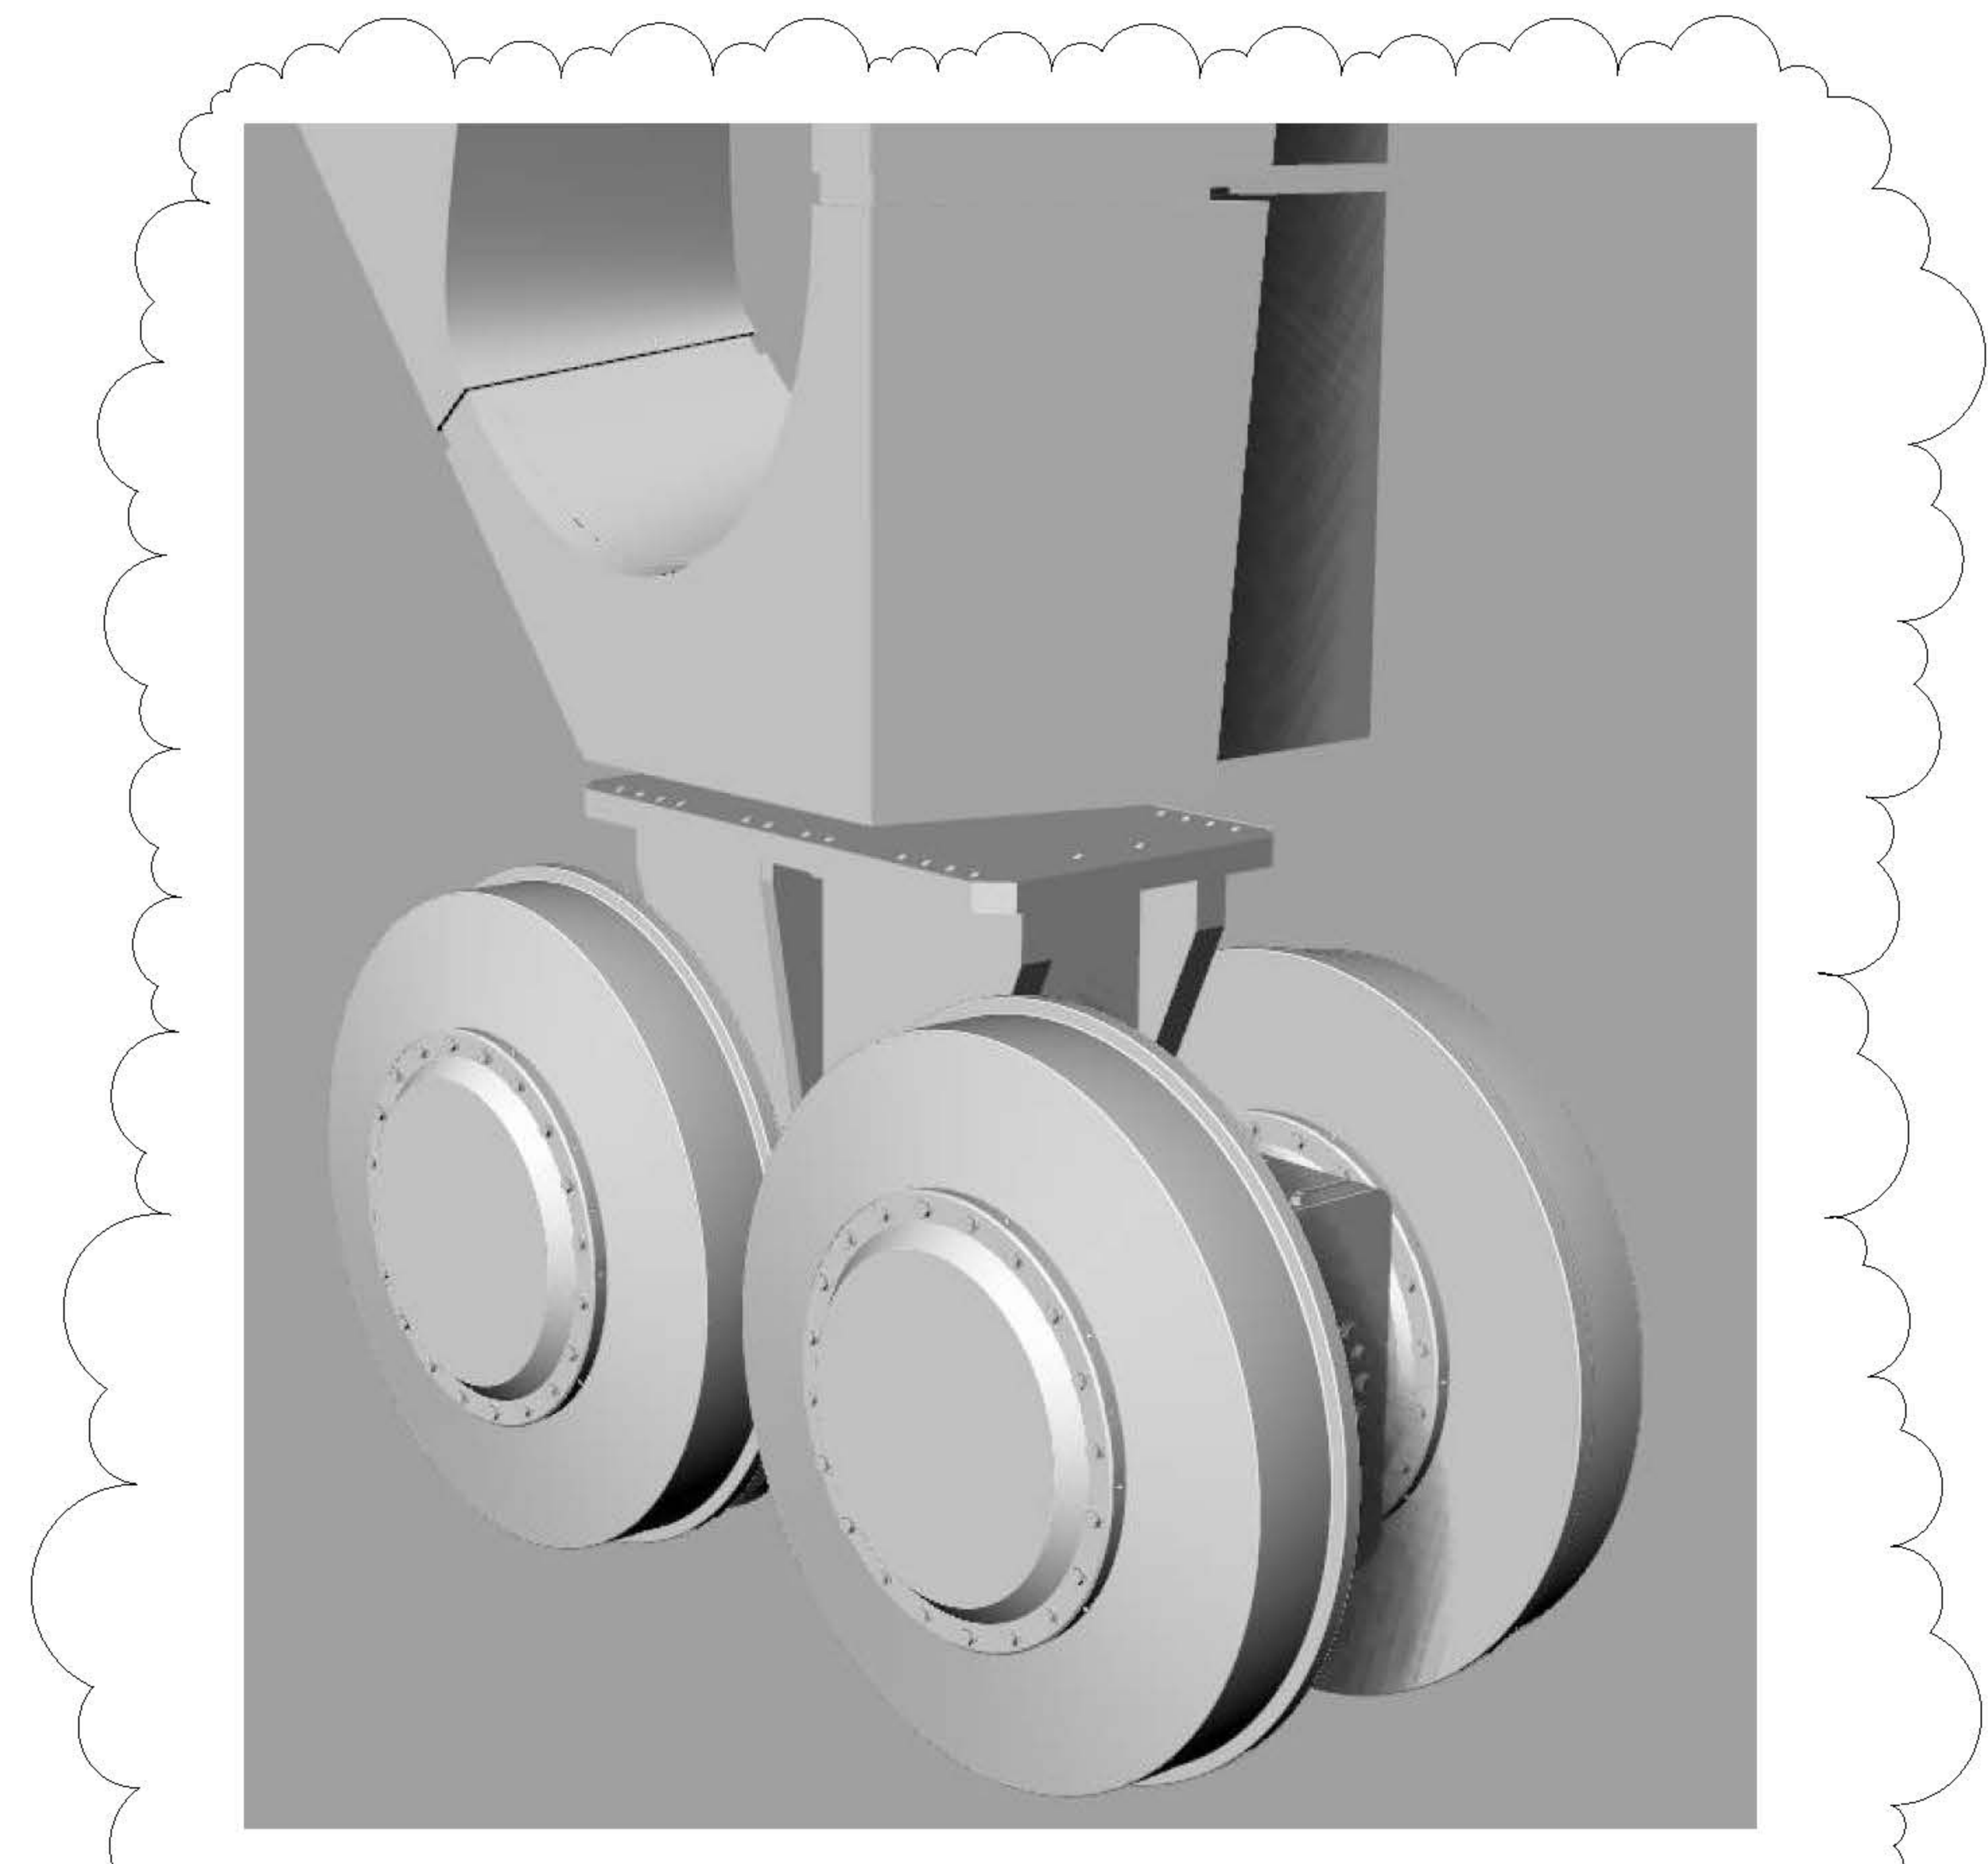

3 BOGIE - DETAILS
 1/2" = 1'-0"

KEY PLAN

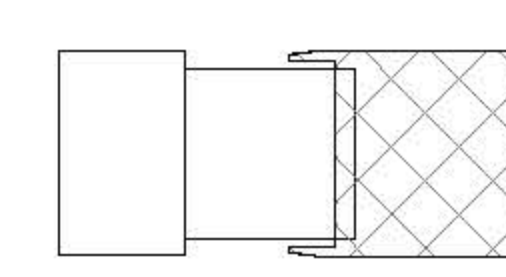

ISSUE

NO.	DESCRIPTION	DATE
63	60 - 60B AMENDMENT 7	03.19.2016
44	30 - 30B AMENDMENT 6	04.09.2016
21	CONSTRUCTION SET	10.09.2015
10	4 - 100% CONSTRUCTION DOCUMENTS	03.18.2016
9	90% CONSTRUCTION DOCUMENTS	02.16.2016
6	PRELIMINARY CDR SUBMISSION	12.10.2014
1	ADVANCED PROCUREMENT BID SET	06.16.2014

STAMP



DRAWN BY
 Author


CHECKED BY
 Checker

PROJECT NUMBER
 N11318.00

TITLE
 STEEL TOLERANCES - BOGIES

DRAWING NO.
 S-009.01

B.SCAN NO.
 S-009.01

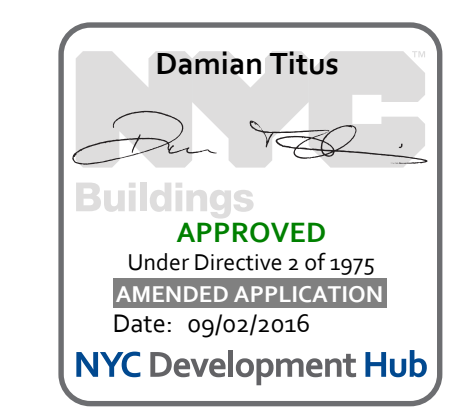

CULTURE SHED
545 West 30th Street
New York, New York 10001
OWNER: CULTURE SHED INC.

ARCHITECTS
Oiler Scalfaro + Renfro Architects, DPC
601 West 26th Street #815
New York, New York 10001
T: 212.260.7971

rockwellgroup
5 Union St. West, 6th Flr
New York, New York 10003
T: 212.463.0334
F: 212.463.0335

STRUCTURAL ENGINEER
Thornton Tomasetti
51 Madison Avenue
New York, New York 10010
T: 917.661.7800
F: 917.661.7801

MEP ENGINEER
Jans Baum & Bolles
50 Park Street
New York, New York 10005
T: 212.530.9300
F: 212.266.6934

FACADE CONSULTANT
Thornton Tomasetti
51 Madison Avenue
New York, New York 10010
T: 917.661.7800
F: 917.661.7801

KINETICS ENGINEER
Hardsy & Hanover
1501 Broadway
New York, New York 10036
T: 212.944.1150
F: 212.399.0297

LIGHTING DESIGNER
Tilston Design Associates
40 North Street #160
New York, New York 10013
T: 212.675.7760

THEATRE PLANNING & DESIGN
Fisher Dodge Associates
22 West 15th Street
New York, New York 10011
T: 212.691.3000

LIFE SAFETY
Code Consultants, Inc.
215 West 43rd St, 15th Flr
New York, New York 10018
T: 212.216.9596

ENERGY MODEL/LEED
Vindian
50 Washington Street
Norwalk, CT 06854
T: 203.298.1411

ACOUSTIC/AUDIO-VISUAL
Aureville
50 North Main Street
South Norwalk, CT 06854
T: 347.210.5540

VERTICAL TRANSPORTATION
Van Duusen & Associates
5 Regent Street, Suite 524
Livingston, NJ 07039
T: 973.994.9220

SPECIFICATIONS
Construction Specifications Inc.
PO Box 489
227 Emmet Road
Morganville, NJ 07751
T: 732.970.0700
F: 732.970.0750


SECURITY
Duchella Venter & Santoro
1020 Sherman Avenue
Hartford, CT 06114
T: 203.286.6490

WATERPROOFING
James R. Gahfort AIA Consulting Architects PC
104 West 27th Street
New York, NY 10001
T: 212.736.3344

FACADE MAINTENANCE
Erick Engineering PLLC
186 Ave. Street
New York, NY 10005
T: 212.986.3000

BRANDING GRAPHICS
2nd Global Design Consultancy
180 York Street 15th Floor
New York, NY 10014
T: 212.647.1170

KEY PLAN

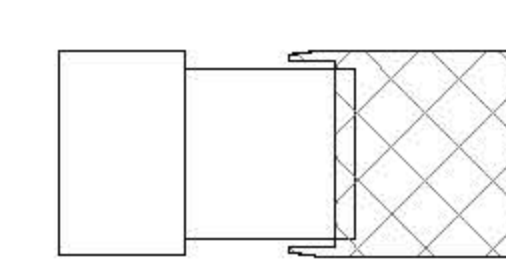

ISSUE **PRINTING** **DATE**

ISSUE	PRINTING	DATE	
63	60	DOB AMENDMENT 7	03/19/2016
44	30	DOB AMENDMENT 6	04/02/2016
21		CONSTRUCTION SET	10/08/2015
10	4	100% CONSTRUCTION DOCUMENTS	03/18/2015
9		90% CONSTRUCTION DOCUMENTS	02/16/2015
6		PRELIMINARY CDS SUBMISSION	12/16/2014
1		ADVANCED PROCUREMENT BID SET	06/16/2014

STAMP



DRAWN BY Audrey
CHECKED BY Damian Titus

PROJECT NUMBER
N11318.00


TITLE
STEEL TOLERANCES - NODES

DRAWING NO.
S-010.01


B.SCAN NO.
S-010.01

9 of 123


GEOMETRY, DIMENSIONS AND SURFACE CONTOURING, BLENDING AND INTERSECTION OF SECTIONS ILLUSTRATED IN THE STRUCTURAL DRAWINGS ARE PROVIDED FOR REFERENCE AND GENERATION OF STRUCTURAL ARRANGEMENT AND DETAILS ONLY. THE 3D MODEL ISSUED BY THE ARCHITECT DEFINES THE EXTERIOR SURFACE AND SHALL BE ADHERED TO FOR THE FINAL GEOMETRY. FOR DETAILS OF SECONDARY STEEL, INCLUDING STRUCTURAL CLADDING REFER TO ARCHITECTURE DRAWINGS. IT IS THE RESPONSIBILITY OF THE CONTRACTOR TO IDENTIFY ANY DISCREPANCIES OR AMBIGUITIES FOR DISCUSSION, RESOLUTION AND DIRECTION FROM THE ARCHITECT AND SER.

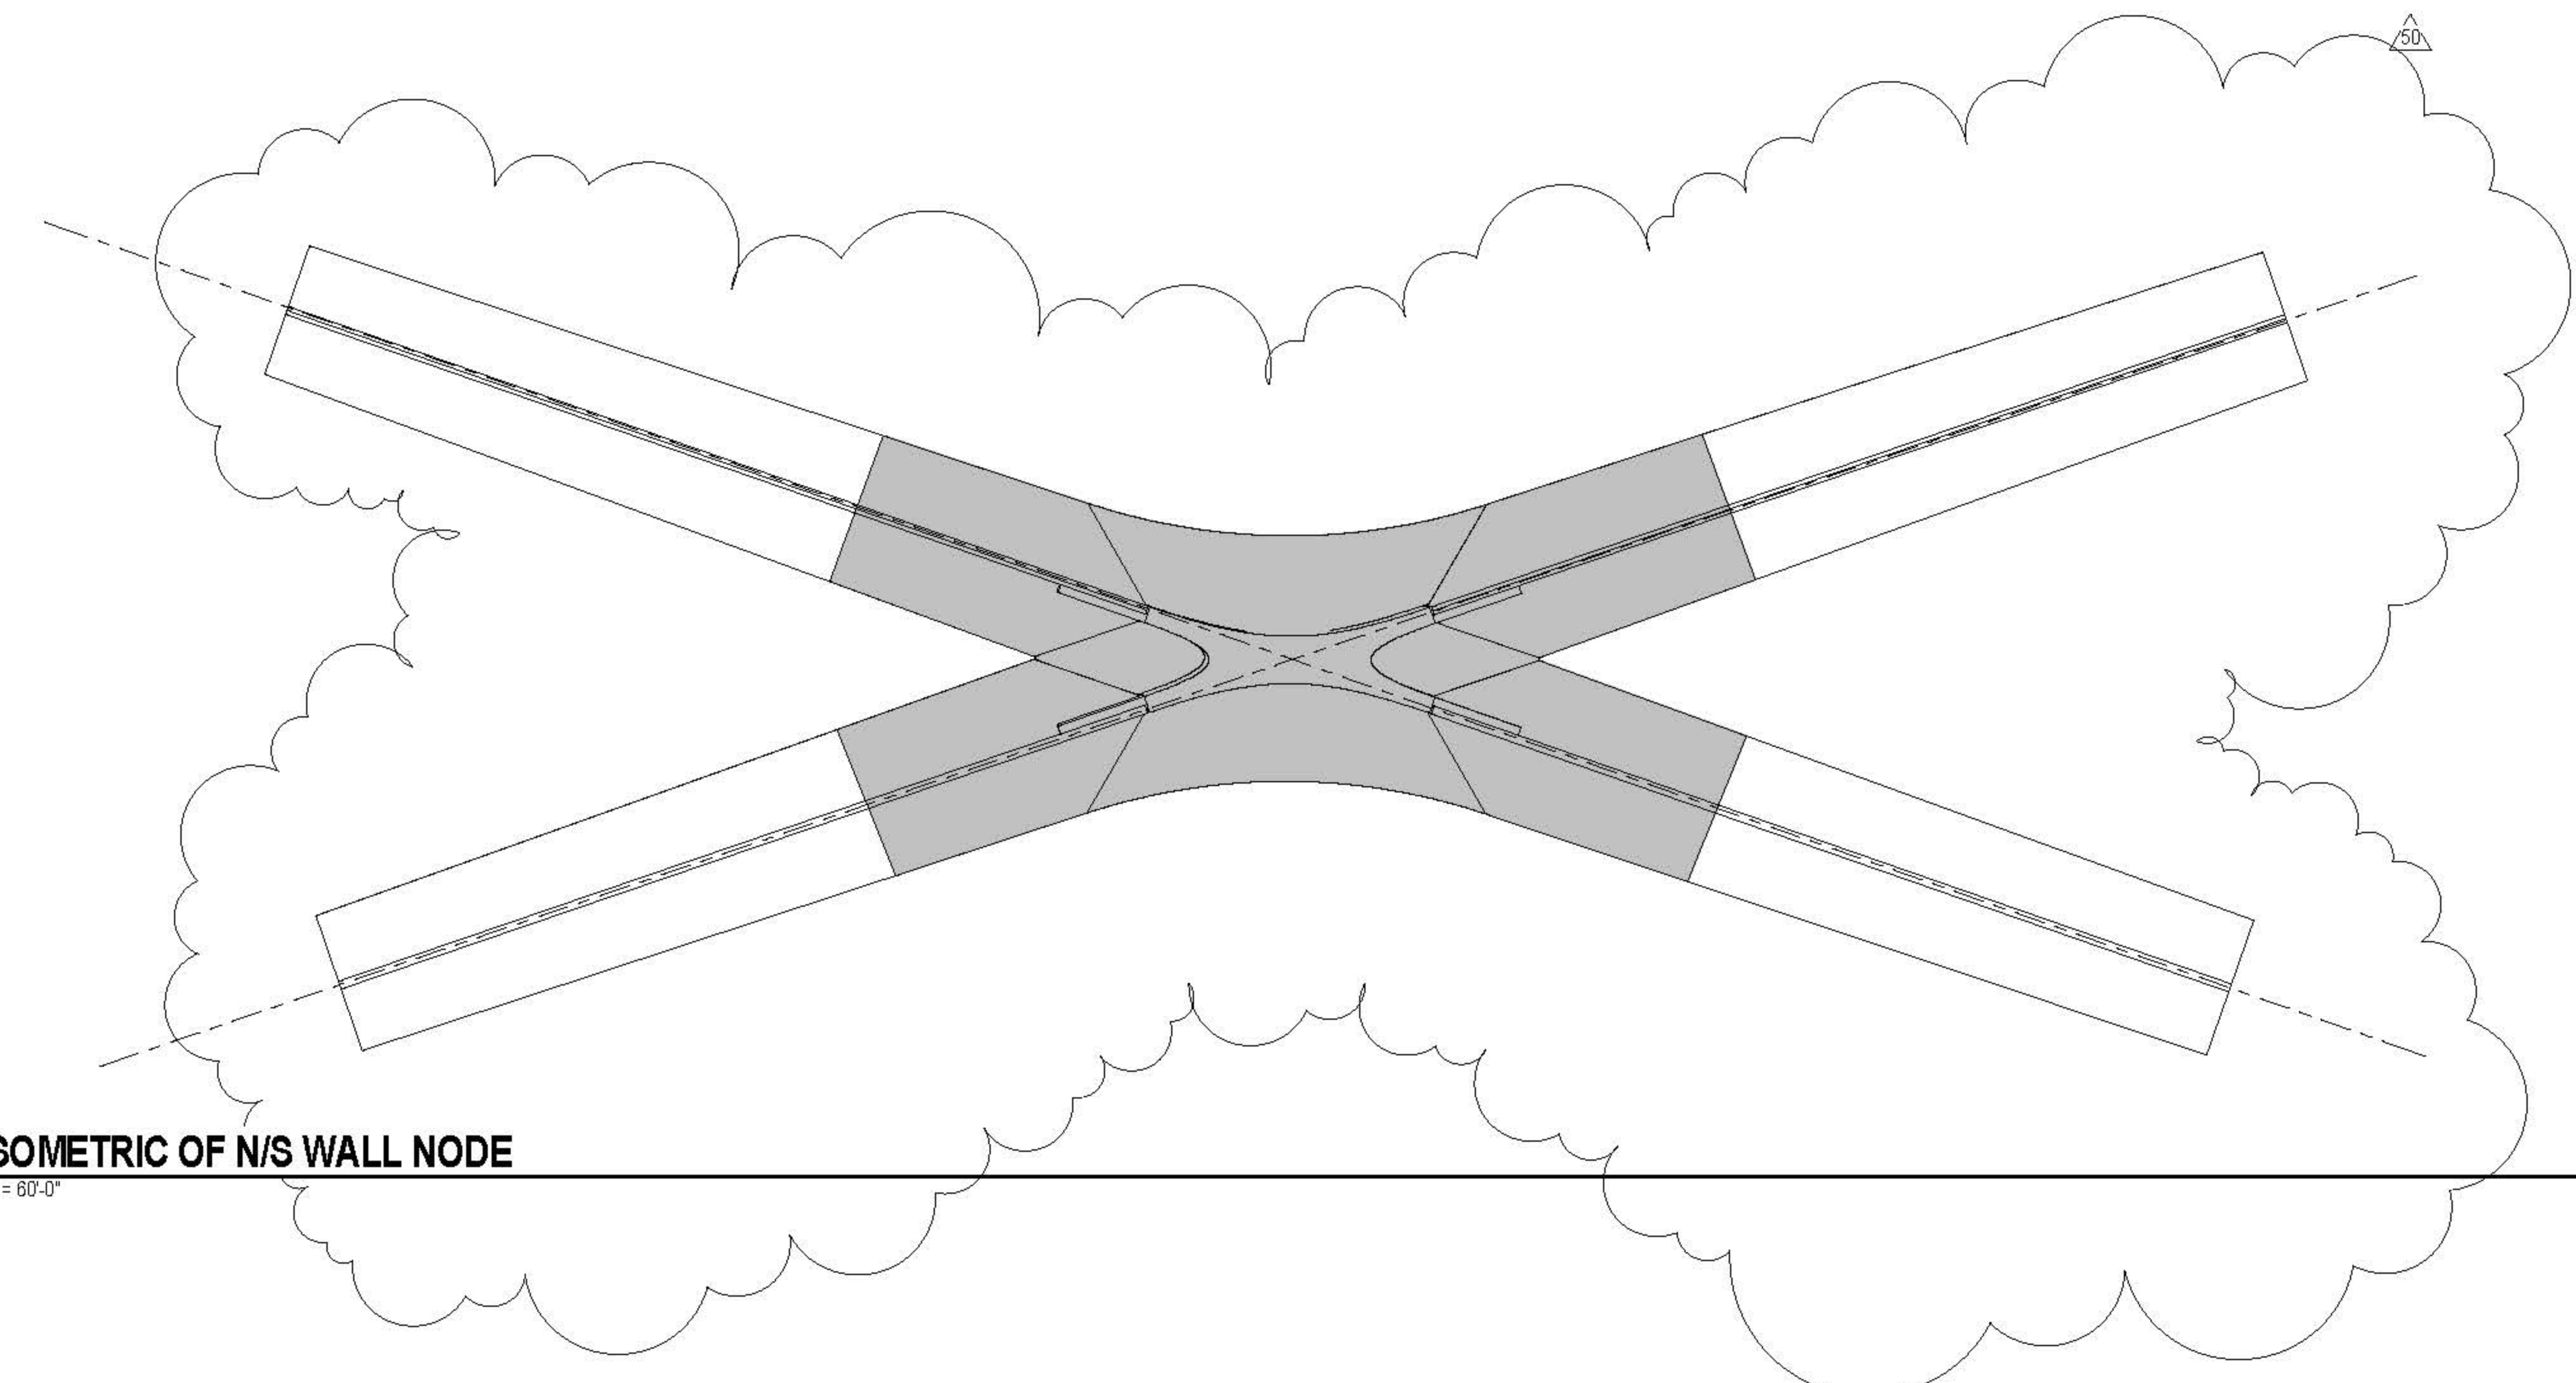

1 ISOMETRIC OF N/S WALL NODE
1" = 60'0"

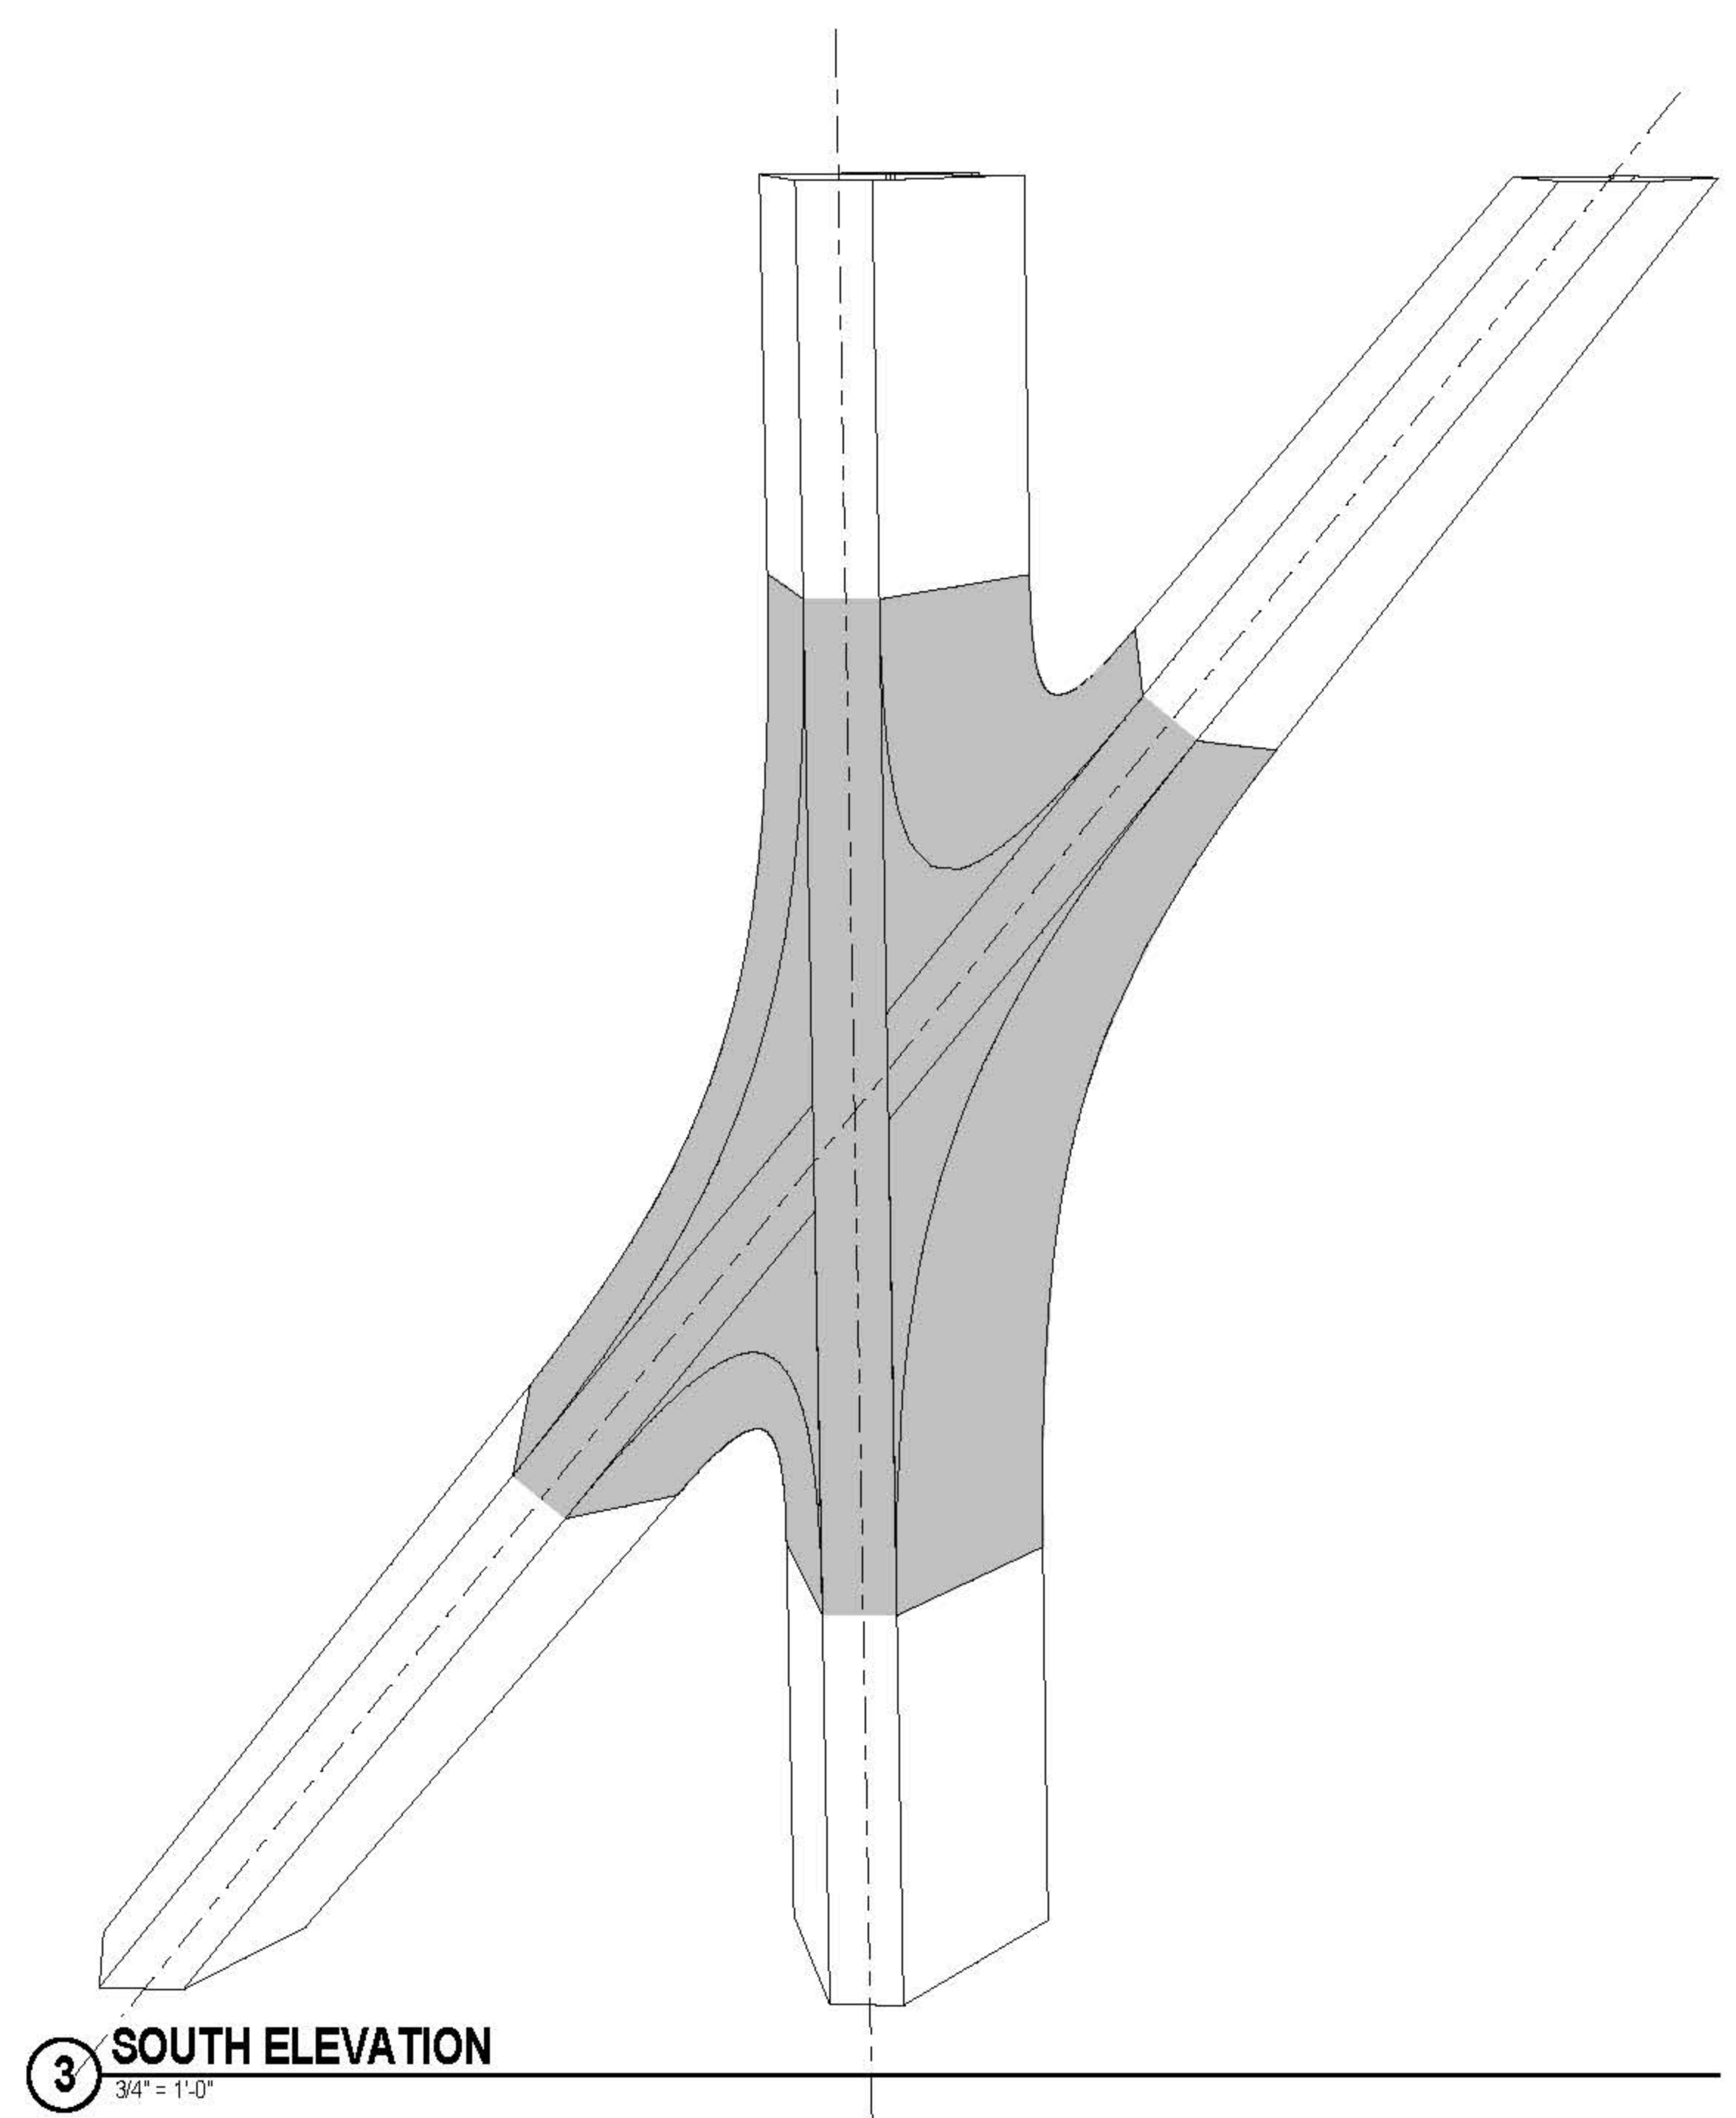


3 SOUTH ELEVATION
3/8" = 1'-0"

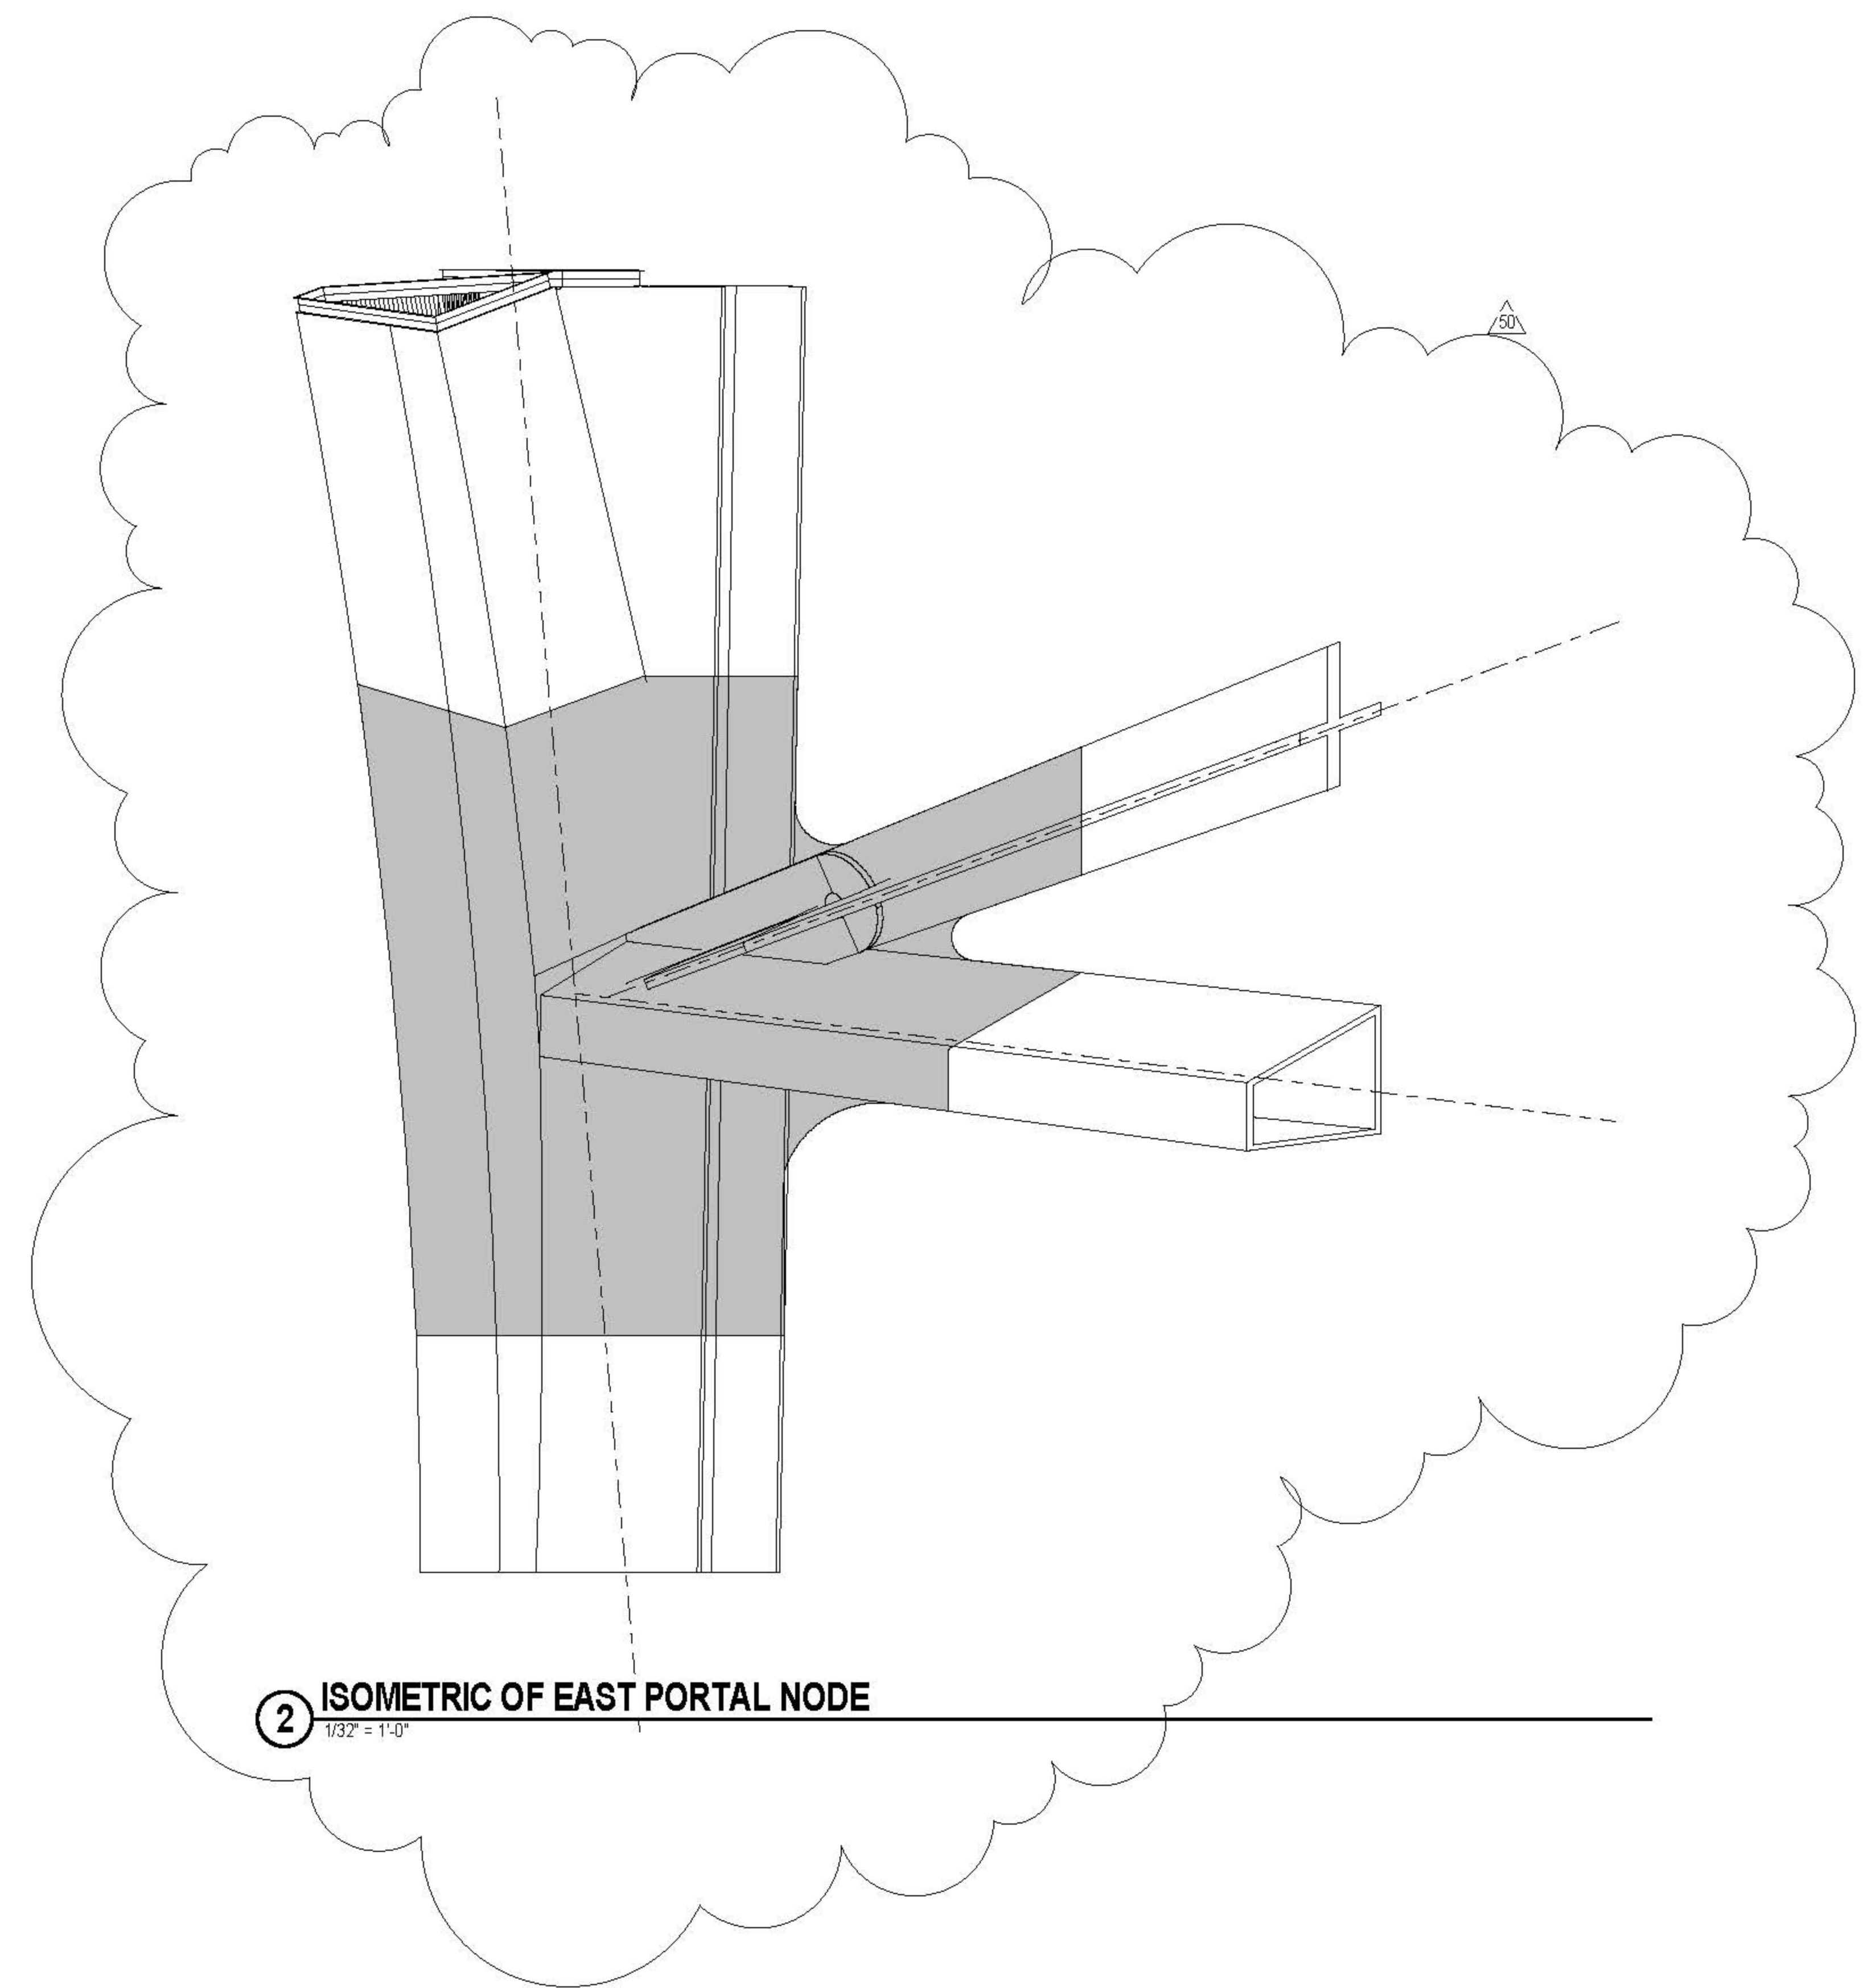

2 ISOMETRIC OF EAST PORTAL NODE
1/32" = 1'-0"

NOTES - ALL TYPICAL:

FOR EXPOSED NODES AS PART OF THE SHED STEELWORK ANY GIVEN POINT MAY BE OUT OF TOLERANCE BY +/- 0.125". PLEASE NOTE HOWEVER THAT NO KINKS OR SHARP CHANGES IN ANGLE ARE PERMITTED AND SURFACES ARE TO BE BLENDED/CONTOURED TO PROVIDE A SMOOTH AND CONTINUOUS ARRANGEMENT. ALIGNMENT WITH ADJACENT MEMBERS +/- 0.04" AT SPLINES PER S-108

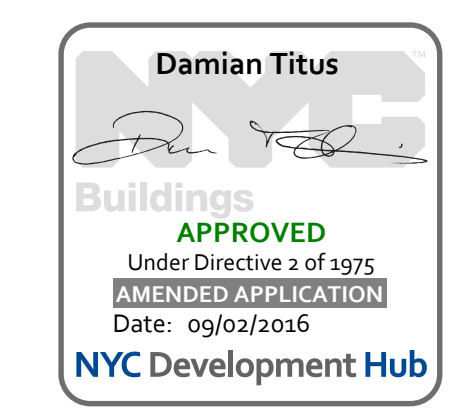

CULTURE SHED
545 West 30th Street
New York, New York 10001

OWNER
CULTURE SHED INC

ARCHITECTS
Oller Scaletta + Renfro Architects, DPC
601 West 30th Street #815
New York, New York 10001
T: 212.260.7971

STRUCTURAL ENGINEER
Thornton Tomasetti
51 Madison Avenue
New York, New York 10010
T: 917.561.7800
F: 917.561.7801

MEP ENGINEER
Jans Baum & Bolles
50 Pine Street
New York, New York 10005
T: 212.530.9300
F: 212.260.6934

FACADE CONSULTANT
Thornton Tomasetti
51 Madison Avenue
New York, New York 10010
T: 917.561.7800
F: 917.561.7801

KINETICS ENGINEER
Hardess & Hanover
1501 Broadway
New York, New York 10036
T: 212.944.1150
F: 212.391.0297

LIGHTING DESIGNER
Tilston Design Associates
40 North Street #1650
New York, New York 10013
T: 212.675.7760

THEATRE PLANNING & DESIGN
Fisher Dodge Associates
21 West 19th Street
New York, New York 10011
T: 212.691.3000

LIFE SAFETY
Code Consultants, Inc.
215 West 40th St, 15th Flr
New York, New York 10018
T: 212.216.9596

ENERGY MODEL/LEED
Vindian
50 Washington Street
Norwalk, CT 06854
T: 203.298.1411

ACOUSTIC/AUDIO-VISUAL
Newell
50 North Main Street
South Norwalk, CT 06854
T: 347.210.5540

VERTICAL TRANSPORTATION
Van Dusen & Associates
5 Regent Street, Suite 524
Lakington, NJ 07038
T: 973.994.9200

SPECIFICATIONS
Construction Specifications Inc.
PO Box 489
22 Turrent Road
Morganville, NJ 07751
T: 732.970.0700
F: 732.970.0700


SECURITY
Duchella Venter & Santoro
1020 Sherman Avenue
Hartford, CT 06114
T: 203.286.6490

WATERPROOFING
James R. Gahfort AIA Consulting Architects PC
104 West 27th Street
New York, NY 10001
T: 212.736.3344

FACADE MAINTENANCE
Etek Engineering PLLC
356 Ave. Street
New York, NY 10005
T: 212.696.3000

BRANDING GRAPHICS
2nd Global Design Consultancy
180 Varck Street 15th Floor
New York, NY 10014
T: 212.647.1170

KEY PLAN

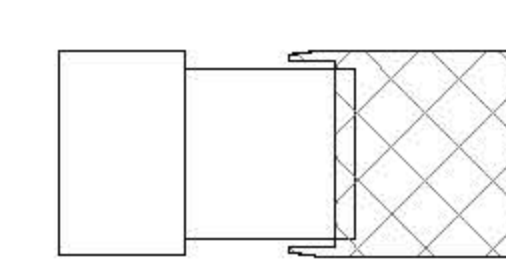

ISSUE △ PRINTING DATE

61	50	DOB AMENDMENT 7	08.19.2016
44	39	DOB AMENDMENT 5	04.28.2016
25		CONSTRUCTION SET	10.09.2015
10	4	100% CONSTRUCTION DOCUMENTS	03.18.2015
9		90% CONSTRUCTION DOCUMENTS	02.16.2015

STAMP



DRAWN BY
Audrey


CHECKED BY
Chris

PROJECT NUMBER
N1318.00


TITLE
LOADING DIAGRAMS II

DRAWING NO.
8-032.01


B-SCAN NO.
S-032.01

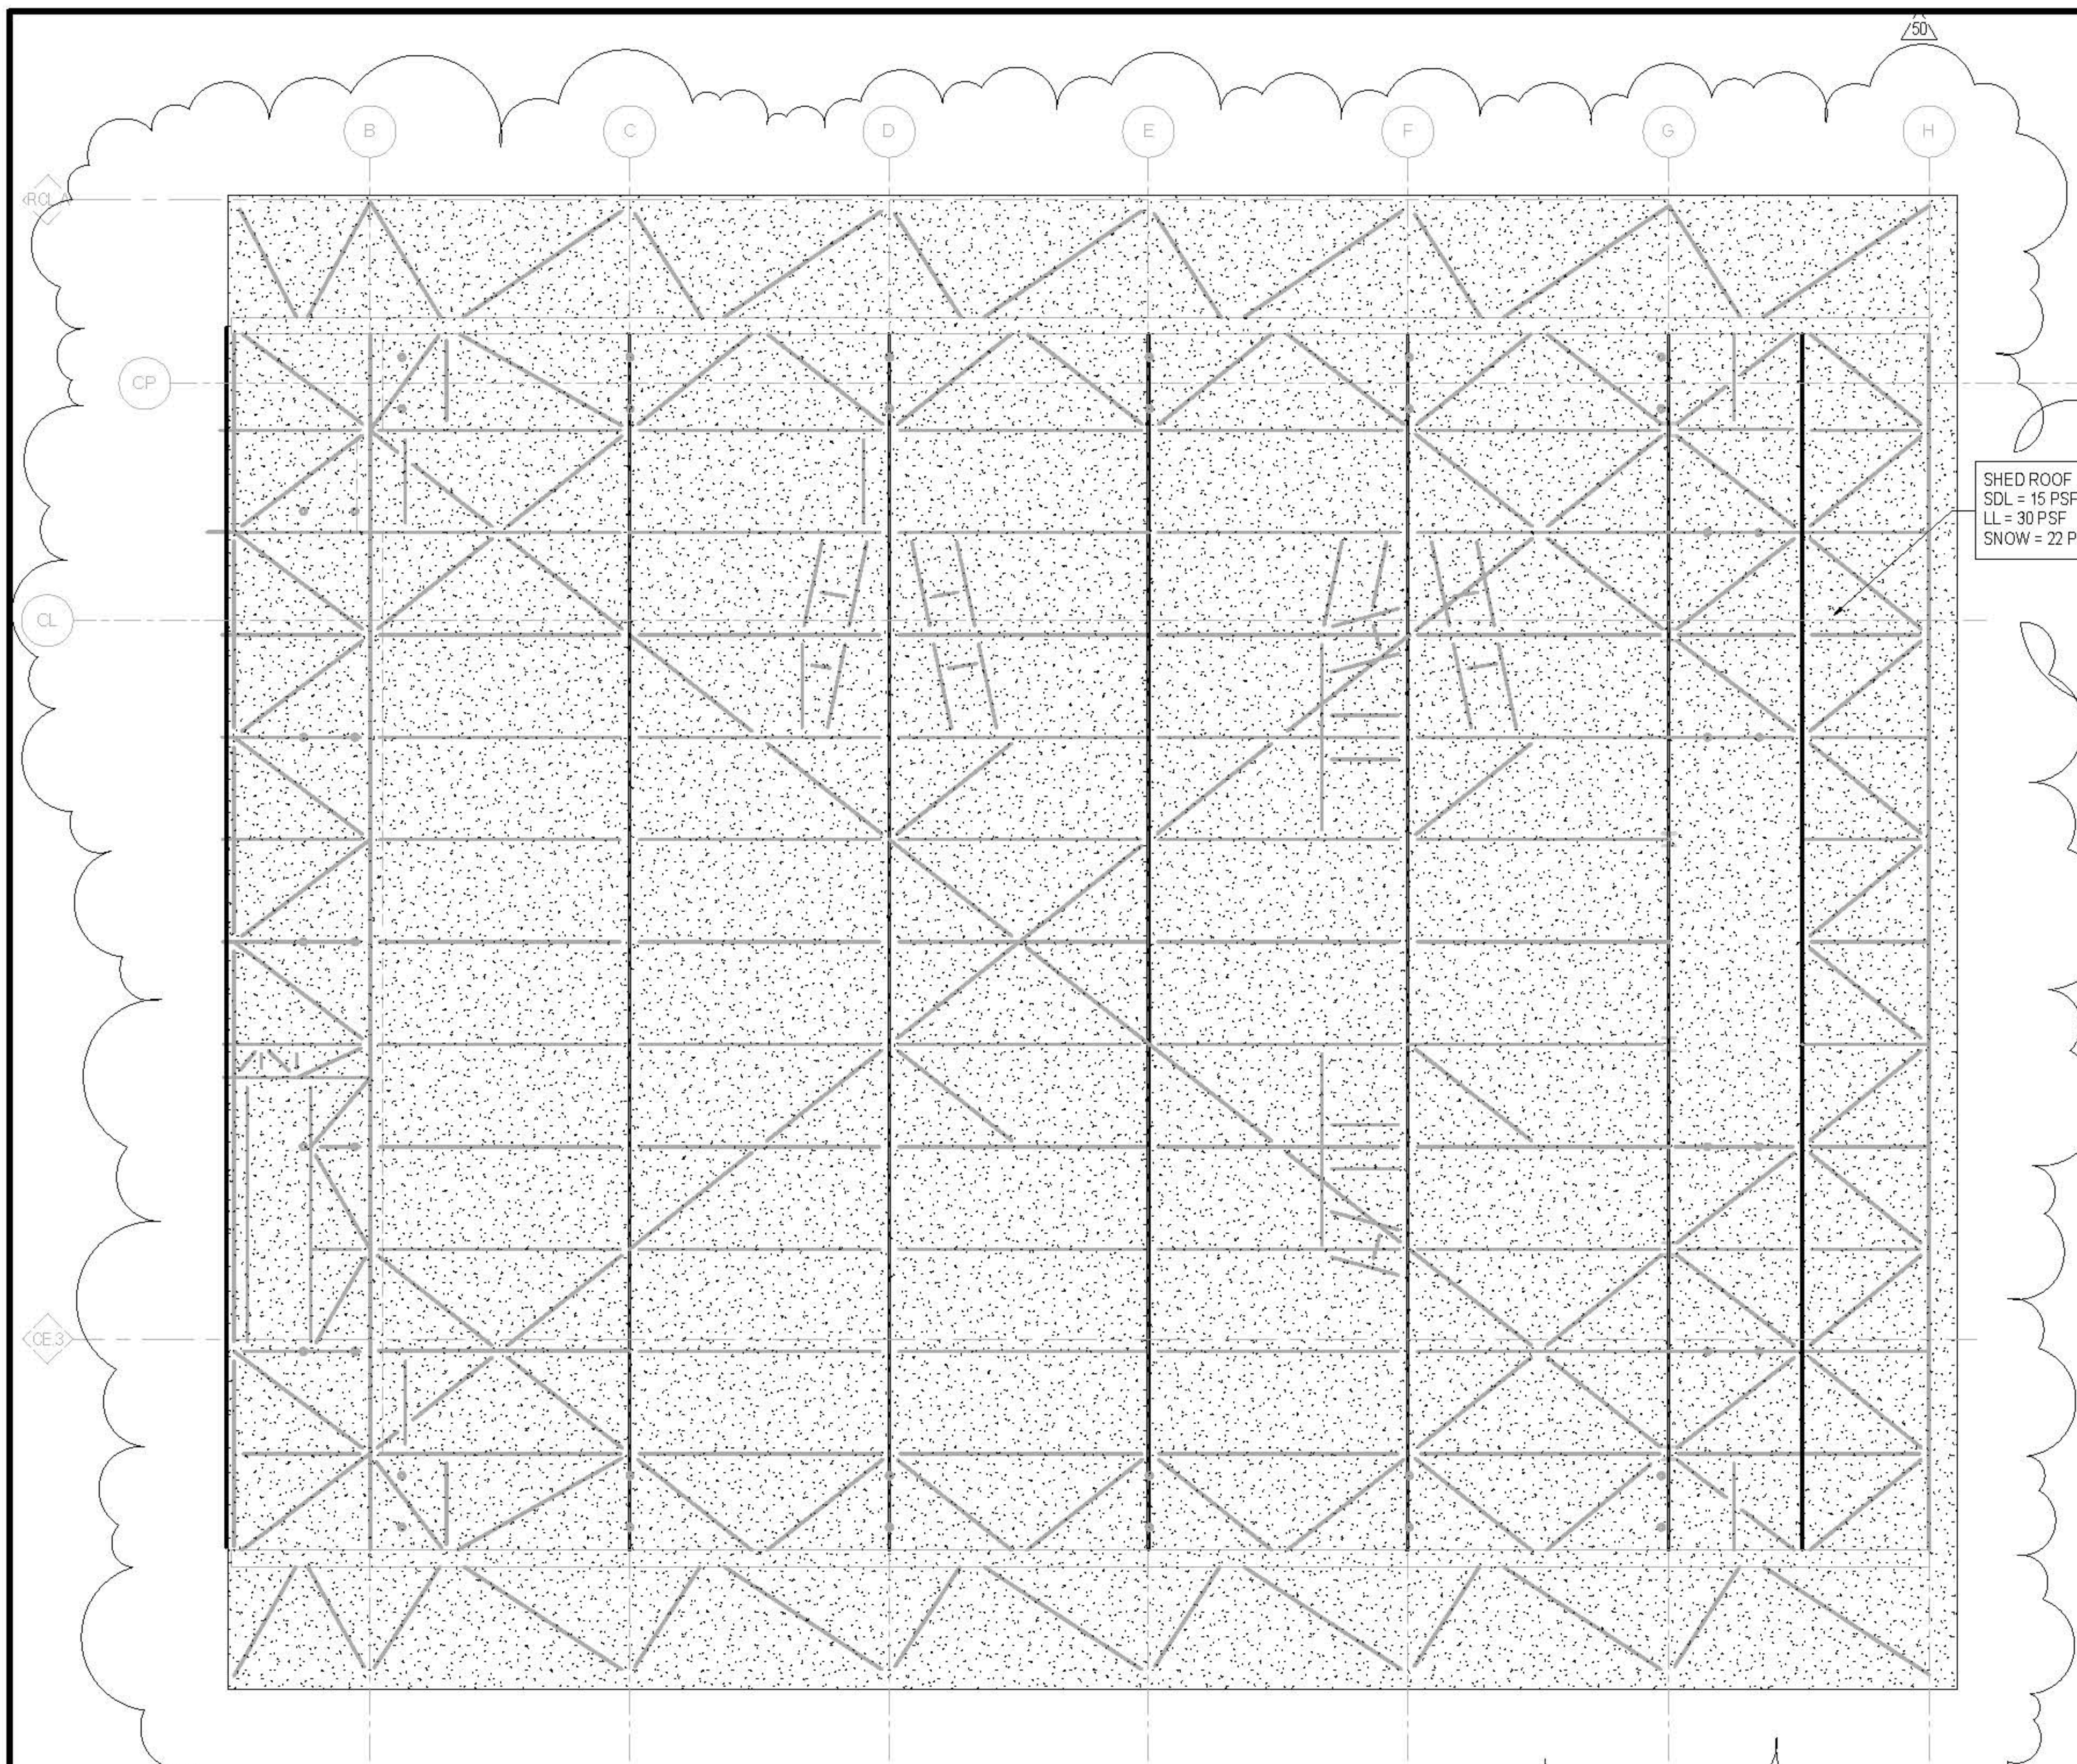

1 LOADING DIAGRAMS - SHED ROOF
1" = 10'-0"

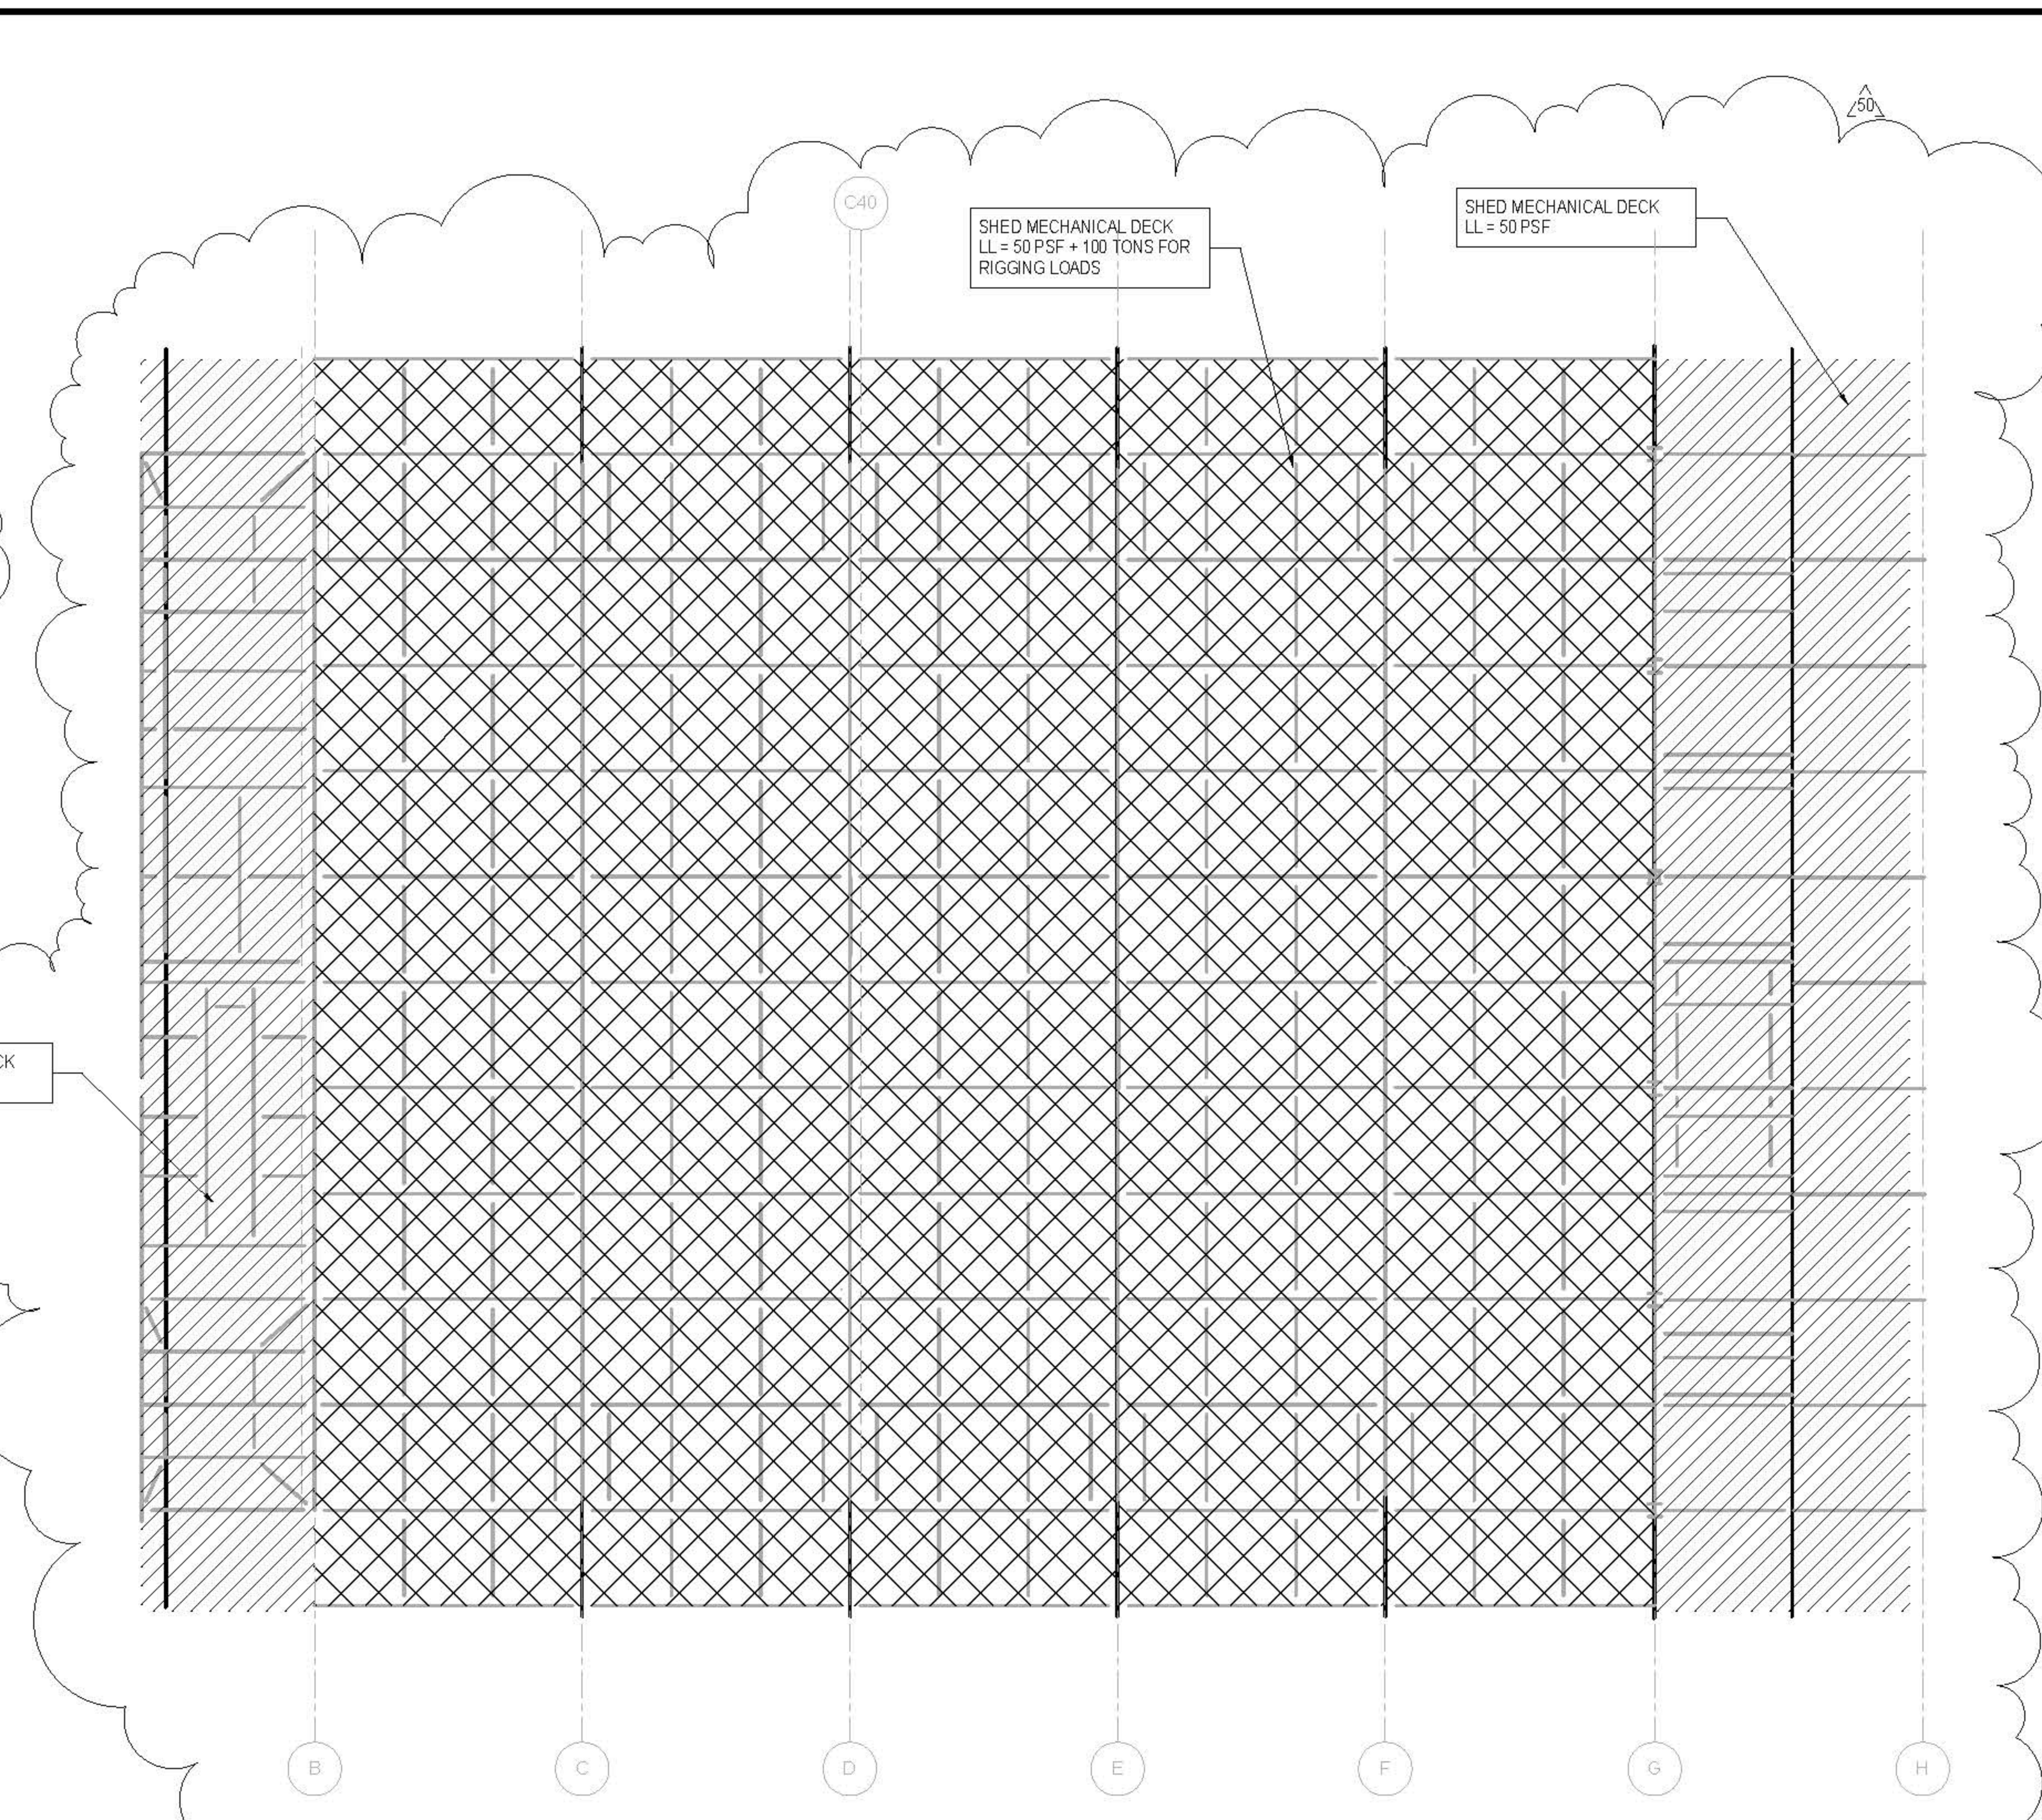

3 LOADING DIAGRAMS - SHED MECHANICAL DECK
1" = 10'-0"

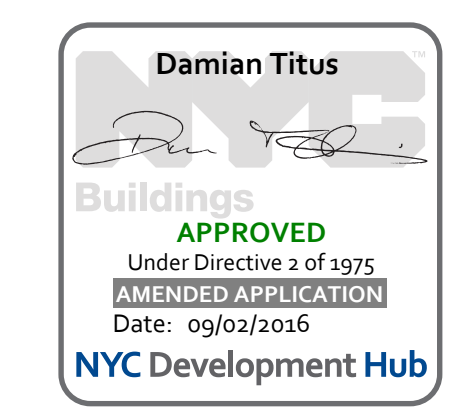

GEOMETRY, DIMENSIONS AND SURFACE CONTOURING, BLENDING AND INTERSECTION OF SECTIONS ILLUSTRATED IN THE STRUCTURAL DRAWINGS ARE PROVIDED FOR REFERENCE AND GENERATION OF STRUCTURAL ARRANGEMENT AND DETAILS ONLY. THE 3D MODEL ISSUED BY THE ARCHITECT DEFINES THE EXTERIOR SURFACE AND SHALL BE ADHERED TO FOR THE FINAL GEOMETRY. FOR DETAILS OF SECONDARY STEEL, INCLUDING STRUCTURAL CLADDING REFER TO ARCHITECTURE DRAWINGS. IT IS THE RESPONSIBILITY OF THE CONTRACTOR TO IDENTIFY ANY DISCREPANCIES OR AMBIGUITIES FOR DISCUSSION, RESOLUTION AND DIRECTION FROM THE ARCHITECT AND SER.

CULTURE SHED
545 West 30th Street
New York, New York 10001

OWNER
CULTURE SHED INC.

ARCHITECTS
Oller Scaletto + Renfro Architects, DPC
601 West 30th Street #815
New York, New York 10001
T: 212.260.7971

rockwellgroup
5 Union Sq West, 6th Fl
New York, New York 10003
T: 212.463.0334
F: 212.463.0335

STRUCTURAL ENGINEER
Thornton Tomasetti
51 Madison Avenue
New York, New York 10010
T: 917.661.7800
F: 917.661.7801

MEP ENGINEER
Jans Baum & Bolles
60 Pine Street
New York, New York 10005
T: 212.530.9300
F: 212.260.6964

FACADE CONSULTANT
Thornton Tomasetti
51 Madison Avenue
New York, New York 10010
T: 917.661.7800
F: 917.661.7801

KINETICS ENGINEER
Hadesky & Hanneke
1501 Broadway
New York, New York 10036
T: 212.944.1150
F: 212.399.0297

LIGHTING DESIGNER
Tilston Design Associates
40 North Street #1650
New York, New York 10013
T: 212.675.7760

THEATRE PLANNING & DESIGN
Fisher Dodge Associates
22 West 15th Street
New York, New York 10011
T: 212.691.3000

LIFE SAFETY
Code Consultants, Inc.
215 West 40th St, 15th Fl
New York, New York 10018
T: 212.216.9596

ENERGY MODEL/LEED
Vindan
50 Washington Street
Norwalk, CT 06854
T: 203.298.1411

ACOUSTIC/AUDIO-VISUAL
Avenille
50 North Main Street
South Norwalk, CT 06854
T: 347.210.5540

VERTICAL TRANSPORTATION
Van Dusen & Associates
5 Regent Street, Suite 524
Livingston, NJ 07039
T: 973.994.9220

SPECIFICATIONS
Construction Specifications Inc.
PO Box 489
227 Emmet Road
Morganville, NJ 07751
T: 732.970.0700
F: 732.970.0700

SECURITY
Duchella Venter & Santoro
100 Sherman Avenue
Hartford, CT 06114
T: 203.286.6490


WATERPROOFING
James R. Gahfort AIA Consulting Architects PC
104 West 27th Street
New York, NY 10001
T: 212.736.3344

FACADE MAINTENANCE
Erick Engineering PLLC
166 Ave. Street
New York, NY 10005
T: 212.986.3000

BRANDING GRAPHICS
2nd Global Design Consultancy
180 Varck Street 15th Floor
New York, NY 10014
T: 212.647.1170



KEY PLAN

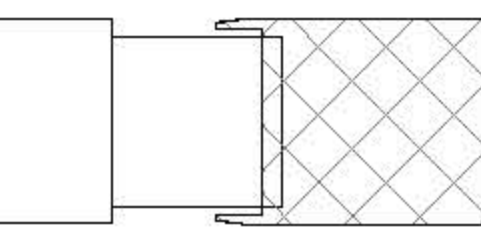

ISSUE Δ PRINTING DATE

ISSUE Δ	PRINTING	DATE
63	60	DOB AMENDMENT 7 03.29.2016
44	30	DOB AMENDMENT 6 04.02.2016
21		CONSTRUCTION SET 10.08.2015
10	4	100% CONSTRUCTION DOCUMENTS 03.18.2015
9		90% CONSTRUCTION DOCUMENTS 02.16.2015
6		PRELIMINARY DOB SUBMISSION 12.10.2014
1		ADVANCED PROCUREMENT BID SET 06.16.2014

STAMP



DRAWN BY: Anthony
CHECKED BY: Chris


PROJECT NUMBER: NY1318.00

TITLE: AXONOMETRIC - DEPLOYED SHED (SE)


DRAWING NO.: S-052.01

B.SCAN NO.: S-052.01

16 of 123

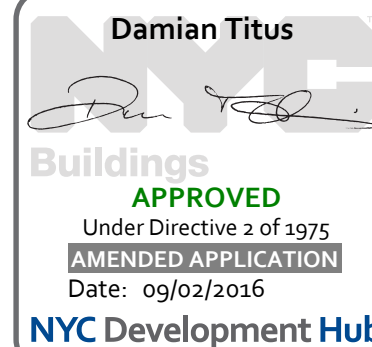

NOTE: AXONOMETRIC VIEWS SHOW PRIMARY STEEL/TERTIARY AND QUAD ELEMENTS. REFER TO ARCHITECTURAL AND STRUCTURAL DRAWINGS FOR LAYOUT, CONFIGURATION AND DETAILS.
OPERABLE DOORS, MOVING MECHANISM, SECONDARY STEEL AND MECHANICAL DECK OMITTED FOR CLARITY.

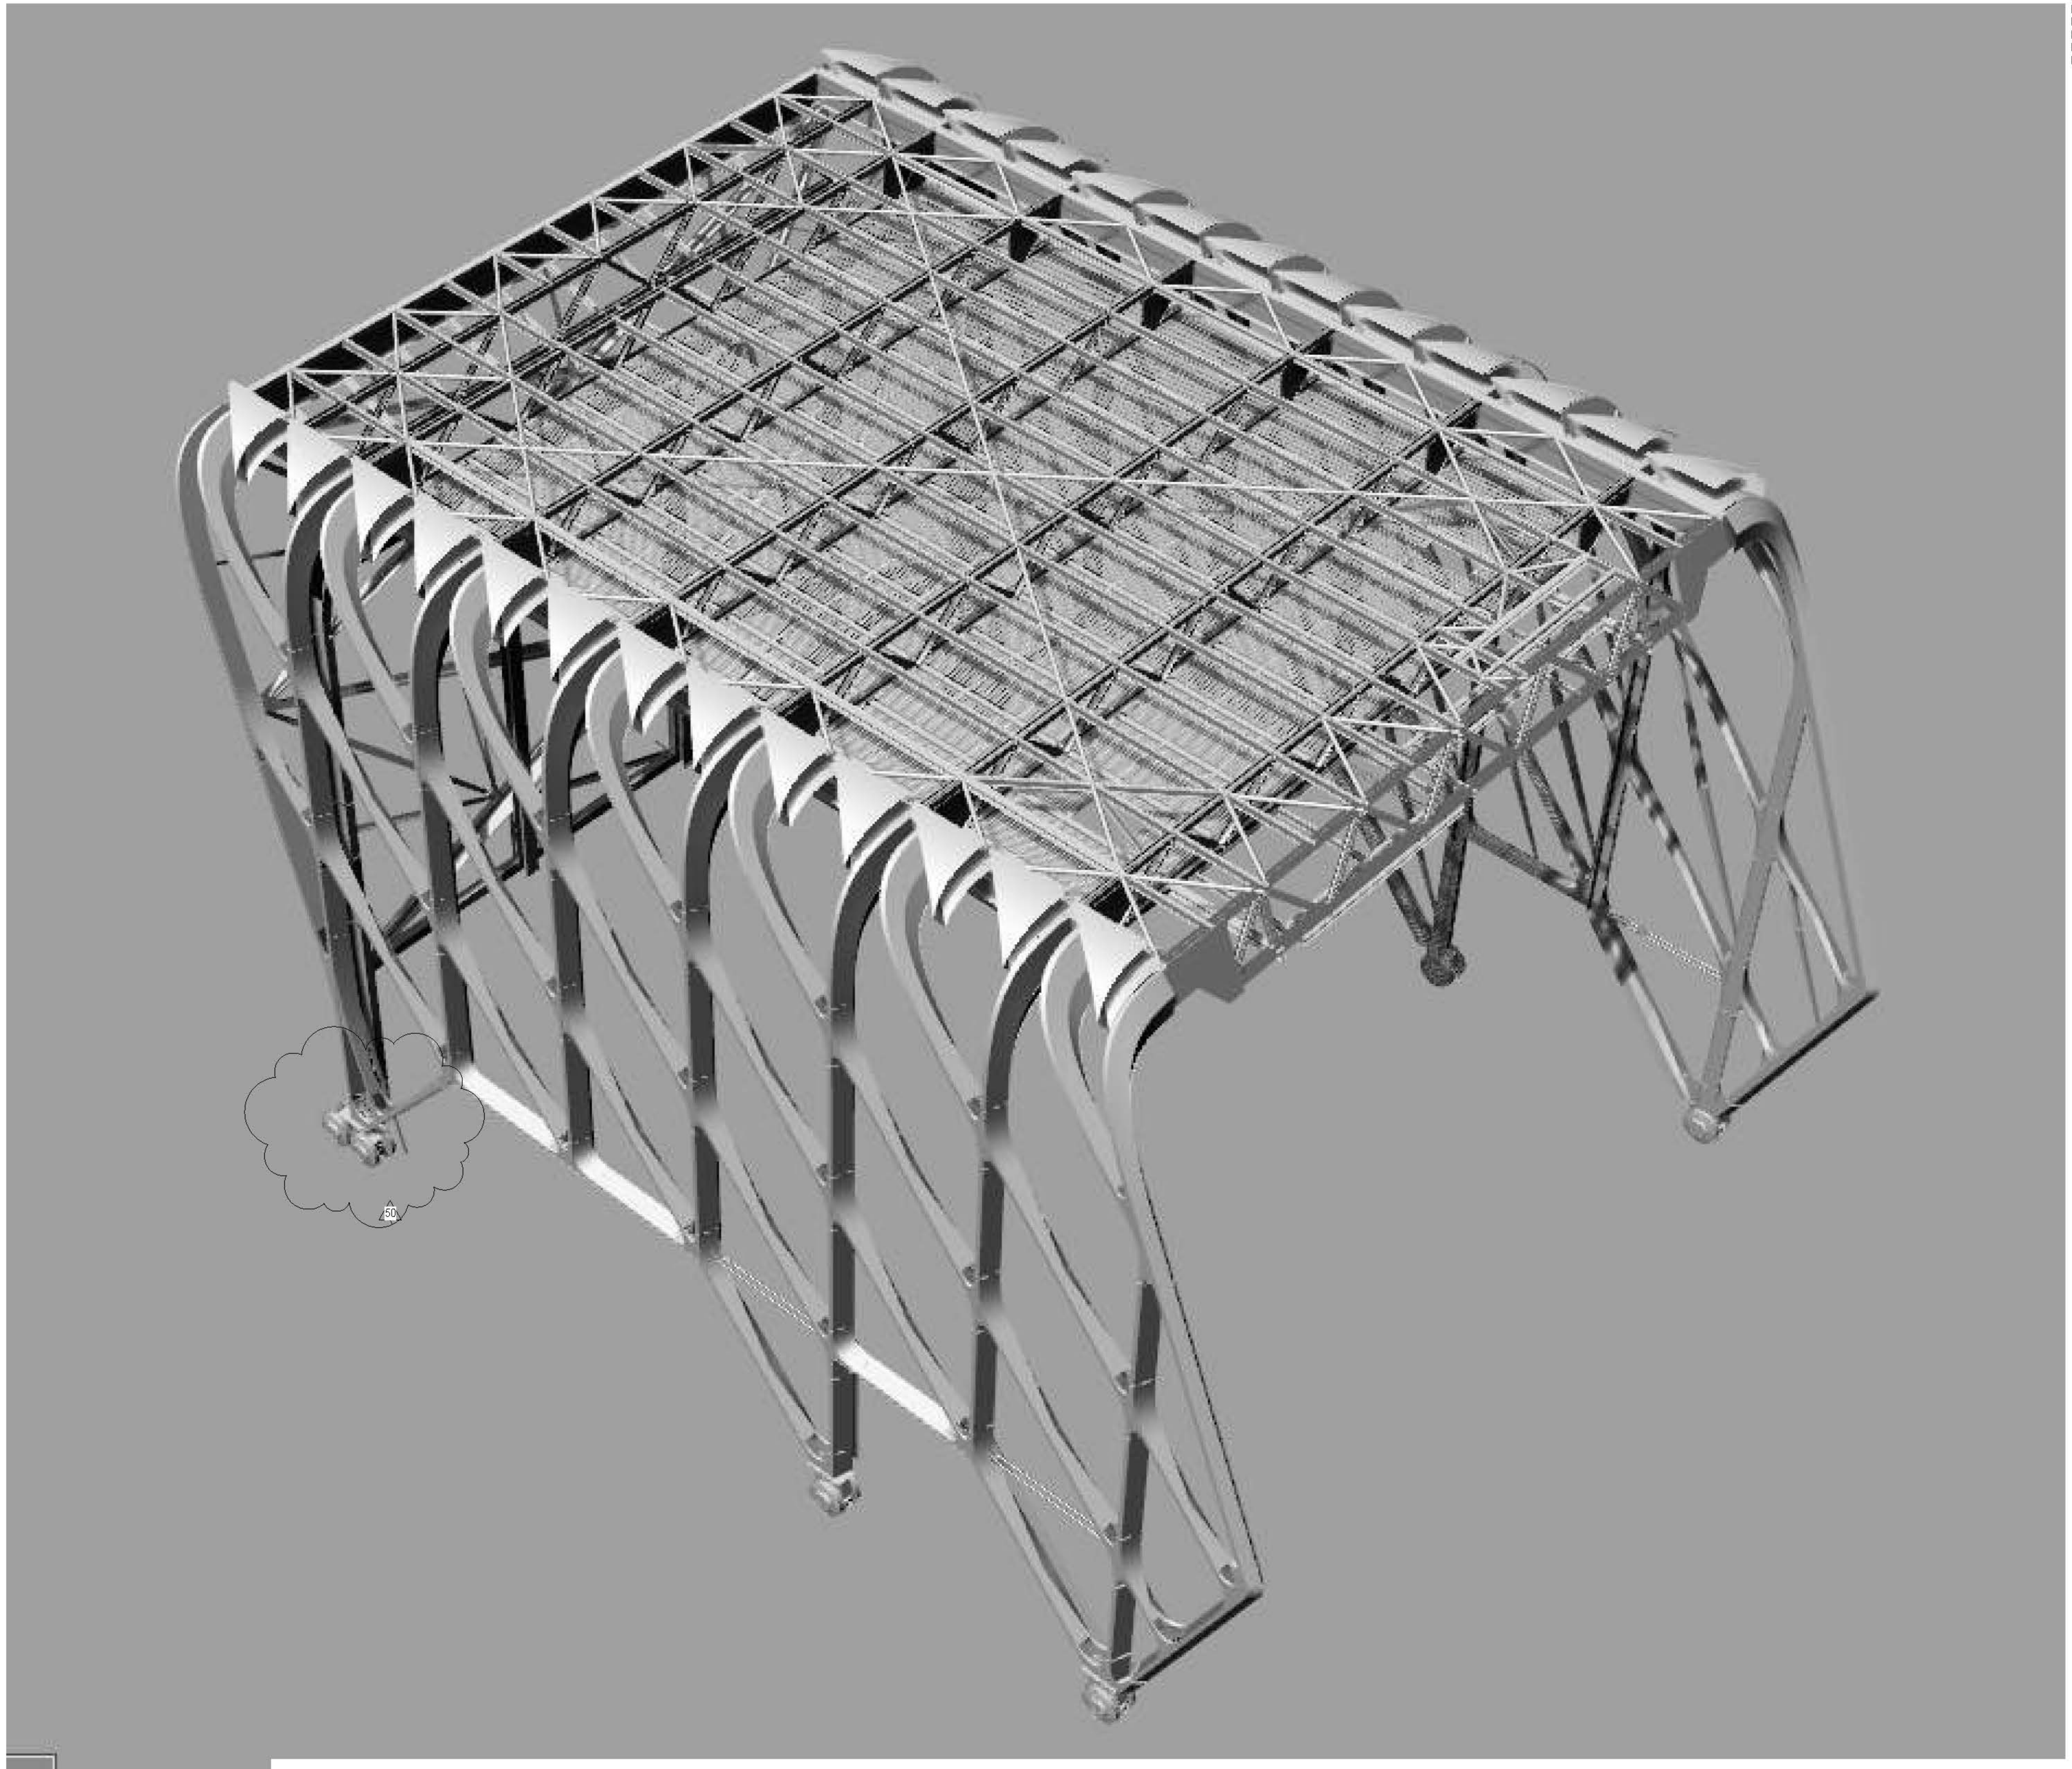

GEOMETRY, DIMENSIONS AND SURFACE CONTOURING, BLENDING AND INTERSECTION OF SECTIONS ILLUSTRATED IN THE STRUCTURAL DRAWINGS ARE PROVIDED FOR REFERENCE AND GENERATION OF STRUCTURAL ARRANGEMENT AND DETAILS ONLY. THE 3D MODEL ISSUED BY THE ARCHITECT DEFINES THE EXTERIOR SURFACE AND SHALL BE ADHERED TO FOR THE FINAL GEOMETRY. FOR DETAILS OF SECONDARY STEEL, INCLUDING STRUCTURAL CLADDING REFER TO ARCHITECTURE DRAWINGS. IT IS THE RESPONSIBILITY OF THE CONTRACTOR TO IDENTIFY ANY DISCREPANCIES OR AMBIGUITIES FOR DISCUSSION, RESOLUTION AND DIRECTION FROM THE ARCHITECT AND SER.

CULTURE SHED

545 West 30th Street
New York, New York 10001

OWNER
CULTURE SHED INC.

ARCHITECTS
Oller Scaife + Renfro Architects, DPC
601 West 30 Street #815
New York, New York 10001
T: 212.260.7971

rockwellgroup
5 Union St. West, 6th Fl.
New York, New York 10003
T: 212.463.0334
F: 212.463.0335

STRUCTURAL ENGINEER
Thornton Tomasetti
51 Madison Avenue
New York, New York 10010
T: 917.861.7800
F: 917.861.7801

MEP ENGINEER
Jans Baum & Bolles
60 Pine Street
New York, New York 10005
T: 212.530.9300
F: 212.260.6944

FACADE CONSULTANT
Thornton Tomasetti
51 Madison Avenue
New York, New York 10010
T: 917.861.7800
F: 917.861.7801

KINETICS ENGINEER
Hardisty & Hancock
1501 Broadway
New York, New York 10036
T: 212.944.1150
F: 212.399.0297

LIGHTING DESIGNER
Tilston Design Associates
40 Worth Street #160
New York, New York 10013
T: 212.675.7760

THEATRE PLANNING & DESIGN
Fisher Dodge Associates
22 West 15th Street
New York, New York 10011
T: 212.691.3000

LIFE SAFETY
Code Consultants, Inc.
215 West 40th St, 15th Fl.
New York, New York 10018
T: 212.216.9596

ENERGY MODEL/LEED
Vindian
60 Washington Street
Norwalk, CT 06854
T: 203.298.1411

ACOUSTIC/AUDIO-VISUAL
Avenille
93 North Main Street
South Norwalk, CT 06854
T: 347.210.5540

VERTICAL TRANSPORTATION
Van Dusen & Associates
5 Regent Street, Suite 524
Livingston, NJ 07039
T: 973.994.9220

SPECIFICATIONS
Construction Specifications Inc.
PO Box 489
227 Emmet Road
Morganville, NJ 07751
T: 732.970.0700
F: 732.970.0700


SECURITY
Duchella Venter & Santoro
1100 Sherman Avenue
Hartford, CT 06114
T: 203.286.6490

WATERPROOFING
James R. Gahfort AIA Consulting Architects PC
104 West 27th Street
New York, NY 10001
T: 212.736.3344

FACADE MAINTENANCE
Erick Engineering PLLC
166 Arden Street
New York, NY 10005
T: 212.698.3000

BRANDING GRAPHICS
2nd Global Design Consultancy
180 Varck Street 15th Floor
New York, NY 10014
T: 212.647.1170

KEY PLAN

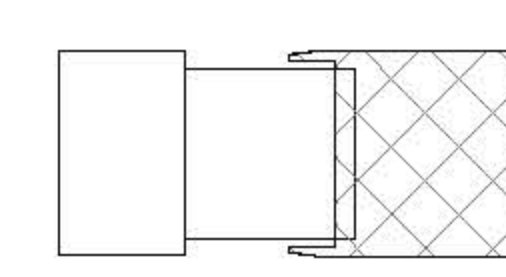

ISSUE Δ PRINTING DATE

ISSUE Δ	PRINTING	DATE	
63	60	DOB AMENDMENT 7	03/19/2016
44	30	DOB AMENDMENT 6	04/02/2016
21		CONSTRUCTION SET	10/08/2015
10	4	100% CONSTRUCTION DOCUMENTS	03/18/2015
9		90% CONSTRUCTION DOCUMENTS	02/16/2015
6		PRELIMINARY DOB SUBMISSION	12/10/2014
1		ADVANCED PROCUREMENT BID SET	06/16/2014



DRAWN BY: **Autrey** CHECKED BY: **Chris**

PROJECT NUMBER: **N1318.00**

TITLE: **AXONOMETRIC - DEPLOYED SHED (MV)**

DRAWING NO.: **S-053.01**

B.SCAN NO.: **S-053.01**

17 of 123



NOTE: AXONOMETRIC VIEWS SHOW PRIMARY STEEL/TERTIARY AND QUAD ELEMENTS. REFER TO ARCHITECTURAL AND STRUCTURAL DRAWINGS FOR LAYOUT, CONFIGURATION AND DETAILS.

OPERABLE DOORS, MOVING MECHANISM, SECONDARY STEEL AND MECHANICAL DECK OMITTED FOR CLARITY.

CULTURE SHED

540 West 30th Street
New York, New York 10001

OWNER
CULTURE SHED INC.

ARCHITECTS
Oller Scaffolds + Renfro Architects, DPC
601 West 26th Street #815
New York, New York 10001
T: 212.263.7971

rackwellgroup
5 Union St. West, 6th Flr
New York, New York 10003
T: 212.463.0334
F: 212.463.0335

STRUCTURAL ENGINEER
Thornton Tomasetti
51 Madison Avenue
New York, New York 10010
T: 917.991.7800
F: 917.991.7801

MEP ENGINEER
Jana Baum & Bolles
63 Pine Street
New York, New York 10005
T: 212.530.9300
F: 212.236.6944

FAÇADE CONSULTANT
Thornton Tomasetti
51 Madison Avenue
New York, New York 10010
T: 917.991.7800
F: 917.991.7801

KINETICS ENGINEER
Hardsy & Harnow
1501 Broadway
New York, New York 10036
T: 212.944.1150
F: 212.391.0297

LIGHTING DESIGNER
Tilston Design Associates
40 North Street #1650
New York, New York 10013
T: 212.675.7760

THEATRE PLANNING & DESIGN
Fisher Dodge Associates
22 West 15th Street
New York, New York 10011
T: 212.691.3000

LIFE SAFETY
Code Consultants, Inc.
215 West 43rd St, 15th Flr
New York, New York 10018
T: 212.216.9596

ENERGY MODEL/LEED
Vindian
53 Washington Street
Norwalk, CT 06854
T: 203.298.1411

ACOUSTIC/AUDIO-VISUAL
Avenelle
93 North Main Street
South Norwalk, CT 06854
T: 347.210.5540

VERTICAL TRANSPORTATION
Van Dusen & Associates
5 Regent Street, Suite 524
Livingston, NJ 07039
T: 973.994.9220

SPECIFICATIONS
Construction Specifications Inc.
PO Box 489
227 Tenth Road
Morganville, NJ 07751
T: 732.970.0700
F: 732.970.0750



SECURITY
Duchella Venter & Santoro
1100 Sherman Avenue
Hartford, CT 06114
T: 203.286.6490

WATERPROOFING
James R. Gahfort AIA Consulting Architects PC
104 West 27th Street
New York, NY 10001
T: 212.736.3344

FAÇADE MAINTENANCE
Frank Engineering PLLC
152 Arden Street
New York, NY 10005
T: 212.986.3000

BRANDING/GRAPHICS
2nd Global Design Consultancy
180 Varck Street 15th Floor
New York, NY 10014
T: 212.647.1170

KEY PLAN

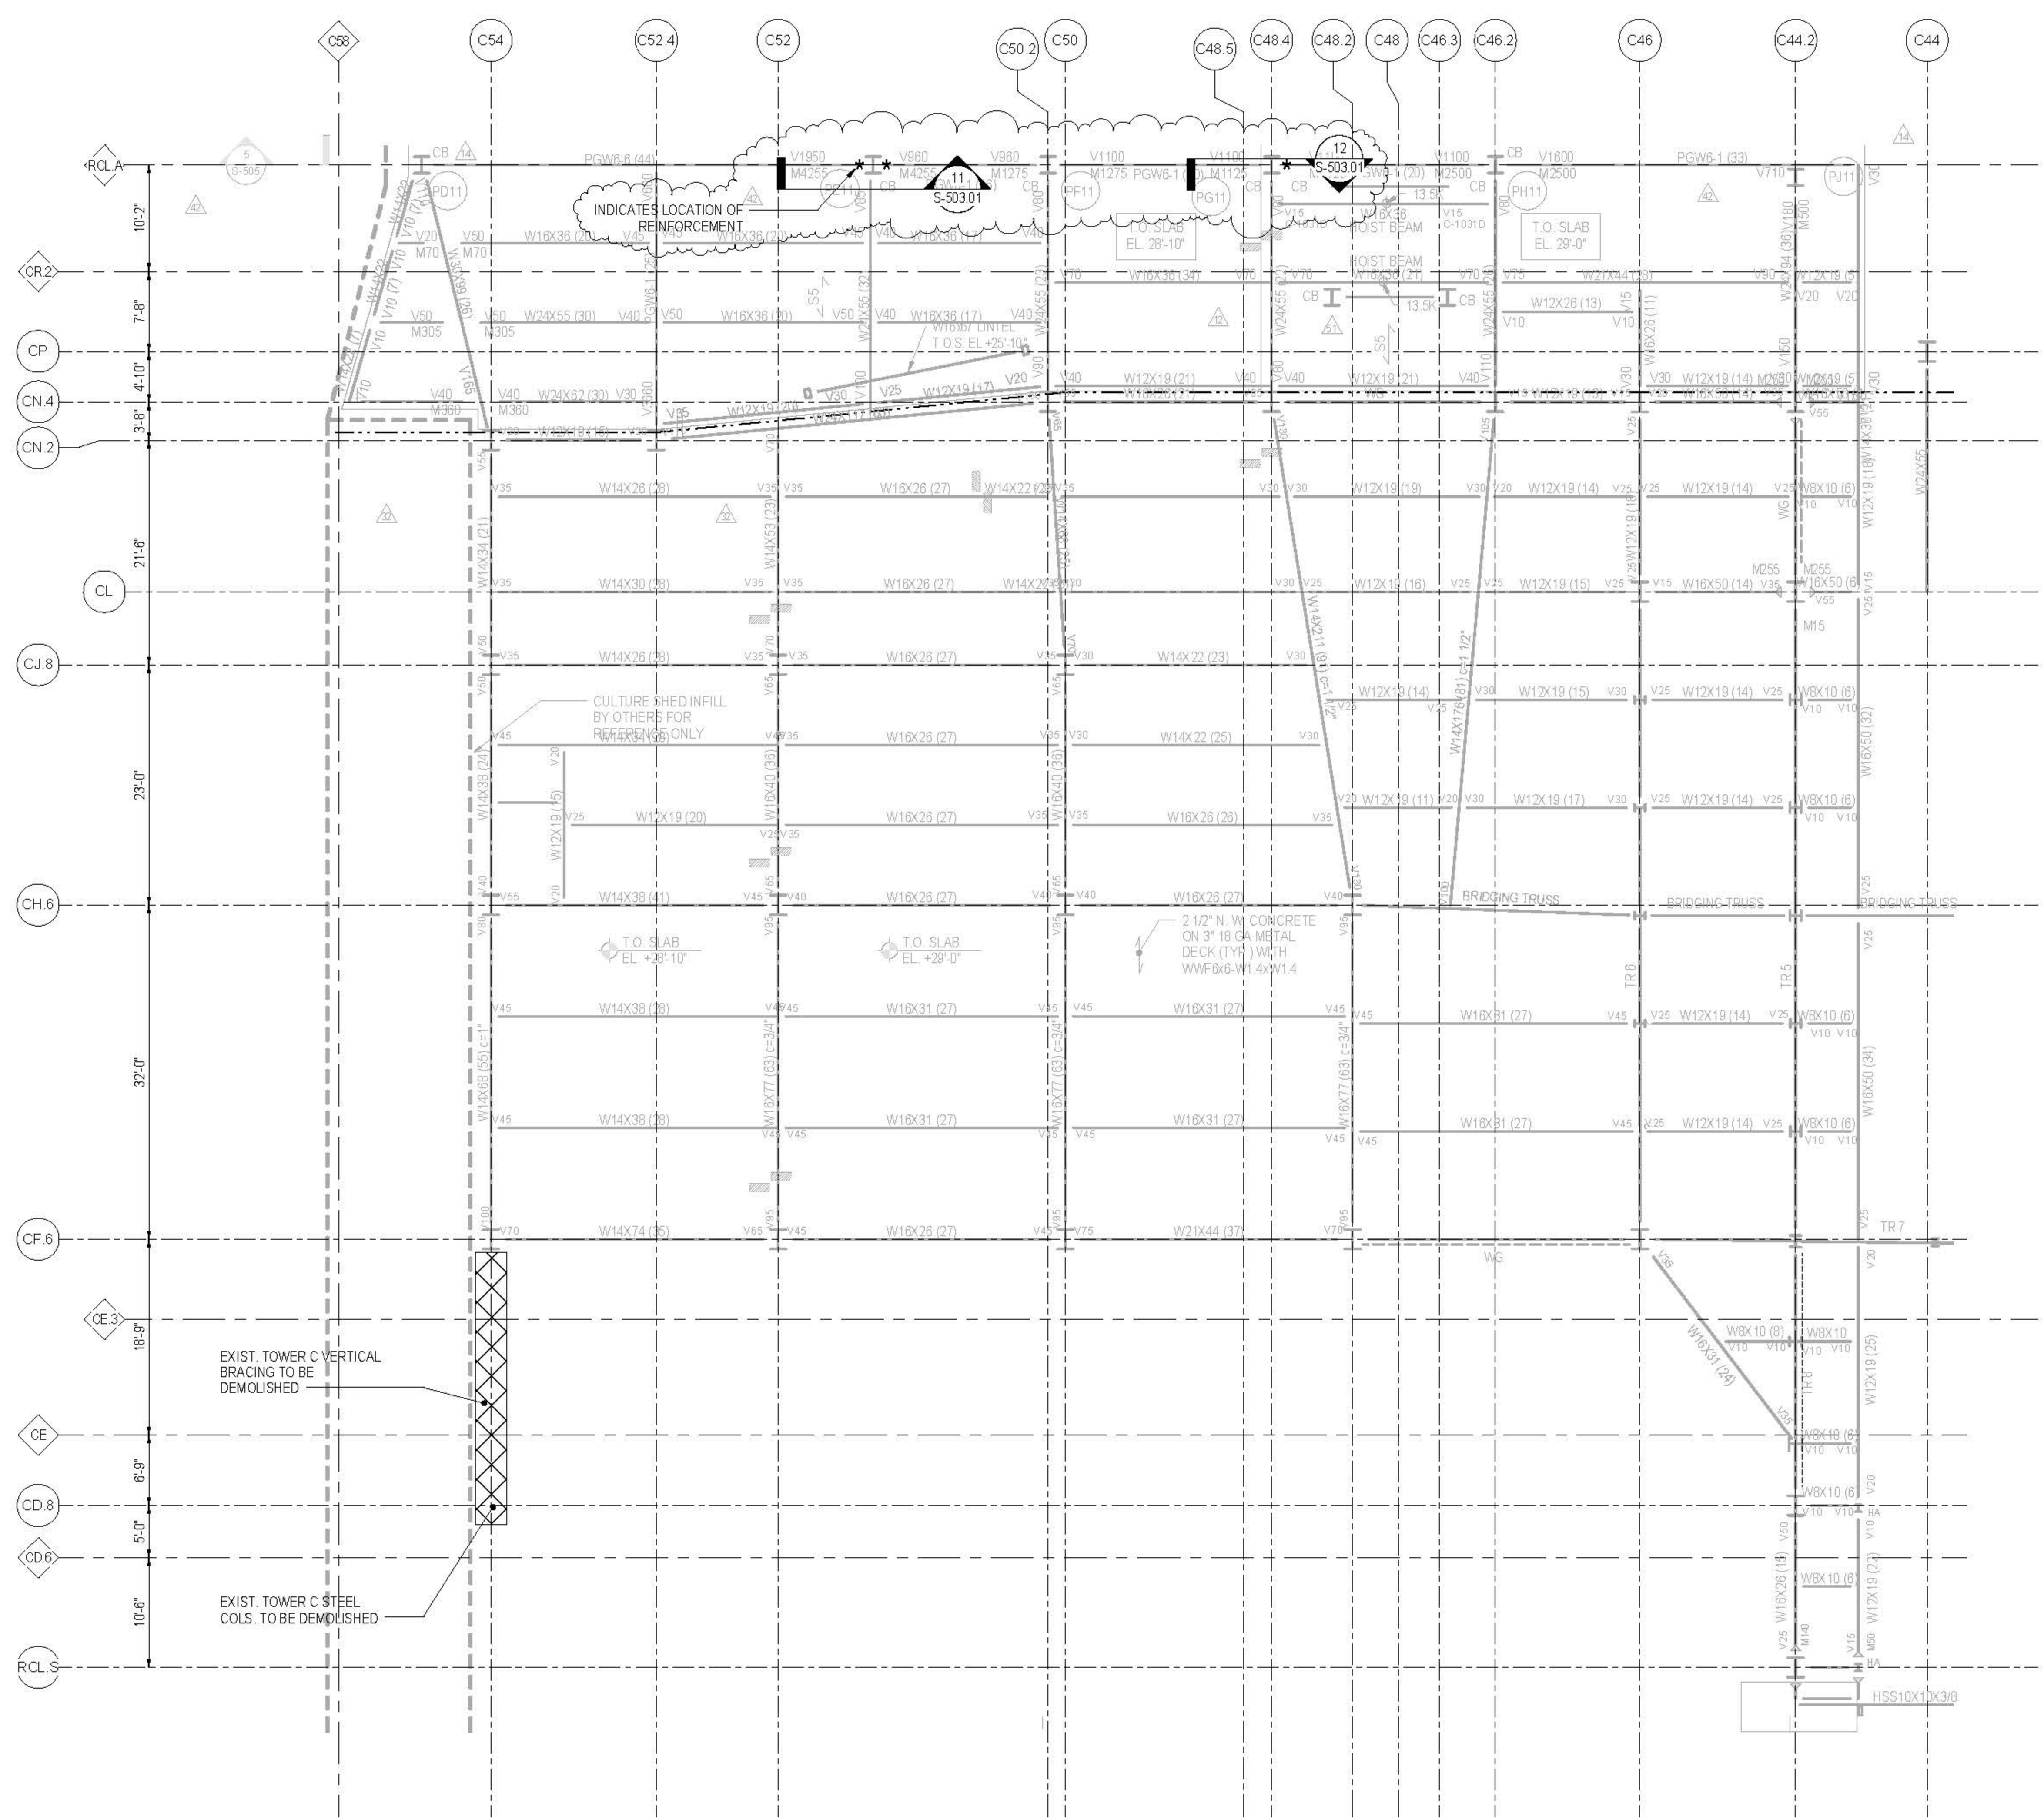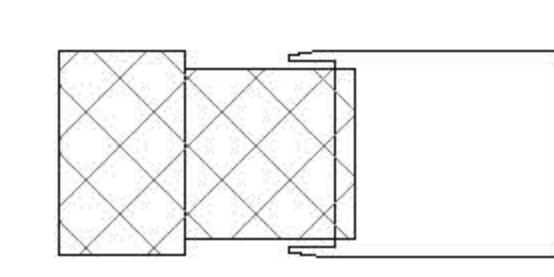

1 LEVEL 01 OVERALL DEMOLITION AND SLAB INFILL KEY PLAN
1/8" = 1'-0"

ISSUE	PRINTING	DATE
01	018 AMENDMENT 7	08.19.2016
02	ASME'S BULLETIN #6	09.17.2015
10	100% CONSTRUCTION DOCUMENTS	03.18.2016
9	90% CONSTRUCTION DOCUMENTS	02.16.2016
6	PRELIMINARY CDR SUBMISSION	12.16.2014
1	ADVANCED PROCUREMENT BID SET	06.16.2014

STAMP



DRAWN BY: *Autum* CHECKED BY: *Chris*


PROJECT NUMBER: N11318.00

TITLE: DEMOLITION AND INFILL PLAN, FIXED BUILDING LEVEL 01

DRAWING NO.: 8-D101.01

B.SCAN NO.: S-081.01

19 of 123

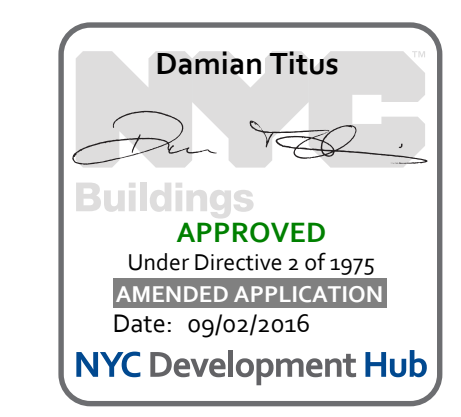


SHEET NOTES:




1. T/STEEL SLAB EL+28'-0" UON
2. T/STEEL EL+28'-6 1/2"
3. INDICATES DECK SPAN DIRECTION, REFER TO COMPOSITE STEEL DECK SCHEDULE INFORMATION.
4. FOR ADDITIONAL INFORMATION REFER TO THE FOLLOWING DRAWINGS:
DRAWING LISTS, GENERAL NOTES, AND S-000 SERIES DRAWINGS
LOADING DIAGRAMS
5. LATERAL SYSTEM ELEVATIONS, CONNECTION FORCES, AND DETAILS S-300 SERIES DRAWINGS
6. STEEL SUPERSTRUCTURE SCHEDULES AND DETAILS S-700 SERIES DRAWINGS
7. STEEL COLUMN SCHEDULES AND DETAILS S-800 SERIES DRAWINGS
8. AT STAIRS, SEE TYPICAL DETAILS FOR TC, TCS, AND KICKER REQUIREMENTS 1, 2 & 3S-704
9. REFER TO ARCH DWGS FOR LOCATION AND SIZE OF OPENINGS. SEE ALSO GENERAL NOTE GR-18 AND TYPICAL DETAIL 1/S-713

- SYMBOLS:
- INDICATES MOMENT CONNECTION
 - INDICATES DEEP BEAM BOTTOM FLANGE BRACING CONNECTION SEE DETAIL 6/S-703
 - INDICATES FULL HEIGHT FITTED STIFFENER CONNECTION SEE DETAIL 4/S-703
 - INDICATES FULL HEIGHT UNFITTED STIFFENER CONNECTION SEE DETAIL 5/S-703
 - INDICATES KICKER AT SPANDREL BEAM CONNECTION SEE DETAIL 3/S-703
 - INDICATES SLOPE IN TOP OF SLAB
 - INDICATES BEAM SPLICE CONNECTION, SEE SECTION 14, S-721

8. NOTATIONS:
- BF INDICATES LATERAL BRACED FRAME
 - CA/CB INDICATES COLUMN ABOVE/BELOW, COMPRESSION AXIAL FORCE IN COLUMN INDICATED WHERE APPLICABLE. SEE DETAIL 1/S-702 & 2/S-702
 - CBX INDICATES CASTELLATED BEAM. SEE SCHEDULE 1/S-402
 - DB INDICATES HSSB4X38 ELEVATOR DIVIDER BEAM (NOT FIREPROOFED)
 - HAHB INDICATES HANGER ABOVE/BELOW, TENSION AXIAL FORCE IN HANGER BELOW INDICATED WHERE APPLICABLE. SEE DETAIL 3/S-702
 - MF INDICATES LATERAL MOMENT FRAME
 - PCX INDICATES COLUMN FROM ABOVE TRANSFERS, COMPRESSION AXIAL FORCE IN COLUMN INDICATED WHERE APPLICABLE. SEE DETAIL 1/S-702
 - PCXT INDICATES TAPERED PLATE GIRDER. SEE DETAIL 1/S-704
 - TC INDICATES TORSIONAL CONNECTION FOR STAIR. SEE DETAIL 1/S-704
 - TR INDICATES COLUMN FROM ABOVE TRANSFERS, COMPRESSION AXIAL FORCE IN COLUMN INDICATED WHERE APPLICABLE. SEE DETAIL 1/S-702
 - C1 INDICATES PG8X24 COLUMN BELOW
 - C2 INDICATES PG8X24 COLUMN FROM LOWER ROOF TO UPPER ROOF LEVEL
 - C3 INDICATES PG8X24 COLUMN FROM LEVEL 00 TO UPPER ROOF LEVEL
 - C4 INDICATES SHS150X150X10 POST FROM LOWER ROOF TO TOP OF PARAPET, SEE SECTION

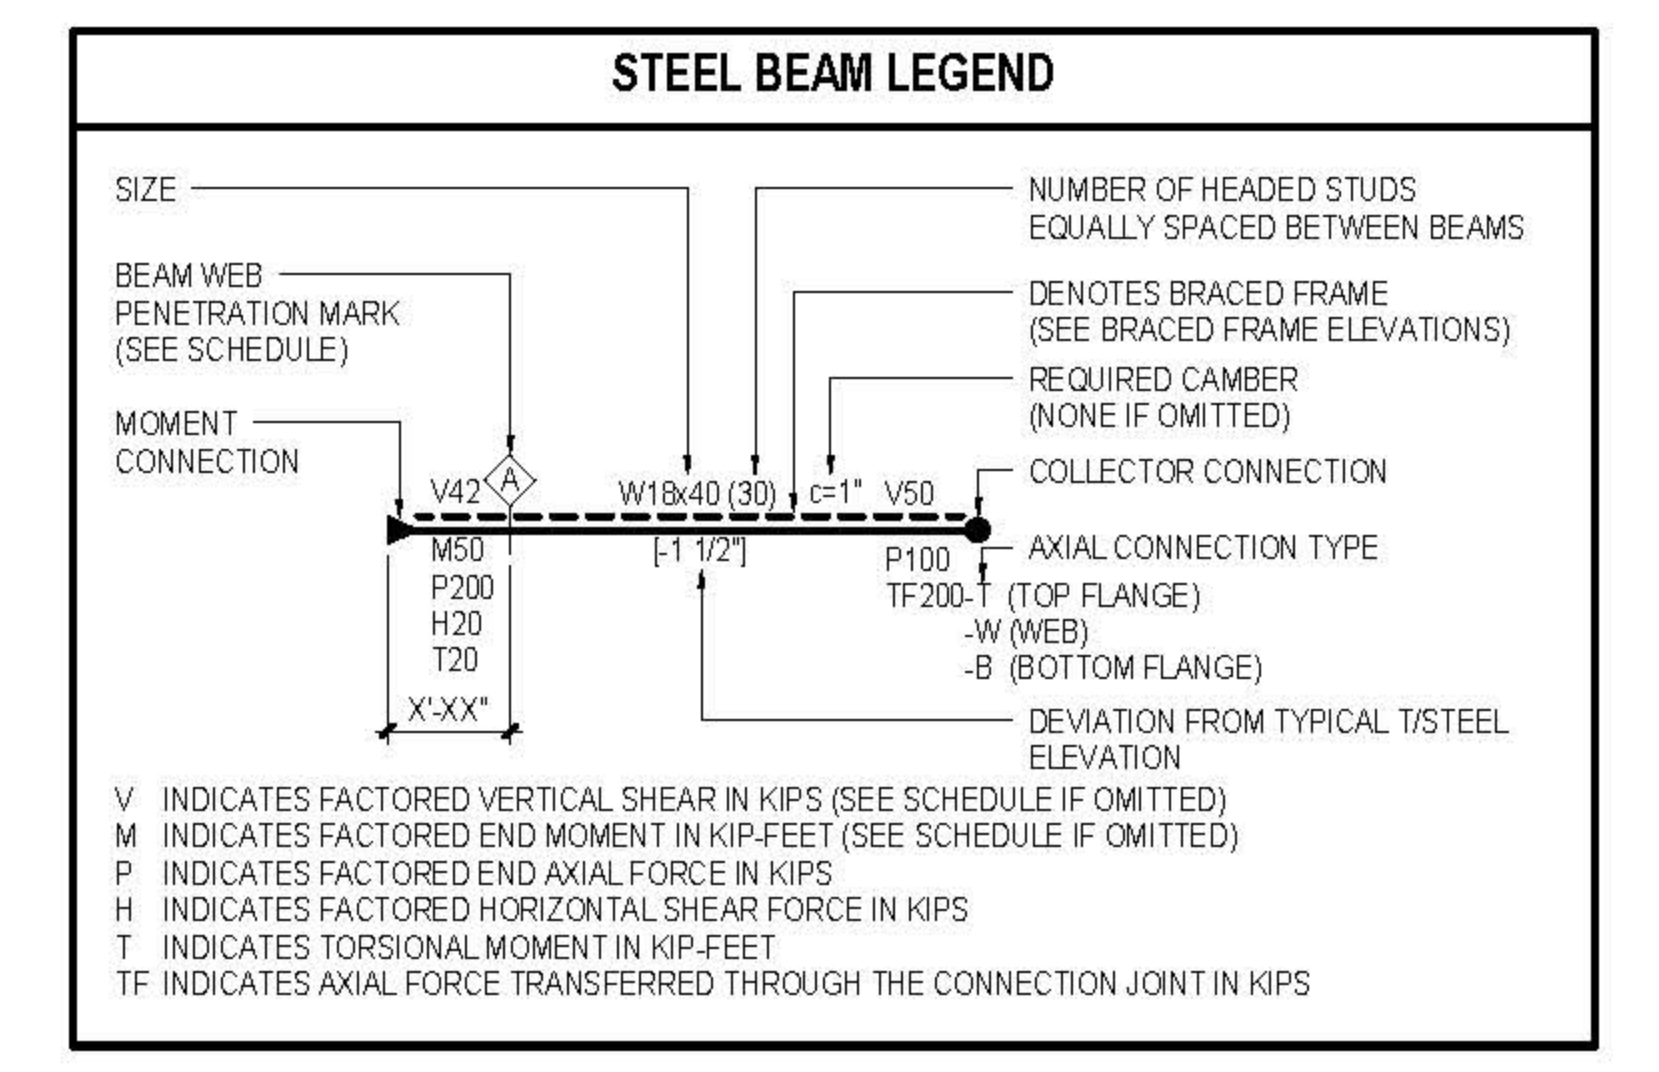

SLAB MARK	TOTAL SLAB THICKNESS AND CONCRETE TYPE	STEEL DECK (MIN)	CONCRETE TOPPING SLAB	SLAB REINFORCEMENT	NOTES
S1	5 1/2" NWC	3'-18 GA		6 x 6 - W4 D x W4 D WWR	
S2	7 1/2" NWC	3'-18 GA		4 x 4 - W4 D x W4 D WWR	
S3	8" NWC	3'-18 GA		#4 @ 16" O.C. EACH WAY	
S4	4" NWC	1 1/2" - 18 GA		6 x 6 - W29 x W29 WWR	
S5	8 1/2" NWC	3'-18 GA		#4 @ 12" O.C. N.S. #4 @ 18" O.C. E-W	N.S. BARS COORDINATED TO MECHANICAL COUPLERS IN EXISTING SLAB

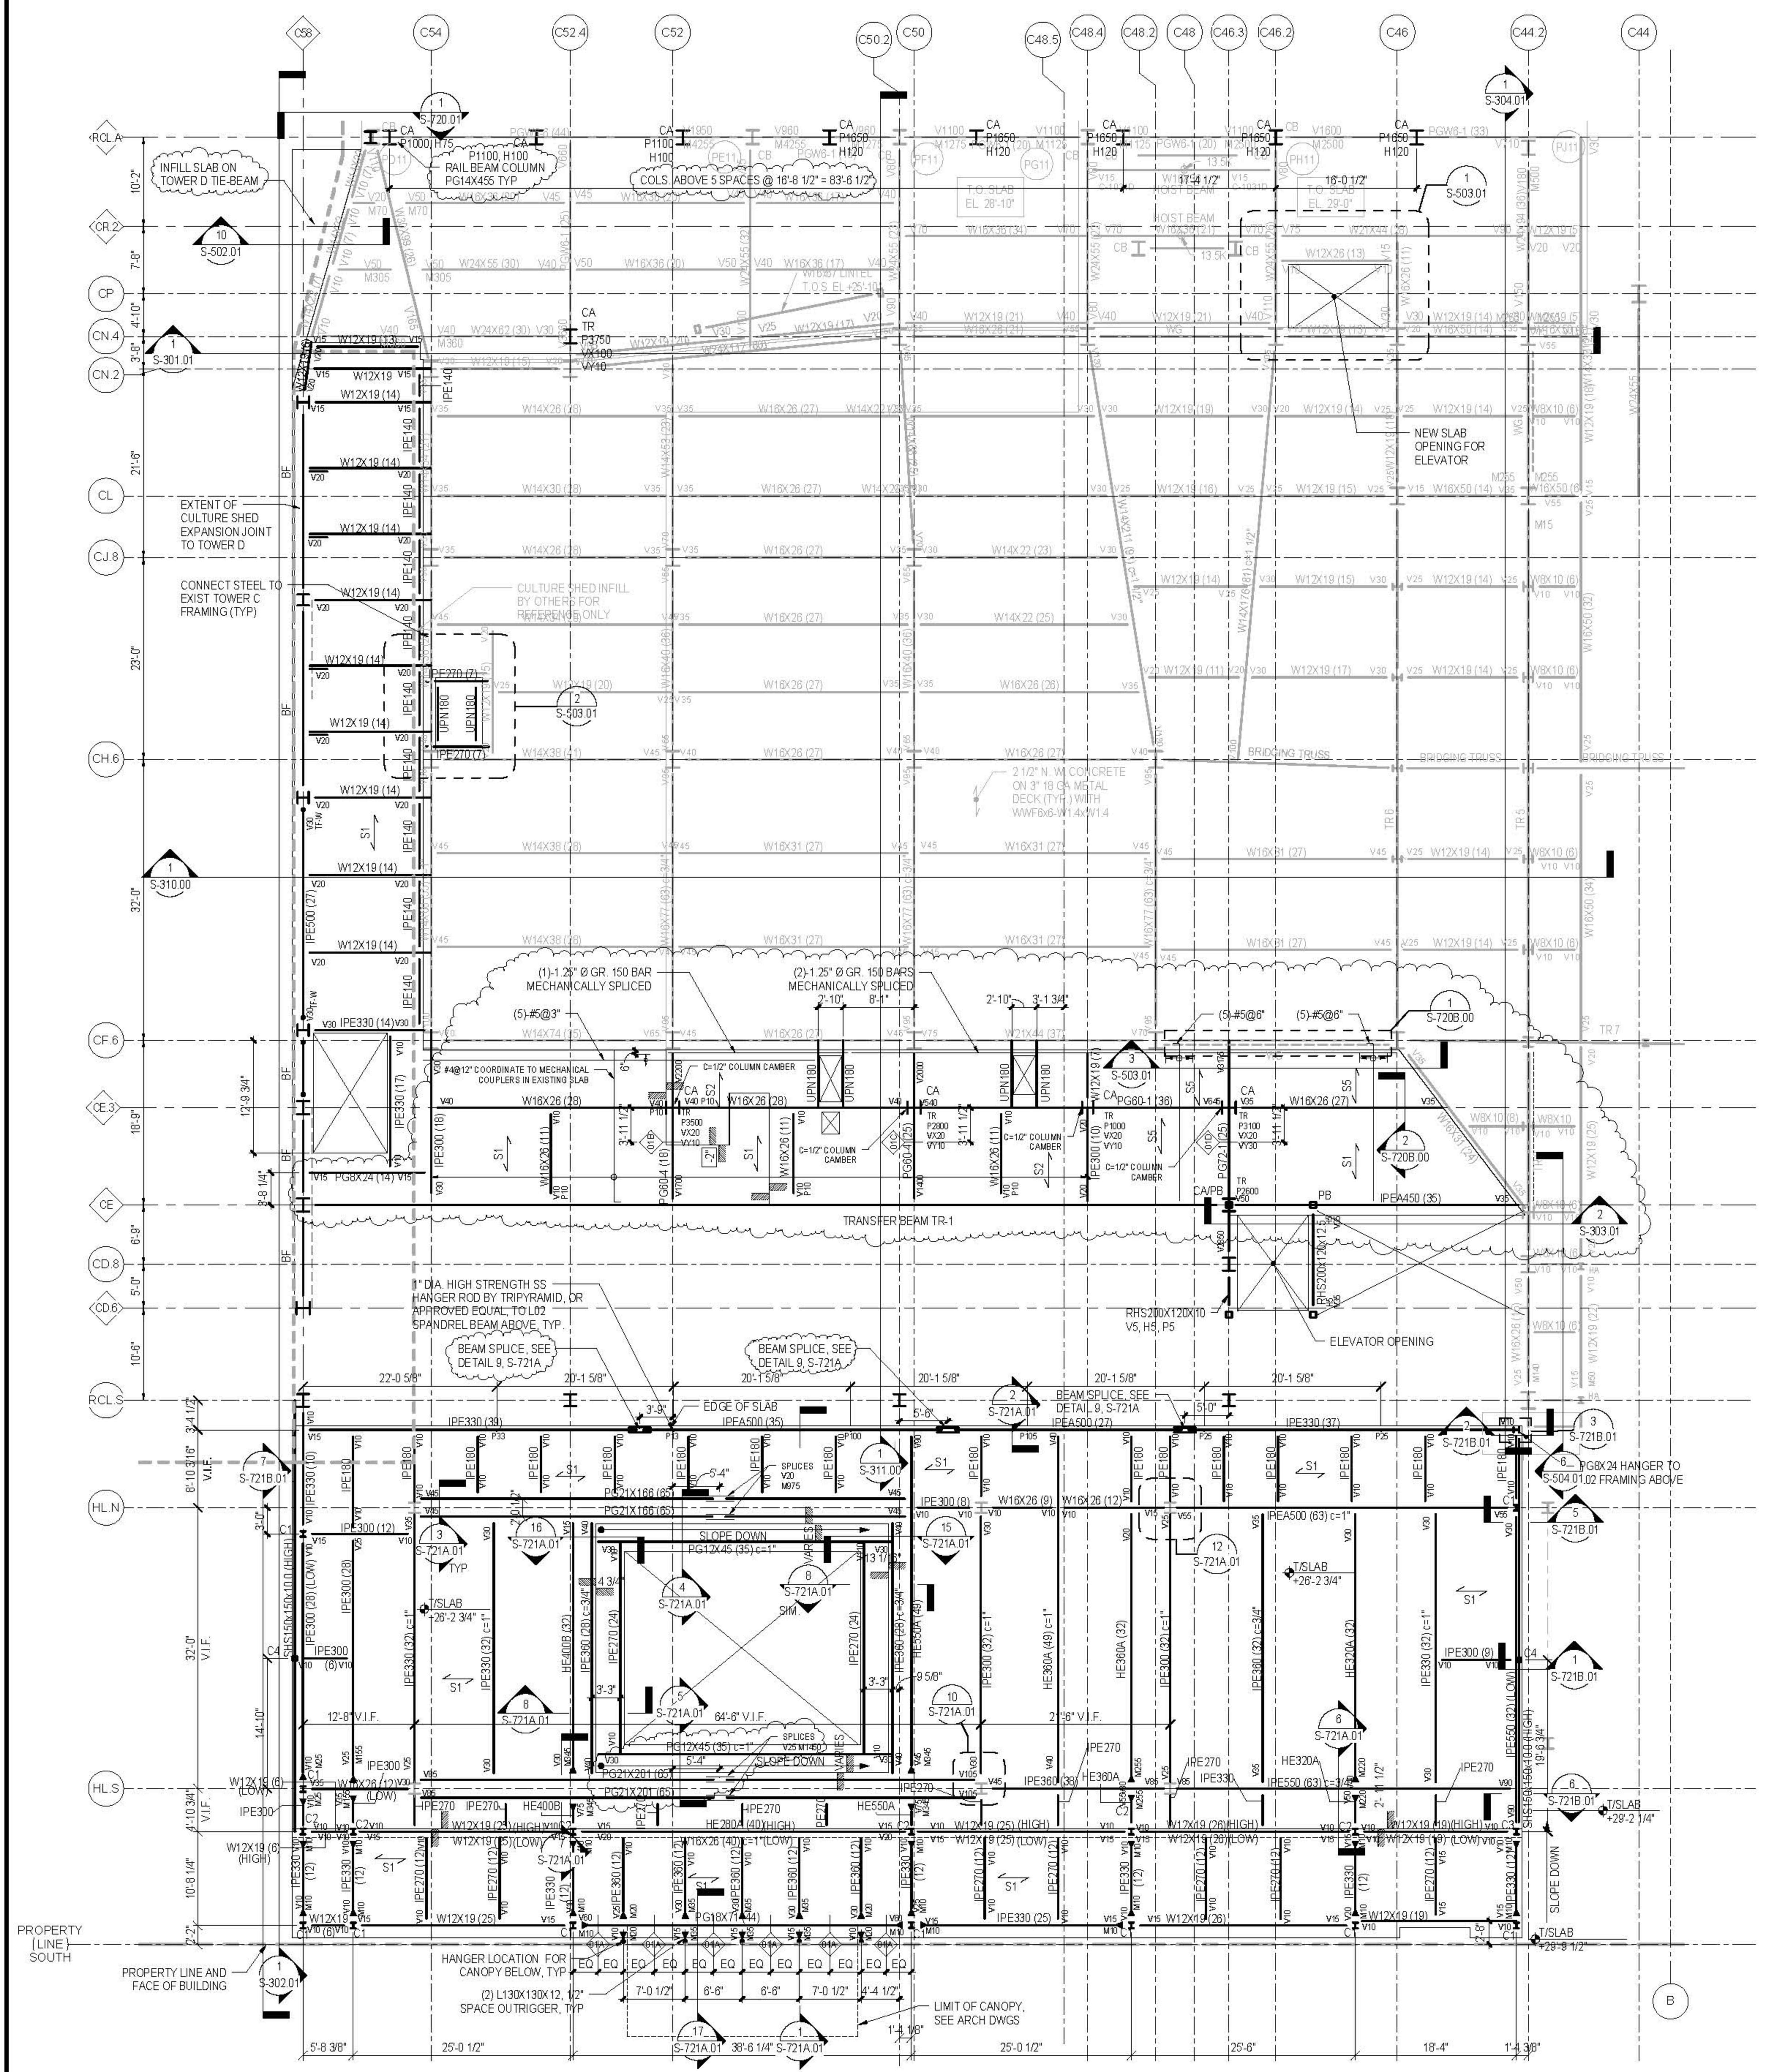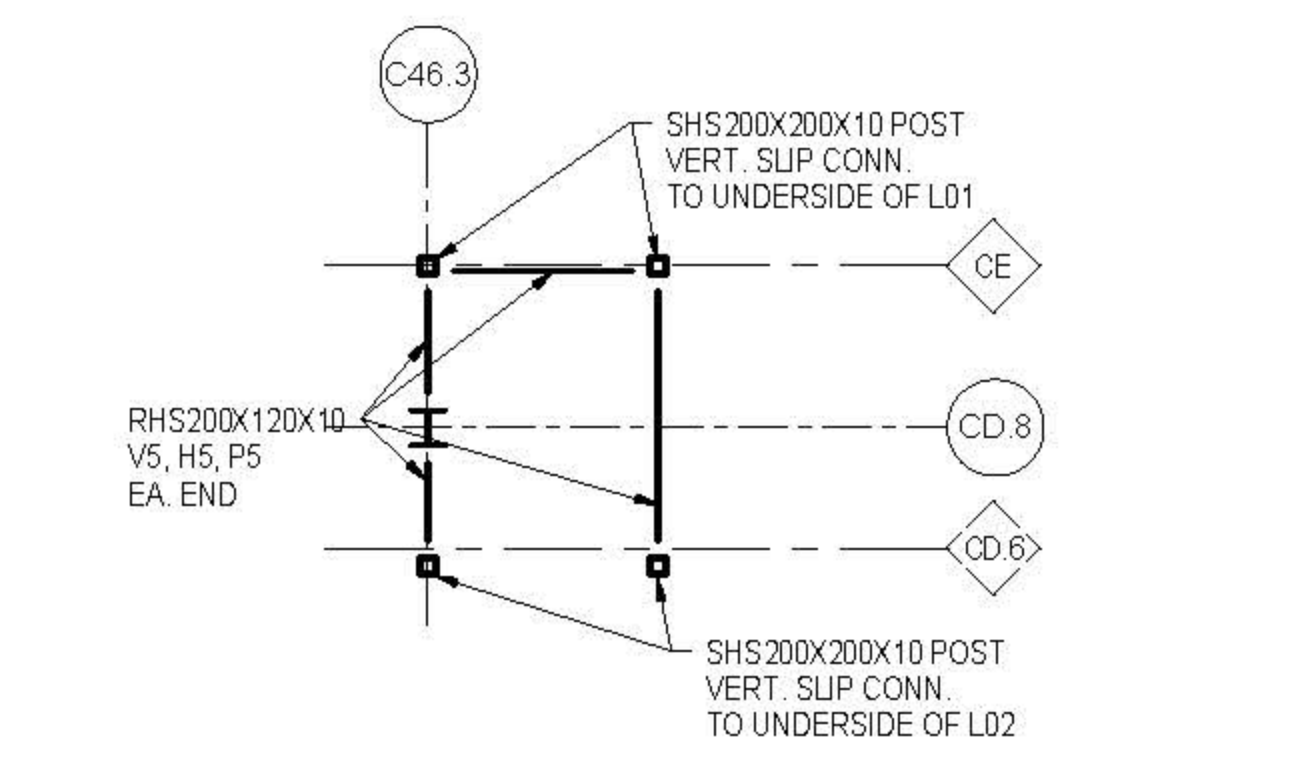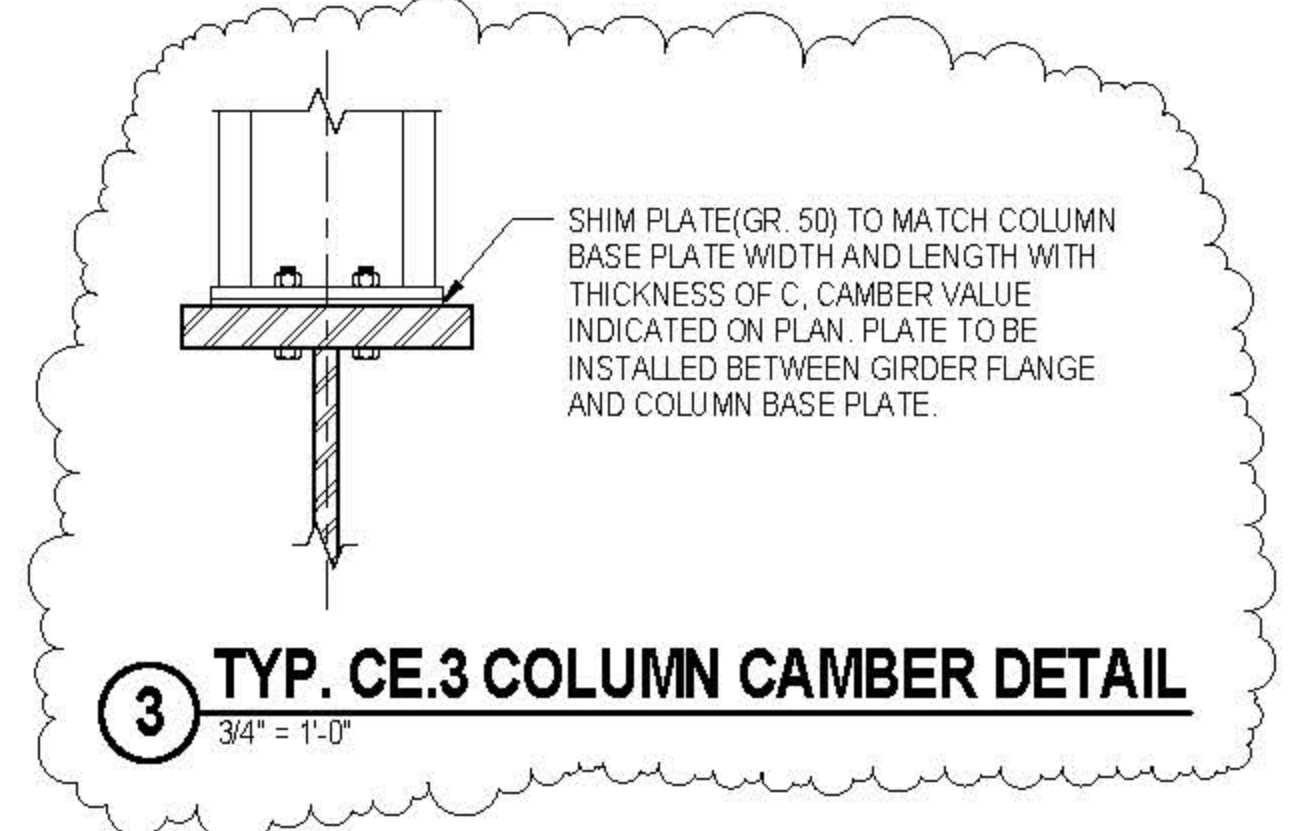

ISSUE

NO.	DESCRIPTION	DATE
01	DOB AMENDMENT 7	03/19/2016
02	ADD WRS	04/01/2016
03	ADV. PROCEEDMENT ADDENDUM 6	04/16/2016
04	100% CONSTRUCTION DOCUMENTS	03/18/2016
05	REVISIONS CONSTRUCTION DOCUMENTS	02/26/2016
06	ADV. PROCEEDMENT ADDENDUM 1	10/09/2014
07	ADVANCED PROCEEDMENT BID SET	06/16/2014

STAMP



DRAWN BY
N11318.00

CHECKED BY
CHIEF

TITLE
FRAMING PLAN, FIXED BUILDING - LEVEL 01

DRAWING NUMBER
S-101.01

B.SCAN NO.
S-101.01


23 of 123

ISSUE	PRINTING	DATE
01	01	08/19/2016
02	02	08/19/2016
03	03	08/19/2016
04	04	08/19/2016
05	05	08/19/2016
06	06	08/19/2016
07	07	08/19/2016
08	08	08/19/2016
09	09	08/19/2016
10	10	08/19/2016
11	11	08/19/2016
12	12	08/19/2016
13	13	08/19/2016
14	14	08/19/2016
15	15	08/19/2016
16	16	08/19/2016
17	17	08/19/2016
18	18	08/19/2016
19	19	08/19/2016
20	20	08/19/2016



DRAWN BY: Author
 CHECKED BY: Checker
 PROJECT NUMBER: #111718-02
 TITLE: FRAMING PLAN, FIXED BUILDING - LEVEL 02

DRAWING NO.: S-102.01
 B.SCAN NO.: S-102.01

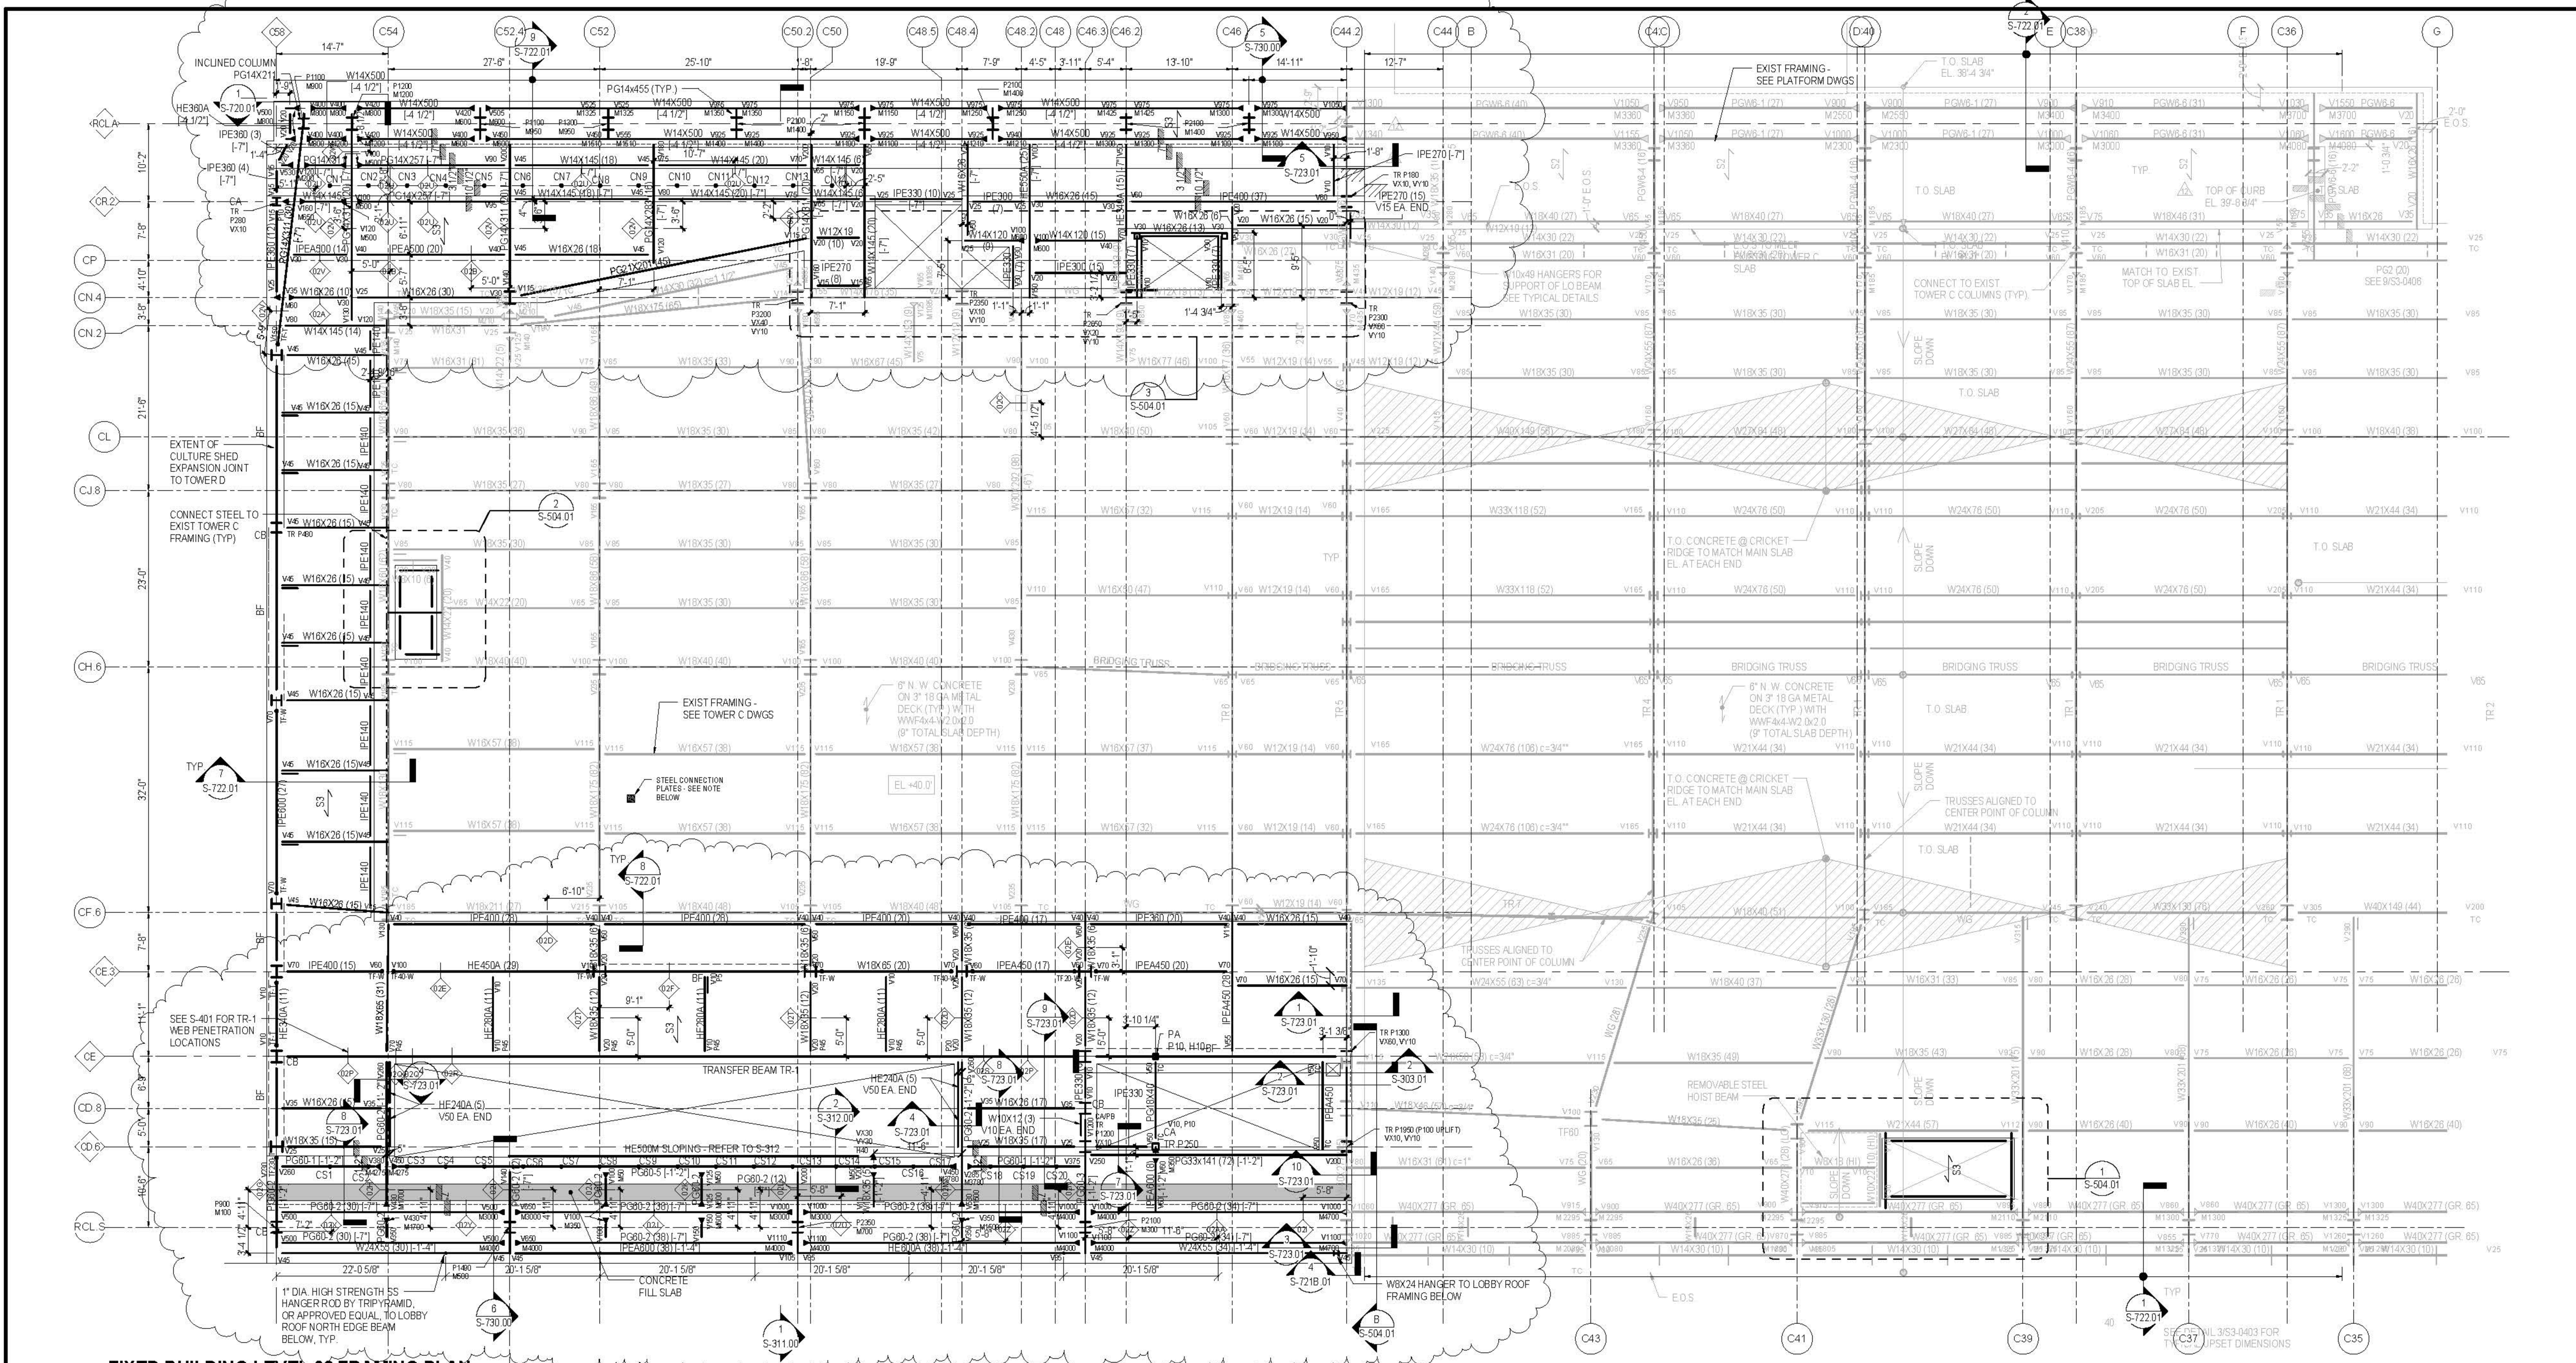

1 FIXED BUILDING LEVEL 02 FRAMING PLAN
 1/8" = 1'-0"

- SHEET NOTES:**
1. T/STRUCTURAL SLAB EL. +40'-0" UON.
 2. T/STEEL EL. +39'-3"
 3. INDICATES DECK SPAN DIRECTION, REFER TO COMPOSITE STEEL DECK SCHEDULE INFORMATION.
 4. FOR ADDITIONAL INFORMATION REFER TO THE FOLLOWING DRAWINGS:
 DRAWING LISTS, GENERAL NOTES, AND S-000 SERIES DRAWINGS
 LATERAL SYSTEM ELEVATIONS, CONNECTION FORCES, AND DETAILS S-300 SERIES DRAWINGS
 STEEL SUPERSTRUCTURE SCHEDULES AND DETAILS S-700 SERIES DRAWINGS
 STEEL COLUMN SCHEDULES AND DETAILS S-800 SERIES DRAWINGS
 5. AT STAIRS, SEE TYPICAL DETAILS FOR TC, TCS, AND KICKER REQUIREMENTS 1, 2 & 3/5-104
 6. REFER TO ARCH DWGS FOR LOCATION AND SIZE OF OPENINGS. SEE ALSO GENERAL NOTE GR-18 AND TYPICAL DETAIL 1/5-713

- 7. SYMBOLS:**
- INDICATES MOMENT CONNECTION
 - INDICATES DEEP BEAM BOTTOM FLANGE BRACING CONNECTION SEE DETAIL 9/5-703
 - INDICATES FULL HEIGHT FITTED STIFFENER CONNECTION SEE DETAIL 4/5-703
 - INDICATES FULL HEIGHT UNFITTED STIFFENER CONNECTION SEE DETAIL 5/5-703
 - INDICATES KICKER AT SPANDREL BEAM CONNECTION SEE DETAIL 9/5-703
 - INDICATES SLOPE IN TOP OF SLAB
- 8. NOTATIONS:**
- BF INDICATES LATERAL BRACED FRAME
 - CANCB SEE BRACED FRAME ELEVATIONS FOR BEAM INFORMATION AND CONNECTION FORCES
 - INDICATES COLUMN ABOVE/BELOW. COMPRESSION AXIAL FORCE IN COLUMN INDICATED WHERE APPLICABLE. SEE DETAIL 1/5-702 & 2/5-702
 - INDICATES CASTELLATED BEAM. SEE SCHEDULE 1/5-402
 - INDICATES HS38x439 ELEVATOR DIVIDER BEAM (NOT FIREPROOFED)
 - INDICATES HANGER ABOVE/BELOW. TENSION AXIAL FORCE IN HANGER BELOW INDICATED WHERE APPLICABLE. SEE DETAIL 3/5-702
 - INDICATES LATERAL MOMENT FRAME
 - SEE MOMENT FRAME ELEVATIONS FOR BEAM INFORMATION AND CONNECTION FORCES
 - INDICATES PLATE GIRDER TYPE. SEE S-703 FOR PLATE GIRDER SCHEDULE.
 - INDICATES TAPERED PLATE GIRDER. SEE DETAIL 3/5-724
 - INDICATES TORSIONAL CONNECTION FOR STAIR. SEE DETAIL 1/5-704
 - INDICATES COLUMN FROM ABOVE TRANSFERS. COMPRESSION AXIAL FORCE IN COLUMN INDICATED WHERE APPLICABLE. SEE DETAIL 1/5-702
- 9. STEEL PLATES FOR TEMPORARY PARTITION SUPPORTS EMBEDDED IN NEW SLAB ON METAL DECK OR ANCHORED THROUGH EXISTING SLAB TO BE PROVIDED AT APPROX. 10 FT X 10 FT SPACINGS THROUGHOUT GALLERIES ON LEVEL 02 AND LEVEL 04. REFER TO ARCH DWGS. FOR LAYOUT AND DETAILS.**


CABLE-TOP ANCHOR FORCES AND DISPLACEMENTS				
SOUTH WALL				
CABLE	MAX. ULT. TENSION [KIPS]	CABLE PRE-STRESS [KIPS]	PRE STRESS Δ [IN.]	CAMBER @ CABLE C.L. [IN.]
C51	120	110		
C52	80	70		
C53	65	55		
C54	65	55		
C55	60	55		
C56	65	55		
C57	65	55		
C58	65	55		
C59	65	55		
C510	65	55		
C511	65	55		
C512	60	50		
C513	55	45		
C514	55	45		
C515	55	45		
C516	55	45		
C517	60	45		
C518	60	45		
C519	60	50		
C520	100	90		

CONTRACTOR TO SUBMIT TO S.E.R. PRE-STRESSING SEQUENCE FOR COMMENT AND APPROVAL. CONNECTING STEEL WORK TO BE VERIFIED FOR CONTRACTOR'S PROPOSED SEQUENCING.

NOTE: DOWNWARD DISPLACEMENT VALUES INDICATED AS NEGATIVE.

NORTH WALL				
CABLE	MAX. ULT. TENSION [KIPS]	CABLE PRE-STRESS [KIPS]	PRE STRESS Δ [IN.]	CAMBER @ CABLE C.L. [IN.]
CN1	95	90		
CN2	60	45		
CN3	45	35		
CN4	40	25		
CN5	35	25		
CN6	40	25		
CN7	40	25		
CN8	40	25		
CN9	40	25		
CN10	40	25		
CN11	40	25		
CN12	45	35		
CN13	60	45		
CN14	100	90		


STEEL BEAM LEGEND

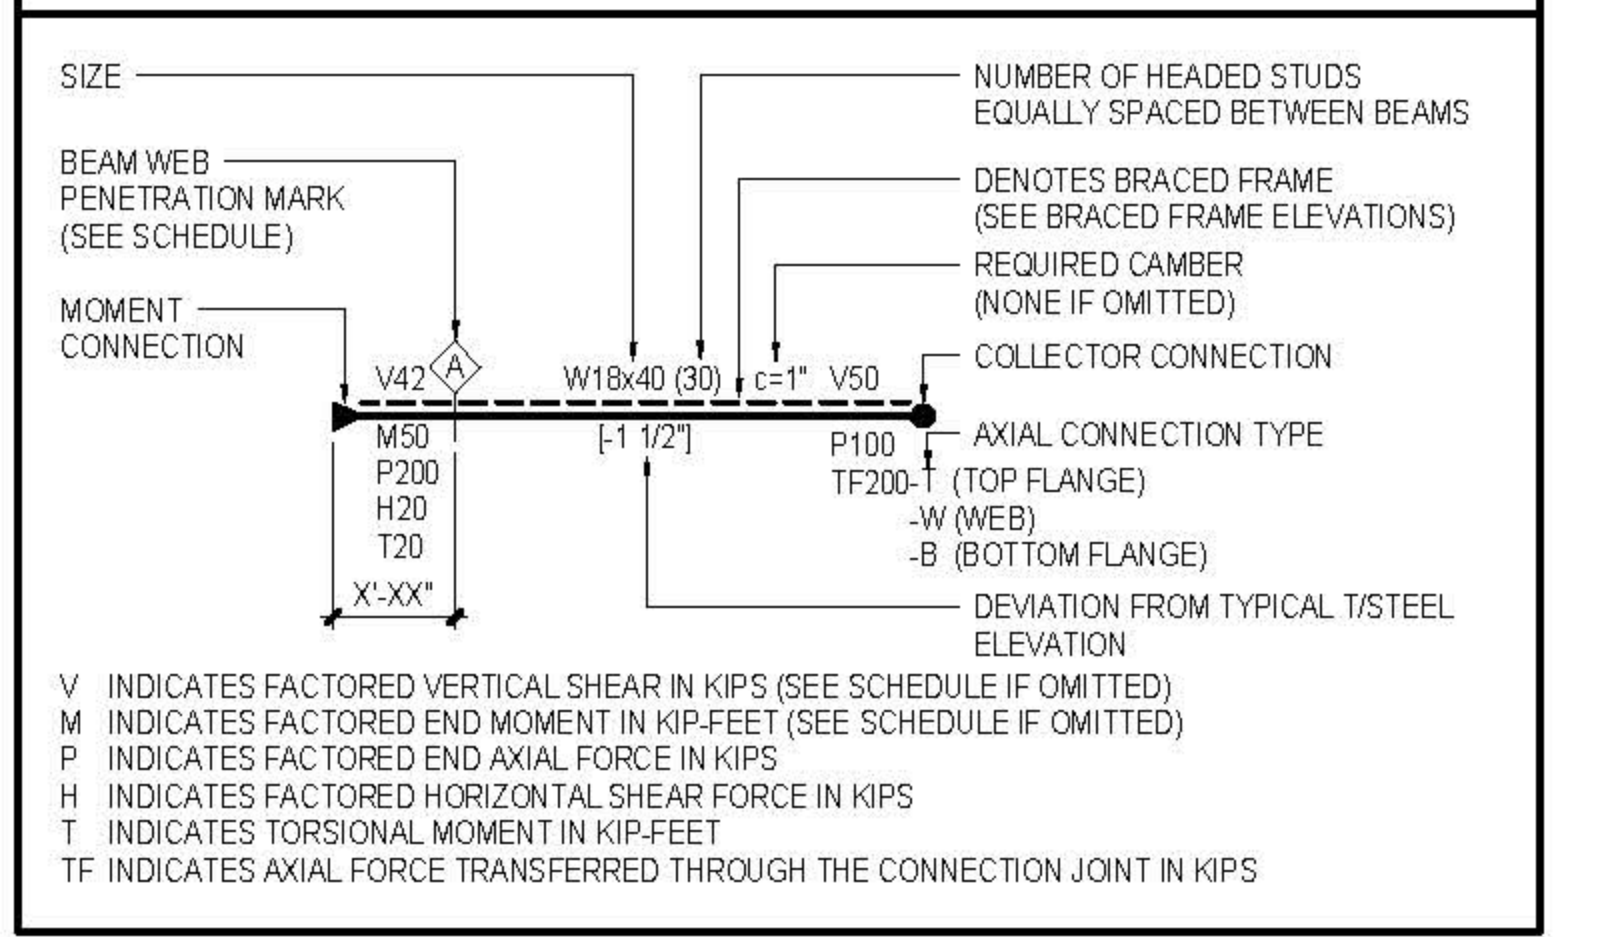

COMPOSITE STEEL DECK SCHEDULE

SLAB MARK	TOTAL SLAB THICKNESS AND CONCRETE TYPE	STEEL DECK (MIN)	CONCRETE TOPPING SLAB	SLAB REINFORCEMENT	NOTES
S1	5 1/2" NWC	3'-18 GA		8 x 8 - W4.0 x W4.0 WWR	
S2	7 1/2" NWC	3'-18 GA		4 x 4 - W4.0 x W4.0 WWR	
S3	9" NWC	3'-18 GA		#4 @ 18" O.C. EACH WAY	
S4	4" NWC	1 1/2" 18 GA		8 x 8 - W2.9 x W2.9 WWR	
SS	8 1/2" NWC	3'-18 GA		#4 @ 12" O.C. N-S #4 @ 18" O.C. E-W	N-S BARS COORDINATED TO MECHANICAL COUPLERS IN EXISTING SLAB

2 PART PLAN AT T/STEEL EL. 53'-9" / 12
 1/8" = 1'-0"

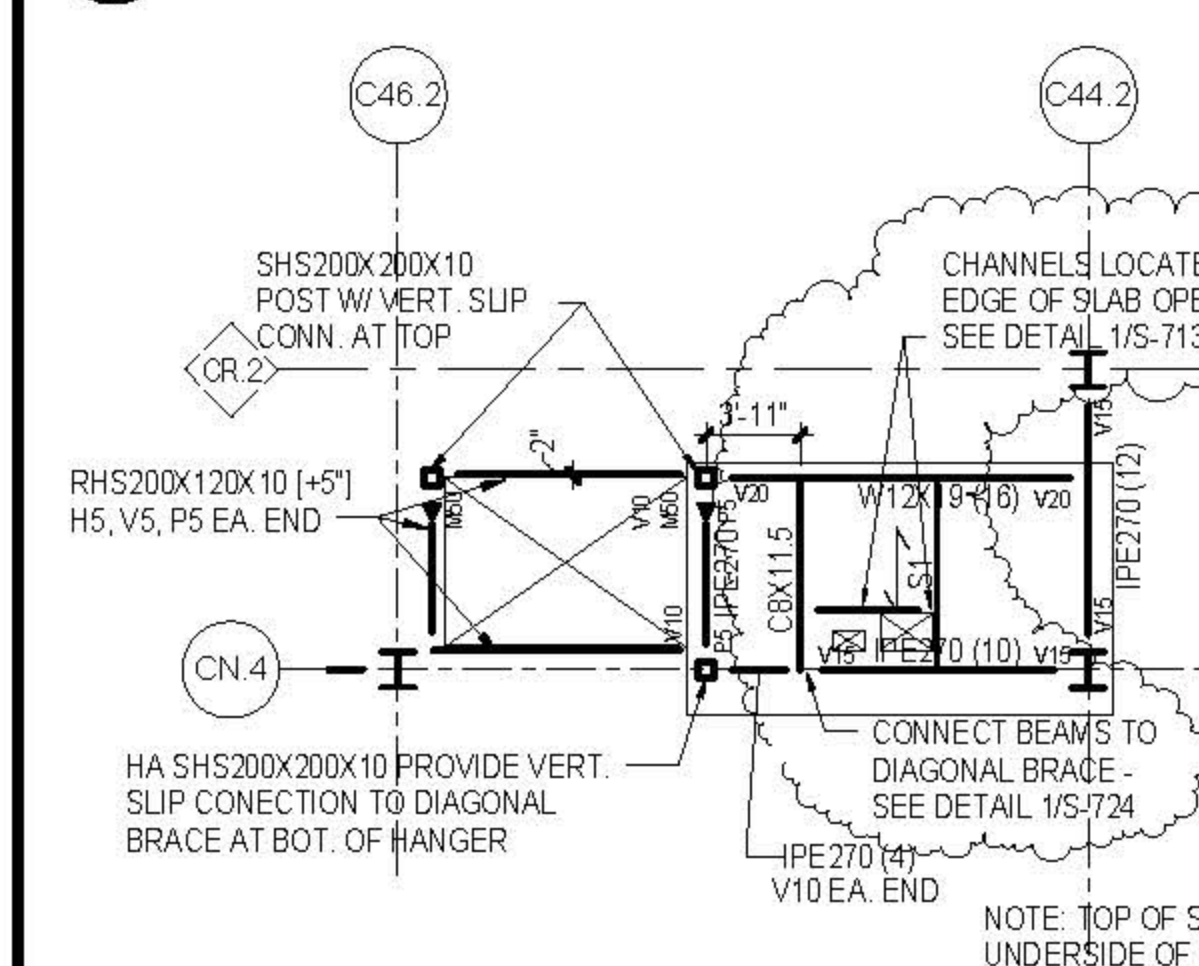

3 PART PLAN MEZZANINE 02 T/SLAB EL. 53'-10"
 1/8" = 1'-0"



CULTURE SHED

540 West 30th Street
New York, New York 10001

OWNER
CULTURE SHED INC.

ARCHITECTS
Oller Scaffida + Renfro Architects, DPC
601 West 30th Street #815
New York, New York 10001
T: 212.463.0334
F: 212.463.0335

STRUCTURAL ENGINEER
Thornton Tomasetti
51 Madison Avenue
New York, New York 10010
T: 917.861.7800
F: 917.861.7801

MEP ENGINEER
Jana Baum & Bolles
60 Pine Street
New York, New York 10005
T: 212.530.9300
F: 212.266.6944

FAÇADE CONSULTANT
Thornton Tomasetti
51 Madison Avenue
New York, New York 10010
T: 917.861.7800
F: 917.861.7801

KINETICS ENGINEER
Hardisty & Hanover
1501 Broadway
New York, New York 10036
T: 212.944.1150
F: 212.391.0239

LIGHTING DESIGNER
Tilston Design Associates
40 North Street #1650
New York, New York 10013
T: 212.675.7760

THEATRE PLANNING & DESIGN
Fisher Dodge Associates
22 West 15th Street
New York, New York 10001
T: 212.691.3000

LIFE SAFETY
Code Consultants, Inc.
215 West 40th St, 15th Flr
New York, New York 10018
T: 212.216.9596

ENERGY MODEL/LEED
Vindian
60 Washington Street
Norwalk, CT 06854
T: 203.298.1411

ACOUSTIC/AUDIO-VISUAL
Akustik
93 North Main Street
South Norwalk, CT 06854
T: 347.210.5540

VERTICAL TRANSPORTATION
Van Duinen & Associates
5 Regent Street, Suite 224
Larchmont, NJ 07038
T: 973.994.9200



SPECIFICATIONS
Construction Specifications Inc.
PO Box 489
22 Tenth Road
Morganville, NJ 07751
T: 732.970.0700
F: 732.970.0700

SECURITY
Duchella Venter & Santoro
1020 Sherman Avenue
Hartford, CT 06114
T: 203.286.6490


WATERPROOFING
James R. Galford AIA Consulting Architects PC
104 West 27th Street
New York, NY 10001
T: 212.736.3344

FAÇADE MAINTENANCE
Erick Engineering PLLC
162 Area Street
New York, NY 10005
T: 212.698.3000


BRANDING GRAPHICS
2nd Global Design Consultancy
180 Varck Street 15th Floor
New York, NY 10014
T: 212.647.1170

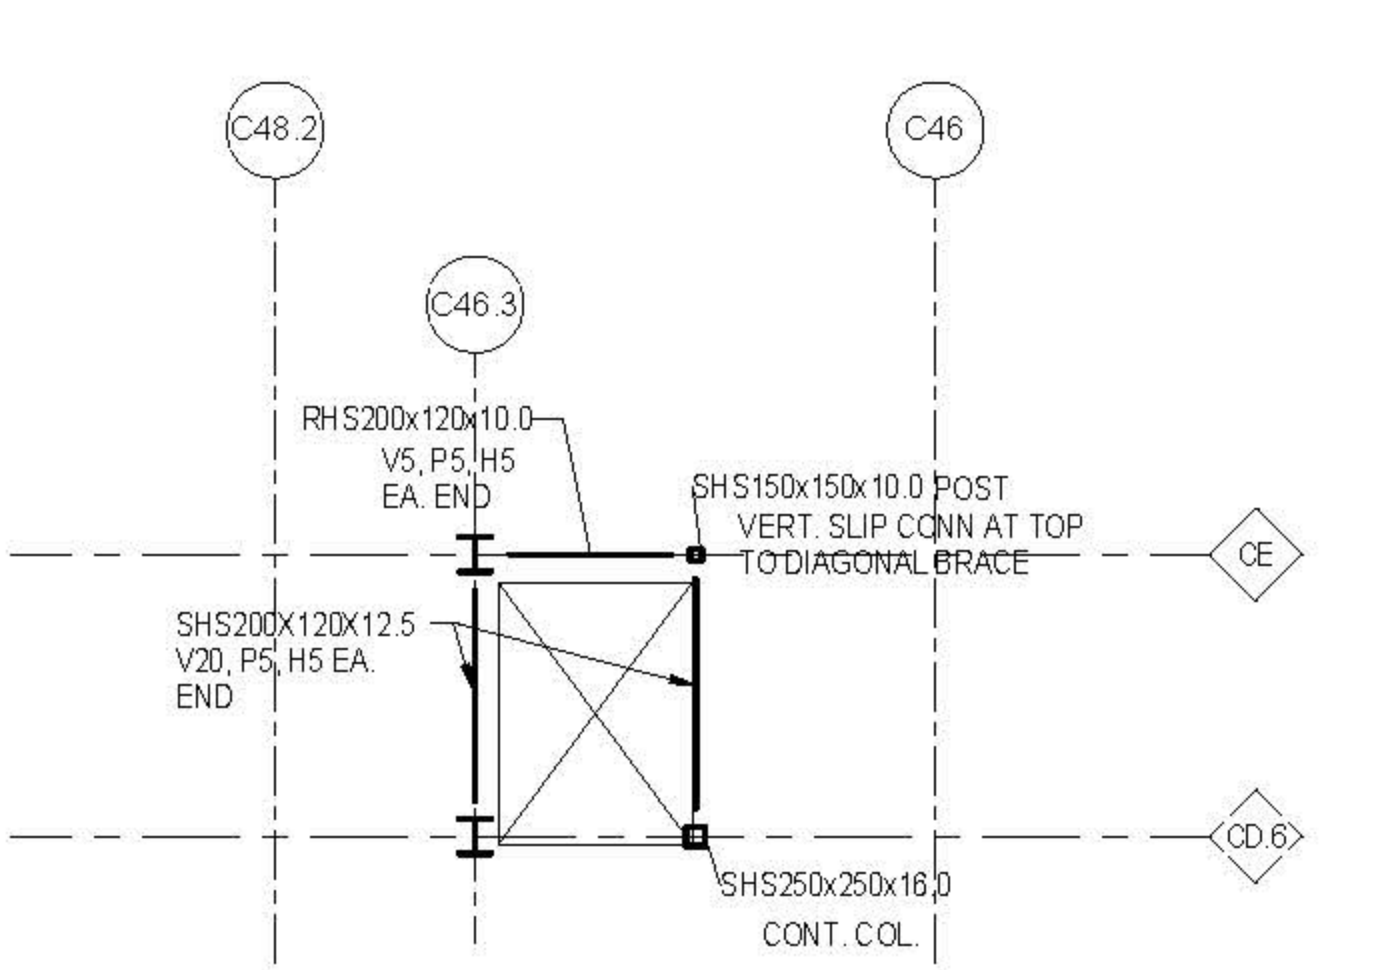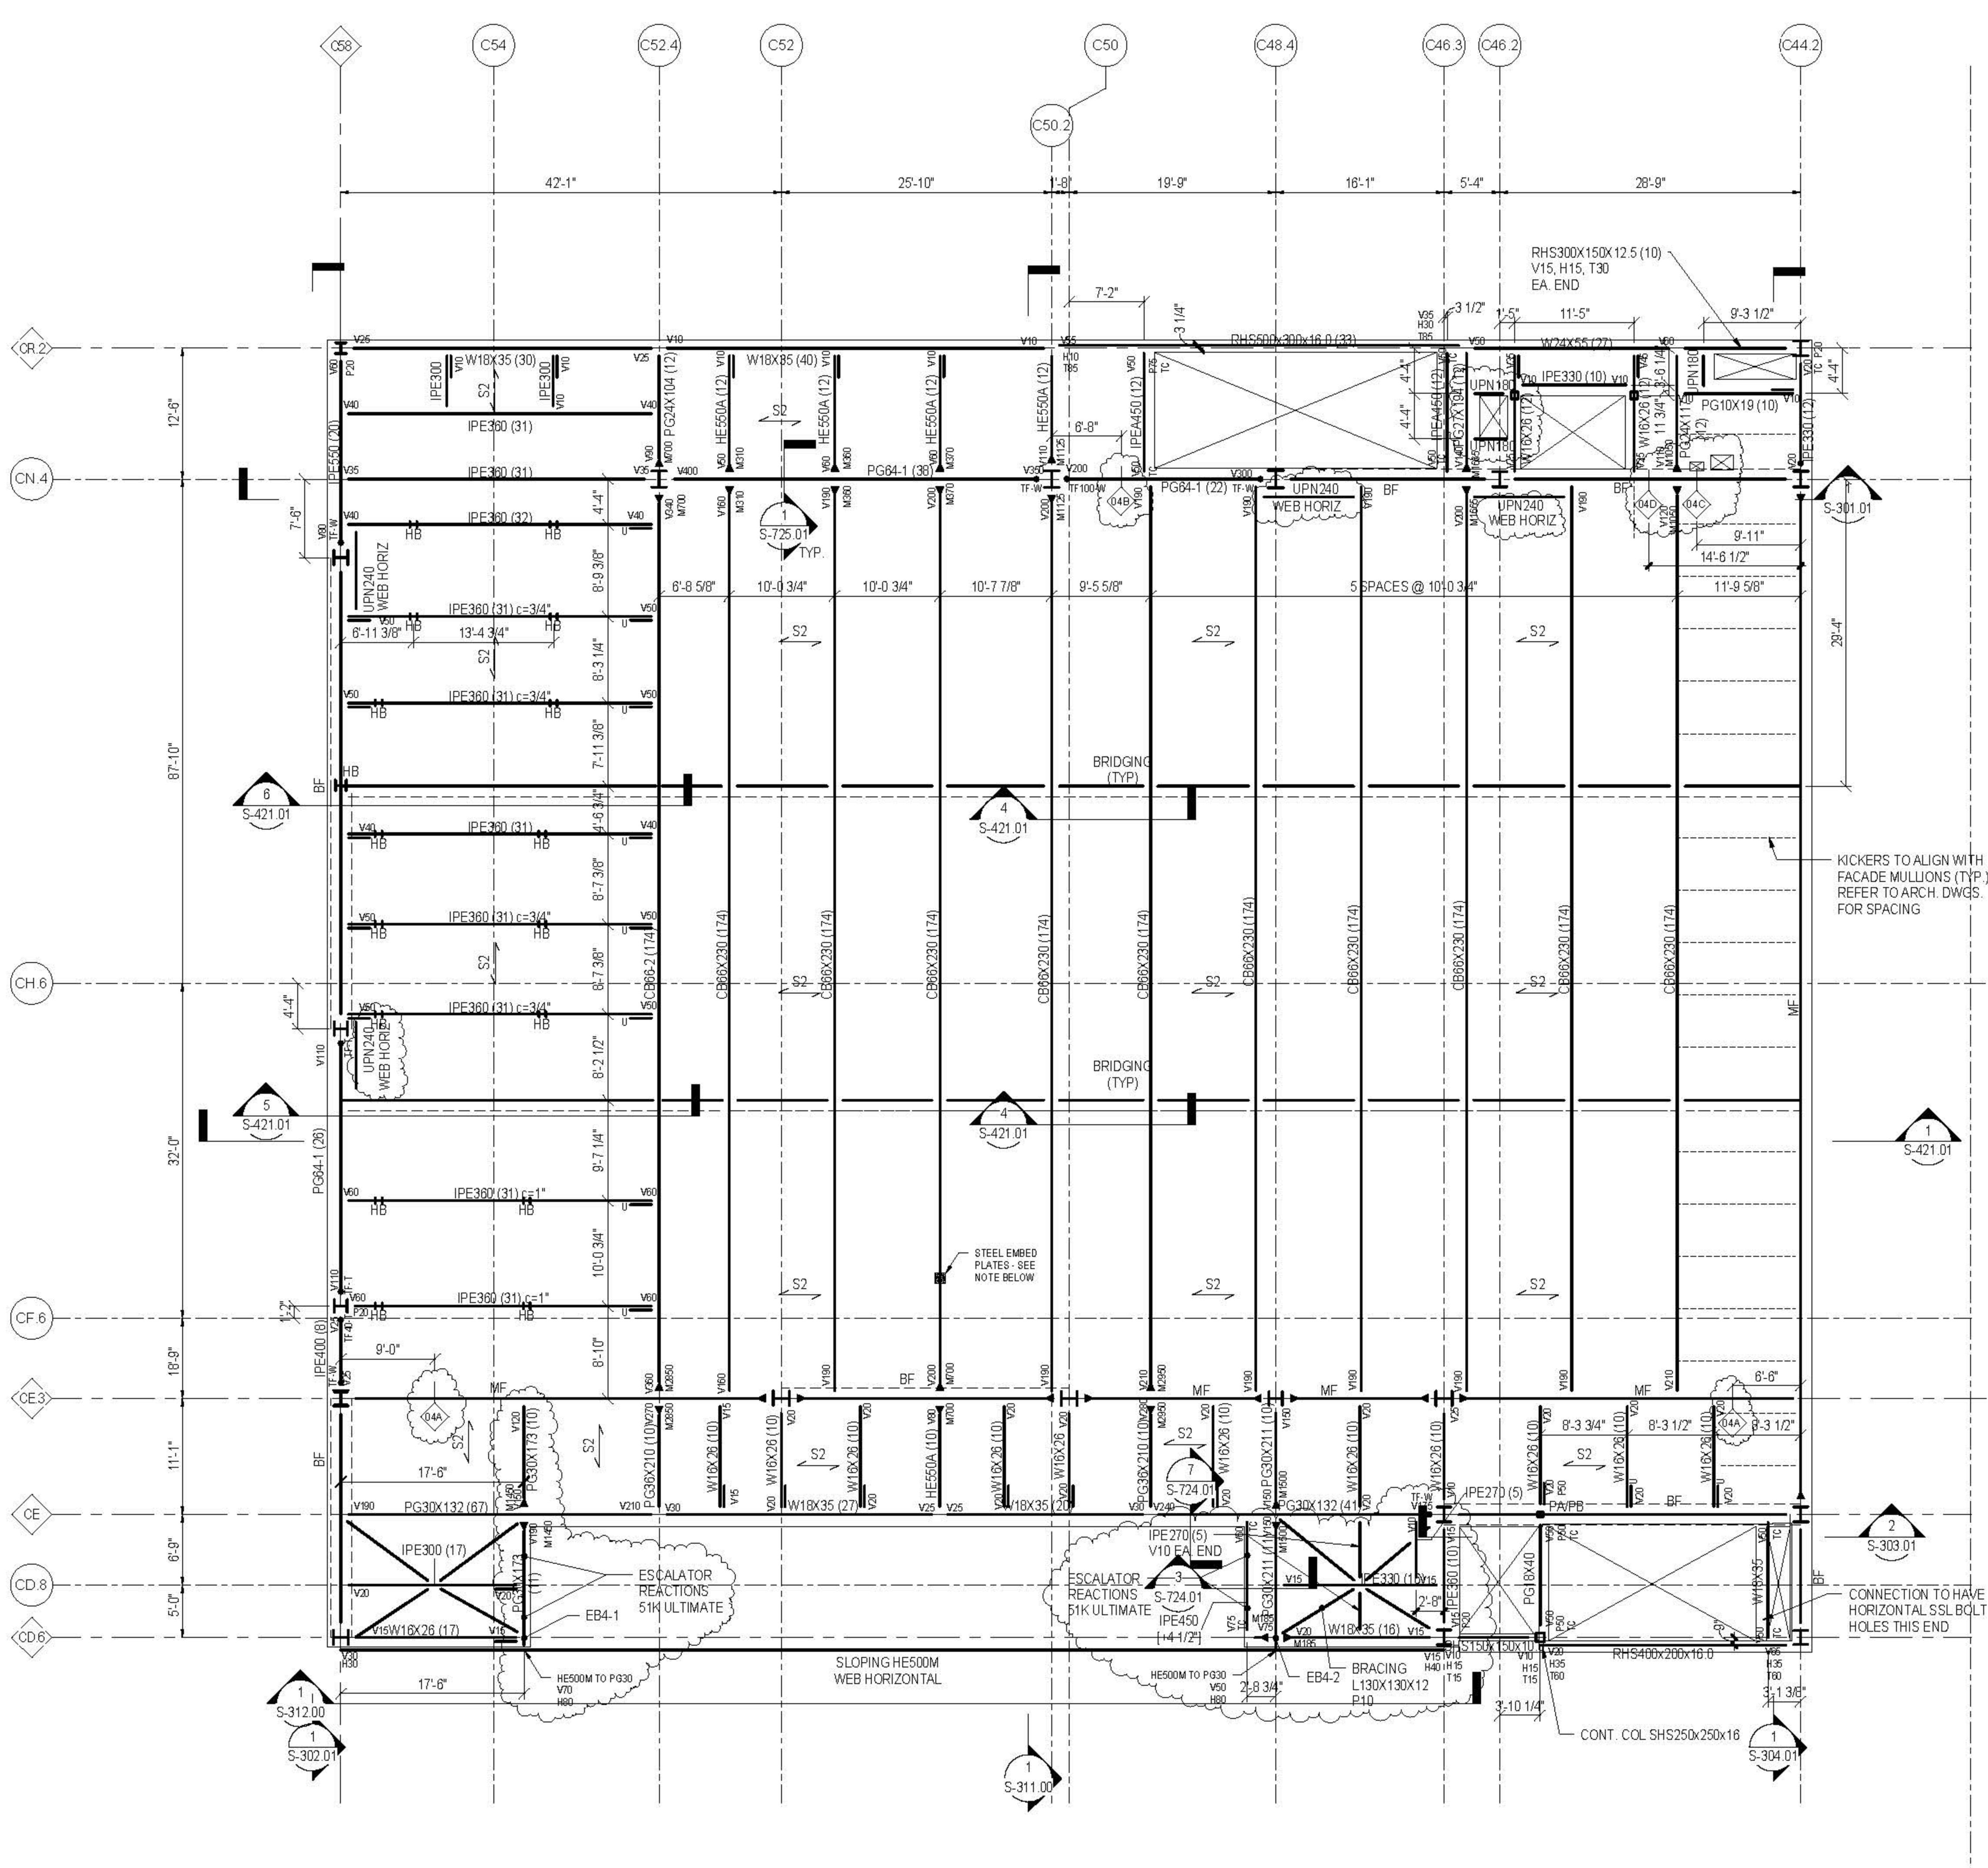

2 PART PLAN AT T/STEEL EL. 80'-5 1/2"
1/8" = 1'-0"

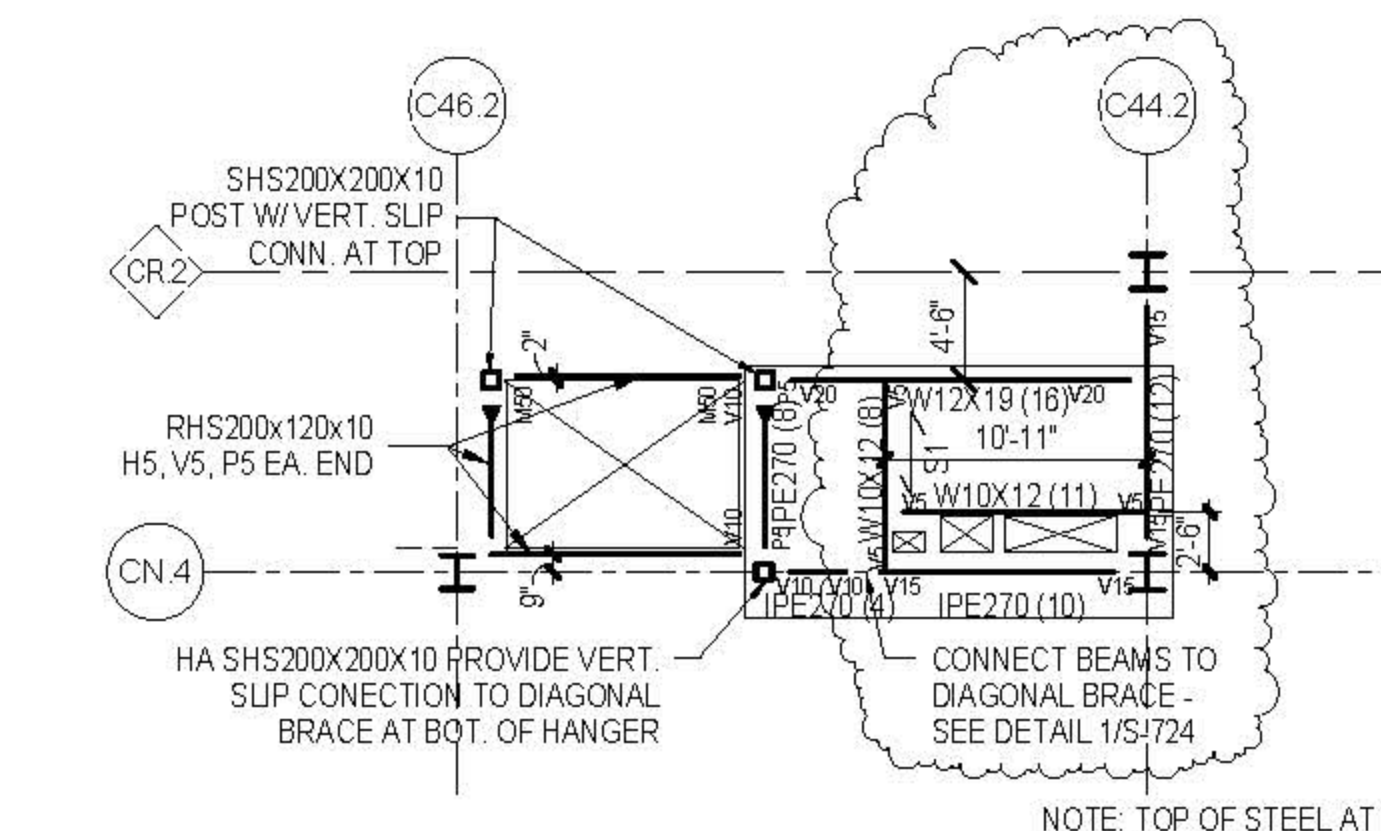

3 PART PLAN MEZZANINE 04 T/SLAB EL. 80'-8 1/2"
1/8" = 1'-0"

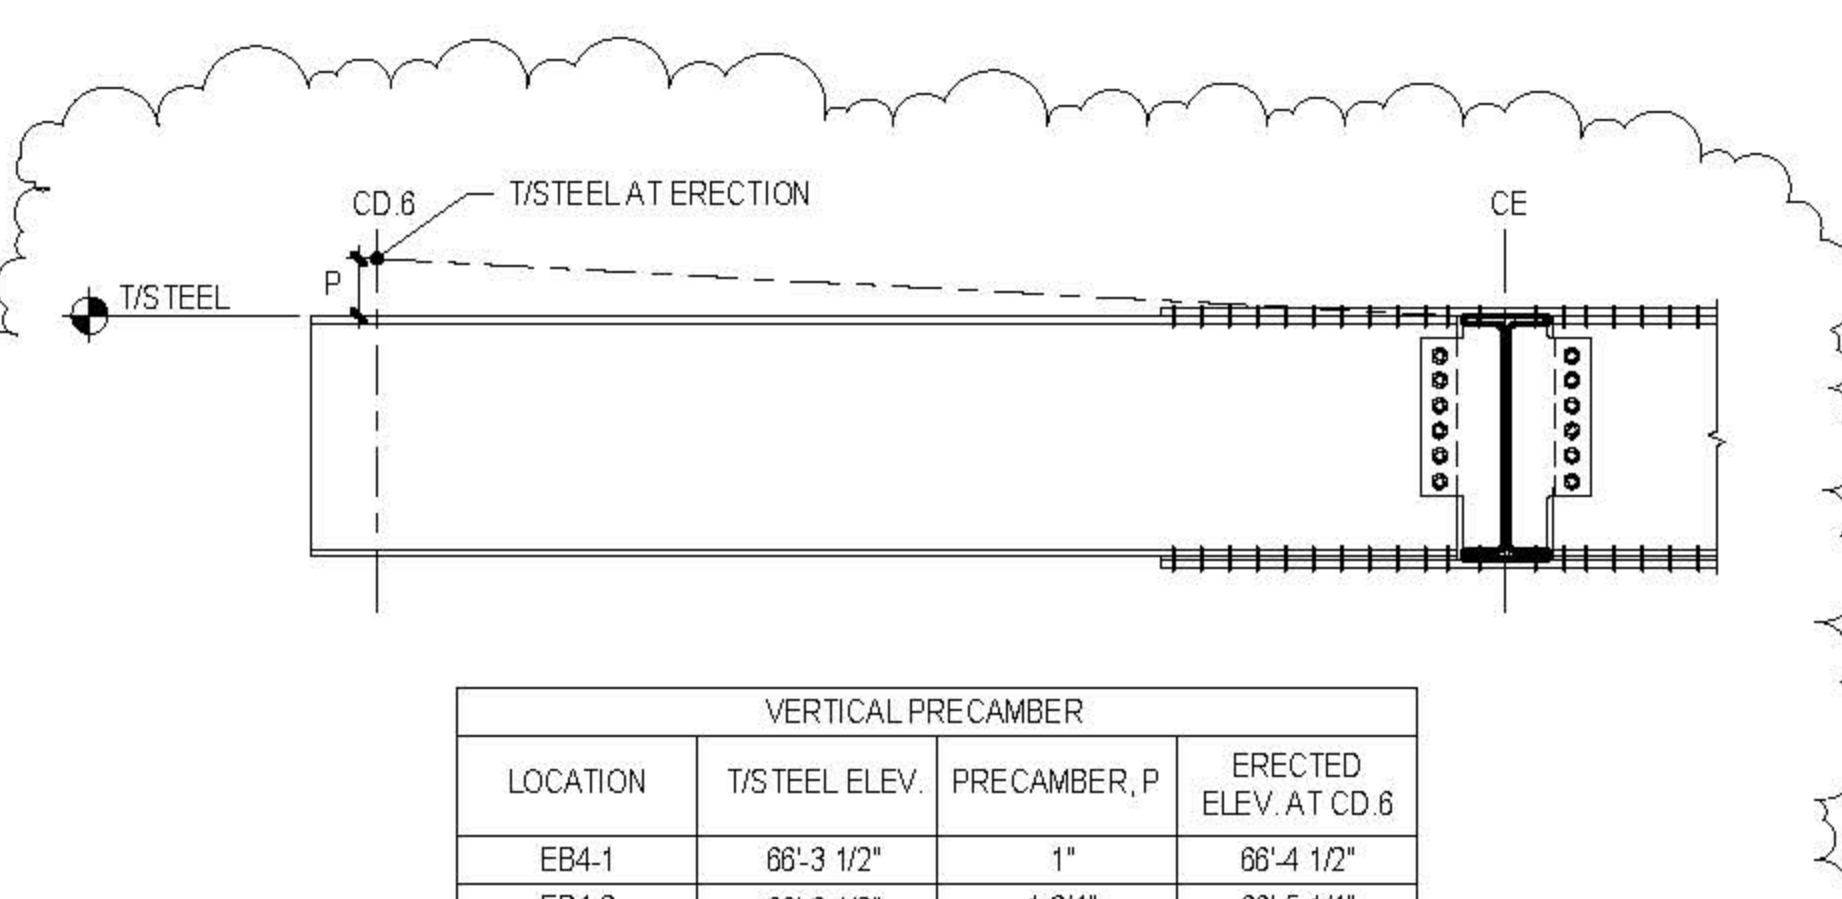

4 ESCALATOR SUPPORT CANTILEVER CAMBER LEVEL 04
1/2" = 1'-0"


VERTICAL PRECAMBER			
LOCATION	T/STEEL ELEV.	PRECAMBER, P	ERECTED ELEV. AT CD.6
EB4-1	86'-3 1/2"	1"	86'-4 1/2"
EB4-2	86'-3 1/2"	1 3/4"	86'-5 1/4"

1 FIXED BUILDING LEVEL 04 FRAMING PLAN
1/8" = 1'-0"

- SHEET NOTES:**
- T/STRUCTURAL SLAB EL. +86'-11" UON.
 - T/STEEL EL. +86'-3 1/2"
 - INDICATES DECK SPAN DIRECTION, REFER TO COMPOSITE STEEL DECK SCHEDULE INFORMATION.
 - FOR ADDITIONAL INFORMATION REFER TO THE FOLLOWING DRAWINGS:
DRAWING LISTS, GENERAL NOTES, AND LOADING DIAGRAMS S-000 SERIES DRAWINGS
LATERAL SYSTEM ELEVATIONS, CONNECTION FORCES, AND DETAILS S-300 SERIES DRAWINGS
STEEL SUPERSTRUCTURE SCHEDULES AND DETAILS S-700 SERIES DRAWINGS
STEEL COLUMN SCHEDULES AND DETAILS S-900 SERIES DRAWINGS
 - AT STAIRS, SEE TYPICAL DETAILS FOR TC, TCS, AND KICKER REQUIREMENTS 1, 2, 8, 9S-704
 - REFER TO ARCH DWGS FOR LOCATION AND SIZE OF OPENINGS. SEE ALSO GENERAL NOTE GR-18 AND TYPICAL DETAIL 1/S-713

- 7. SYMBOLS:**
- INDICATES MOMENT CONNECTION
 - INDICATES DEEP BEAM BOTTOM FLANGE BRACING CONNECTION SEE DETAIL 6/S-703
 - INDICATES FULL HEIGHT FITTED STIFFENER CONNECTION SEE DETAIL 4/S-703
 - INDICATES FULL HEIGHT UNFITTED STIFFENER CONNECTION SEE DETAIL 5/S-703
 - INDICATES KICKER AT SPANDREL BEAM CONNECTION SEE DETAIL 3/S-703
 - INDICATES SLOPE IN TOP OF SLAB
- 8. NOTATIONS:**
- BF INDICATES LATERAL BRACED FRAME
 - CA/CB INDICATES COLUMN ABOVE/BELOW. COMPRESSION AXIAL FORCE IN COLUMN INDICATED WHERE APPLICABLE. SEE DETAIL 1/S-702 & 2/S-702
 - CBXX INDICATES CASTELLATED BEAM. SEE SCHEDULE 16S-402
 - DB INDICATES HSS/SHK/316 ELEVATOR DIVIDER BEAM (NOT FIREPROOFED)
 - HA/HB INDICATES HANGER ABOVE/BELOW. TENSION AXIAL FORCE IN HANGER BELOW INDICATED WHERE APPLICABLE. SEE DETAIL 3/S-702
 - MF INDICATES LATERAL MOMENT FRAME
 - PGXX INDICATES PLATE GIRDER TYPE. SEE S-703 FOR PLATE GIRDER SCHEDULE.
 - TCXX INDICATES TAPERED PLATE GIRDER. SEE DETAIL 3/S-704
 - T INDICATES TORSIONAL CONNECTION FOR STAIRS. SEE DETAIL 1/S-704
 - TR INDICATES COLUMN FROM ABOVE TRANSFERS. COMPRESSION AXIAL FORCE IN COLUMN INDICATED WHERE APPLICABLE. SEE DETAIL 1/S-702

- 9.** STEEL PLATES FOR TEMPORARY PARTITION SUPPORTS EMBEDDED IN NEW SLAB ON METAL DECK OR ANCHORED THROUGH EXISTING SLAB TO BE PROVIDED AT APPROX. 10 FT X 10 FT SPACING THROUGHOUT GALLERIES ON LEVEL 02 AND LEVEL 04. REFER TO ARCH. DWGS. FOR LAYOUT AND DETAILS.

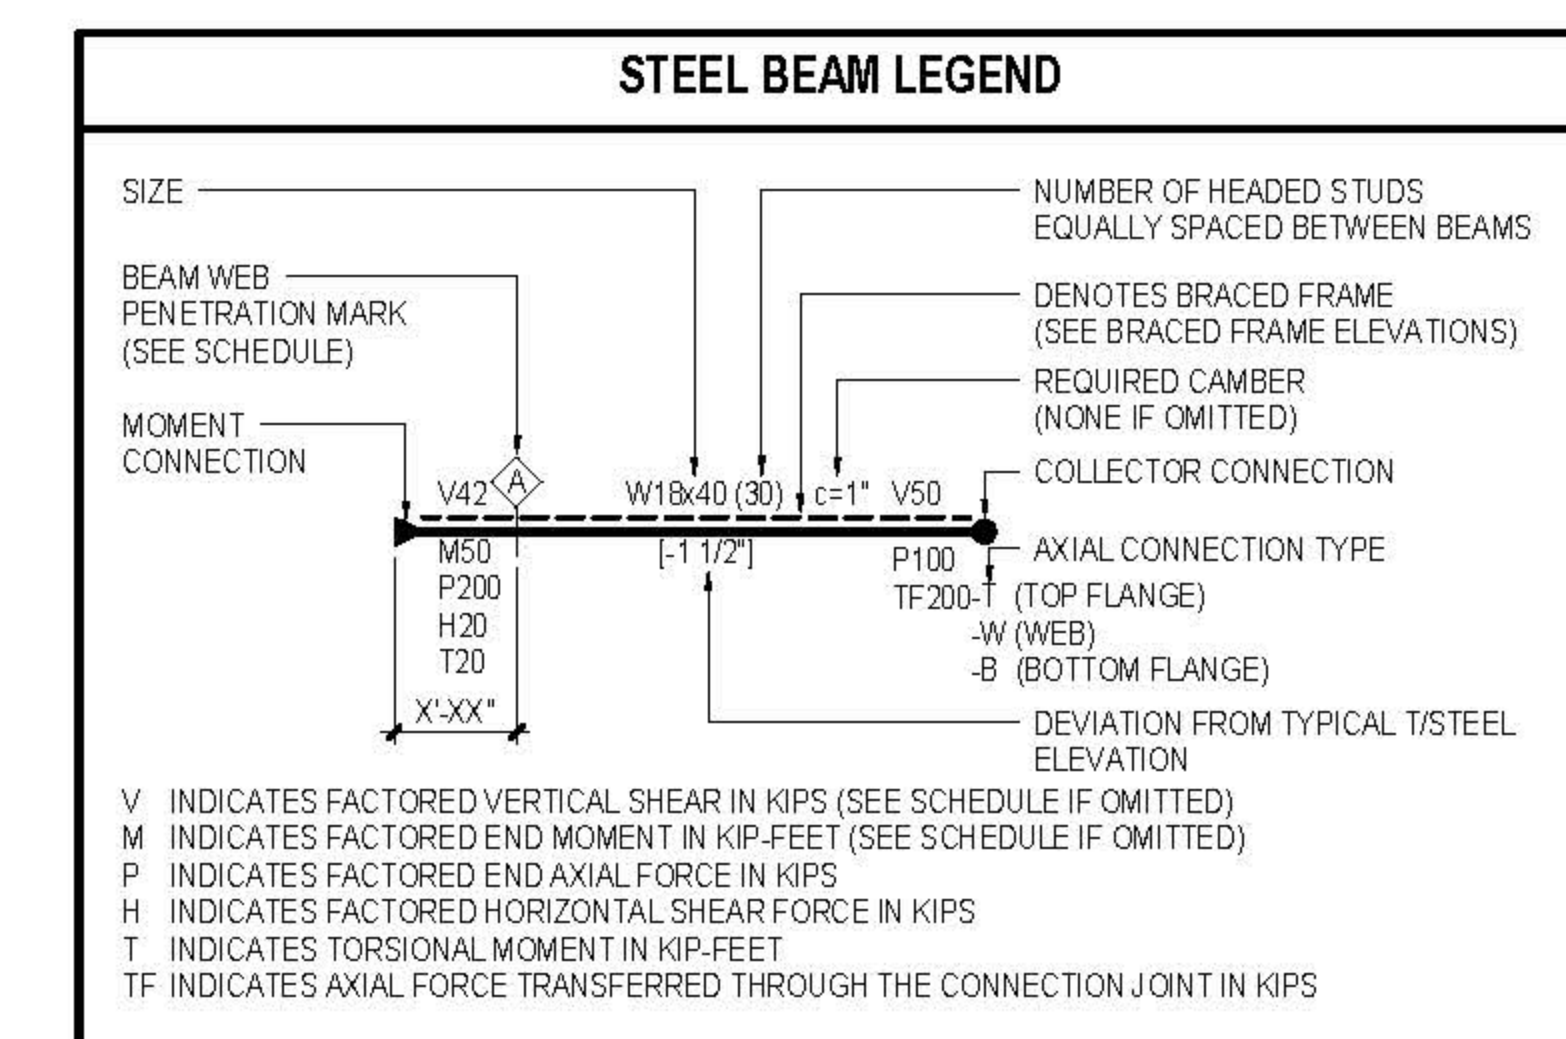

COMPOSITE STEEL DECK SCHEDULE					
SLAB MARK	TOTAL SLAB THICKNESS AND CONCRETE TYPE	STEEL DECK (MIN)	CONCRETE TOPPING SLAB	SLAB REINFORCEMENT	NOTES
S1	5 1/2" NWC	3'-8 GA		6 x 6 - W4 0 x W4 0 WWR	
S2	7 1/2" NWC	3'-8 GA		4 x 4 - W4 0 x W4 0 WWR	
S3	8" NWC	3'-8 GA		1" O.C. EACH WAY	
S4	4" NWC	1 1/2" @ 18 GA		4 x 4 - W2 9 x W2 9 WWR	
S5	8 1/2" NWC	3'-8 GA		#4 @ 12" O.C. N-S #4 @ 18" O.C. E-W	N-S BARS COORDINATED TO MECHANICAL COUPLERS IN EXISTING SLAB

ISSUE PRINTING DATE

NO.	DESCRIPTION	DATE
01	010 AMENDMENT 7	03/20/2016
11	6 ADV. PROCUREMENT ADDENDUM 6	04/10/2016
10	4 100% CONSTRUCTION DOCUMENTS	03/18/2016
9	PRELIMINARY DESIGN SUBMISSION	12/30/2014
3	1 ADV. PROCUREMENT ADDENDUM 1	10/03/2014
1	ADVANCED PROCUREMENT BID SET	06/16/2014

STAMP
NEW YORK STATE ENGINEER
THORNTON TOMASETTI

DRAWN BY
Autumn

CHECKED BY
Chris

PROJECT NUMBER
N11318.00

TITLE
FRAMING PLAN, FIXED BUILDING - LEVEL 04

DRAWING NO.
S-104.01

8-SCAN NO.
S-104.01

CULTURE SHED

545 West 30th Street
New York, New York 10001

OWNER
CULTURE SHED INC.

ARCHITECTS
Oller Scaffolds + Renfro Architects, DPC
601 West 25th Street #815
New York, New York 10001
T: 212.463.0334
F: 212.463.0335

rackwellgroup
5 Union St. West, 6th Fl.
New York, New York 10003
T: 212.463.0334
F: 212.463.0335

STRUCTURAL ENGINEER
Thornton Tomasetti
51 Madison Avenue
New York, New York 10010
T: 917.861.7800
F: 917.861.7801

MEP ENGINEER
Jana Baum & Bolles
63 Park Street
New York, New York 10005
T: 212.530.9300
F: 212.236.6944

FAÇADE CONSULTANT
Thornton Tomasetti
51 Madison Avenue
New York, New York 10010
T: 917.861.7800
F: 917.861.7801

KINETICS ENGINEER
Hardisty & Hanover
1501 Broadway
New York, New York 10036
T: 212.944.1150
F: 212.391.0297

LIGHTING DESIGNER
Tilston Design Associates
40 North Street #1650
New York, New York 10013
T: 212.675.7760

THEATRE PLANNING & DESIGN
Flüchter Dachs Associates
22 West 15th Street
New York, New York 10011
T: 212.691.3000

LIFE SAFETY
Code Consultants, Inc.
215 West 43rd St., 15th Fl.
New York, New York 10018
T: 212.216.9596

ENERGY MODEL AEEED
Vindian
63 Washington Street
Norwalk, CT 06854
T: 203.298.1411

ACOUSTIC/AUDIO-VISUAL
Avalonville
53 North Main Street
South Norwalk, CT 06854
T: 347.210.5540

VERTICAL TRANSPORTATION
Van Duusen & Associates
5 Regent Street, Suite 524
Lanington, NJ 07038
T: 973.994.9220

SPECIFICATIONS
Construction Specifications Inc.
PO Box 489
227 Fenwick Road
Morganville, NJ 07751
T: 732.970.0700
F: 732.970.0750


SECURITY
Duchella Venter & Santoro
1020 Sherman Avenue
Hartford, CT 06114
T: 203.288.6490

WATERPROOFING
James R. Galford AIA Consulting Architects PC
104 West 27th Street
New York, NY 10001
T: 212.736.3344

FAÇADE MAINTENANCE
Eink Engineering PLLC
362 Avenue Street
New York, NY 10005
T: 212.698.3000

BRANDING GRAPHICS
24 Global Design Consultancy
180 York Street 15th Floor
New York, NY 10014
T: 212.647.1170

KEY PLAN

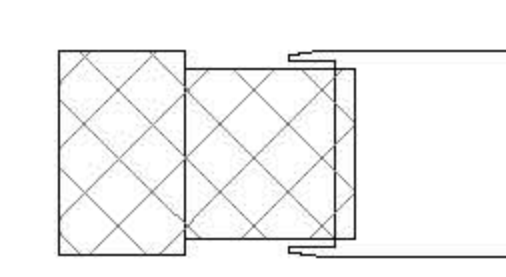

ISSUE PRINTING DATE

ISSUE	PRINTING	DATE
01	01	03/20/2016
02	21	04/01/2016
03	25	04/01/2016
04	25	04/01/2016
STAMP



DRAWN BY: N11318.00
CHECKED BY: N11318.00

PROJECT NUMBER: N11318.00


TITLE: FRAMING PLAN, FIXED BUILDING - LEVEL 06

DATE: 03/20/2016

DRAWING NO.: S-106.01

B.SCAN NO.: S-106.01

26 of 123

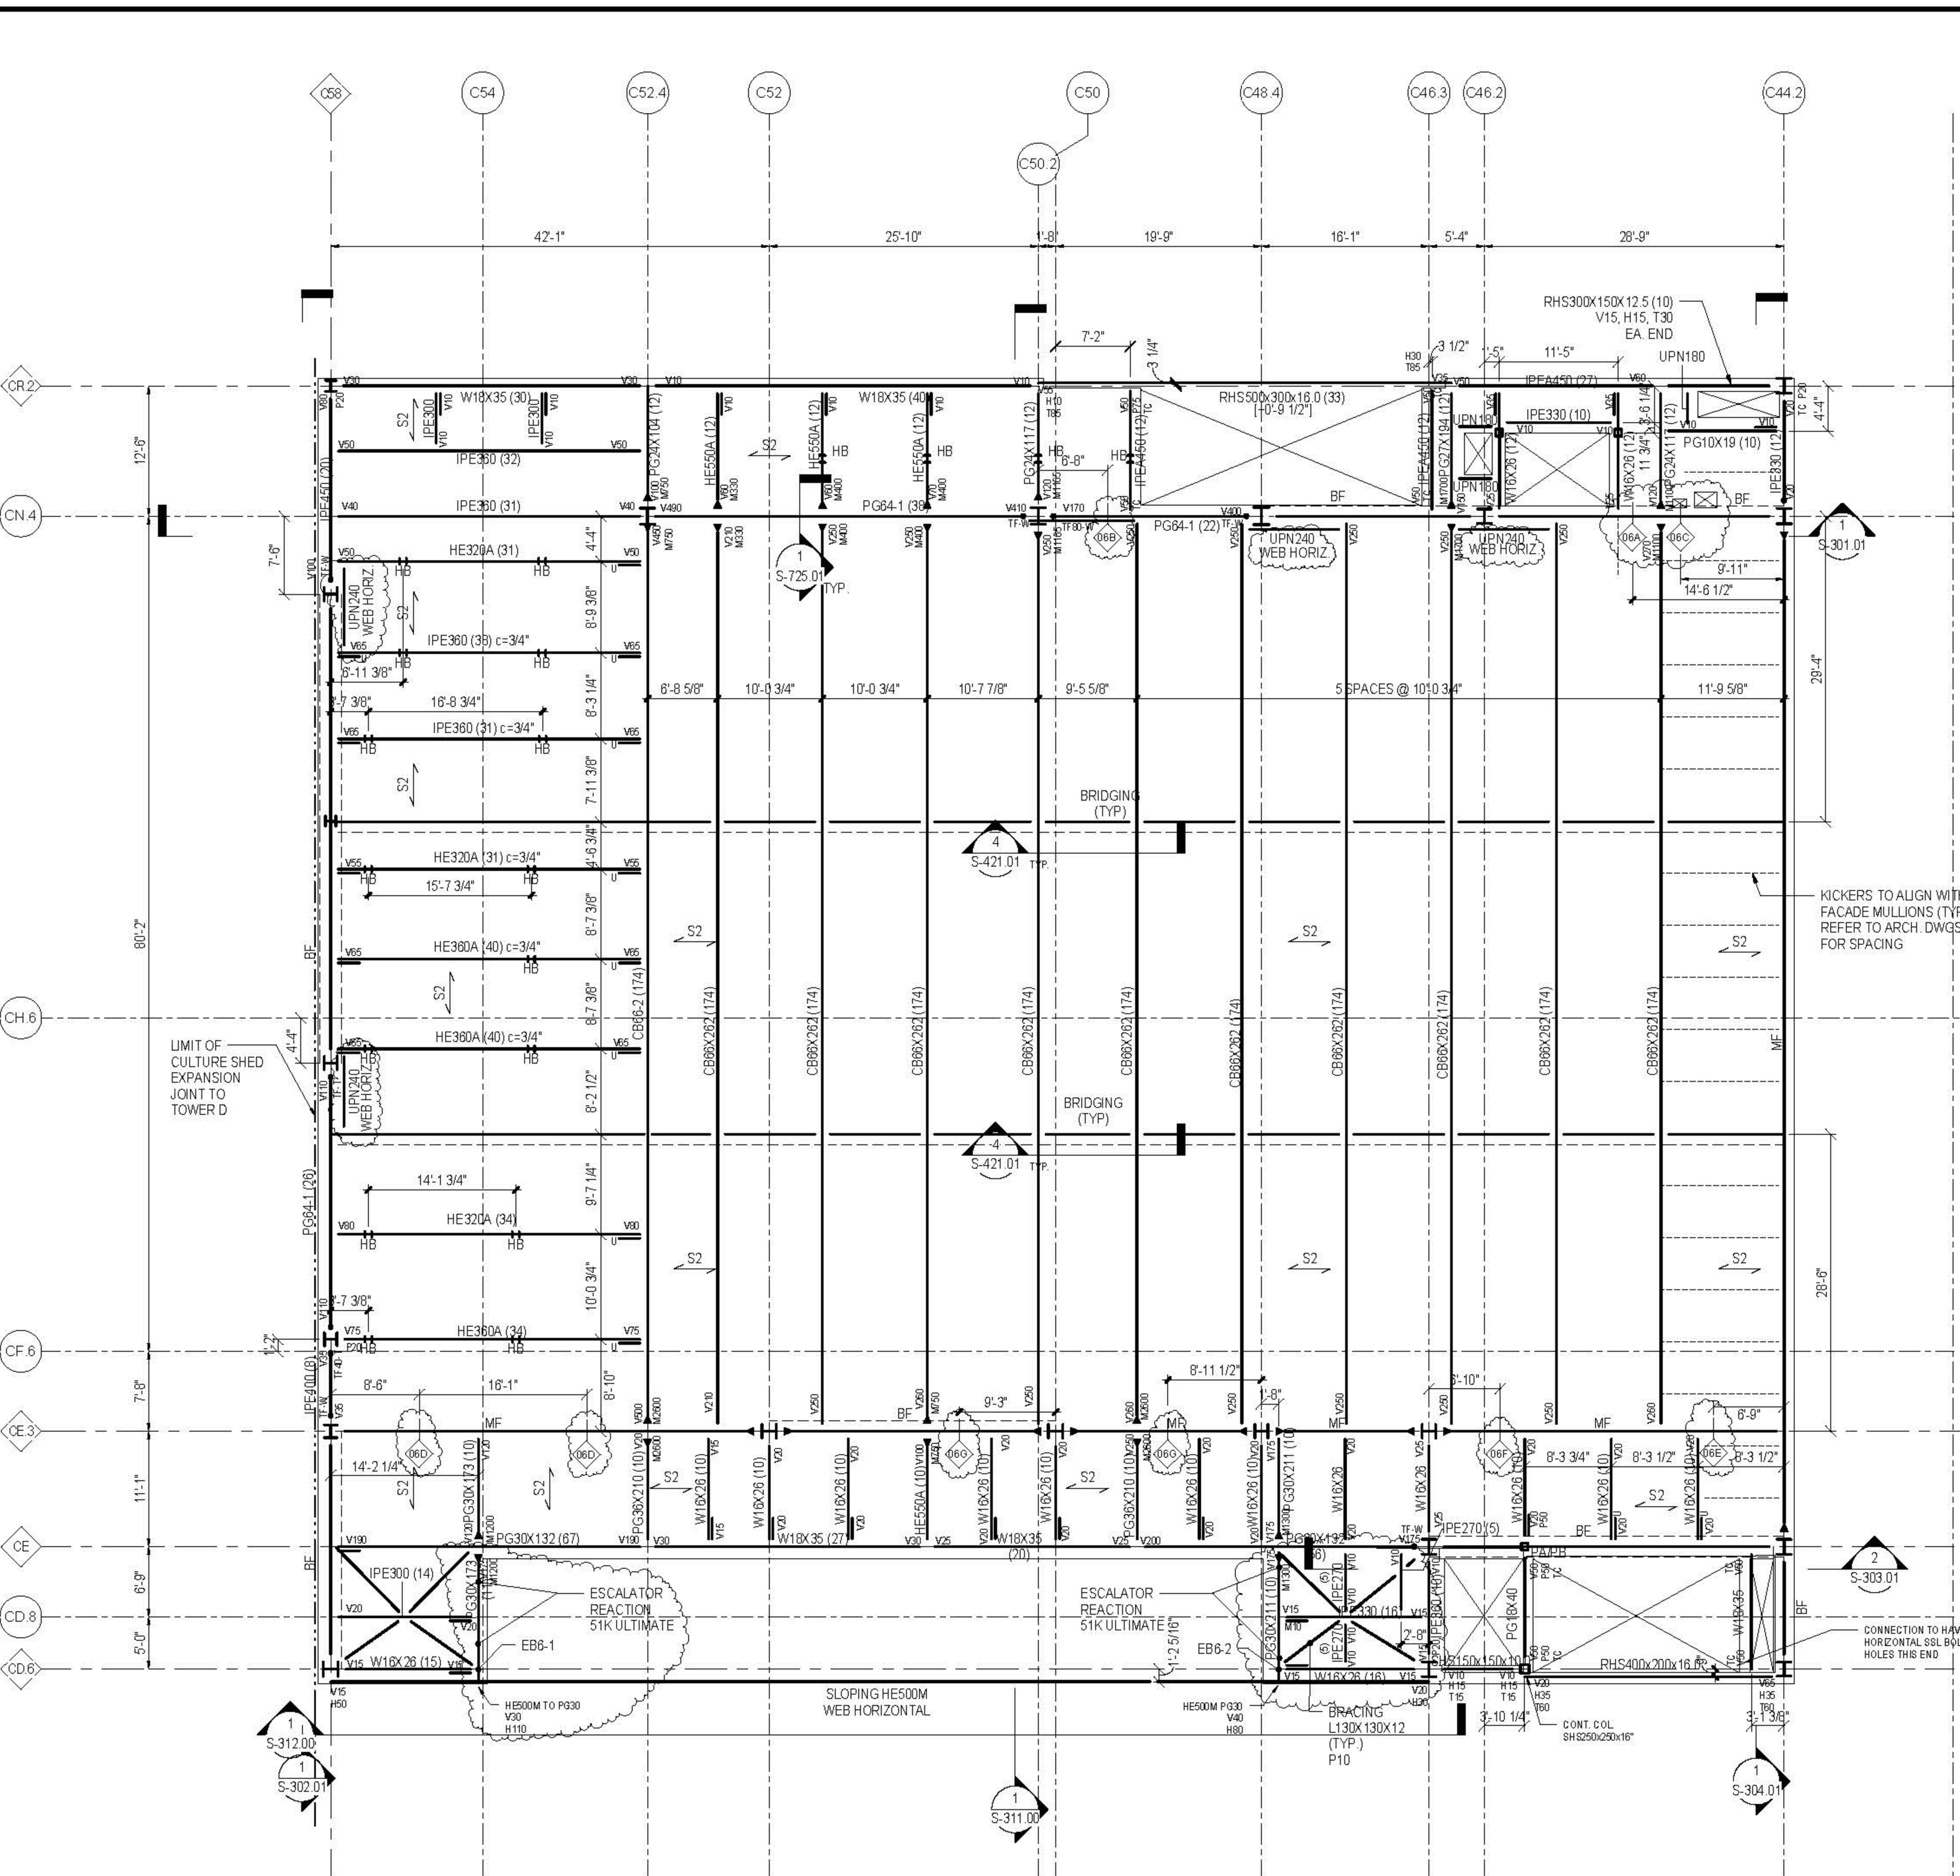

1 FIXED BUILDING LEVEL 06 FRAMING PLAN
1/8" = 1'-0"

SHEET NOTES

- T/STRUCTURAL SLAB EL. +93'-1" UON.
- T/STEEL EL. +92'-5 1/2"
- INDICATES DECK SPAN DIRECTION. REFER TO COMPOSITE STEEL DECK SCHEDULE INFORMATION.
- FOR ADDITIONAL INFORMATION REFER TO THE FOLLOWING DRAWINGS:
DRAWING LISTS, GENERAL NOTES, AND LOADING DIAGRAMS S-000 SERIES DRAWINGS
LATERAL SYSTEM ELEVATIONS, CONNECTION FORCES, AND DETAILS S-300 SERIES DRAWINGS
STEEL SUPERSTRUCTURE SCHEDULES AND DETAILS S-700 SERIES DRAWINGS
STEEL COLUMN SCHEDULES AND DETAILS S-800 SERIES DRAWINGS
- AT STAIRS, SEE TYPICAL DETAILS FOR TC, TCS, AND KICKER REQUIREMENTS 1, 2 & 3S-704
- REFER TO ARCH DWGS FOR LOCATION AND SIZE OF OPENINGS. SEE ALSO GENERAL NOTE GR-18 AND TYPICAL DETAIL 1/5-713


7. SYMBOLS:

- INDICATES MOMENT CONNECTION
- INDICATES DEEP BEAM BOTTOM FLANGE BRACING CONNECTION SEE DETAIL 6/5-703
- INDICATES FULL HEIGHT FITTED STIFFENER CONNECTION SEE DETAIL 4/5-703
- INDICATES FULL HEIGHT UNFITTED STIFFENER CONNECTION SEE DETAIL 5/5-703
- INDICATES KICKER AT SPANDREL BEAM CONNECTION SEE DETAIL 3/5-703
- INDICATES SLOPE IN TOP OF SLAB


8. NOTATIONS:

- BF INDICATES LATERAL BRACED FRAME
- CA/CB INDICATES BRACED FRAME ELEVATIONS FOR BEAM INFORMATION AND CONNECTION FORCES
- CBXX INDICATES CASTELLATED BEAM. SEE SCHEDULE 1/5-402
- DE INDICATES HSS/DK/309 ELEVATOR DIVIDER BEAM (NOT FIREPROOFED)
- HA/HB INDICATES HANGER ABOVE/BELOW. TENSION AXIAL FORCE IN HANGER BELOW INDICATED WHERE APPLICABLE. SEE DETAIL 3/5-702
- MF INDICATES LATERAL MOMENT FRAME
- PGXX INDICATES TAPERED PLATE GIRDER. SEE DETAIL 3/5-724
- TC INDICATES TORSIONAL CONNECTION FOR STAIRS. SEE DETAIL 1/5-704
- TR INDICATES COLUMN FROM ABOVE TRANSFERS. COMPRESSION AXIAL FORCE IN COLUMN INDICATED WHERE APPLICABLE. SEE DETAIL 1/5-702



2 PART PLAN AT T/STEEL EL. 103'-11 1/2" AND EL. 111'-10"
1/8" = 1'-0"

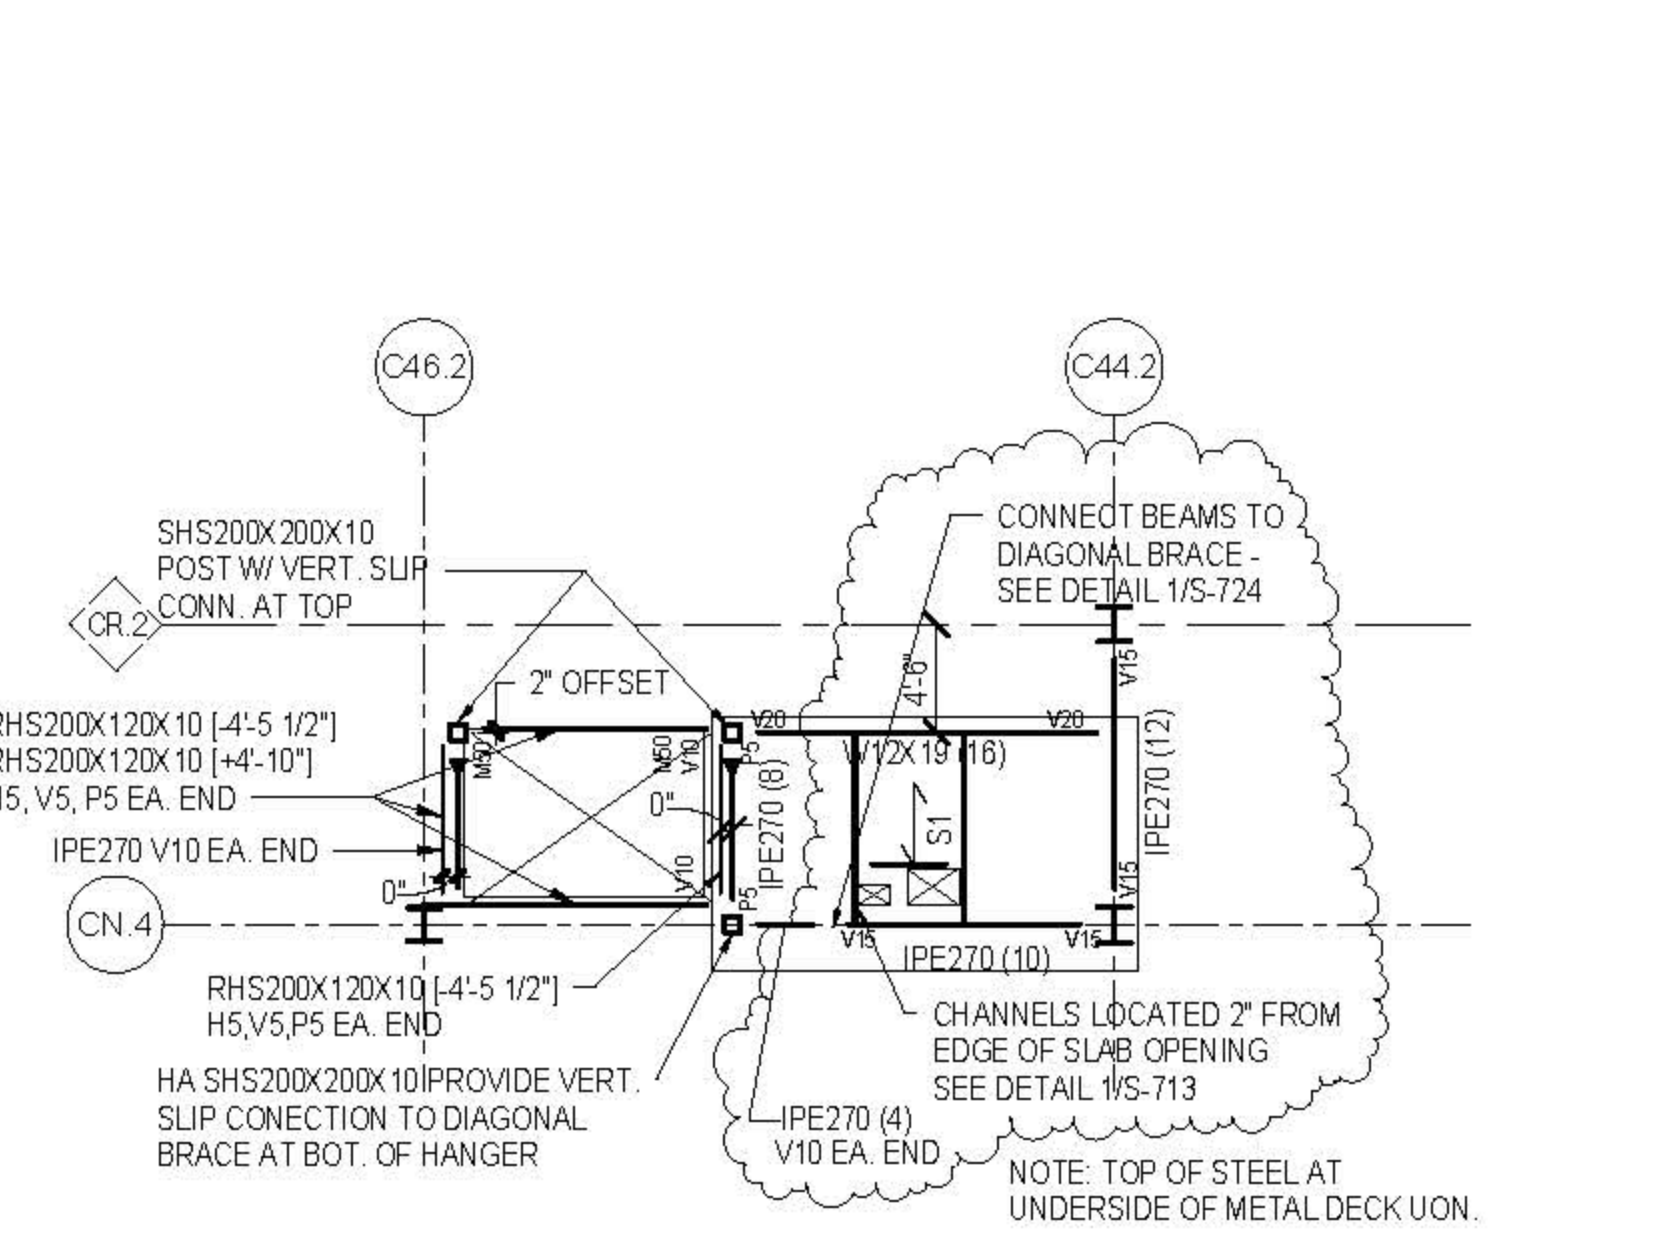

3 PART PLAN MEZZANINE 06 T/SLAB EL. 109'-10 1/2"
1/8" = 1'-0"

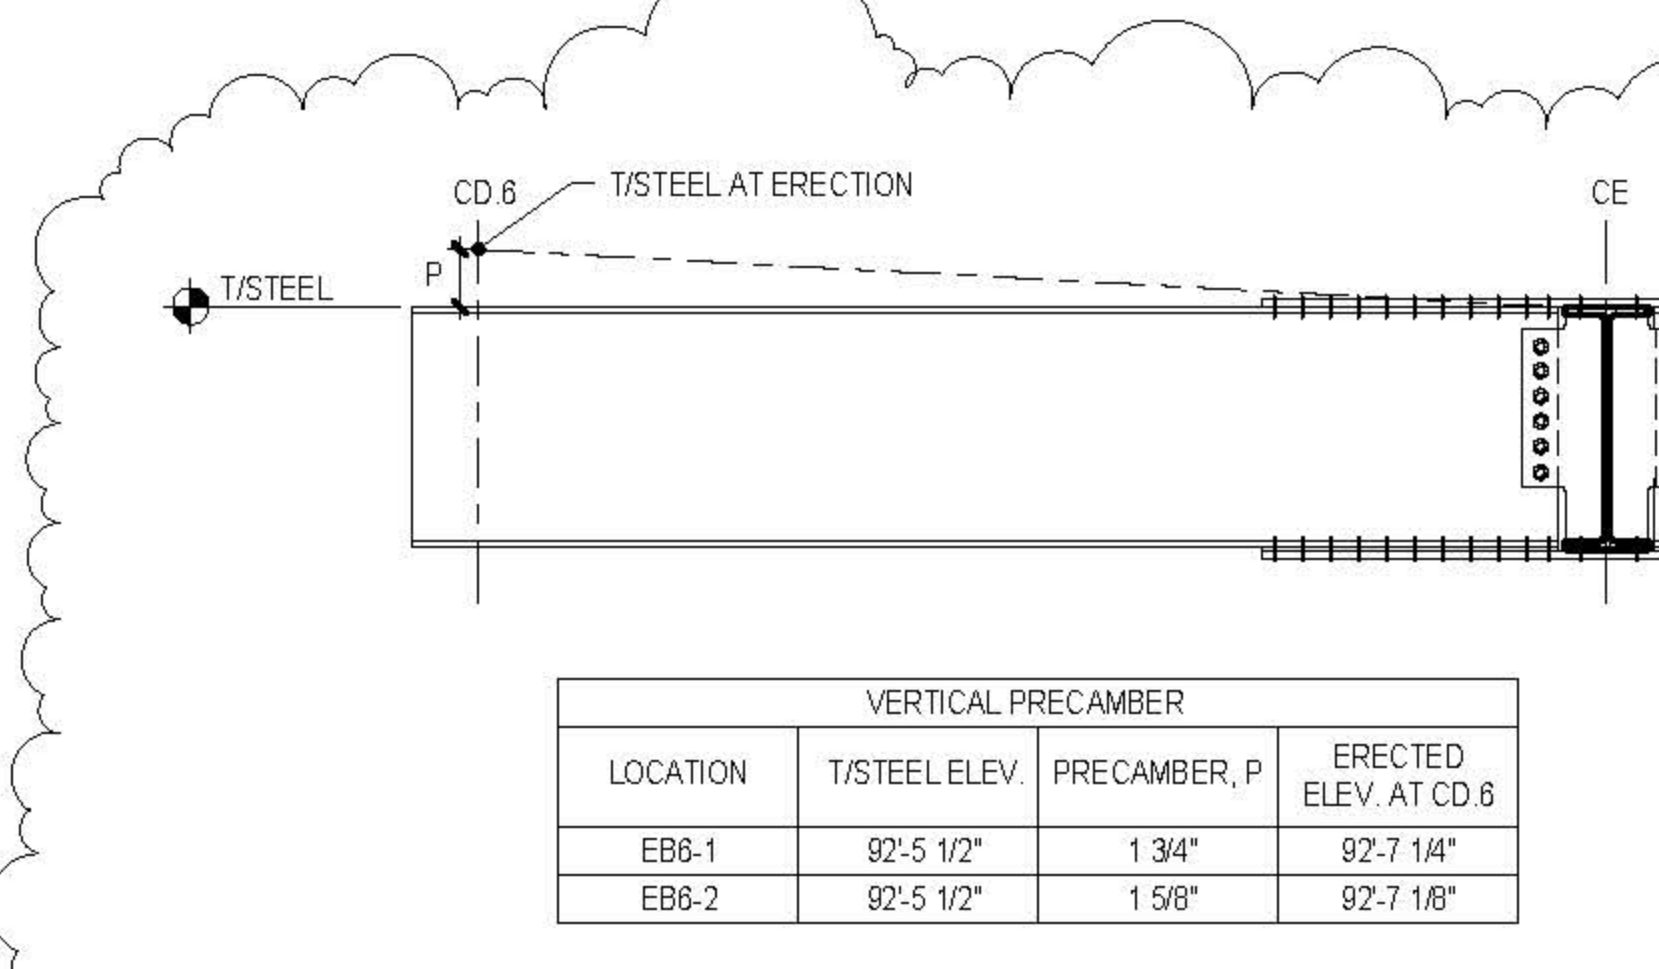

4 ESCALATOR SUPPORT CANTILEVER CAMBER LEVEL 06
1/2" = 1'-0"

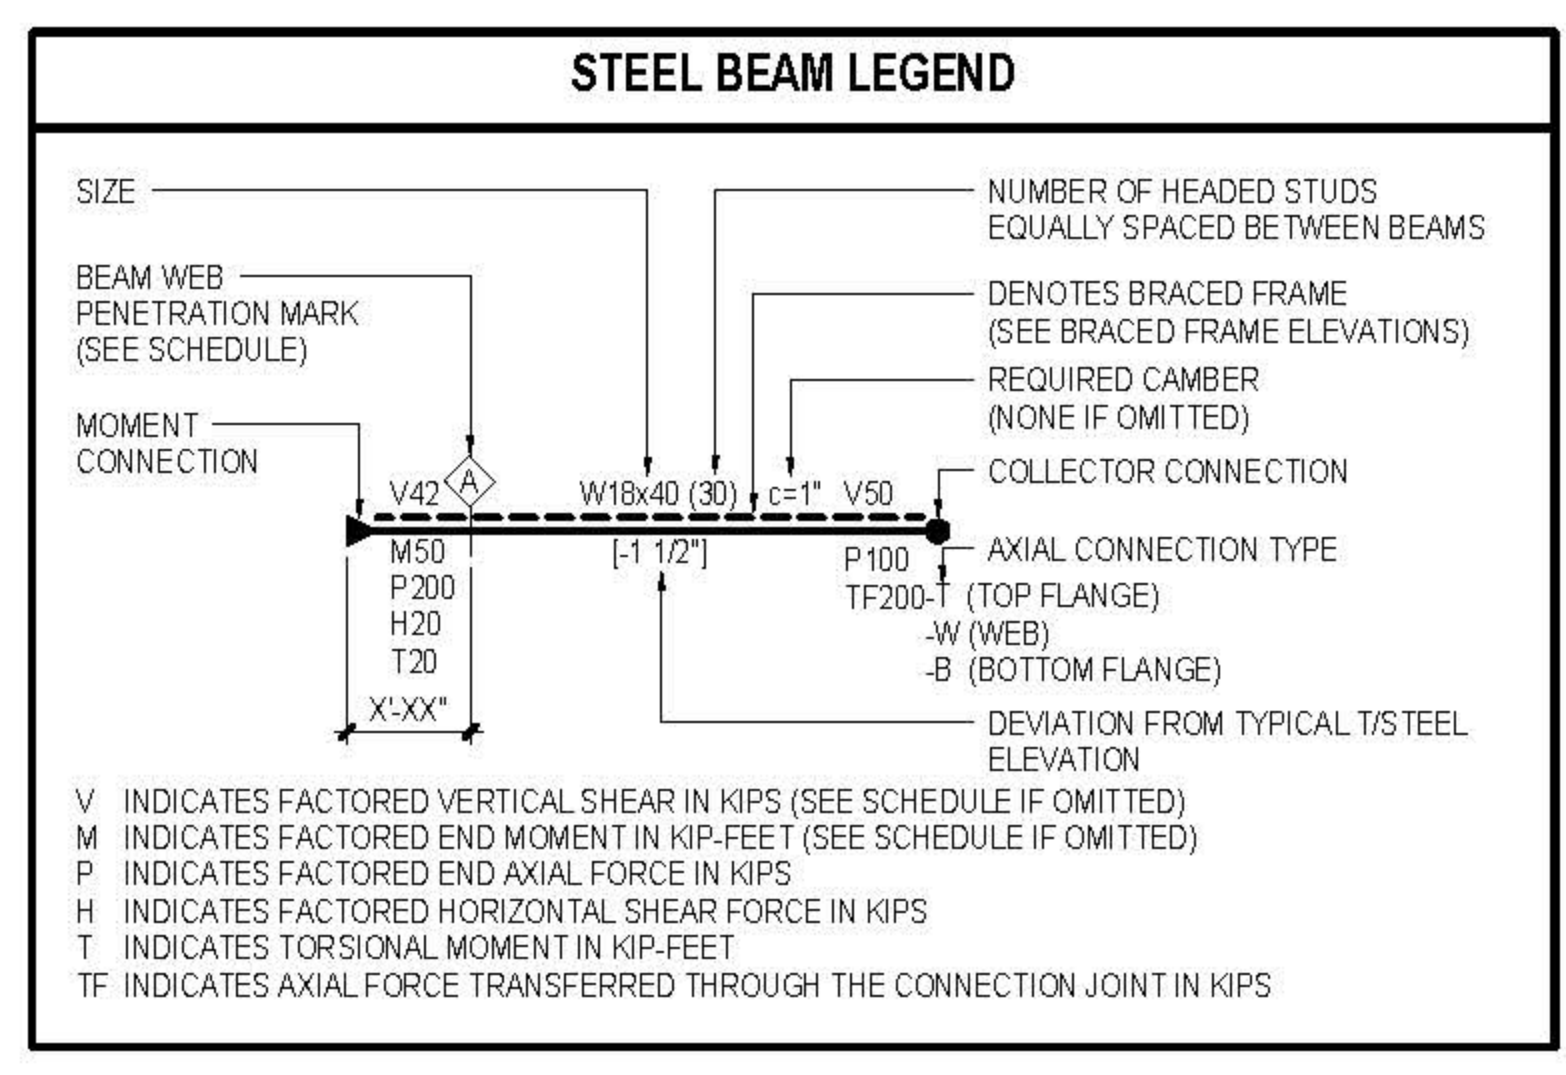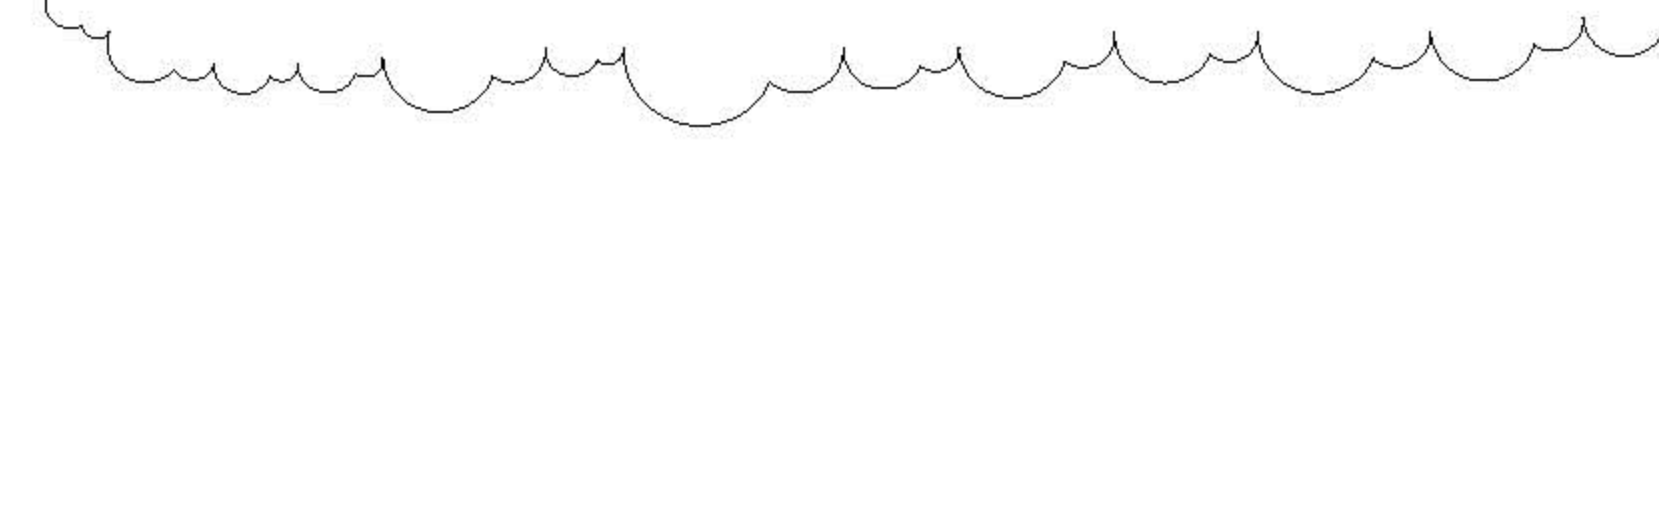

COMPOSITE STEEL DECK SCHEDULE					
SLAB MARK	TOTAL SLAB THICKNESS AND CONCRETE TYPE	STEEL DECK (MM)	CONCRETE TOPPING SLAB	SLAB REINFORCEMENT	NOTES
S1	5 1/2" NWC	3'-18 GA		6 x 6 - W4.0 x W4.0 WWR	
S2	7 1/2" NWC	3'-18 GA		4 x 4 - W4.0 x W4.0 WWR	
S3	9" NWC	3'-18 GA		#4 @ 18" C. EACH WAY	
S4	4" NWC	1 1/2" 18 GA		W2 x W2.9 WWR	
S5	8 1/2" NWC	3'-18 GA		#4 @ 12" O.C. N-S #4 @ 18" O.C. E-W	N-S BARS COORDINATED TO MECHANICAL COUPLERS IN EXISTING SLAB

CULTURE SHED

540 West 30th Street
New York, New York 10001

OWNER
CULTURE SHED INC.

ARCHITECTS
Oller Scaffida + Renfro Architects, DPC
601 West 25th Street #815
New York, New York 10001
T: 212.463.0334
F: 212.463.0335

STRUCTURAL ENGINEER
Thornton Tomasetti
51 Madison Avenue
New York, New York 10010
T: 917.861.7800
F: 917.861.7801

MEP ENGINEER
Jana Baum & Bolles
83 Park Street
New York, New York 10005
T: 212.530.9300
F: 212.265.6564

MEP ENGINEER
Jana Baum & Bolles
83 Park Street
New York, New York 10005
T: 212.530.9300
F: 212.265.6564


MEP ENGINEER
Jana Baum & Bolles
83 Park Street
New York, New York 10005
T: 212.530.9300
F: 212.265.6564

MEP ENGINEER
Jana Baum & Bolles
83 Park Street
New York, New York 10005
T: 212.530.9300
F: 212.265.6564
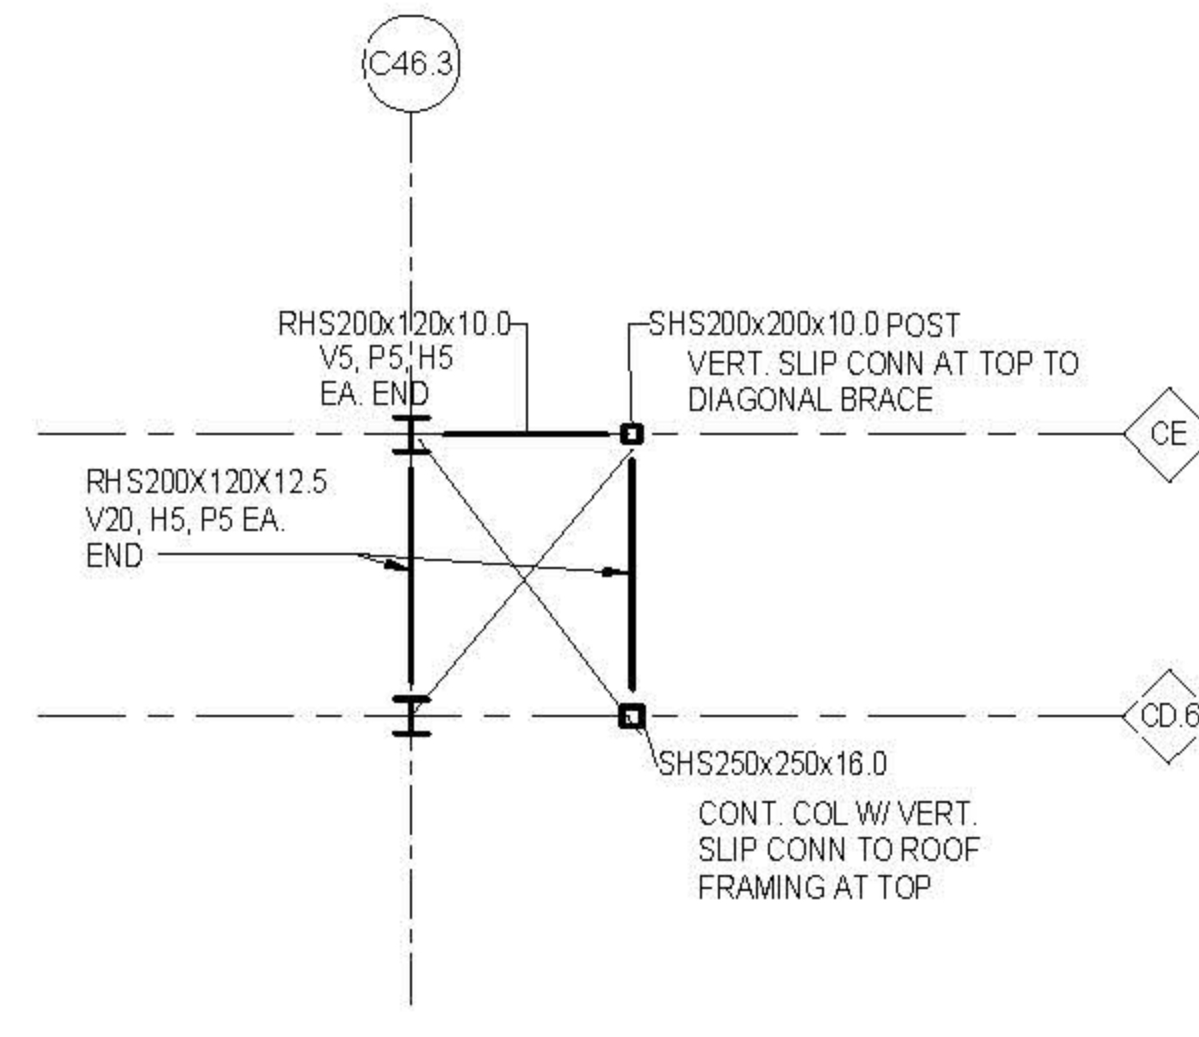


2 PART PLAN AT EL T/STEEL EL. 134'-7"
1/8" = 1'-0"

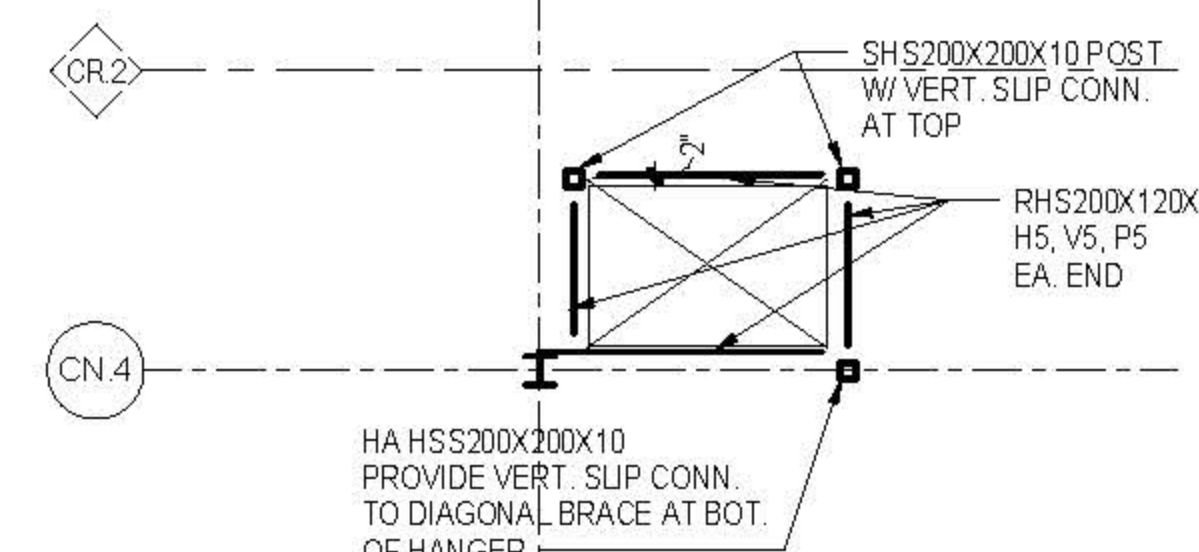

3 PART PLAN AT T/STEEL EL. 134'-7"
1/8" = 1'-0"

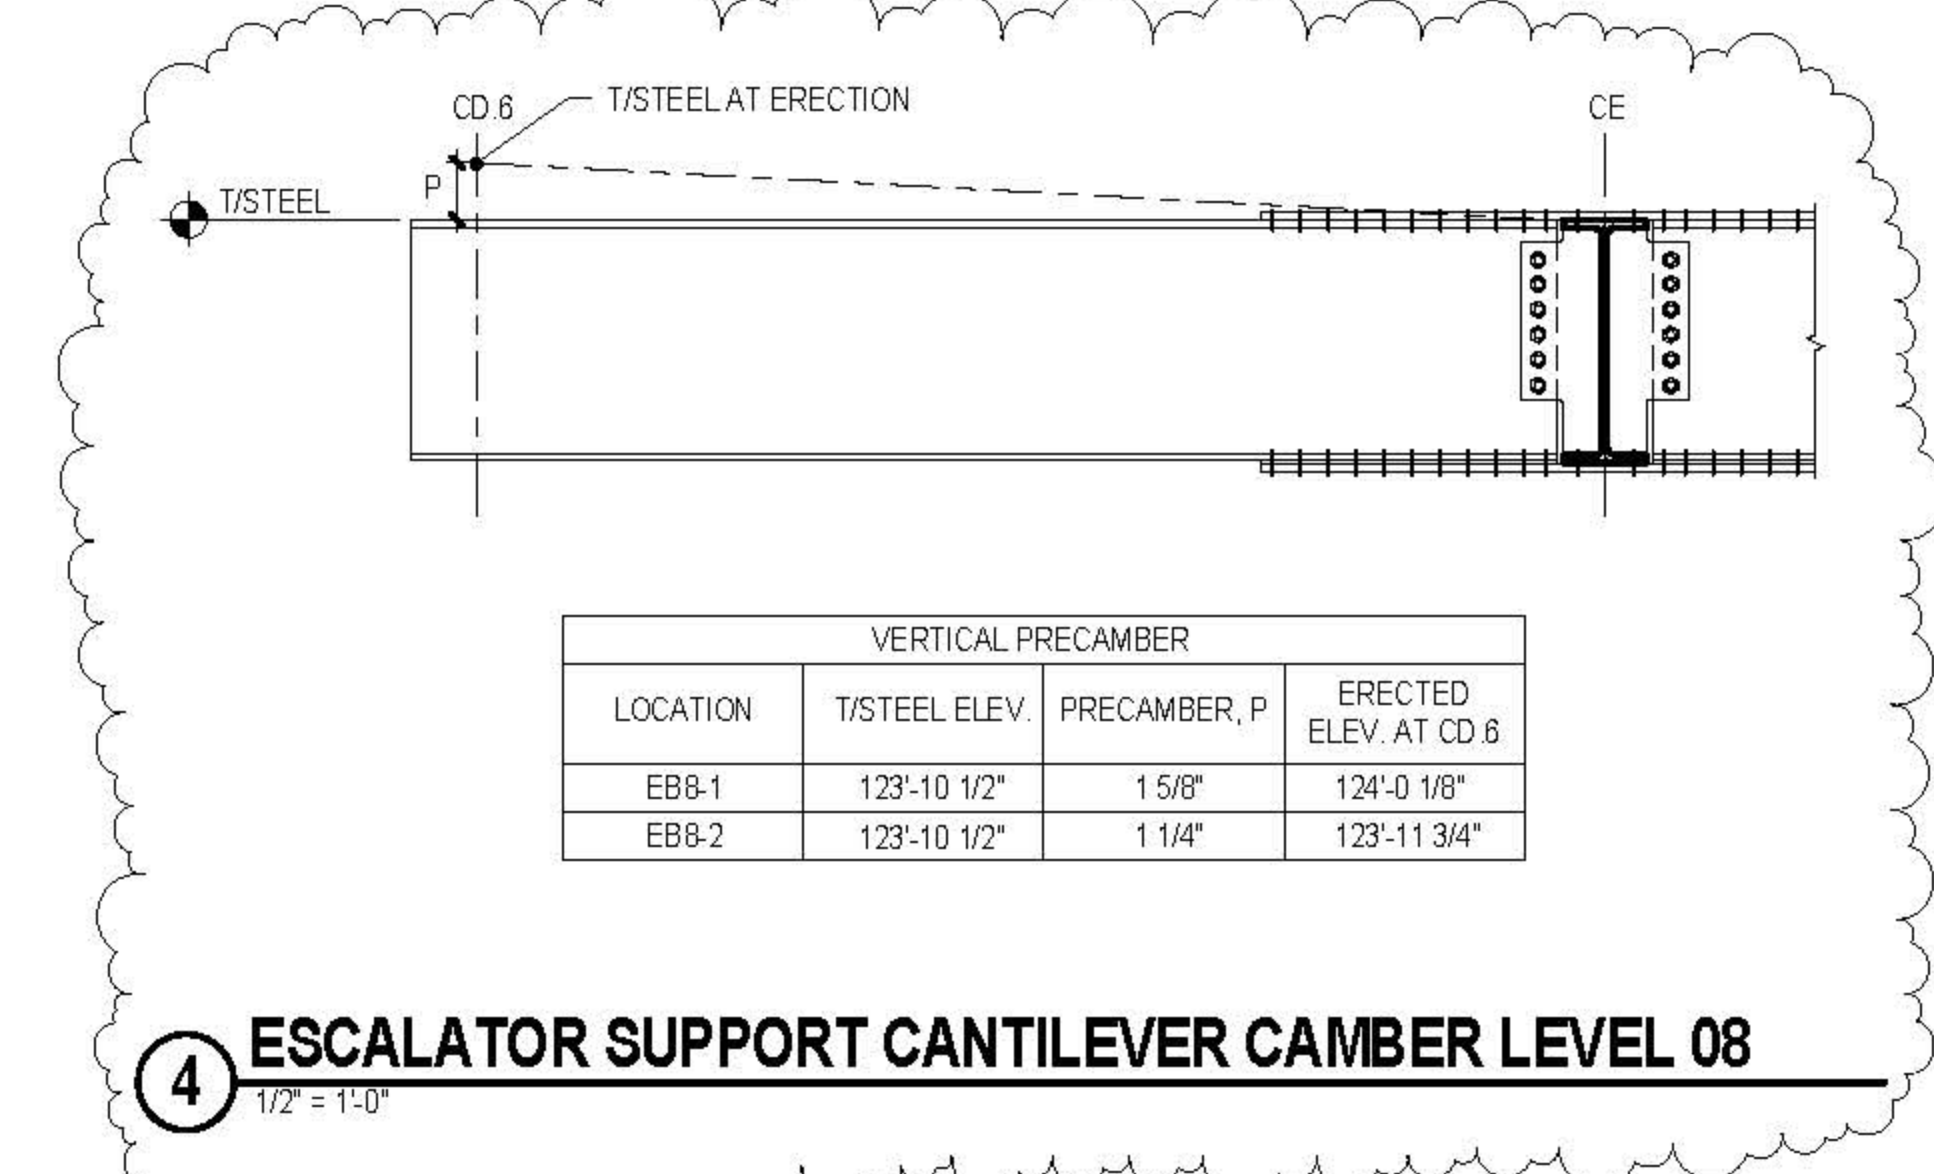

4 ESCALATOR SUPPORT CANTILEVER CAMBER LEVEL 08
1/2" = 1'-0"

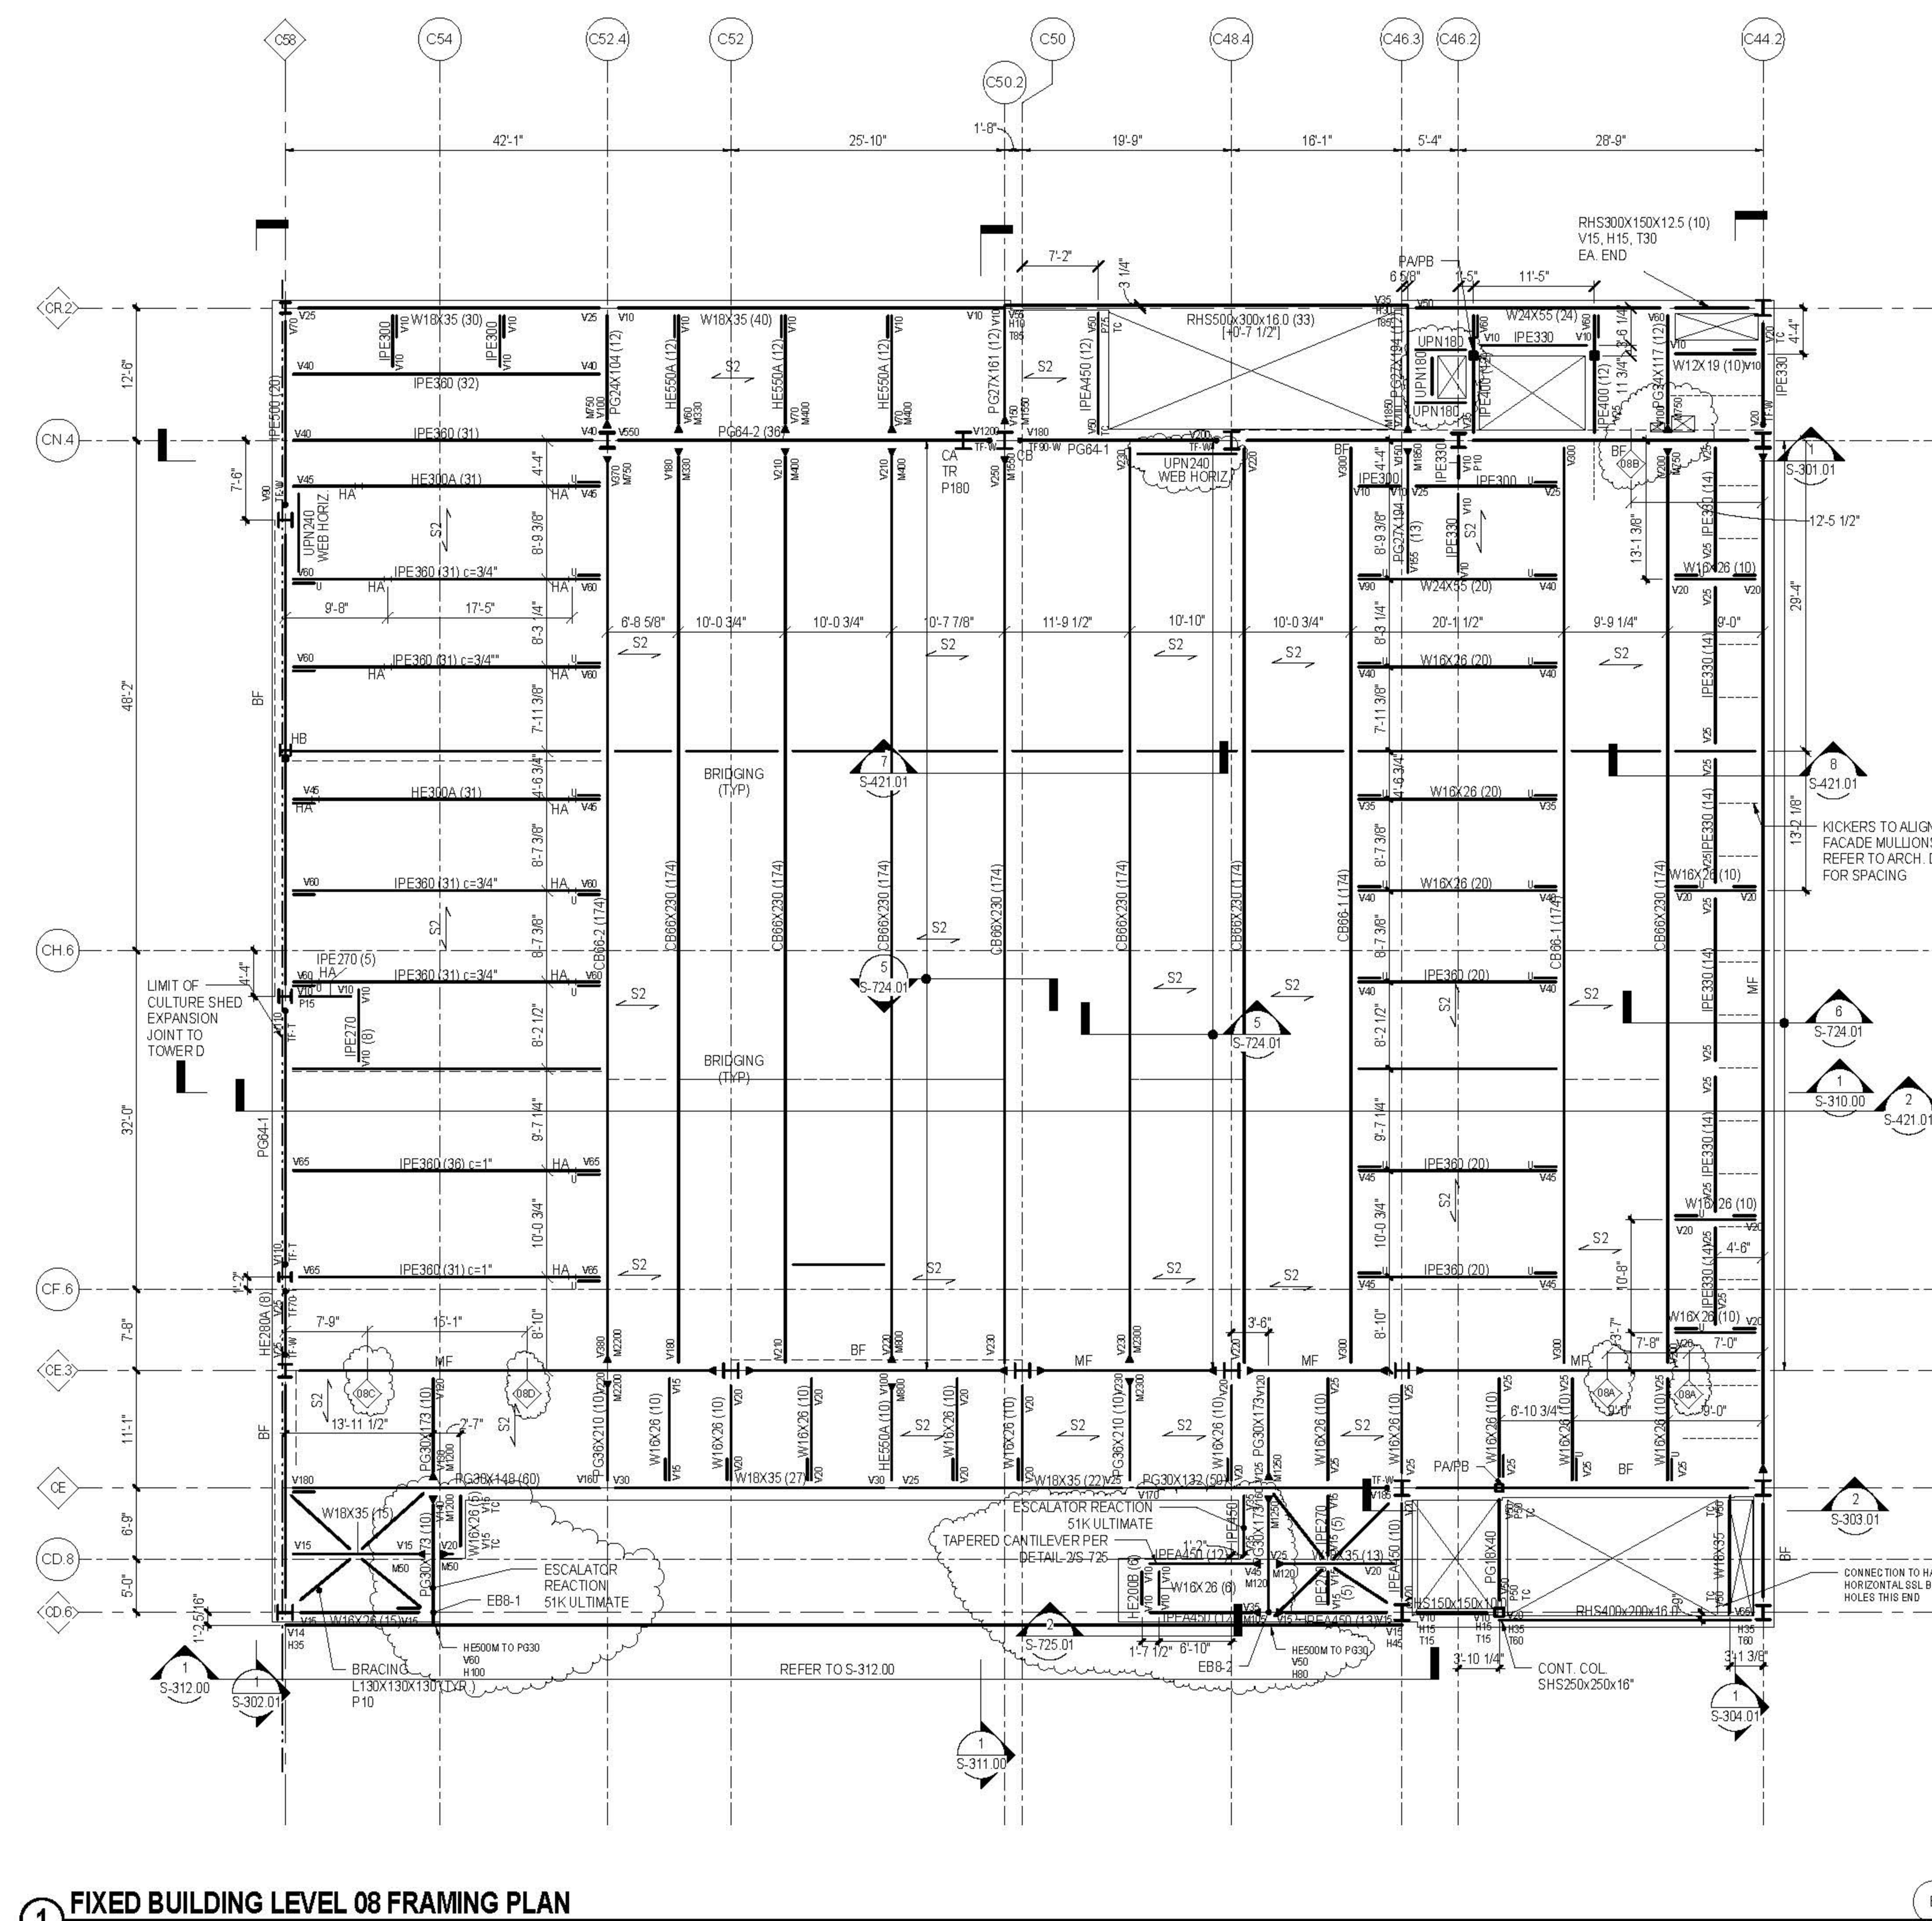

1 FIXED BUILDING LEVEL 08 FRAMING PLAN
1/8" = 1'-0"

SHEET NOTES


- T/STRUCTURAL SLAB EL+124'-6" UON
- T/STEEL EL+123'-10 1/2"
- INDICATES DECK SPAN DIRECTION, REFER TO COMPOSITE STEEL DECK SCHEDULE INFORMATION
- FOR ADDITIONAL INFORMATION REFER TO THE FOLLOWING DRAWINGS:
DRAWING LISTS, GENERAL NOTES, AND LOADING DIAGRAMS S-000 SERIES DRAWINGS
LATERAL SYSTEM ELEVATIONS, CONNECTION FORCES, AND DETAILS S-300 SERIES DRAWINGS
STEEL SUPERSTRUCTURE SCHEDULES AND DETAILS S-700 SERIES DRAWINGS
STEEL COLUMN SCHEDULES AND DETAILS S-800 SERIES DRAWINGS
- AT STAIRS, SEE TYPICAL DETAILS FOR TC, TCS, AND KICKER REQUIREMENTS 1, 2 & 3S-704
- REFER TO ARCH DWGS FOR LOCATION AND SIZE OF OPENINGS. SEE ALSO GENERAL NOTE GR-18 AND TYPICAL DETAIL 1/S-713

7. SYMBOLS:

- INDICATES MOMENT CONNECTION
- INDICATES DEEP BEAM BOTTOM FLANGE BRACING CONNECTION SEE DETAIL 9S-703
- INDICATES FULL HEIGHT FITTED STIFFENER CONNECTION SEE DETAIL 4S-703
- INDICATES FULL HEIGHT UNFITTED STIFFENER CONNECTION SEE DETAIL 5S-703
- INDICATES KICKER AT SPANDREL BEAM CONNECTION SEE DETAIL 3S-703
- INDICATES SLOPE IN TOP OF SLAB


8. NOTATIONS

- BF INDICATES LATERAL BRACED FRAME
- CA/CB INDICATES COLUMN ABOVE/BELOW, COMPRESSION AXIAL FORCE IN COLUMN INDICATED WHERE APPLICABLE. SEE DETAIL 1/S-702 & 2S-702
- CBX INDICATES CASTELLATED BEAM. SEE SCHEDULE 1/S-402
- CS INDICATES HSS/BOX/PIPE ELEVATOR DIVIDER BEAM (NOT FIREPROOFED)
- HA/HB INDICATES HANGER ABOVE/BELOW, TENSION AXIAL FORCE IN HANGER BELOW INDICATED WHERE APPLICABLE. SEE DETAIL 3S-702
- MF INDICATES LATERAL MOMENT FRAME
- PGX INDICATES PLATE GIRDER TYPE. SEE S-703 FOR PLATE GIRDER SCHEDULE
- PGX/T INDICATES TAPERED PLATE GIRDER. SEE DETAIL 3S-724
- TC INDICATES TORSIONAL CONNECTION FOR STAIR. SEE DETAIL 1/S-704
- TR INDICATES COLUMN FROM ABOVE TRANSFERS, COMPRESSION AXIAL FORCE IN COLUMN INDICATED WHERE APPLICABLE. SEE DETAIL 1/S-702

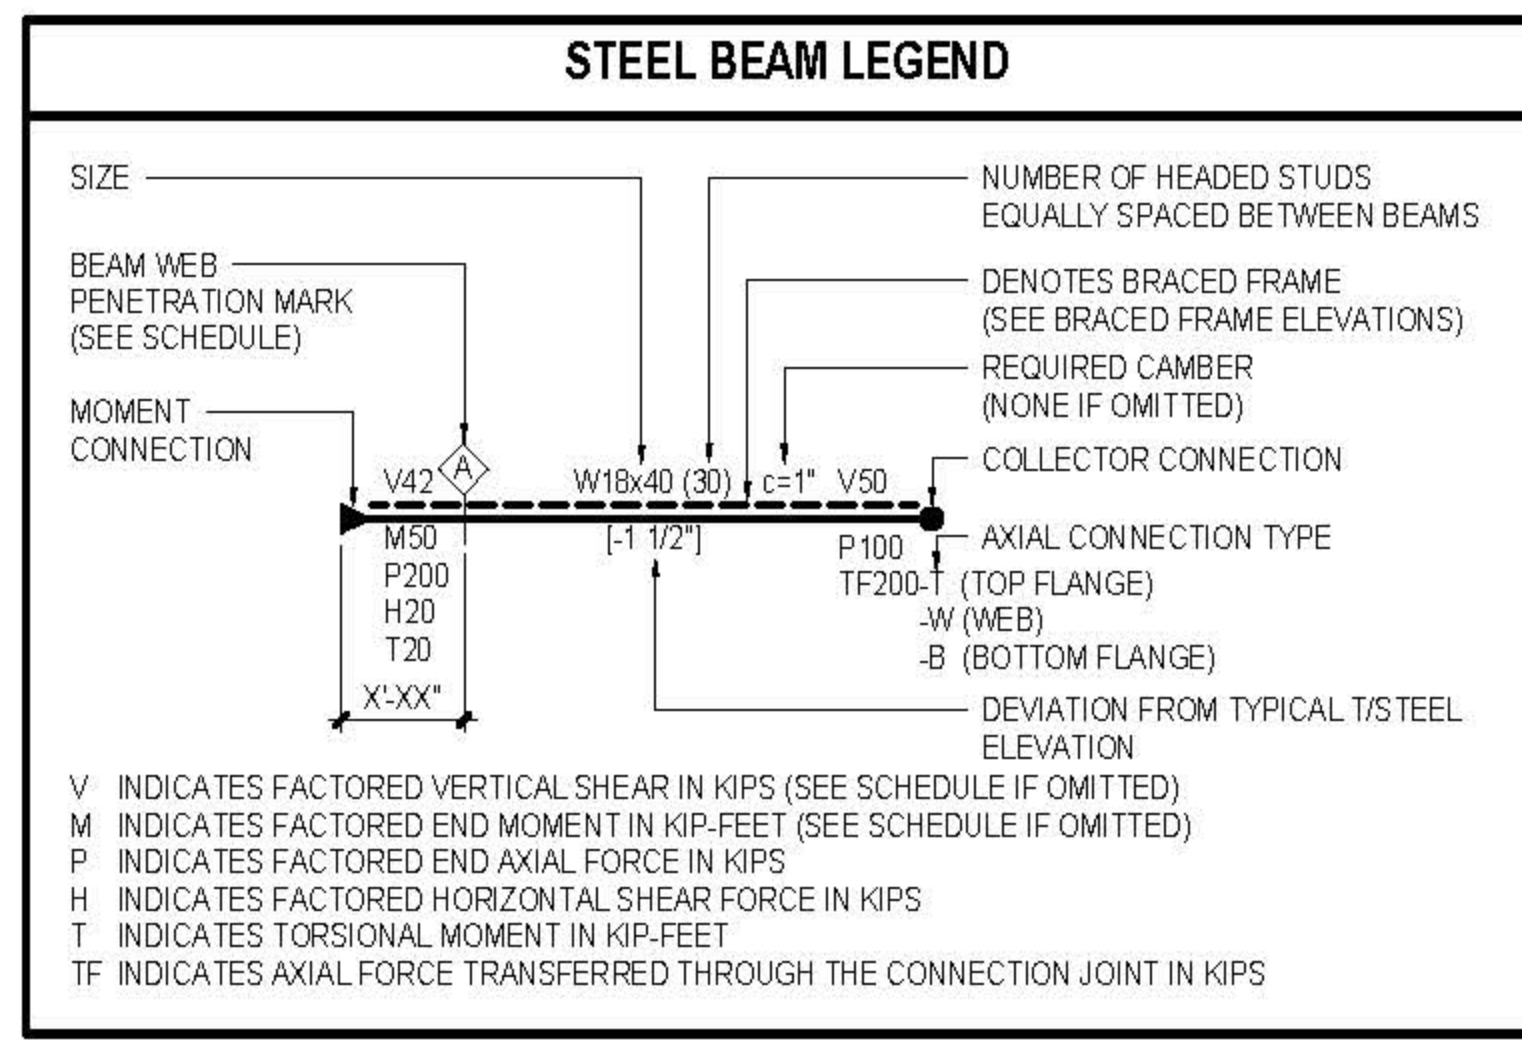

SLAB MARK	TOTAL SLAB THICKNESS AND CONCRETE TYPE	STEEL DECK (MIN)	CONCRETE TOPPING SLAB	SLAB REINFORCEMENT	NOTES
S1	5 1/2" NWC	3'-18 GA		6 x 6 - W4.0 x W4.0 WWR	
S2	7 1/2" NWC	3'-18 GA		4 x 4 - W4.0 x W4.0 WWR	
S3	8" NWC	3'-18 GA		D.C. EACH WAY	
S4	4" NWC	1 1/2" - 18 GA		9 x 9 x W2.9 WWR	
S5	8 1/2" NWC	3'-18 GA		#4 @ 12" O.C. N-S #4 @ 18" O.C. E-W	N-S BARS COORDINATED TO MECHANICAL COUPLERS IN EXISTING SLAB

KEY PLAN

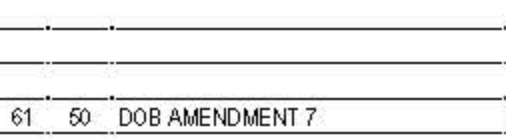

ISSUE

NO.	DESCRIPTION	DATE
01	ISSUE FOR PERMITTING	08/19/2016
02	REVISED FOR PERMITTING	08/22/2016
03	REVISED FOR PERMITTING	08/22/2016


DRAWN BY: [Name] CHECKED BY: [Name]

PROJECT NUMBER: N11318.00


TITLE: FRAMING PLAN, FIXED BUILDING - LEVEL 08

DRAWING NO.: S-108.01

B.SCAN NO.: S-108.01

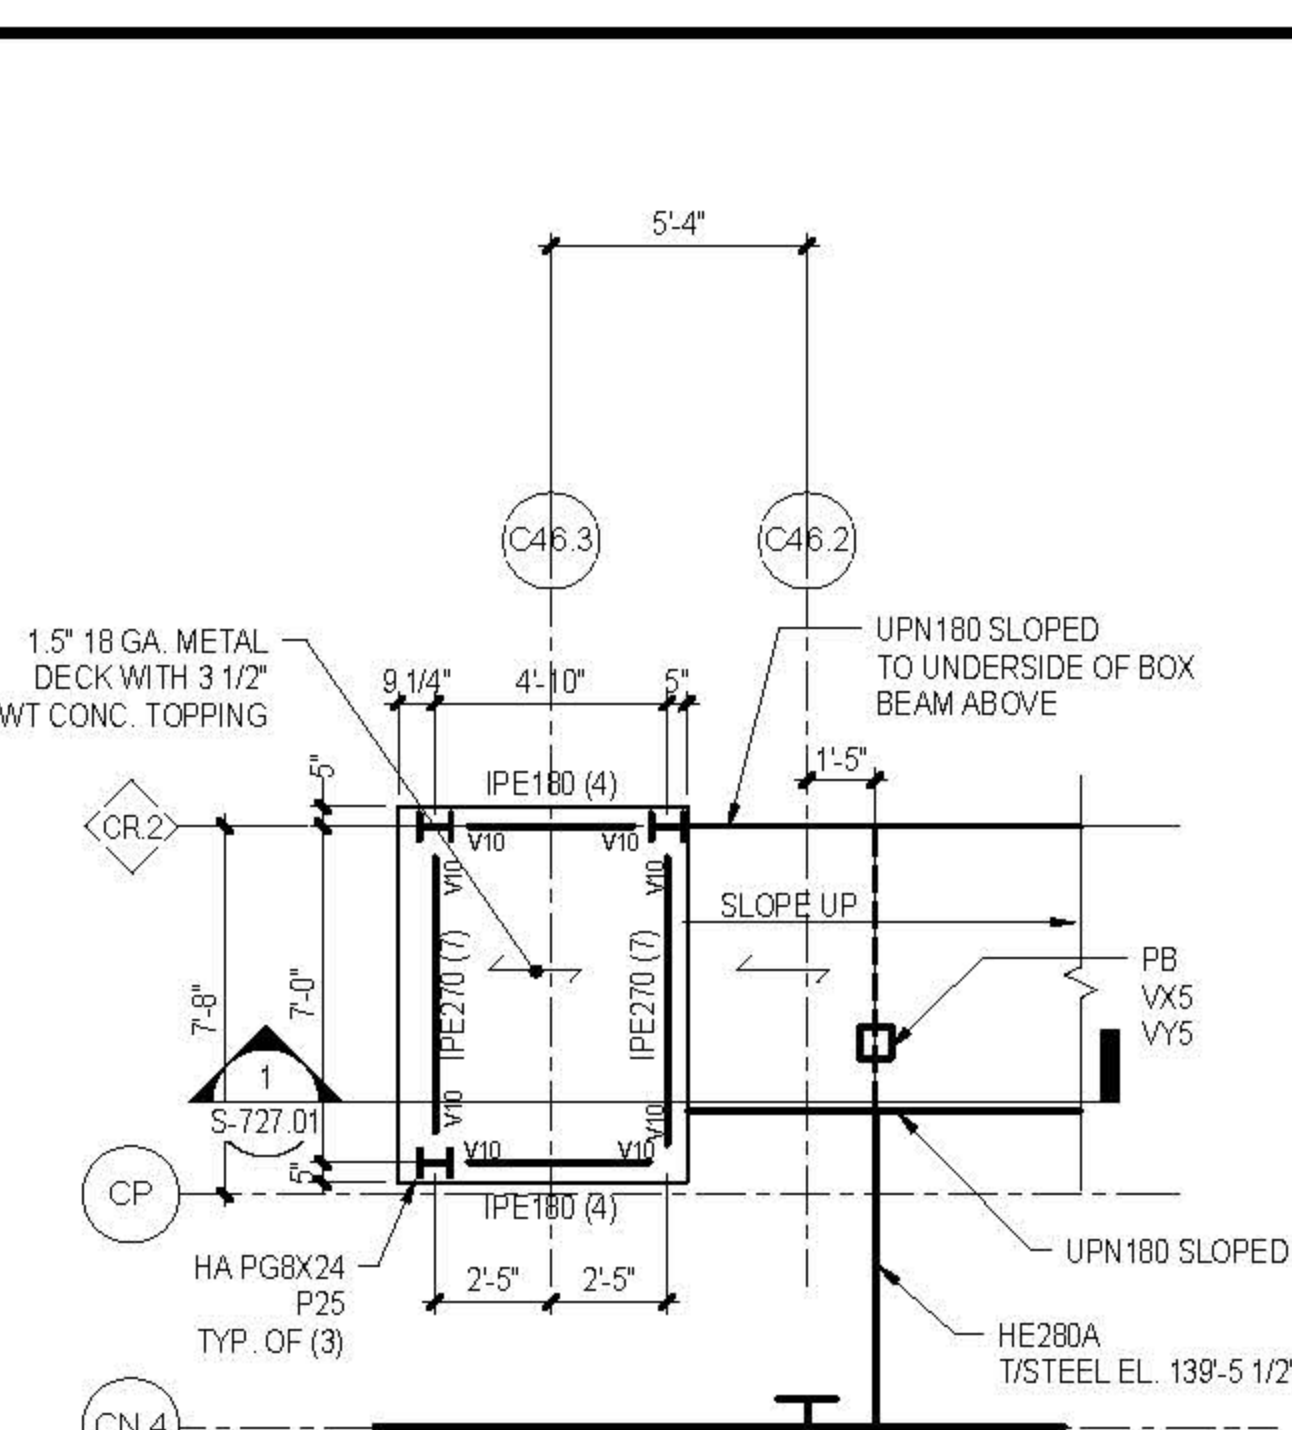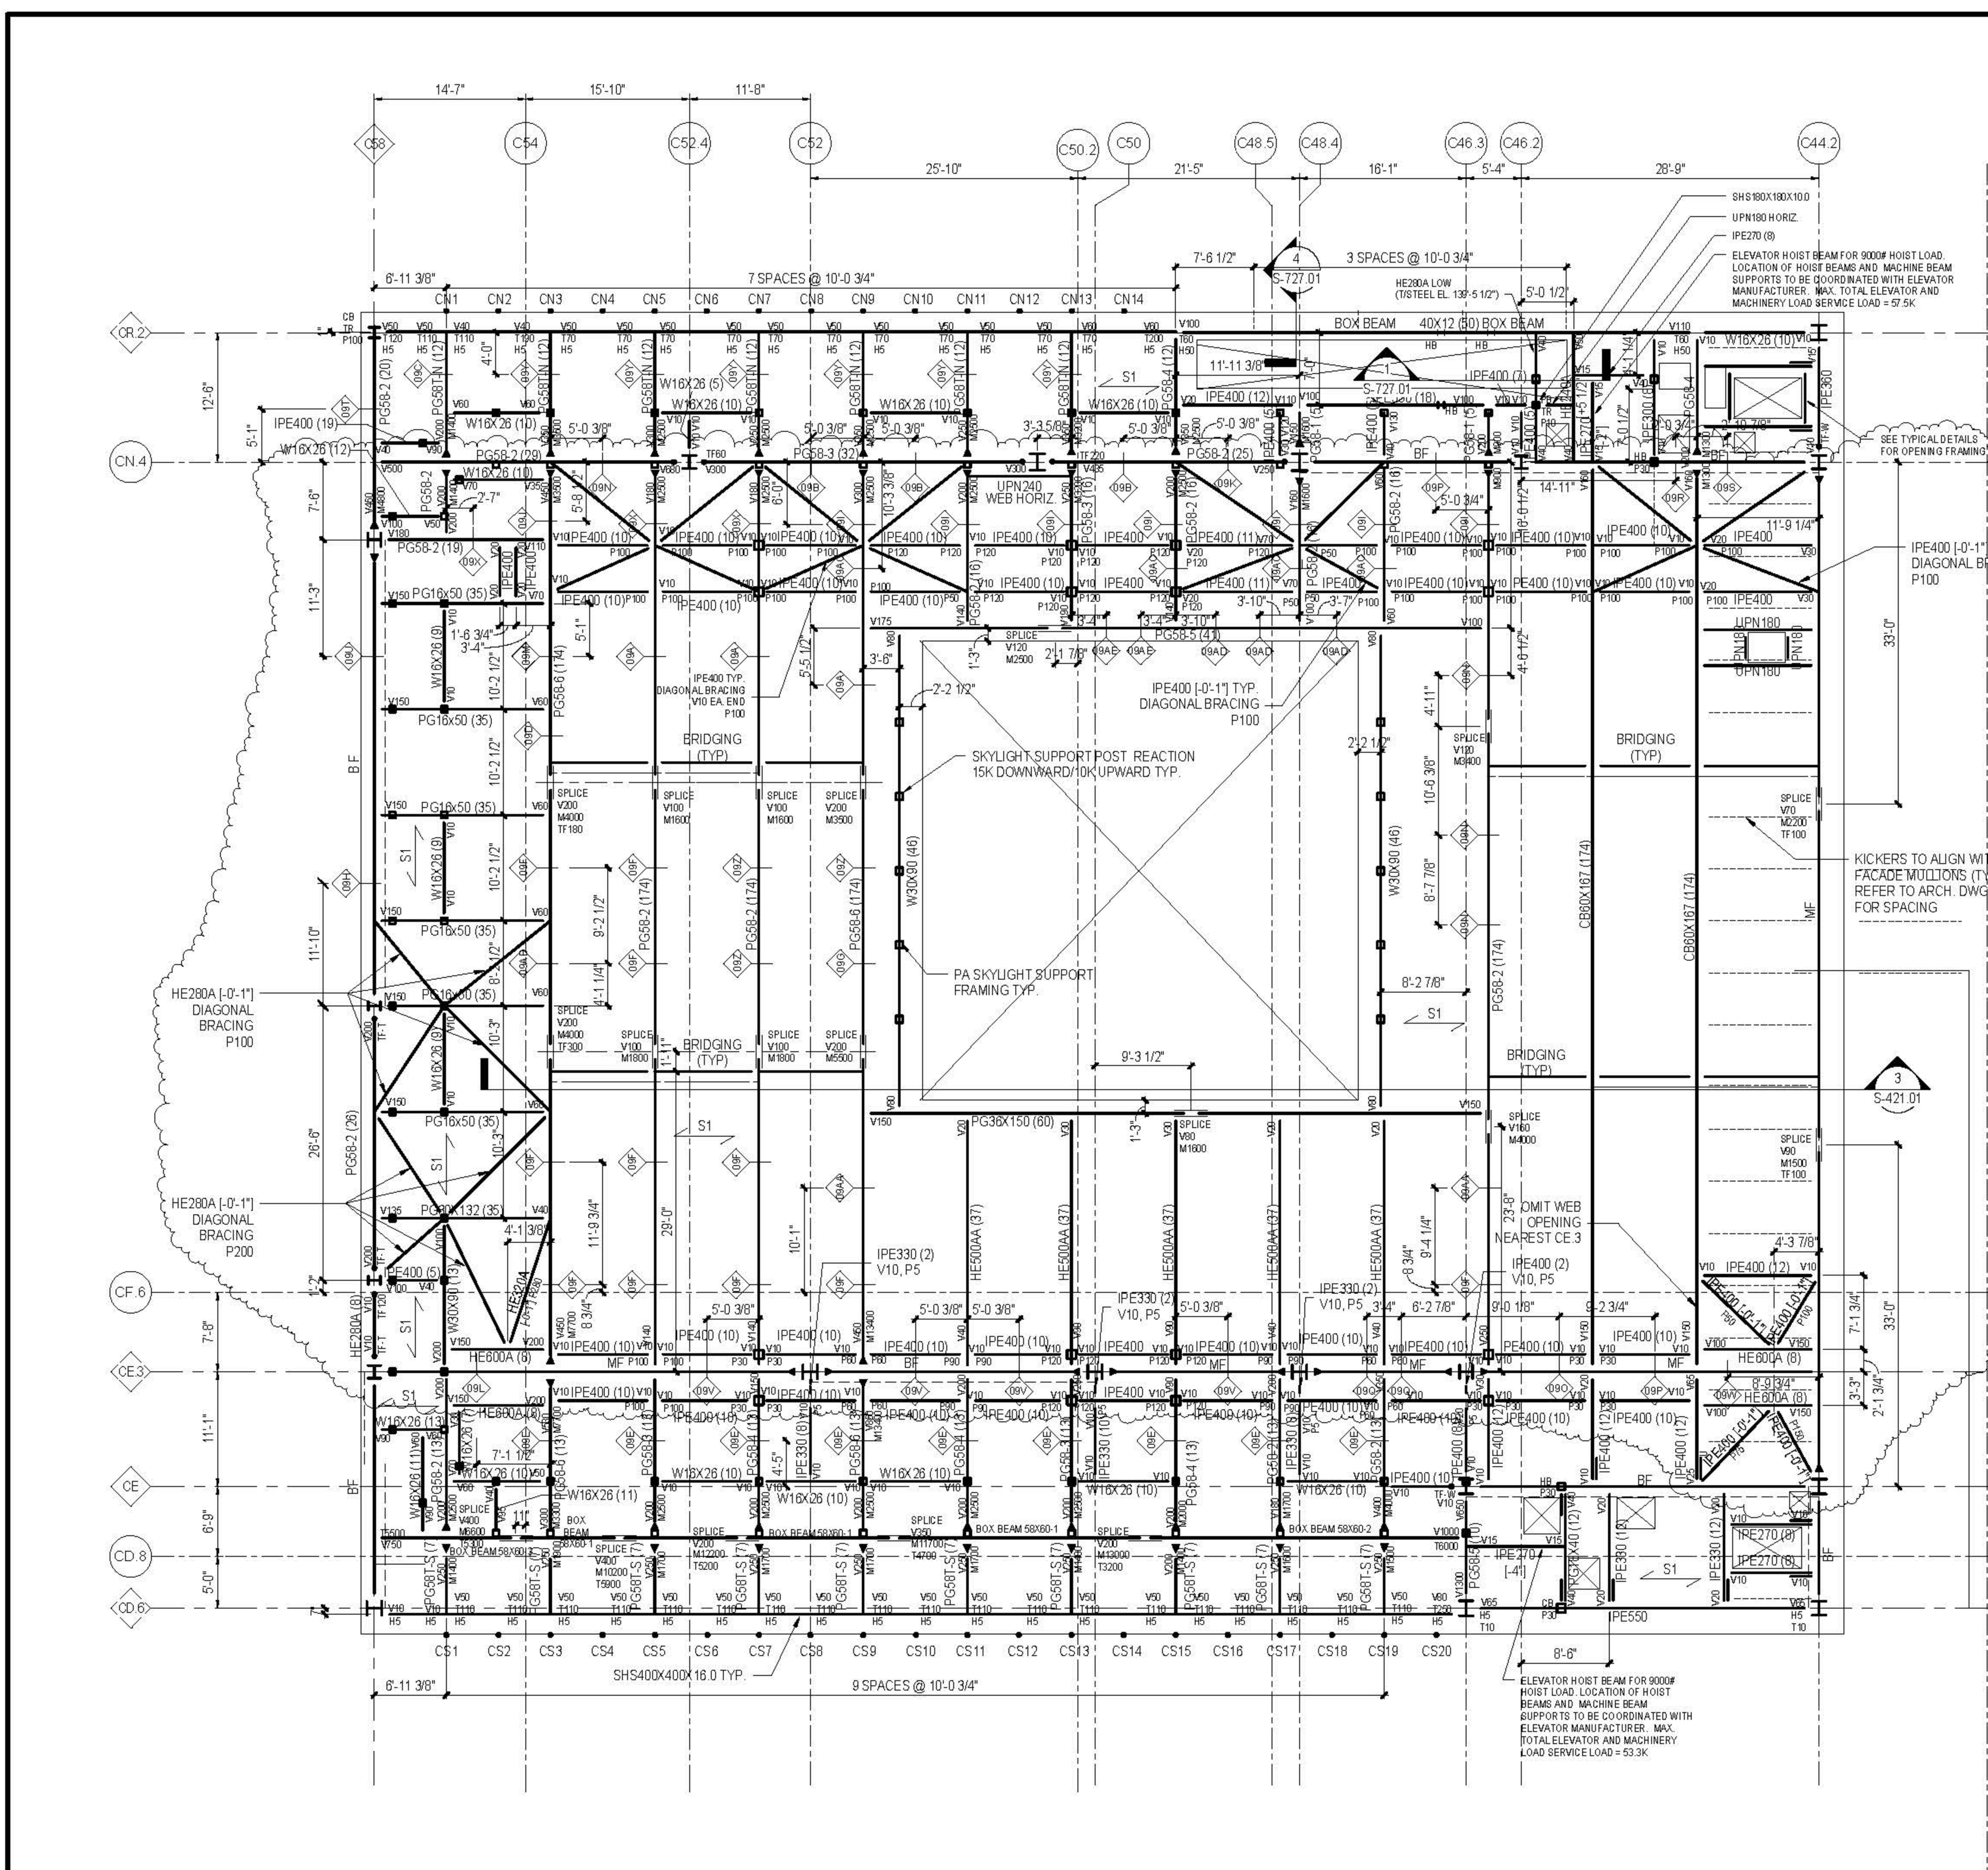

3 PART PLAN AT ROOF STAIR
1/4\"/>

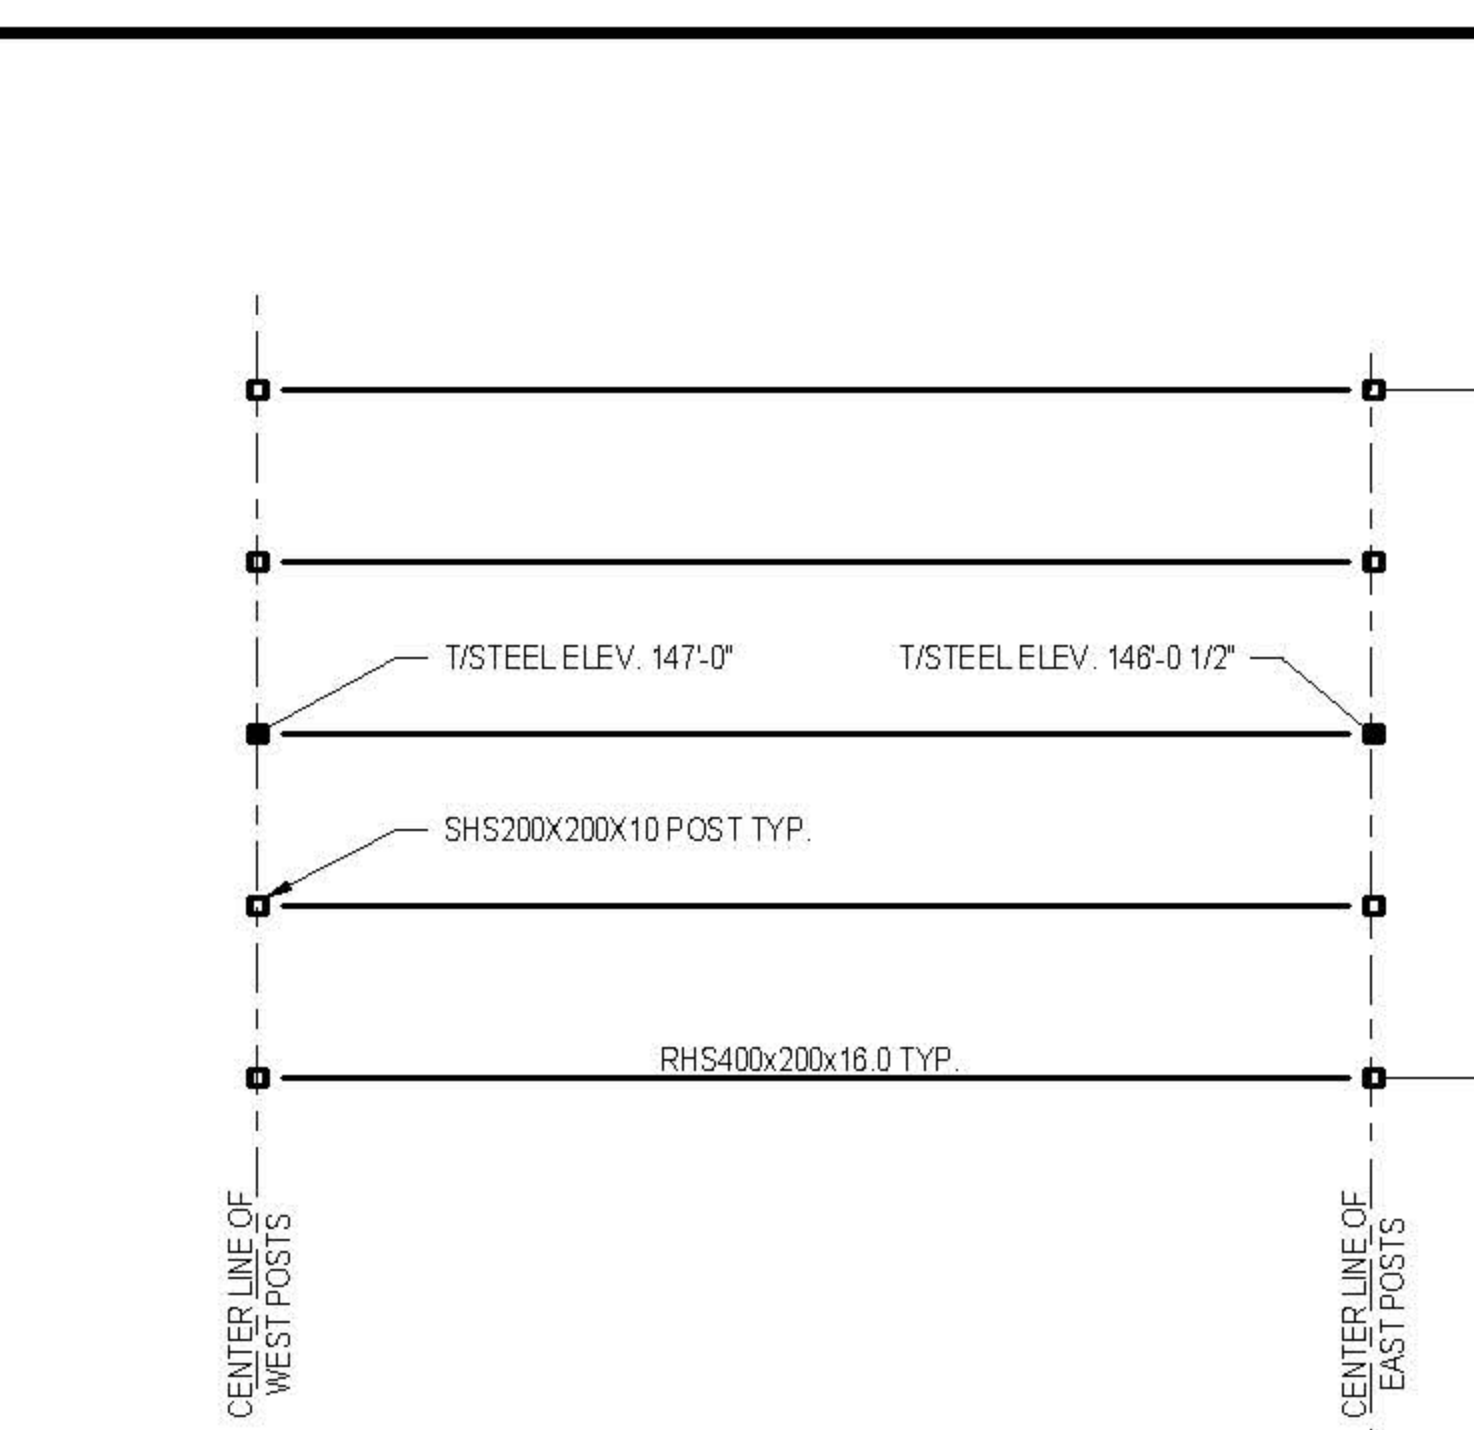

2 PART PLAN AT SKYLIGHT FRAMING
1/8\"/>

CABLE TOP ANCHOR FORCES AND DISPLACEMENTS				
CABLE	SOUTH WALL		NORTH WALL	
	MAX. U.L.T. TENSION [KIPS]	CABLE PRE-STRESS [KIPS]	PRE-STRESS Δ [IN.]	CAMBER @ CABLE C.L. [IN.]
CS1	120	110		
CS2	80	70		
CS3	65	55		
CS4	65	55		
CS5	60	55		
CS6	65	55		
CS7	65	55		
CS8	65	55		
CS9	65	55		
CS10	65	55		
CS11	65	55		
CS12	60	50		
CS13	55	45		
CS14	55	45		
CS15	55	45		
CS16	55	45		
CS17	60	45		
CS18	60	45		
CS19	60	50		
CS20	100	90		
CN1	95	90		
CN2	60	45		
CN3	45	35		
CN4	40	25		
CN5	35	25		
CN6	40	25		
CN7	40	25		
CN8	40	25		
CN9	40	25		
CN10	40	25		
CN11	40	25		
CN12	45	35		
CN13	60	45		
CN14	100	90		

CONTRACTOR TO SUBMIT TO S.E.R. PRE-STRESSING SEQUENCE FOR COMMENT AND APPROVAL. CONNECTING STEEL WORK TO BE VERIFIED FOR CONTRACTOR'S PROPOSED SEQUENCING.


NOTE:
DOWNWARD DISPLACEMENT VALUES INDICATED AS NEGATIVE.

1 FIXED BUILDING ROOF LEVEL FRAMING PLAN
1/8\"/>

SHEET NOTES

1. T/STRUCTURAL SLAB EL. 142'-5" UON
2. T/STEEL EL. 141'-11 1/2"
3. INDICATES DECK SHEAR DIRECTION, REFER TO COMPOSITE STEEL DECK SCHEDULE INFORMATION.
4. FOR ADDITIONAL INFORMATION REFER TO THE FOLLOWING DRAWINGS:
DRAWING LISTS, GENERAL NOTES, AND LOADING DIAGRAMS S-5000 SERIES DRAWINGS
LATERAL SYSTEM ELEVATIONS, CONNECTION FORCES, AND DETAILS S-3000 SERIES DRAWINGS
STEEL SUPERSTRUCTURE SCHEDULES AND DETAILS S-7000 SERIES DRAWINGS
STEEL COLUMN SCHEDULES AND DETAILS S-8000 SERIES DRAWINGS
5. AT STAIRS, SEE TYPICAL DETAILS FOR TC, TCS, AND KICKER REQUIREMENTS 1, 2 & 3/S-704
6. REFER TO ARCH DWGS FOR LOCATION AND SIZE OF OPENINGS. SEE ALSO GENERAL NOTE GR-18 AND TYPICAL DETAIL 1/S-713

7. SYMBOLS:
INDICATES MOMENT CONNECTION
INDICATES DEEP BEAM BOTTOM FLANGE BRACING CONNECTION SEE DETAIL 6/S-703
INDICATES FULL HEIGHT FITTED STIFFENER CONNECTION SEE DETAIL 4/S-703
INDICATES FULL HEIGHT UNFITTED STIFFENER CONNECTION SEE DETAIL 5/S-703
INDICATES KICKER AT SPANDREL BEAM CONNECTION SEE DETAIL 3/S-703
INDICATES SLOPE IN TOP OF SLAB
8. NOTATIONS:
BF INDICATES LATERAL BRACED FRAME
CAB/CB SEE BRACED FRAME ELEVATIONS FOR BEAM INFORMATION AND CONNECTION FORCES
C/CB/CB INDICATES COLUMN ABOVE/BELOW COMPRESSION AXIAL FORCE IN COLUMN INDICATED WHERE APPLICABLE. SEE DETAIL 1/S-702 & 2/S-702
CBXX INDICATES CASTELLATED BEAM. SEE SCHEDULE 1/S-402
DB INDICATES HSS/BOX/300 ELEVATOR DIVIDER BEAM (NOT FIREPROOFED)
HA/HB INDICATES HANGER ABOVE/BELOW. TENSION AXIAL FORCE IN HANGER BELOW INDICATED WHERE APPLICABLE. SEE DETAIL 3/S-702
MF INDICATES LATERAL MOMENT FRAME
SEE MOMENT FRAME ELEVATIONS FOR BEAM INFORMATION AND CONNECTION FORCES
PGXX INDICATES PLATE GIRDER TYPE. SEE S-703 FOR PLATE GIRDER SCHEDULE.
TC INDICATES TAPERED PLATE GIRDER. SEE DETAIL 3/S-724
TR INDICATES TORSIONAL CONNECTION FOR STAIR. SEE DETAIL 1/S-704
TR INDICATES COLUMN FROM ABOVE TRANSFERS COMPRESSION AXIAL FORCE IN COLUMN INDICATED WHERE APPLICABLE. SEE DETAIL 1/S-702

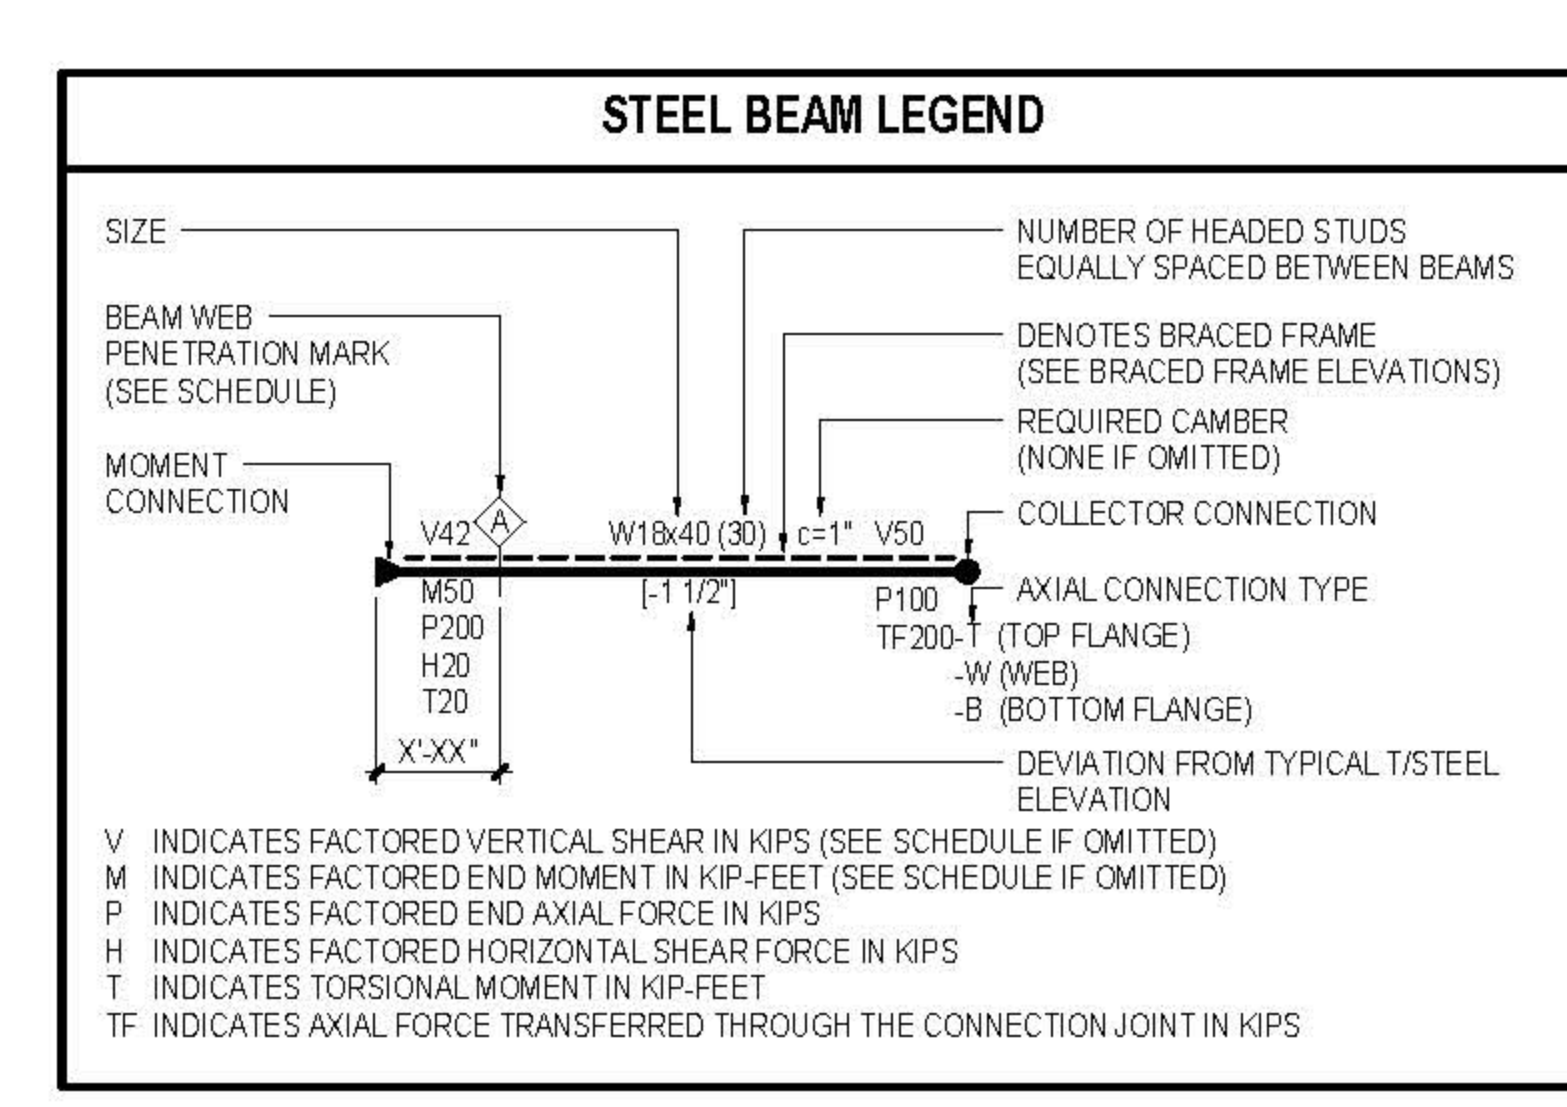

COMPOSITE STEEL DECK SCHEDULE					
SLAB MARK	TOTAL SLAB THICKNESS AND CONCRETE TYPE	STEEL DECK (MIN)	CONCRETE TOPPING SLAB	SLAB REINFORCEMENT	NOTES
S1	5 1/2" NWC	3'-8" GA		6 x 6 - W4.0 x W4.0 WWR	
S2	7 1/2" NWC	3'-8" GA		4 x 4 - W4.0 x W4.0 WWR	
S3	9" NWC	3'-8" GA		4 x 4 - W4.0 x W4.0 WWR EACH WAY	
S4	4" NWC	1 1/2" - 18 GA		4 x 4 - W4.0 x W4.0 WWR	
S5	8 1/2" NWC	3'-8" GA		4 x 4 - W4.0 x W4.0 WWR	N.S. BARS COORDINATED TO EXISTING SLAB

CULTURE SHED

540 West 30th Street
New York, New York 10001

OWNER
CULTURE SHED INC.

ARCHITECTS
Oller Scaletta + Renfro Architects, DPC
601 West 26 Street #815
New York, New York 10001
T: 212.463.0334
F: 212.463.0335

rackwellgroup
5 Union St, West, 6th Flr
New York, New York 10003
T: 212.463.0334
F: 212.463.0335

STRUCTURAL ENGINEER
Thornton Tomasetti
51 Madison Avenue
New York, New York 10010
T: 917.661.7800
F: 917.661.7801

MEP ENGINEER
Jara Baum & Bolles
60 Pine Street
New York, New York 10005
T: 212.530.9300
F: 212.266.6944

FAÇADE CONSULTANT
Thornton Tomasetti
51 Madison Avenue
New York, New York 10010
T: 917.661.7800
F: 917.661.7801

KINETICS ENGINEER
Hardess & Hanover
1501 Broadway
New York, New York 10036
T: 212.944.1150
F: 212.391.0397

LIGHTING DESIGNER
Tilston Design Associates
40 North Street #160
New York, New York 10013
T: 212.675.7760

THEATRE PLANNING & DESIGN
Fisher Dodge Associates
22 West 15th Street
New York, New York 10011
T: 212.691.3000

LIFE SAFETY
Code Consultants, Inc.
215 West 43rd St, 15th Flr
New York, New York 10018
T: 212.216.9596

ENERGY MODEL/LEED
Vindian
60 Washington Street
Norwalk, CT 06854
T: 203.298.1411

ACOUSTIC/AUDIO-VISUAL
Avenelle
93 North Main Street
South Norwalk, CT 06854
T: 347.210.5540

VERTICAL TRANSPORTATION
Van Duusen & Associates
5 Regent Street, Suite 524
Larchmont, NJ 07038
T: 973.994.9220

SPECIFICATIONS
Construction Specifications Inc.
PO Box 489
227 Fenwick Road
Morganville, NJ 07751
T: 732.970.0700
F: 732.970.0700


SECURITY
Duchella Venter & Santoro
1100 Sherman Avenue
Hartford, CT 06114
T: 203.286.6490

WATERPROOFING
James R. Gahfort AIA Consulting Architects PC
104 West 27th Street
New York, NY 10001
T: 212.736.3344

FAÇADE MAINTENANCE
Frank Engineering PLLC
162 Area Street
New York, NY 10005
T: 212.698.3000

BRANDING/GRAPHICS
204 Global Design Consultancy
180 Varck Street 15th Floor
New York, NY 10014
T: 212.647.1170

KEY PLAN

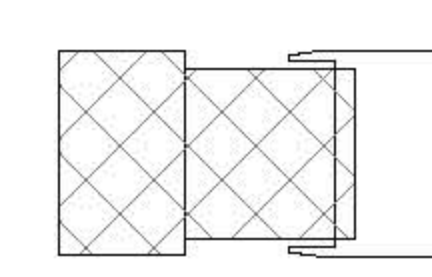

ISSUE PRINTING DATE

01	50	DOB AMENDMENT 7	08.19.2016
02	26	REV #011	02.12.2016
03		CONSTRUCTION SET	10.09.2016
11	6	ADV. PROCUREMENT ADDENDUM 6	04.10.2016
10	4	100% CONSTRUCTION DOCUMENTS	03.18.2016
9		90% CONSTRUCTION DOCUMENTS	02.16.2016
6		PRELIMINARY JOB SUBMISSION	12.10.2014
1		ADVANCED PROCUREMENT BID SET	06.16.2014

STAMP



DRAWN BY
Autumn

CHECKED BY
Chris

PROJECT NUMBER
N11318.00


TITLE
FRAMING PLAN, FIXED BUILDING SLED DRIVE AND BMU TRACK

DRAWING NO.
S-110.01

B-SCAN NO.
S-110.01

29 of 123


© COPYRIGHT 2016 BY ENGINEER Damian Titus, P.E. ALL RIGHTS RESERVED. NO PART OF THIS DOCUMENT MAY BE REPRODUCED OR TRANSMITTED IN ANY FORM OR BY ANY MEANS, ELECTRONIC OR MECHANICAL, WITHOUT PERMISSION IN WRITING FROM THE ENGINEER.

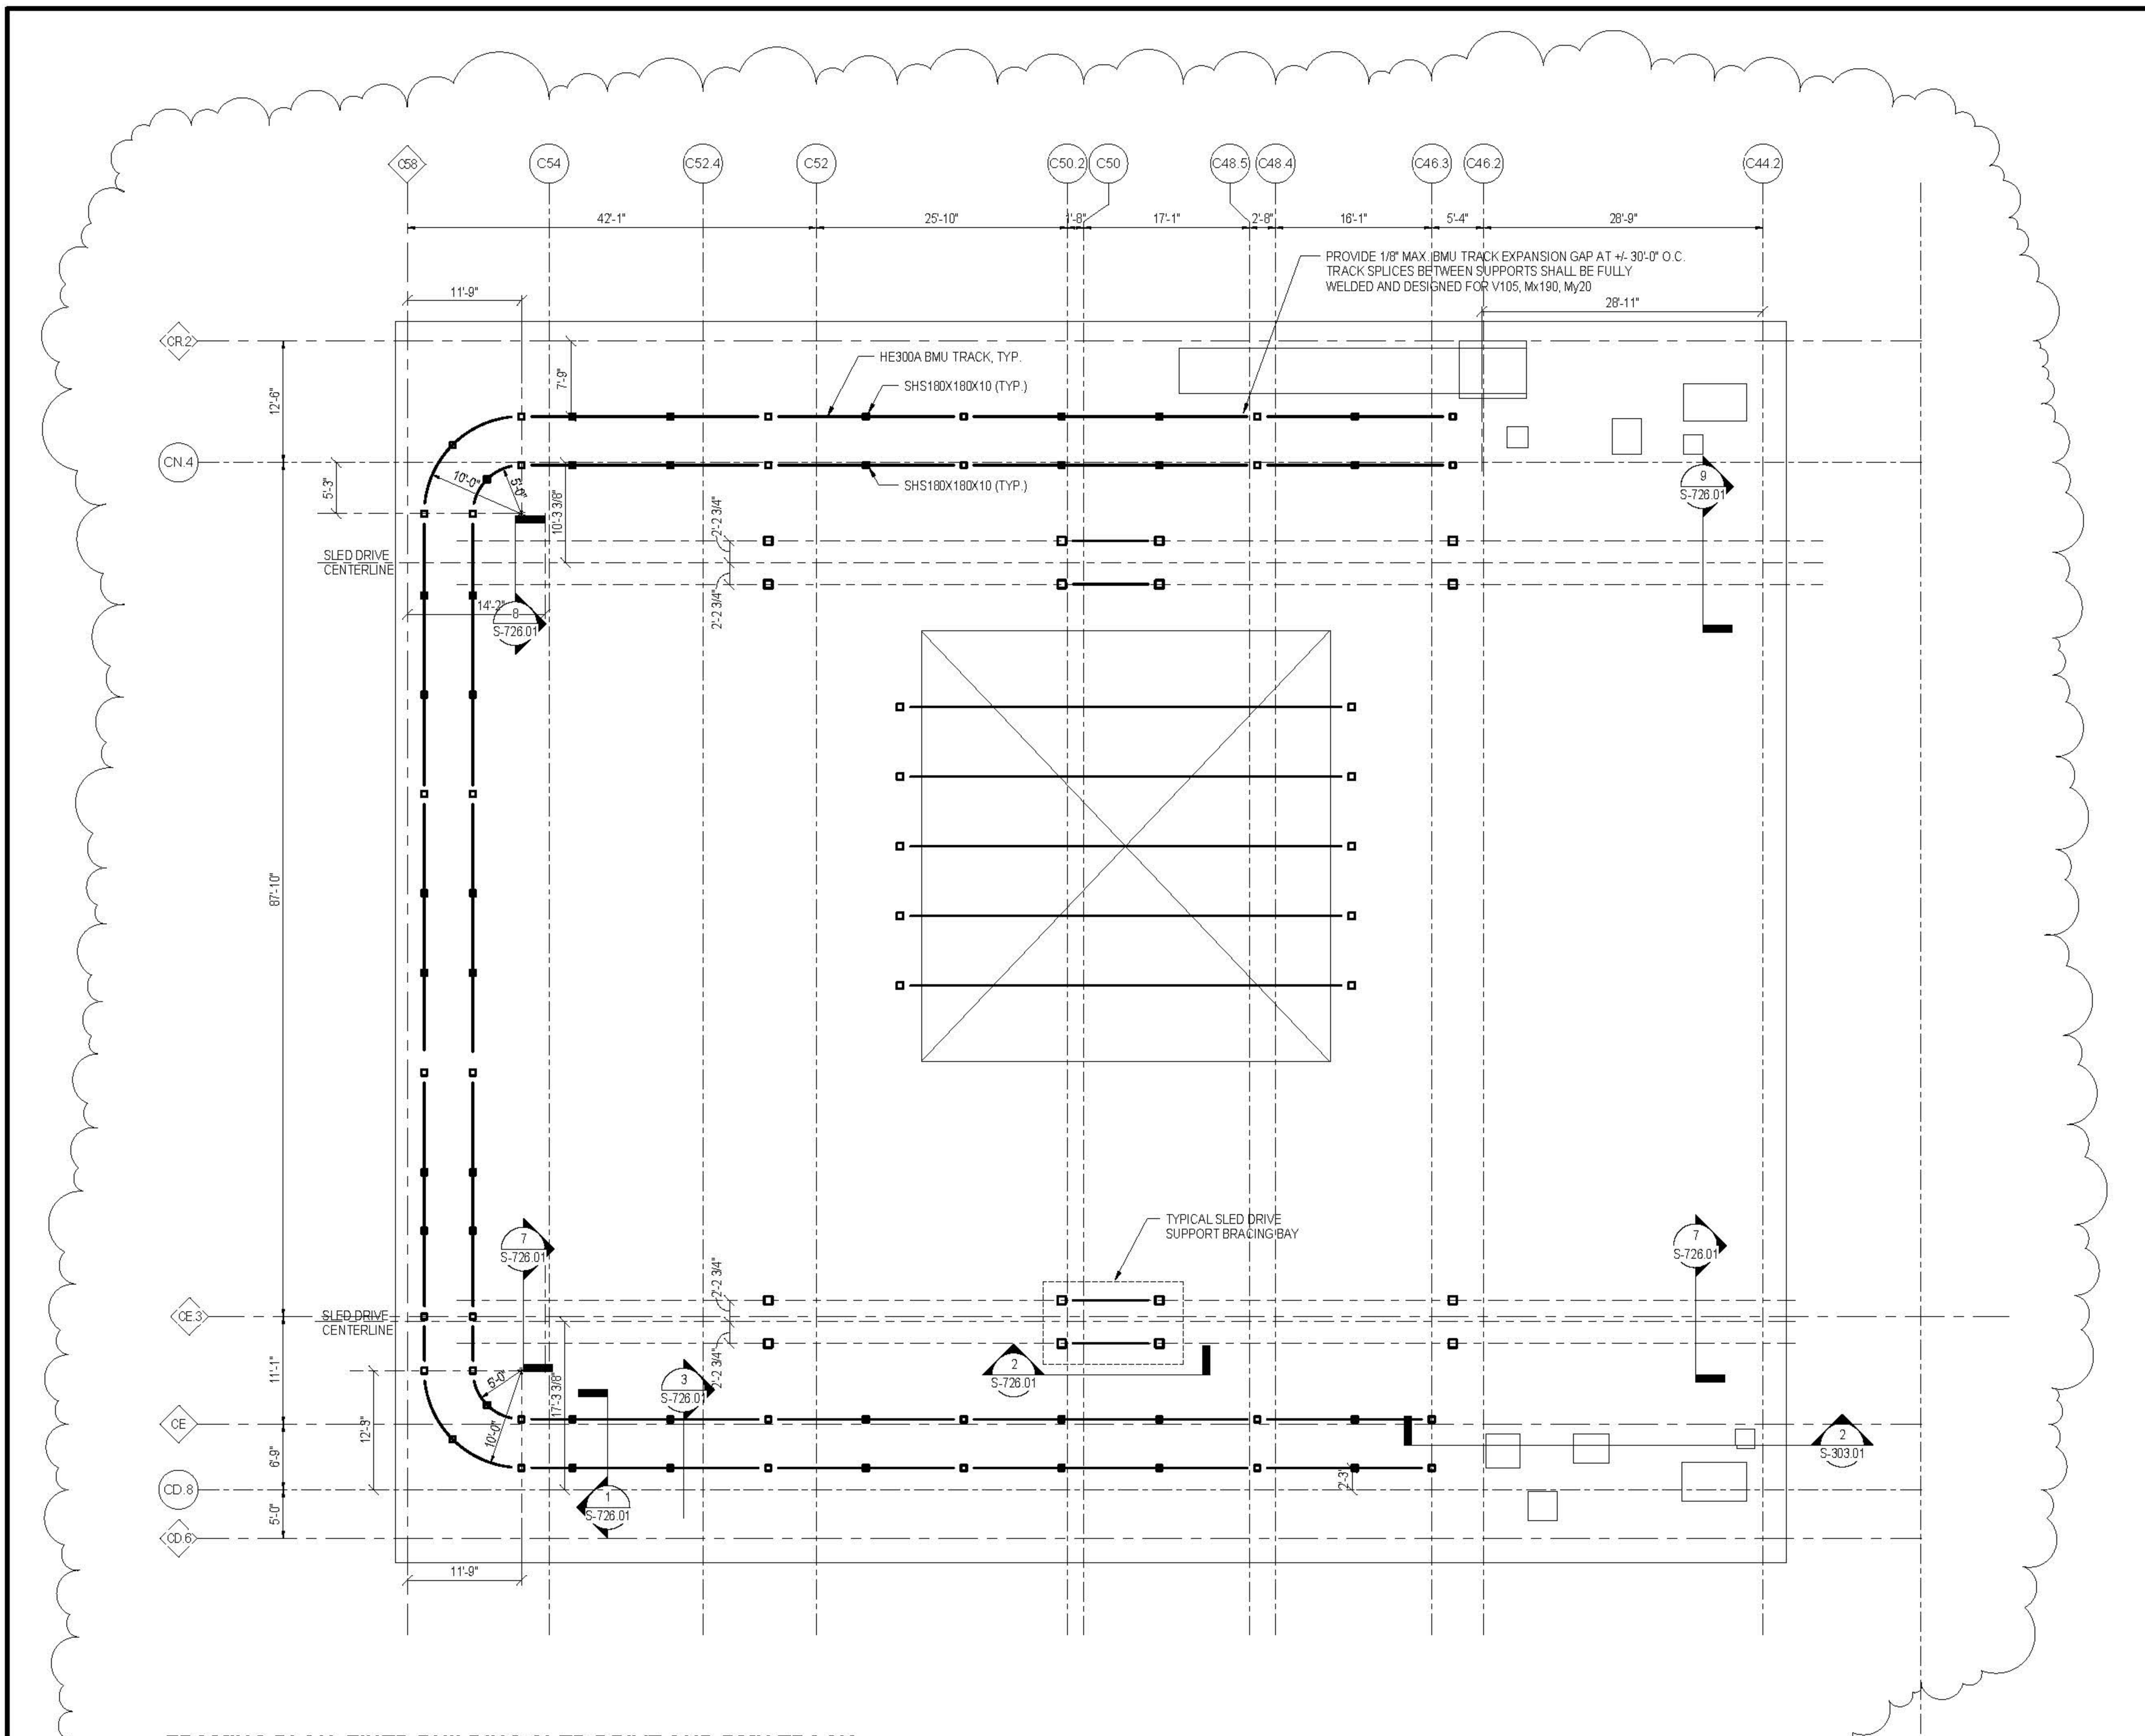

1 FRAMING PLAN, FIXED BUILDING SLED DRIVE AND BMU TRACK
1/8" = 1'-0"

- SHEET NOTES:**
- T/STRUCTURAL SLAB EL. N/A
 - T/STEEL BMU RAIL EL. 145'-2 1/4"
 - T/STEEL SLED DRIVE SUPPORTS 144'-3" UNO
 - FOR ADDITIONAL INFORMATION REFER TO THE FOLLOWING DRAWINGS:
DRAWING LISTS, GENERAL NOTES, AND LOADING DIAGRAMS S-000 SERIES DRAWINGS
LATERAL SYSTEM ELEVATIONS, CONNECTION FORCES, AND DETAILS S-300 SERIES DRAWINGS
STEEL SUPERSTRUCTURE SCHEDULES AND DETAILS S-700 SERIES DRAWINGS
STEEL COLUMN SCHEDULES AND DETAILS S-900 SERIES DRAWINGS
 - AT STAIRS, SEE TYPICAL DETAILS FOR TC, TCS, AND KICKER REQUIREMENTS 1, 2 & 3S-704
 - REFER TO ARCH DWGS FOR LOCATION AND SIZE OF OPENINGS

- 7. SYMBOLS:**
- INDICATES MOMENT CONNECTION
 - INDICATES DEEP BEAM BOTTOM FLANGE BRACING CONNECTION SEE DETAIL 9S-703
 - INDICATES FULL HEIGHT FITTED STIFFENER CONNECTION SEE DETAIL 4S-703
 - INDICATES FULL HEIGHT UNFITTED STIFFENER CONNECTION SEE DETAIL 9S-703
 - INDICATES KICKER AT SPANDREL BEAM CONNECTION SEE DETAIL 3S-703
 - INDICATES SLOPE IN TOP OF SLAB
- 8. NOTATIONS:**
- BF INDICATES LATERAL BRACED FRAME SEE BRACED FRAME ELEVATIONS FOR BEAM INFORMATION AND CONNECTION FORCES
 - CA/CB INDICATES COLUMN ABOVE/BELOW, COMPRESSION AXIAL FORCE IN COLUMN INDICATED WHERE APPLICABLE. SEE DETAIL 1S-702 & 2S-702
 - CBXX INDICATES CASTELLATED BEAM. SEE SCHEDULE 1S-402
 - DS INDICATES HSS/SHS/KB/36 ELEVATOR DIVIDER BEAM (NOT FIREPROOFED) INDICATED WHERE APPLICABLE. SEE DETAIL 3S-702
 - HA/HB INDICATES HANGER ABOVE/BELOW, TENSION AXIAL FORCE IN HANGER BELOW INDICATED WHERE APPLICABLE. SEE DETAIL 3S-702
 - MF INDICATES LATERAL MOMENT FRAME SEE MOMENT FRAME ELEVATIONS FOR BEAM INFORMATION AND CONNECTION FORCES
 - PGXX INDICATES PLATE GIRDER TYPE. SEE S-703 FOR PLATE GIRDER SCHEDULE
 - PGXX/T INDICATES TAPERED PLATE GIRDER. SEE DETAIL 3S-704
 - TC INDICATES TORSIONAL CONNECTION FOR STAIR. SEE DETAIL 1S-704
 - TR INDICATES COLUMN FROM ABOVE TRANSFERS, COMPRESSION AXIAL FORCE IN COLUMN INDICATED WHERE APPLICABLE. SEE DETAIL 1S-702

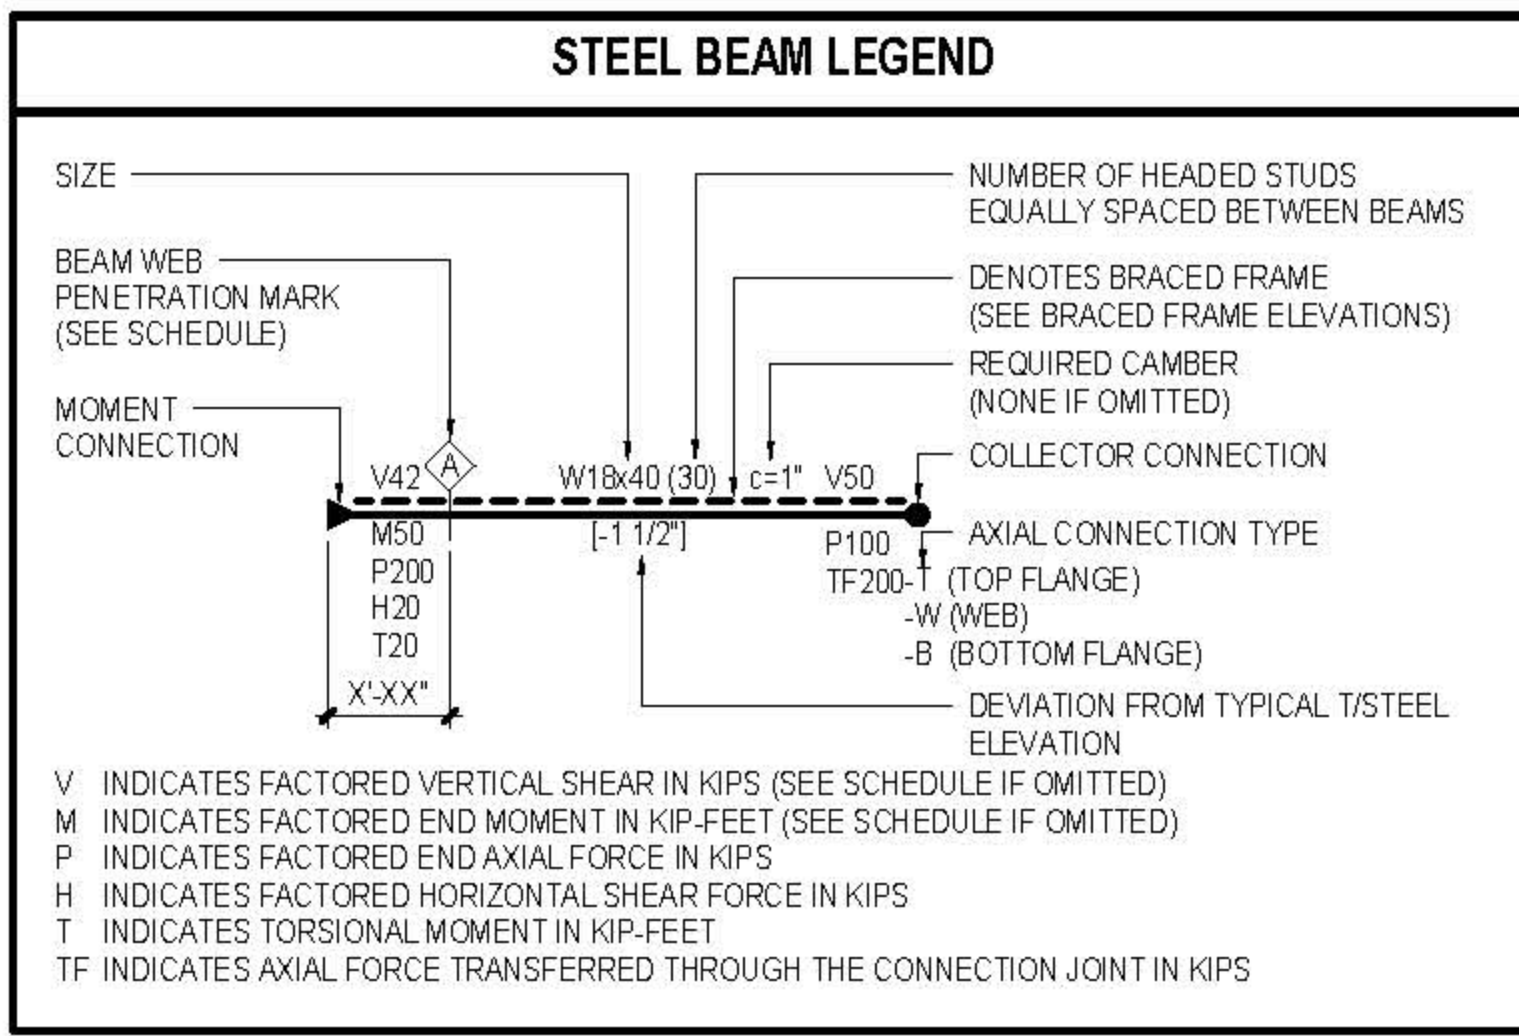

SLAB MARK	TOTAL SLAB THICKNESS AND CONCRETE TYPE	STEEL DECK (MIN)	CONCRETE TOPPING SLAB	SLAB REINFORCEMENT	NOTES
S1	5 1/2" NWC	3'-18 GA		6 x 6 - W4.0 x W4.0 WWR	
S2	7 1/2" NWC	3'-18 GA		4 x 4 - W4.0 x W4.0 WWR	
S3	8" NWC	3'-18 GA			
S4	4" NWC	1 1/2" - 18 GA			
S5	8 1/2" NWC	3'-18 GA		#4 @ 12" O.C. N-S #4 @ 18" O.C. E-W	N-S BARS COORDINATED TO MECHANICAL COUPLERS IN EXISTING SLAB

CULTURE SHED
545 West 30th Street
New York, New York 10001
OWNER: CULTURE SHED INC.

ARCHITECTS
Oller Scaffida + Renfro Architects, PC
601 West 26th Street #815
New York, New York 10001
T: 212.260.7971

rockwellgroup
5 Union St. West, 6th Fl.
New York, New York 10003
T: 212.463.0334
F: 212.463.0335

STRUCTURAL ENGINEER
Thornton Tomasetti
51 Madison Avenue
New York, New York 10010
T: 917.861.7800
F: 917.861.7801

MEP ENGINEER
Jana Baum & Bolles
60 Pine Street
New York, New York 10005
T: 212.530.9300
F: 212.260.6584

FACADE CONSULTANT
Thornton Tomasetti
51 Madison Avenue
New York, New York 10010
T: 917.861.7800
F: 917.861.7801

KINETICS ENGINEER
Hardess & Hanover
1501 Broadway
New York, New York 10036
T: 212.391.1150
F: 212.391.0337

LIGHTING DESIGNER
Tilston Design Associates
40 North Street #1650
New York, New York 10013
T: 212.675.7760

THEATRE PLANNING & DESIGN
Fisher Dodge Associates
22 West 19th Street
New York, New York 10011
T: 212.691.3000

LIFE SAFETY
Code Consultants, Inc.
215 West 43rd St, 15th Fl.
New York, New York 10018
T: 212.216.9596

ENERGY MODEL/LEED
Vindian
60 Washington Street
Norwalk, CT 06854
T: 203.298.1411

ACOUSTIC/AUDIO-VISUAL
Avenille
93 North Main Street
South Norwalk, CT 06854
T: 347.210.5540

VERTICAL TRANSPORTATION
Van Dusen & Associates
5 Regent Street, Suite 624
Livingston, NJ 07039
T: 973.994.9220

SECIFICATIONS
Construction Specifications Inc.
PO Box 489
22 Tannock Road
Morganville, NJ 07751
T: 732.970.0700
F: 732.970.0700


SECURITY
Duchella Venter & Santoro
1100 Sherman Avenue
Hartford, CT 06114
T: 203.286.6490

WATERPROOFING
James R. Gahfort AIA Consulting Architects PC
104 West 27th Street
New York, NY 10001
T: 212.736.3344


FACADE MAINTENANCE
Erick Engineering PLLC
162 Ave. Street
New York, NY 10005
T: 212.698.3000

BRANDING GRAPHICS
24th Global Design Consultancy
180 Varck Street 15th Floor
New York, NY 10014
T: 212.647.1170

GEOMETRY, DIMENSIONS AND SURFACE CONTOURING, BLENDING AND INTERSECTION OF SECTIONS ILLUSTRATED IN THE STRUCTURAL DRAWINGS ARE PROVIDED FOR REFERENCE AND GENERATION OF STRUCTURAL ARRANGEMENT AND DETAILS ONLY. THE 3D MODEL ISSUED BY THE ARCHITECT DEFINES THE EXTERIOR SURFACE AND SHALL BE ADHERED TO FOR THE FINAL GEOMETRY. FOR DETAILS OF SECONDARY STEEL, INCLUDING STRUCTURAL CLADDING REFER TO ARCHITECTURE DRAWINGS. IT IS THE RESPONSIBILITY OF THE CONTRACTOR TO IDENTIFY ANY DISCREPANCIES OR AMBIGUITIES FOR DISCUSSION, RESOLUTION AND DIRECTION FROM THE ARCHITECT AND SER.

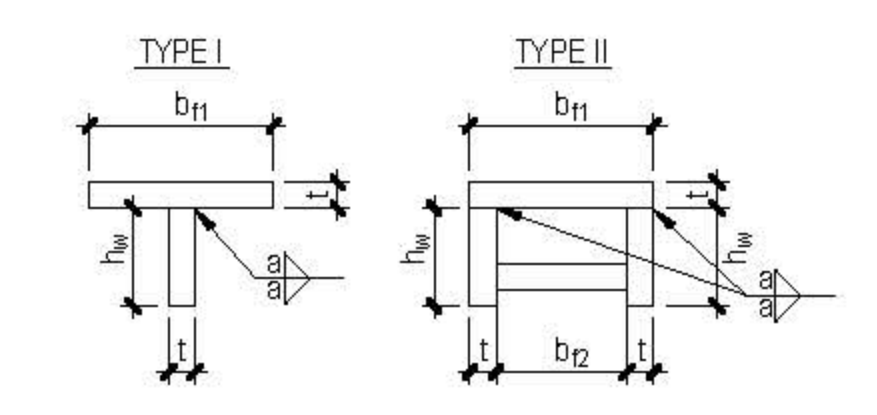



SECTION	b ₁	b ₂	h ₁	t	s
TYPE I T-A	8'-5 7/8"		11'-3 3/4"	7/8"	5/16"
TYPE I T-B	5'-7 7/8"		8'-5 7/8"	7/16"	5/16"
TYPE II RHS-A	15'-3 3/4"	14'-7 3/32"	11'-13 1/16"	3/4"	3/8" P.P.P. ONE SIDE

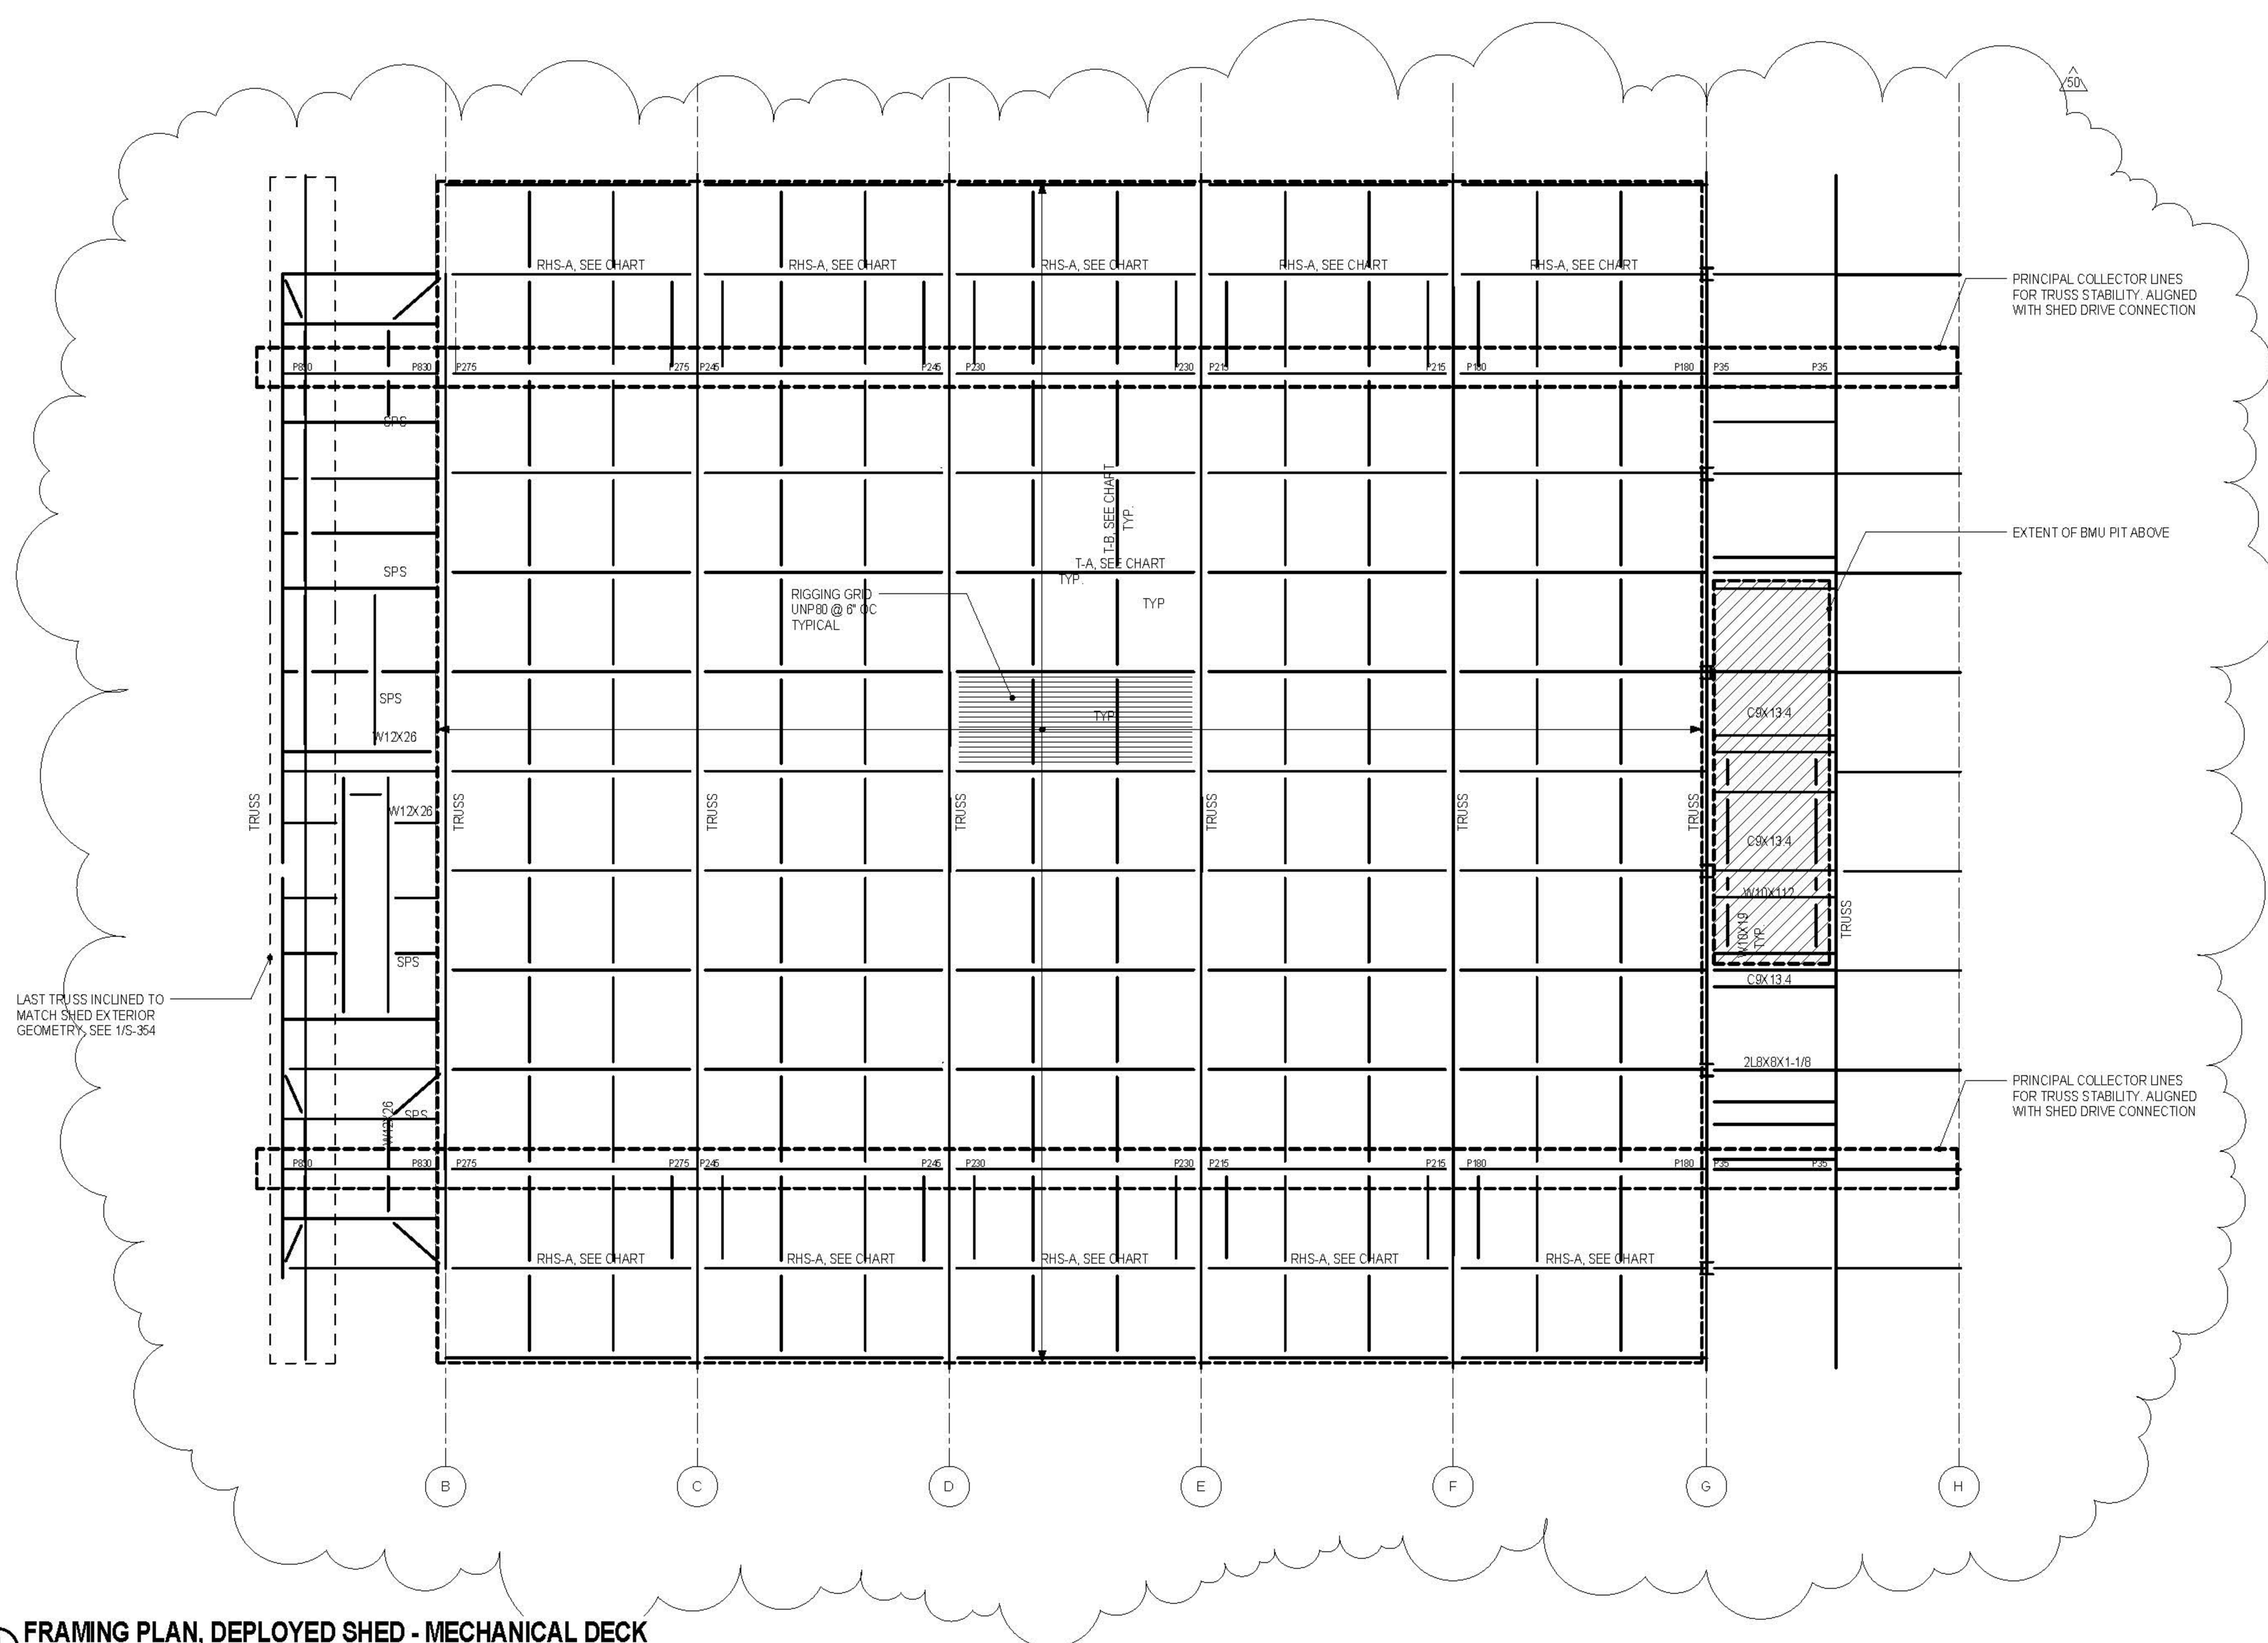

1 FRAMING PLAN, DEPLOYED SHED - MECHANICAL DECK
1/8" = 1'-0"

SPS, OR SIMILAR APPROVED, DECK SYSTEM TO SPAN BETWEEN THE STEEL FRAMING AS INDICATED. DECK SYSTEM TO BE NO GREATER THAN 33 MM THICK, PROVIDE A 2-HOUR FIRE RATING AND SUPPORT A LIVE LOAD OF 50 P.S.F. (UNFACTORED) AND SATISFY DEFLECTION CRITERIA OF L/360 FOR DESIGN PURPOSES. SPS PANEL 425-4 WAS ADOPTED. SUBJECT TO APPROVAL BY AOR AND EOR.

REFER TO ARCHITECTURAL MODEL AND DRAWINGS. PENDING COORDINATION DURING DESIGN ASSIST.

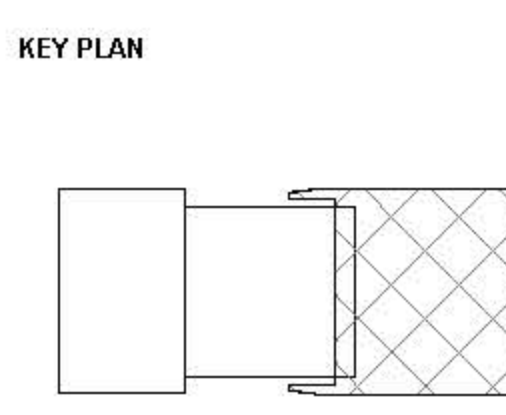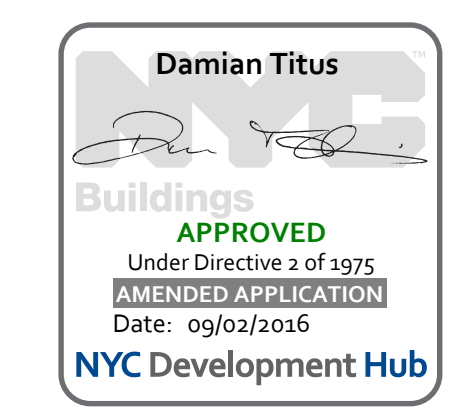

ISSUE △ PRINTING DATE

63	60	DOB AMENDMENT 7	03.19.2016
44	30	DOB AMENDMENT 6	04.09.2016
21		CONSTRUCTION SET	10.08.2015
10	4	100% CONSTRUCTION DOCUMENTS	03.18.2015
9		90% CONSTRUCTION DOCUMENTS	02.16.2015
6		PRELIMINARY JOB SUBMISSION	12.10.2014
1		ADVANCED PROCUREMENT BID SET	06.16.2014



DRAWN BY: Audrey
CHECKED BY: Chris
PROJECT NUMBER: N11318.00

TITLE: FRAMING PLAN, DEPLOYED SHED - MECHANICAL DECK

DRAWING NO.: S-152.01

B.SCAN NO.: S-152.01

CULTURE SHED

545 West 30th Street
New York, New York 10001

OWNER
CULTURE SHED INC

ARCHITECTS
Oller Scaletta + Renfro Architects, PC
601 West 30th Street #815
New York, New York 10001
T: 212.463.0334
F: 212.463.0335

STRUCTURAL ENGINEER
Thornton Tomasetti
51 Madison Avenue
New York, New York 10010
T: 917.861.7800
F: 917.861.7801

MEP ENGINEER
Jans Baum & Bolles
63 Park Street
New York, New York 10005
T: 212.530.9300
F: 212.265.6564

FACADE CONSULTANT
Thornton Tomasetti
51 Madison Avenue
New York, New York 10010
T: 917.861.7800
F: 917.861.7801

KINETICS ENGINEER
Hardesky & Hanover
1501 Broadway
New York, New York 10036
T: 212.944.1150
F: 212.391.0297

LIGHTING DESIGNER
Tilston Design Associates
40 North Street #150
New York, New York 10013
T: 212.675.7760

THEATRE PLANNING & DESIGN
Fisher Dodge Associates
22 West 15th Street
New York, New York 10011
T: 212.691.3000

LIFE SAFETY
Code Consultants, Inc.
215 West 43rd St, 15th Fl
New York, New York 10018
T: 212.216.9596

ENERGY MODEL/LEED
Vindian
50 Washington Street
Norwalk, CT 06854
T: 203.298.1411

ACOUSTIC/AUDIO-VISUAL
Avenille
50 North Main Street
South Norwalk, CT 06854
T: 347.210.5540

VERTICAL TRANSPORTATION
Van Duusen & Associates
5 Regent Street, Suite 524
Larchmont, NJ 07038
T: 973.994.9220

SPECIFICATIONS
Construction Specifications Inc.
PO Box 489
227 Tenthill Road
Morganville, NJ 07751
T: 732.970.0700
F: 732.970.0700

SECURITY
Duchella Venter & Santoro
1100 Sherman Avenue
Hartford, CT 06114
T: 203.286.6490


WATERPROOFING
James R. Galford AIA Consulting Architects PC
104 West 27th Street
New York, NY 10001
T: 212.736.3344

FACADE MAINTENANCE
Erick Engineering PLLC
106 Avenue Street
New York, NY 10005
T: 212.698.3000

BRANDING GRAPHICS
2nd Global Design Consultancy
180 Varck Street 15th Floor
New York, NY 10014
T: 212.647.1170


GEOMETRY, DIMENSIONS AND SURFACE CONTOURING, BLENDING AND INTERSECTION OF SECTIONS ILLUSTRATED IN THE STRUCTURAL DRAWINGS ARE PROVIDED FOR REFERENCE AND GENERATION OF STRUCTURAL ARRANGEMENT AND DETAILS ONLY. THE 3D MODEL ISSUED BY THE ARCHITECT, DEFINES THE EXTERIOR SURFACE AND SHALL BE ADHERED TO FOR THE FINAL GEOMETRY. FOR DETAILS OF SECONDARY STEEL, INCLUDING STRUCTURAL CLADDING REFER TO ARCHITECTURE DRAWINGS. IT IS THE RESPONSIBILITY OF THE CONTRACTOR TO IDENTIFY ANY DISCREPANCIES OR AMBIGUITIES FOR DISCUSSION, RESOLUTION AND DIRECTION FROM THE ARCHITECT AND SER.

NOTES
1. CONTRACTOR MAY PROPOSE, SUBJECT TO AGREEMENT WITH ARCHITECT AND SER, TO STANDARDIZE SECTION DESIGNATIONS.
2. WHERE W4X30S ARE SHOWN IT IS ANTICIPATED CONNECTIONS WILL BE SHOP WELDED TO CREATE A TRANSPORTABLE FRAME. A BOLTED CONNECTION MAY BE PROPOSED AND REQUIRE A HEAVIER SECTION

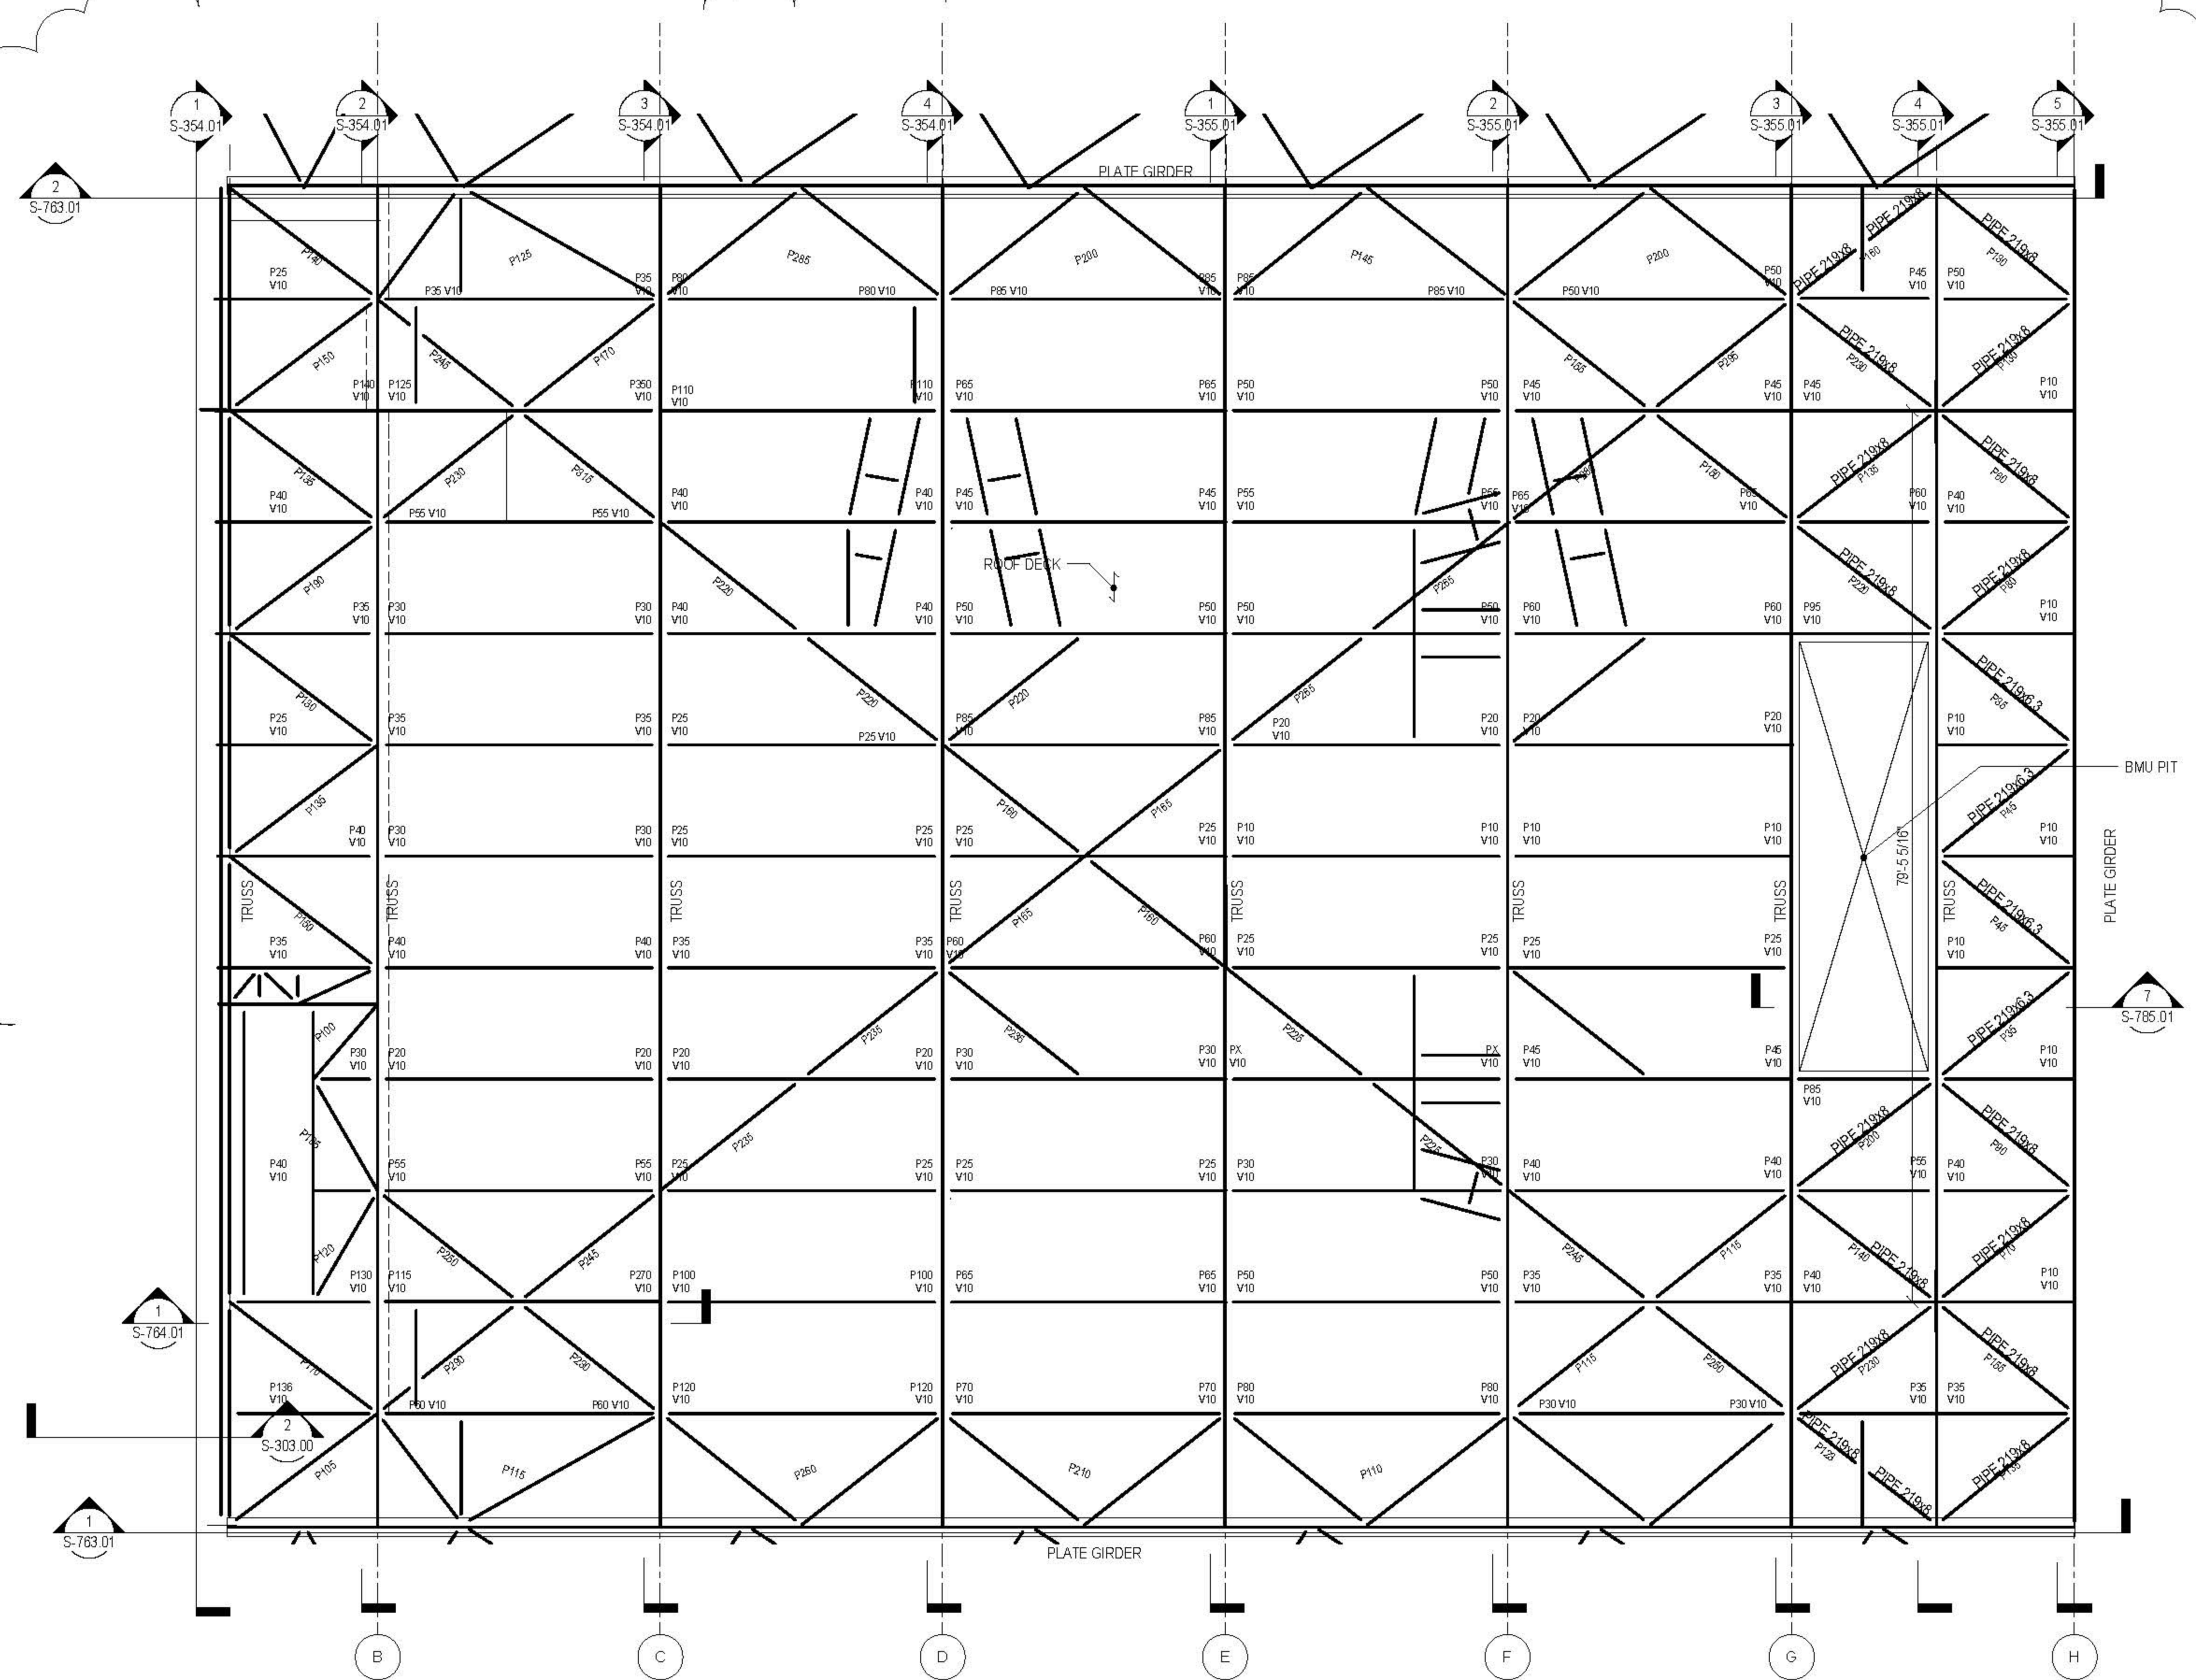

1 FRAMING PLAN, DEPLOYED SHED - ROOF
1/8" = 1'-0"

KEY PLAN

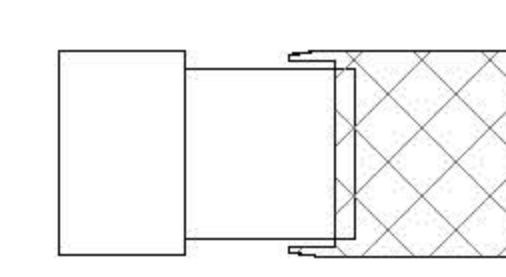

ISSUE PRINTING DATE


ISSUE	PRINTING	DATE	
63	60	DOB AMENDMENT 7	03.19.2016
44	30	DOB AMENDMENT 6	04.09.2016
21		CONSTRUCTION SET	10.08.2015
10	4	100% CONSTRUCTION DOCUMENTS	03.18.2015
9		90% CONSTRUCTION DOCUMENTS	02.16.2015
6		PRELIMINARY DOB SUBMISSION	12.16.2014
1		ADVANCED PROCUREMENT BID SET	06.16.2014



DRAWN BY
Autism

CHECKED BY
Chris M

PROJECT NUMBER
N1318.00

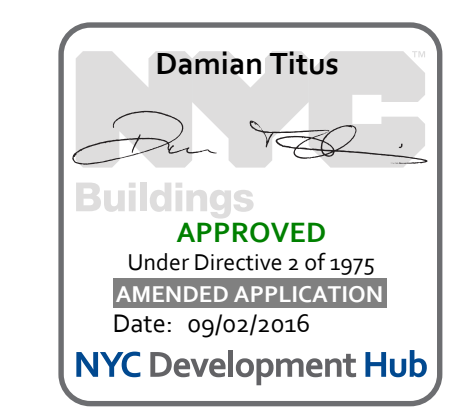

DATE: 06/16/2014
APPROVED
Under Directive 1 of 1975
NYC Development Hub

TITLE
FRAMING PLAN, DEPLOYED SHED - ROOF

DRAWING NO.
S-153.01

B.SCAN NO.
S-153.01

NOTES: SHED SHOWN IN FULLY DEPLOYED POSITION
REFER TO ARCHITECTURAL MODEL AND DRAWINGS.
PENDING COORDINATION DURING DESIGN ASSIST.

CULTURE SHED
545 West 30th Street
New York, New York 10001

OWNER
CULTURE SHED INC

ARCHITECTS
Oller Scaletto + Renfro Architects, DPC
601 West 26 Street #815
New York, New York 10001
T: 212.263.7971

STRUCTURAL ENGINEER
Thornton Tomasetti
51 Madison Avenue
New York, New York 10010
T: 917.981.7800
F: 917.981.7801

MEP ENGINEER
Jana Baum & Bolles
83 Pine Street
New York, New York 10005
T: 212.535.9300
F: 212.265.6564

FACADE CONSULTANT
Thornton Tomasetti
51 Madison Avenue
New York, New York 10010
T: 917.981.7800
F: 917.981.7801

KINETICS ENGINEER
Hardesky & Hanover
1501 Broadway
New York, New York 10036
T: 212.944.1150
F: 212.391.0337

LIGHTING DESIGNER
Tilston Design Associates
40 North Street #1650
New York, New York 10013
T: 212.675.7760

THEATRE PLANNING & DESIGN
Fisher Dodge Associates
22 West 15th Street
New York, New York 10011
T: 212.691.3000

LIFE SAFETY
Code Consultants, Inc.
215 West 40th St, 15th Fl
New York, New York 10018
T: 212.216.9596

ENERGY MODEL/LEED
Vindian
53 Washington Street
Norwalk, CT 06854
T: 203.298.1411

ACOUSTIC/AUDIO-VISUAL
Avenille
93 North Main Street
South Norwalk, CT 06854
T: 347.210.5540

VERTICAL TRANSPORTATION
Van Duusen & Associates
5 Regent Street, Suite 524
Larkington, NJ 07038
T: 973.994.9220

SPECIFICATIONS
Construction Specifications Inc.
PO Box 489
227 Tenth Road
Morganville, NJ 07751
T: 732.970.0700
F: 732.970.0700


SECURITY
Duchella Venter & Santoro
1100 Sherman Avenue
Hartford, CT 06114
T: 203.286.6490

WATERPROOFING
James R. Gahfort AIA Consulting Architects PC
104 West 27th Street
New York, NY 10001
T: 212.736.3344


FACADE MAINTENANCE
Erick Engineering PLLC
166 Ave. Street
New York, NY 10005
T: 212.698.3000

BRANDING GRAPHICS
2nd Global Design Consultancy
180 Varck Street 15th Floor
New York, NY 10014
T: 212.647.1170

GEOMETRY, DIMENSIONS AND SURFACE CONTOURING, BLENDING AND INTERSECTION OF SECTIONS ILLUSTRATED IN THE STRUCTURAL DRAWINGS ARE PROVIDED FOR REFERENCE AND GENERATION OF STRUCTURAL ARRANGEMENT AND DETAILS ONLY. THE 3D MODEL ISSUED BY THE ARCHITECT DEFINES THE EXTERIOR SURFACE AND SHALL BE ADHERED TO FOR THE FINAL GEOMETRY. FOR DETAILS OF SECONDARY STEEL, INCLUDING STRUCTURAL CLADDING REFER TO ARCHITECTURE DRAWINGS. IT IS THE RESPONSIBILITY OF THE CONTRACTOR TO IDENTIFY ANY DISCREPANCIES OR AMBIGUITIES FOR DISCUSSION, RESOLUTION AND DIRECTION FROM THE ARCHITECT AND SER.

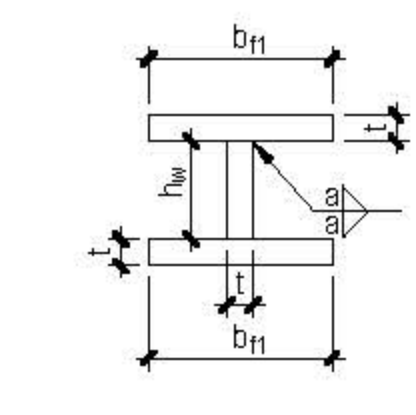


SECTION	b1	b2	t1	t2	s
R1	10'15/64"	10'15/64"	7'-7/8"	1/2"	1'-3/16"
R2	7'-3/16"	7'-3/16"	16'-17/32"	3/8"	3/16"

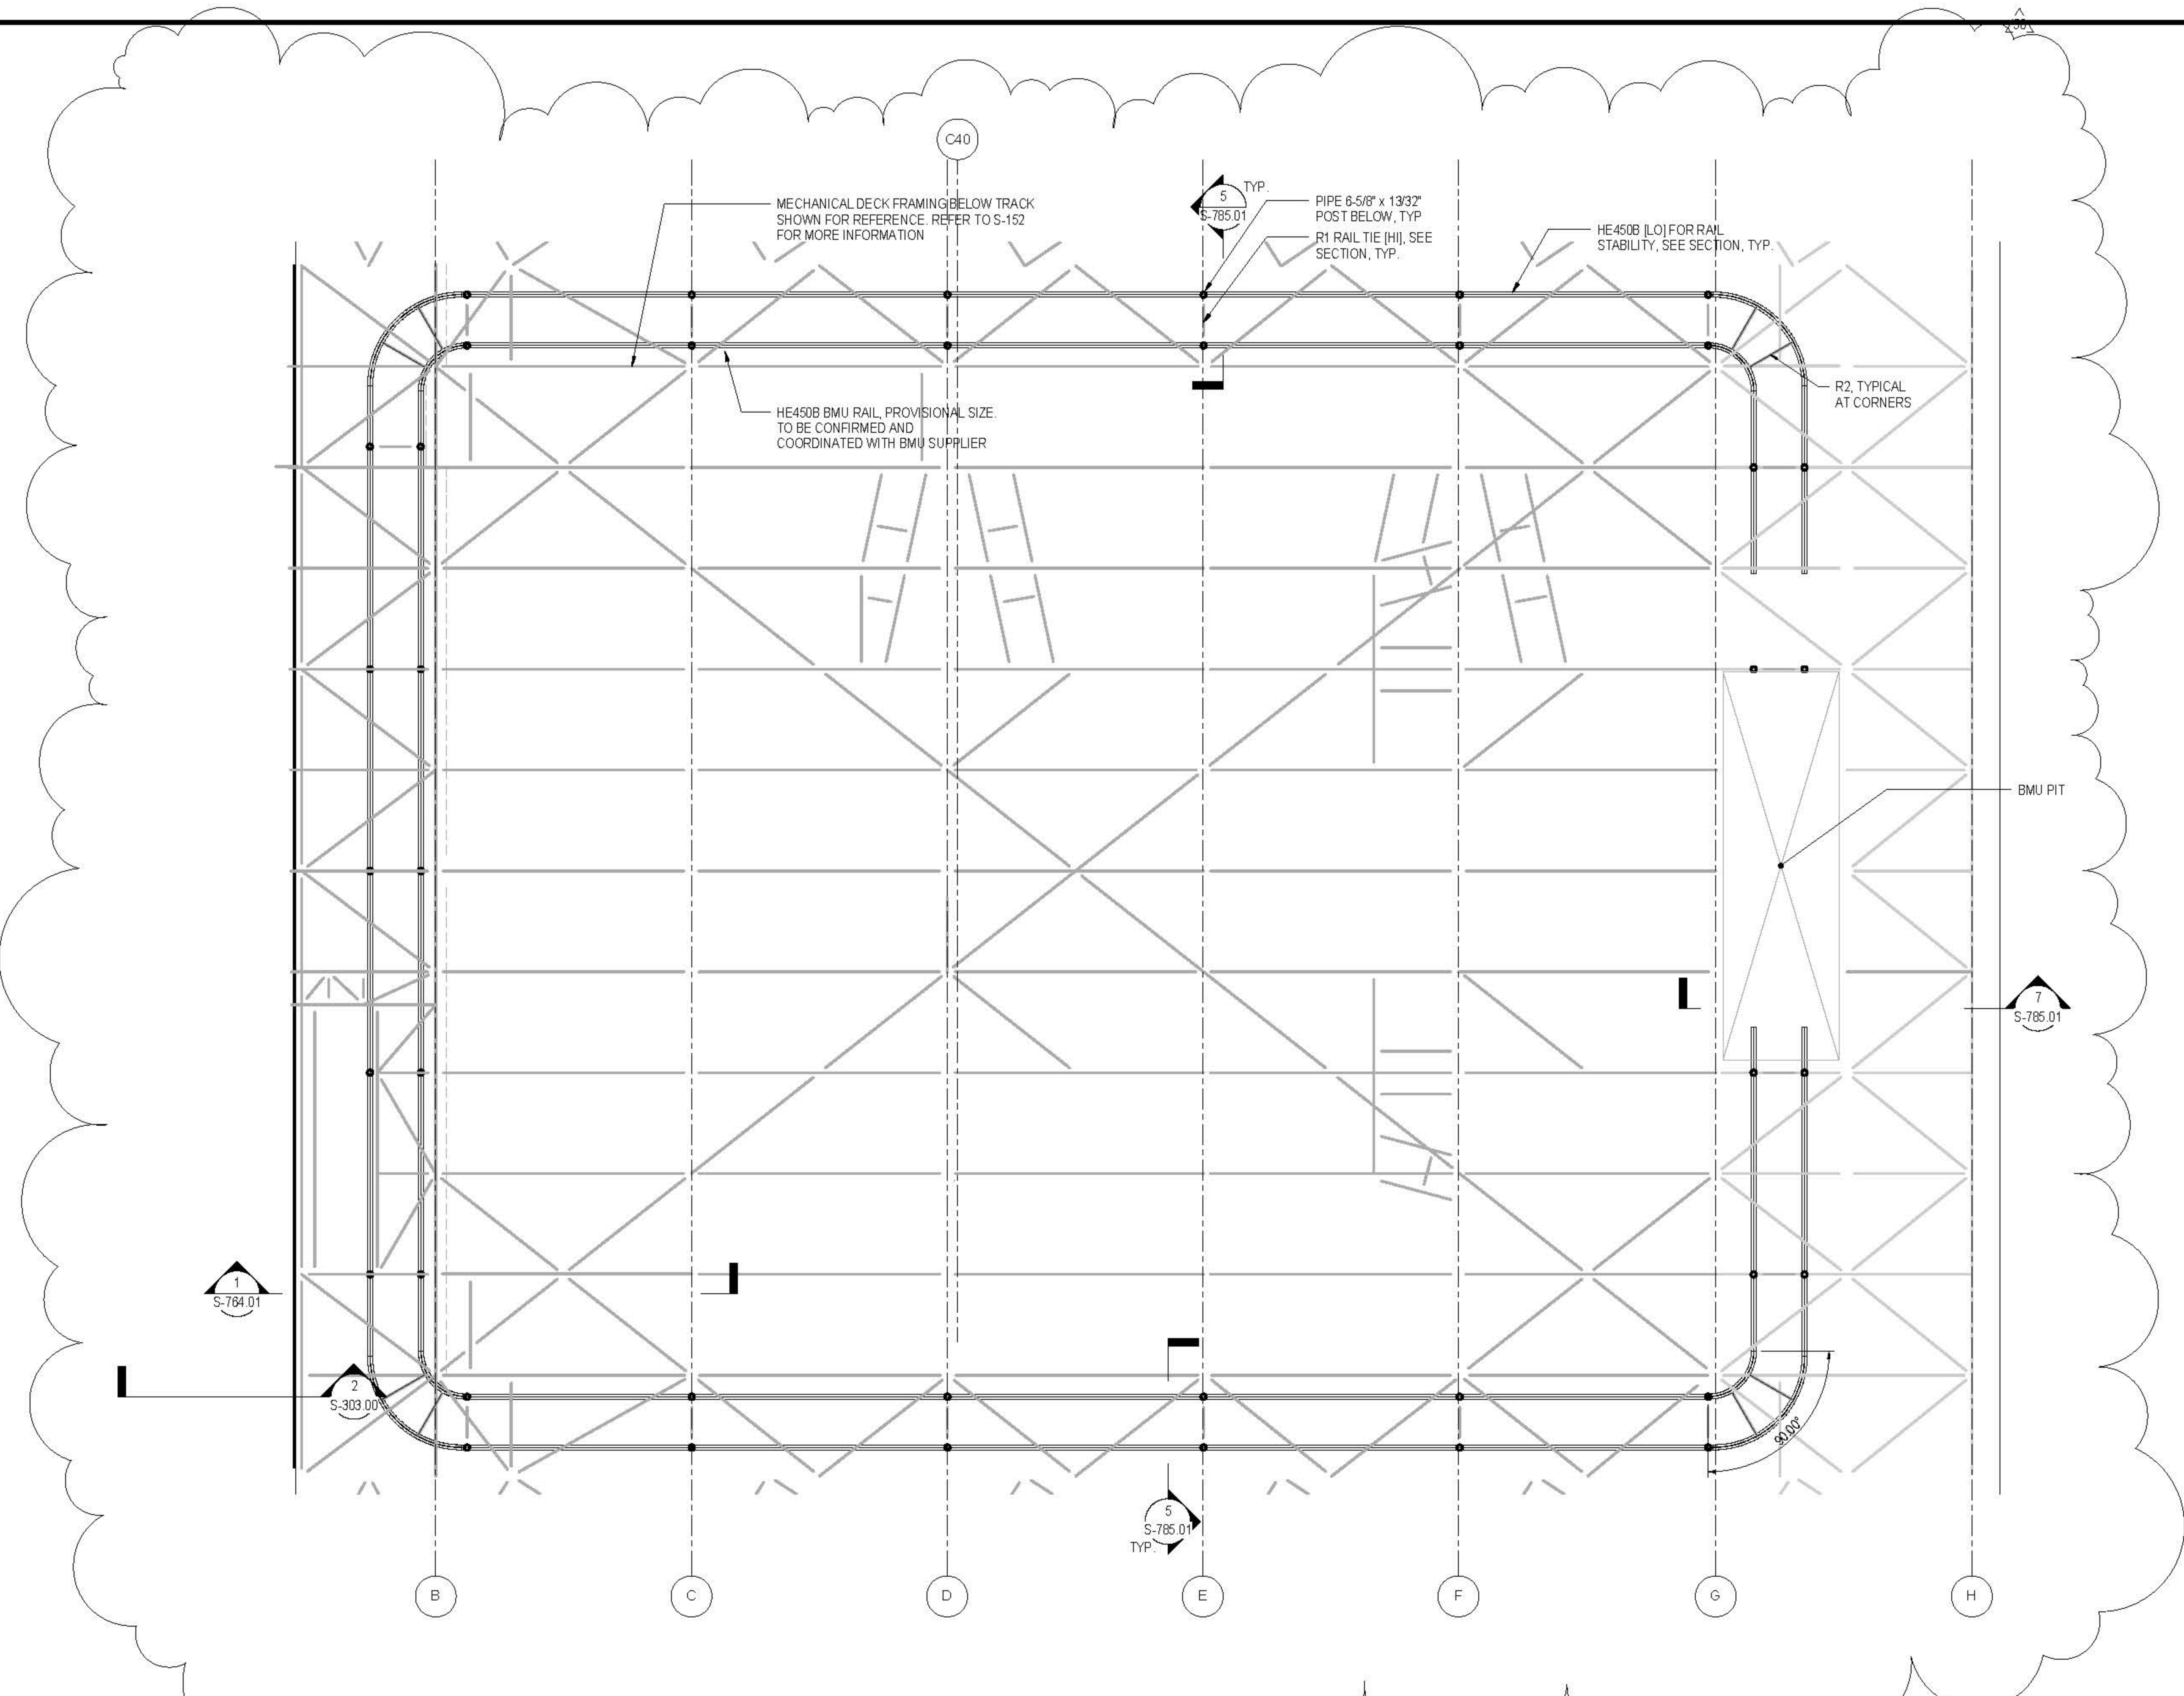

1 FRAMING PLAN, DEPLOYED SHED - ROOF
1/8" = 1'-0"

KEY PLAN

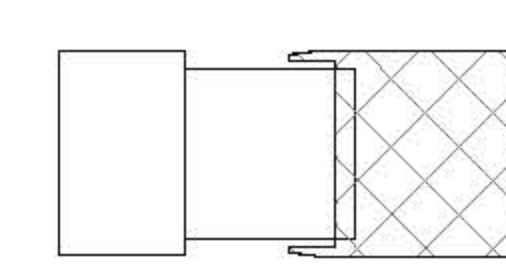

ISSUE PRINTING DATE

NO.	DESCRIPTION	DATE
63	60 DOB AMENDMENT 7	03/29/2016
44	30 DOB AMENDMENT 6	04/02/2016
21	CONSTRUCTION SET	10/08/2015
10	4 100% CONSTRUCTION DOCUMENTS	03/18/2015
9	90% CONSTRUCTION DOCUMENTS	02/16/2015
6	PRELIMINARY DOB SUBMISSION	12/10/2014
1	ADVANCED PROCUREMENT BID SET	06/16/2014



DRAWN BY: *Autism* CHECKED BY: *Chris*


PROJECT NUMBER
N1318.00

TITLE
FRAMING PLAN, DEPLOYED SHED - BMU TRACK

DRAWING NO.
S-154.01

B.SCAN NO.
S-154.01

32 of 123

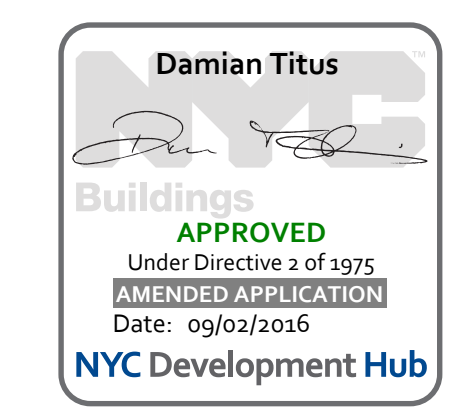

REFER TO ARCHITECTURAL MODEL AND DRAWINGS.
PENDING COORDINATION DURING DESIGN ASSIST.

CULTURE SHED

540 West 30th Street
New York, New York 10001

OWNER
CULTURE SHED INC.

ARCHITECTS
Oller Scaffaro + Renfro Architects, DPC
601 West 30th Street #815
New York, New York 10001
T: 212.263.7971

rackwellgroup
5 Union St. West, 6th Flr
New York, New York 10003
T: 212.463.0334
F: 212.463.0335

STRUCTURAL ENGINEER
Thornton Tomasetti
51 Madison Avenue
New York, New York 10010
T: 917.981.7800
F: 917.981.7801

MEP ENGINEER
Jana Baum & Bolles
63 Park Street
New York, New York 10005
T: 212.530.9300
F: 212.266.6544

FAÇADE CONSULTANT
Thornton Tomasetti
51 Madison Avenue
New York, New York 10010
T: 917.981.7800
F: 917.981.7801

KINETICS ENGINEER
Hardisty & Hanover
1501 Broadway
New York, New York 10036
T: 212.944.1150
F: 212.391.0297

LIGHTING DESIGNER
Tilston Design Associates
40 North Street #1650
New York, New York 10013
T: 212.675.7760

THEATRE PLANNING & DESIGN
Fisher Dodge Associates
22 West 15th Street
New York, New York 10011
T: 212.691.3000

LIFE SAFETY
Code Consultants, Inc.
215 West 43rd St, 15th Flr
New York, New York 10018
T: 212.216.9596

ENERGY MODEL/LEED
Vindian
63 Washington Street
Norwalk, CT 06854
T: 203.298.1411

ACOUSTIC/AUDIO-VISUAL
Avenille
93 North Main Street
South Norwalk, CT 06854
T: 347.210.5540

VERTICAL TRANSPORTATION
Van Dusen & Associates
5 Regent Street, Suite 524
Larkington, NJ 07038
T: 973.994.9220

SPECIFICATIONS
Construction Specifications Inc.
PO Box 489
227 Tenthon Road
Morganville, NJ 07751
T: 732.970.0700
F: 732.970.0750


SECURITY
Duchella Venter & Santoro
1020 Sherman Avenue
Hartford, CT 06114
T: 203.286.6490

WATERPROOFING
James R. Galford AIA Consulting Architects PC
104 West 27th Street
New York, NY 10001
T: 212.736.3344

FAÇADE MAINTENANCE
Erick Engineering PLLC
62 Ave. Street
New York, NY 10005
T: 212.696.3000

BRANDING GRAPHICS
2nd Global Design Consultancy
180 Varck Street 15th Floor
New York, NY 10014
T: 212.647.1170

KEY PLAN

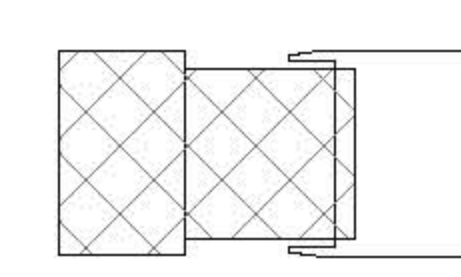


ISSUE PRINTING DATE

NO.	DESCRIPTION	DATE
01	01 - DISB AMENDMENT 7	03.19.2016
11	11 - 6 ADV. PROCUREMENT ADDENDUM 6	04.10.2015
10	10 - 4 100% CONSTRUCTION DOCUMENTS	03.18.2015
9	9 - 30% CONSTRUCTION DOCUMENTS	02.16.2015
8	8 - PRELIMINARY DISB SUBMISSION	12.10.2014
1	1 - ADVANCED PROCUREMENT BID SET	06.16.2014



DRAWN BY: **Autmy** CHECKED BY: **Chris**
PROJECT NUMBER: N11318.00


TITLE: BRACING ELEVATIONS FIXED BUILDING II

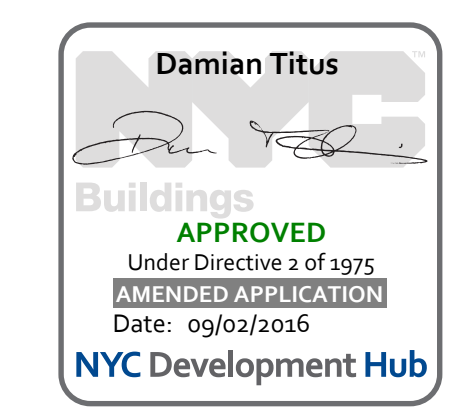

DRAWING NO.: S-302.01

B.SCAN NO.: S-302.01

B.SCAN NO.: S-302.01

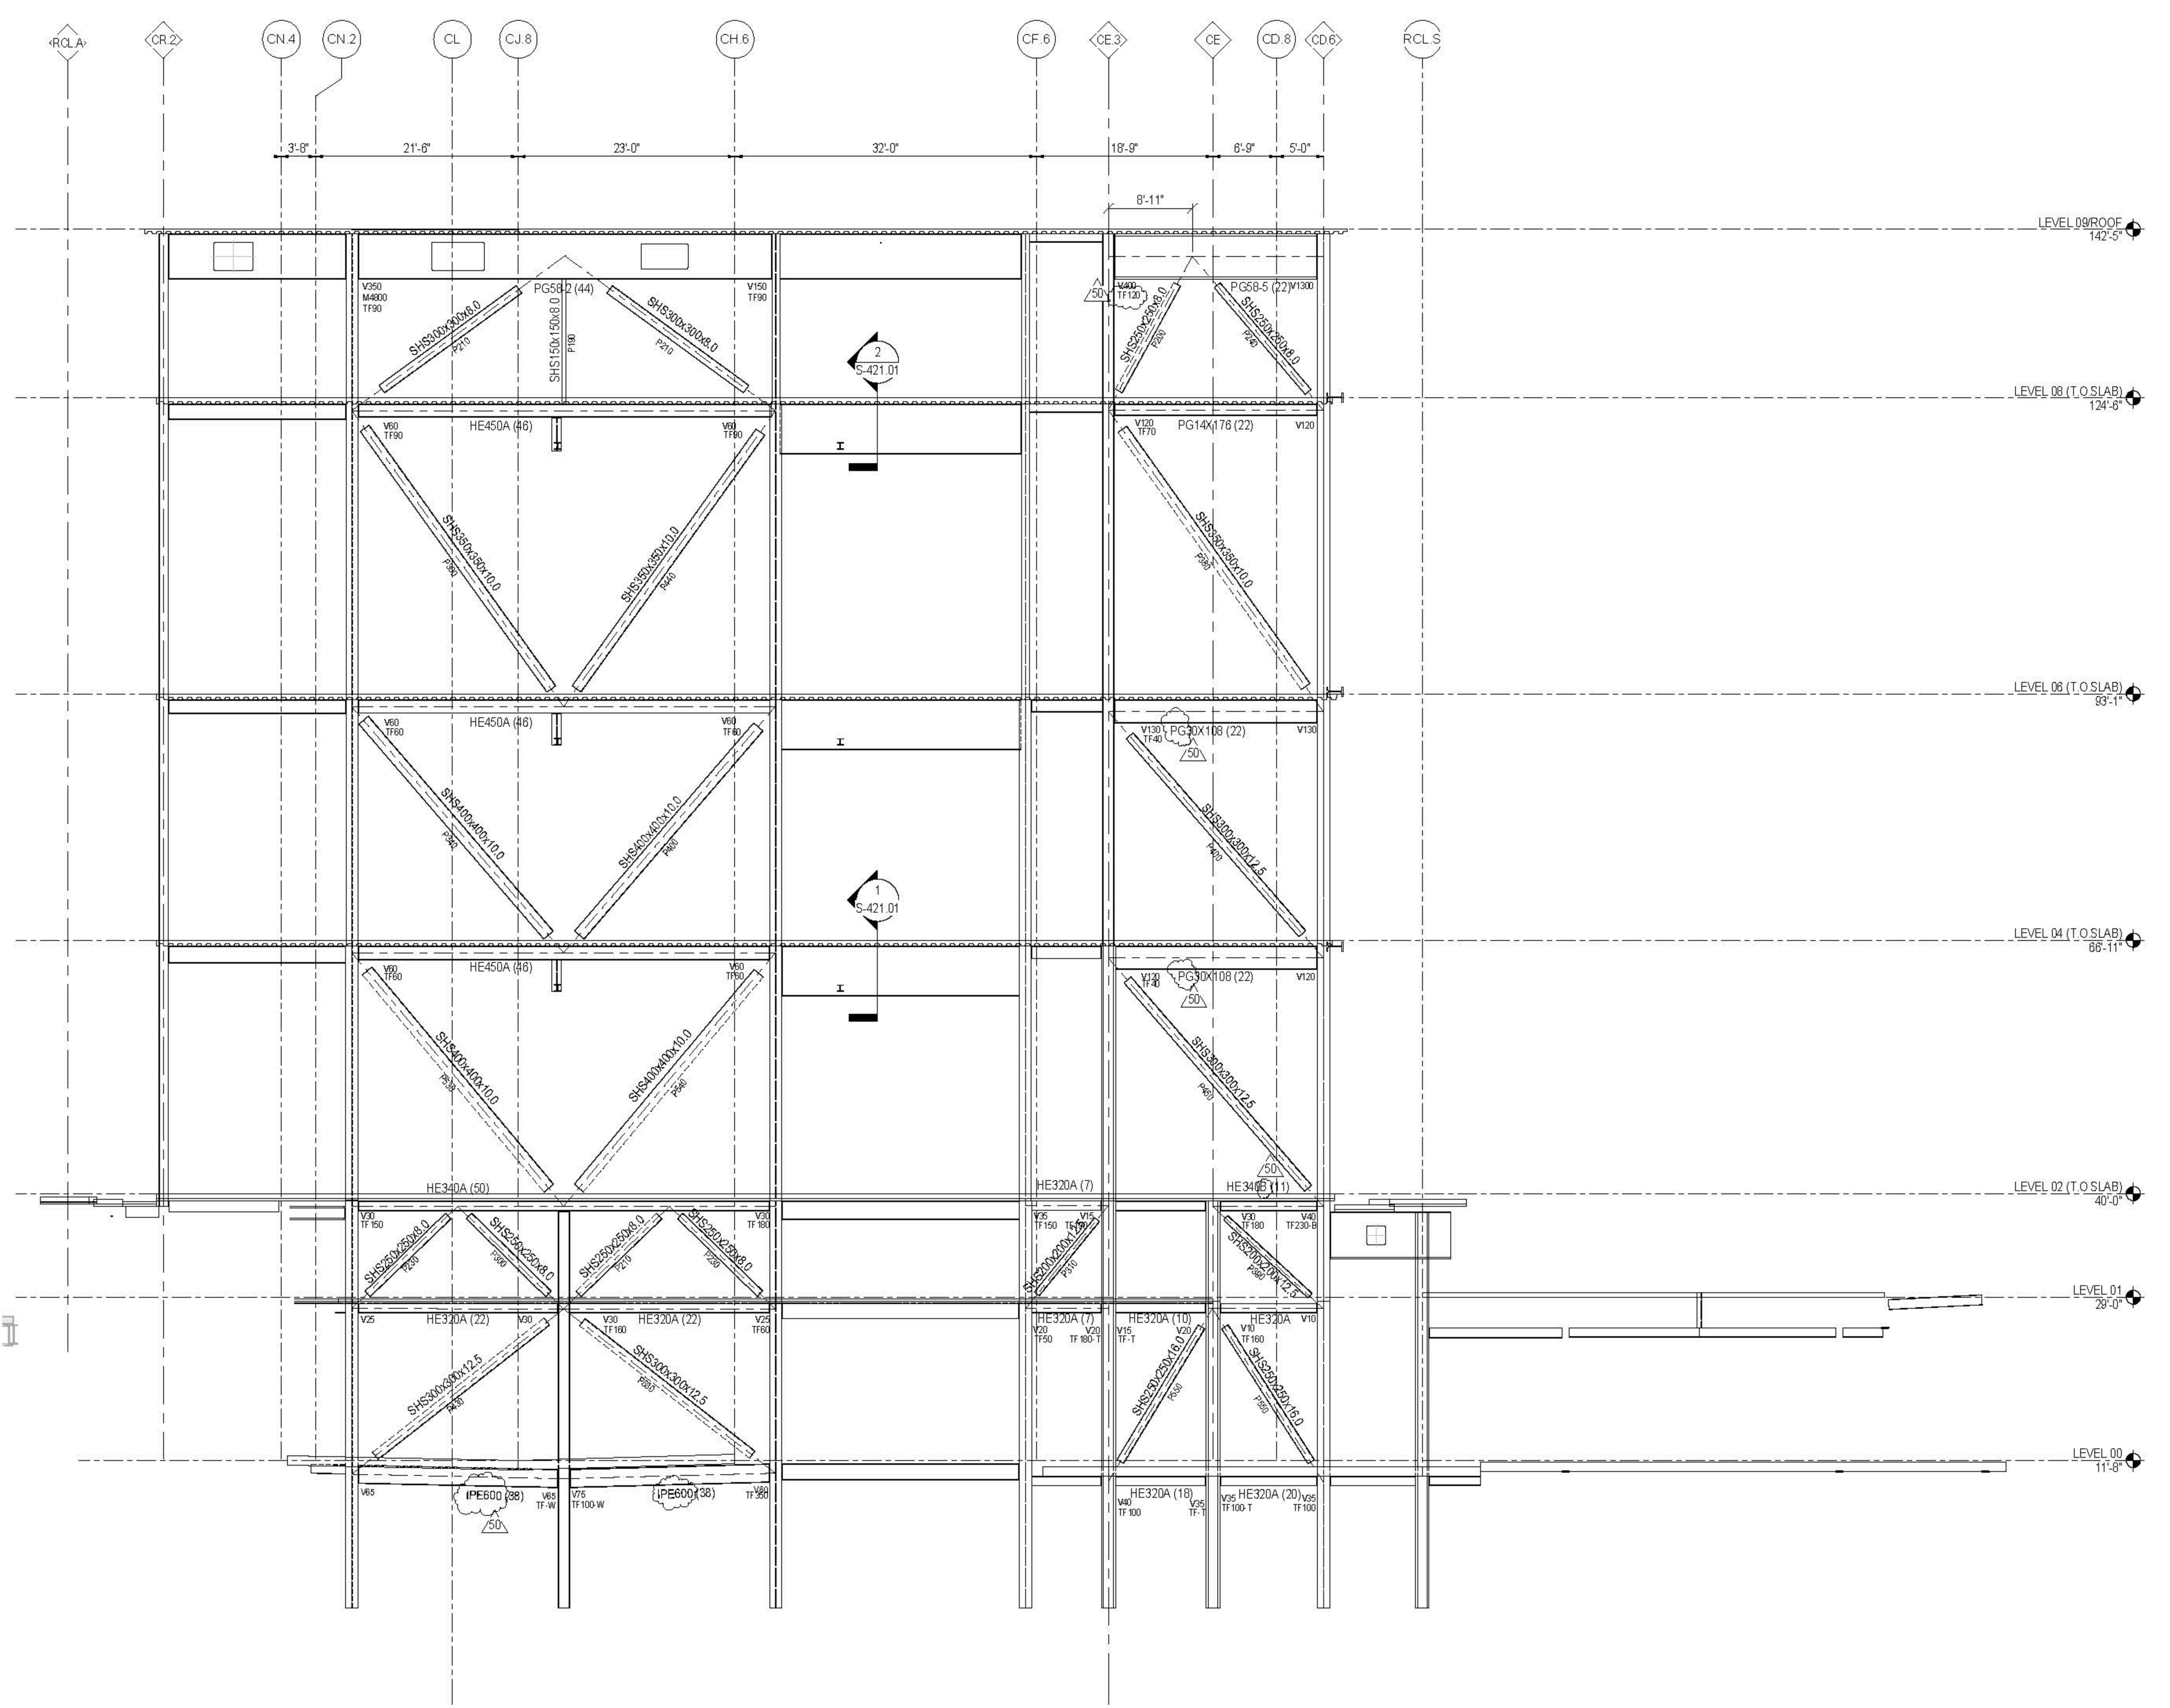

1 ELEVATION ON GRID LINE C58
1/8" = 1'-0"

- GENERAL BRACED FRAME NOTES:**
- REFER TO PLANS FOR TOP STEEL ELEVATIONS AND FOR GRIDLINE DIMENSIONS
 - ALL FORCES (KIPS) ARE FACTORED AND ARE TO BE CONSIDERED FULLY REVERSIBLE UNLESS OTHERWISE NOTED AS FOLLOWS:
+XXX INDICATES TENSION ONLY
-XXX INDICATES COMPRESSION ONLY
 - IF NOT INDICATED DESIGN BRACED FRAME BEAM TO COLUMN CONNECTIONS FOR A MINIMUM TRANSFER FORCE OF XX KIPS
 - SEE TYPICAL BRACE CONNECTION DETAILS
 - ALL BRACE AND BEAM MEMBERS ARE ORIENTED WEB VERTICAL UNLESS OTHERWISE NOTED ON ELEVATION AS FOLLOWS:
(H) INDICATES MEMBER WITH WEB ORIENTED HORIZONTAL
 - SEE PLAN FOR COLUMN ORIENTATION
 - SEE STEEL COLUMN SCHEDULE FOR SHEAR BASE MARK AND SCHEDULE
 - SEE STEEL BEAM LEGEND ON FRAMING PLAN FOR KEY TO BEAM DATA AND FOR FORCES NOT SHOWN
 - ALL BRACED FRAME LINE DIAGRAMS DENOTE CENTERLINES FOR BEAMS AND COLUMNS AND WORKING LINES FOR BRACES (SEE BRACE DETAILS)
 - MINIMIZE UNBRACED LENGTH OF GUSSET AT BRACE TO GUSSET CONNECTIONS
- LEGEND:**
- TFXX INDICATES FACTORED AXIAL FORCE TRANSFERRED THROUGH THE CONNECTION JOINT INTO THE FAR MEMBER IN KIPS
 - TSXX INDICATES FACTORED TENSION COLUMN SPLICE FORCE OR NET UPLIFT AT BASE IN KIPS
SEE TENSION / MOMENT COLUMN SPLICE DETAIL
 - EPX INDICATES SHEAR EMBED PLATE
SEE SCHEDULE AND NOTE 7 ABOVE

CULTURE SHED

540 West 30th Street
New York, New York 10001
OWNER
CULTURE SHED INC.
ARCHITECTS
Oller Scaffaro + Renfro Architects, PC
601 West 30th Street #815
New York, New York 10001
T: 212.363.7971

rockwellgroup
5 Union St. West, 6th Fl.
New York, New York 10003
T: 212.463.0334
F: 212.463.0335

STRUCTURAL ENGINEER
Thornton Tomasetti
51 Madison Avenue
New York, New York 10010
T: 917.991.7800
F: 917.991.7801

MEP ENGINEER
Jana Baum & Bolles
80 Park Street
New York, New York 10005
T: 212.530.9300
F: 212.265.6564

FACADE CONSULTANT
Thornton Tomasetti
51 Madison Avenue
New York, New York 10010
T: 917.991.7800
F: 917.991.7801

KINETICS ENGINEER
Hardesky & Hanover
1501 Broadway
New York, New York 10036
T: 212.944.1150
F: 212.391.0297

LIGHTING DESIGNER
Tilston Design Associates
40 North Street #150
New York, New York 10013
T: 212.675.7760

THEATRE PLANNING & DESIGN
Fisher Dodge Associates
22 West 15th Street
New York, New York 10011
T: 212.691.3000

LIFE SAFETY
Code Consultants, Inc.
215 West 43rd St., 15th Fl.
New York, New York 10018
T: 212.216.9596

ENERGY MODEL A/EED
Vindian
50 Washington Street
Norwalk, CT 06854
T: 203.290.1411

ACOUSTIC/AUDIO-VISUAL
Avenelle
93 North Main Street
South Norwalk, CT 06854
T: 347.210.5540

VERTICAL TRANSPORTATION
Van Dusen & Associates
5 Regent Street, Suite 524
Livingston, NJ 07039
T: 973.994.9220

SPECIFICATIONS
Construction Specifications Inc.
PO Box 489
227 Fenwick Road
Morganville, NJ 07751
T: 732.970.0700
F: 732.970.0700


SECURITY
Duchella Venter & Santoro
1020 Sherman Avenue
Hartford, CT 06114
T: 203.286.6490

WATERPROOFING
James R. Gahfort AIA Consulting Architects PC
104 West 27th Street
New York, NY 10001
T: 212.736.3344

FACADE MAINTENANCE
Eink Engineering PLLC
362 Arden Street
New York, NY 10005
T: 212.696.3000

BRANDING GRAPHICS
214 Global Design Consultancy
180 Varck Street 15th Floor
New York, NY 10014
T: 212.647.1170

KEY PLAN

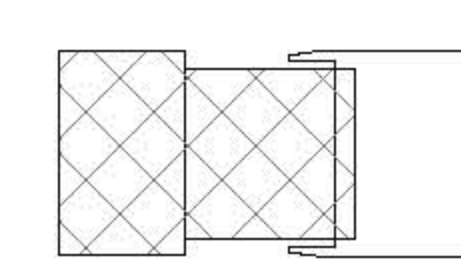

ISSUE PRINTING DATE

ISSUE	PRINTING	DATE
01	50	DOB AMENDMENT 7 08.19.2016
02	26	AS 401 02.12.2016
03		CONSTRUCTION SET 10.09.2016
04	6	ADV. PROCUREMENT ADDENDUM 6 04.10.2015
05	4	100% CONSTRUCTION DOCUMENTS 03.18.2015
06	3	90% CONSTRUCTION DOCUMENTS 02.16.2015
07	5	PRELIMINARY DOB SUBMISSION 12.10.2014
08	1	ADVANCED PROCUREMENT BID SET 06.16.2014

STAMP



DRAWN BY
Autmy

CHECKED BY
Chris


PROJECT NUMBER
N11318.00

TITLE
BRACING ELEVATIONS FIXED BUILDING II

DRAWING NO.
S-303.01

B.SCAN NO.
S-303.01


37 of 123

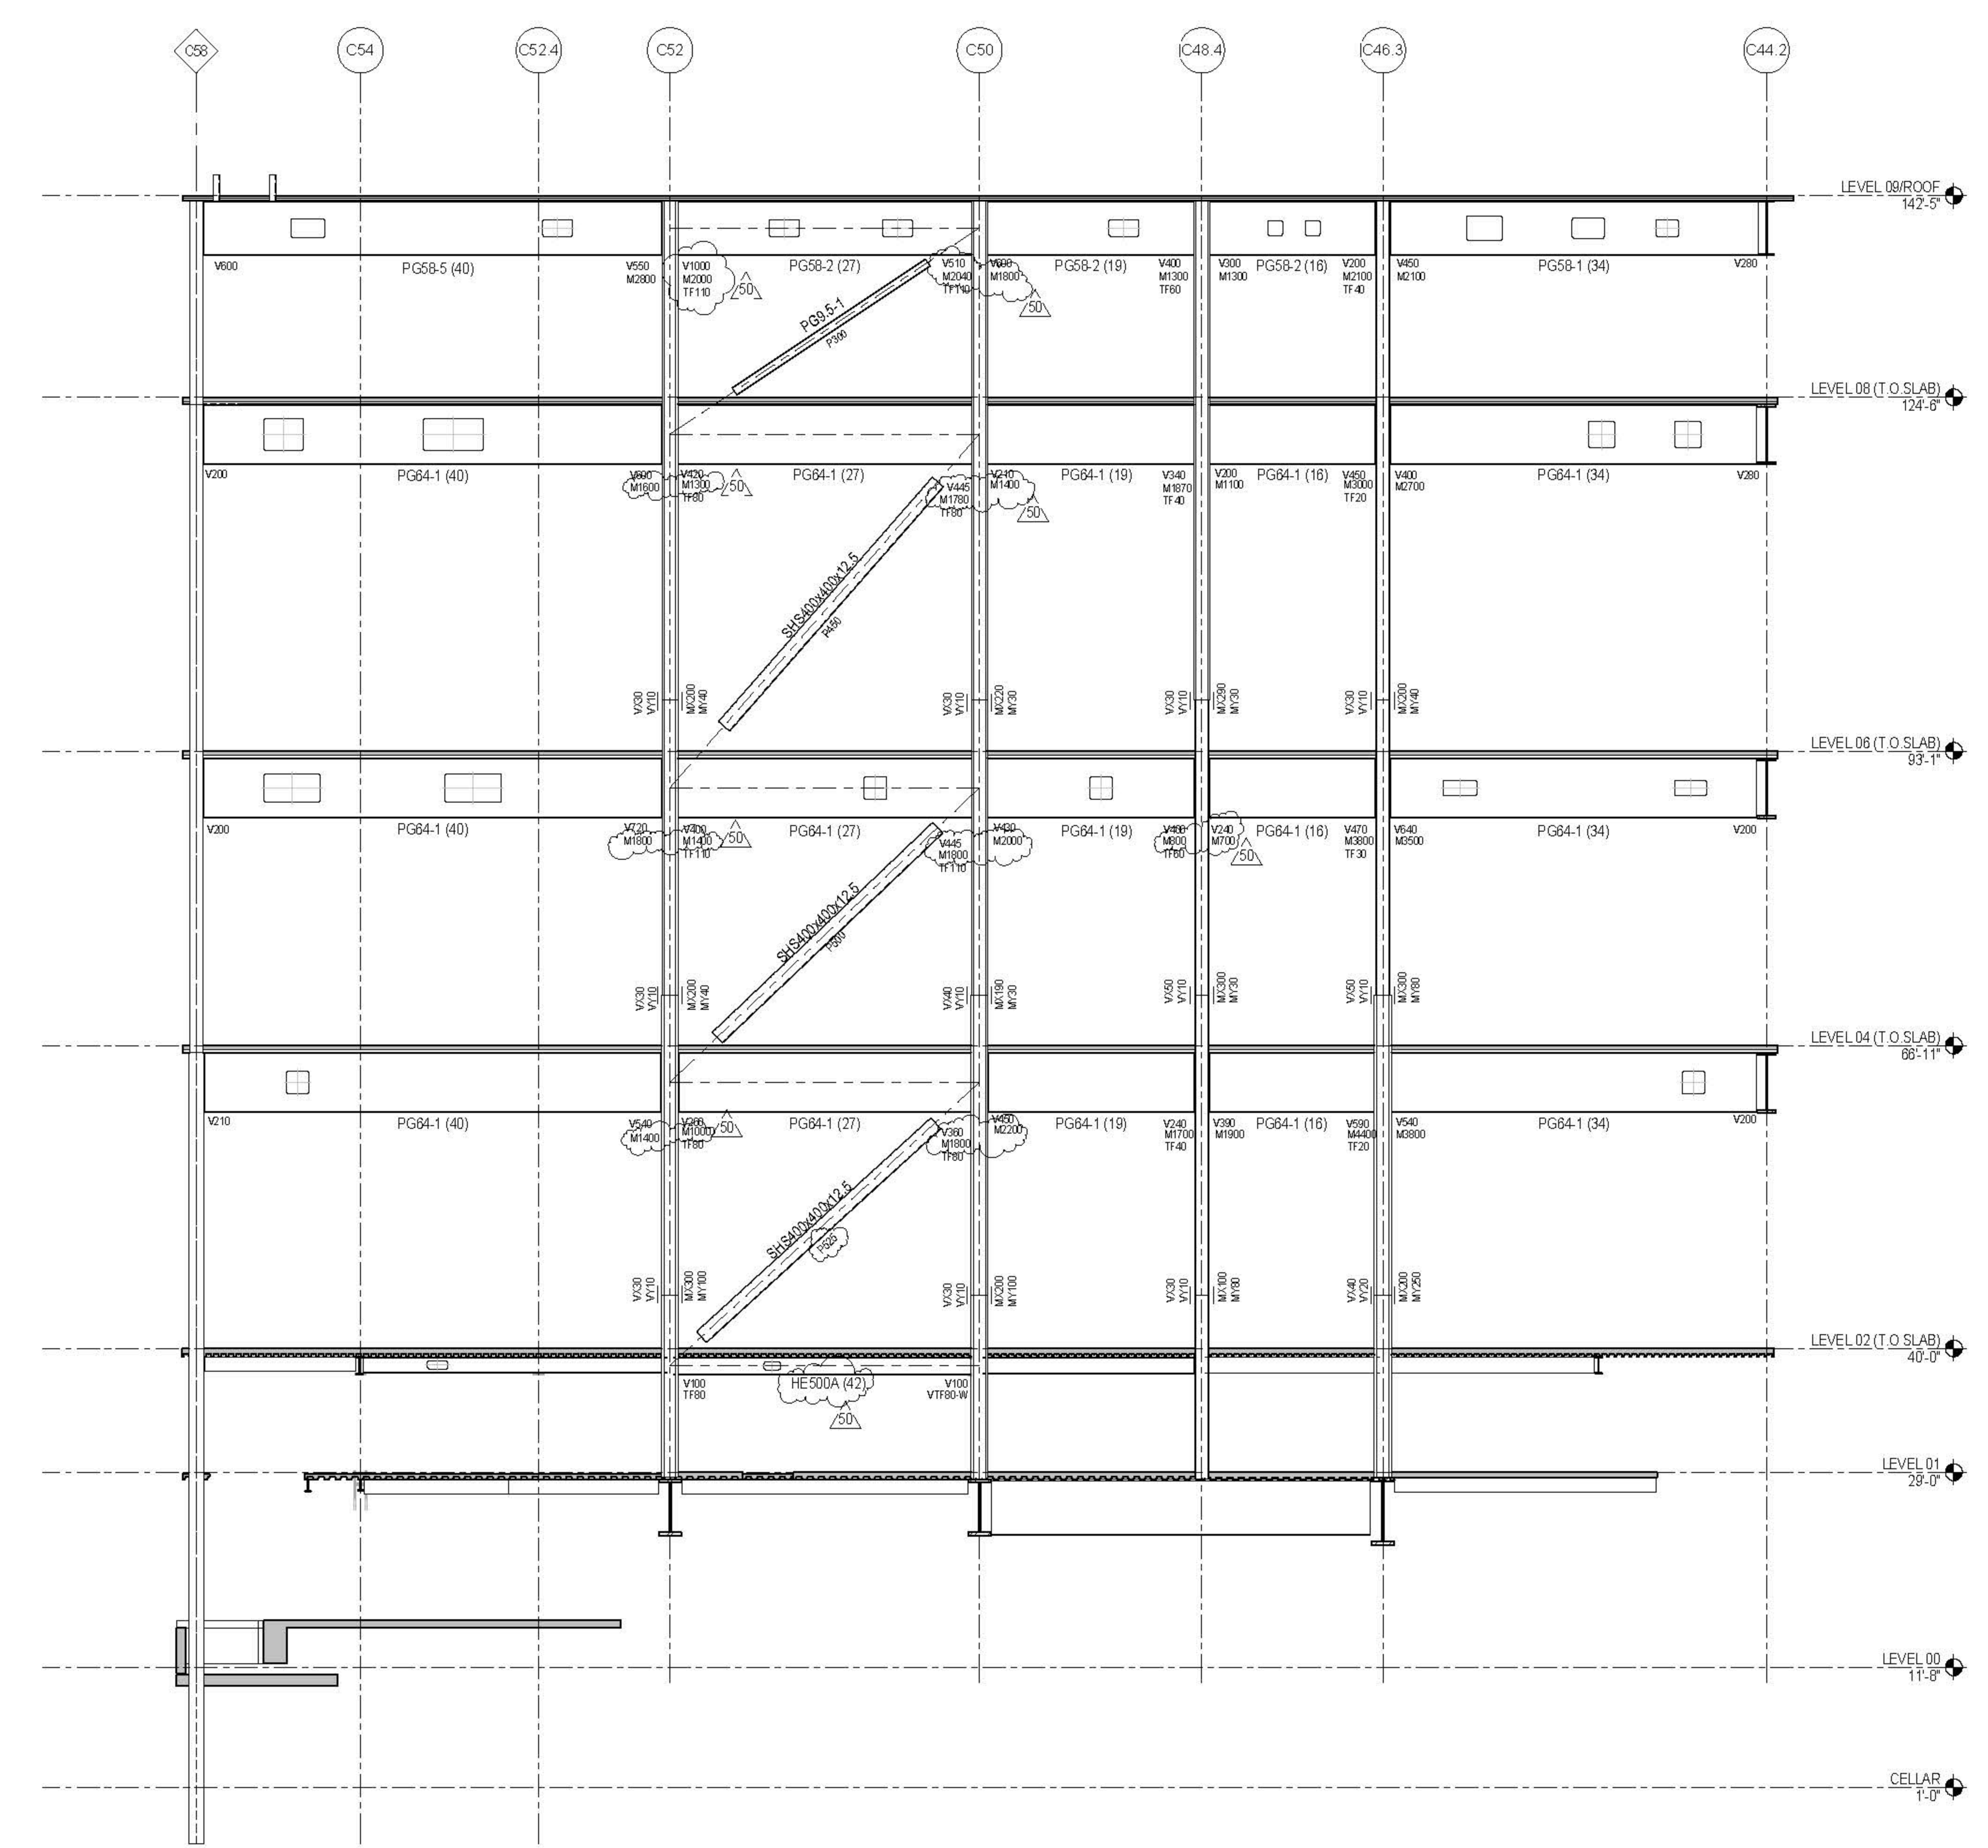

1 ELEVATION ON GRID LINE CE.3


- 1/8" = 1'-0"
- GENERAL BRACED FRAME NOTES:**
- REFER TO PLANS FOR TOP STEEL ELEVATIONS AND FOR GRIDLINE DIMENSIONS
 - ALL FORCES (KIPS) ARE FACTORED AND ARE TO BE CONSIDERED FULLY REVERSIBLE UNLESS OTHERWISE NOTED AS FOLLOWS:
+XXX INDICATES TENSION ONLY
-XXX INDICATES COMPRESSION ONLY
 - IF NOT INDICATED DESIGN BRACED FRAME BEAM TO COLUMN CONNECTIONS FOR A MINIMUM TRANSFER FORCE OF XX KIPS
 - SEE TYPICAL BRACE CONNECTION DETAILS
 - ALL BRACE AND BEAM MEMBERS ARE ORIENTED WEB VERTICAL UNLESS OTHERWISE NOTED ON ELEVATION AS FOLLOWS:
(H) INDICATES MEMBER WITH WEB ORIENTED HORIZONTAL
 - SEE PLAN FOR COLUMN ORIENTATION
 - SEE STEEL COLUMN SCHEDULE FOR SHEAR BASE MARK AND SCHEDULE
 - SEE STEEL BEAM LEGEND ON FRAMING PLAN FOR KEY TO BEAM DATA AND FOR FORCES NOT SHOWN
 - ALL BRACED FRAME LINE DIAGRAMS DENOTE CENTERLINES FOR BEAMS AND COLUMNS AND WORKING LINES FOR BRACES (SEE BRACE DETAILS)
 - MINIMIZE UNBRACED LENGTH OF GUSSET AT BRACE TO GUSSET CONNECTIONS

- LEGEND:**
- TFXX INDICATES FACTORED AXIAL FORCE TRANSFERRED THROUGH THE CONNECTION JOINT INTO THE FAR MEMBER IN KIPS
- TSXX INDICATES FACTORED TENSION COLUMN SPLICE FORCE OR NET UPLIFT AT BASE IN KIPS
SEE TENSION / MOMENT COLUMN SPLICE DETAIL
- EPX INDICATES SHEAR EMBED PLATE
SEE SCHEDULE AND NOTE 7 ABOVE

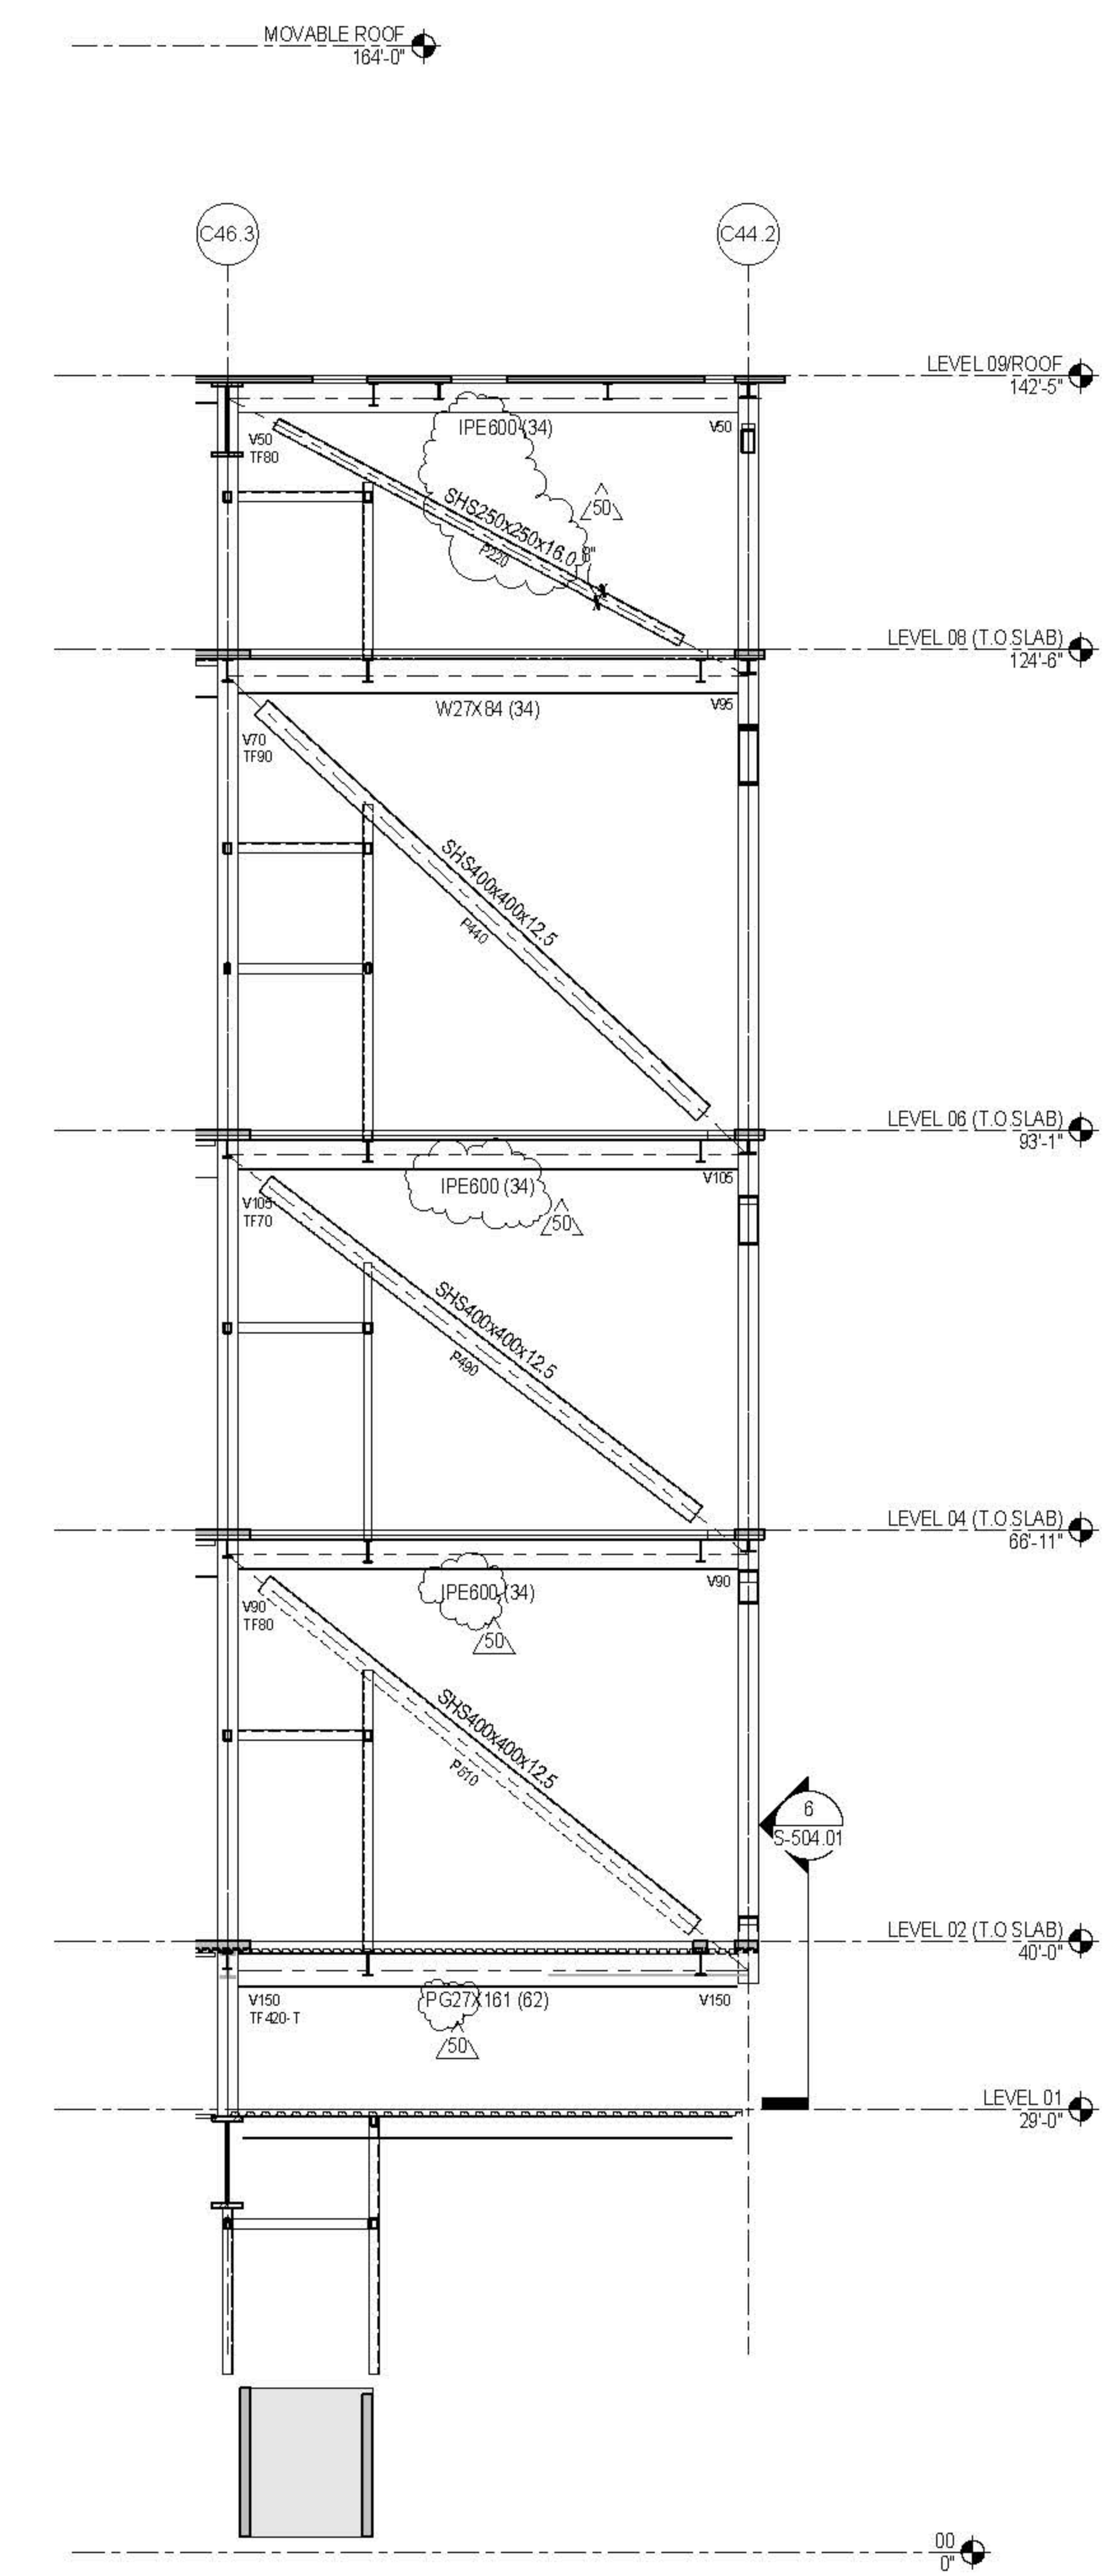

2 ELEVATION ON GRID CE

- 1/8" = 1'-0"
- GENERAL BRACED FRAME NOTES:**
- REFER TO PLANS FOR TOP STEEL ELEVATIONS AND FOR GRIDLINE DIMENSIONS
 - ALL FORCES (KIPS) ARE FACTORED AND ARE TO BE CONSIDERED FULLY REVERSIBLE UNLESS OTHERWISE NOTED AS FOLLOWS:
+XXX INDICATES TENSION ONLY
-XXX INDICATES COMPRESSION ONLY
 - IF NOT INDICATED DESIGN BRACED FRAME BEAM TO COLUMN CONNECTIONS FOR A MINIMUM TRANSFER FORCE OF XX KIPS
 - SEE TYPICAL BRACE CONNECTION DETAILS
 - ALL BRACE AND BEAM MEMBERS ARE ORIENTED WEB VERTICAL UNLESS OTHERWISE NOTED ON ELEVATION AS FOLLOWS:
(H) INDICATES MEMBER WITH WEB ORIENTED HORIZONTAL
 - SEE PLAN FOR COLUMN ORIENTATION
 - SEE STEEL COLUMN SCHEDULE FOR SHEAR BASE MARK AND SCHEDULE
 - SEE STEEL BEAM LEGEND ON FRAMING PLAN FOR KEY TO BEAM DATA AND FOR FORCES NOT SHOWN
 - ALL BRACED FRAME LINE DIAGRAMS DENOTE CENTERLINES FOR BEAMS AND COLUMNS AND WORKING LINES FOR BRACES (SEE BRACE DETAILS)
 - MINIMIZE UNBRACED LENGTH OF GUSSET AT BRACE TO GUSSET CONNECTIONS

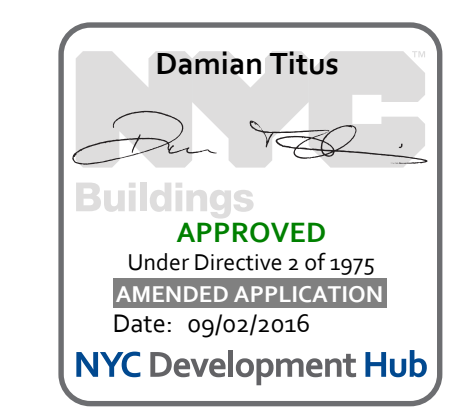

DRAWN BY
Autmy

CHECKED BY
Chris

PROJECT NUMBER
N11318.00

TITLE
BRACING ELEVATIONS FIXED BUILDING II

DRAWING NO.
S-303.01

B.SCAN NO.
S-303.01

37 of 123

CULTURE SHED

540 West 30th Street
New York, New York 10001

OWNER
CULTURE SHED INC.

ARCHITECTS
Oller Scaffolds + Renfro Architects, DPC
601 West 20th Street #815
New York, New York 10011
T: 212.463.0334
F: 212.463.0335

STRUCTURAL ENGINEER
Thornton Tomasetti
51 Madison Avenue
New York, New York 10010
T: 917.981.7800
F: 917.981.7801

MEP ENGINEER
Jana Baum & Bolles
83 Park Street
New York, New York 10005
T: 212.530.9300
F: 212.266.6934

FACADE CONSULTANT
Thornton Tomasetti
51 Madison Avenue
New York, New York 10010
T: 917.981.7800
F: 917.981.7801

KINETICS ENGINEER
Hardsy & Hanover
1501 Broadway
New York, New York 10036
T: 212.944.1150
F: 212.391.0297

LIGHTING DESIGNER
Tilston Design Associates
40 North Street #1650
New York, New York 10013
T: 212.675.7760

THEATRE PLANNING & DESIGN
Fisher Dachs Associates
22 West 15th Street
New York, New York 10011
T: 212.691.3000

LIFE SAFETY
Code Consultants, Inc.
215 West 43rd St, 15th Flr
New York, New York 10018
T: 212.216.9596

ENERGY MODEL/LEED
Vindian
50 Washington Street
Norwalk, CT 06854
T: 203.298.1411

ACOUSTIC/AUDIO-VISUAL
Avenille
93 North Main Street
South Norwalk, CT 06854
T: 347.210.5540

VERTICAL TRANSPORTATION
Van Duusen & Associates
5 Regent Street, Suite 524
Larchmont, NJ 07038
T: 973.994.9220

SPECIFICATIONS
Construction Specifications Inc.
PO Box 489
227 Fenwick Road
Morganville, NJ 07751
T: 732.970.0700
F: 732.970.0700



SECURITY
Duchella Venter & Santoro
1100 Sherman Avenue
Hartford, CT 06114
T: 203.286.6490

WATERPROOFING
James R. Gahfort AIA Consulting Architects PC
104 West 27th Street
New York, NY 10001
T: 212.736.3344

FACADE MAINTENANCE
Erick Engineering PLLC
162 Ave. Street
New York, NY 10005
T: 212.698.3000

BRANDING GRAPHICS
2nd Global Design Consultancy
180 Varck Street 15th Floor
New York, NY 10014
T: 212.647.1170

KEY PLAN

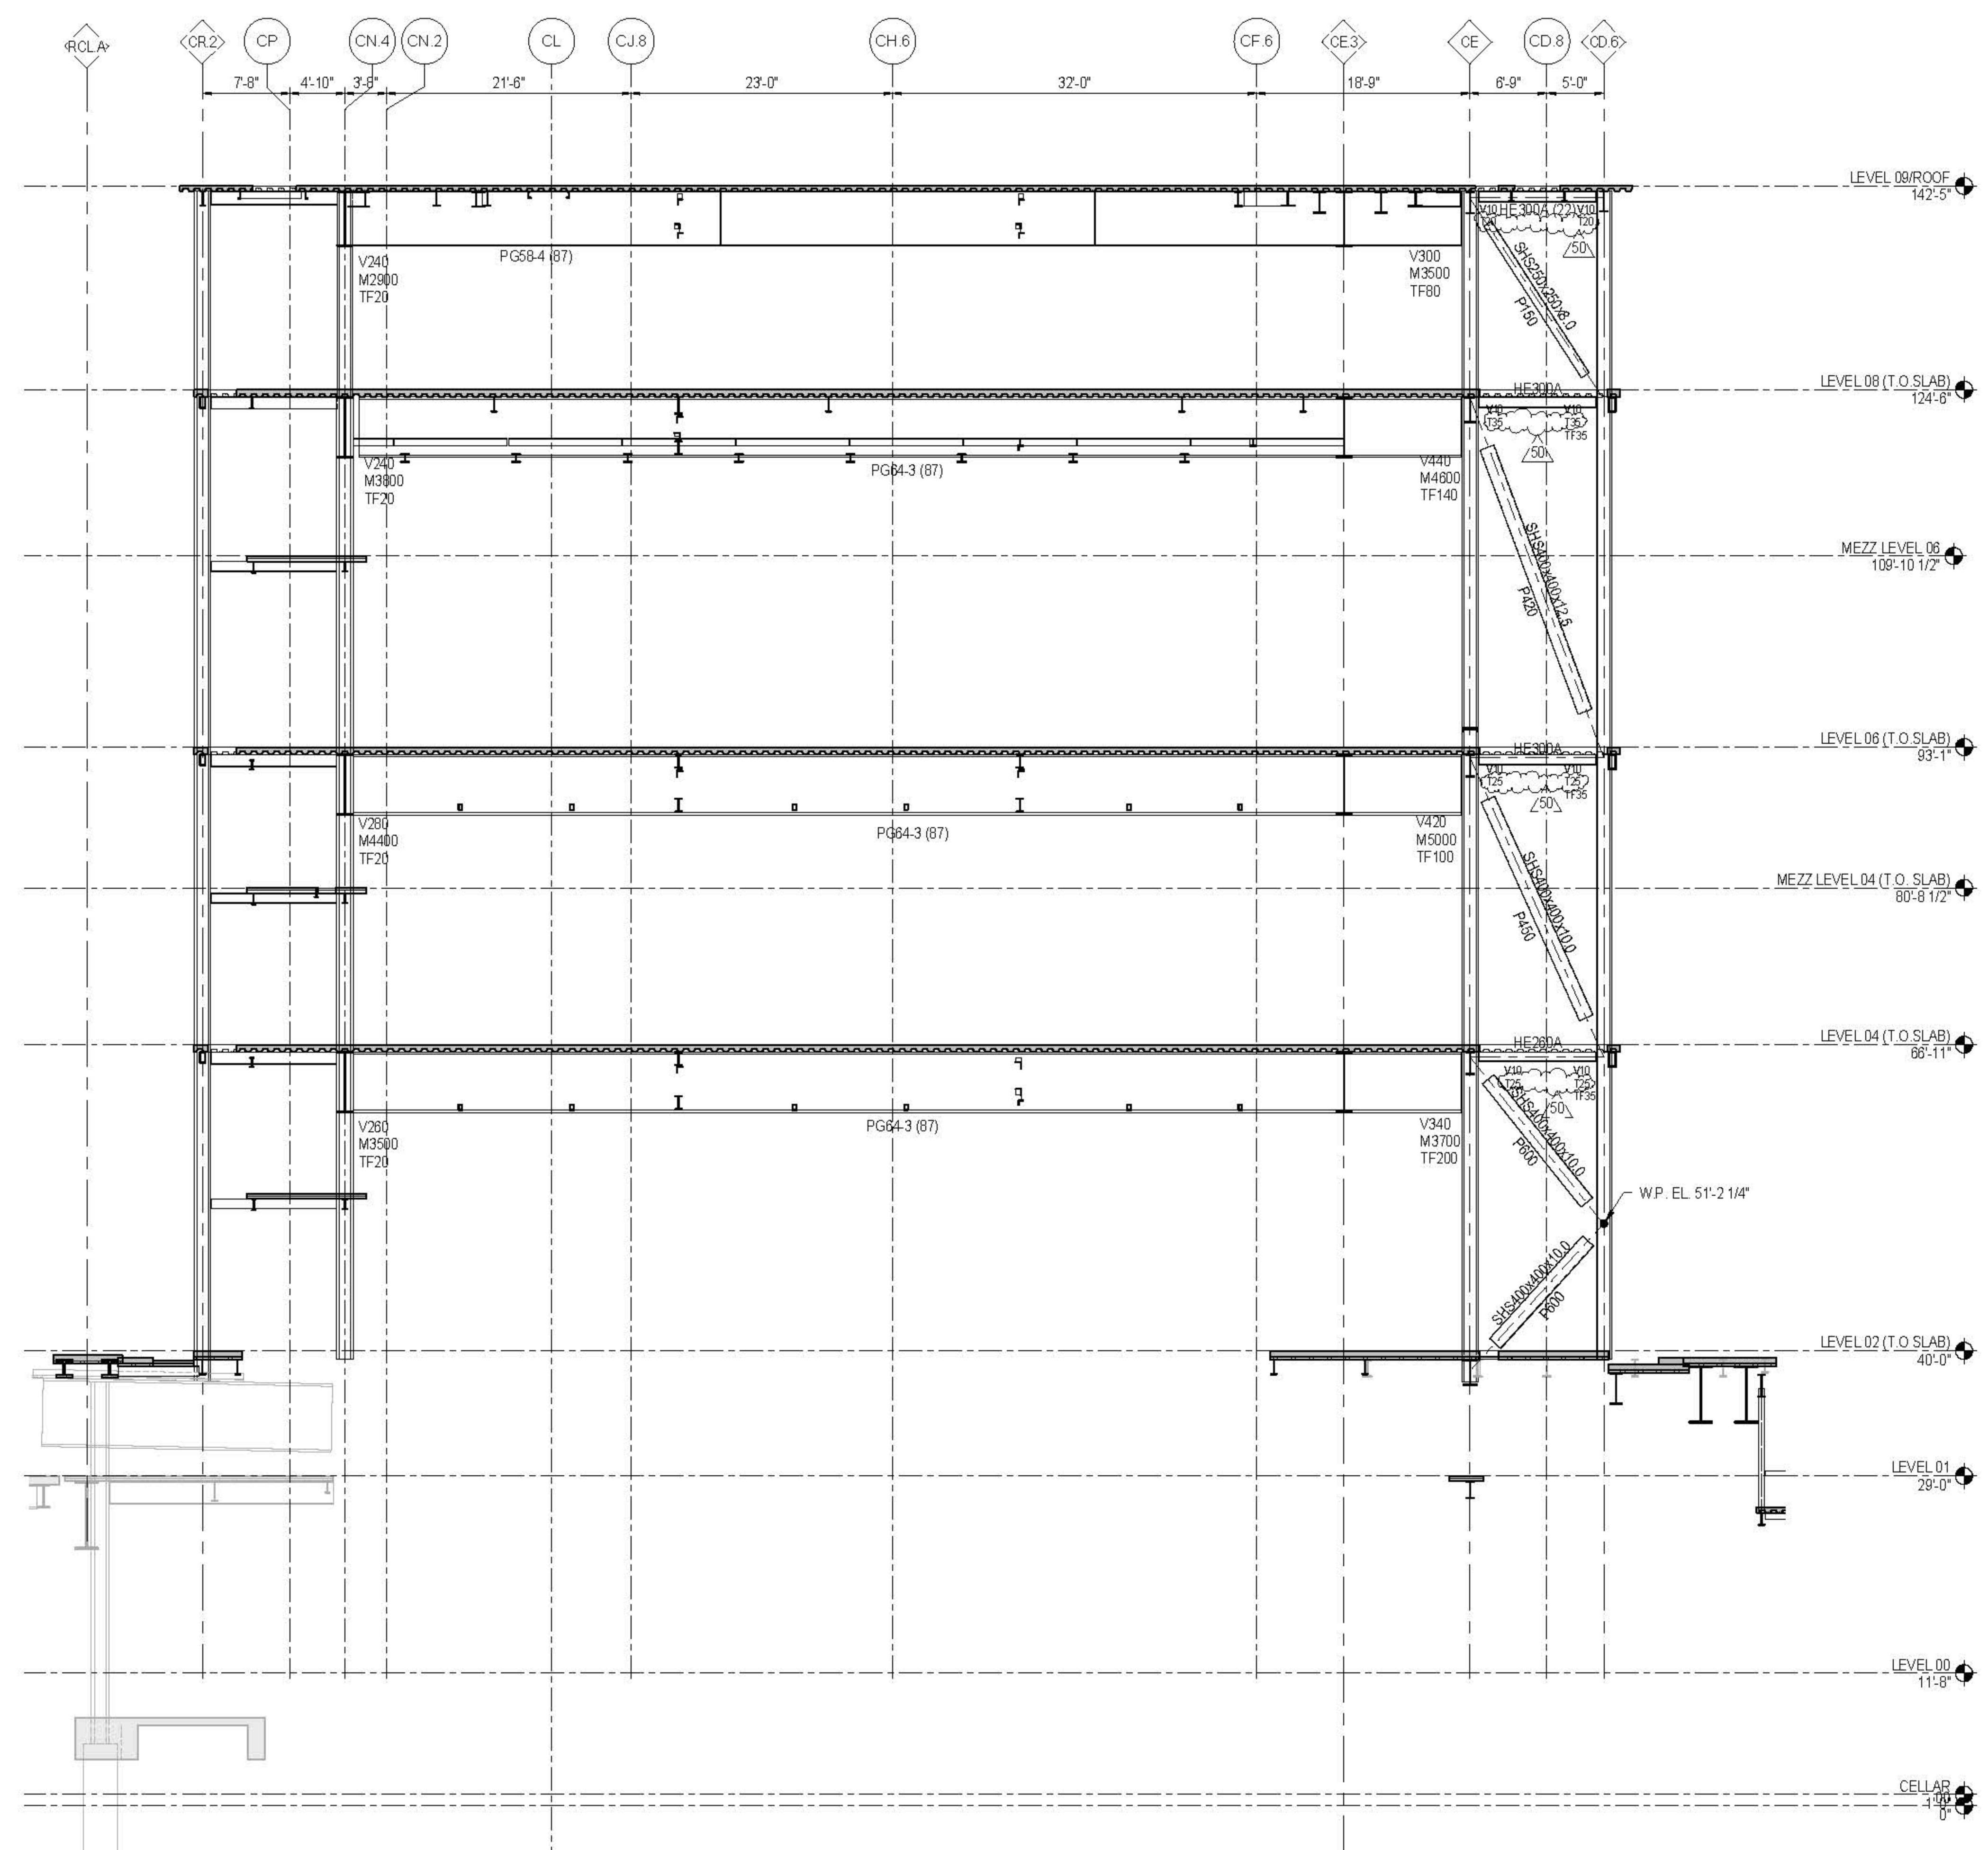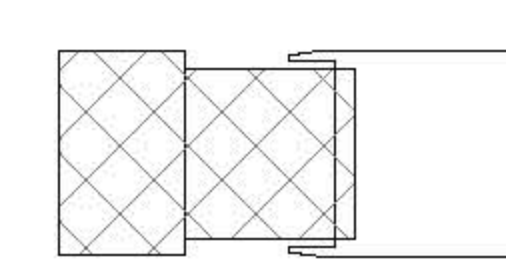

SECTION AT GRID LINE C44.2
WB = T-O

GENERAL BRACED FRAME NOTES:

- REFER TO PLANS FOR TOP STEEL ELEVATIONS AND FOR GRIDLINE DIMENSIONS
- ALL FORCES (R/PS) ARE FACTORED AND ARE TO BE CONSIDERED FULLY REVERSIBLE UNLESS OTHERWISE NOTED AS FOLLOWS:
+XXX INDICATES TENSION ONLY
-XXX INDICATES COMPRESSION ONLY
- IF NOT INDICATED DESIGN BRACED FRAME BEAM TO COLUMN CONNECTIONS FOR A MINIMUM TRANSFER FORCE OF XX KIPS
- SEE TYPICAL BRACE CONNECTION DETAILS
- ALL BRACE AND BEAM MEMBERS ARE ORIENTED WEB VERTICAL UNLESS OTHERWISE NOTED ON ELEVATION AS FOLLOWS:
(H) INDICATES MEMBER WITH WEB ORIENTED HORIZONTAL
- SEE PLAN FOR COLUMN ORIENTATION
- SEE STEEL COLUMN SCHEDULE FOR SHEAR BASE MARK AND SCHEDULE
- SEE STEEL BEAM LEGEND ON FRAMING PLAN FOR KEY TO BEAM DATA AND FOR FORCES NOT SHOWN
- ALL BRACED FRAME LINE DIAGRAMS DENOTE CENTERLINES FOR BEAMS AND COLUMNS AND WORKING LINES FOR BRACES (SEE BRACE DETAILS)
- MINIMIZE UNBRACED LENGTH OF GUSSET AT BRACE TO GUSSET CONNECTIONS

LEGEND:

- TFXX INDICATES FACTORED AXIAL FORCE TRANSFERRED THROUGH THE CONNECTION JOINT INTO THE FAR MEMBER IN KIPS
- TSXX INDICATES FACTORED TENSION COLUMN SPUCE FORCE OR NET UPLIFT AT BASE IN KIPS
SEE TENSION / MOMENT COLUMN SPUCE DETAIL
- EPX INDICATES SHEAR EMBED PLATE
SEE SCHEDULE AND NOTE 7 ABOVE

ISSUE PRINTING DATE


ISSUE	PRINTING	DATE
01	01	08/19/2016
11	6	04/10/2015
10	4	03/18/2015
9	3	02/16/2015
8	2	12/10/2014
1	1	06/16/2014

STAMP



DRAWN BY: *Autum* CHECKED BY: *Chris*
PROJECT NUMBER: N11318.00

TITLE: BRACING ELEVATIONS FIXED BUILDING IV

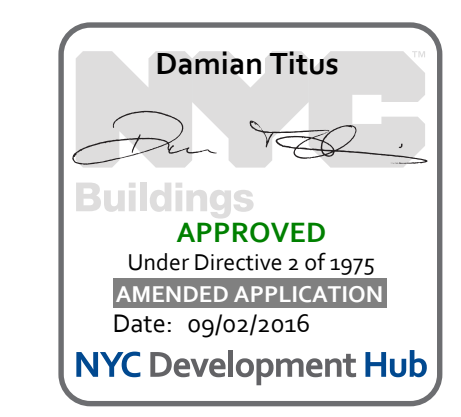

DRAWING NO. S-304.01

B.SCAN NO. S-304.01

38 of 123

CULTURE SHED
545 West 30th Street
New York, New York 10001
OWNER
CULTURE SHED INC.

GEOMETRY, DIMENSIONS AND SURFACE CONTOURING, BLENDING AND INTERSECTION OF SECTIONS ILLUSTRATED IN THE STRUCTURAL DRAWINGS ARE PROVIDED FOR REFERENCE AND GENERATION OF STRUCTURAL ARRANGEMENT AND DETAILS ONLY. THE 3D MODEL ISSUED BY THE ARCHITECT DEFINES THE EXTERIOR SURFACE AND SHALL BE ADHERED TO FOR THE FINAL GEOMETRY. FOR DETAILS OF SECONDARY STEEL, INCLUDING STRUCTURAL CLADDING REFER TO ARCHITECTURE DRAWINGS. IT IS THE RESPONSIBILITY OF THE CONTRACTOR TO IDENTIFY ANY DISCREPANCIES OR AMBIGUITIES FOR DISCUSSION, RESOLUTION AND DIRECTION FROM THE ARCHITECT AND SER.

ARCHITECTS
Oller Scaletta + Renfro Architects, DPC
601 West 26 Street #815
New York, New York 10001
T: 212.260.7971

rackworkgroup
5 Union St. West, 6th Fl.
New York, New York 10003
T: 212.463.0334
F: 212.463.0335

STRUCTURAL ENGINEER
Thornton Tomasetti
51 Madison Avenue
New York, New York 10010
T: 917.661.7800
F: 917.661.7811

MEP ENGINEER
Jans Baum & Bolles
60 Park Street
New York, New York 10005
T: 212.530.9300
F: 212.260.6944

FAÇADE CONSULTANT
Thornton Tomasetti
51 Madison Avenue
New York, New York 10010
T: 917.661.7800
F: 917.661.7811

KINETICS ENGINEER
Hardisty & Hanover
1501 Broadway
New York, New York 10036
T: 212.944.1150
F: 212.391.0297

LIGHTING DESIGNER
Tilstone Design Associates
40 North Street #1650
New York, New York 10013
T: 212.675.7760

THEATRE PLANNING & DESIGN
Fisher Dodge Associates
22 West 19th Street
New York, New York 10011
T: 212.691.3000

LIFE SAFETY
Code Consultants, Inc.
215 West 43rd St, 15th Fl.
New York, New York 10018
T: 212.216.9596

ENERGY MODEL/LEED
Vindian
50 Washington Street
Norwalk, CT 06854
T: 203.298.1411

ACOUSTIC/AUDIO-VISUAL
Avalon
50 North Main Street
South Norwalk, CT 06854
T: 347.210.5540

VERTICAL TRANSPORTATION
Van Duunen & Associates
5 Regent Street, Suite 524
Lakewood, NJ 07038
T: 973.994.9220

SPECIFICATIONS
Construction Specifications Inc.
PO Box 489
227 Fenwick Road
Morristown, NJ 07751
T: 732.970.0700
F: 732.970.0700


SECURITY
Duchella Venter & Santoro
1100 Sherman Avenue
Hartford, CT 06114
T: 203.286.6490

WATERPROOFING
James R. Gahfort AIA Consulting Architects PC
104 West 27th Street
New York, NY 10001
T: 212.736.3344


FAÇADE MAINTENANCE
Frank Engineering PLLC
166 Area Street
New York, NY 10005
T: 212.698.3000

BRANDING GRAPHICS
2nd Global Design Consultancy
180 Varck Street 15th Floor
New York, NY 10014
T: 212.647.1170

KEY PLAN

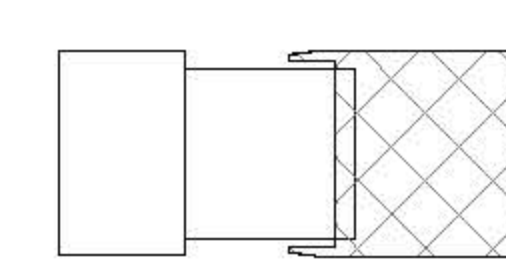

ISSUE	PRINTING	DATE	
63	60	DOB AMENDMENT 7	03.19.2016
44	39	DOB AMENDMENT 6	04.09.2016
21		CONSTRUCTION SET	10.08.2015
10	4	100% CONSTRUCTION DOCUMENTS	03.18.2015
9		90% CONSTRUCTION DOCUMENTS	02.16.2015
6		PRELIMINARY DOB SUBMISSION	12.10.2014
1		ADVANCED PROCUREMENT BID SET	06.16.2014

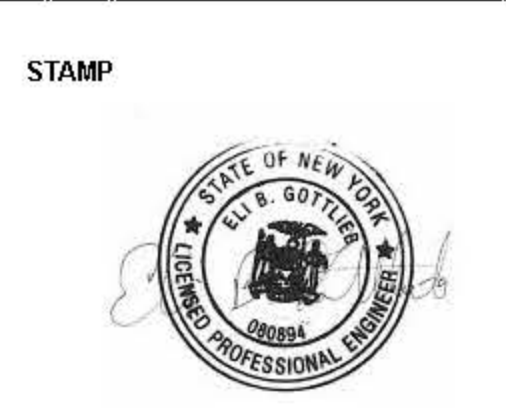


DRAWN BY
Autum

CHECKED BY
Chris

PROJECT NUMBER
N11318.00


TITLE
ELEVATIONS, DEPLOYED SHED

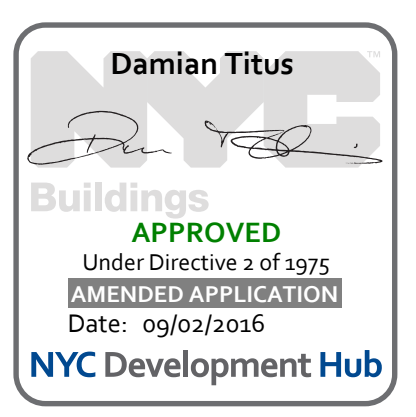


DRAWING NO.
S-351.01

B.SCAN NO.
S-351.01


44 of 123

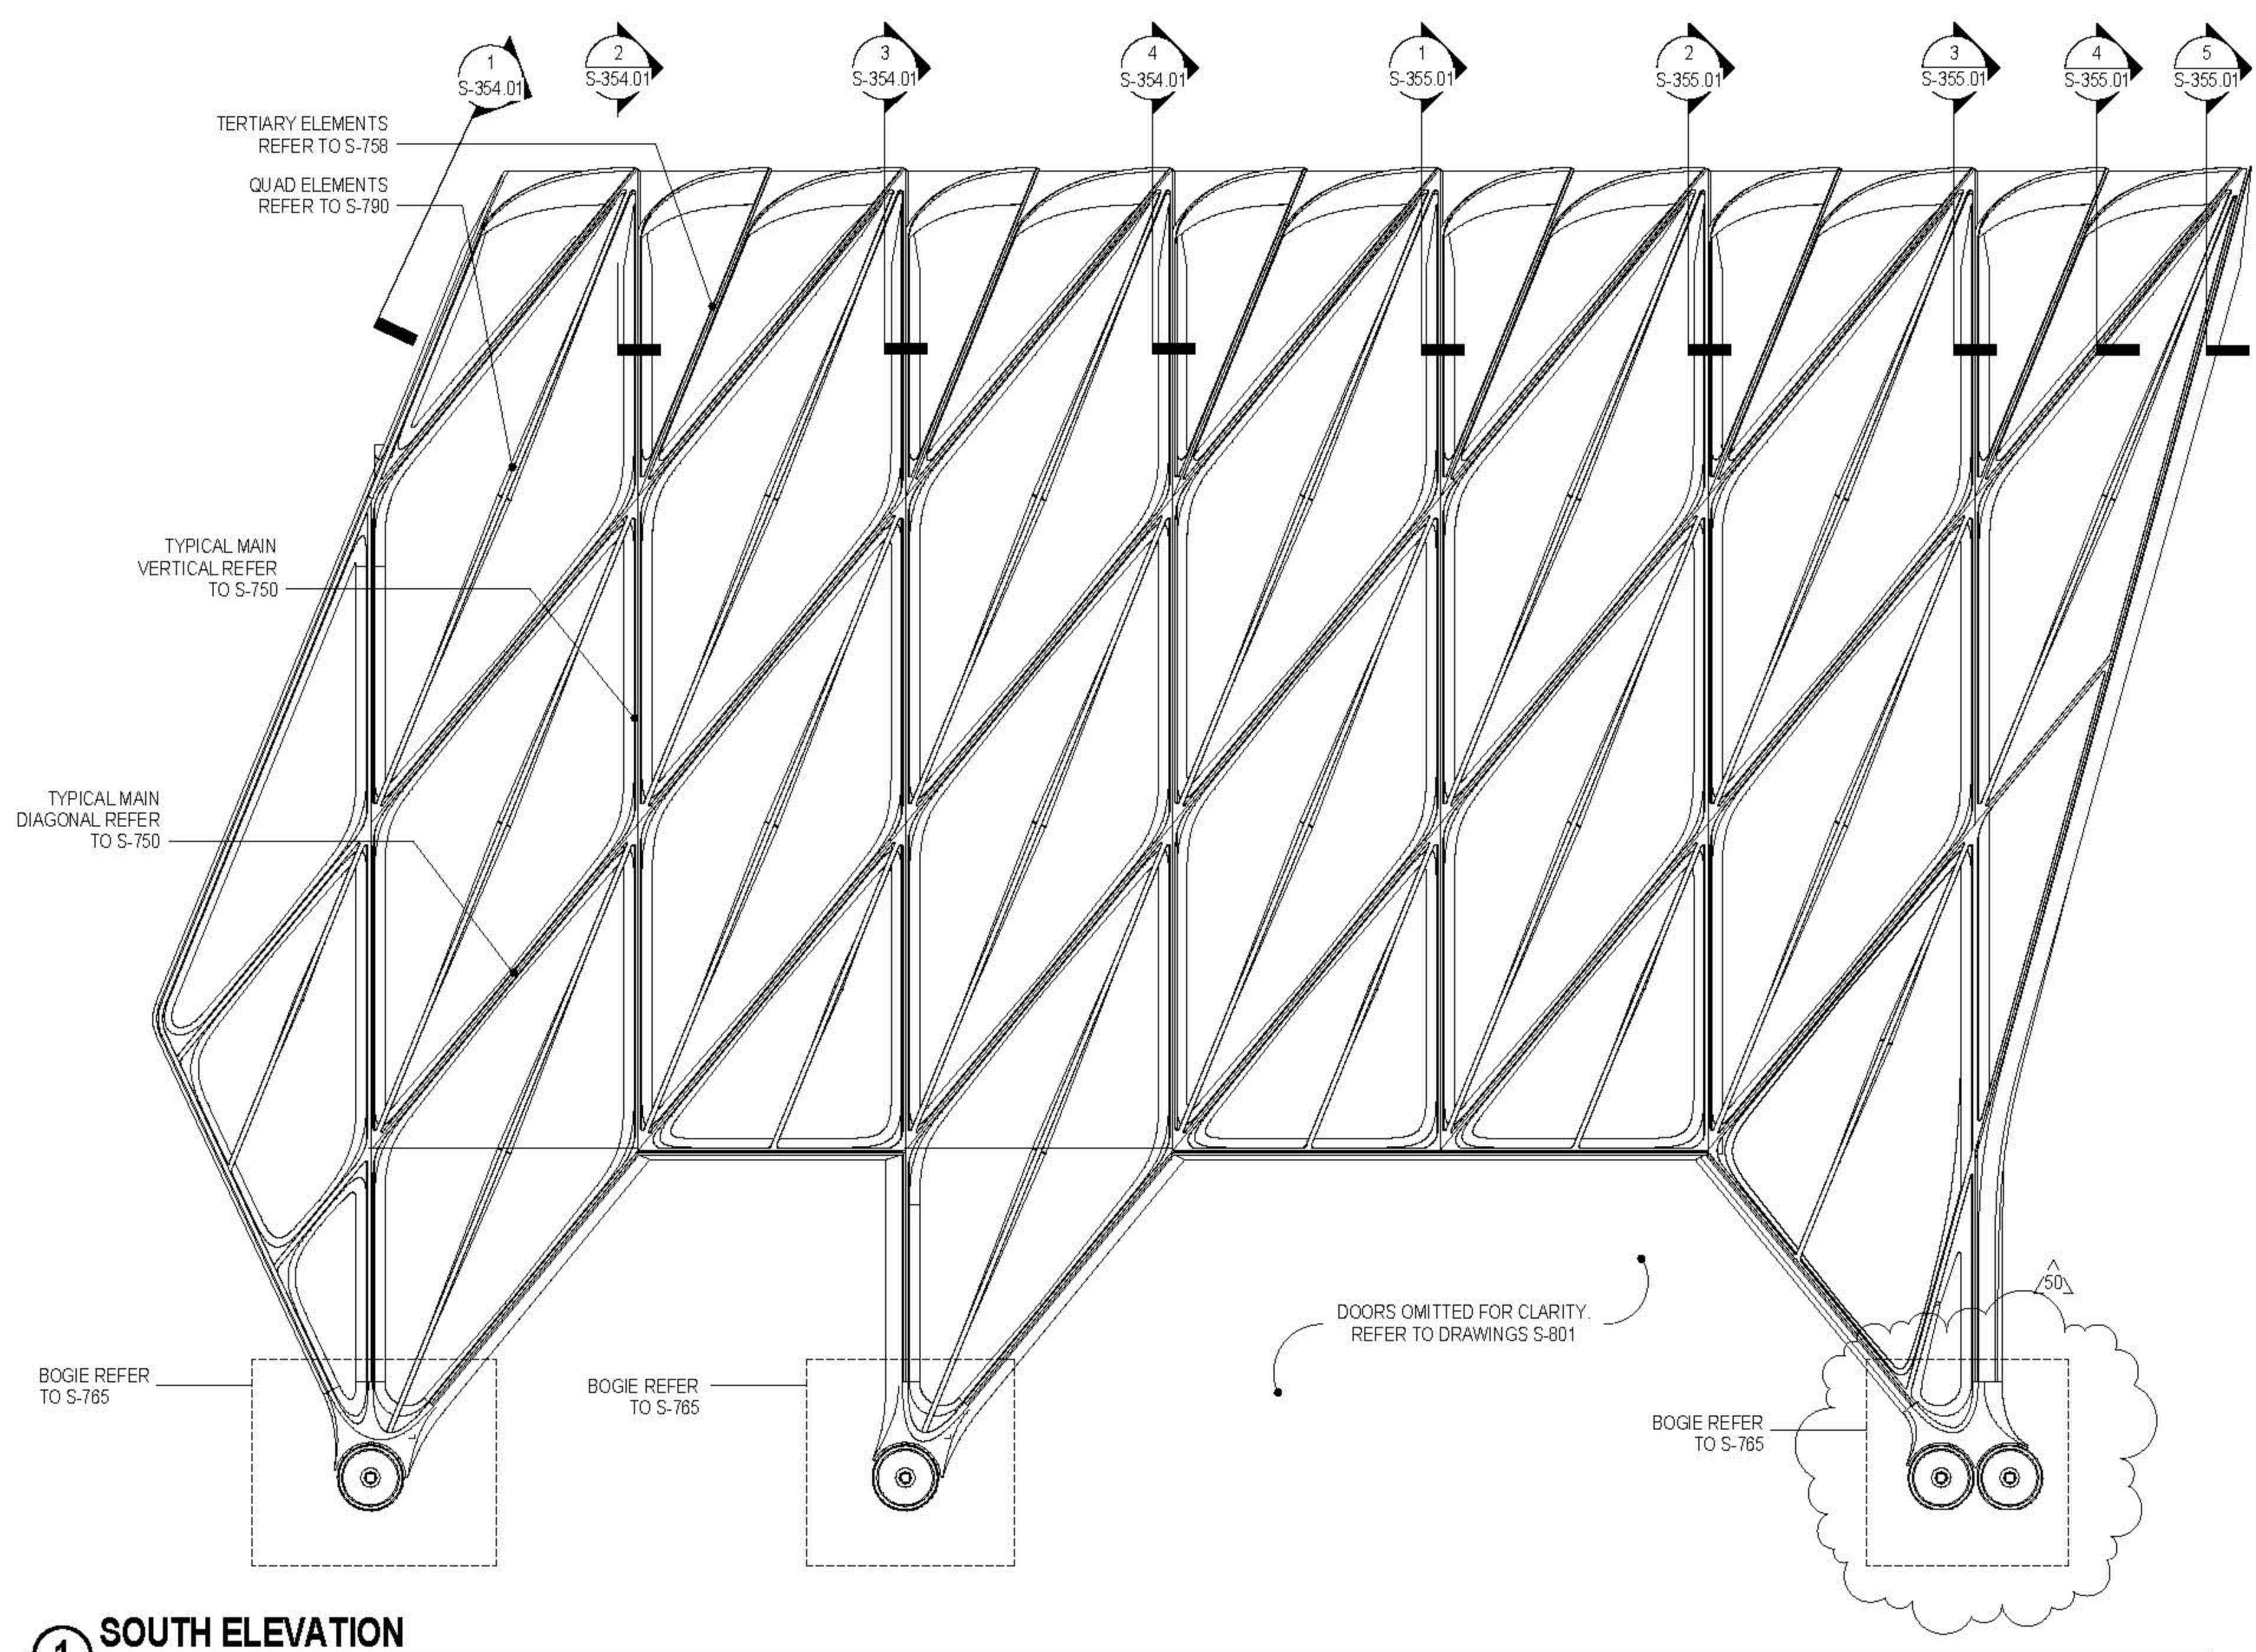

1 SOUTH ELEVATION
3/32" = 1'-0"

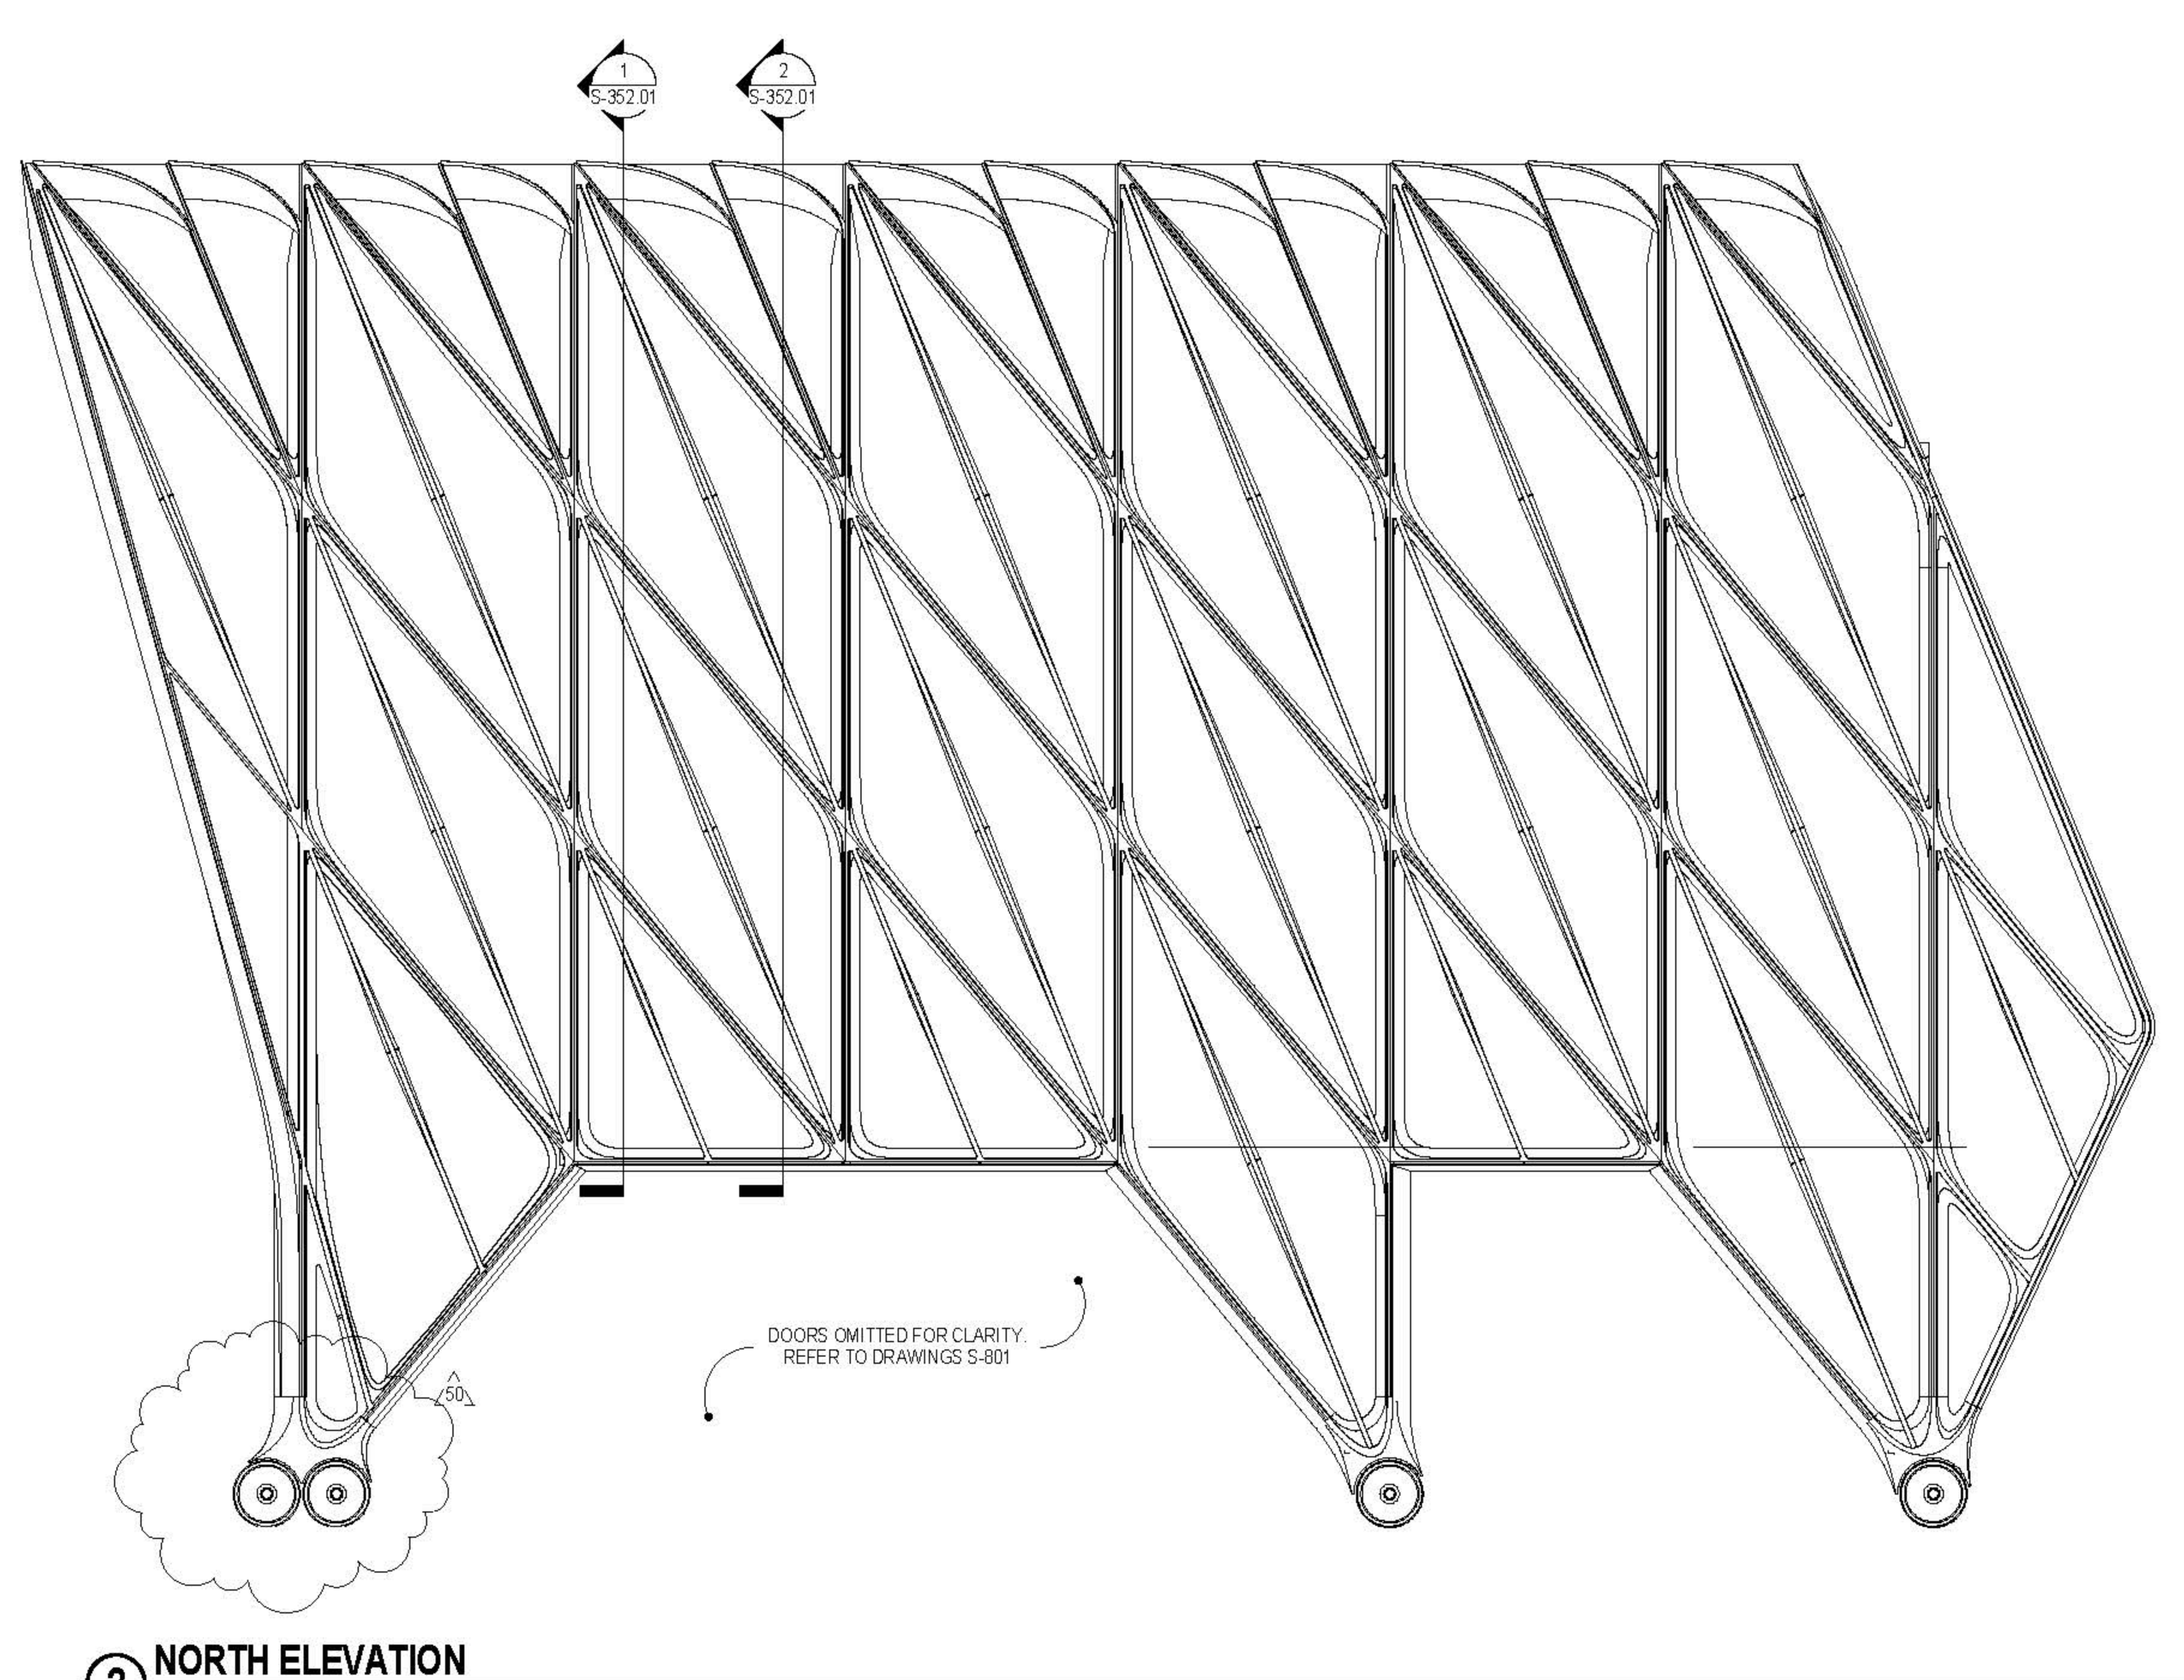

2 NORTH ELEVATION
3/32" = 1'-0"

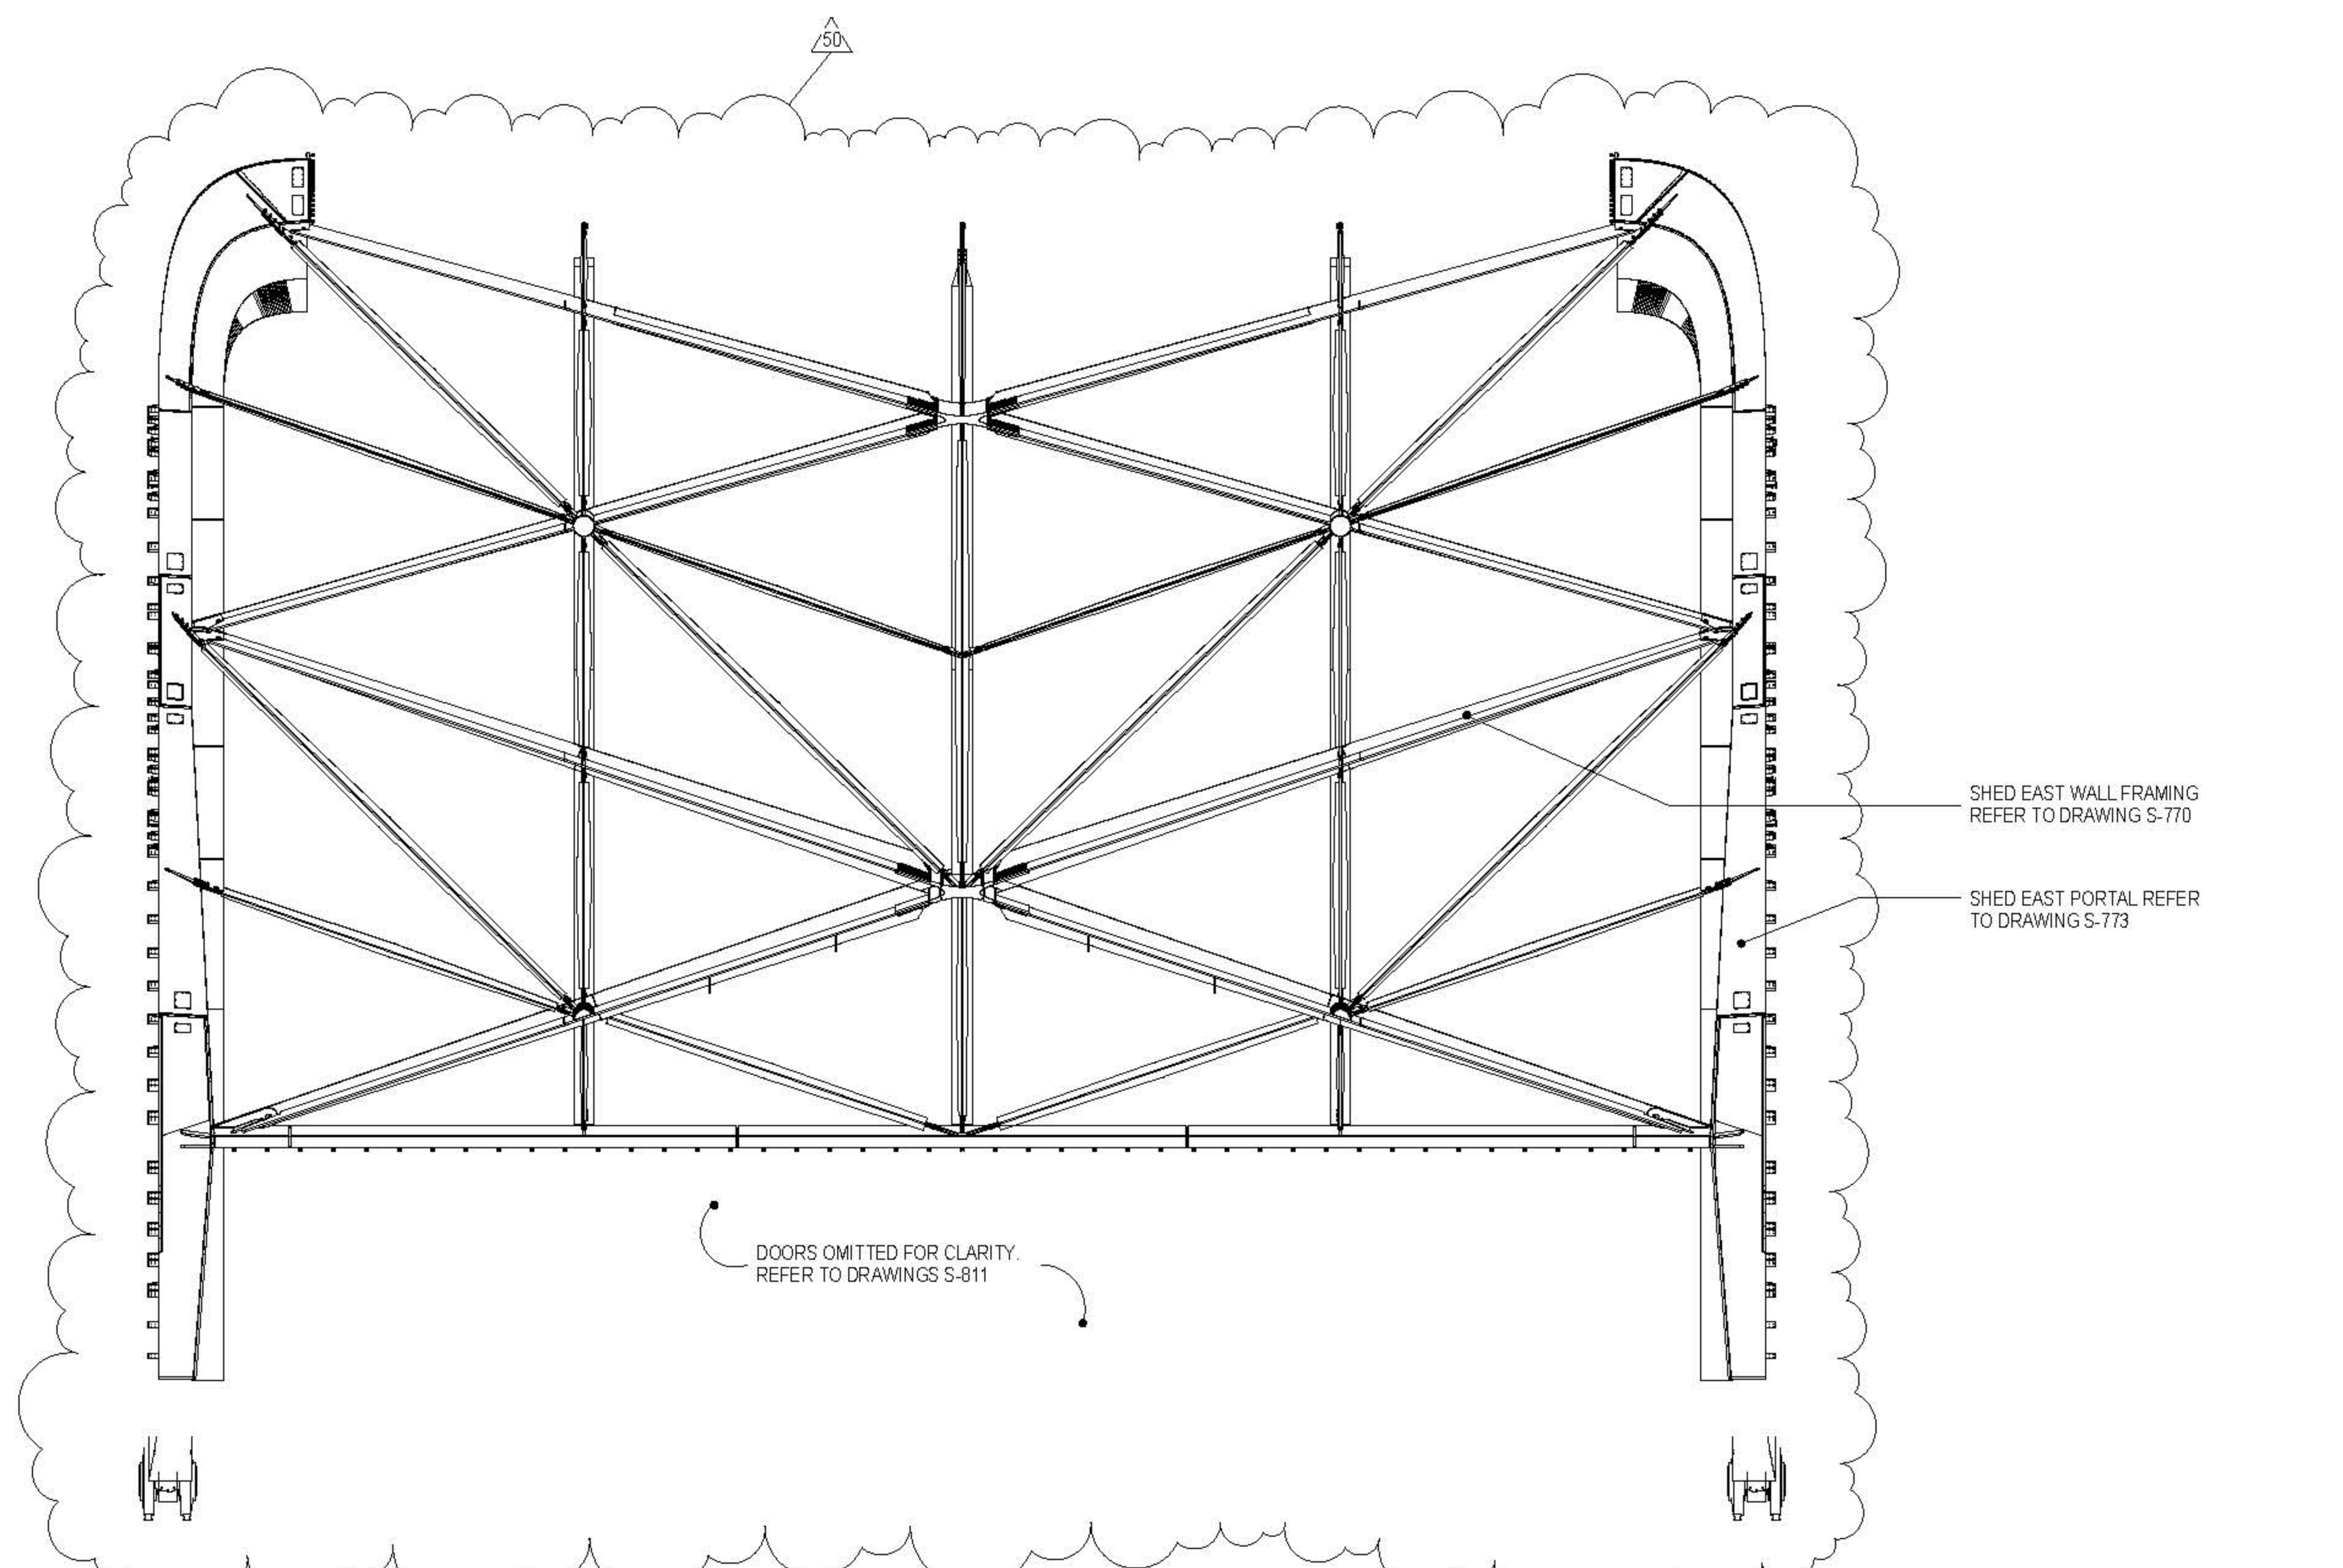

3 EAST ELEVATION
3/32" = 1'-0"

PENDING COORDINATION DURING DESIGN ASSIST.

GEOMETRY, DIMENSIONS AND SURFACE CONTOURING, BLENDING AND INTERSECTION OF SECTIONS ILLUSTRATED IN THE STRUCTURAL DRAWINGS ARE PROVIDED FOR REFERENCE AND GENERATION OF STRUCTURAL ARRANGEMENT AND DETAILS ONLY. THE 3D MODEL ISSUED BY THE ARCHITECT DEFINES THE EXTERIOR SURFACE AND SHALL BE ADHERED TO FOR THE FINAL GEOMETRY. FOR DETAILS OF SECONDARY STEEL, INCLUDING STRUCTURAL CLADDING REFER TO ARCHITECTURE DRAWINGS. IT IS THE RESPONSIBILITY OF THE CONTRACTOR TO IDENTIFY ANY DISCREPANCIES OR AMBIGUITIES FOR DISCUSSION, RESOLUTION AND DIRECTION FROM THE ARCHITECT AND SER.

CULTURE SHED
545 West 30th Street
New York, New York 10001

OWNER
CULTURE SHED INC.

ARCHITECTS
Oller Scaletto + Renfro Architects, DPC
601 West 26 Street #815
New York, New York 10001
T: 212.260.7971

rockwellgroup
5 Union St. West, 6th Fl.
New York, New York 10003
T: 212.463.0334
F: 212.463.0335

STRUCTURAL ENGINEER
Thornton Tomasetti
51 Madison Avenue
New York, New York 10010
T: 917.861.7800
F: 917.861.7801

MEP ENGINEER
Jana Baum & Bolles
50 Pine Street
New York, New York 10005
T: 212.530.9300
F: 212.266.6564

FACADE CONSULTANT
Thornton Tomasetti
51 Madison Avenue
New York, New York 10010
T: 917.861.7800
F: 917.861.7801

KINETICS ENGINEER
Hudess & Hanover
1501 Broadway
New York, New York 10036
T: 212.944.1150
F: 212.391.0297

LIGHTING DESIGNER
Tilston Design Associates
40 North Street #1650
New York, New York 10013
T: 212.675.7760

THEATRE PLANNING & DESIGN
Fisher Dodge Associates
22 West 15th Street
New York, New York 10011
T: 212.691.3000

LIFE SAFETY
Code Consultants, Inc.
215 West 40th St, 15th Fl.
New York, New York 10018
T: 212.216.9596

ENERGY MODEL/LEED
Vindian
50 Washington Street
Norwalk, CT 06854
T: 203.298.1411

ACOUSTIC/AUDIO-VISUAL
Avalon
50 North Main Street
South Norwalk, CT 06854
T: 347.210.5540

VERTICAL TRANSPORTATION
Van Duusen & Associates
5 Regent Street, Suite 524
Livingston, NJ 07039
T: 973.994.9220

SPECIFICATIONS
Construction Specifications Inc.
PO Box 489
227 Tenth Road
Morganville, NJ 07751
T: 732.970.0700
F: 732.970.0700


SECURITY
Duchella Venter & Santoro
1100 Sherman Avenue
Hartford, CT 06114
T: 203.286.6490

WATERPROOFING
James R. Galkoff AIA Consulting Architects PC
104 West 27th Street
New York, NY 10001
T: 212.736.3344

FACADE MAINTENANCE
Erick Engineering PLLC
186 Ave. Street
New York, NY 10005
T: 212.986.3000

BRANDING/GRAPHICS
2nd Global Design Consultancy
180 Varck Street 15th Floor
New York, NY 10014
T: 212.647.1170

KEY PLAN

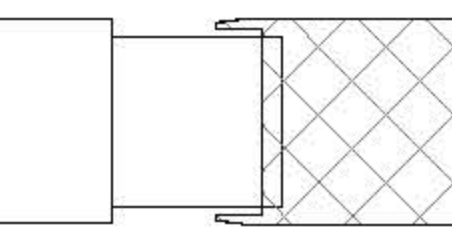

ISSUE PRINTING DATE

ISSUE	PRINTING	DATE
63	60	DOB AMENDMENT 7 03/19/2016
44	30	DOB AMENDMENT 6 04/02/2016
21		CONSTRUCTION SET 10/08/2015
10	4	100% CONSTRUCTION DOCUMENTS 03/18/2015
9		90% CONSTRUCTION DOCUMENTS 02/16/2015
6		PRELIMINARY CDR SUBMISSION 12/10/2014
1		ADVANCED PROCUREMENT BID SET 06/16/2014

STAMP



DRAWN BY: Audrey
CHECKED BY: Chris M

PROJECT NUMBER: N11318.00


TITLE: SECTIONS, DEPLOYED SHED

DRAWING NO.: S-352.01


B.SCAN NO.: 45 of 123

S-352.01


45 of 123

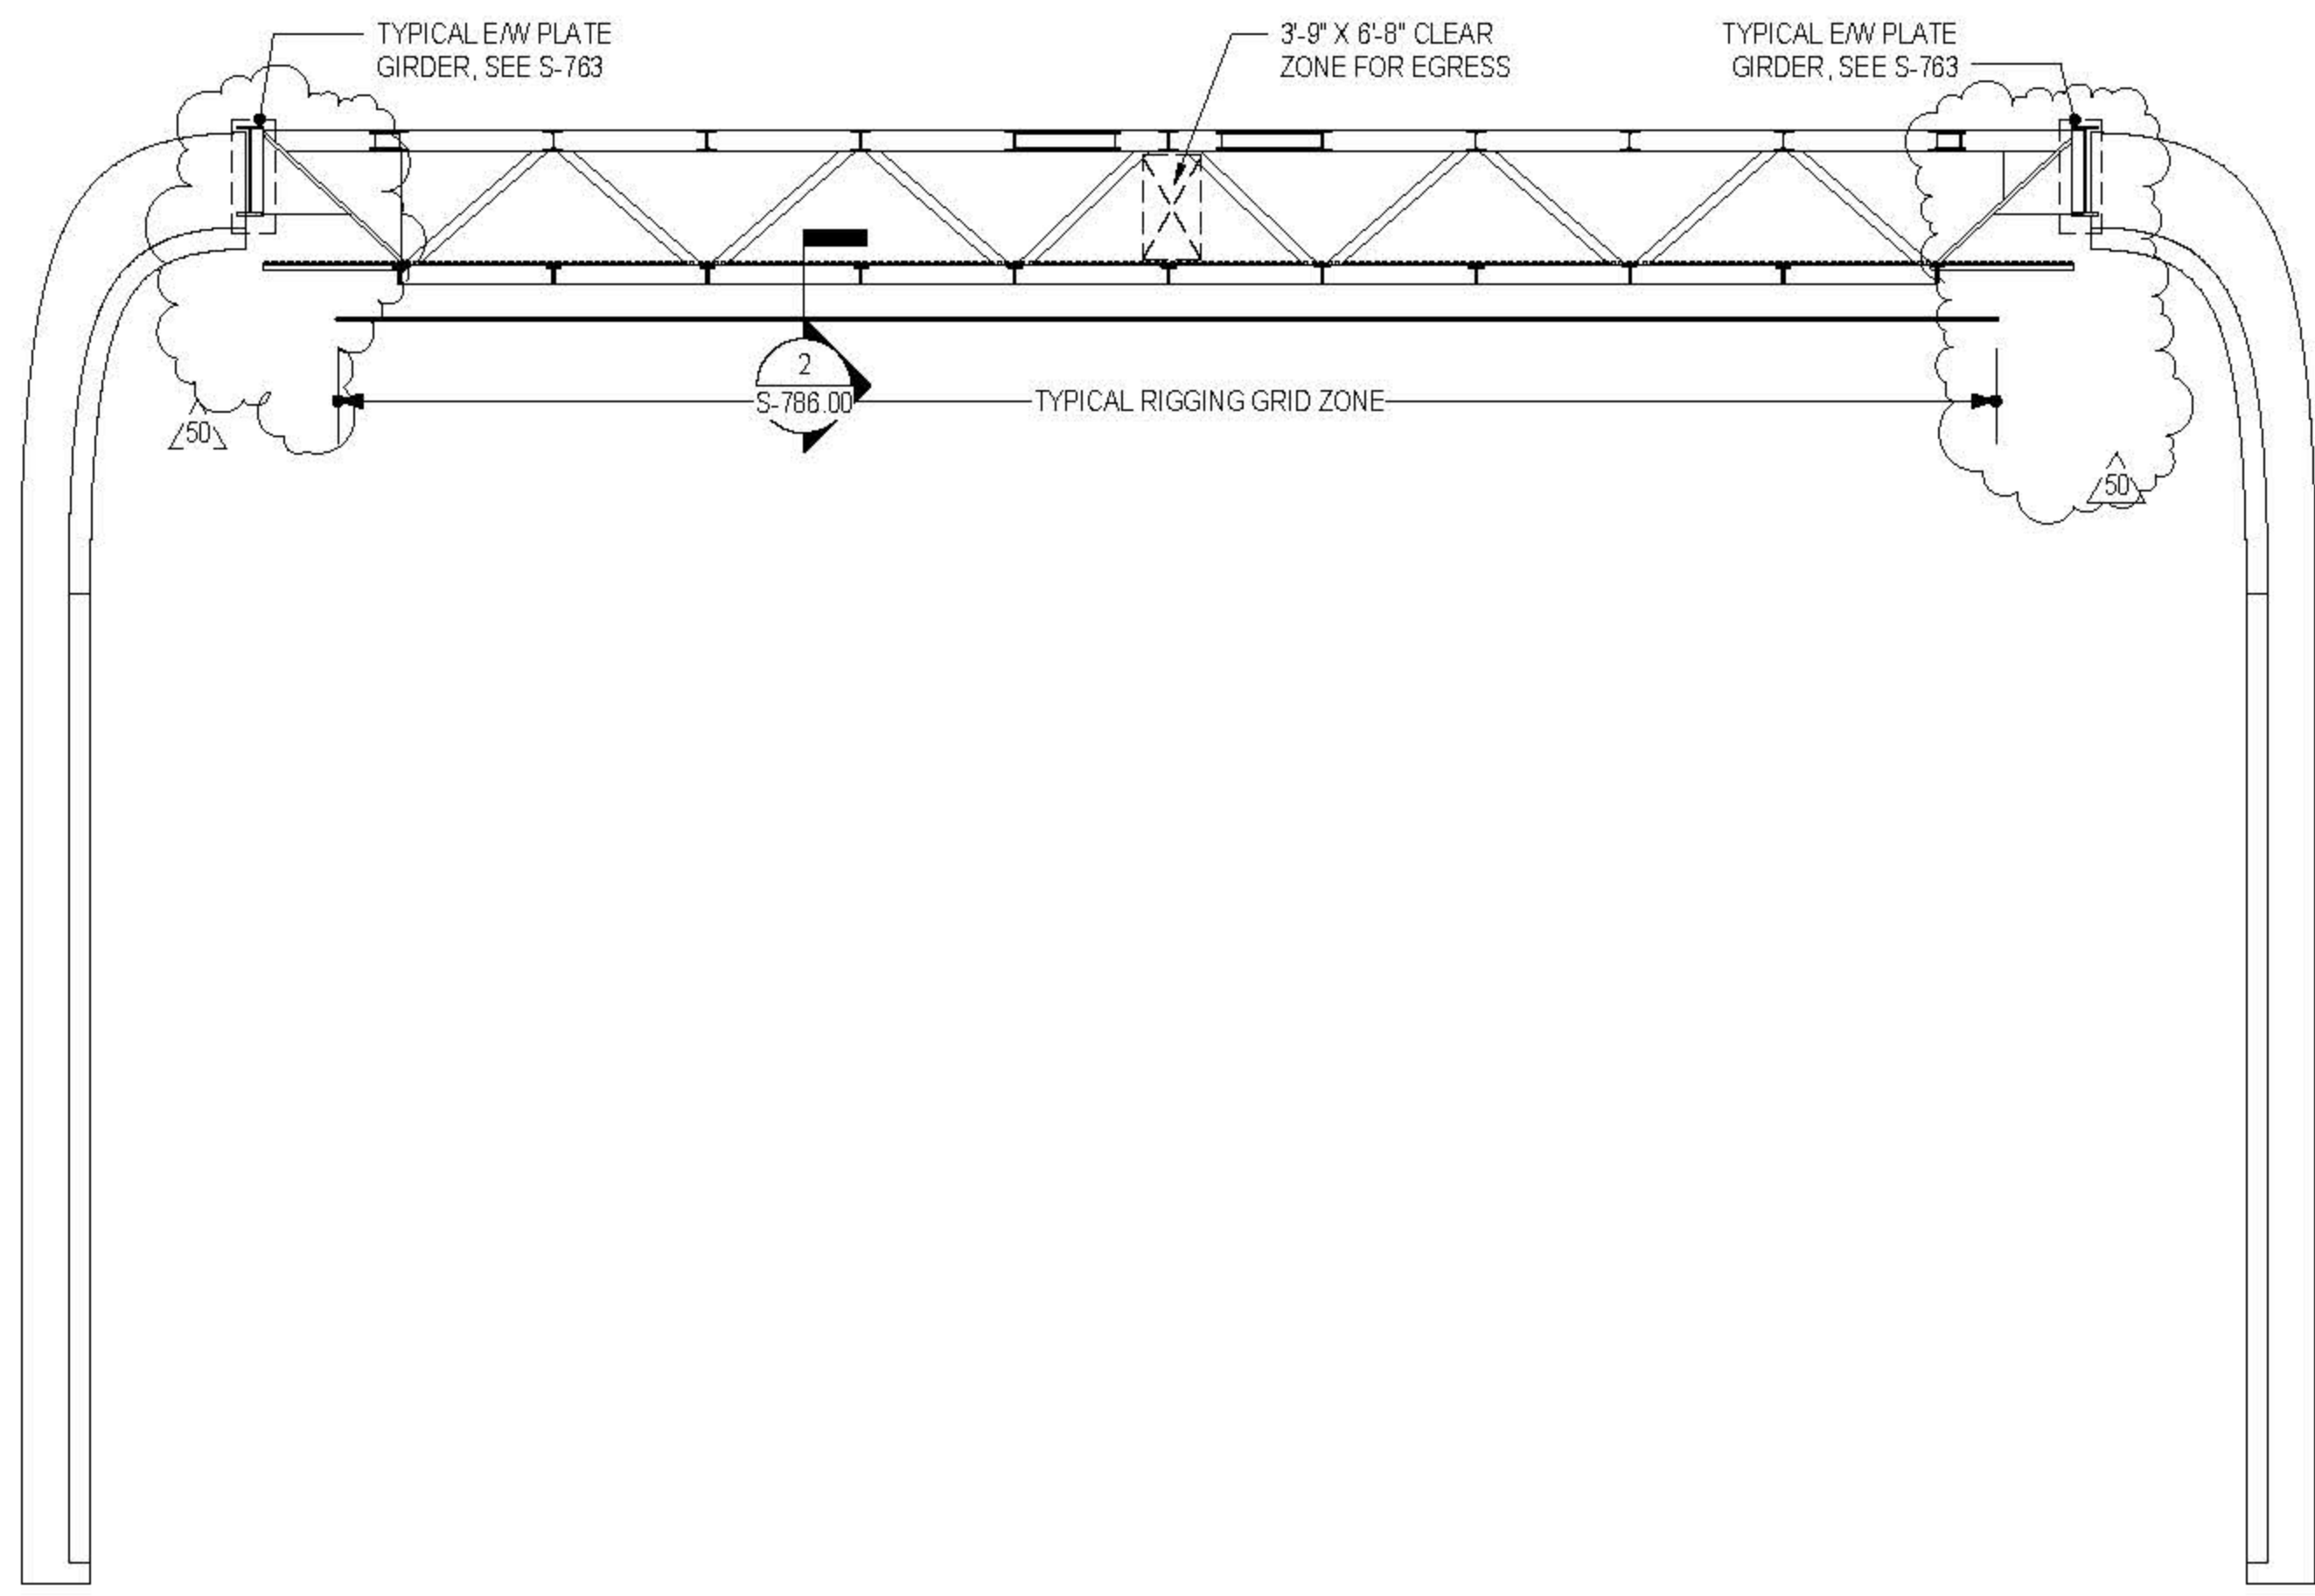

1 TYPICAL SECTION AT TRUSSES
3/32" = 1'-0"

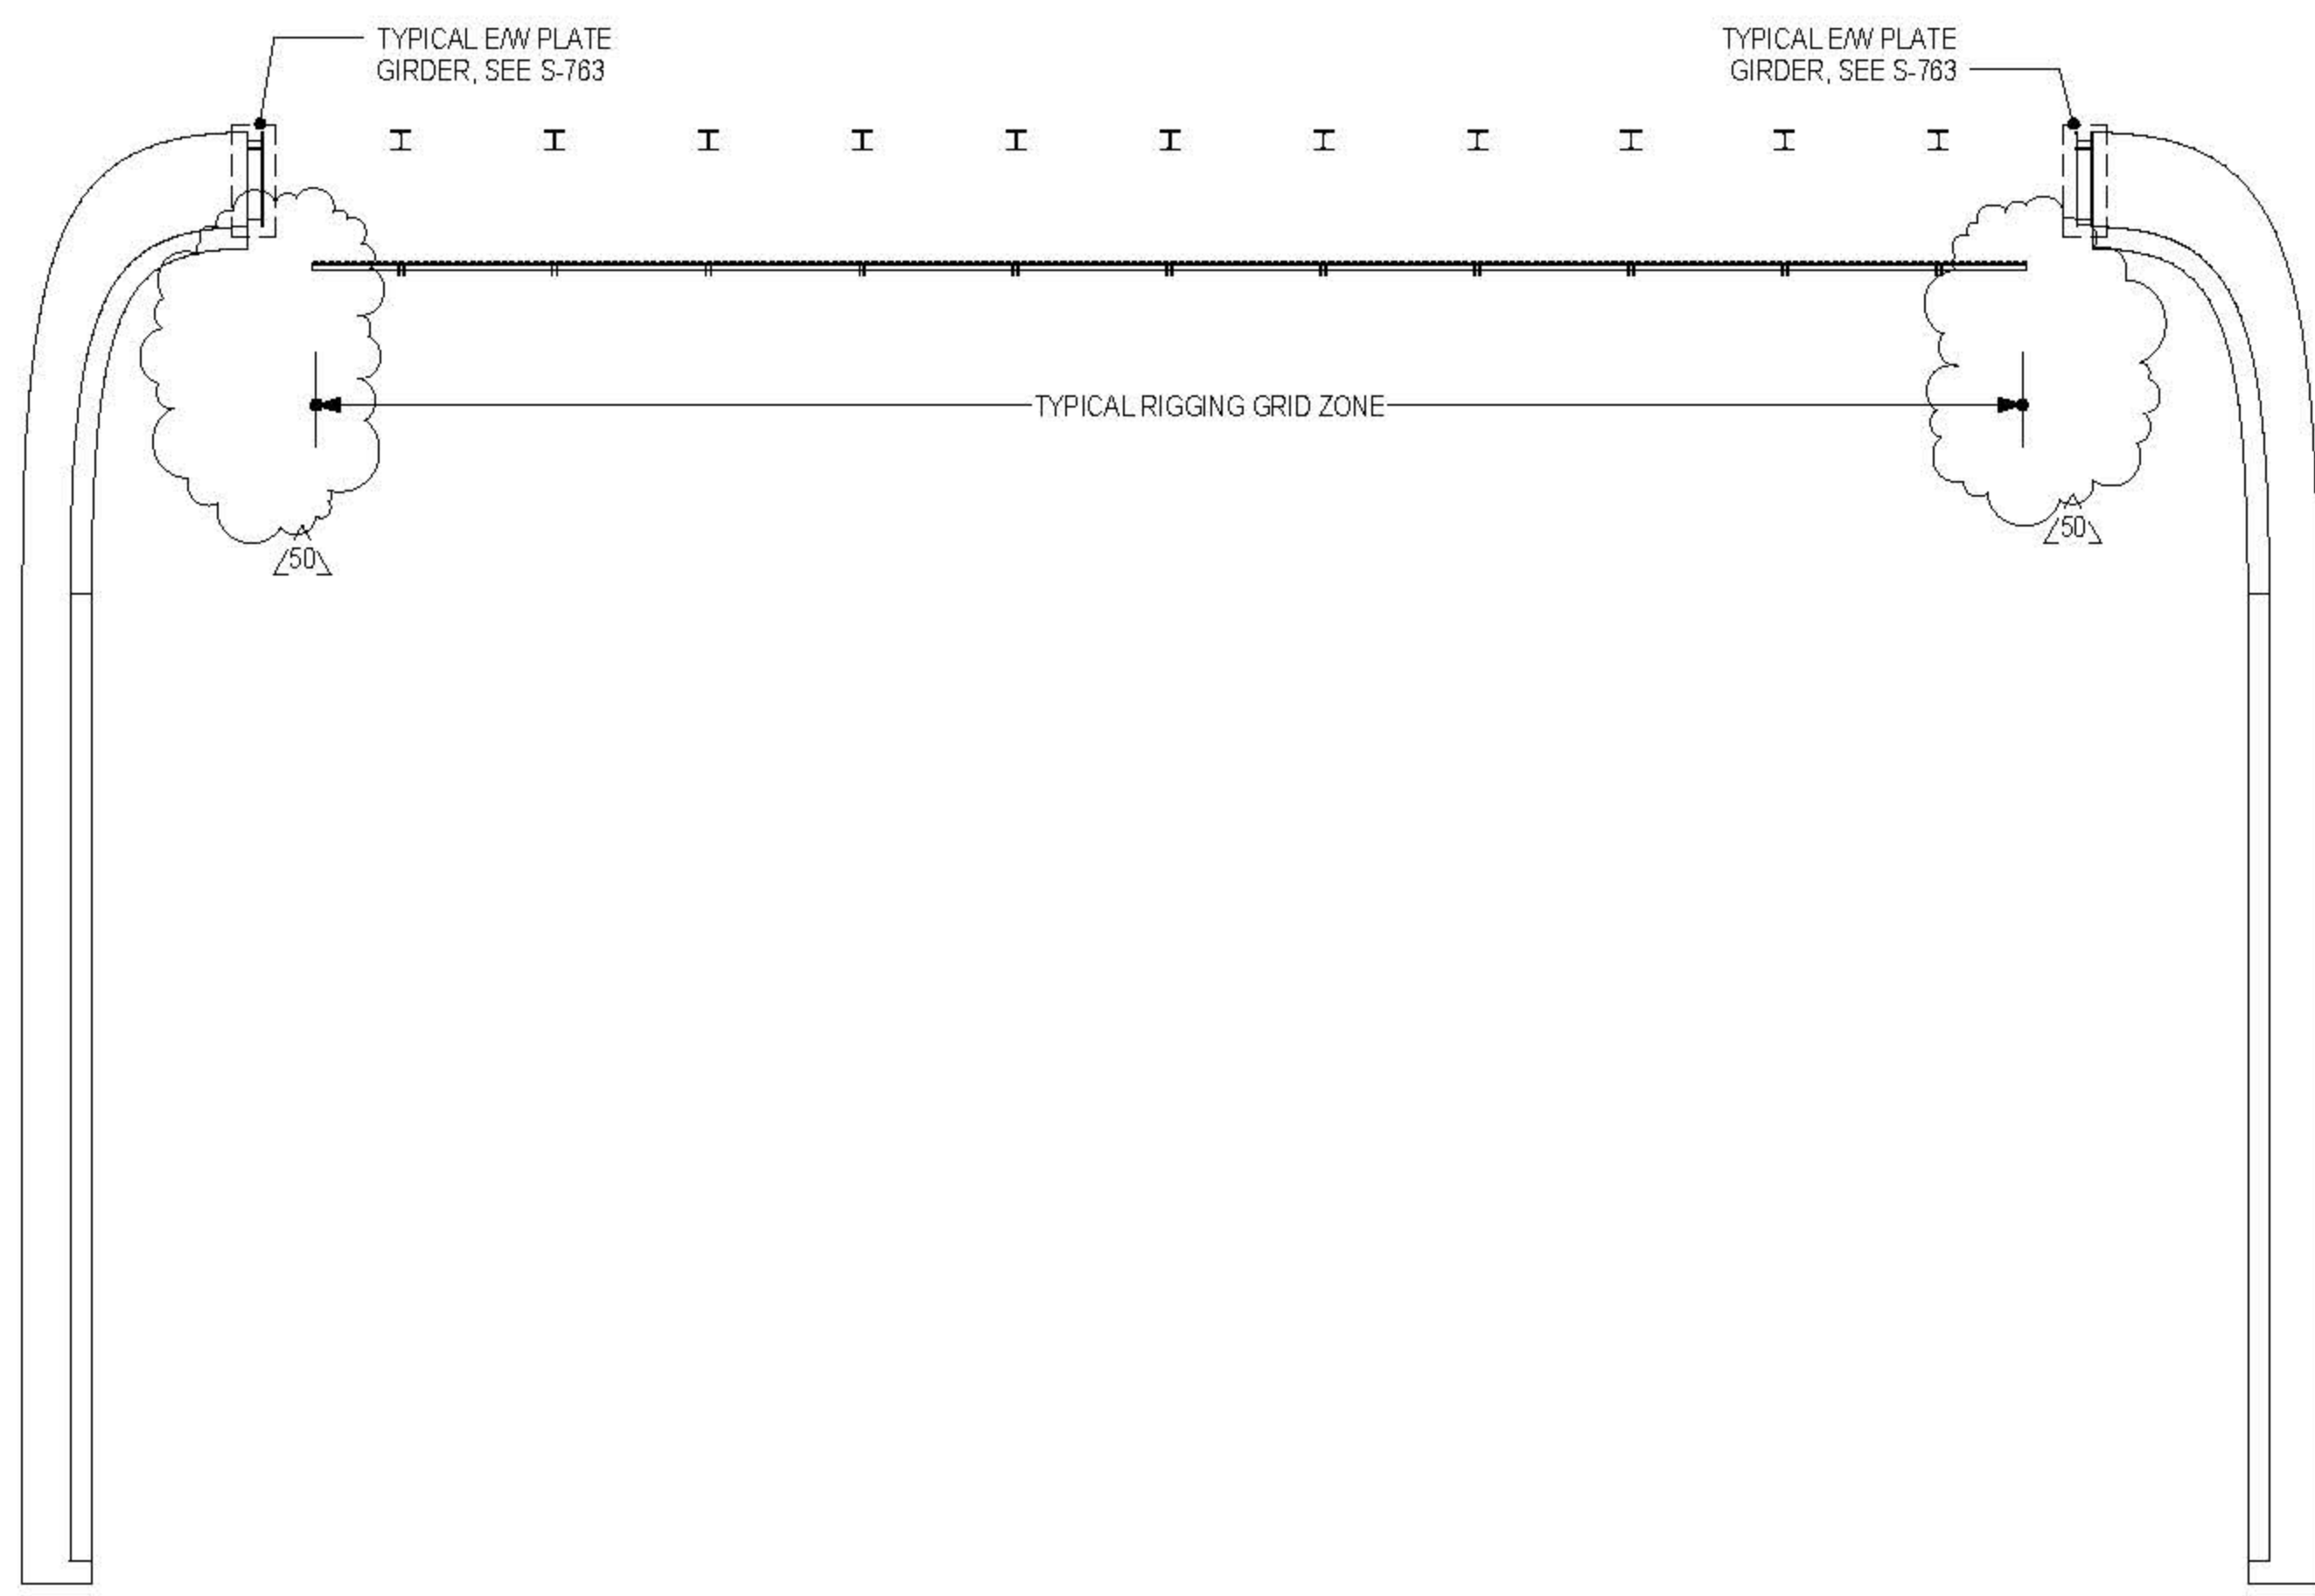

2 TYPICAL SECTION BETWEEN TRUSSES
3/32" = 1'-0"

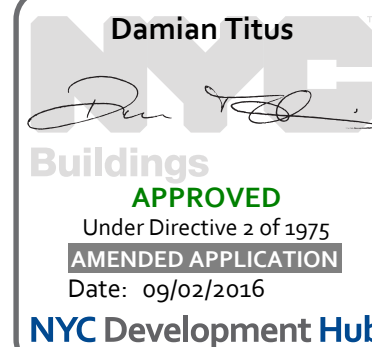

PENDING COORDINATION DURING DESIGN ASSIST.

CULTURE SHED
 545 West 30th Street
 New York, New York 10001
 OWNER: CULTURE SHED INC.

GEOMETRY, DIMENSIONS AND SURFACE CONTOURING, BLENDING AND INTERSECTION OF SECTIONS ILLUSTRATED IN THE STRUCTURAL DRAWINGS ARE PROVIDED FOR REFERENCE AND GENERATION OF STRUCTURAL ARRANGEMENT AND DETAILS ONLY. THE 3D MODEL ISSUED BY THE ARCHITECT DEFINES THE EXTERIOR SURFACE AND SHALL BE ADHERED TO FOR THE FINAL GEOMETRY. FOR DETAILS OF SECONDARY STEEL, INCLUDING STRUCTURAL CLADDING REFER TO ARCHITECTURE DRAWINGS. IT IS THE RESPONSIBILITY OF THE CONTRACTOR TO IDENTIFY ANY DISCREPANCIES OR AMBIGUITIES FOR DISCUSSION, RESOLUTION AND CLARIFICATION FROM THE ARCHITECT AND SEER.

FOR TYPICAL NORTH/SOUTH TRUSS DETAILS REFER TO DRAWING S-788

ARCHITECTS
 Office Scullin + Renfro Architects, P.C.
 601 West 26 Street #815
 New York, New York 10001
 T: 212.463.0334
 F: 212.463.0335

STRUCTURAL ENGINEER
 Thornton Tomasetti
 51 Madison Avenue
 New York, New York 10010
 T: 917.561.7800
 F: 917.561.7801

MEP ENGINEER
 Jans Baum & Bolles
 60 Park Street
 New York, New York 10005
 T: 212.530.9300
 F: 212.266.6944

FACADE CONSULTANT
 Thornton Tomasetti
 51 Madison Avenue
 New York, New York 10010
 T: 917.561.7800
 F: 917.561.7801

KINETICS ENGINEER
 Hadesky & Hanover
 1501 Broadway
 New York, New York 10036
 T: 212.944.1150
 F: 212.391.0337

LIGHTING DESIGNER
 Tiltcon Design Associates
 40 North Street #160
 New York, New York 10011
 T: 212.691.3000

THEATRE PLANNING & DESIGN
 Fisher Dodge Associates
 22 West 19th Street
 New York, New York 10011
 T: 212.691.3000

LIFE SAFETY
 Code Consultants, Inc.
 215 West 43rd St, 15th Fl
 New York, New York 10018
 T: 212.216.9596

ENERGY MODEL/LEED
 Viduan
 50 Washington Street
 Norwalk, CT 06854
 T: 203.298.1411

ACOUSTIC/AUDIO-VISUAL
 Acoustic
 50 North Main Street
 South Norwalk, CT 06854
 T: 347.210.5540

VERTICAL TRANSPORTATION
 Van Duusen & Associates
 5 Regent Street, Suite 524
 Livingston, NJ 07039
 T: 973.994.9220


SPECIFICATIONS
 Construction Specifications Inc.
 PO Box 489
 227 Fenwick Road
 Morganville, NJ 07751
 T: 732.970.0700
 F: 732.970.0750

SECURITY
 Duchella Venter & Santoro
 1100 Sherman Avenue
 Hamden, CT 06514
 T: 203.286.6490

WATERPROOFING
 James R. Gahfort AIA Consulting Architects PC
 104 West 27th Street
 New York, NY 10001
 T: 212.736.3344


FACADE MAINTENANCE
 Frank Engineering PLLC
 166 1st Street
 New York, NY 10005
 T: 212.696.3000

BRANDING GRAPHICS
 21st Global Design Consultancy
 180 Varck Street 15th Floor
 New York, NY 10014
 T: 212.647.1170

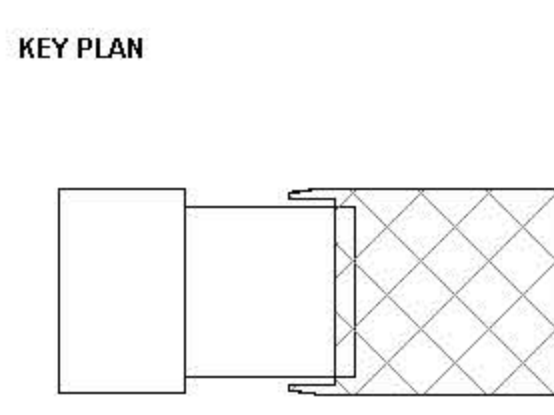

ISSUE **PRINTING** **DATE**

01	01	01
02	02	02
03	03	03
50	50	50

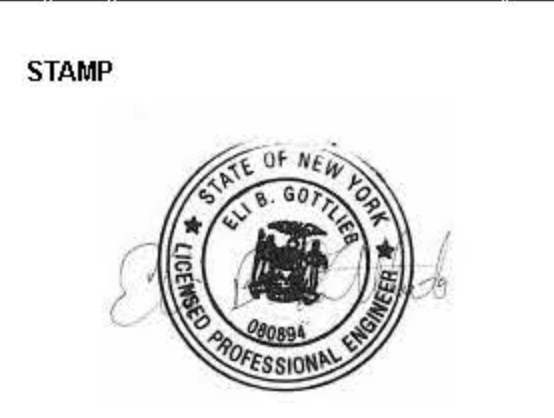

DRAWN BY
 Damian Titus


CHECKED BY
 Chris

PROJECT NUMBER
 N1318.00


TITLE
 TRUSS SECTIONS

DRAWING NO.
 S-355.01


B.SCAN NO.
 S-355.01

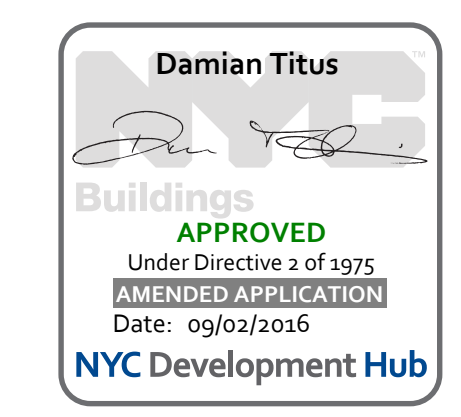


PENDING COORDINATION DURING DESIGN ASSIST.

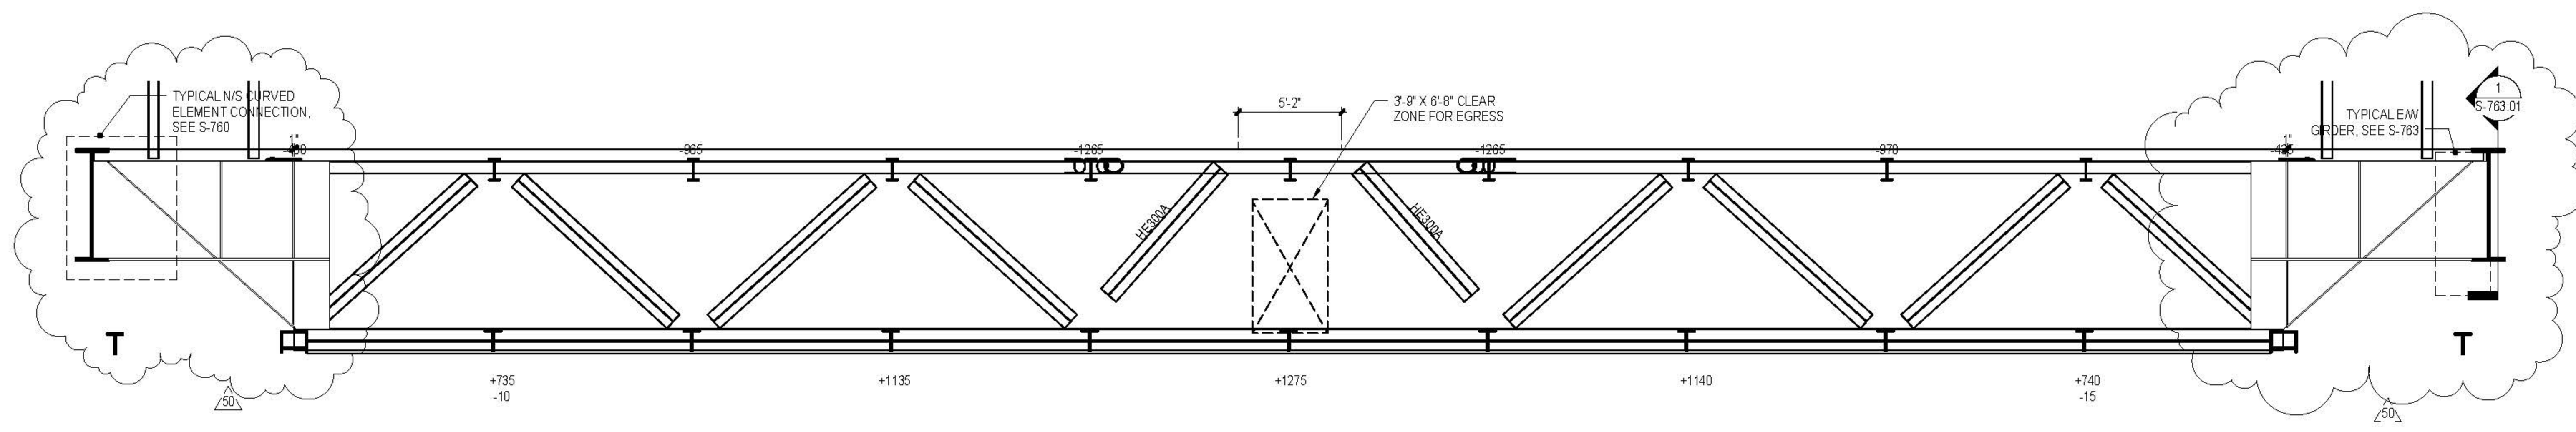


1 TRUSS 05
 1/4" = 1'-0"

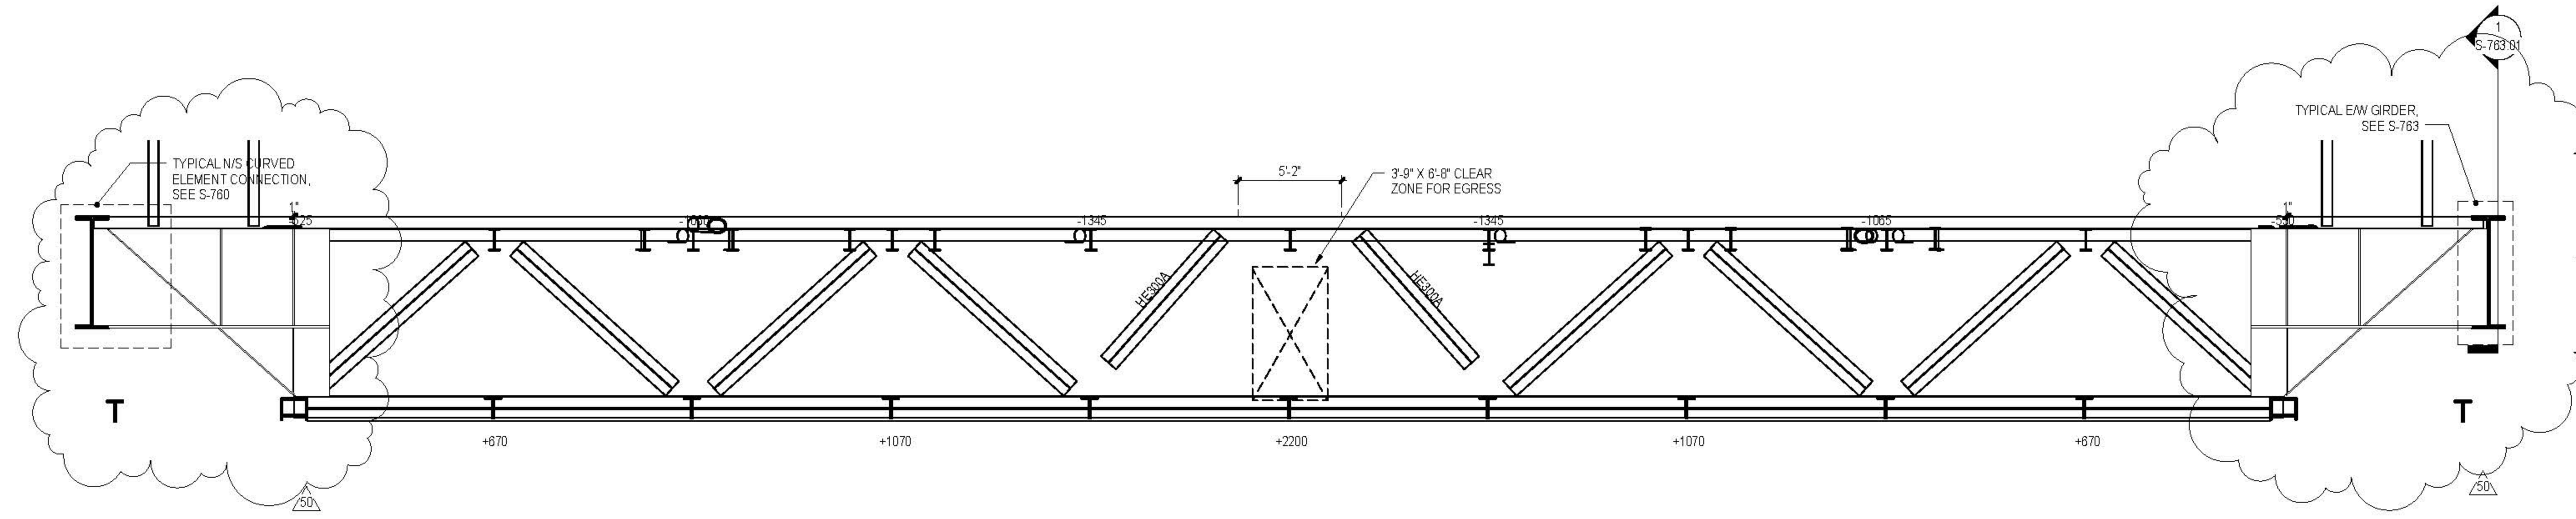


2 TRUSS 06
 1/4" = 1'-0"

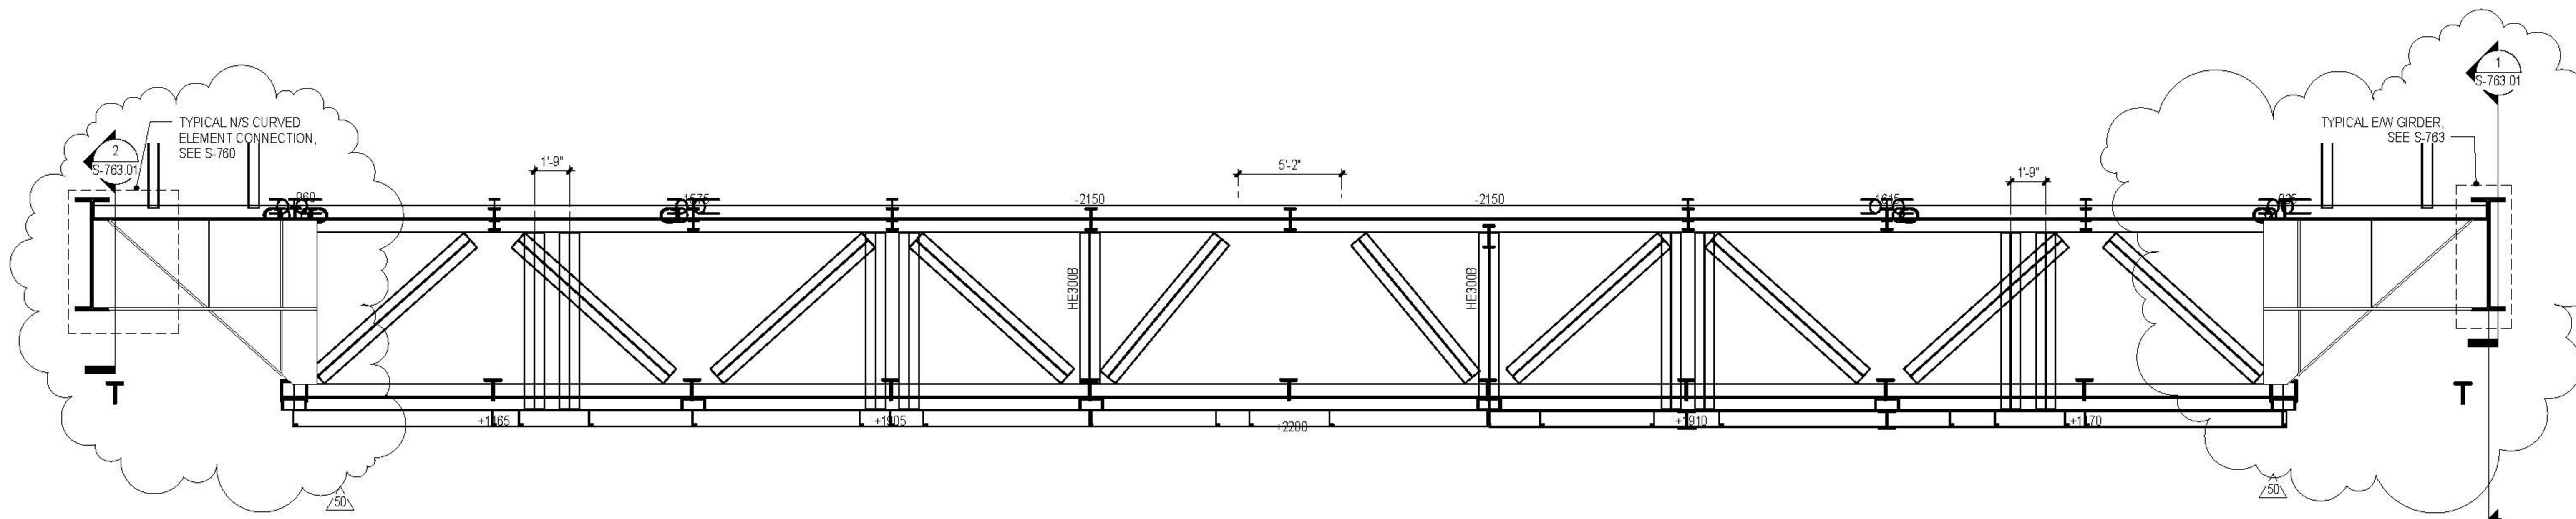

3 TRUSS 07
 1/4" = 1'-0"

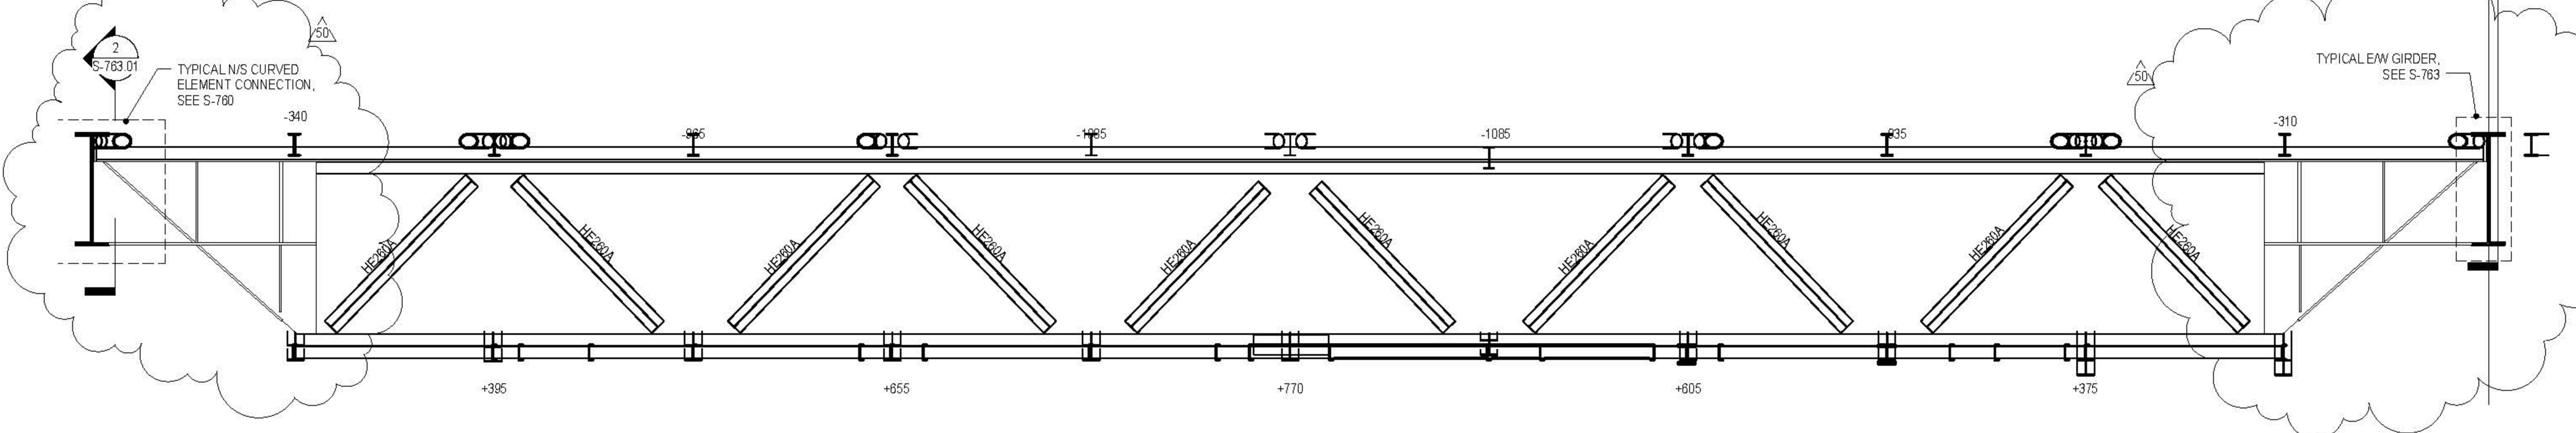

4 TRUSS 08
 1/4" = 1'-0"

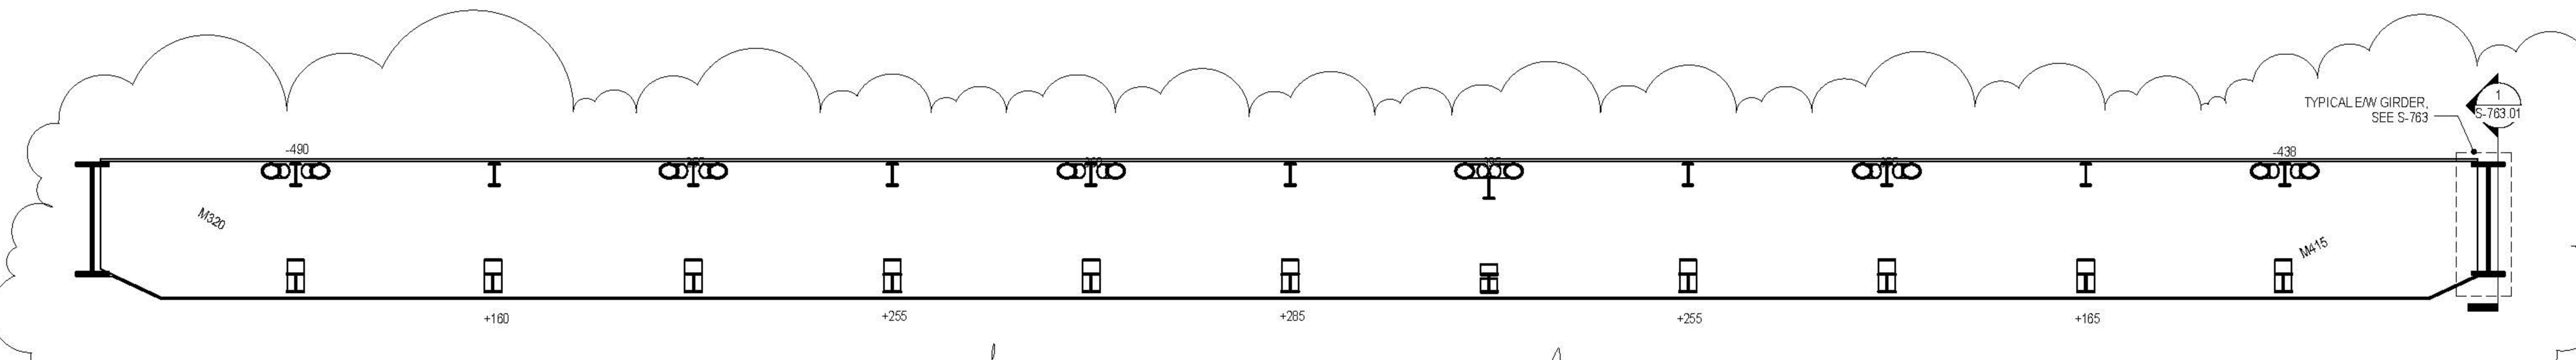

5 TRUSS 09
 1/4" = 1'-0"

CULTURE SHED

540 West 30th Street
New York, New York 10001

OWNER
CULTURE SHED INC.

ARCHITECTS
Oller Scaffida + Renfro Architects, DPC
601 West 20th Street #815
New York, New York 10001
T: 212.463.0334
F: 212.463.0335

rockwellgroup
5 Union St. West, 6th Flr
New York, New York 10003
T: 212.463.0334
F: 212.463.0335

STRUCTURAL ENGINEER
Thornton Tomasetti
51 Madison Avenue
New York, New York 10010
T: 212.591.7800
F: 212.269.7801

MEP ENGINEER
Jana Baum & Bolles
60 Park Street
New York, New York 10005
T: 212.530.9300
F: 212.269.6544

FACADE CONSULTANT
Thornton Tomasetti
51 Madison Avenue
New York, New York 10010
T: 212.591.7800
F: 212.269.7801

KINETICS ENGINEER
Hardy & Hanover
1501 Broadway
New York, New York 10036
T: 212.391.0287
F: 212.391.0287

LIGHTING DESIGNER
Tilston Design Associates
40 North Street #1650
New York, New York 10013
T: 212.675.7760

THEATRE PLANNING & DESIGN
Fisher Dodge Associates
22 West 15th Street
New York, New York 10011
T: 212.691.3000

LIFE SAFETY
Code Consultants, Inc.
215 West 43rd St, 15th Flr
New York, New York 10018
T: 212.216.9596

ENERGY MODEL A/EED
Vindian
60 Washington Street
Norwalk, CT 06854
T: 203.298.1411

ACOUSTIC/AUDIO-VISUAL
Avenille
93 North Main Street
South Norwalk, CT 06854
T: 347.210.5540

VERTICAL TRANSPORTATION
Van Dusen & Associates
5 Regent Street, Suite 624
Livingston, NJ 07039
T: 973.994.9220


SPECIFICATIONS
Construction Specifications Inc.
PO Box 489
22 Tannet Road
Morganville, NJ 07751
T: 732.970.0700
F: 732.970.0700

SECURITY
Duchella Venter & Santoro
1020 Sherman Avenue
Hartford, CT 06114
T: 203.286.6490

WATERPROOFING
James R. Galtfort AIA Consulting Architects PC
104 West 27th Street
New York, NY 10001
T: 212.736.3344


FACADE MAINTENANCE
Erick Engineering PLLC
166 Ave. Street
New York, NY 10005
T: 212.986.3000

BRANDING GRAPHICS
24 Global Design Consultancy
180 Varck Street 15th Floor
New York, NY 10014
T: 212.647.1170

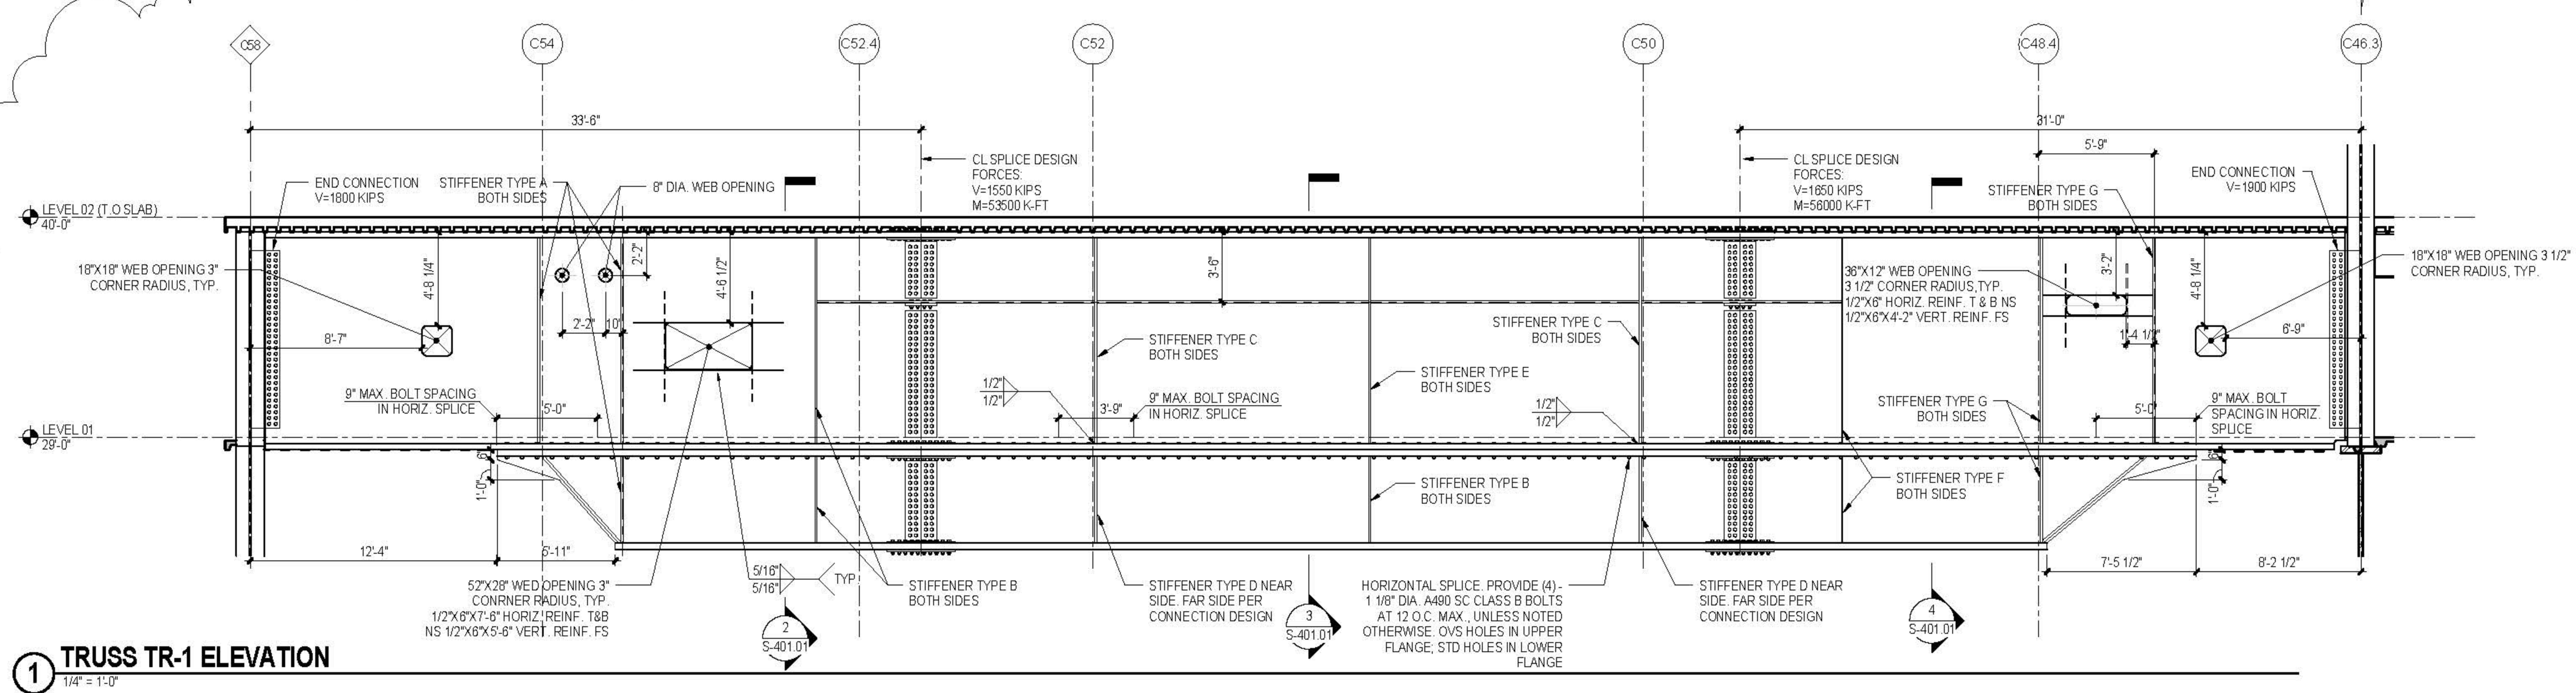


STIFFENER SCHEDULE			
TYPE	THICKNESS	WIDTH	FILLET WELD (BOTH SIDES)
A	1 1/2"	7.34"	5/16"
B	3/4"	7.34"	5/16"
C	1 1/2"	8"	5/16"
D	1 1/2"	7.34"	1/2"
E	3/4"	8"	5/16"
F	3/4"	7 1/2"	5/16"
G	1 1/2"	7 1/2"	5/16"


1 TRUSS TR-1 ELEVATION
1/4" = 1'-0"

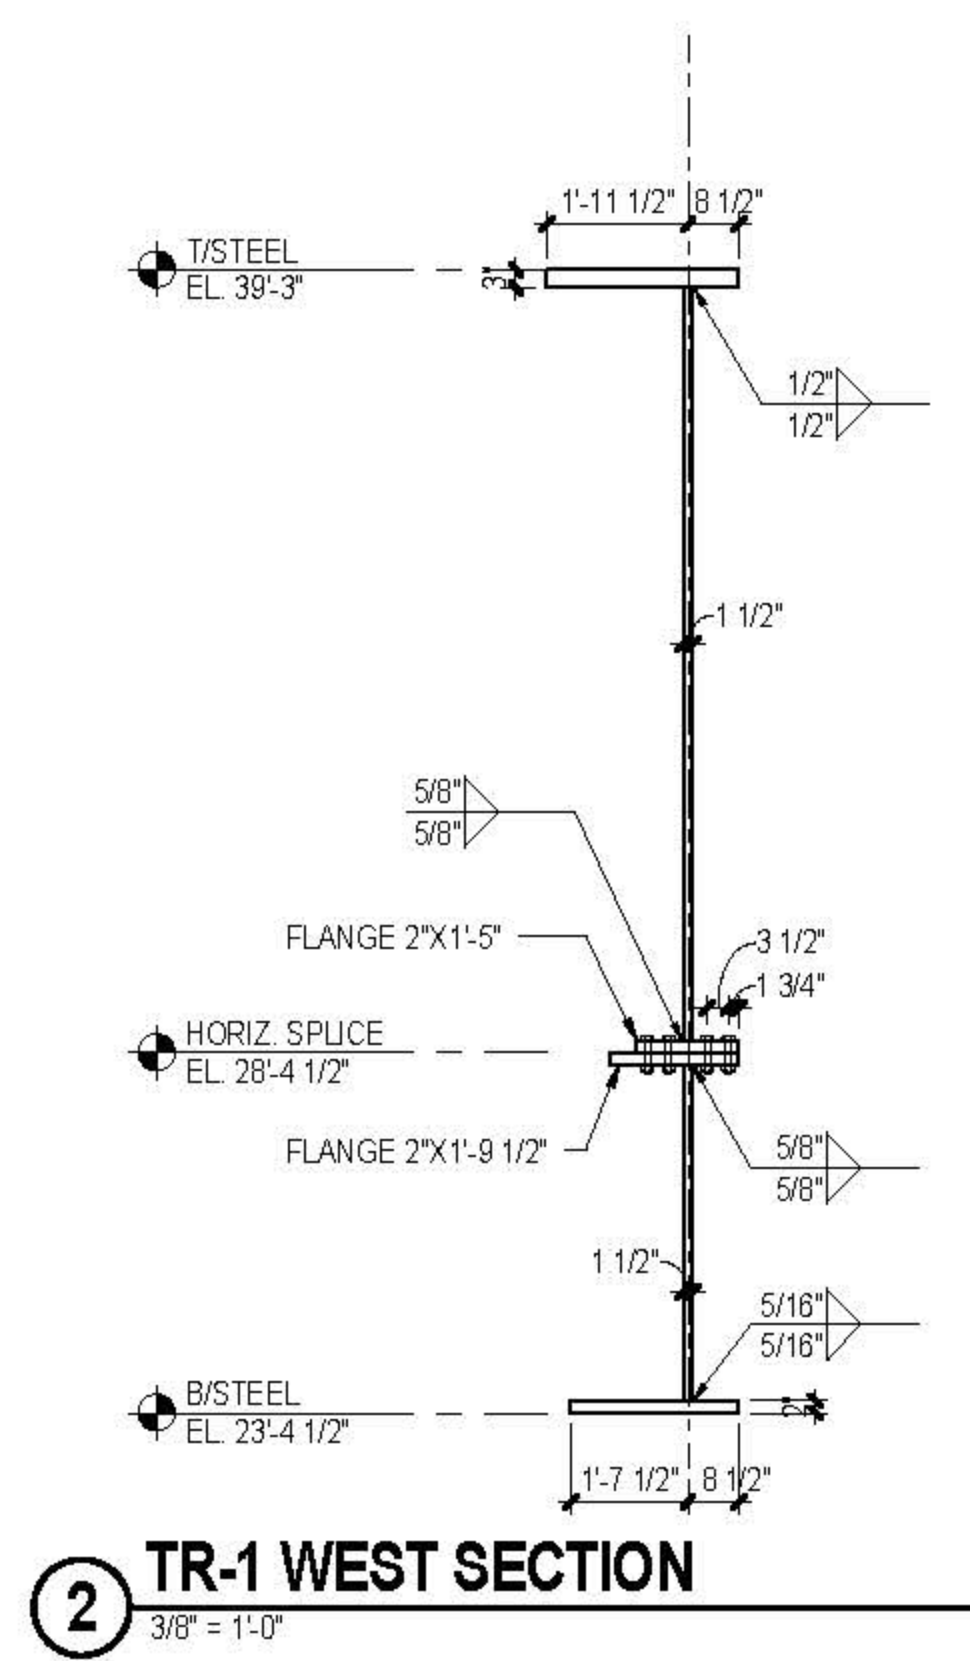

2 TR-1 WEST SECTION
3/8" = 1'-0"

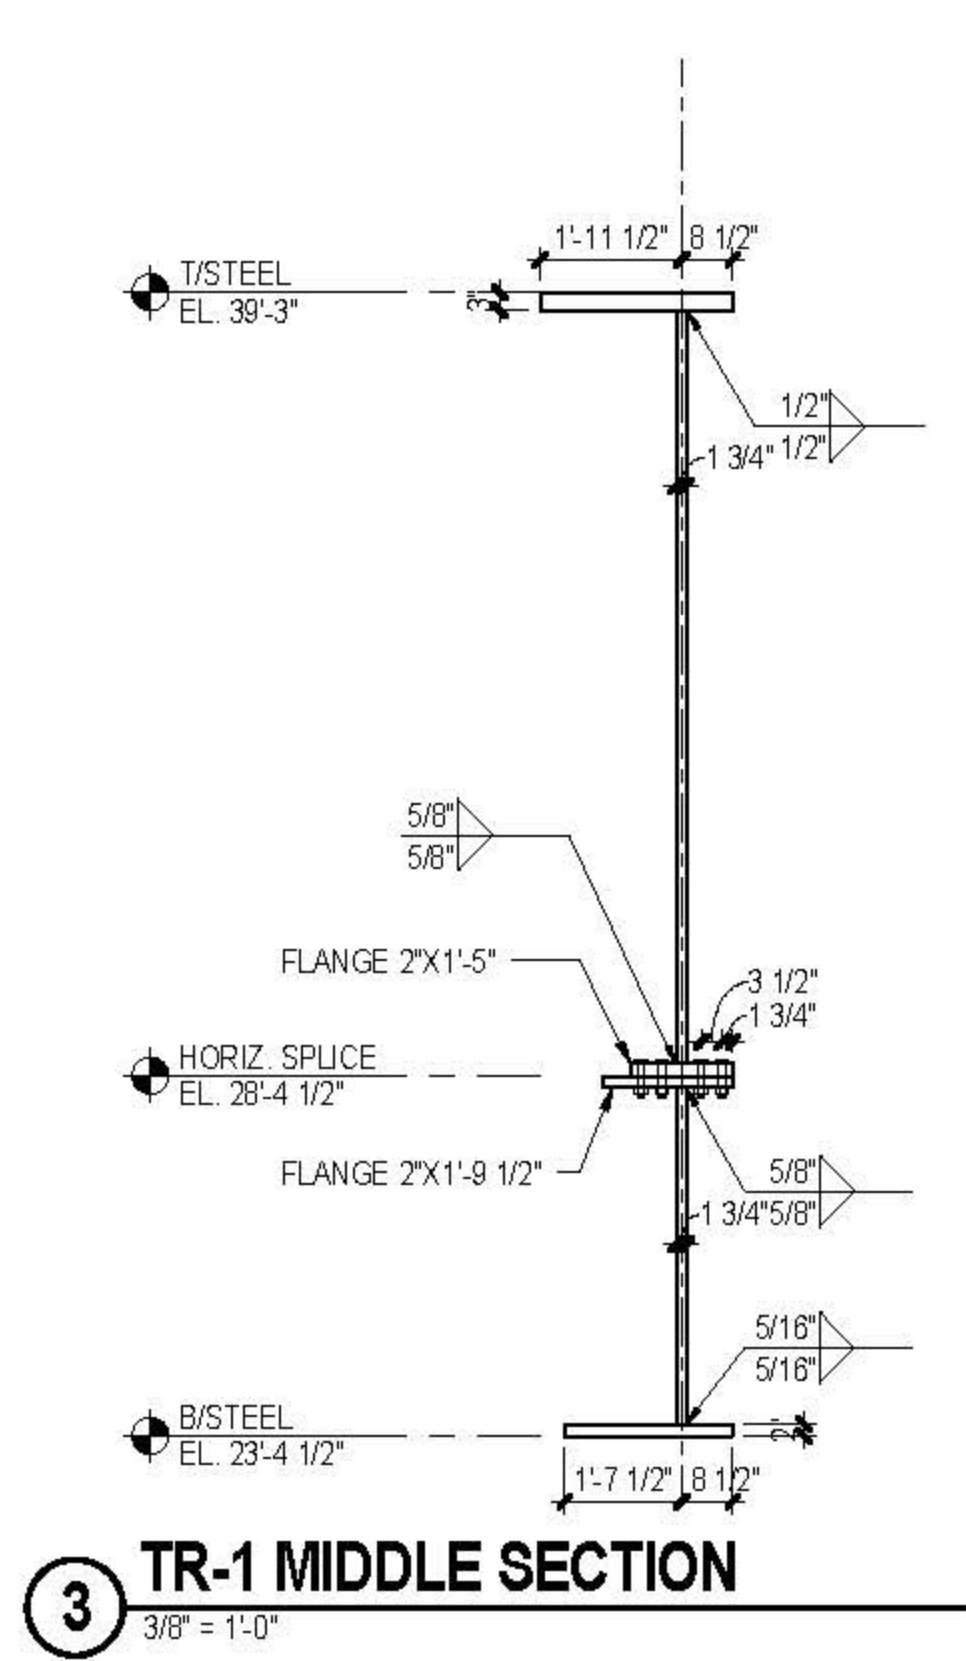


3 TR-1 MIDDLE SECTION
3/8" = 1'-0"

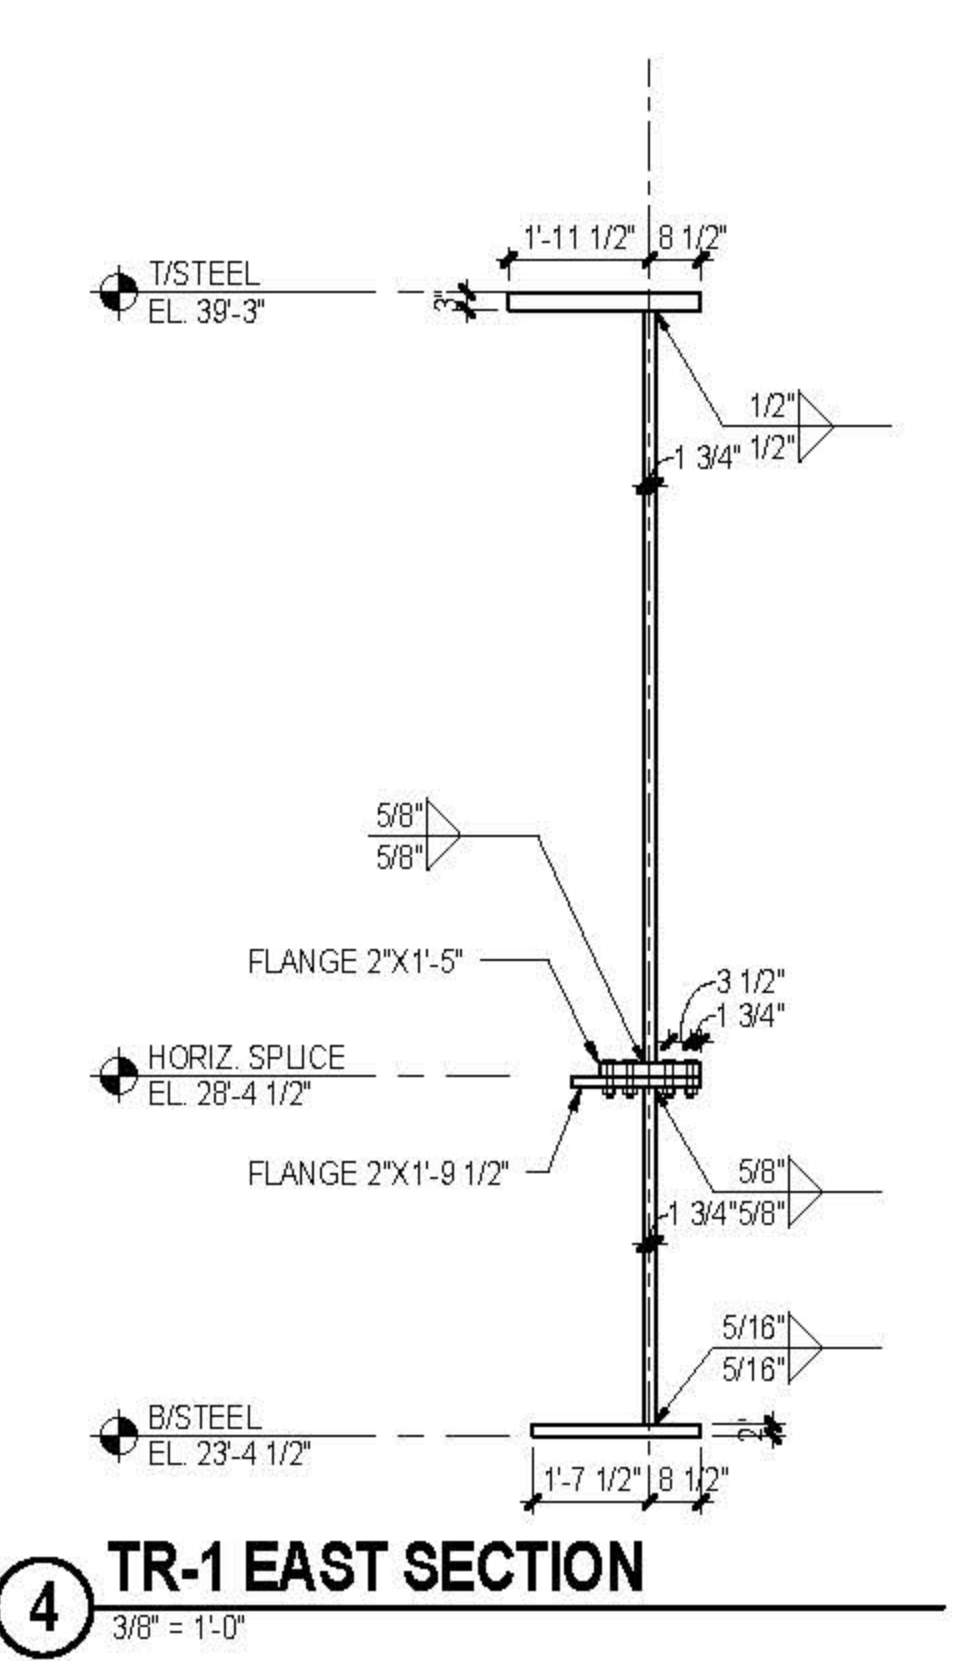


4 TR-1 EAST SECTION
3/8" = 1'-0"

KEY PLAN

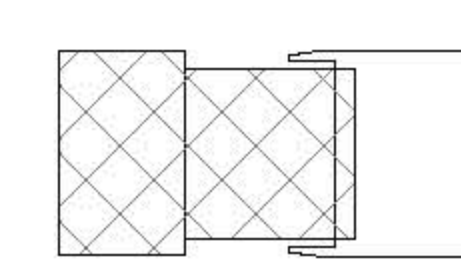

ISSUE PRINTING DATE

NO.	DESCRIPTION	DATE
01	01 - DISB AMENDMENT 7	03.19.2016
11	6 - ADV. PROCUREMENT ADDENDUM 6	04.10.2016
10	4 - 100% CONSTRUCTION DOCUMENTS	03.18.2016
9	90% CONSTRUCTION DOCUMENTS	02.16.2016
6	PRELIMINARY DIS SUBMISSION	12.10.2014
1	ADVANCED PROCUREMENT BID SET	06.16.2014

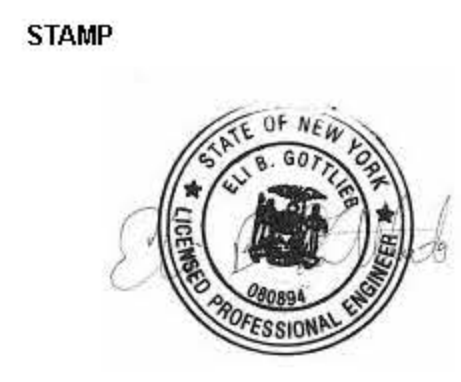


DRAWN BY: Damian Titus
CHECKED BY: [Signature]

PROJECT NUMBER: N11318.00

TITLE: FIXED BUILDING TRUSS ELEVATIONS AND DETAILS

DRAWING NO.: S-401.01

B.SCAN NO.: S-401.01

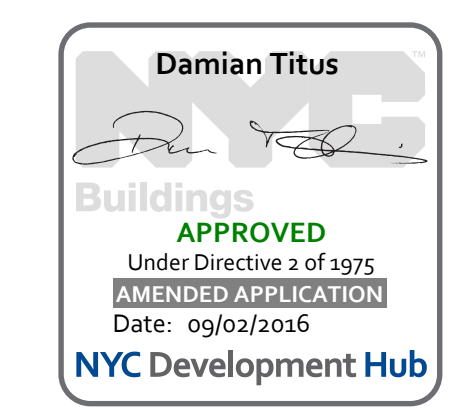

CULTURE SHED

540 West 30th Street
New York, New York 10001

OWNER
CULTURE SHED INC.

ARCHITECTS
Oller Scaletto + Renfro Architects, DPC
601 West 20th Street #815
New York, New York 10011
T: 212.363.7971

MECHANICAL ENGINEER
Thornton Tomasetti
51 Madison Avenue
New York, New York 10010
T: 917.861.7800
F: 917.861.7811

MEP ENGINEER
Jana Baum & Bolles
50 Park Street
New York, New York 10005
T: 212.530.9300
F: 212.265.6544

FACADE CONSULTANT
Thornton Tomasetti
51 Madison Avenue
New York, New York 10010
T: 917.861.7800
F: 917.861.7811

ACINETICS ENGINEER
Hardesky & Hanover
1501 Broadway
New York, New York 10036
T: 212.944.1150
F: 212.391.0339

LIGHTING DESIGNER
Tilston Design Associates
40 North Street #160
New York, New York 10013
T: 212.675.7760

THEATRE PLANNING & DESIGN
Fisher Dachs Associates
22 West 15th Street
New York, New York 10011
T: 212.691.3000

LIFE SAFETY
Code Consultants, Inc.
215 West 43rd St, 15th Fl.
New York, New York 10018
T: 212.216.9596

ENERGY MODEL/LEED
Vindian
50 Washington Street
Norwalk, CT 06854
T: 203.298.1411

ACOUSTIC/AUDIO-VISUAL
Avenille
50 North Main Street
South Norwalk, CT 06854
T: 347.210.5540

VERTICAL TRANSPORTATION
Van Dusen & Associates
5 Regent Street, Suite 524
Livingston, NJ 07039
T: 973.994.9220

SPECIFICATIONS
Construction Specifications Inc.
PO Box 489
22 Tenth Road
Morganville, NJ 07751
T: 732.970.0700
F: 732.970.0750


SECURITY
Duchella Venter & Santoro
1020 Sherman Avenue
Hartford, CT 06114
T: 203.283.6490

WATERPROOFING
James R. Galford AIA Consulting Architects PC
104 West 27th Street
New York, NY 10001
T: 212.736.3344

FACADE MAINTENANCE
Erick Engineering PLLC
166 Ave. Street
New York, NY 10005
T: 212.698.3000

BRANDING/GRAPHICS
214 Global Design Consultancy
180 Varck Street 15th Floor
New York, NY 10014
T: 212.647.1170

KEY PLAN

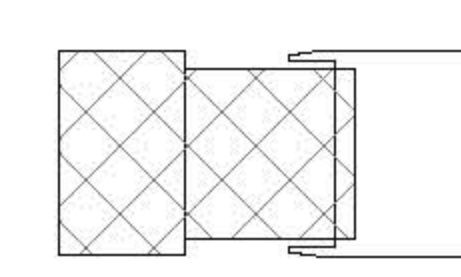

ISSUE PRINTING DATE

01	00	DOB AMENDMENT 7	03/19/2015
11	0	ADV. PROCUREMENT ADDENDUM 6	04/10/2015
10	4	100% CONSTRUCTION DOCUMENTS	03/18/2015
9	0	90% CONSTRUCTION DOCUMENTS	02/16/2015
6	0	PRELIMINARY CIB SUBMISSION	12/10/2014
1	0	ADVANCED PROCUREMENT BID SET	06/16/2014

STAMP



DRAWN BY: *Autum* CHECKED BY: *Chris*

PROJECT NUMBER: N11318.00

TITLE: CASTELLATED BEAM ELEVATIONS AND DETAILS

DRAWING NO.: S-402.01

B.SCAN NO.: S-402.01


49 of 123

PLATE GIRDER SCHEDULE										
MARK	d (in)	MIDDLE ZONE			END ZONES			REMARKS		
		FLANGE	WEB	WELD	FLANGE	WEB	WELD			
		bf (in)	tf (in)	tw (in)	a (in)	bf (in)	tf (in)	tw (in)	a (in)	
CB86X187	58	12	1.0	0.825	1/2	-	-	-	-	
CB86X230	66	16	1.25	0.75	9/16	66	16	1.0	0.75	9/16
CB86X262	66	16	1.5	0.875	5/8	66	16	1.25	0.875	5/8
CB86-1	66	18	2.0	1.0	3/4	66	18	1.25	1.0	3/4
CB86-2	66	20	2.5	1.25	1	-	-	-	-	


- NOTES:
- MIDDLE ZONE APPLIES TO THE PORTION OF THE BEAM BETWEEN TWO SPLICE LOCATIONS AS INDICATED IN THE BEAM ELEVATIONS 1 AND 2. END ZONES APPLY TO THE PORTION OF THE BEAM FROM THE SPLICE TO THE END OF THE MEMBER.
 - WHERE NO VALUES ARE SCHEDULED FOR THE END ZONES, THE BEAMS SHALL HAVE THE PROPERTIES SPECIFIED FOR THE MIDDLE ZONE OVER THEIR ENTIRE LENGTH.

- NOTES:
- SIZE OF WELD 'a' ASSUMES SHIELDED METAL ARC WELDING (SMAW)
 - ALL WELDS ARE CONTINUOUS UON
 - PLATE GIRDER DESIGNED FOR THE FOLLOWING PLATE GRADE:
 tf, tw < 4", ASTM A572 Fy = 50 KSI
 4" < tf < 6", ASTM A572 Fy = 62 KSI
 6" < tf < 8", ASTM A36 Fy = 36 KSI

1 CB PLATE GIRDER SCHEDULE
1" = 1'-0"

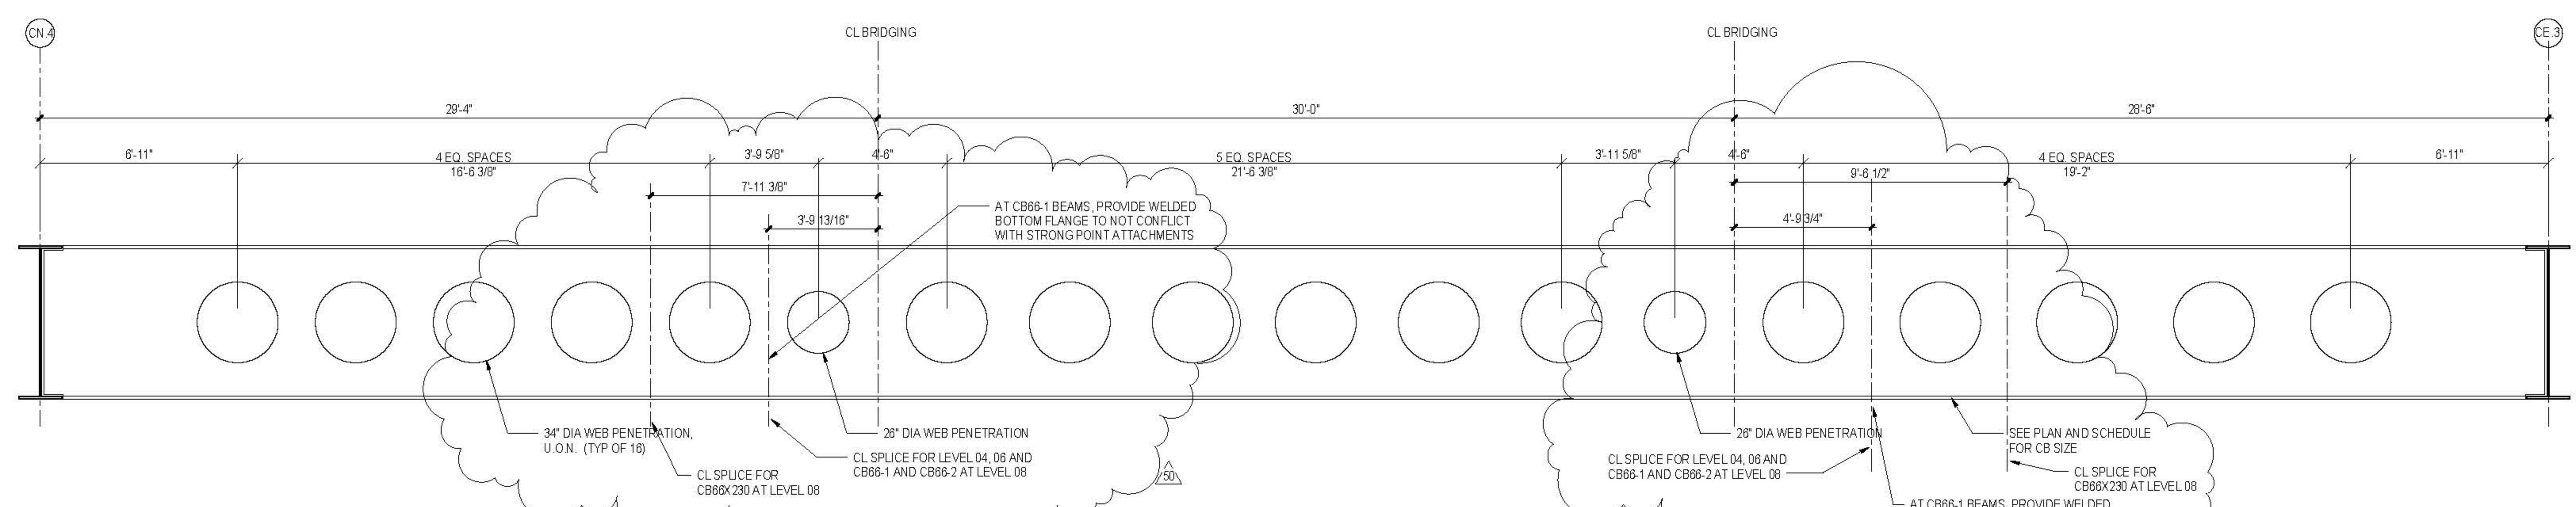


2 CB PLATE GIRDER WEB OPENINGS - LEVELS 04, 06, 08
3/8" = 1'-0"

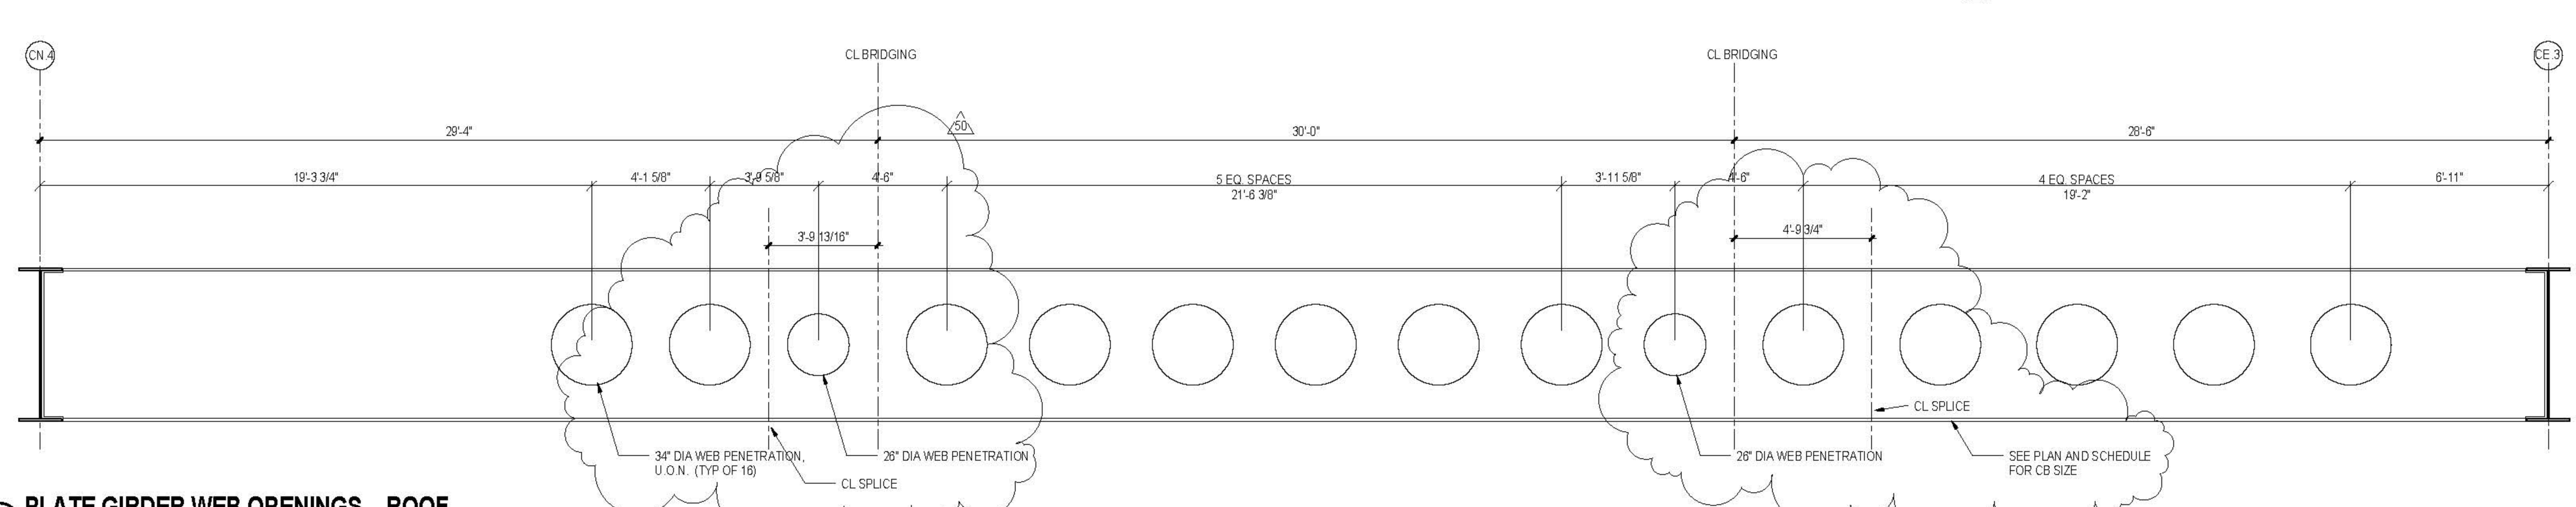

3 PLATE GIRDER WEB OPENINGS - ROOF
3/8" = 1'-0"

SPLICE DESIGN FORCES			
Level	Mark	V (kips)	M (kip-ft)
04	CB86-2	200	7000
04	CB86X230	110	4000
06	CB86-2	250	9000
06	CB86X262	150	5200
08	CB86-2	210	7800
08	CB86X230	150	4100
08	CB86-2	170	6100
ROOF	CB86X187	70	2300

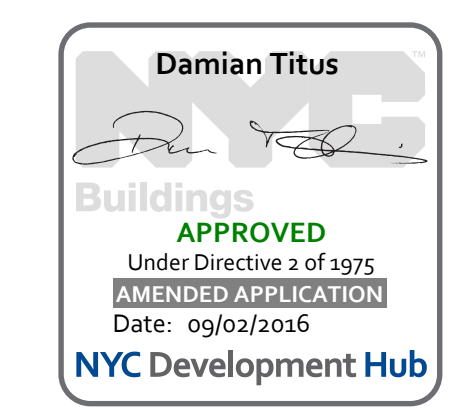

CULTURE SHED

545 West 30th Street
New York, New York 10001

OWNER
CULTURE SHED INC

ARCHITECTS
Oller Scifidio + Renfro Architects, DPC
601 West 28 Street #815
New York, New York 10001
T: 212.260.7971

rockwellgroup
5 Union Sq West, 8th Flr
New York, New York 10003
T: 212.463.0334
F: 212.463.0335

STRUCTURAL ENGINEER
Thornton Tomasetti
51 Madison Avenue
New York, New York 10010
T: 917.661.7800
F: 917.661.7801

MEP ENGINEER
Jaros Baum & Bolles
80 Pine Street
New York, New York 10005
T: 212.530.9300
F: 212.260.9884

FACADE CONSULTANT
Thornton Tomasetti
51 Madison Avenue
New York, New York 10010
T: 917.661.7800
F: 917.661.7801

KINETICS ENGINEER
Hardisty & Hanover
1501 Broadway
New York, New York 10036
T: 212.844.1150
F: 212.391.0397

LIGHTING DESIGNER
Tilston Design Associates
40 Worth Street #180
New York, New York 10013
T: 212.875.7760

THEATRE PLANNING & DESIGN
Fisher Dachs Associates
22 West 16th Street
New York, New York 10011
T: 212.691.3000

LIFE SAFETY
Code Consultants, Inc.
215 West 40th St, 16th Flr
New York, New York 10018
T: 212.216.9596

ENERGY MODEL/LEED
Veridian
50 Washington Street
Norwalk, CT 06854
T: 203.298.1411

ACOUSTIC/AUDIO-VISUAL
Alavik
93 North Main Street
South Norwalk, CT 06854
T: 347.210.5540

VERTICAL TRANSPORTATION
Van Dusen & Associates
5 Regent Street, Suite 504
Livingston, NJ 07039
T: 973.994.9220

SPECIFICATIONS
Construction Specifications Inc.
PO Box 498
22 Tenmile Road
Morganville, NJ 07751
T: 732.870.0700
F: 732.870.0700


SECURITY
Duchella Venter & Santoro
1020 Sherman Avenue
Hamden, CT 06514
T: 203.288.6490

WATERPROOFING
James R. Gairford AIA Consulting Architects PC
104 West 27th Street
New York, NY 10001
T: 212.736.3344

FACADE MAINTENANCE
Erick Engineering PLLC
166 Area Street
New York, NY 10005
T: 212.696.3000

BRANDING/GRAPHICS
2nd Global Design Consultancy
180 Vankh Street 15th Floor
New York, NY 10014
T: 212.647.1170

KEY PLAN

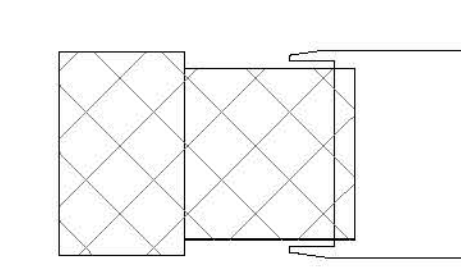

ISSUE PRINTING DATE

ISSUE	PRINTING	DATE
E1	DIS AMENDMENT 7	09/10/2018
E2	AS-BUILT	04/01/2018
E3	CONSTRUCTION SET	10/29/2018
E4	DIS AMENDMENT 3	09/10/2018
E5	ADDENDUM 4	06/11/2018
E6	ADV. PROUREMENT ADDENDUM 5	04/10/2018
E7	100% CONSTRUCTION DOCUMENTS	08/10/2018
E8	PRELIMINARY DIS AMENDMENT	12/10/2014
E9	ADV. PROUREMENT ADDENDUM 1	10/23/2014

STAMP



DRAWN BY
Aldrey


CHECKED BY
Damian Titus

PROJECT NUMBER
N1131800

TITLE
STRONG POINT SUPPORT FRAMING PLAN,
FIXED BUILDING LEVEL 04


DRAWING NO.
S-410.01A

B-SCAN NO.
S-410.01

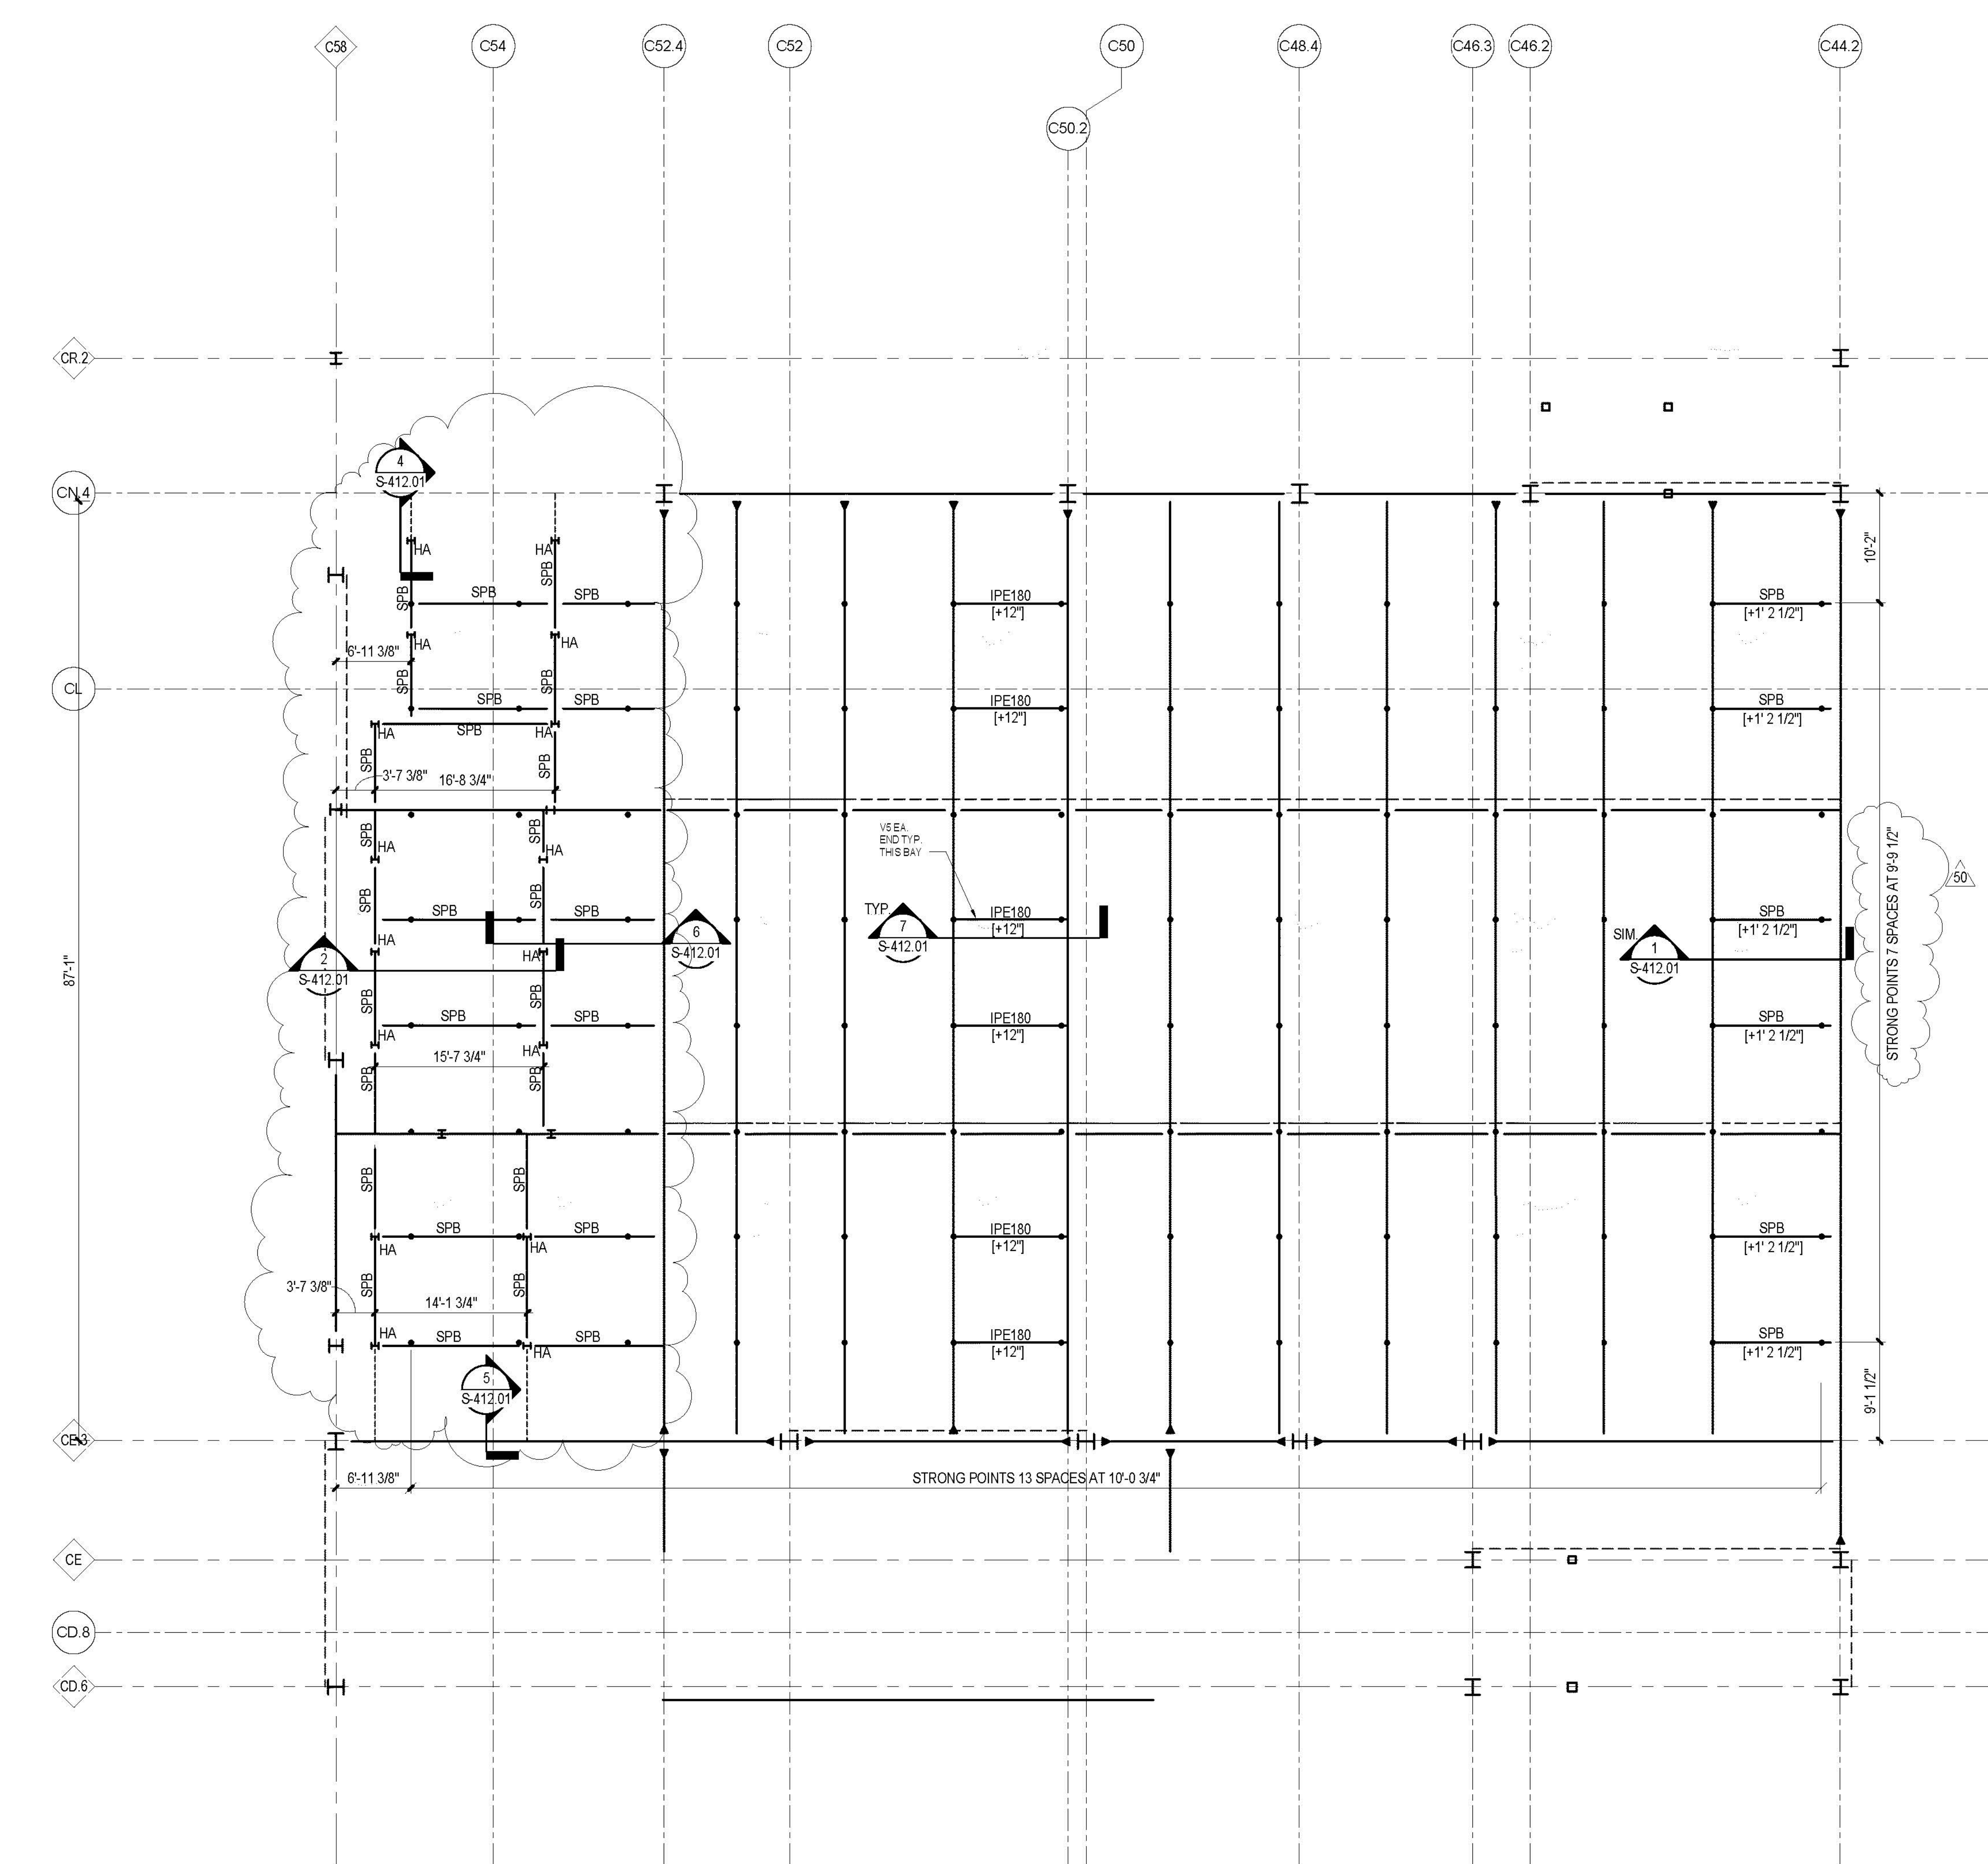

1 FIXED BUILDING LEVEL 04 STRONG POINT SUPPORT FRAMING PLAN
1/8" = 1'-0"

- SHEET NOTES**
- AT LEVEL 04, STEEL EL. 60'-7" UON.
 - REFER TO S-104 FOR ALL FRAMING SIZES NOT INDICATED.
 - NOTATIONS
 - INDICATES IPE 270 HANGER ABOVE. REFER TO DETAIL 2/S-412 FOR DETAILS.
 - INDICATES RH5150X100X8 STRONG POINT SUPPORT BEAM. CONNECT FOR MIN VS. TS, EA. END UNLESS OTHERWISE NOTED ON PLAN.
 - SYMBOLS
 - INDICATES STRONG POINT SUPPORT LOCATION - REFER TO ARCH. DWGS. FOR ADDITIONAL INFORMATION. SUPPORT FRAMING IS DESIGNED FOR 1000 LB MAXIMUM LOAD ON STRONG POINTS.

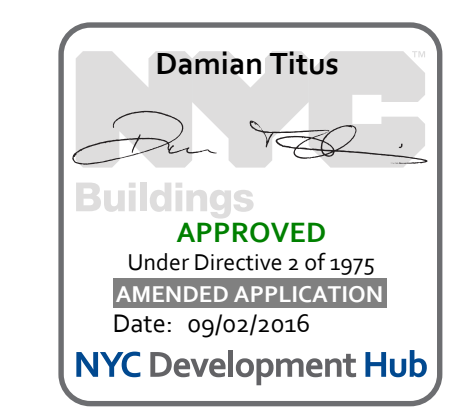

CULTURE SHED

540 West 30th Street
New York, New York 10001

OWNER
CULTURE SHED INC.

ARCHITECTS
Oller Scaletta + Renfro Architects, DPC
601 West 30th Street #815
New York, New York 10001
T: 212.263.7971

rockwellgroup
5 Union St. West, 6th Fl.
New York, New York 10003
T: 212.463.0334
F: 212.463.0335

STRUCTURAL ENGINEER
Thornton Tomasetti
51 Madison Avenue
New York, New York 10010
T: 917.861.7800
F: 917.861.7801

MEP ENGINEER
Jana Baum & Bolles
60 Park Street
New York, New York 10005
T: 212.530.9300
F: 212.266.6944

FACADE CONSULTANT
Thornton Tomasetti
51 Madison Avenue
New York, New York 10010
T: 917.861.7800
F: 917.861.7801

KINETICS ENGINEER
Hudess & Hanover
1501 Broadway
New York, New York 10036
T: 212.944.1150
F: 212.391.0337

LIGHTING DESIGNER
Tilston Design Associates
40 North Street #1650
New York, New York 10013
T: 212.675.7760

THEATRE PLANNING & DESIGN
Fisher Dodge Associates
22 West 15th Street
New York, New York 10011
T: 212.691.3000

LIFE SAFETY
Code Consultants, Inc.
215 West 43rd St., 15th Fl.
New York, New York 10018
T: 212.216.9596

ENERGY MODEL/LEED
Vindian
60 Washington Street
Norwalk, CT 06854
T: 203.298.1411

ACOUSTIC/AUDIO-VISUAL
Anaville
93 North Main Street
South Norwalk, CT 06854
T: 347.210.5540

VERTICAL TRANSPORTATION
Van Dusen & Associates
5 Regent Street, Suite 524
Livingston, NJ 07039
T: 973.994.9220

SPECIFICATIONS
Construction Specifications Inc.
PO Box 489
22 Tenthill Road
Morganville, NJ 07751
T: 732.970.0700
F: 732.970.0750


SECURITY
Duchella Venter & Santoro
1100 Sherman Avenue
Hartford, CT 06114
T: 203.268.6490

WATERPROOFING
James R. Galtfort AIA Consulting Architects PC
104 West 27th Street
New York, NY 10001
T: 212.736.3344

FACADE MAINTENANCE
Erick Engineering PLLC
186 Arden Street
New York, NY 10005
T: 212.698.3000

BRANDING GRAPHICS
2nd Global Design Consultancy
180 York Street 15th Floor
New York, NY 10014
T: 212.647.1170

KEY PLAN

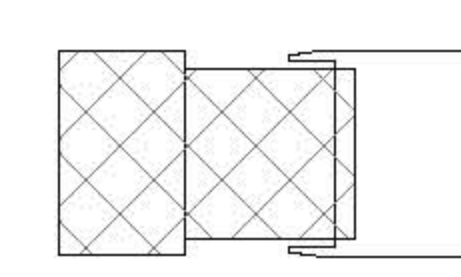

ISSUE △ PRINTING DATE

ISSUE	PRINTING	DATE

61	50	DOB AMENDMENT 7	08/19/2016
42	31	ASB #619	04/01/2016

STAMP




DRAWN BY: *Autum* CHECKED BY: *Checker*
PROJECT NUMBER: N1318.00

TITLE: STRONG POINT SUPPORT FRAMING PLAN, FIXED BUILDING LEVEL 06

DRAWING NO.: S-410.01B
B.SCAN NO.: S-414.00

52 of 123

© COPYRIGHT 2016 BY ROCKWELL GROUP A DIVISION OF OLLER SCALETTA + RENFRO ARCHITECTS, D.P.C. ALL RIGHTS RESERVED.

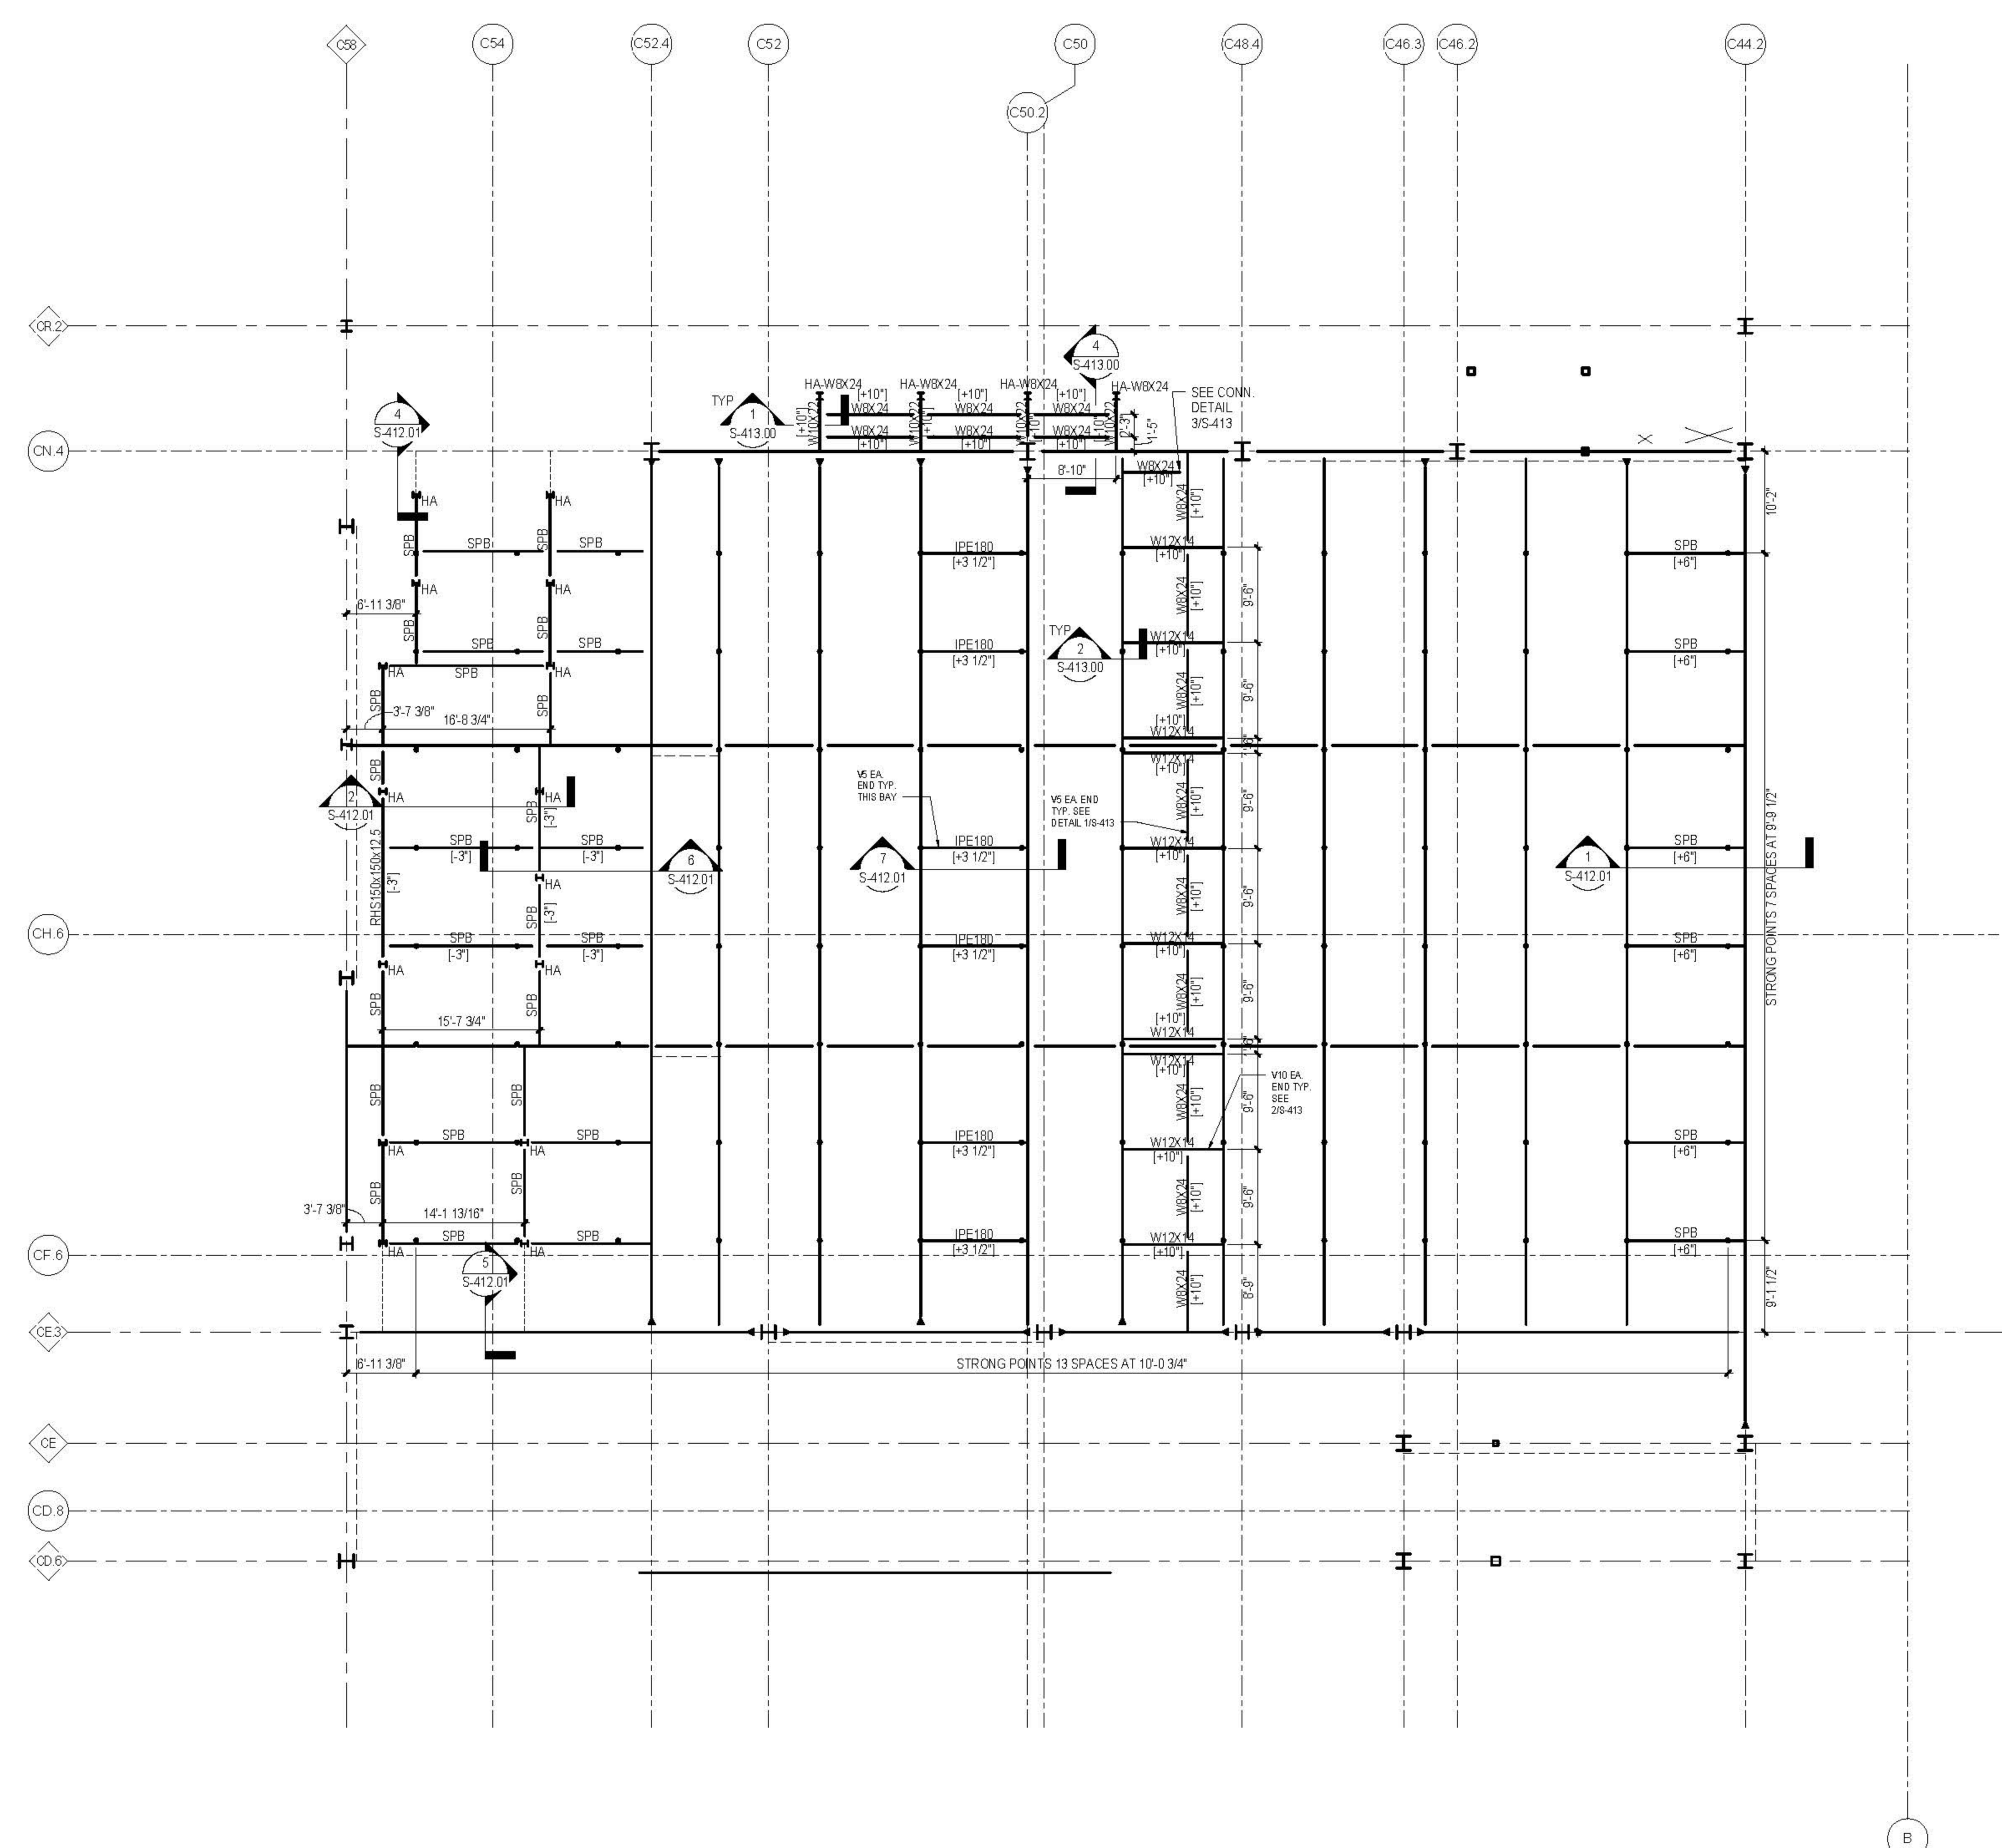


1 FIXED BUILDING LEVEL 06 STRONG POINTS SUPPORT FRAMING PLAN

1/8" = 1'-0"

SHEET NOTES

- AT LEVEL 06, T/STEEL EL. 87'-5 1/2" UON.
- REFER TO S-106 FOR ALL FRAMING SIZES NOT INDICATED.
- NOTATIONS:
HA INDICATES IPE 270 HANGER ABOVE. REFER TO DETAIL 20S-412 FOR DETAILS.
SPB INDICATES RH5150X100X8 STRONG POINT SUPPORT BEAM. CONNECT FOR MIN V5, T5, EA, END UNLESS OTHERWISE NOTED ON PLAN.
- SYMBOLS:
● INDICATES STRONG POINT SUPPORT LOCATION. REFER TO ARCH. DWGS. FOR ADDITIONAL INFORMATION. SUPPORT FRAMING IS DESIGNED FOR 1000 LB MAXIMUM LOAD ON STRONG POINTS.

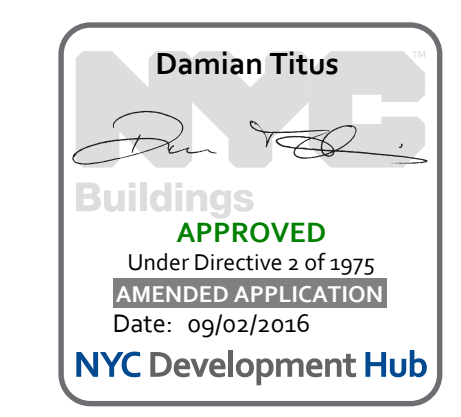

CULTURE SHED

540 West 30th Street
New York, New York 10001

OWNER
CULTURE SHED INC.

ARCHITECTS
Oiler Scudato + Renfro Architects, DPC
601 West 30th Street #815
New York, New York 10001
T: 212.260.7971

rackwellgroup
5 Union St. West, 6th Flr
New York, New York 10003
T: 212.463.0334
F: 212.463.0335

STRUCTURAL ENGINEER
Thornton Tomasetti
51 Madison Avenue
New York, New York 10010
T: 917.861.7800
F: 917.861.7801

MEP ENGINEER
Jans Baum & Bolles
60 Park Street
New York, New York 10005
T: 212.530.9900
F: 212.260.6904

FACADE CONSULTANT
Thornton Tomasetti
51 Madison Avenue
New York, New York 10010
T: 917.861.7800
F: 917.861.7801

KINETICS ENGINEER
Hardy & Hanover
1501 Broadway
New York, New York 10036
T: 212.944.1150
F: 212.391.0297

LIGHTING DESIGNER
Tilston Design Associates
40 North Street #160
New York, New York 10013
T: 212.675.7760

THEATRE PLANNING & DESIGN
Fisher Dachs Associates
22 West 15th Street
New York, New York 10011
T: 212.691.3000

LIFE SAFETY
Code Consultants, Inc.
215 West 43rd St, 15th Flr
New York, New York 10018
T: 212.216.9596

ENERGY MODELLED
Vindian
60 Washington Street
Norwalk, CT 06854
T: 203.298.1411

ACOUSTIC/AUDIO-VISUAL
Avalon
93 North Main Street
South Norwalk, CT 06854
T: 347.210.5540

VERTICAL TRANSPORTATION
Van Dusen & Associates
5 Regent Street, Suite 624
Langston, NJ 07039
T: 973.994.9220

SPECIFICATIONS
Construction Specifications Inc.
PO Box 489
22 Tamm Road
Morganville, NJ 07751
T: 732.970.0700
F: 732.970.0750


SECURITY
Duchella Venter & Santoro
1100 Sherman Avenue
Hartford, CT 06114
T: 203.286.6490

WATERPROOFING
James R. Gahfort AIA Consulting Architects PC
104 West 27th Street
New York, NY 10001
T: 212.736.3344

FACADE MAINTENANCE
Frank Engineering PLLC
162 Ave. Street
New York, NY 10005
T: 212.698.3000

BRANDING GRAPHICS
2nd Global Design Consultancy
180 Varck Street 15th Floor
New York, NY 10014
T: 212.647.1170

KEY PLAN

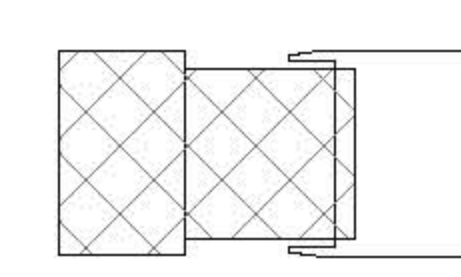

ISSUE PRINTING DATE

01	50	DOB AMENDMENT 7	08/19/2016
11	5	ADV. PROCEEDMENT ADDENDUM 6	04/10/2016
10	4	100% CONSTRUCTION DOCUMENTS	03/31/2015
5		PRELIMINARY DOB SUBMISSION	12/10/2014
3	1	ADV. PROCEEDMENT ADDENDUM 1	10/01/2014

STAMP



DRAWN BY: Damian Titus
CHECKED BY: [Signature]


PROJECT NUMBER: N11318.00

TITLE: STRONG POINT SUPPORT FRAMING PLAN, FIXED BUILDING LEVEL 08

DRAWING NO.: S-411.01

B.SCAN NO.: S-411.01


53 of 123

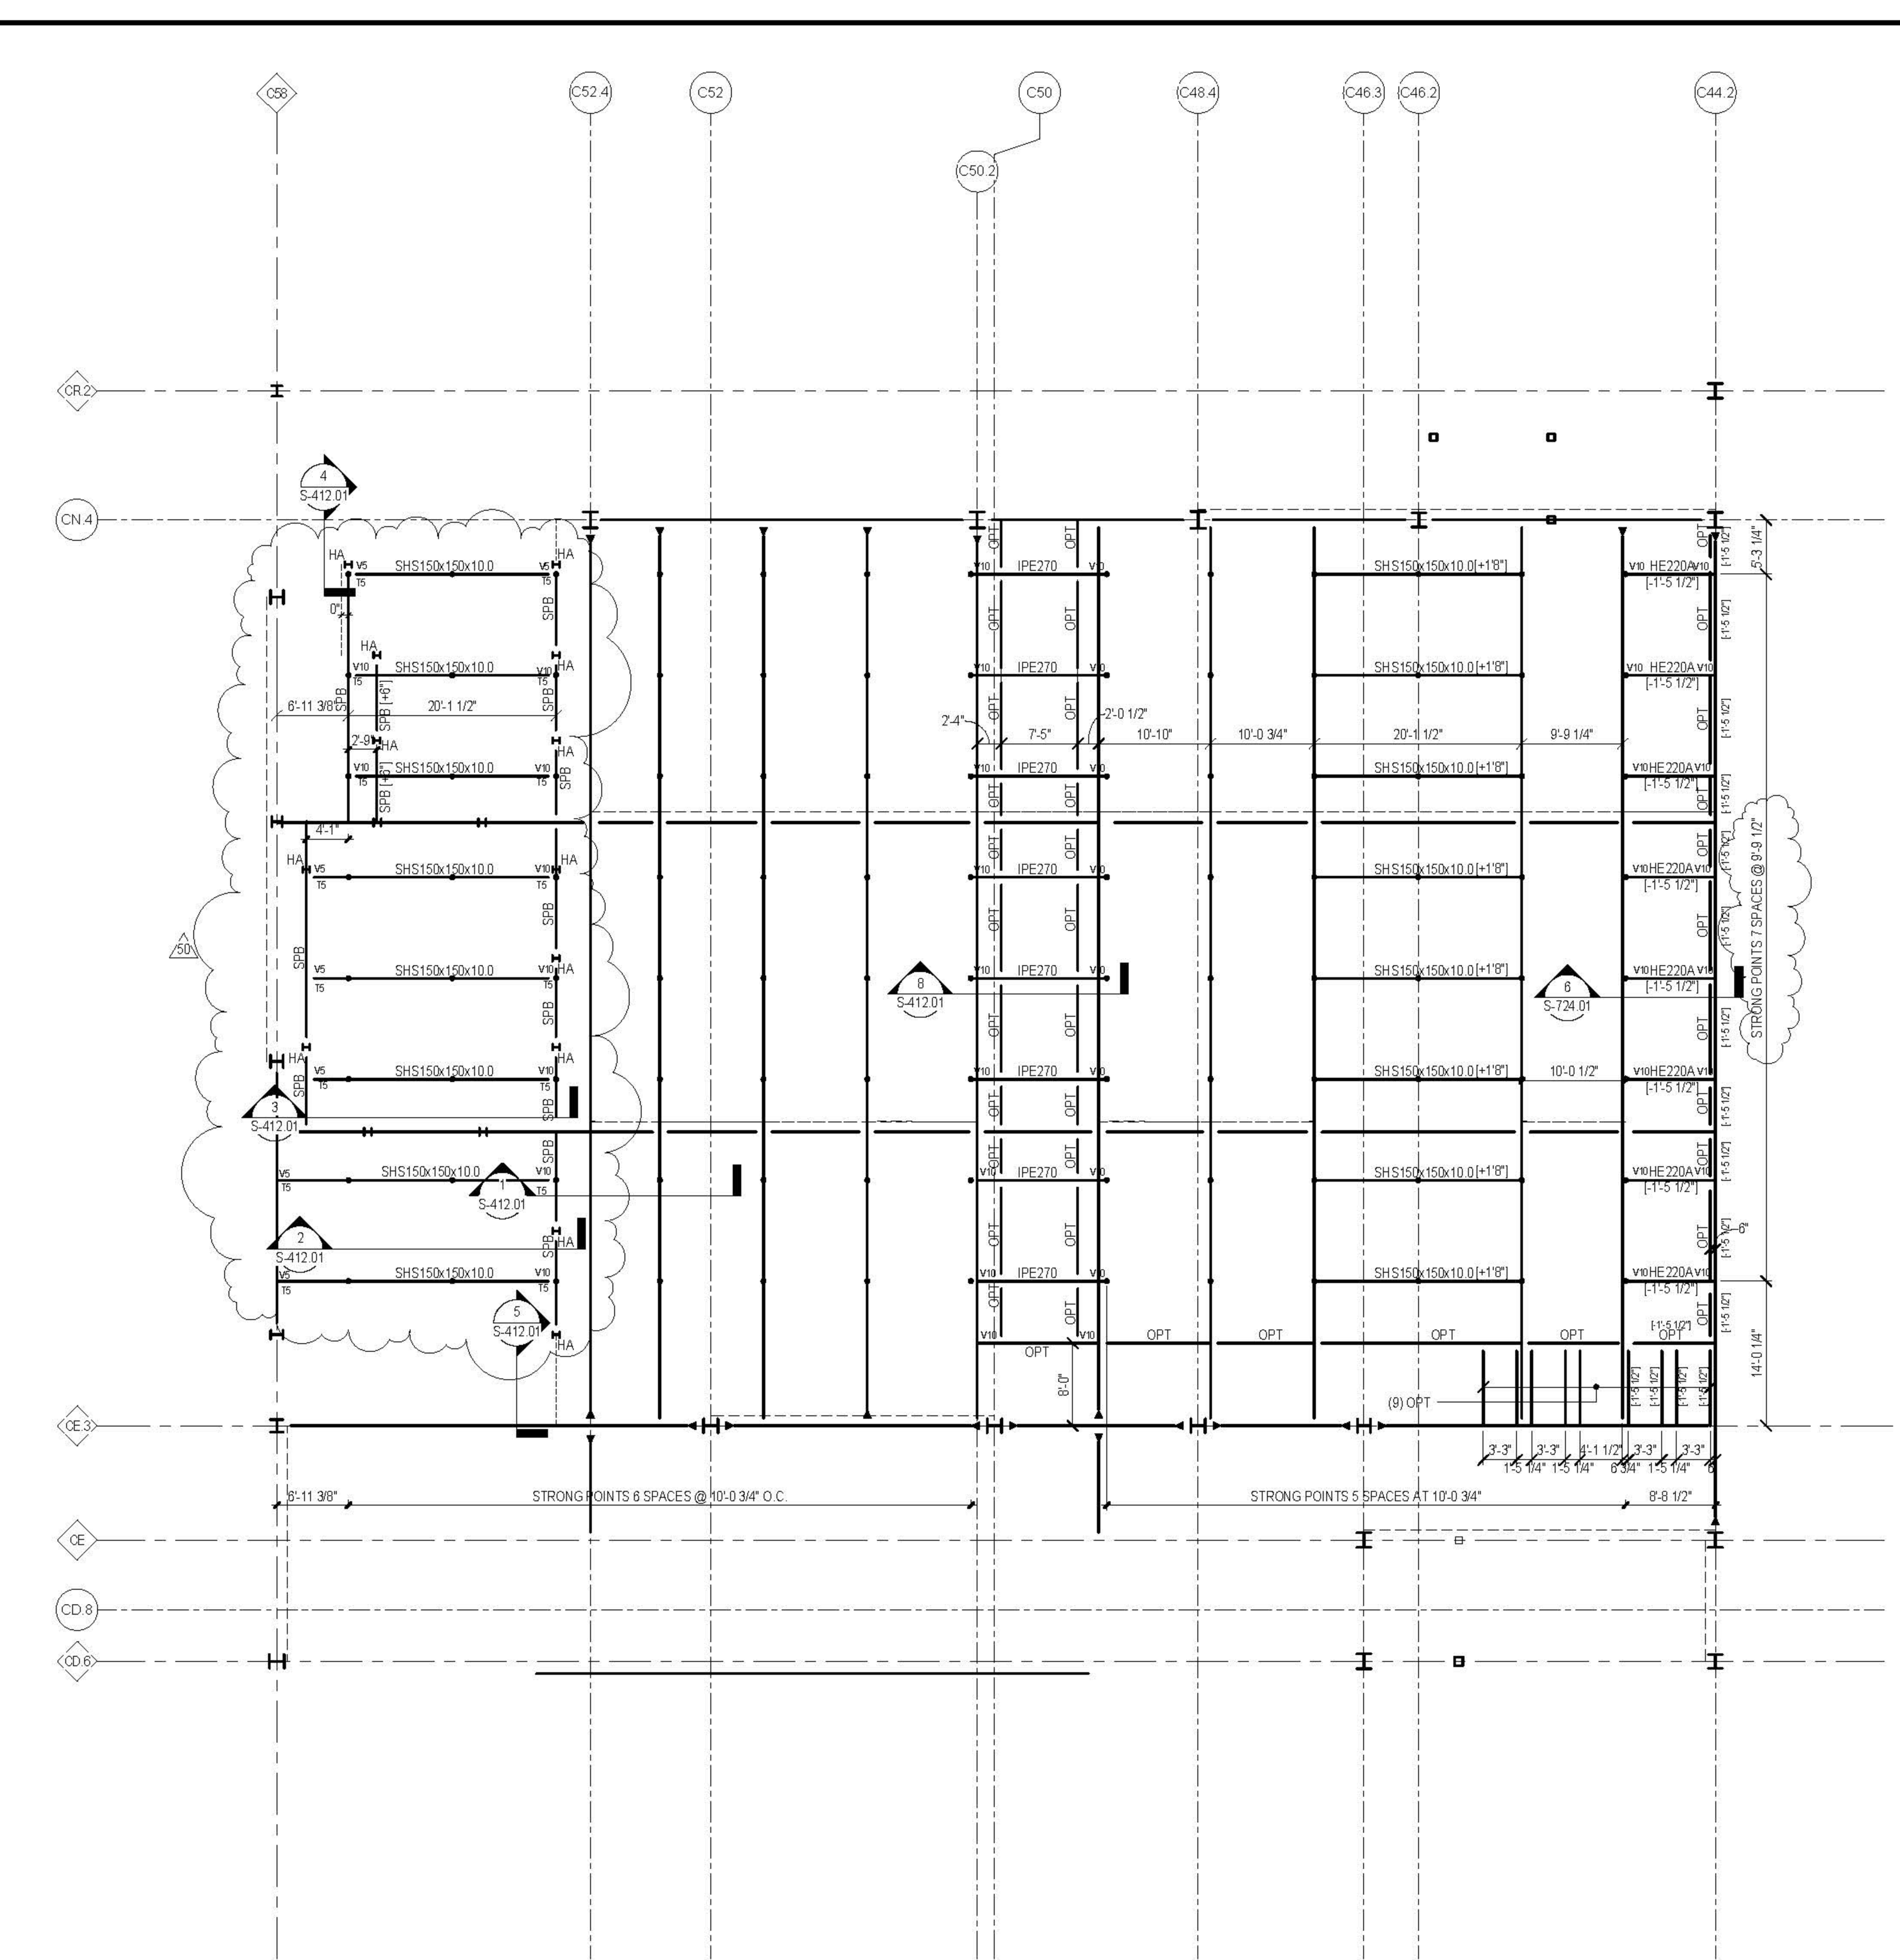

1 FIXED BUILDING LEVEL 08 STRONG POINT SUPPORT FRAMING PLAN
1/8" = 1'-0"

SHEET NOTES

- AT LEVEL 08 1/2 STEEL EL. AS FOLLOWS, UCN:
 - RHS 117'-8" U.O.N. +/-X"
 - WIDE FLANGE 118'-8" U.O.N. +/-X"
- REFER TO S-108 FOR ALL FRAMING SIZES NOT INDICATED.
- NOTATIONS:
 - HA INDICATES IPE270 HANGER ABOVE. REFER TO DETAIL S-412 FOR DETAILS.
 - SPB INDICATES RHS150x150x10.0 STRONG POINT SUPPORT BEAM. CONNECT FOR MIN. V5, T5, EA. END UNLESS OTHERWISE NOTED ON PLAN.
 - OPT INDICATES HE220A SUPPORT FOR OPERABLE PARTITION TRACK. CONNECT FOR V10 EACH END UNLESS OTHERWISE NOTED ON PLAN.
- SYMBOLS:
 - INDICATES STRONG POINT AND PIPE GRID SUPPORT LOCATION. REFER TO ARCH DWGS FOR ADDITIONAL INFORMATION. SUPPORT FRAMING IS DESIGNED FOR 1000 LB MAXIMUM LOAD DIRECTLY RIGGED TO STRONG POINT AND FOR PIPE GRID WITH 3LB/FT SELF WEIGHT AND 30LB/FT RIGGING ALLOWANCE. MAXIMUM SIMULTANEOUS LOADING ON STRONG POINTS AND PIPE GRID NOT TO EXCEED 25 PSF.

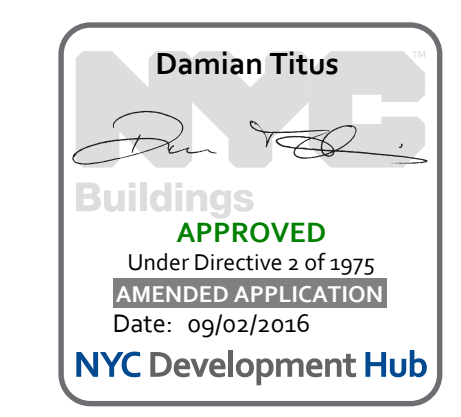

CULTURE SHED

540 West 30th Street
New York, New York 10001

OWNER
CULTURE SHED INC.

ARCHITECTS
Oller Scaletto + Renfro Architects, DPC
601 West 26th Street #815
New York, New York 10001
T: 212.260.7971

rockwellgroup
5 Union Sq. West, 6th Fl.
New York, New York 10003
T: 212.463.0334
F: 212.463.0335

STRUCTURAL ENGINEER
Thornton Tomasetti
51 Madison Avenue
New York, New York 10010
T: 917.661.7800
F: 917.661.7801

MEP ENGINEER
Jans Baum & Bolles
60 Pine Street
New York, New York 10005
T: 212.530.9300
F: 212.260.6944

FACADE CONSULTANT
Thornton Tomasetti
51 Madison Avenue
New York, New York 10010
T: 917.661.7800
F: 917.661.7801

KINETICS ENGINEER
Hardisty & Hanover
1501 Broadway
New York, New York 10036
T: 212.944.1150
F: 212.391.0337

LIGHTING DESIGNER
Tilston Design Associates
40 North Street #1650
New York, New York 10013
T: 212.675.7760

THEATRE PLANNING & DESIGN
Fisher Dodge Associates
22 West 15th Street
New York, New York 10011
T: 212.691.3000

LIFE SAFETY
Code Consultants, Inc.
215 West 43rd St, 15th Fl.
New York, New York 10018
T: 212.216.9596

ENERGY MODEL/LEED
Vindian
60 Washington Street
Norwalk, CT 06854
T: 203.298.1411

ACOUSTIC/AUDIO-VISUAL
Avalonville
93 North Main Street
South Norwalk, CT 06854
T: 347.210.5540

VERTICAL TRANSPORTATION
Van Dusen & Associates
5 Regent Street, Suite 524
Livingston, NJ 07039
T: 973.994.9220

SPECIFICATIONS
Construction Specifications Inc.
PO Box 489
227 Tenth Road
Morganville, NJ 07751
T: 732.970.0700
F: 732.970.0700


SECURITY
Duchella Venter & Santoro
1020 Sherman Avenue
Hartford, CT 06114
T: 203.288.6490

WATERPROOFING
James R. Gahfort AIA Consulting Architects PC
104 West 27th Street
New York, NY 10001
T: 212.736.3344

FACADE MAINTENANCE
Frank Engineering PLLC
162 Avenue Street
New York, NY 10005
T: 212.698.3000

BRANDING/GRAPHICS
21st Global Design Consultancy
180 York Street 15th Floor
New York, NY 10014
T: 212.647.1170

KEY PLAN

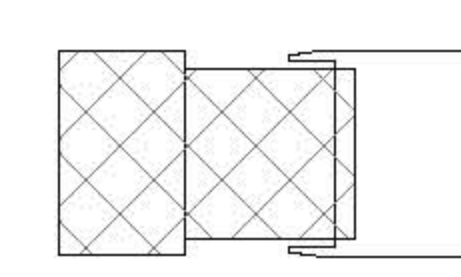

ISSUE PRINTING DATE

ISSUE	PRINTING	DATE
01	00	08.19.2016
11	0	04.10.2016
10	4	03.18.2016
9	3	02.16.2016
6	2	12.10.2014
3	1	10.03.2014

STAMP



DRAWN BY
Autumn


CHECKED BY
Chris

PROJECT NUMBER
N1318.00


TITLE
TYPICAL STRONG POINT SUPPORT FRAMING DETAILS

DRAWING NO.
S-412.01


8. SCAN NO.
54 of 123

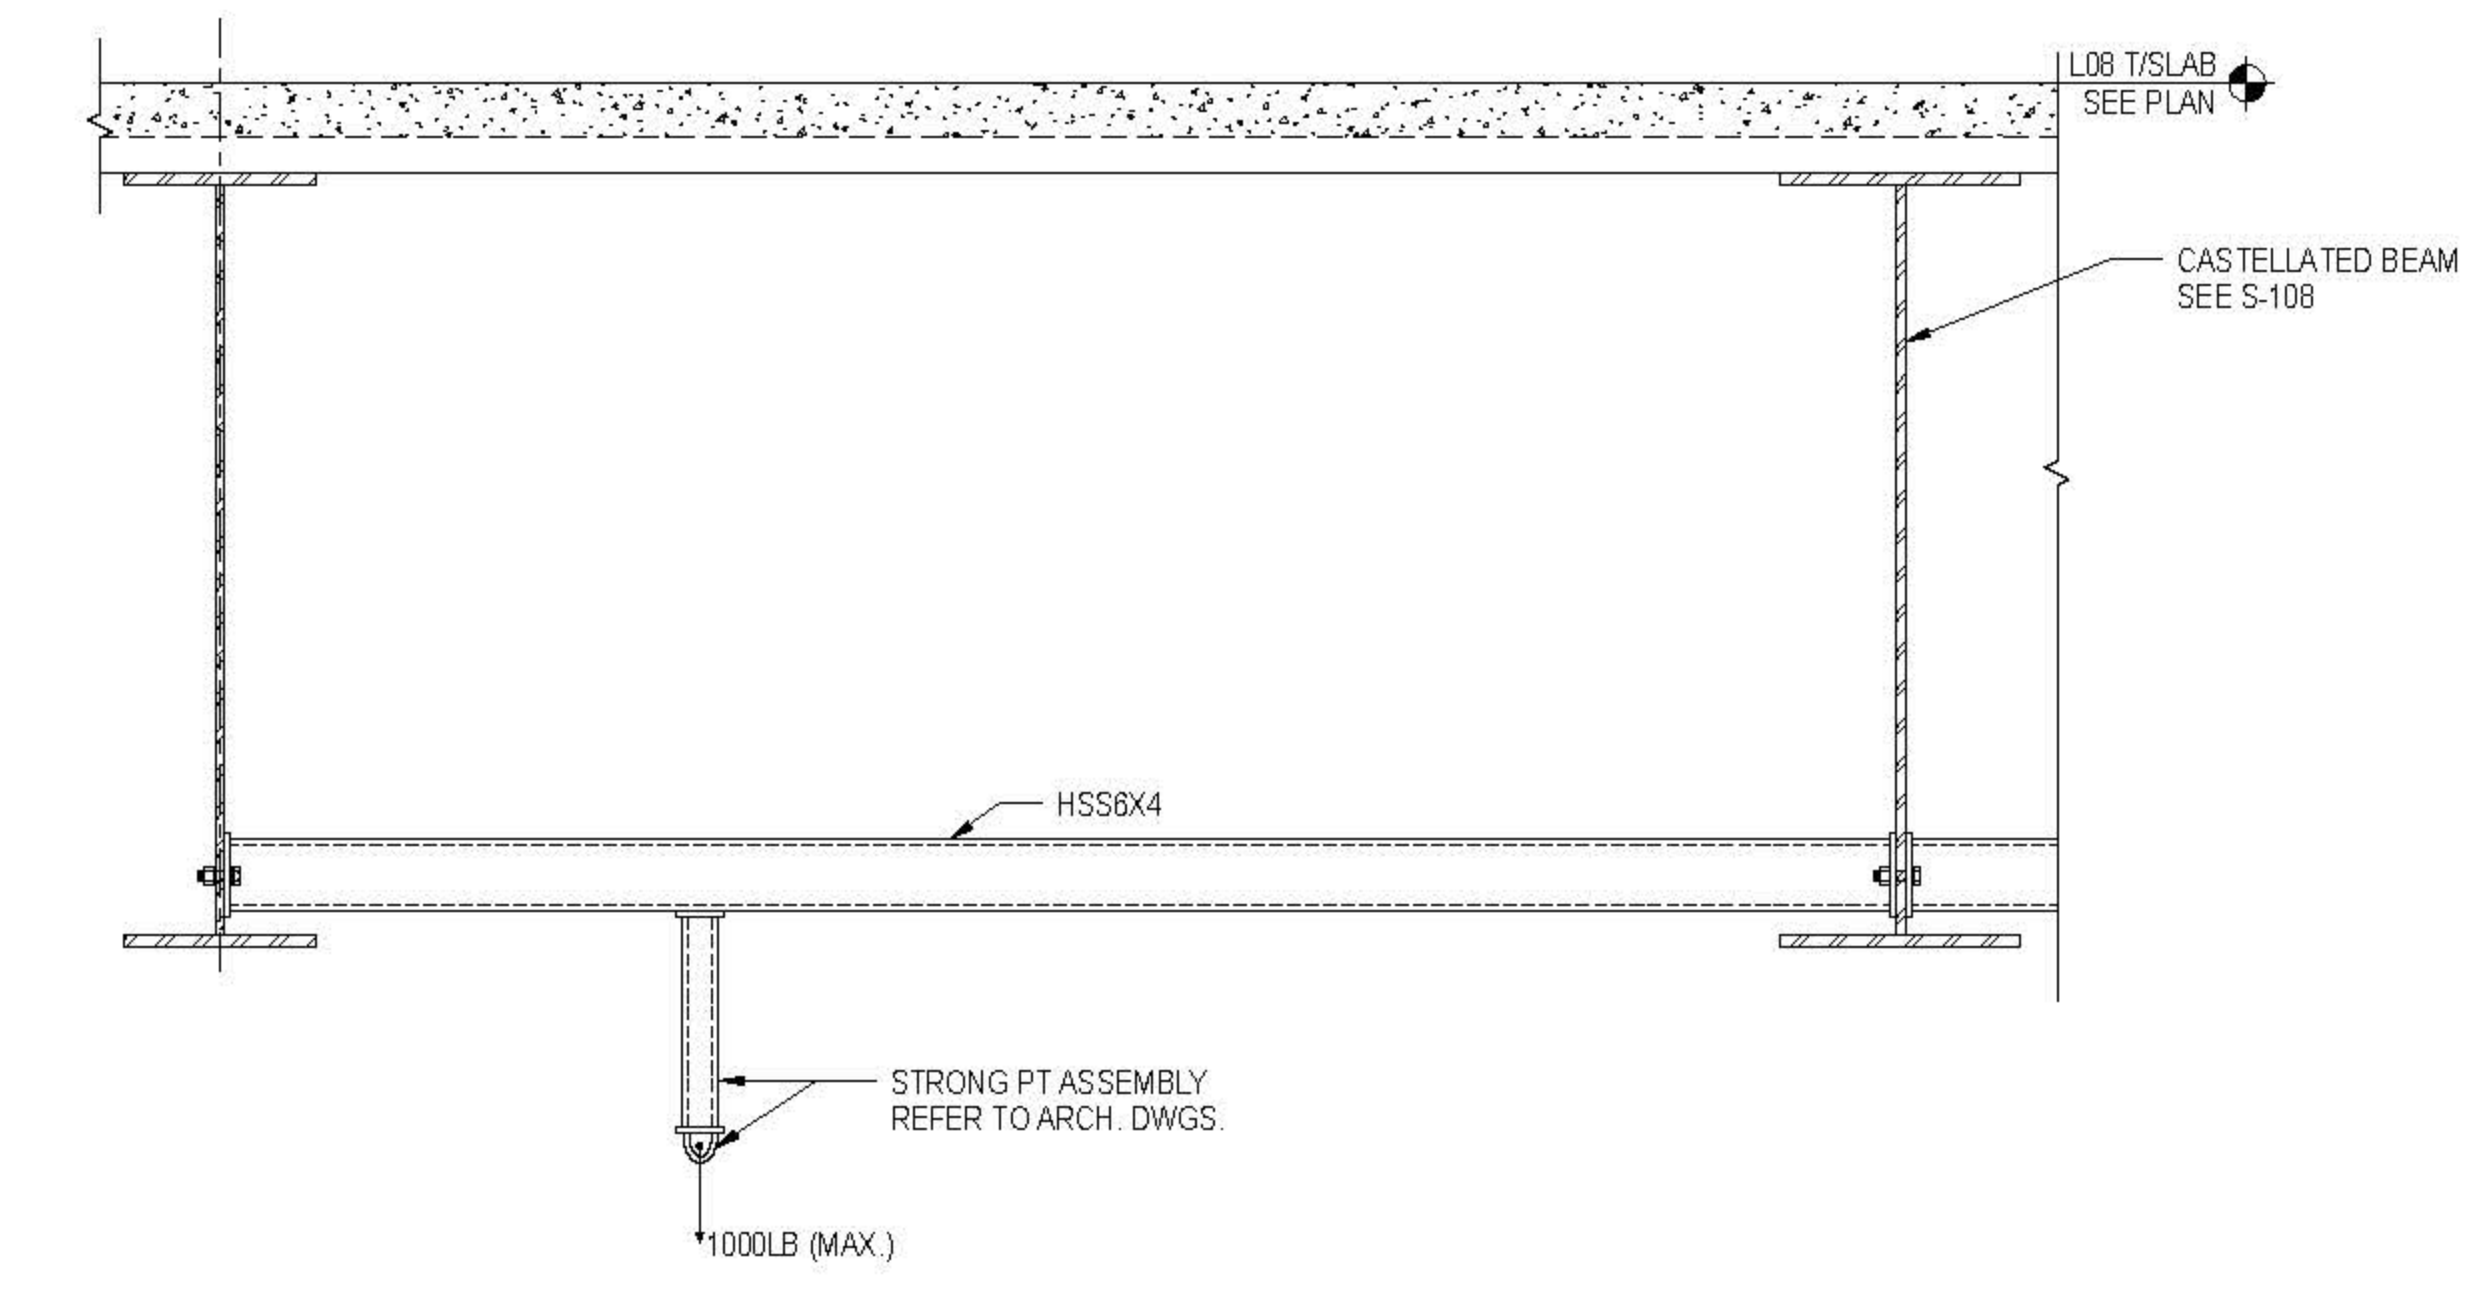


1 TYPICAL STRONG POINT SUPPORT BETWEEN CASTELLATED BEAMS
3/4" = 1'-0"

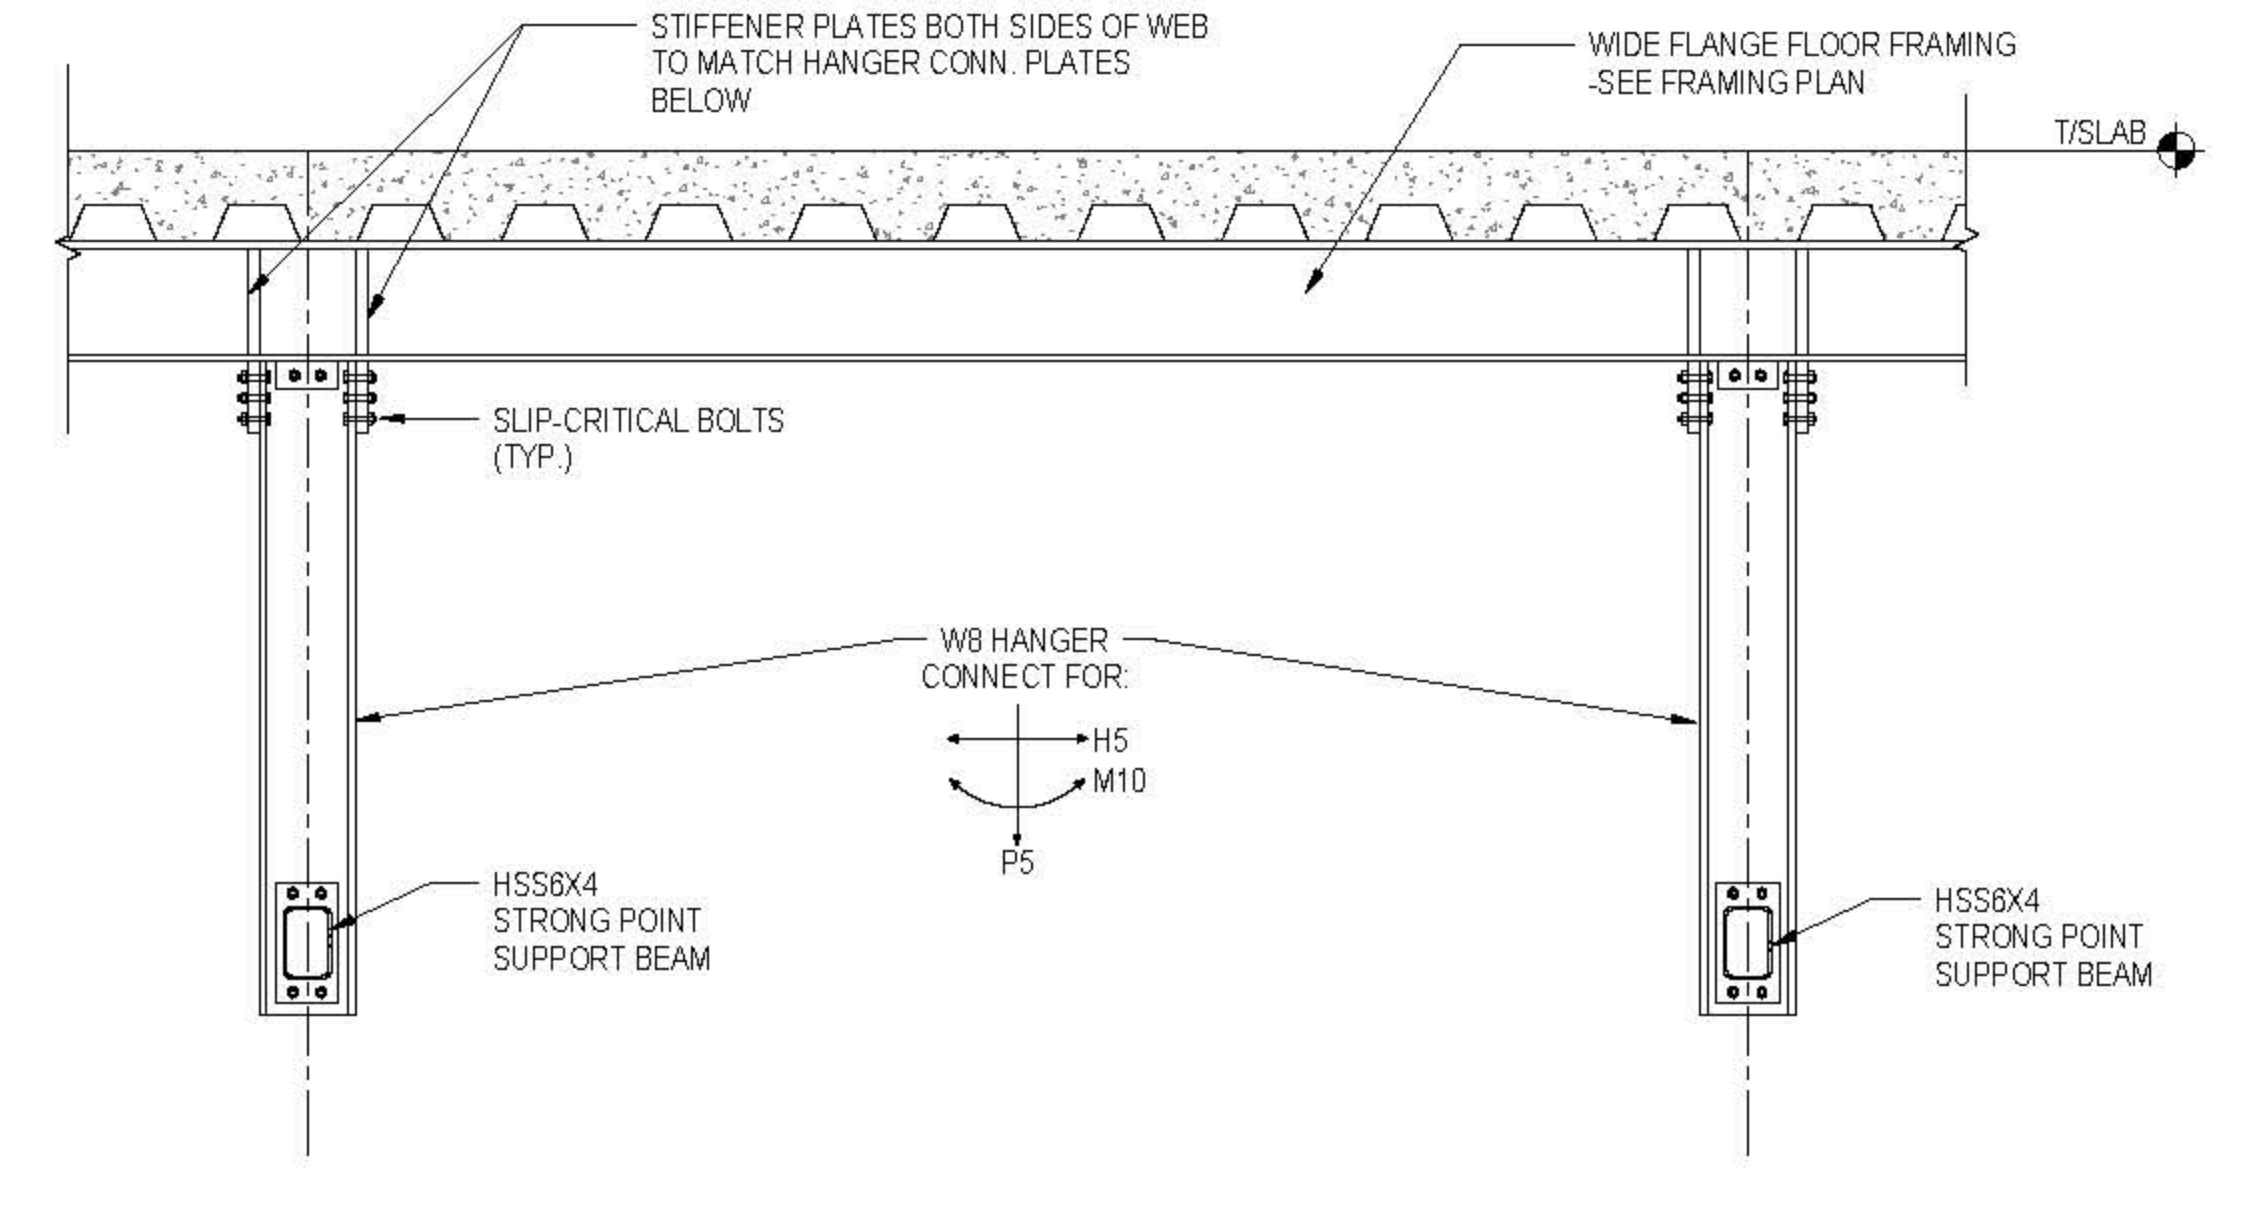


2 TYPICAL HANGER DETAIL FOR STRONG POINT SUPPORT BEAMS
3/4" = 1'-0"

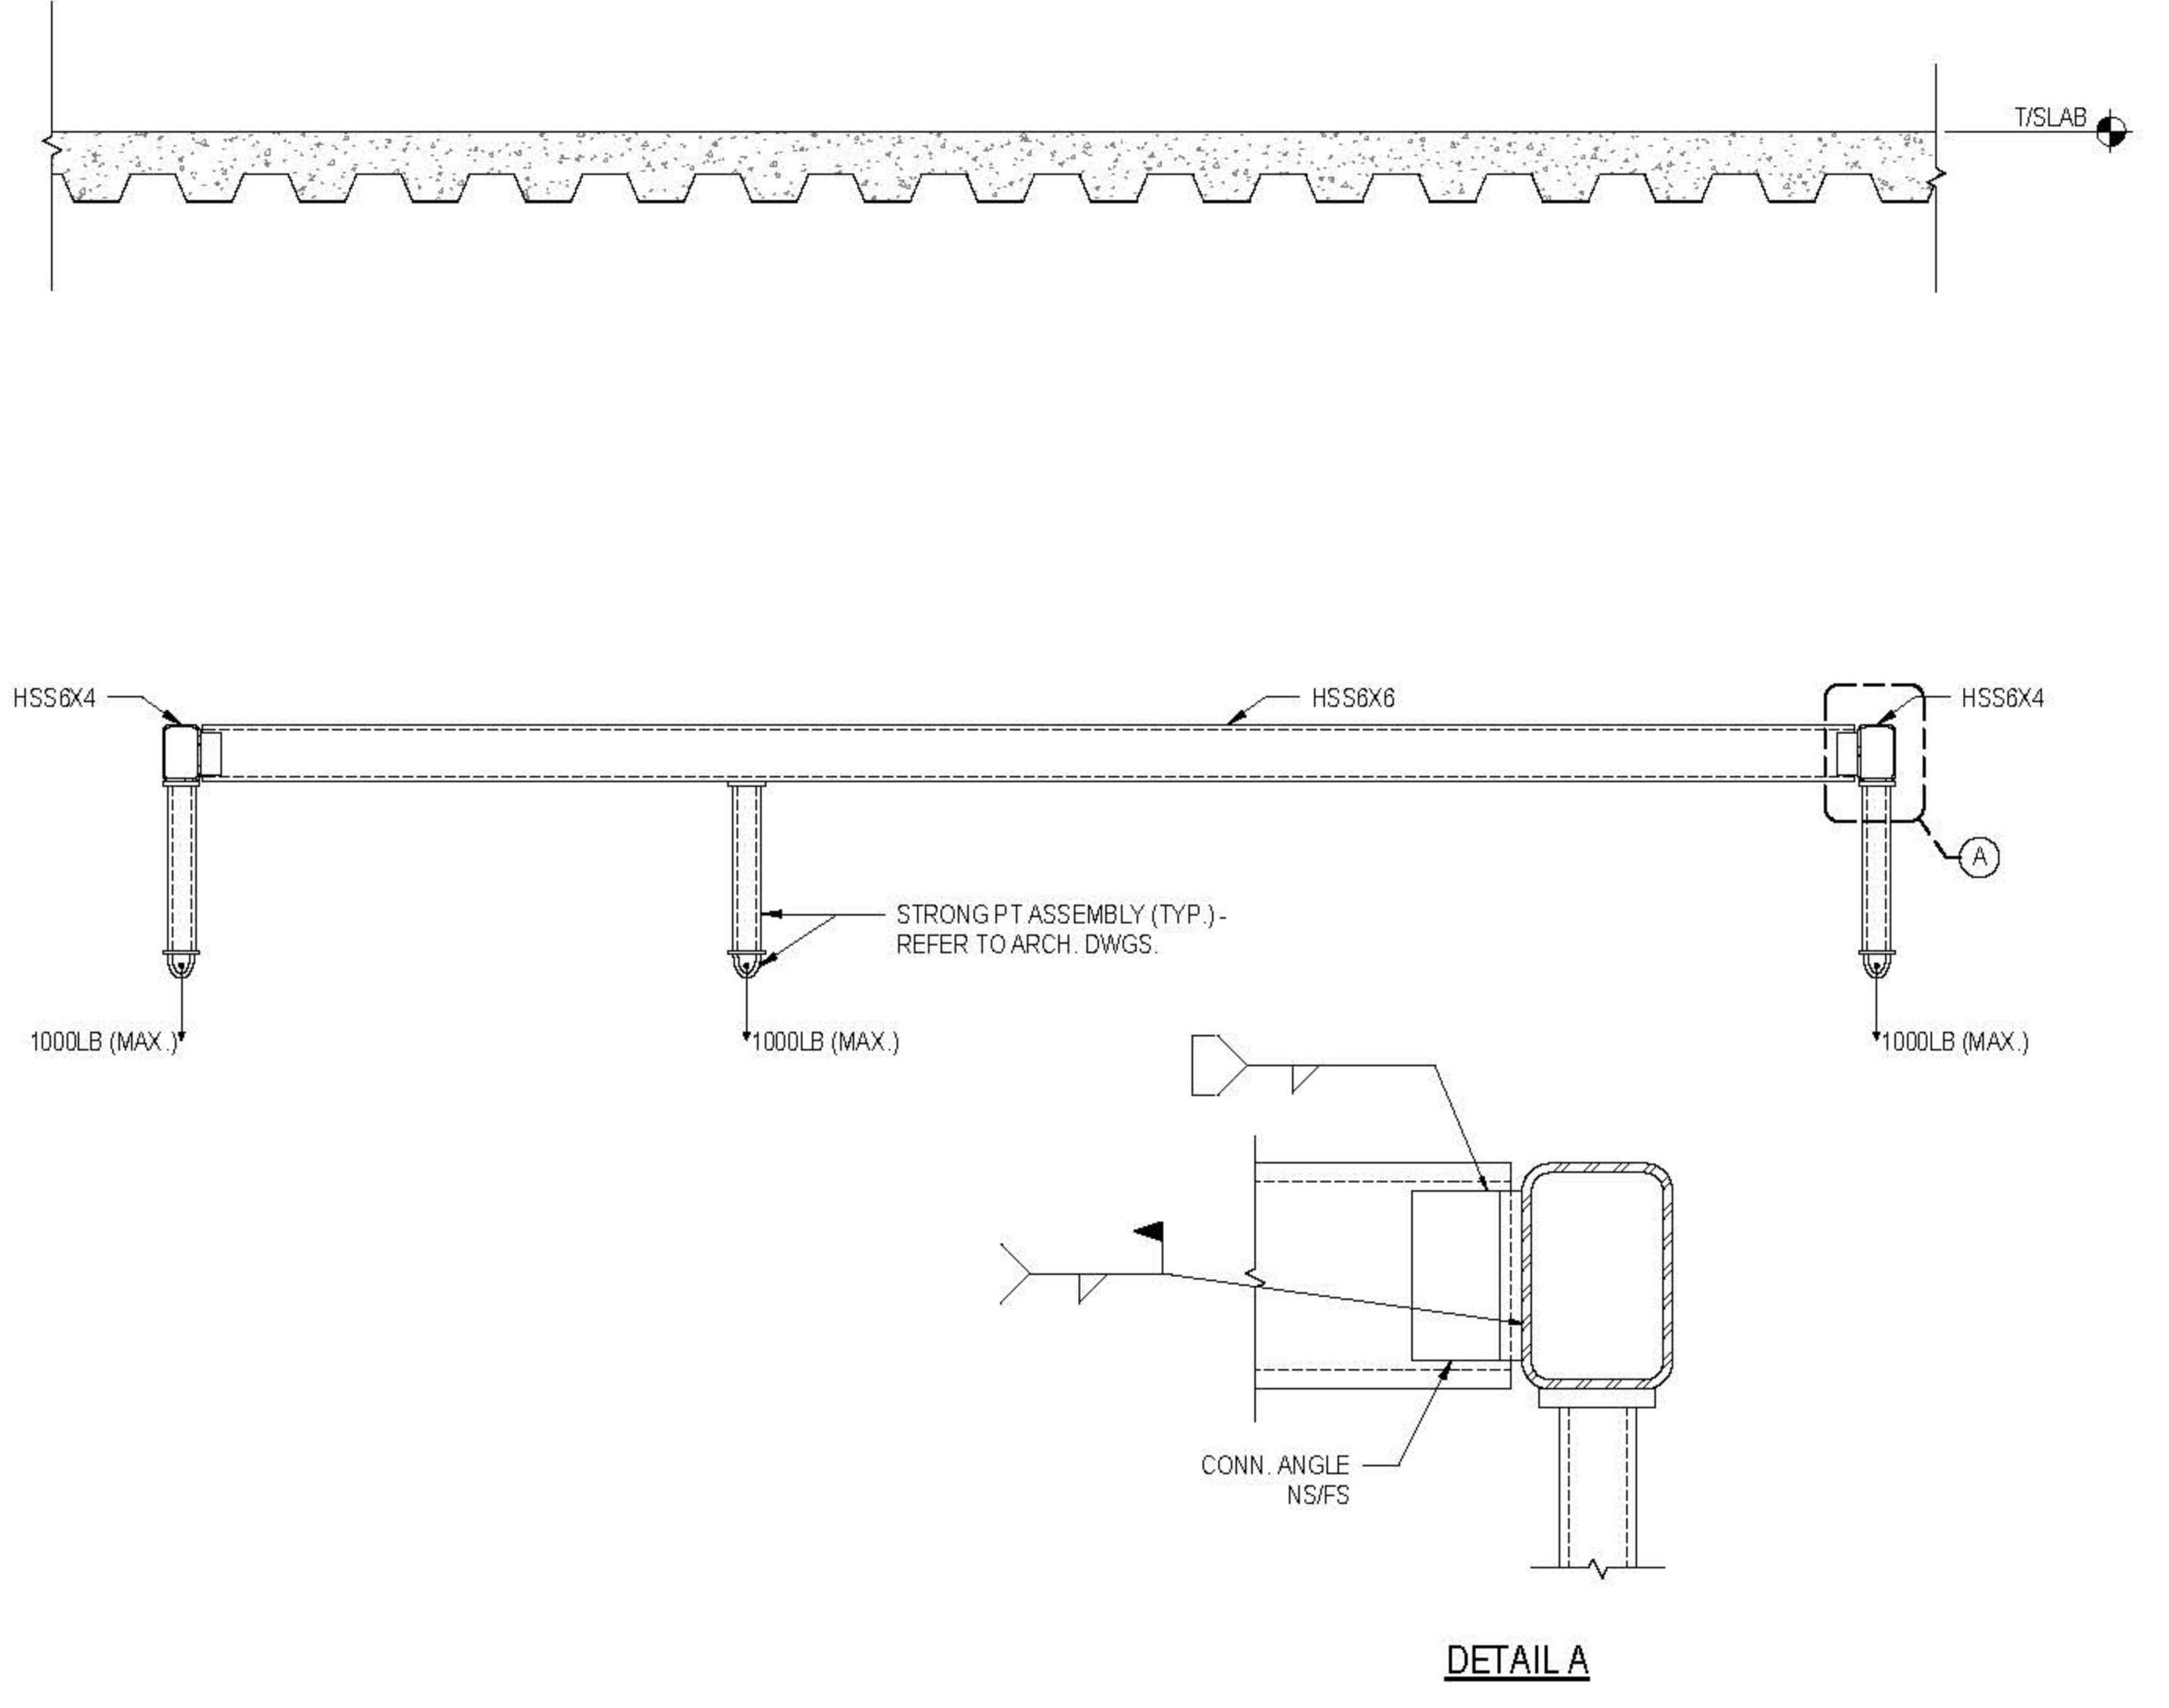


3 TYPICAL STRONG POINT BEAM SECTION AT LEVEL 08 WEST BAY
3/4" = 1'-0"

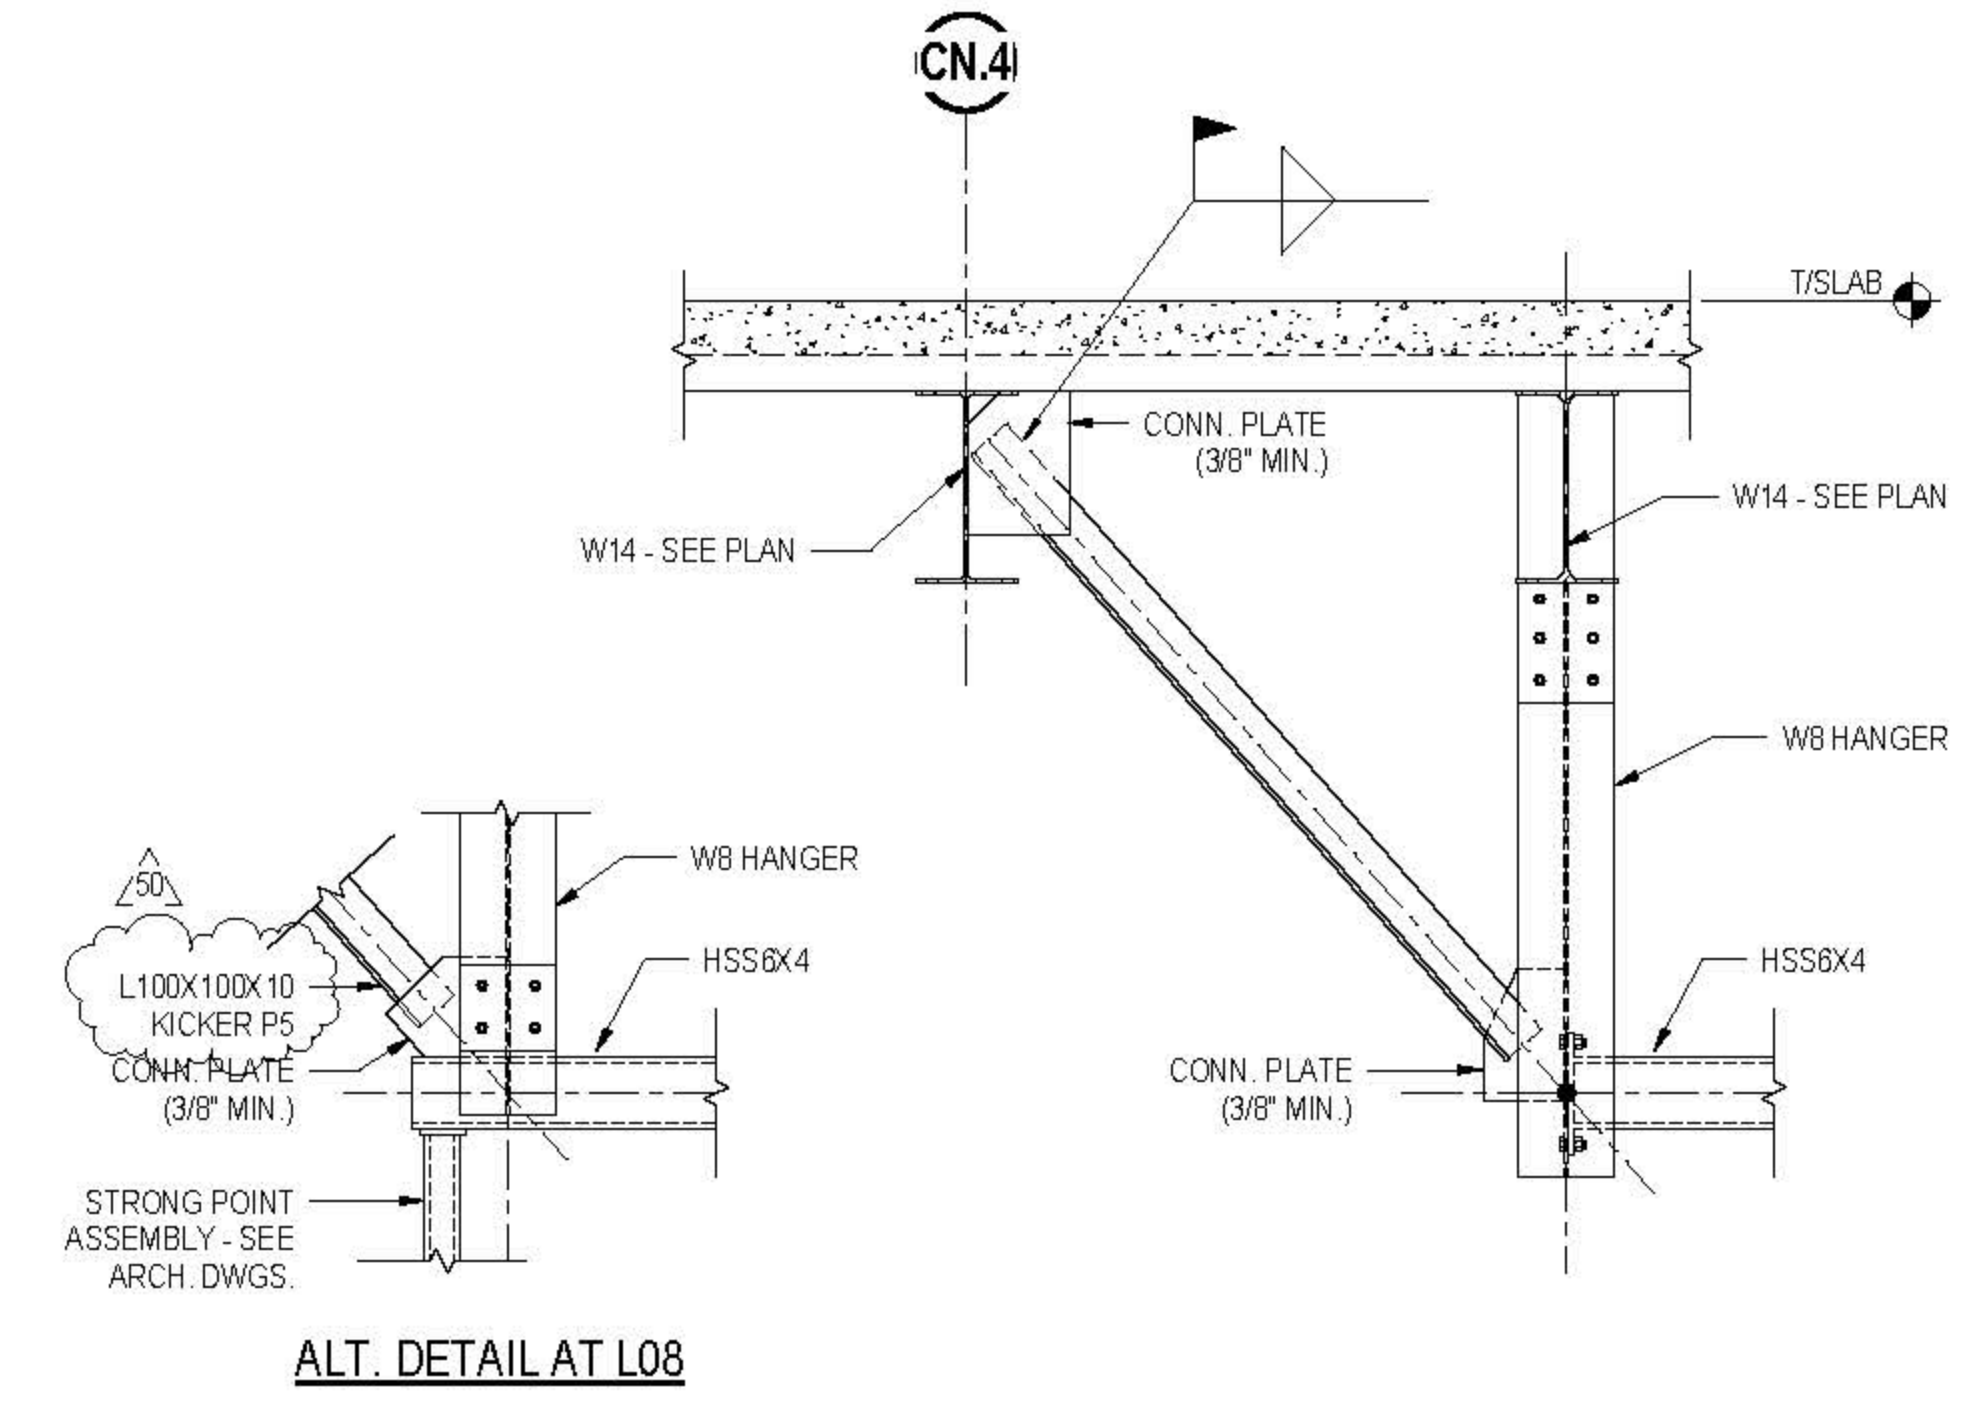


4 TYPICAL KICKER AT CN.4
3/4" = 1'-0"

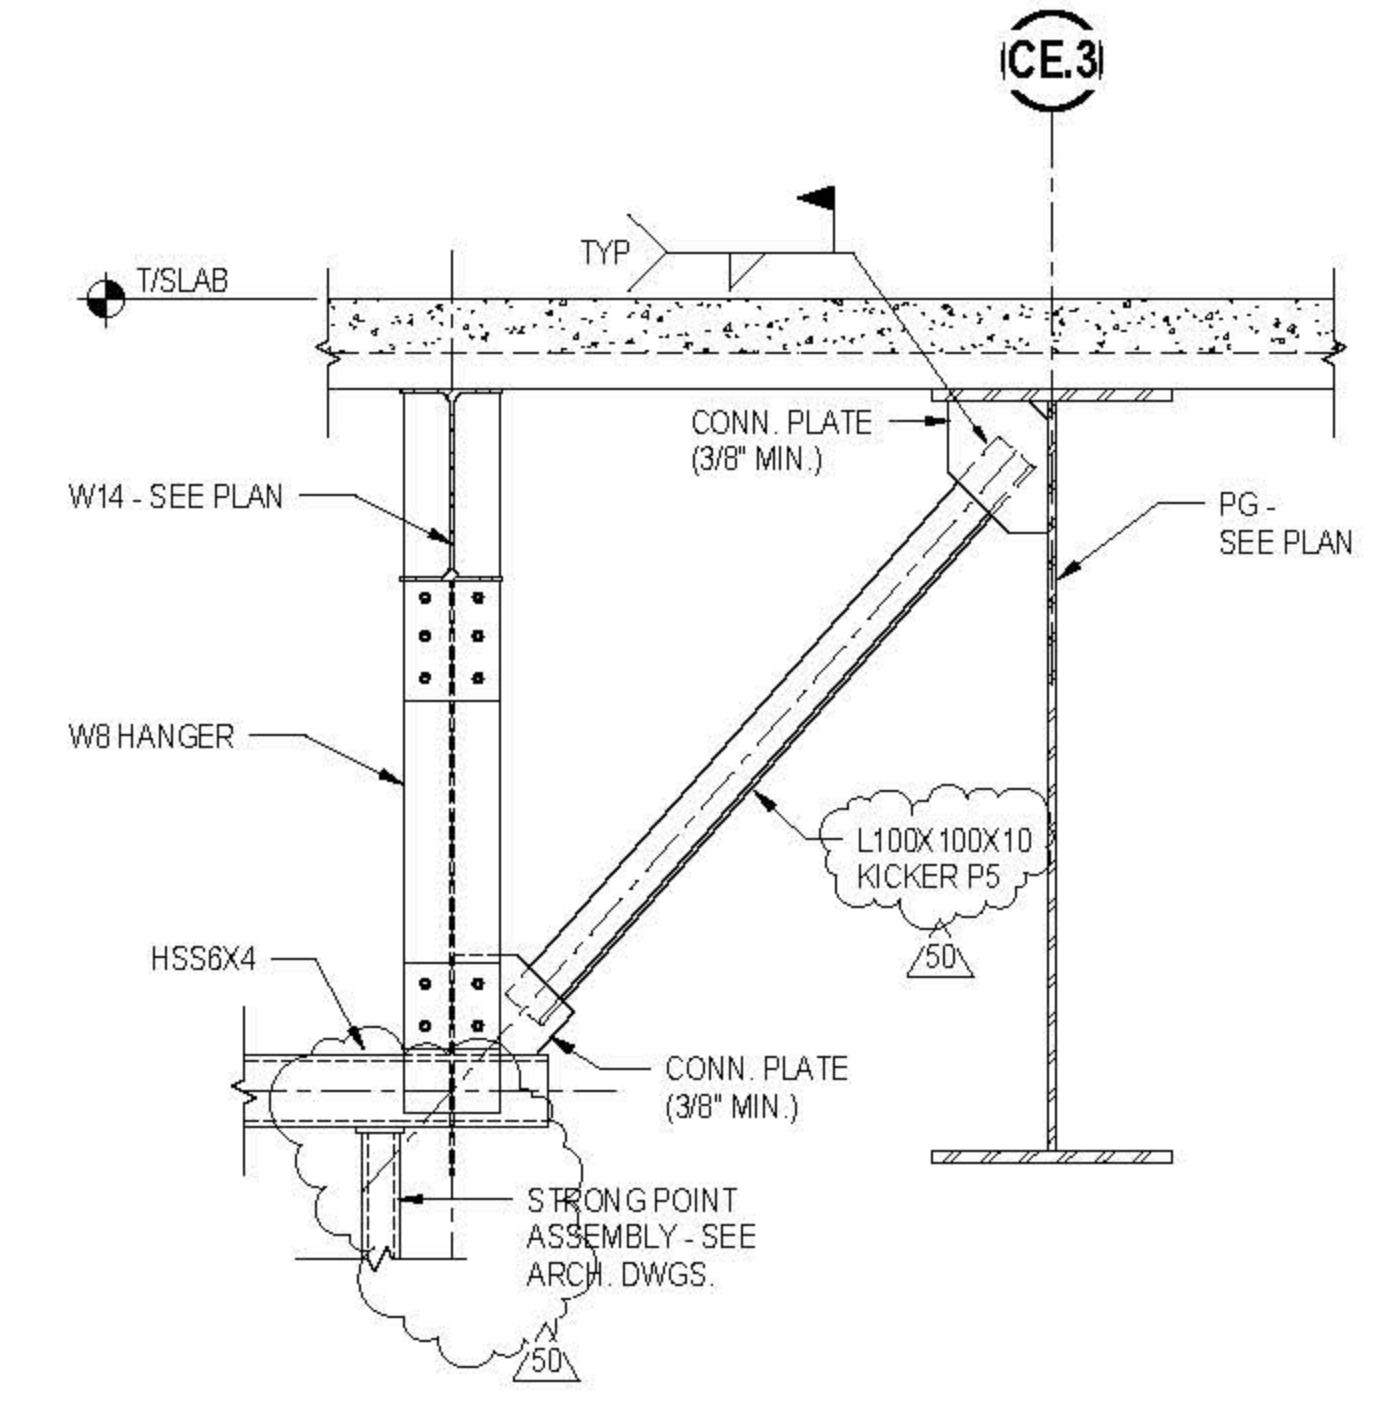


5 TYPICAL KICKER AT CE.3
3/4" = 1'-0"

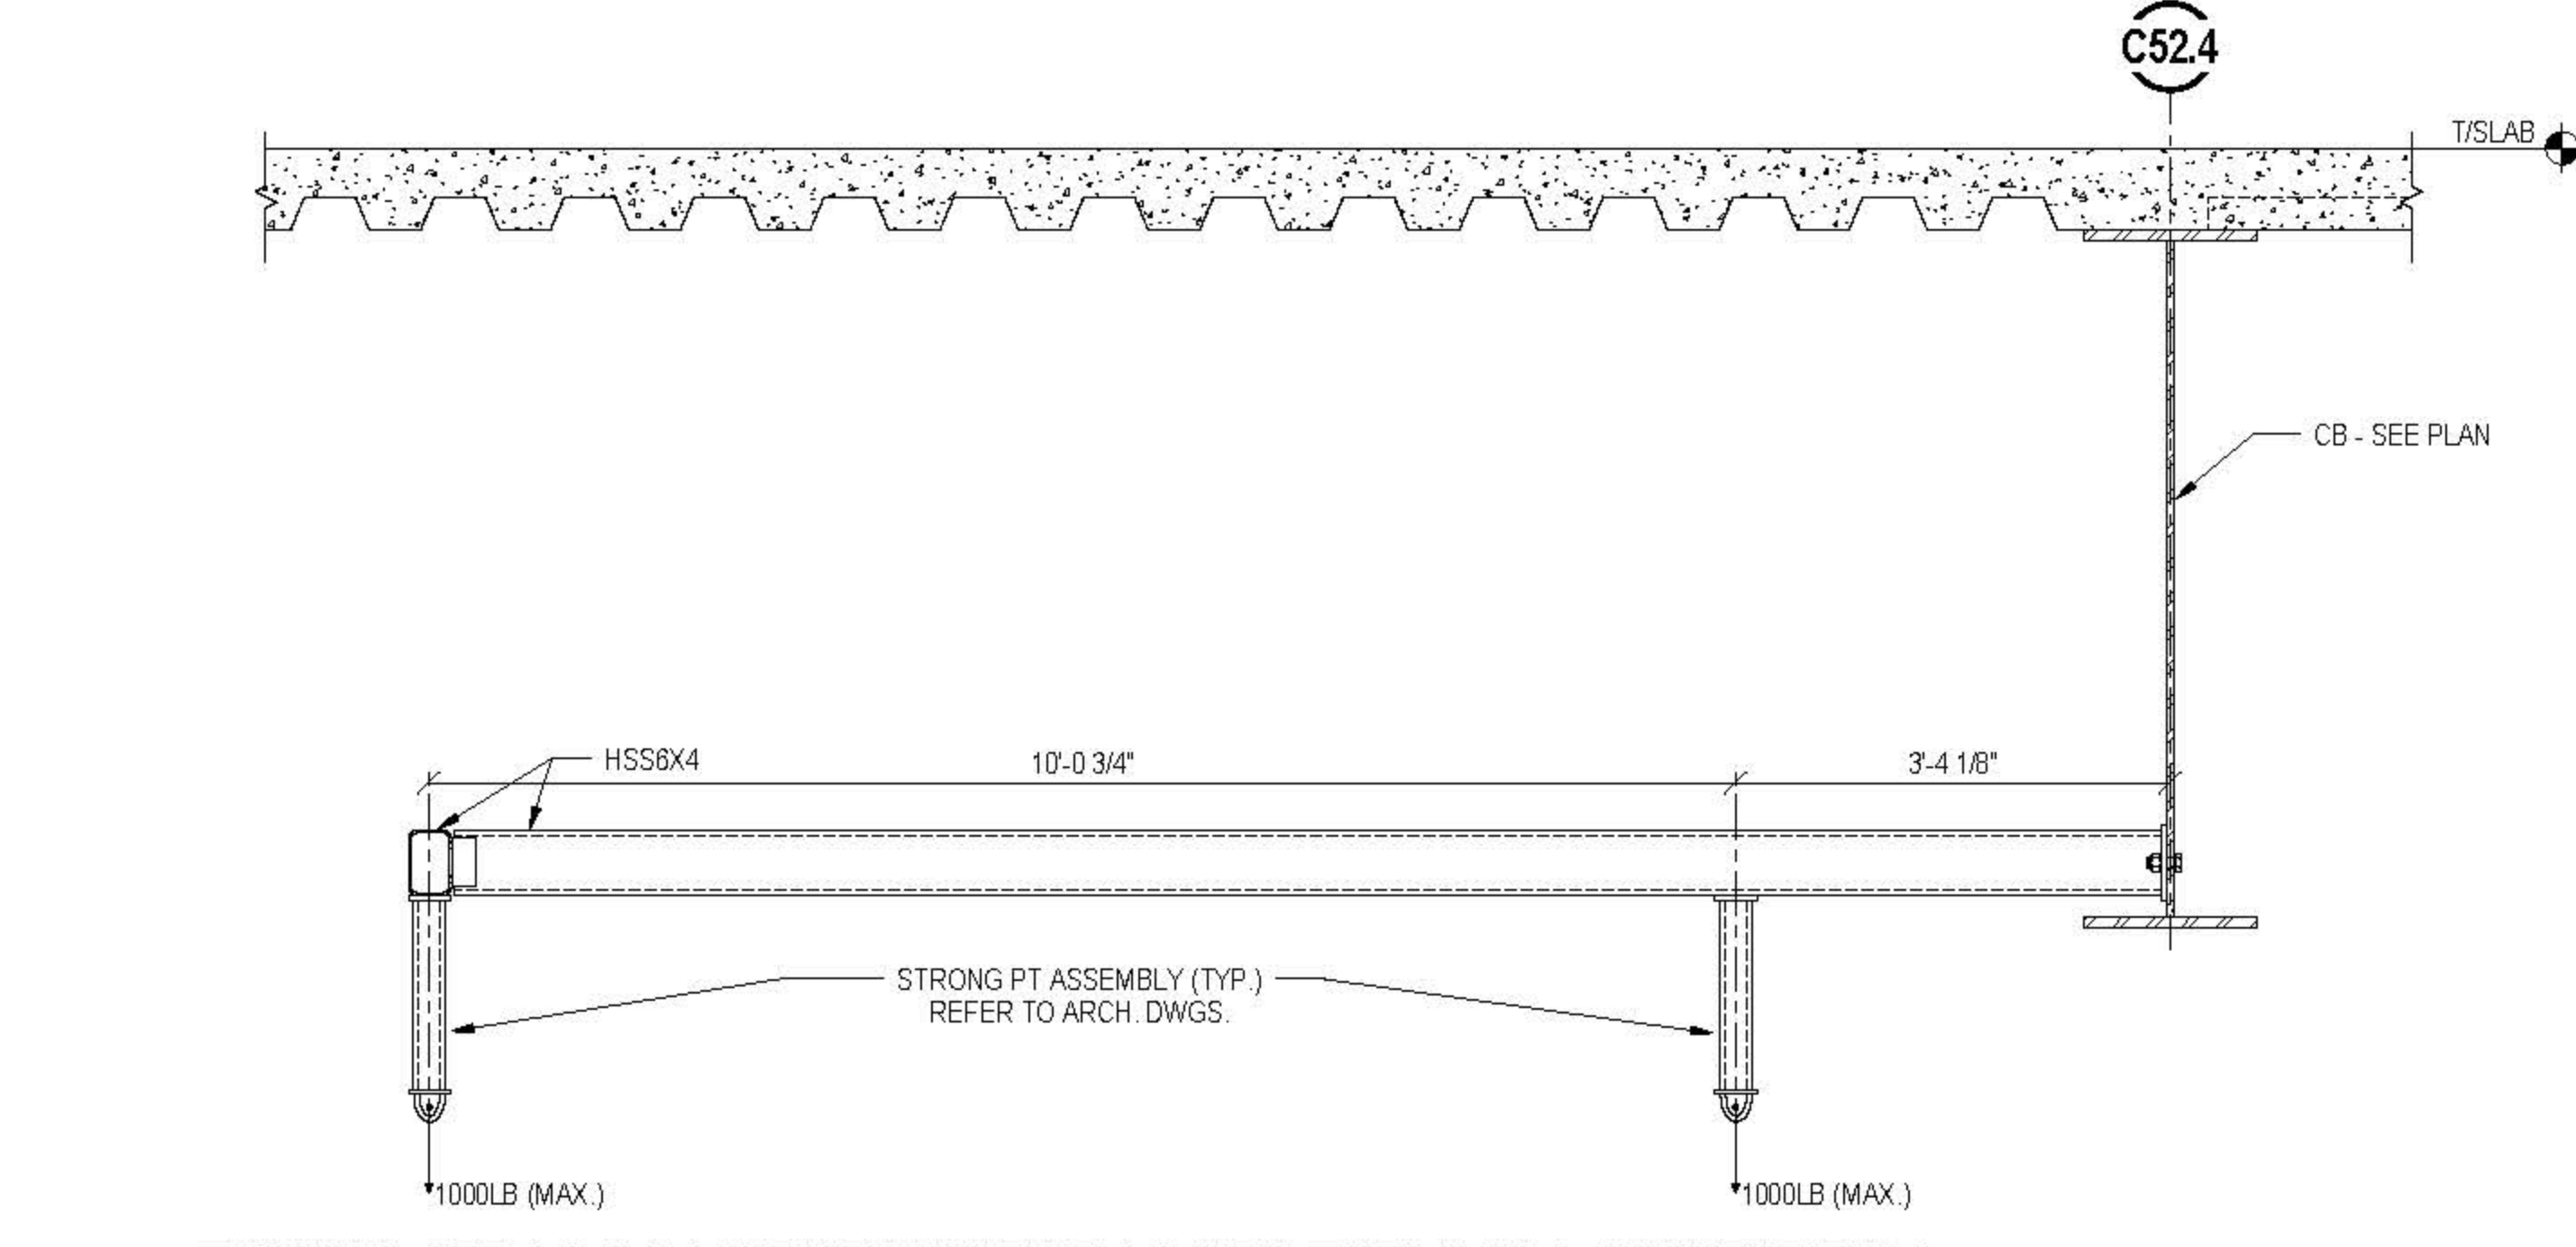

6 TYPICAL STRONG POINT BEAM SECTION AT LEVELS 04 & 06 WEST BAY
3/4" = 1'-0"

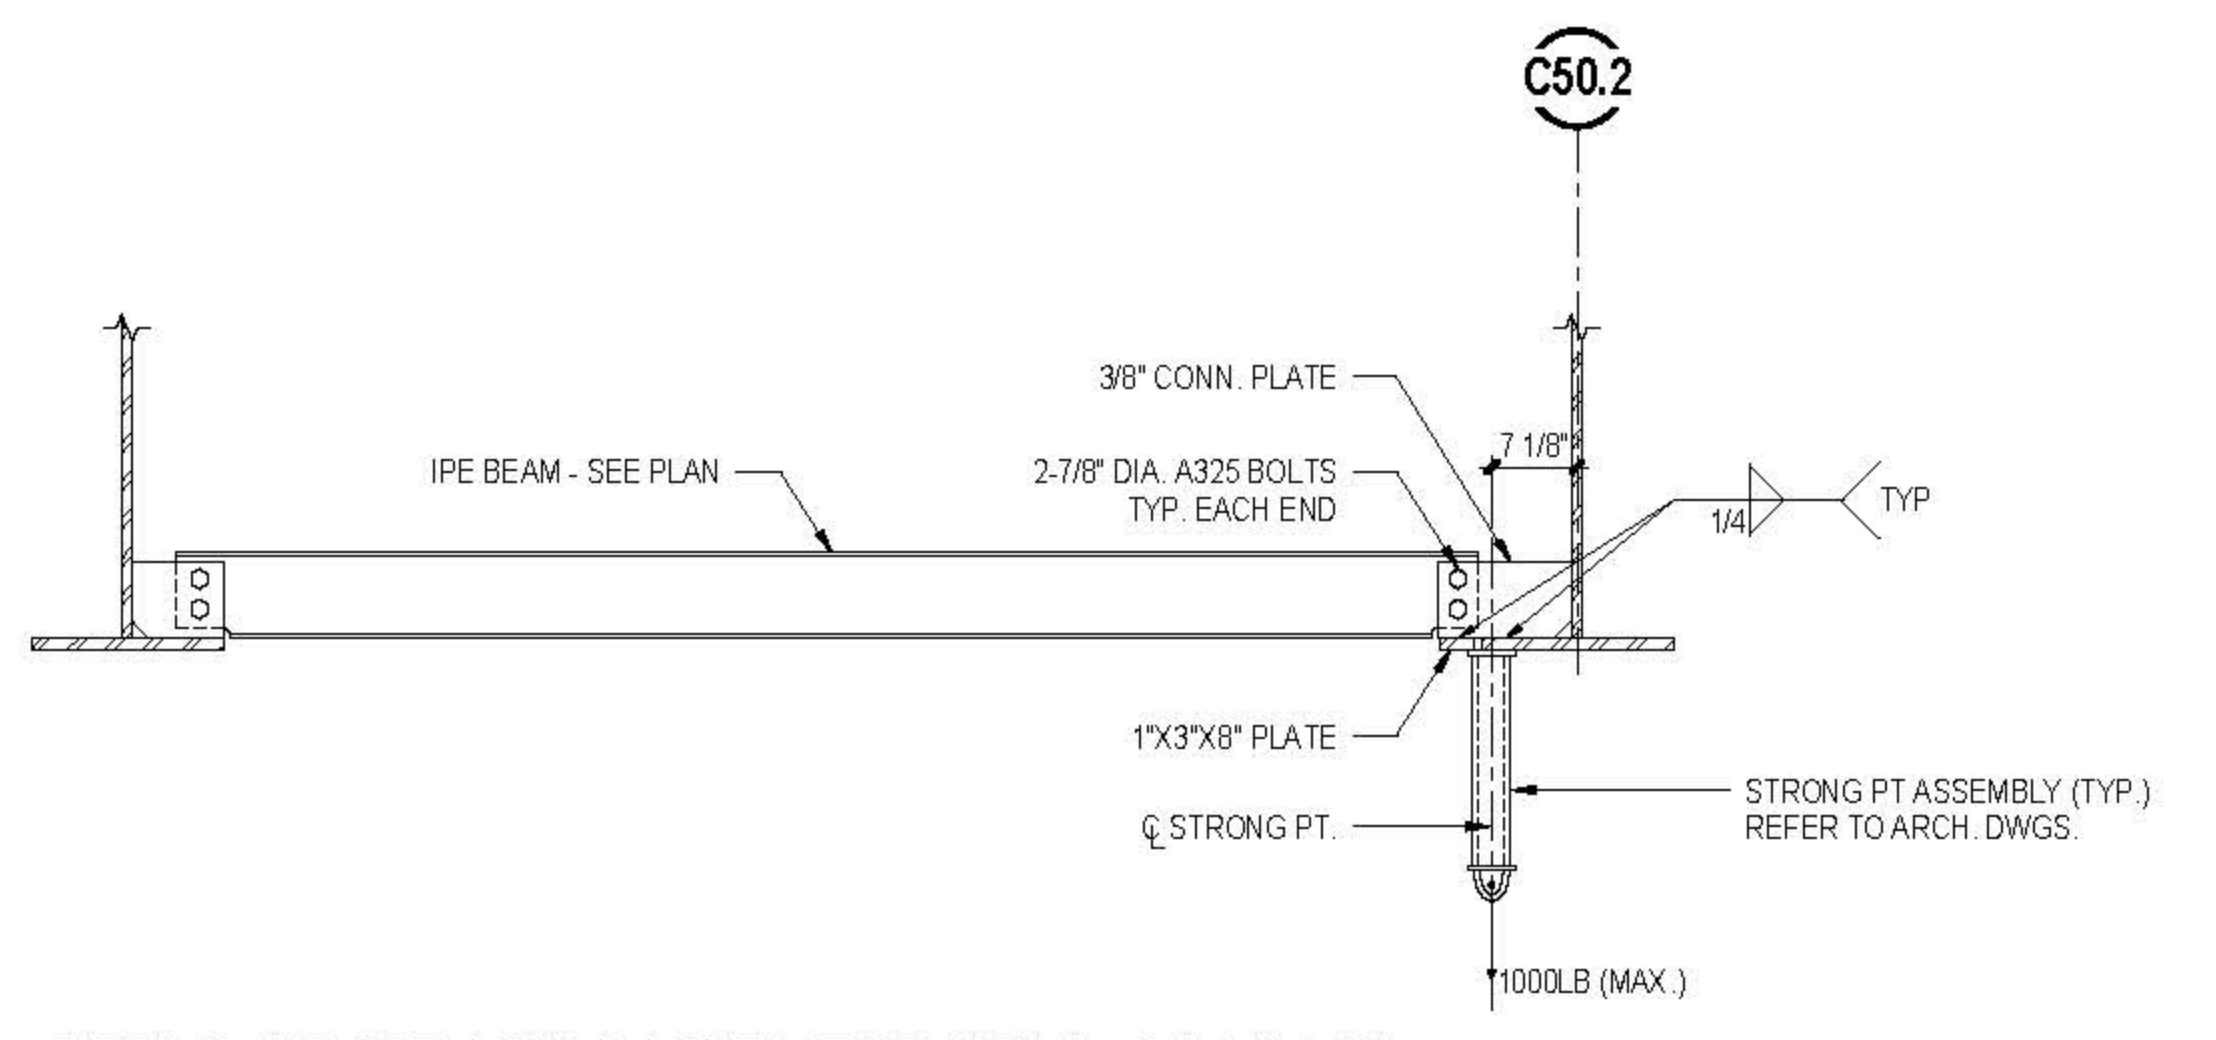

7 DETAIL AT STRONG POINT NEAR C50.2 - L04 & L06
3/4" = 1'-0"

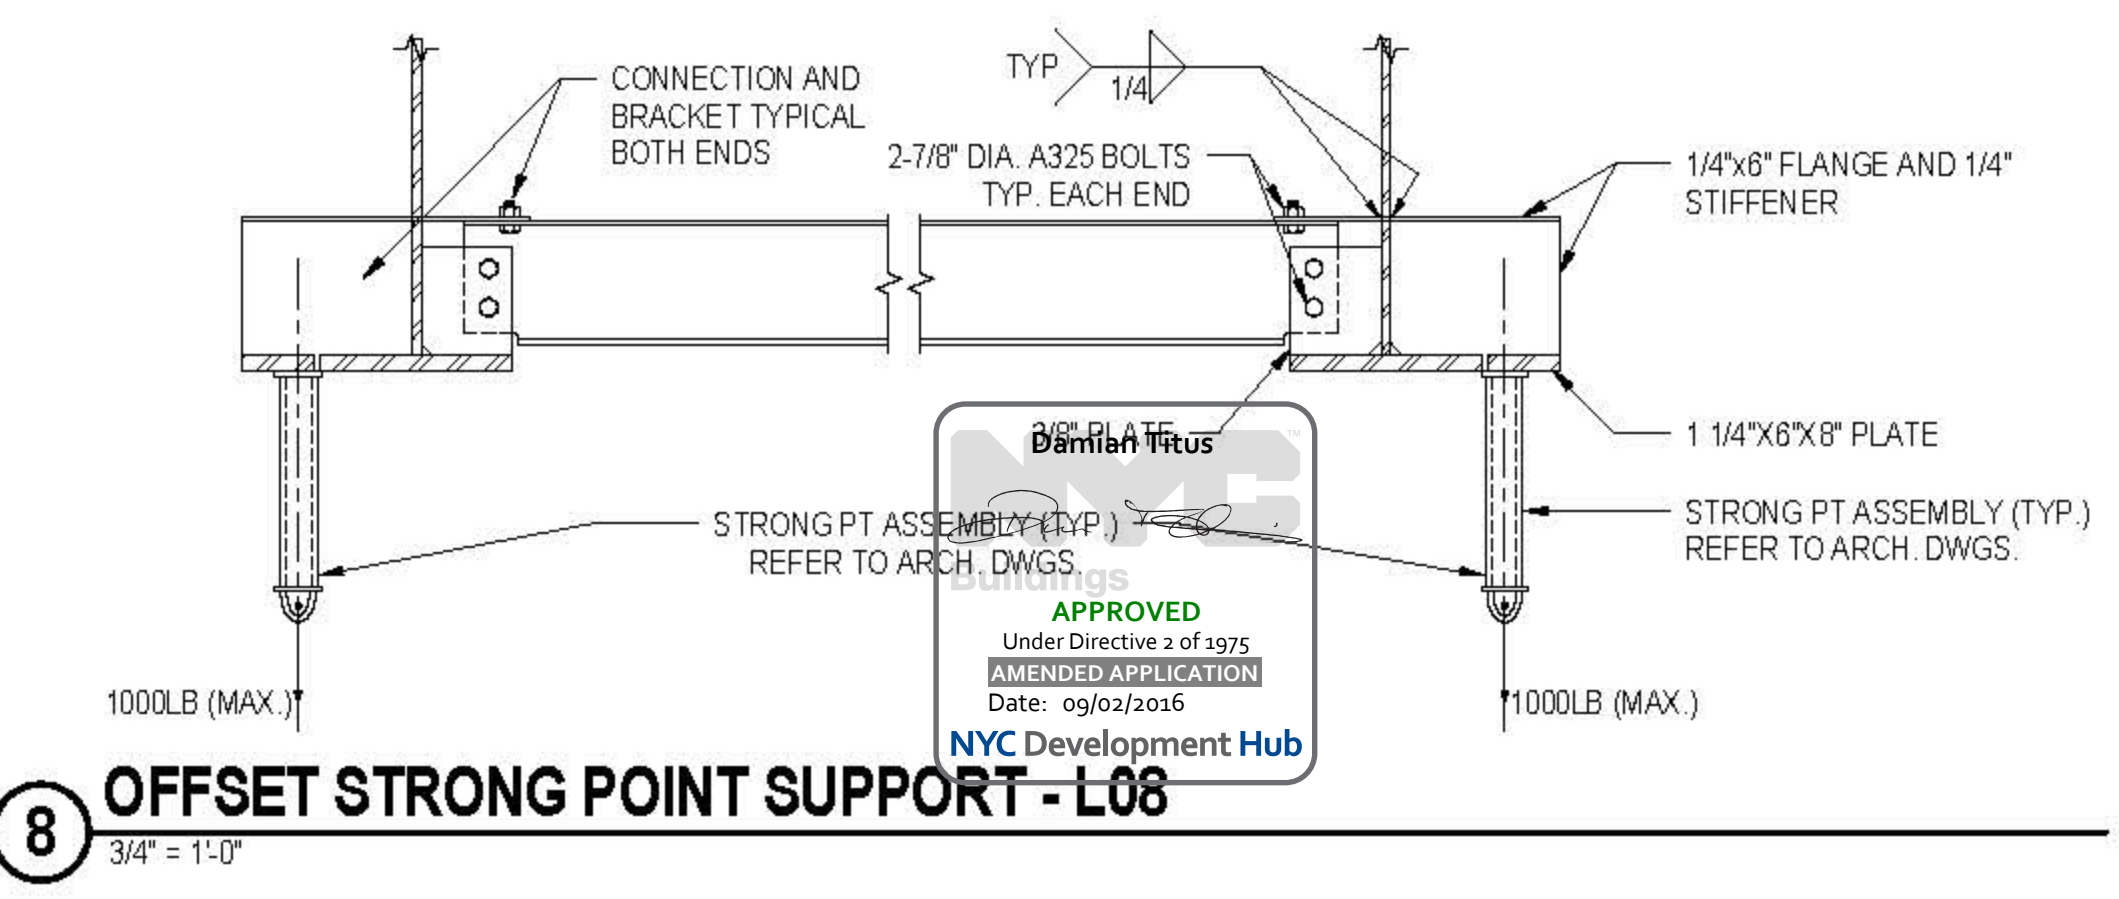

8 OFFSET STRONG POINT SUPPORT - L08
3/4" = 1'-0"

CULTURE SHED

540 West 30th Street
New York, New York 10001

OWNER
CULTURE SHED INC.

ARCHITECTS
Olin Schickel + Renfro Architects, DPC
601 West 26th Street #815
New York, New York 10001
T: 212.463.0334
F: 212.463.0335

STRUCTURAL ENGINEER
Thornton Tomasetti
51 Madison Avenue
New York, New York 10010
T: 917.981.7800
F: 917.981.7801

MEP ENGINEER
Jana Baum & Bolles
60 Park Street
New York, New York 10005
T: 212.530.9300
F: 212.266.6944

MEP ENGINEER
Jana Baum & Bolles
60 Park Street
New York, New York 10005
T: 212.530.9300
F: 212.266.6944


MEP ENGINEER
Jana Baum & Bolles
60 Park Street
New York, New York 10005
T: 212.530.9300
F: 212.266.6944

MEP ENGINEER
Jana Baum & Bolles
60 Park Street
New York, New York 10005
T: 212.530.9300
F: 212.266.6944


MEP ENGINEER
Jana Baum & Bolles
60 Park Street
New York, New York 10005
T: 212.530.9300
F: 212.266.6944

SHEET NOTES:


1. T/STRUCTURAL SLAB EL UON
2. T/STEEL AT UNDERSIDE OF SLAB UON AS (XX) REFERENCED FROM TOP OF SLAB ELEVATION
3. ← INDICATES DECK SPAN DIRECTION, REFER TO COMPOSITE STEEL DECK SCHEDULE INFORMATION
4. FOR ADDITIONAL INFORMATION REFER TO THE FOLLOWING DRAWINGS:
DRAWING LISTS, GENERAL NOTES, AND S-5000 SERIES DRAWINGS
LOADING DIAGRAMS
LATERAL SYSTEM ELEVATIONS, CONNECTION FORCES, AND DETAILS S-3000 SERIES DRAWINGS
STEEL SUPERSTRUCTURE SCHEDULES AND DETAILS S-7000 SERIES DRAWINGS
STEEL COLUMN SCHEDULES AND DETAILS S-8000 SERIES DRAWINGS
5. AT STAIRS, SEE TYPICAL DETAILS FOR TC, TCS, AND KICKER REQUIREMENTS 1, 2, & 3S-704
6. REFER TO ARCH DWGS FOR LOCATION AND SIZE OF OPENINGS. SEE ALSO GENERAL NOTE GR-18 AND TYPICAL DETAIL 1/5-113
7. SYMBOLS:
— INDICATES MOMENT CONNECTION
— INDICATES DEEP BEAM BOTTOM FLANGE BRACING CONNECTION SEE DETAIL 6/5-703
— INDICATES FULL HEIGHT FITTED STIFFENER CONNECTION SEE DETAIL 4/5-703
— INDICATES FULL HEIGHT UNFITTED STIFFENER CONNECTION SEE DETAIL 5/5-703
— INDICATES KICKER AT SPANDREL BEAM CONNECTION SEE DETAIL 3/5-703
UP INDICATES SLOPE IN TOP OF SLAB
8. NOTATIONS:
BF INDICATES LATERAL BRACED FRAME
SEE BRACED FRAME ELEVATIONS FOR BEAM INFORMATION AND CONNECTION FORCES
C/C/B INDICATES COLUMN ABOVE/BELOW, COMPRESSION AXIAL FORCE IN COLUMN INDICATED WHERE APPLICABLE. SEE DETAIL 1/5-702 & 3/5-702
CBX INDICATES CASTELLATED BEAM. SEE SCHEDULE 1/5-402
DB INDICATES HSS8X4X3/8 ELEVATOR DIVIDER BEAM (NOT FIREPROOFED)
H/H/B INDICATES HANGER ABOVE/BELOW, TENSION AXIAL FORCE IN HANGER BELOW INDICATED WHERE APPLICABLE. SEE DETAIL 3/5-702
MF INDICATES LATERAL MOMENT FRAME
SEE MOMENT FRAME ELEVATIONS FOR BEAM INFORMATION AND CONNECTION FORCES
PGX INDICATES PLATE GIRDER TYPE. SEE S-703 FOR PLATE GIRDER SCHEDULE.
PGXT INDICATES TAPERED PLATE GIRDER. SEE DETAIL 3/5-724
TC INDICATES TORSIONAL CONNECTION FOR STAIR. SEE DETAIL 1/5-704
TR INDICATES COLUMN FROM ABOVE TRANSFERS, COMPRESSION AXIAL FORCE IN COLUMN INDICATED WHERE APPLICABLE. SEE DETAIL 1/5-702

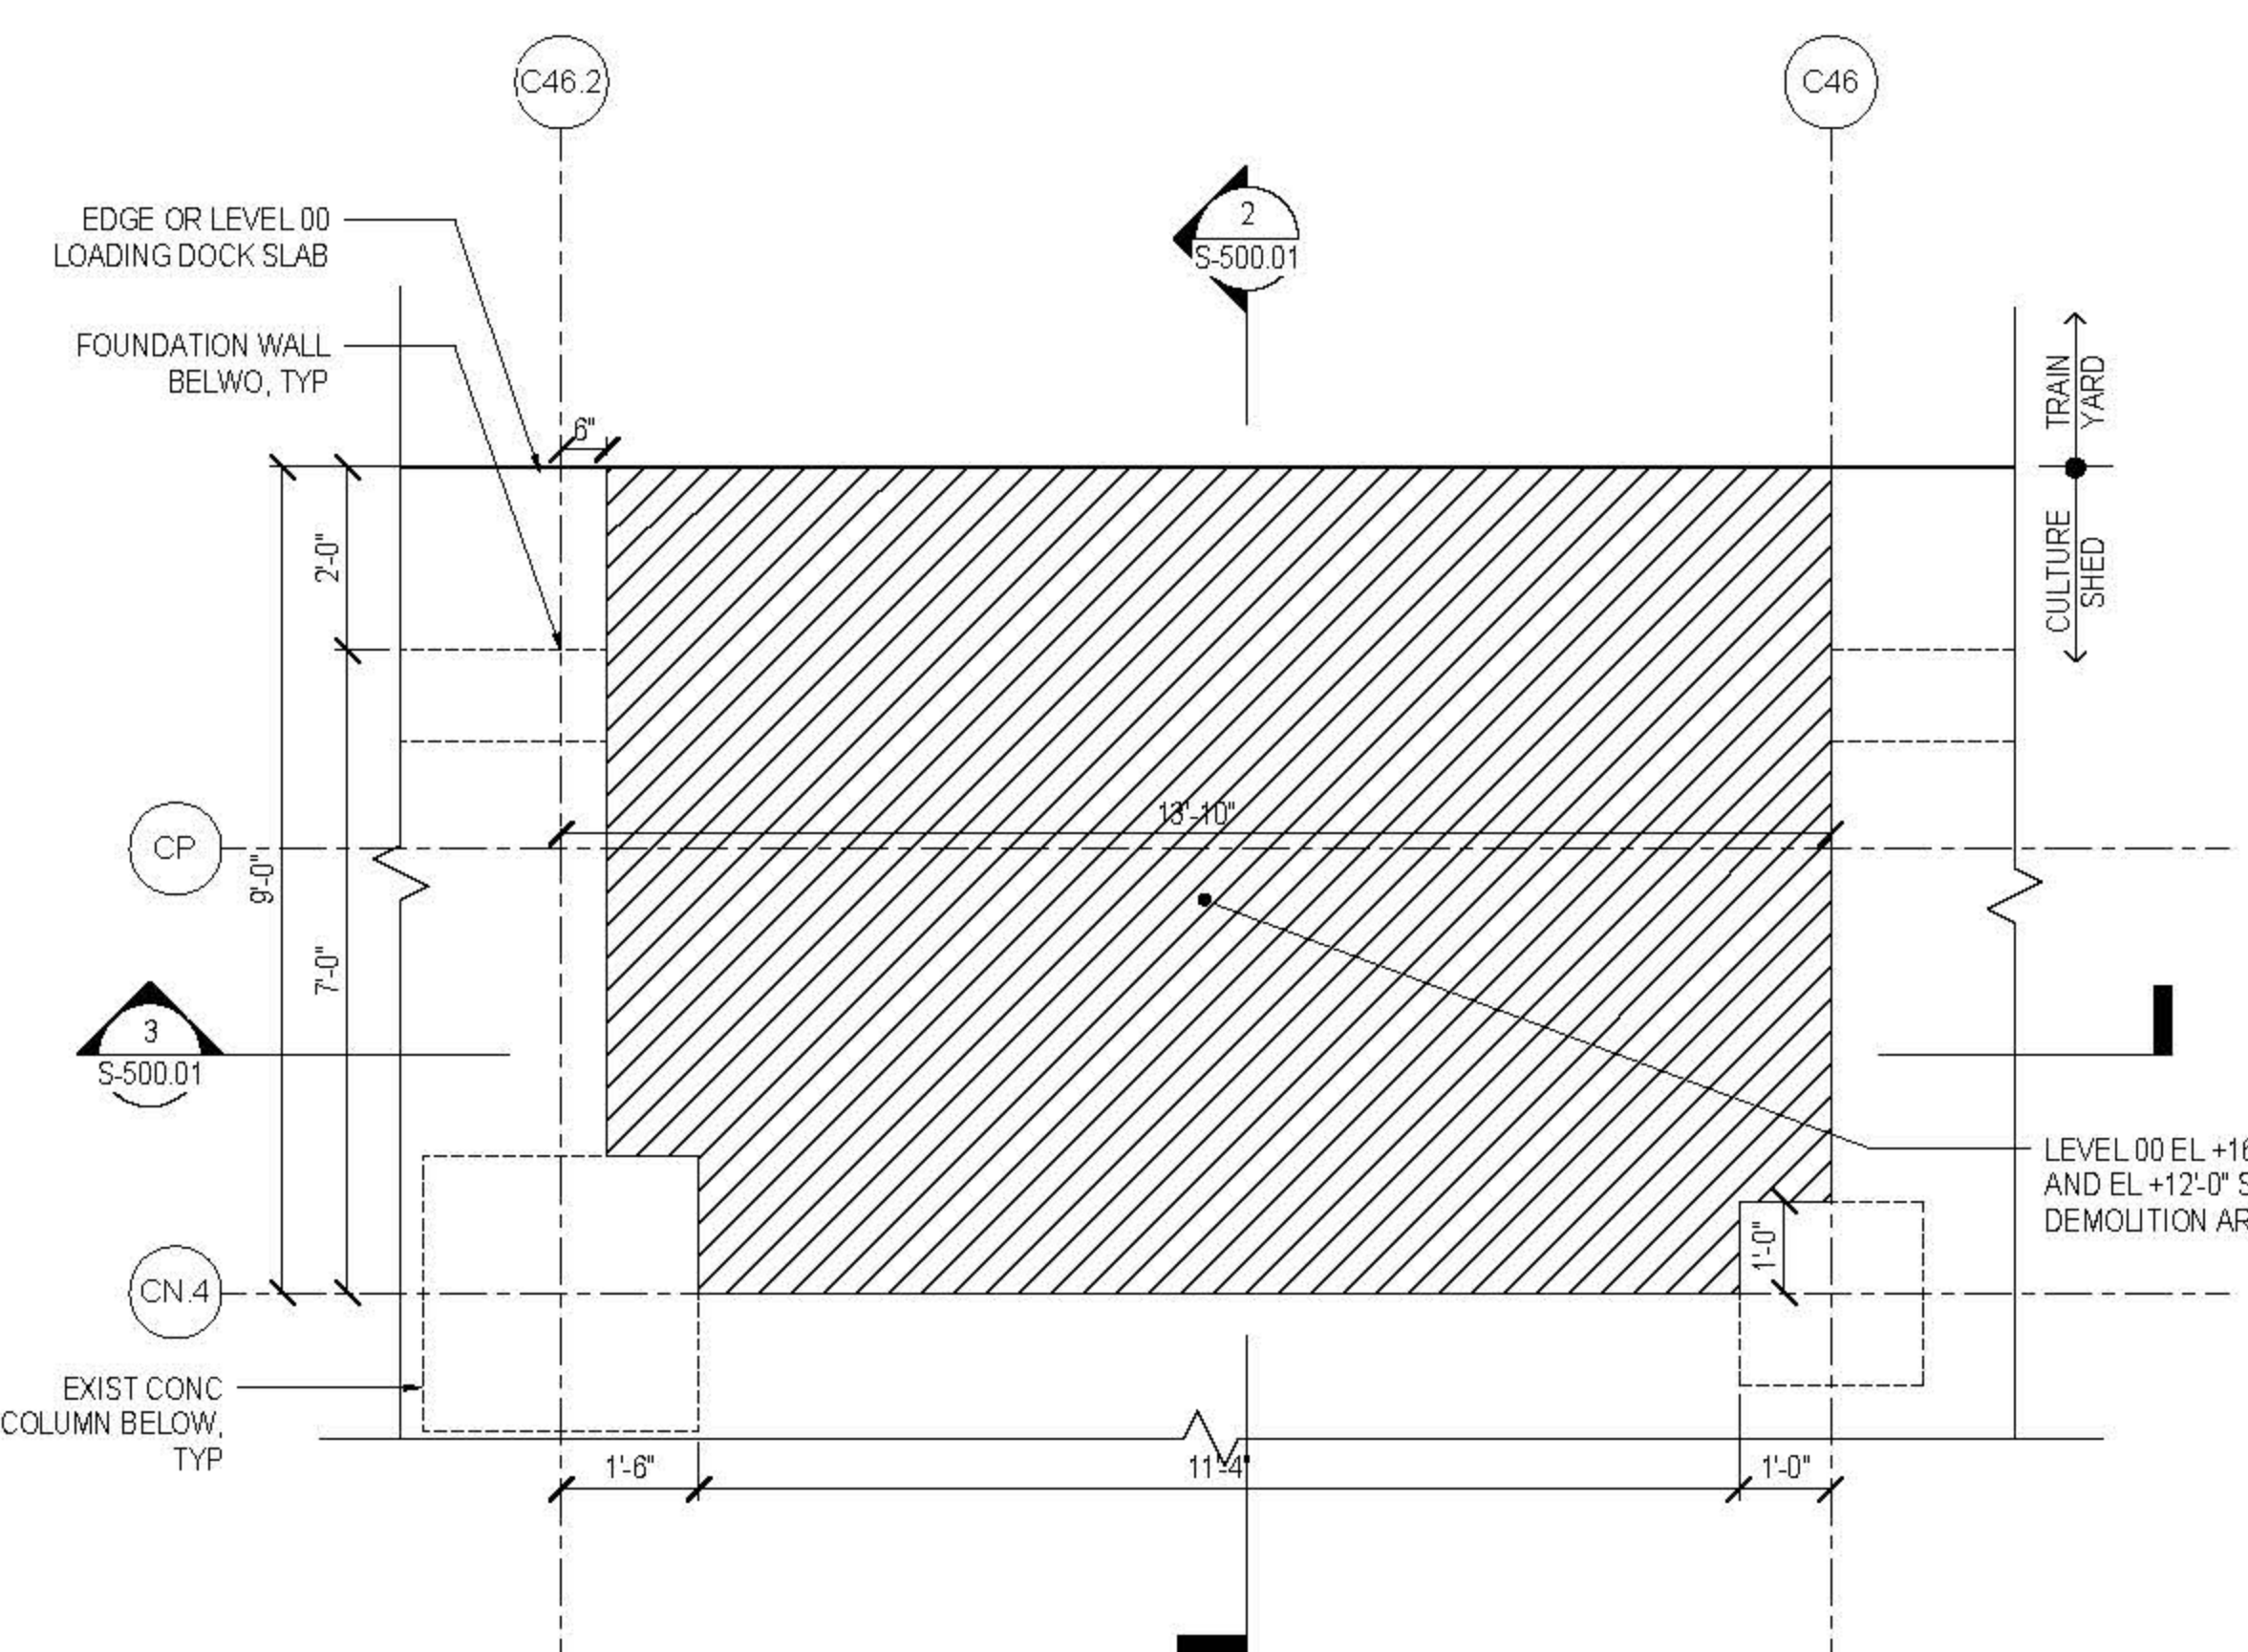


1 LEVEL 00 DEMOLITION PARTIAL PLAN AT NORTH ELEVATOR PIT
1/2" = 1'-0"

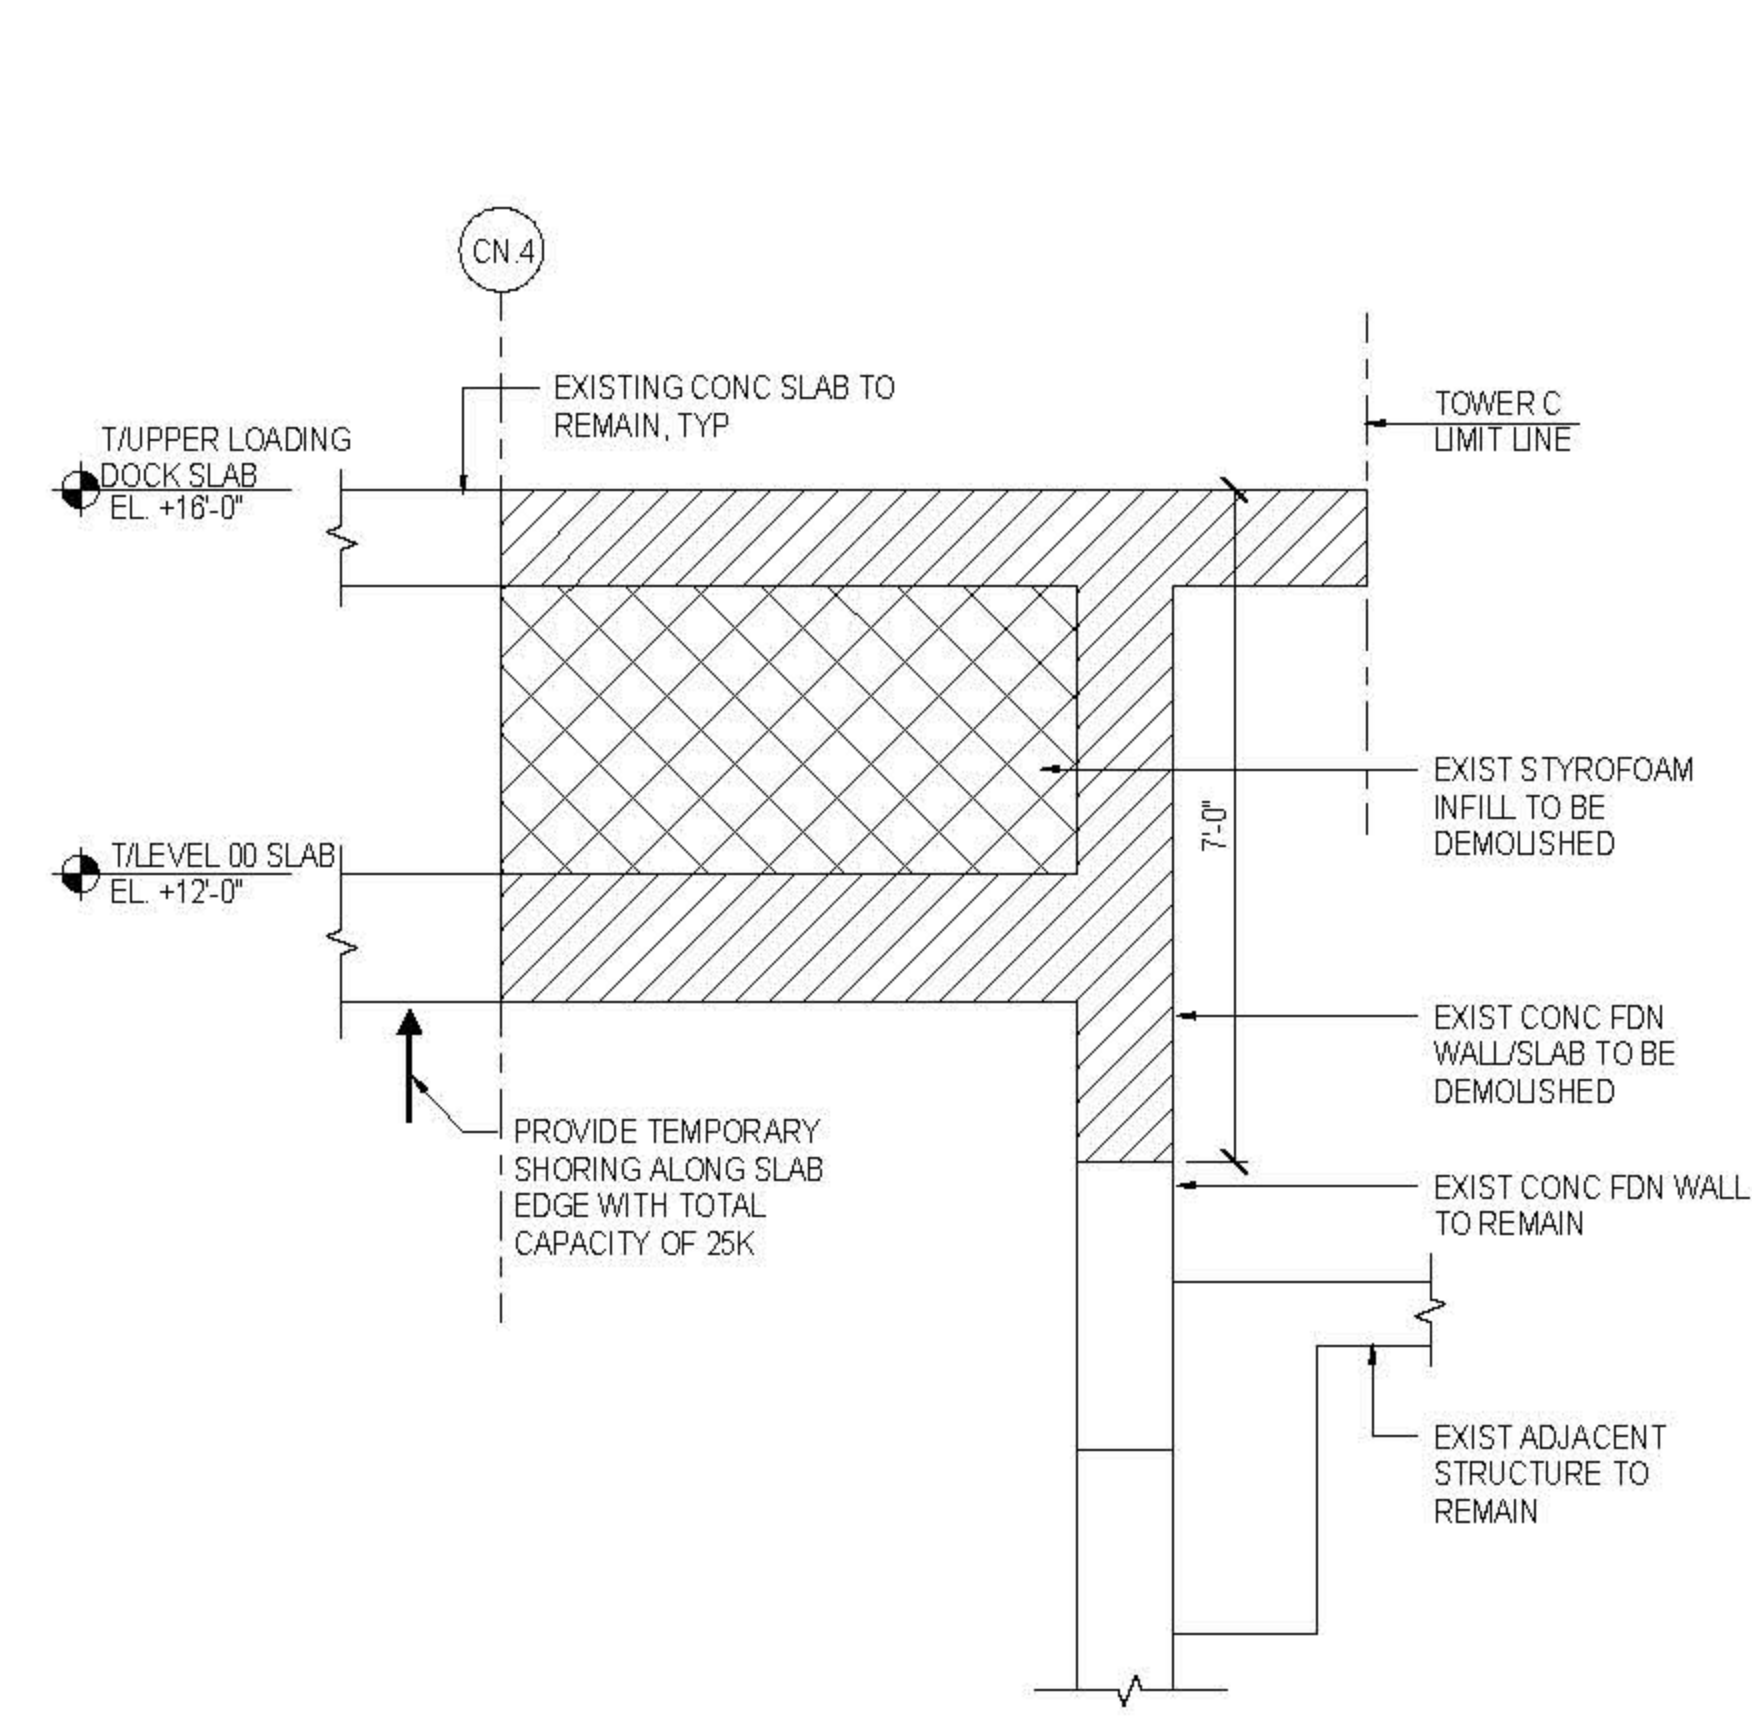


2 DEMOLITION SECTION AT NORTH ELEVATOR PIT
1/2" = 1'-0"

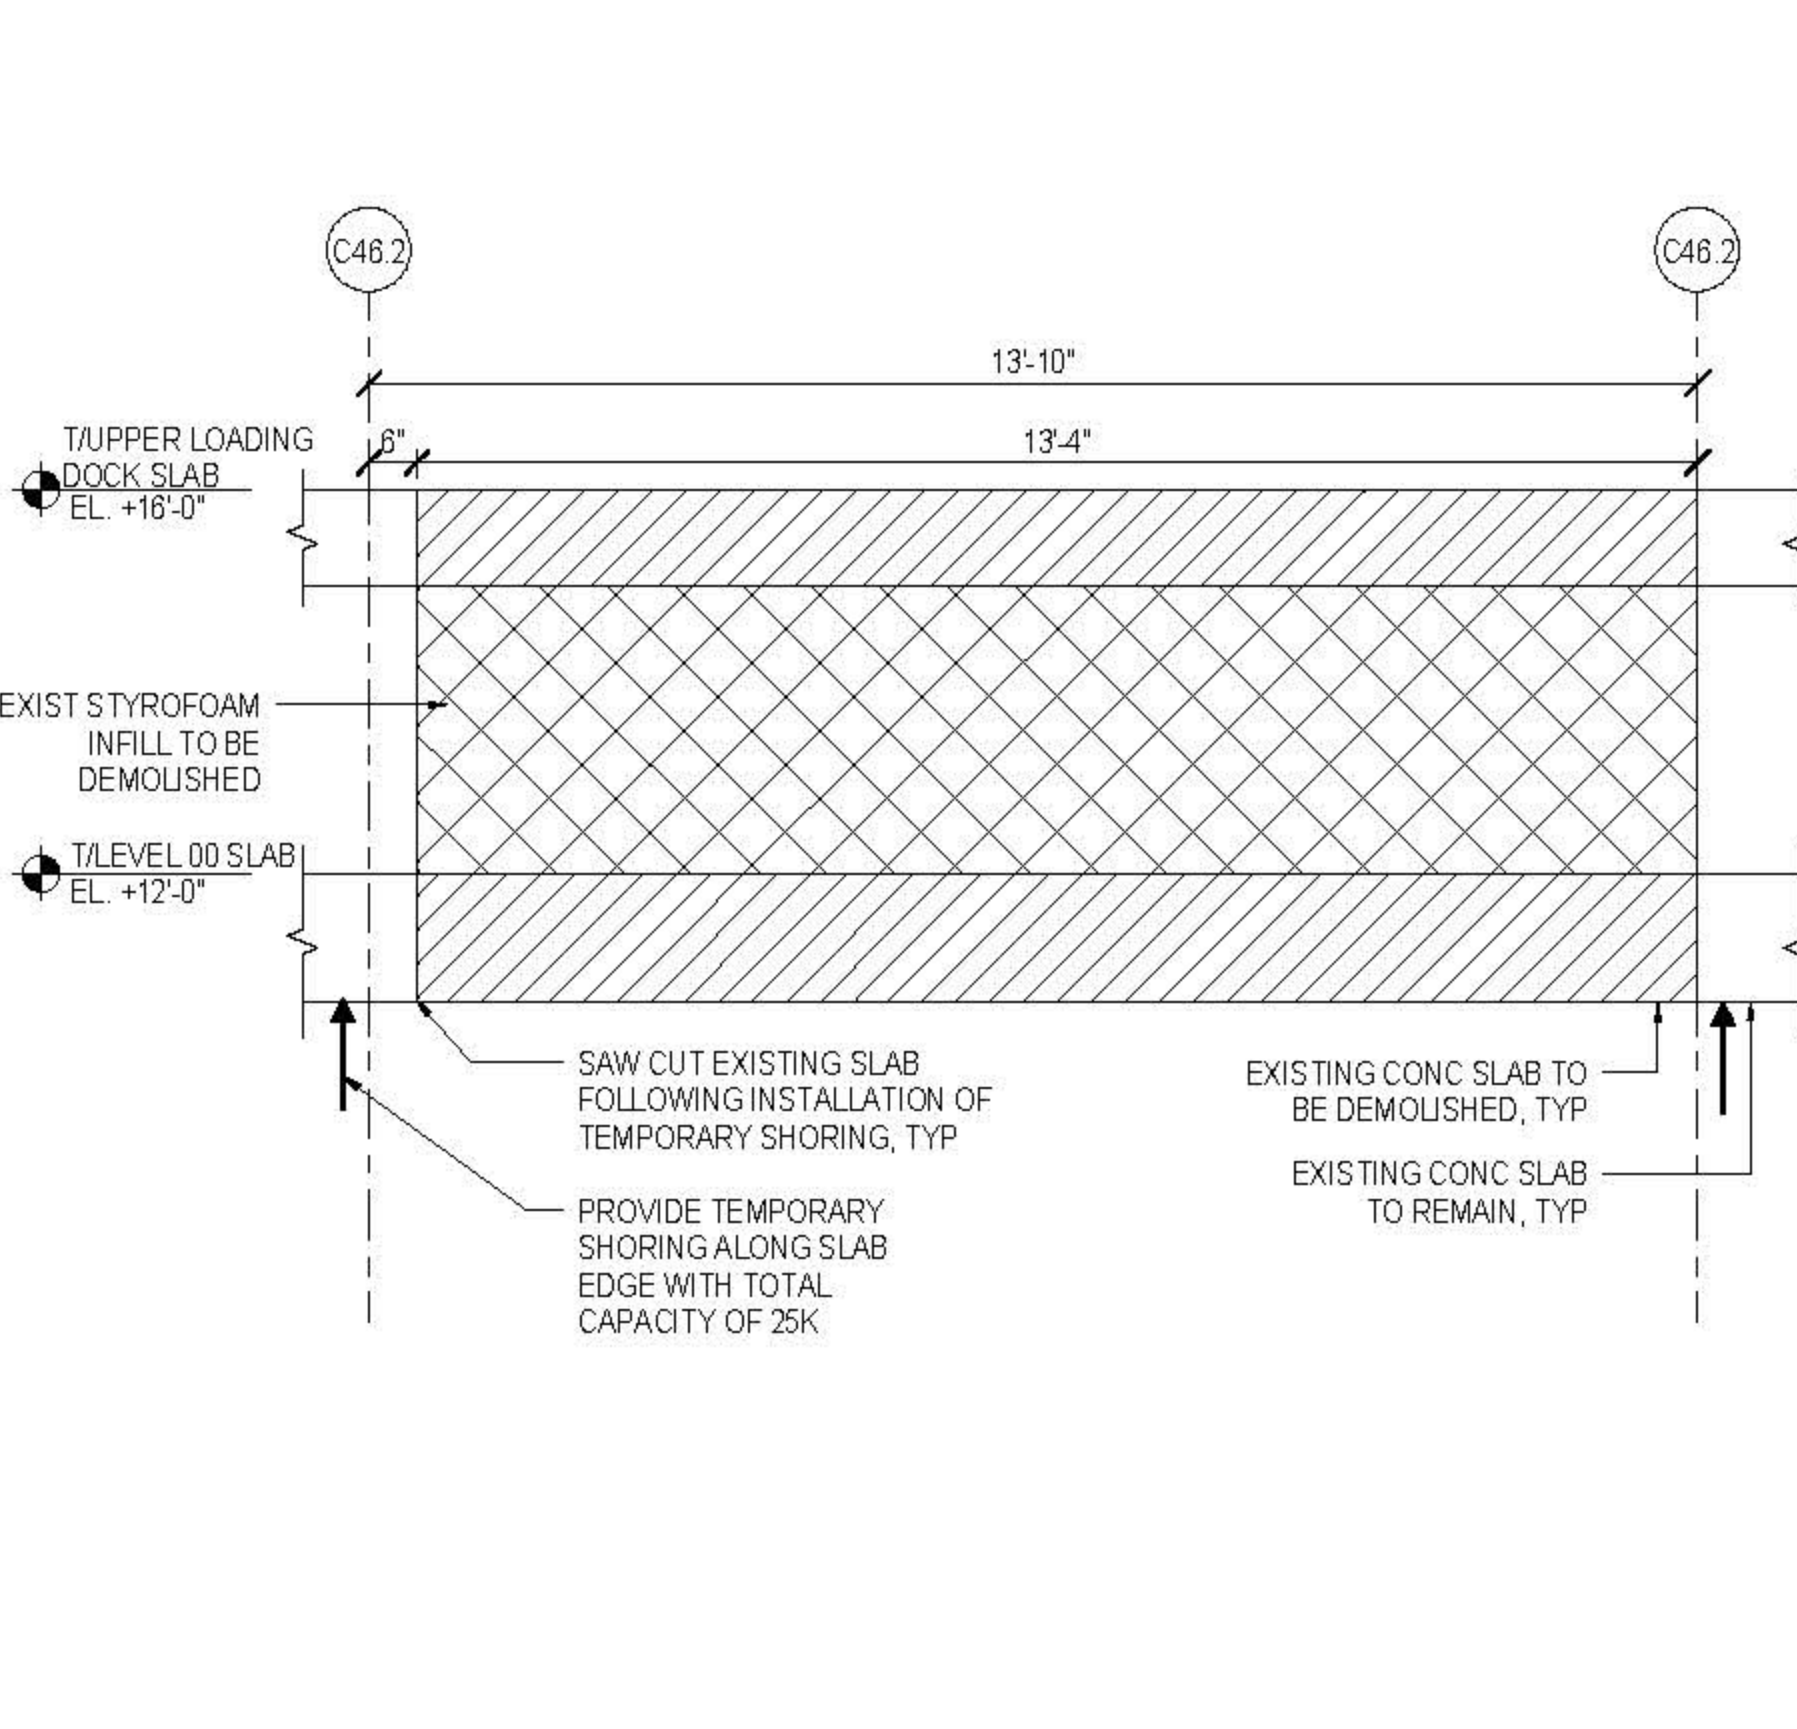


3 DEMOLITION SECTION AT NORTH ELEVATOR PIT
1/2" = 1'-0"

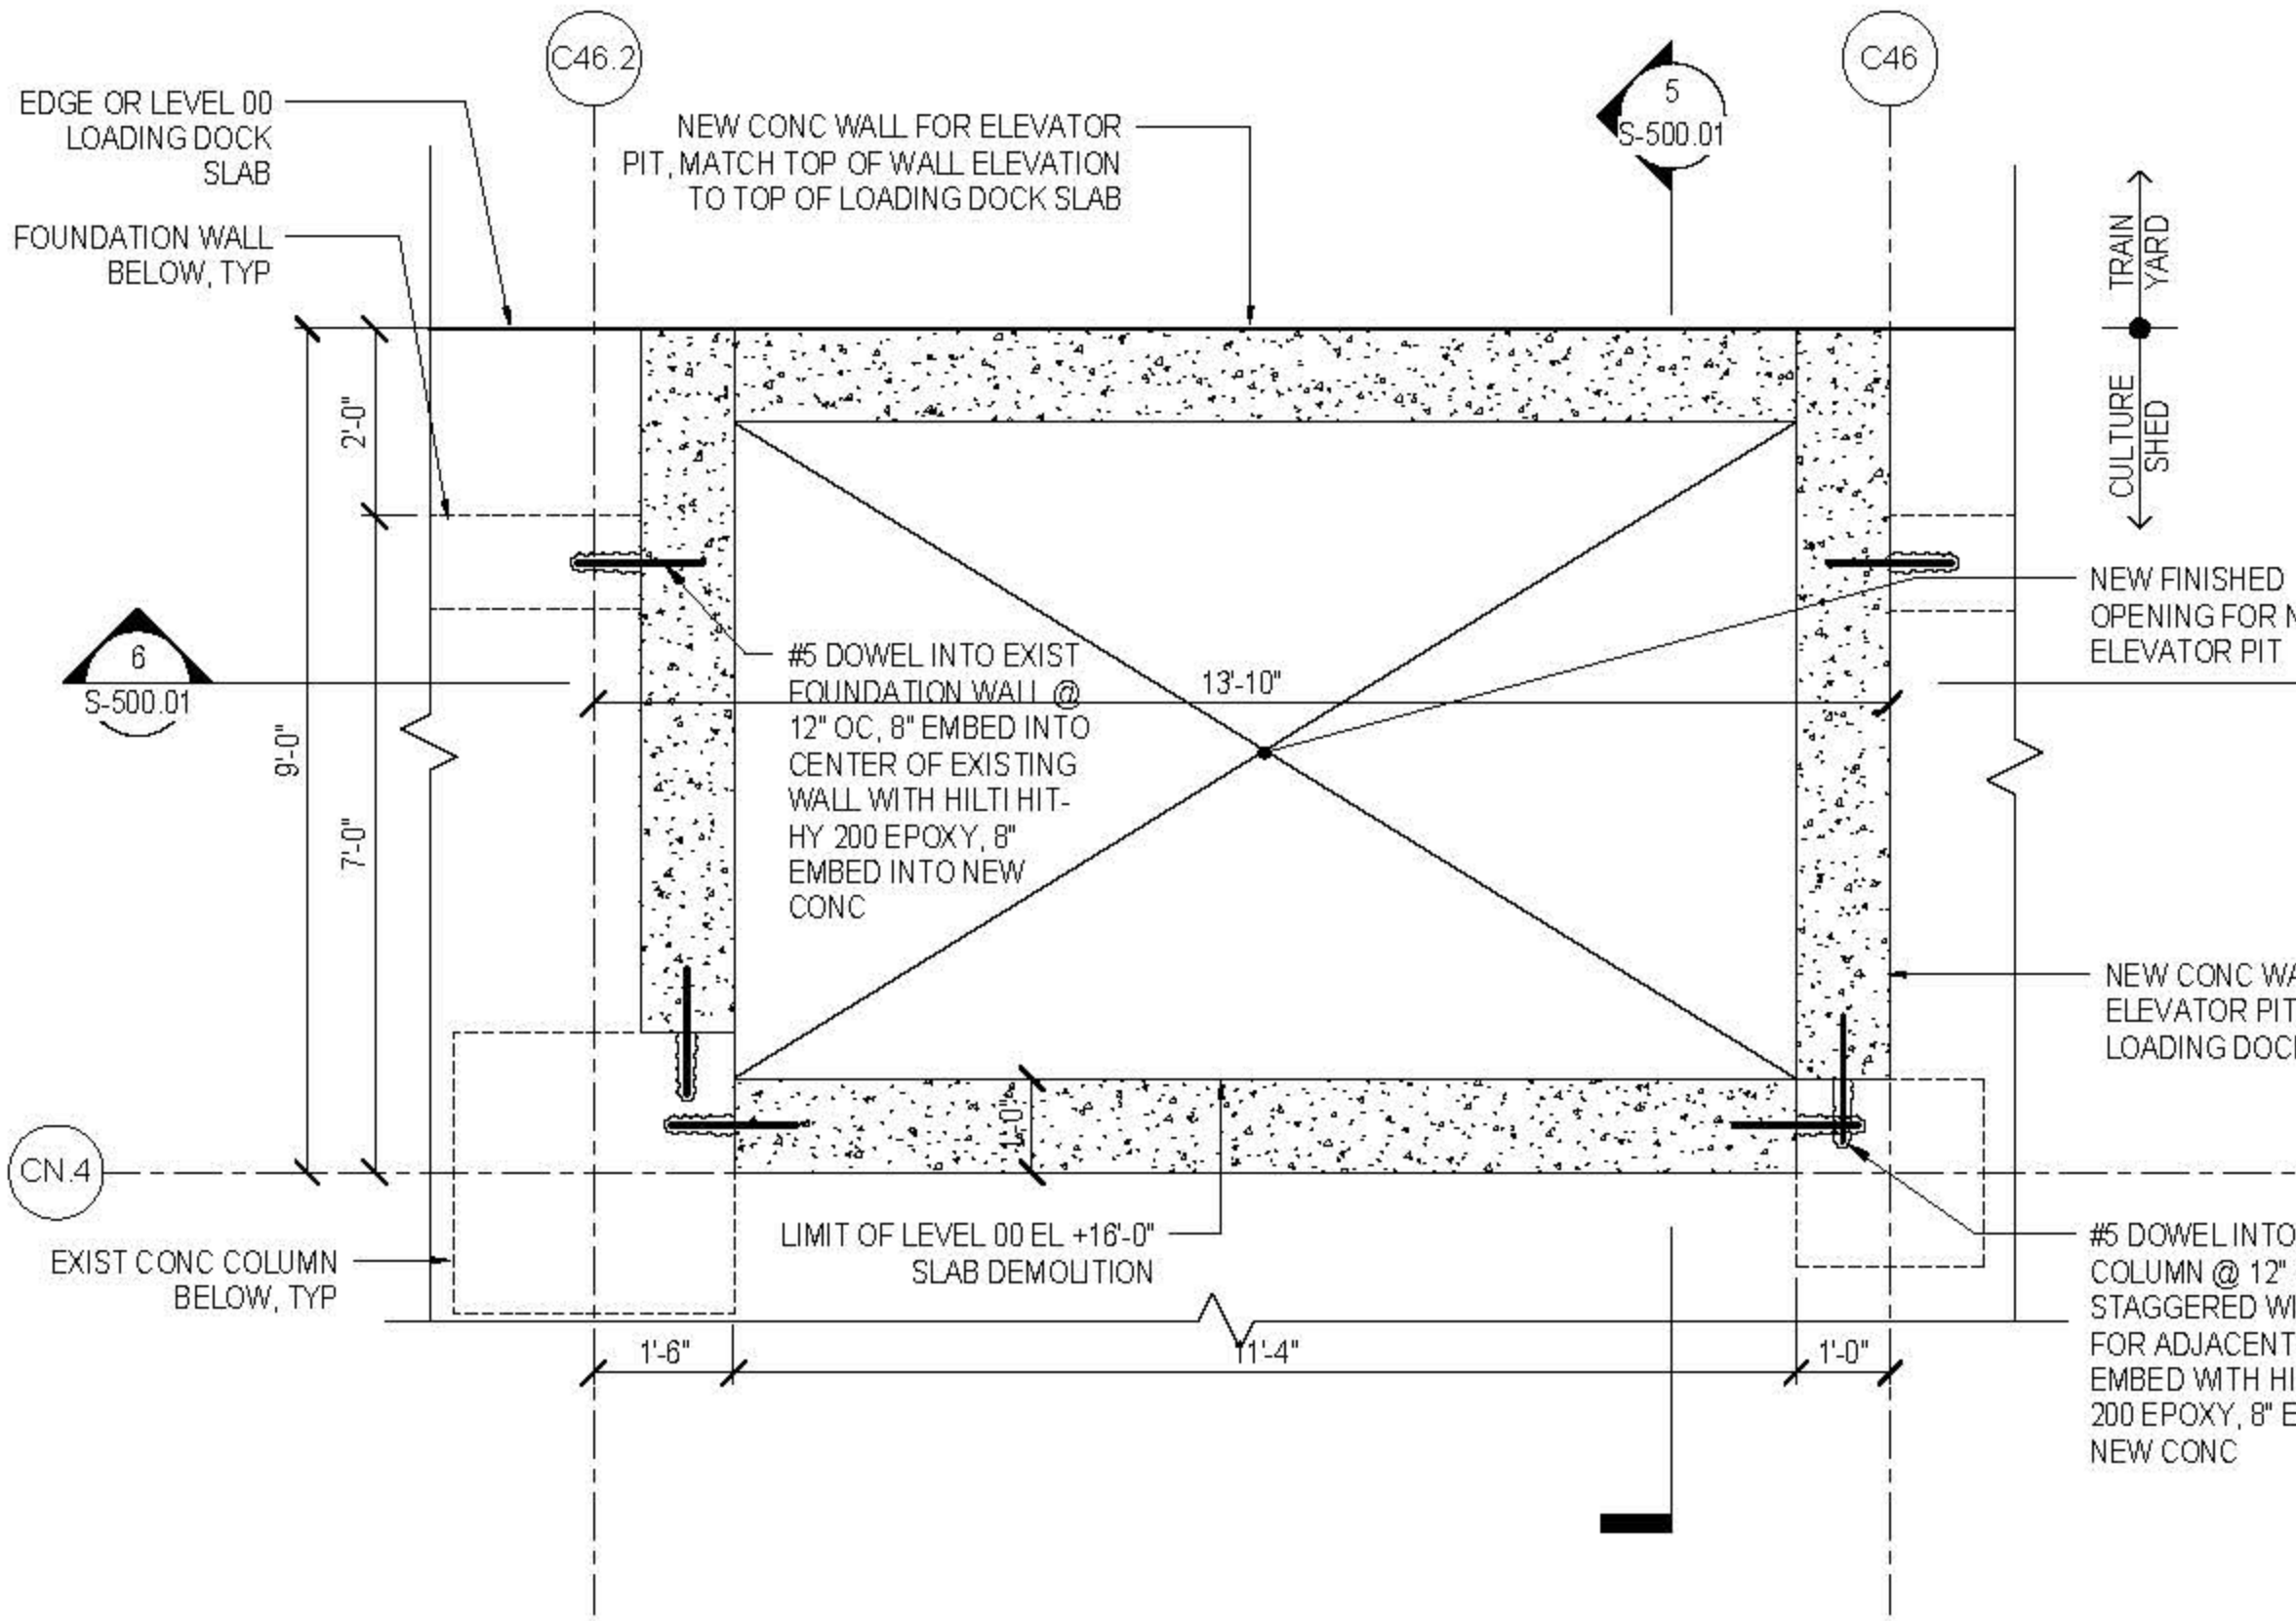

4 LEVEL 00 NEW CONSTRUCTION PARTIAL PLAN AT NORTH ELEVATOR PIT
1/2" = 1'-0"

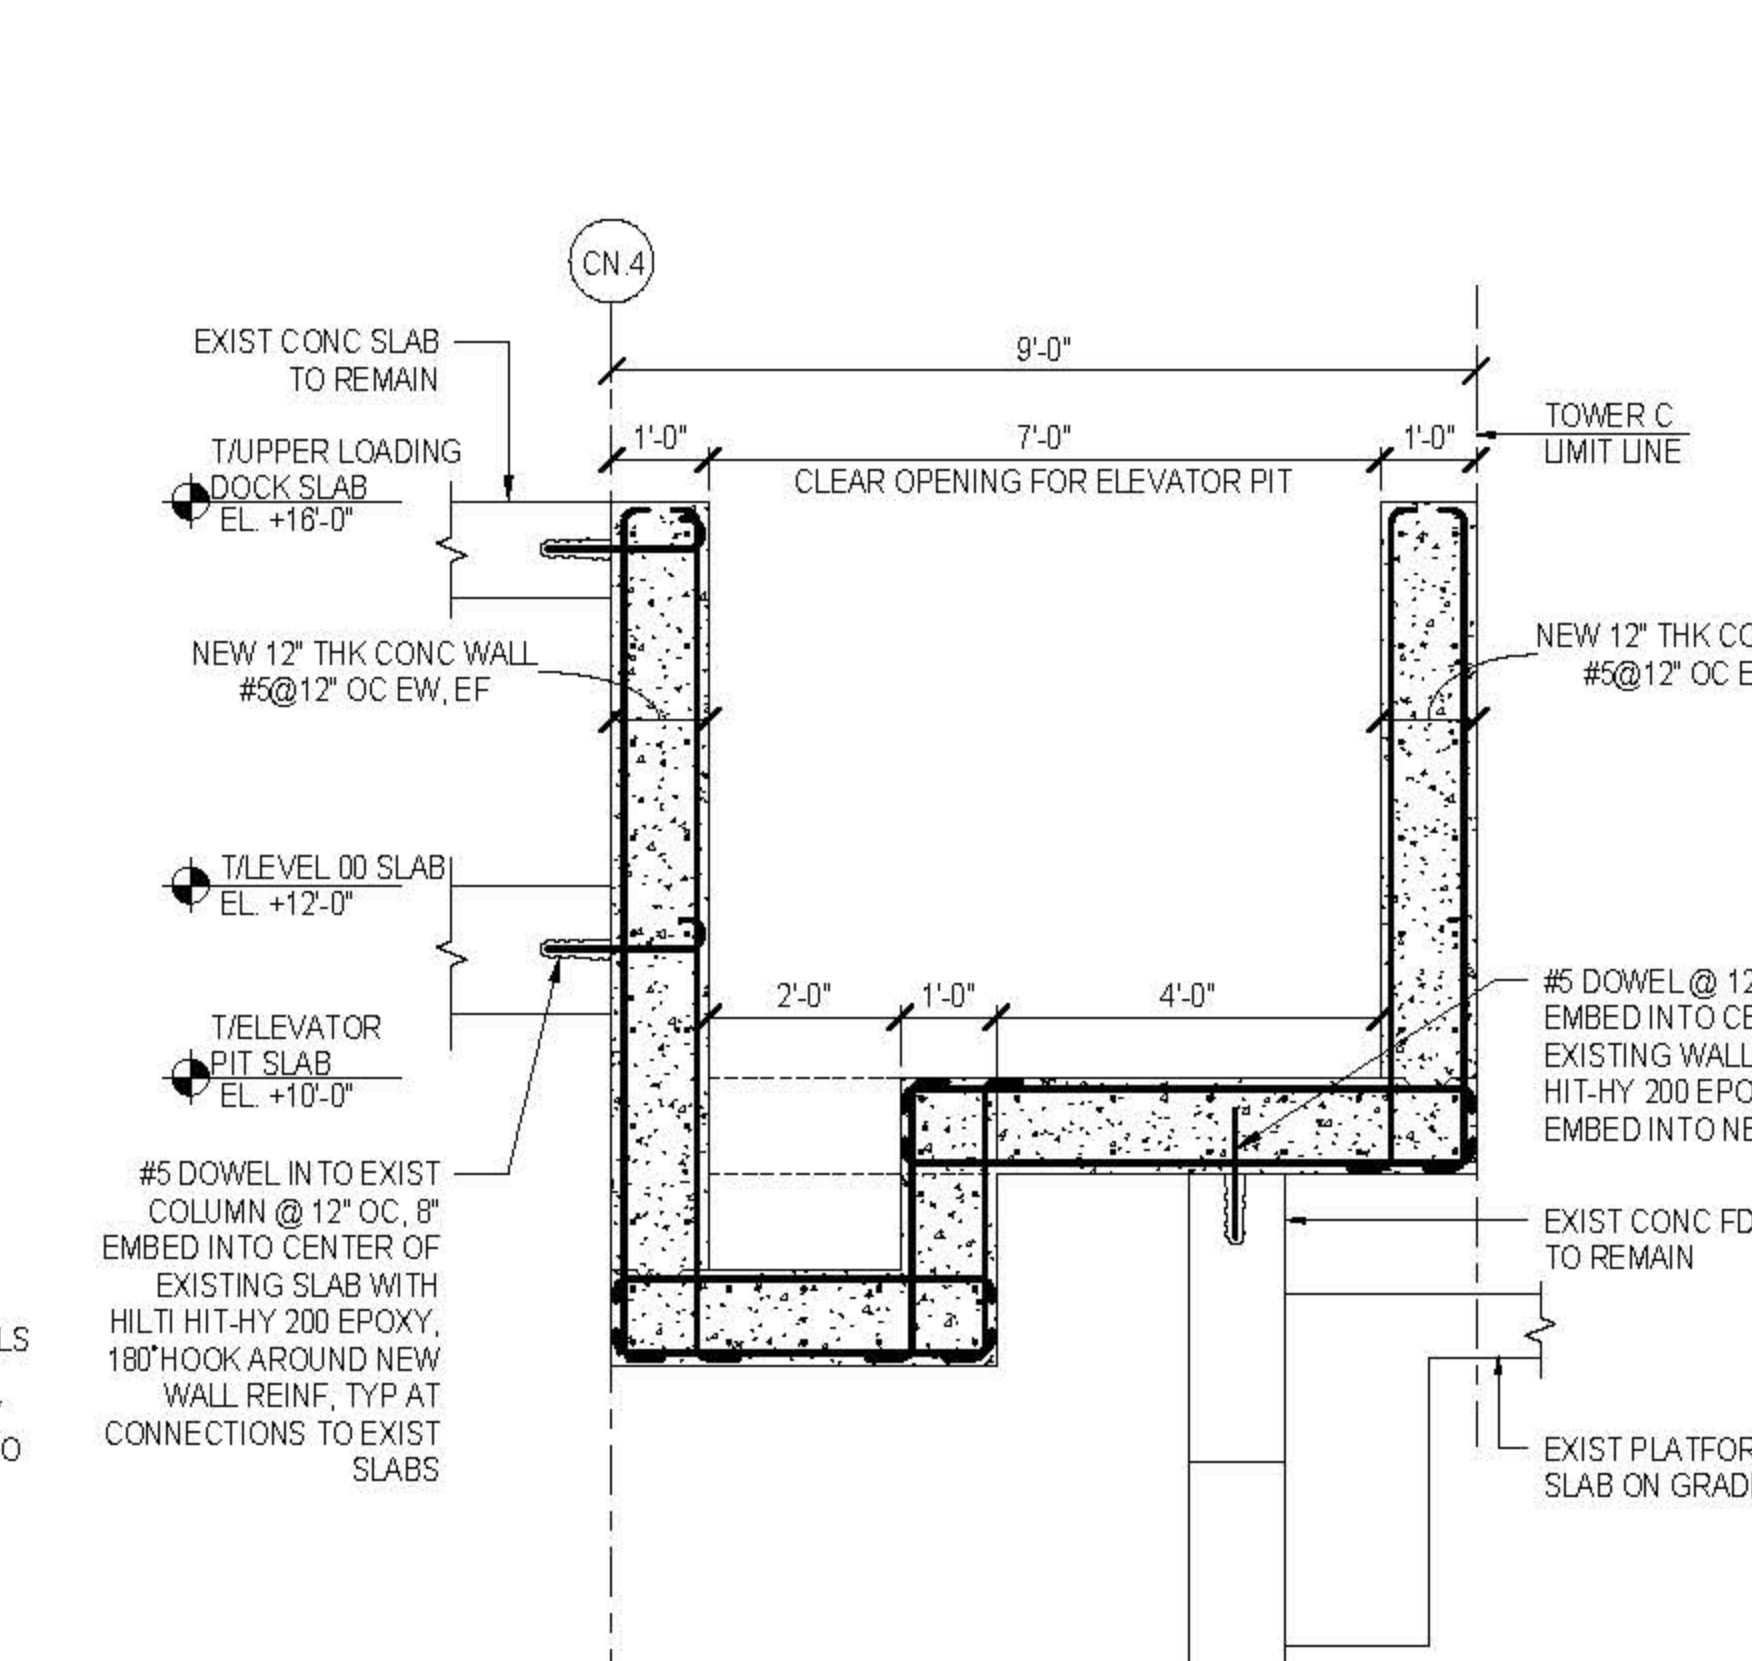

5 NEW CONSTRUCTION SECTION AT NORTH ELEVATOR PIT
1/2" = 1'-0"

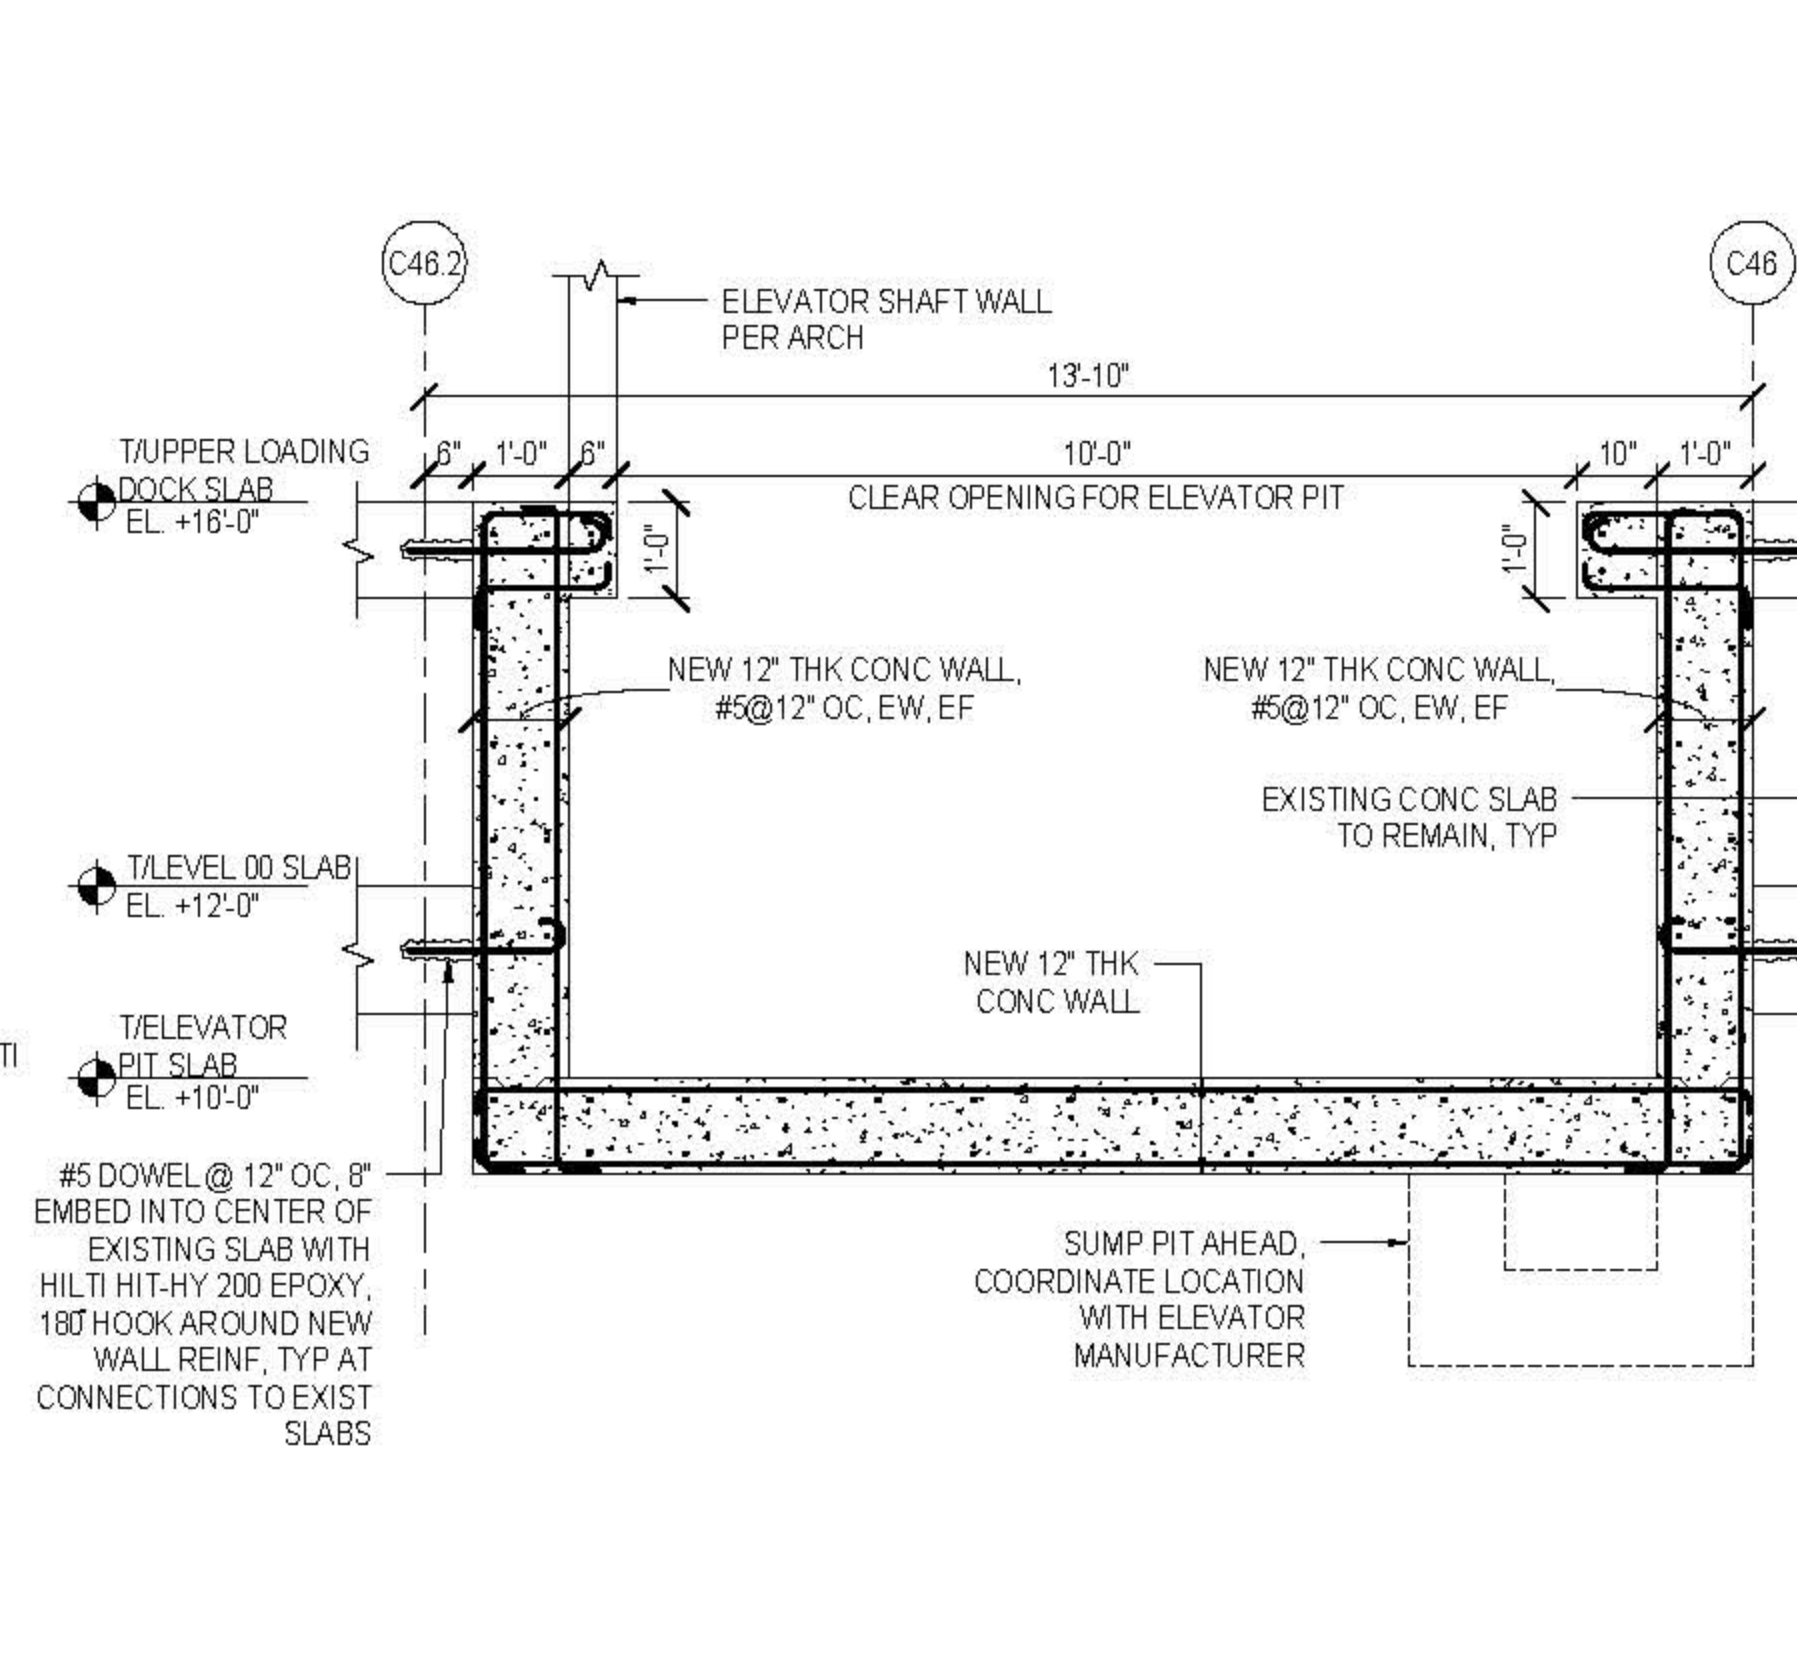

6 NEW CONSTRUCTION SECTION AT NORTH ELEVATOR PIT
1/2" = 1'-0"

STEEL BEAM LEGEND

SIZE	NUMBER OF HEADED STUDS EQUALLY SPACED BETWEEN BEAMS
W12x14	4
W12x16	4
W12x18	4
W12x20	4
W12x22	4
W12x24	4
W12x26	4
W12x28	4
W12x30	4
W12x33	4
W12x36	4
W12x40	4
W12x44	4
W12x48	4
W12x54	4
W12x60	4
W12x66	4
W12x72	4
W12x81	4
W12x90	4
W12x100	4
W12x114	4
W12x126	4
W12x132	4
W12x144	4
W12x150	4
W12x156	4
W12x162	4
W12x174	4
W12x180	4
W12x186	4
W12x192	4
W12x210	4
W12x222	4
W12x234	4
W12x240	4
W12x246	4
W12x252	4
W12x270	4
W12x282	4
W12x294	4
W12x300	4
W12x306	4
W12x312	4
W12x324	4
W12x330	4
W12x336	4
W12x342	4
W12x348	4
W12x354	4
W12x360	4
W12x372	4
W12x384	4
W12x390	4
W12x396	4
W12x1578	4
W12x1584	


SHEET NOTES:

1. T=STRUCTURAL SLAB EL UON
2. X INDICATES CHANGE IN T=STRUCTURAL SLAB ELEVATION
3. T=STEEL AT UNDERSIDE OF SLAB UON AS (XX) REFERENCED FROM TOP OF SLAB ELEVATION
4. INDICATES DECK SPAN DIRECTION, REFER TO COMPOSITE STEEL DECK SCHEDULE INFORMATION
5. FOR ADDITIONAL INFORMATION REFER TO THE FOLLOWING DRAWINGS:
DRAWING LISTS, GENERAL NOTES, AND S-000 SERIES DRAWINGS
LOADING DIAGRAMS
LATERAL SYSTEM ELEVATIONS, CONNECTION FORCES, AND DETAILS S-300 SERIES DRAWINGS
STEEL SUPERSTRUCTURE SCHEDULES AND DETAILS S-700 SERIES DRAWINGS
STEEL COLUMN SCHEDULES AND DETAILS S-800 SERIES DRAWINGS
6. AT STAIRS, SEE TYPICAL DETAILS FOR TC, TCS, AND KICKER REQUIREMENTS 1, 2 & 3S-704
7. REFER TO ARCH DWGS FOR LOCATION AND SIZE OF OPENINGS. SEE ALSO GENERAL NOTE GR-18 AND TYPICAL DETAIL 1/5-719
8. SYMBOLS:
INDICATES MOMENT CONNECTION
INDICATES DEEP BEAM BOTTOM FLANGE BRACING CONNECTION SEE DETAIL 8/5-703
INDICATES FULL HEIGHT FITTED STIFFENER CONNECTION SEE DETAIL 4/5-703
INDICATES FULL HEIGHT UNFITTED STIFFENER CONNECTION SEE DETAIL 5/5-703
INDICATES KICKER AT SPANDREL BEAM CONNECTION SEE DETAIL 3/5-703
INDICATES SLOPE IN TOP OF SLAB
9. NOTATIONS:
BF INDICATES LATERAL BRACED FRAME
C/CBX INDICATES COLUMN ABOVE/BELOW, COMPRESSION AXIAL FORCE IN COLUMN INDICATED WHERE APPLICABLE. SEE DETAIL 1/5-702 & 3/5-702
CBXK INDICATES CASTELLATED BEAM. SEE SCHEDULE 1/5-402
DB INDICATES HSS8X4X3/8 ELEVATOR DIVIDER BEAM (NOT FIREPROOFED)
H/HB INDICATES HANGER ABOVE/BELOW, TENSION AXIAL FORCE IN HANGER BELOW INDICATED WHERE APPLICABLE. SEE DETAIL 9/5-702
MF INDICATES LATERAL MOMENT FRAME
PGX INDICATES PLATE GIRDER TYPE. SEE S-703 FOR PLATE GIRDER SCHEDULE.
PGXT INDICATES TAPERED PLATE GIRDER. SEE DETAIL 3/5-724
TC INDICATES TORSIONAL CONNECTION FOR STAIR. SEE DETAIL 1/5-704
TR INDICATES COLUMN FROM ABOVE TRANSFERS, COMPRESSION AXIAL FORCE IN COLUMN INDICATED WHERE APPLICABLE. SEE DETAIL 1/5-702
P1 INDICATES SHS150X150X10 POST FROM TOP OF CELLAR SLAB TO UNDERSIDE OF LEVEL 00 SLAB
H1 INDICATES L3KX1/4" HANGER FROM LEVEL 00 WIDE FLANGE FRAMING TO ESCALATOR PIT ME FRAMING, SEE TYPICAL DETAIL ON S-501

NOTATIONS:

1. INSTALL TEMPORARY SHORING POSTS AND BEAMS
2. SAW CUT SLAB OPENING IN L00
3. DEMONSTRATE AT L00 ACC-B
4. CONSTRUCT CONCRETE WALLS AND CORRELATING TO EXIST SLAB EDGE AROUND PIT OPENING
5. REMOVE TEMP SHORING
6. RETAIN REMAINDER OF STEEL AND SLAB INFILL

STEEL BEAM LEGEND

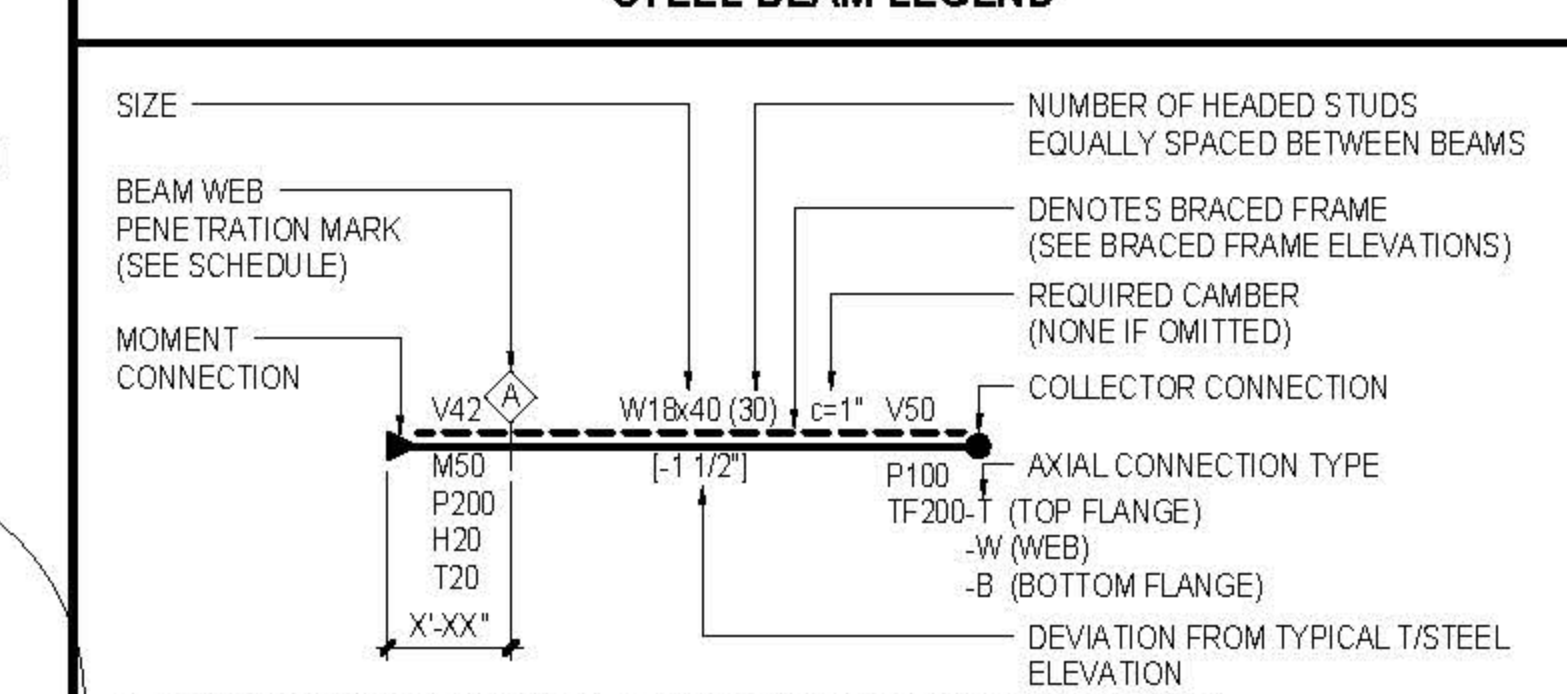

V INDICATES FACTORED VERTICAL SHEAR IN KIPS (SEE SCHEDULE IF OMITTED)
M INDICATES FACTORED END MOMENT IN KIP-FEET (SEE SCHEDULE IF OMITTED)
P INDICATES FACTORED END AXIAL FORCE IN KIPS
H INDICATES FACTORED HORIZONTAL SHEAR FORCE IN KIPS
T INDICATES TORSIONAL MOMENT IN KIP-FEET
TF INDICATES AXIAL FORCE TRANSFERRED THROUGH THE CONNECTION JOINT IN KIPS

COMPOSITE STEEL DECK SCHEDULE

SLAB MARK	TOTAL SLAB THICKNESS AND CONCRETE TYPE	STEEL DECK (MIN)	CONCRETE TOPPING SLAB	SLAB REINFORCEMENT	NOTES
S1	5 1/2" NWC	3"-18 GA		6 x 6 - W4.0 x W4.0 WWR	
S2	7 1/2" NWC	3"-18 GA		4 x 4 - W4.0 x W4.0 WWR	
S3	9" NWC	3"-18 GA		#4 @ 10" O.C. EACH WAY	
S4	4" NWC	1 1/2"-18 GA		6 x 6 - W2.9 x W2.9 WWR	
S5	8 1/2" NWC	3"-18 GA		#4 @ 12" O.C. N-S #4 @ 18" O.C. E-W	N.S BARS COORDINATED TO MECHANICAL COUPLERS IN EXISTING SLAB

KEY PLAN




ISSUE PRINTING DATE


NO.	DESCRIPTION	DATE
01	DOB AMENDMENT 7	03/19/2016
02	ADJ. ACQUISITION	03/19/2016
03	ADV. PROCUREMENT ADDENDUM 4	04/10/2016
04	100% CONSTRUCTION DOCUMENTS	03/18/2016
05	90% CONSTRUCTION DOCUMENTS	02/16/2016
06	ADV. PROCUREMENT ADDENDUM 1	10/09/2014
07	ADVANCED PROCUREMENT BID SET	06/16/2014

STAMP


DRAWN BY: ADMPY CHECKED BY: CHERNY
PROJECT NUMBER: N1318.00
TITLE: MODIFICATION PART PLANS AND DETAILS, FIXED BUILDING LEVEL 00 - 1
DRAWING NO: S-501.01
B SCAN NO: S-501.01
58 of 123

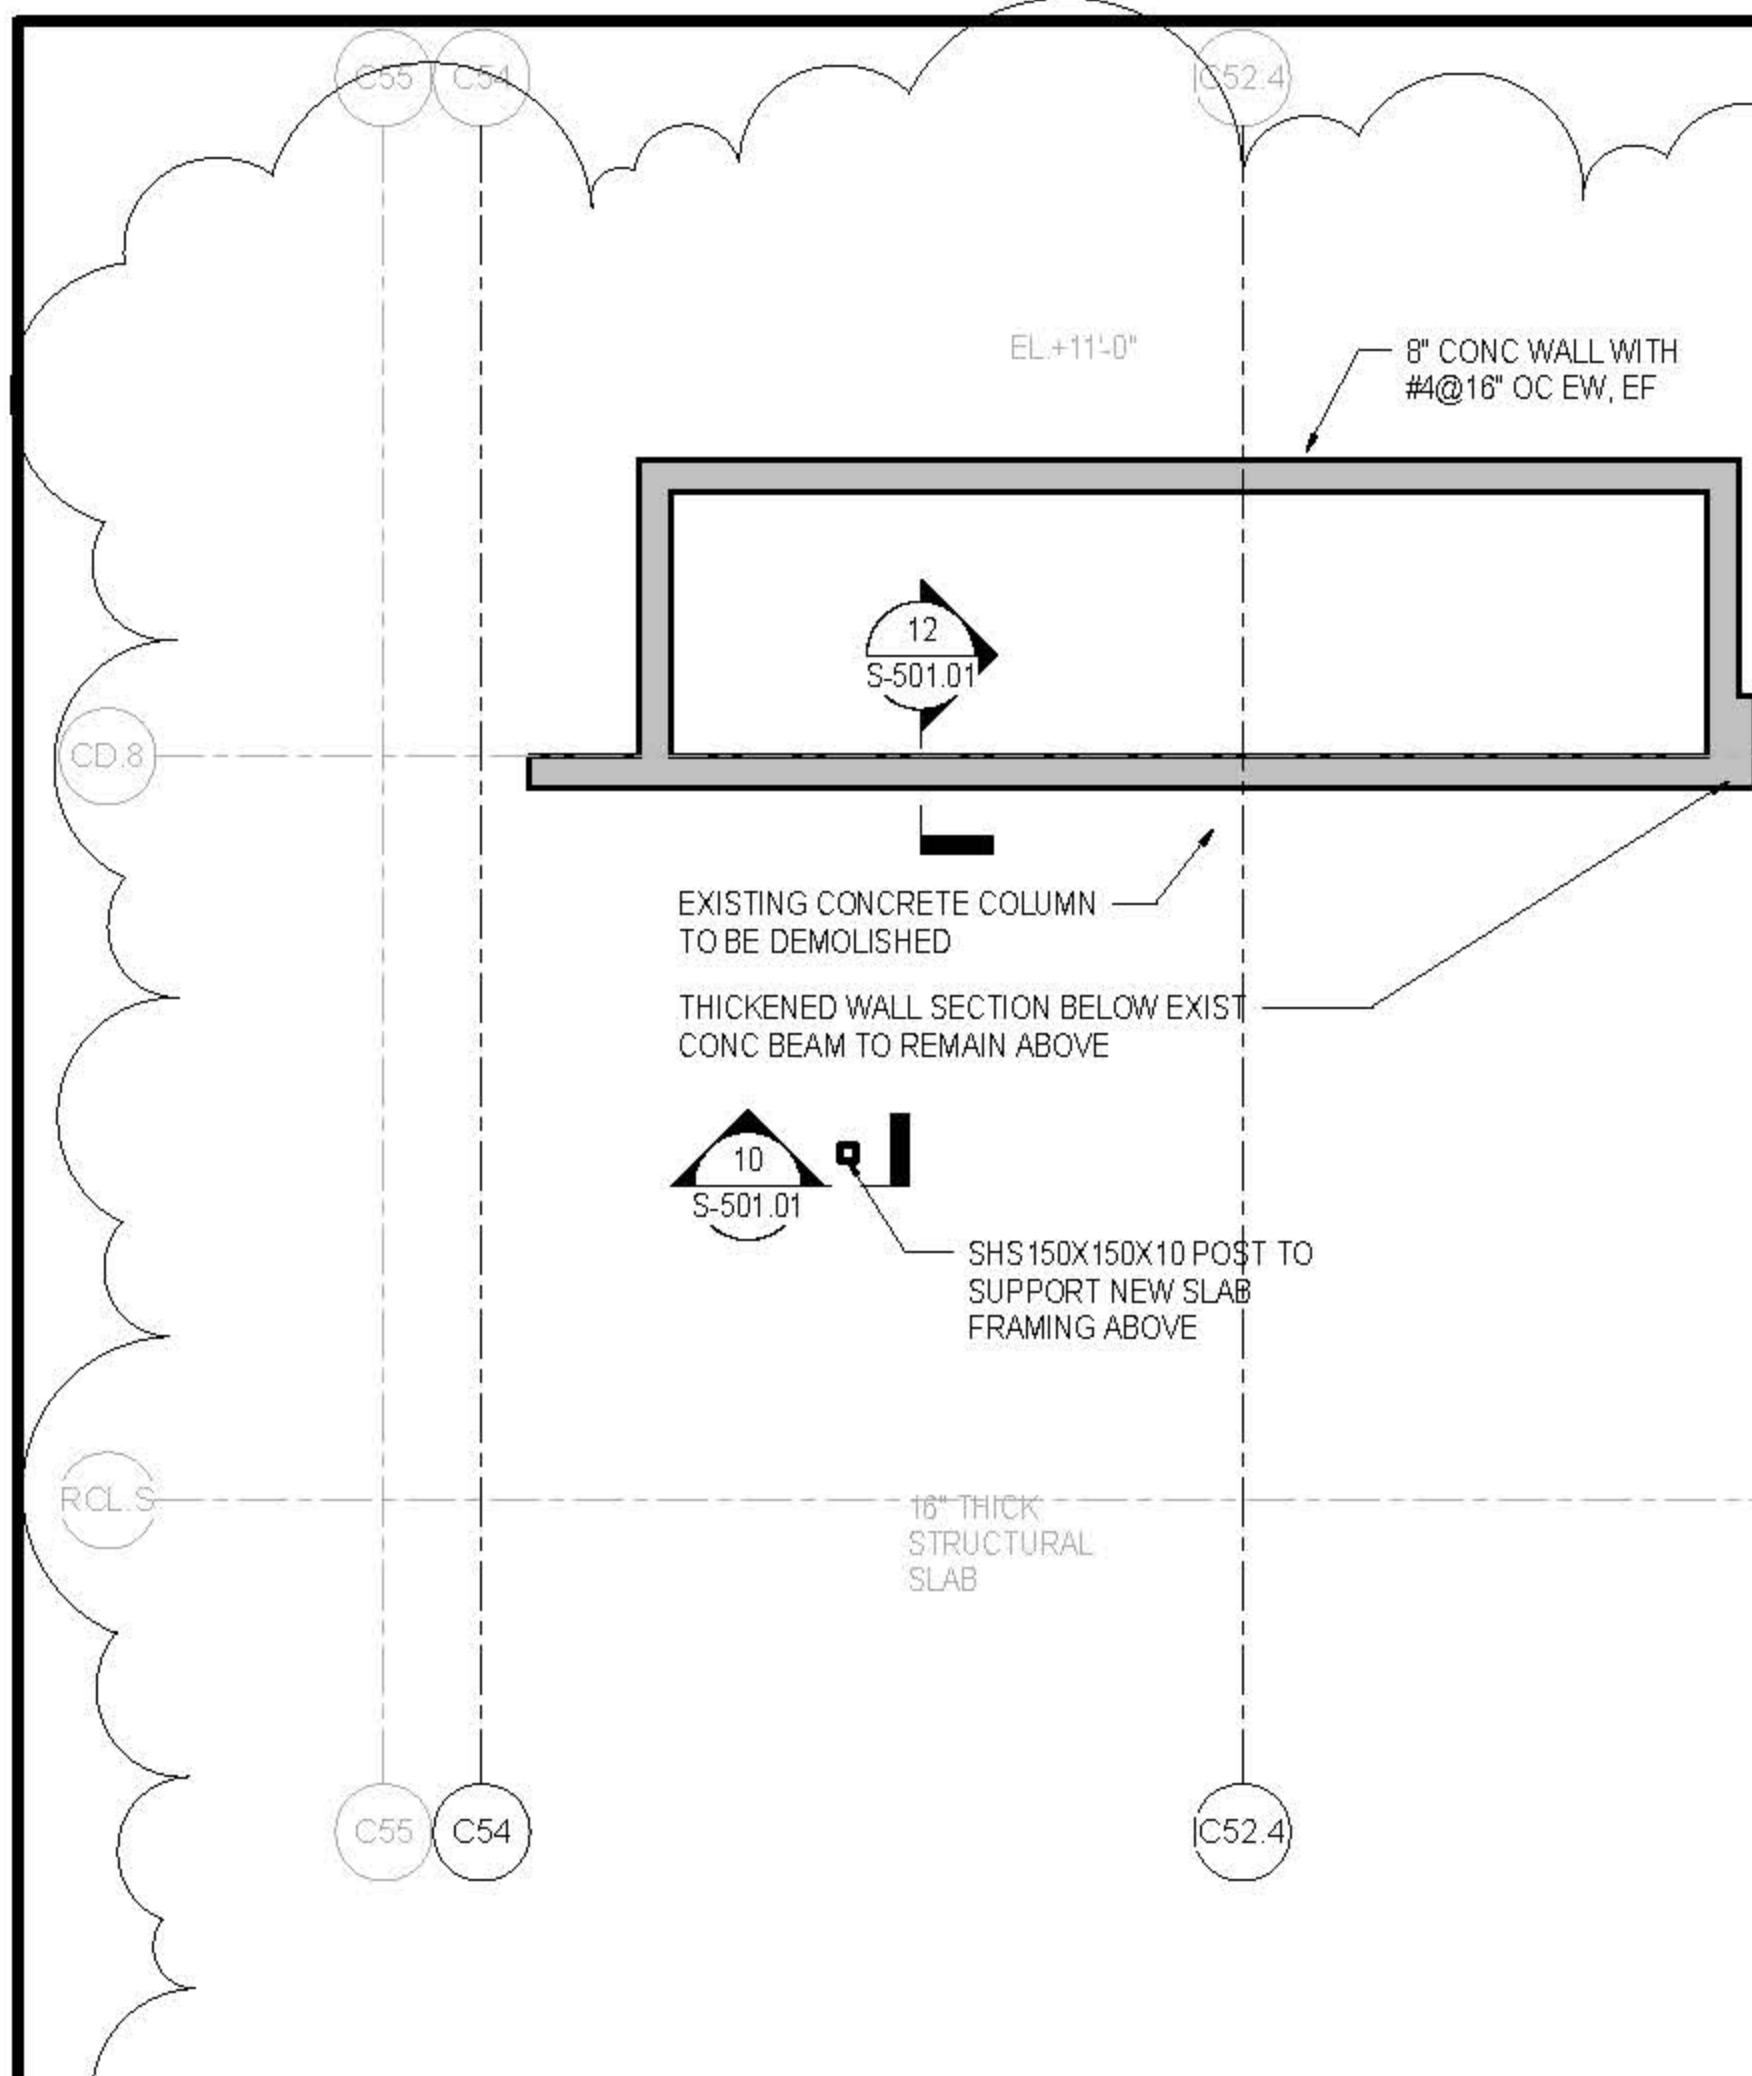


1 CELLAR LEVEL PART PLAN
1/4" = 1'-0"

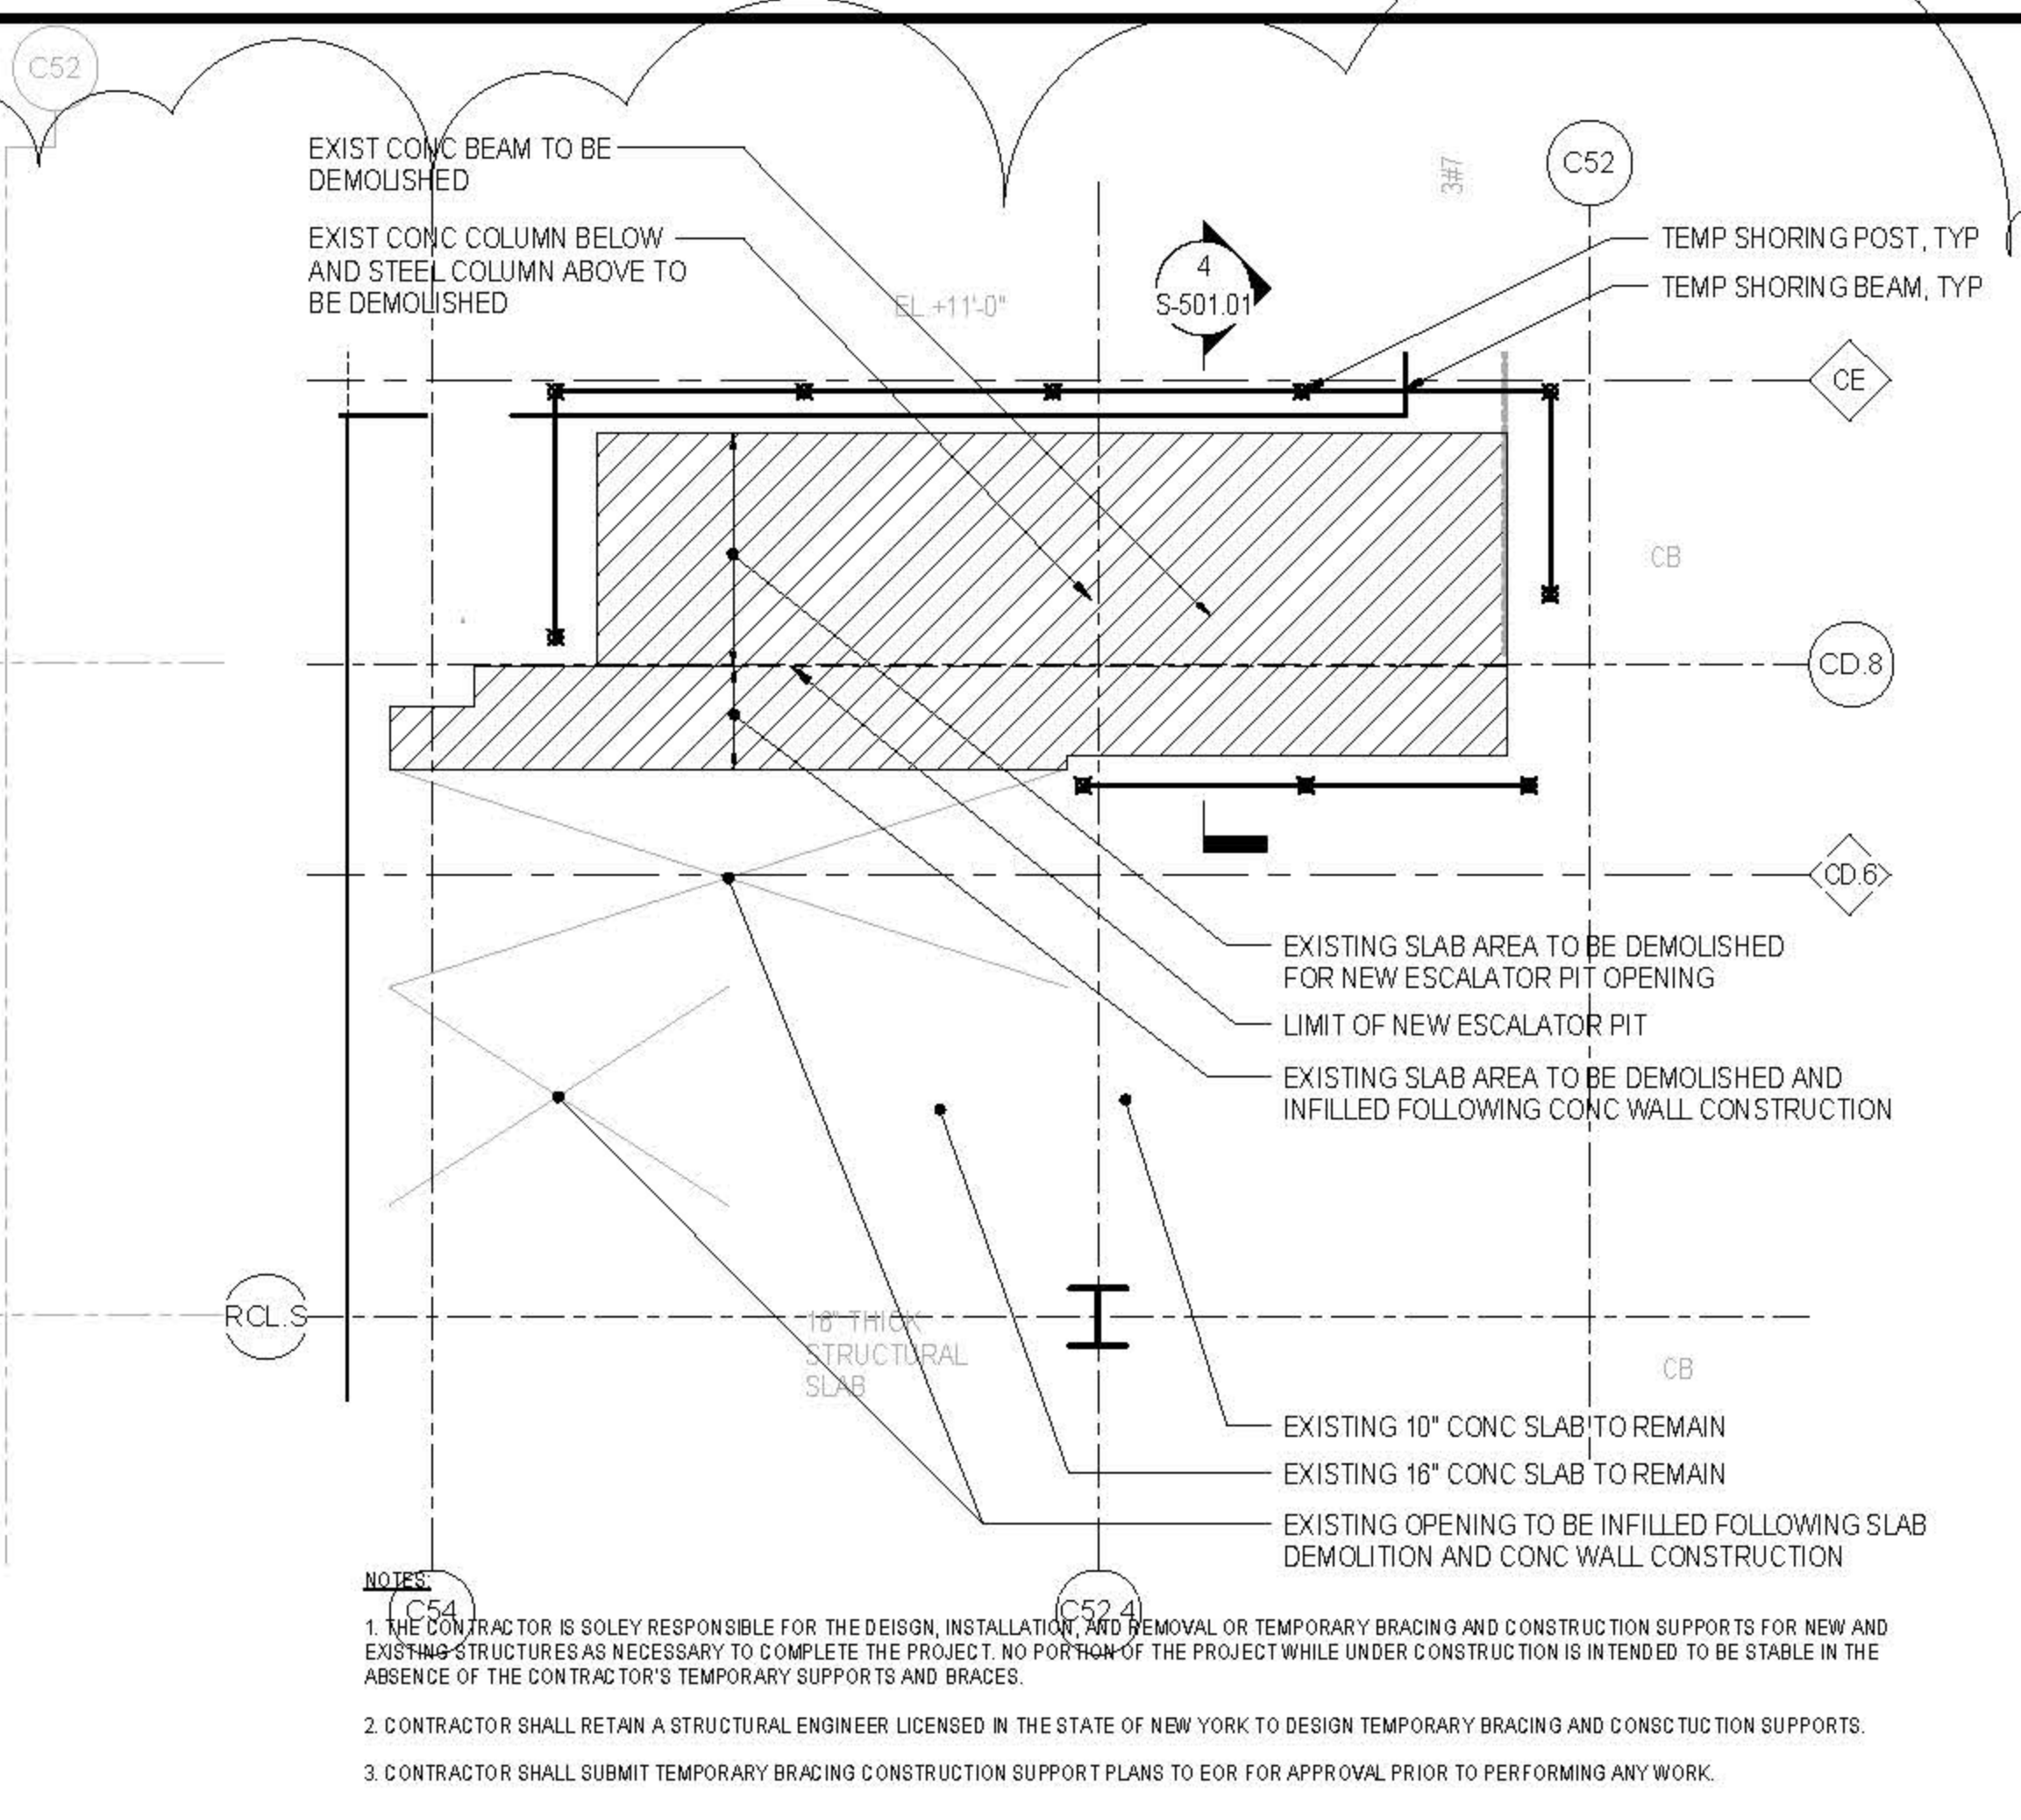


2 PARTIAL LEVEL 00 DEMOLITION PLAN
1/4" = 1'-0"

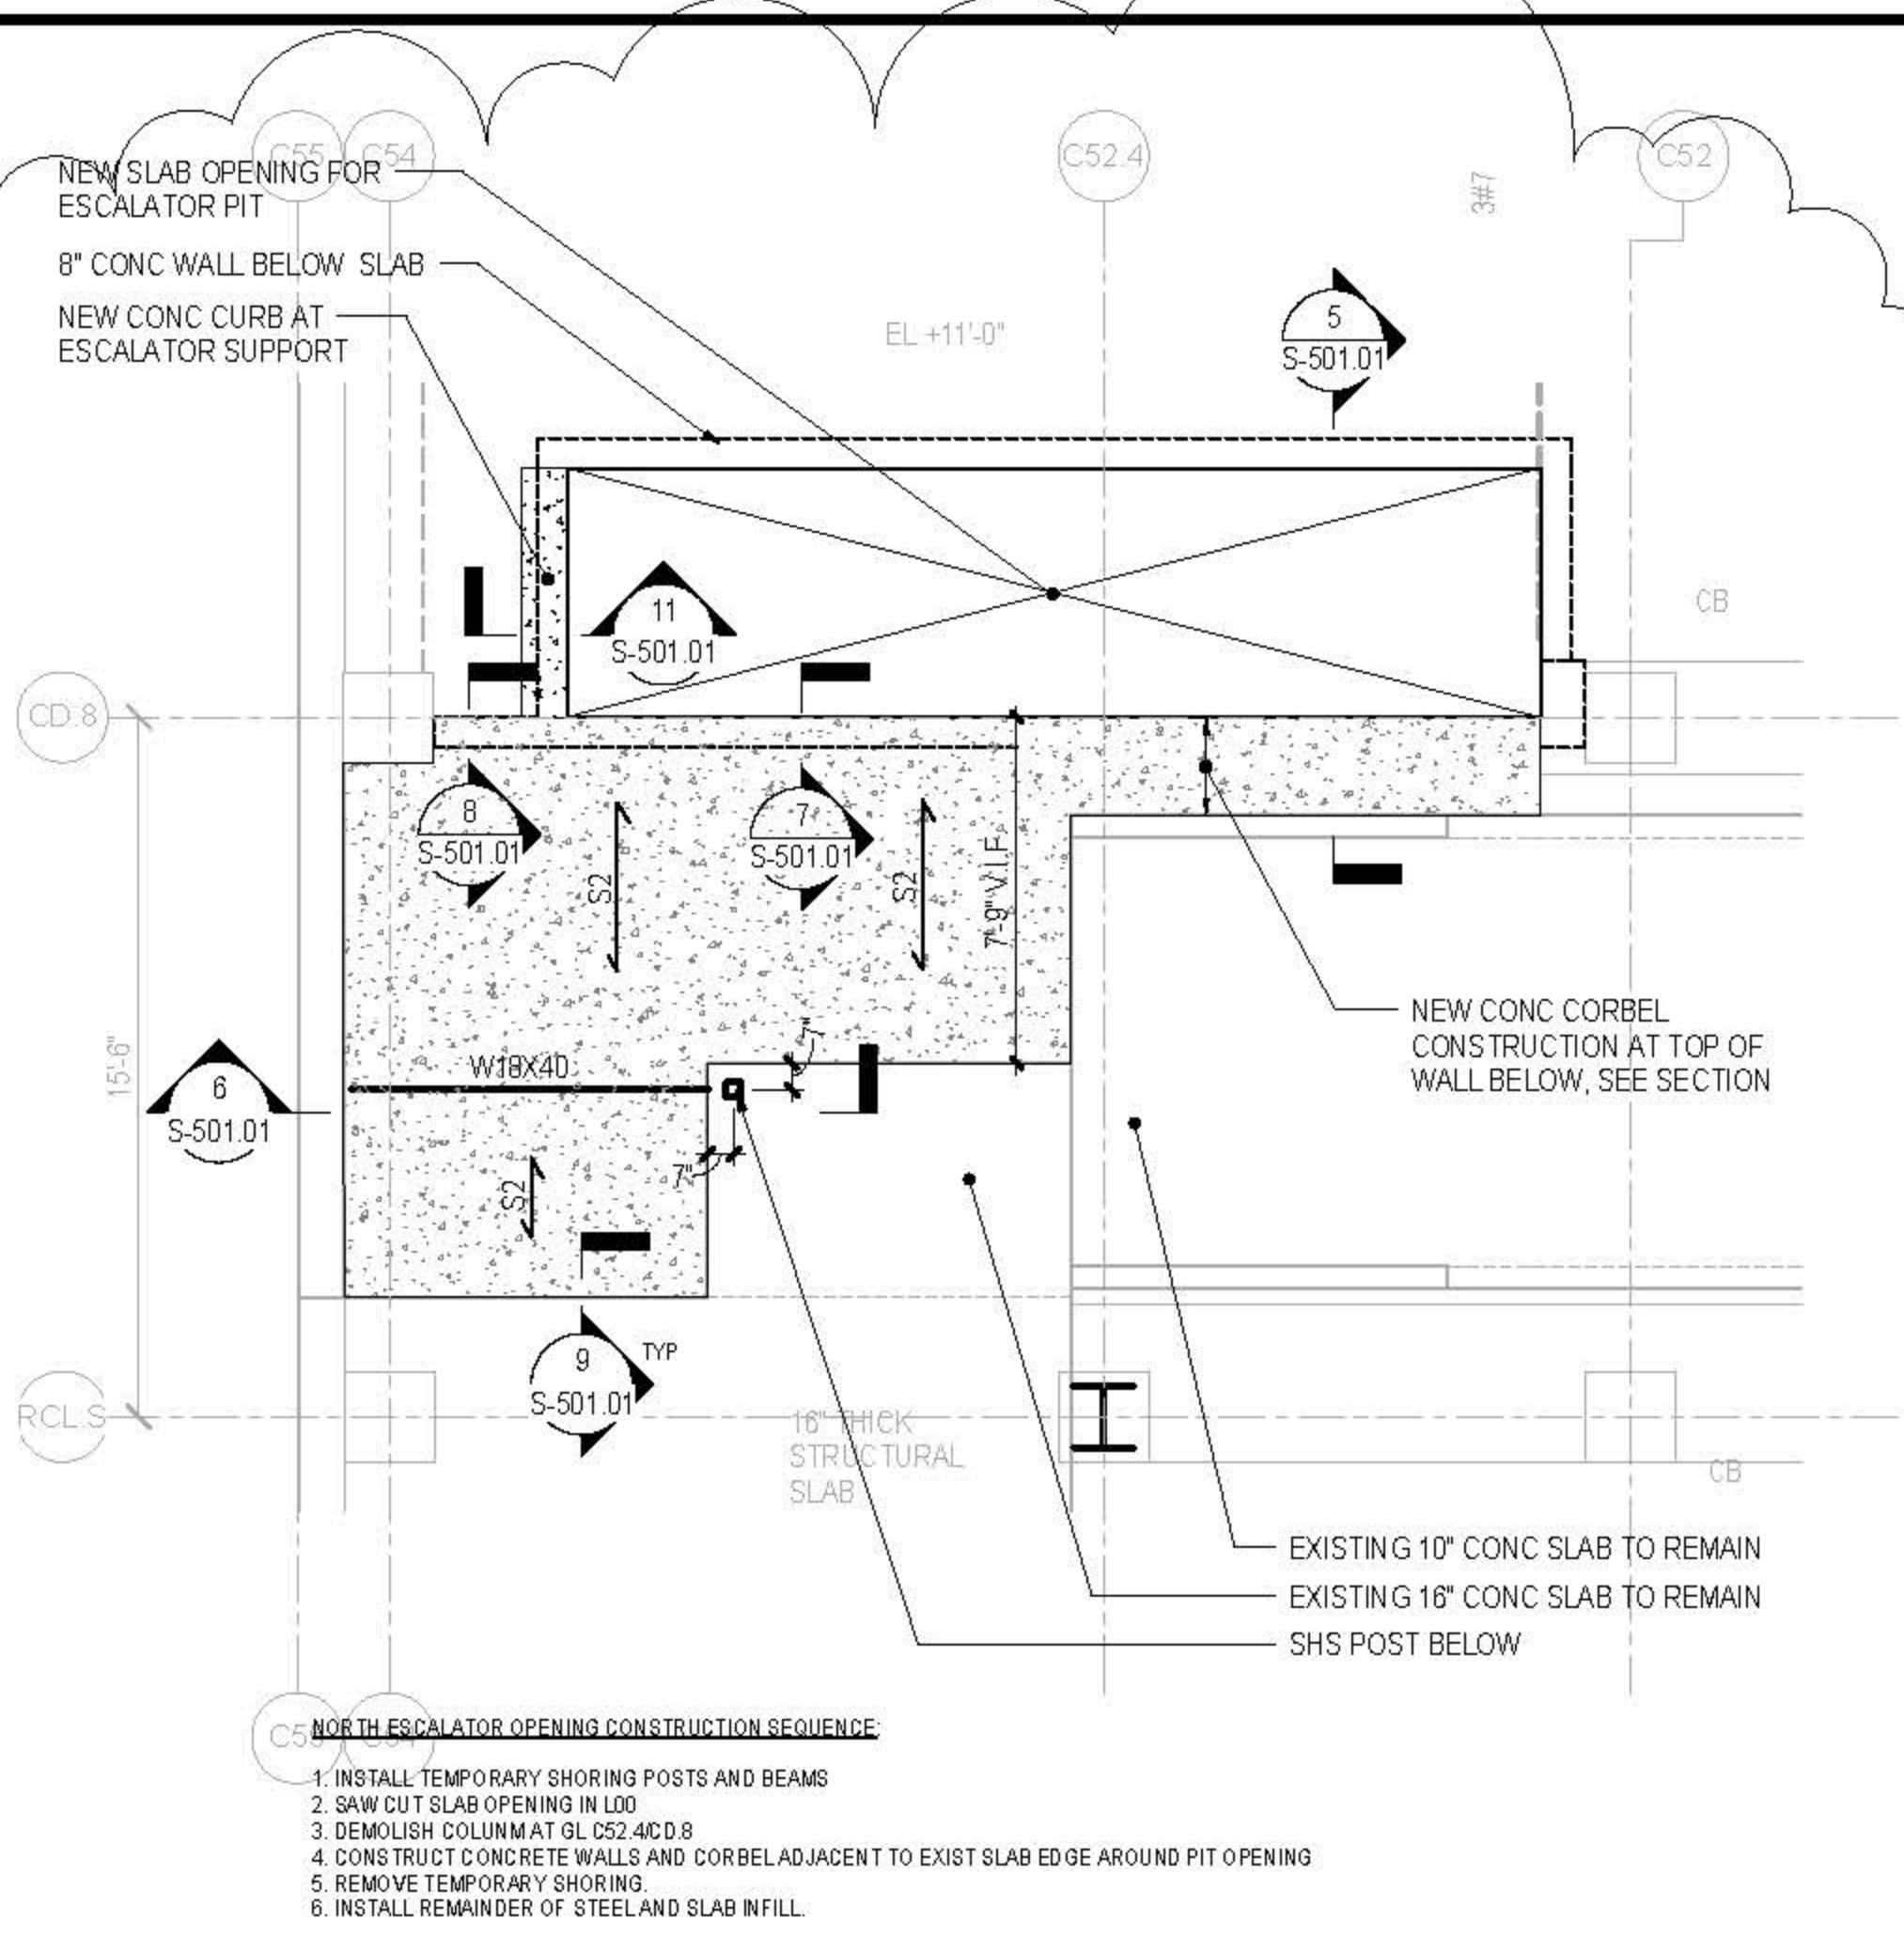


3 PARTIAL LEVEL 00 NEW CONSTRUCTION PLAN
1/4" = 1'-0"

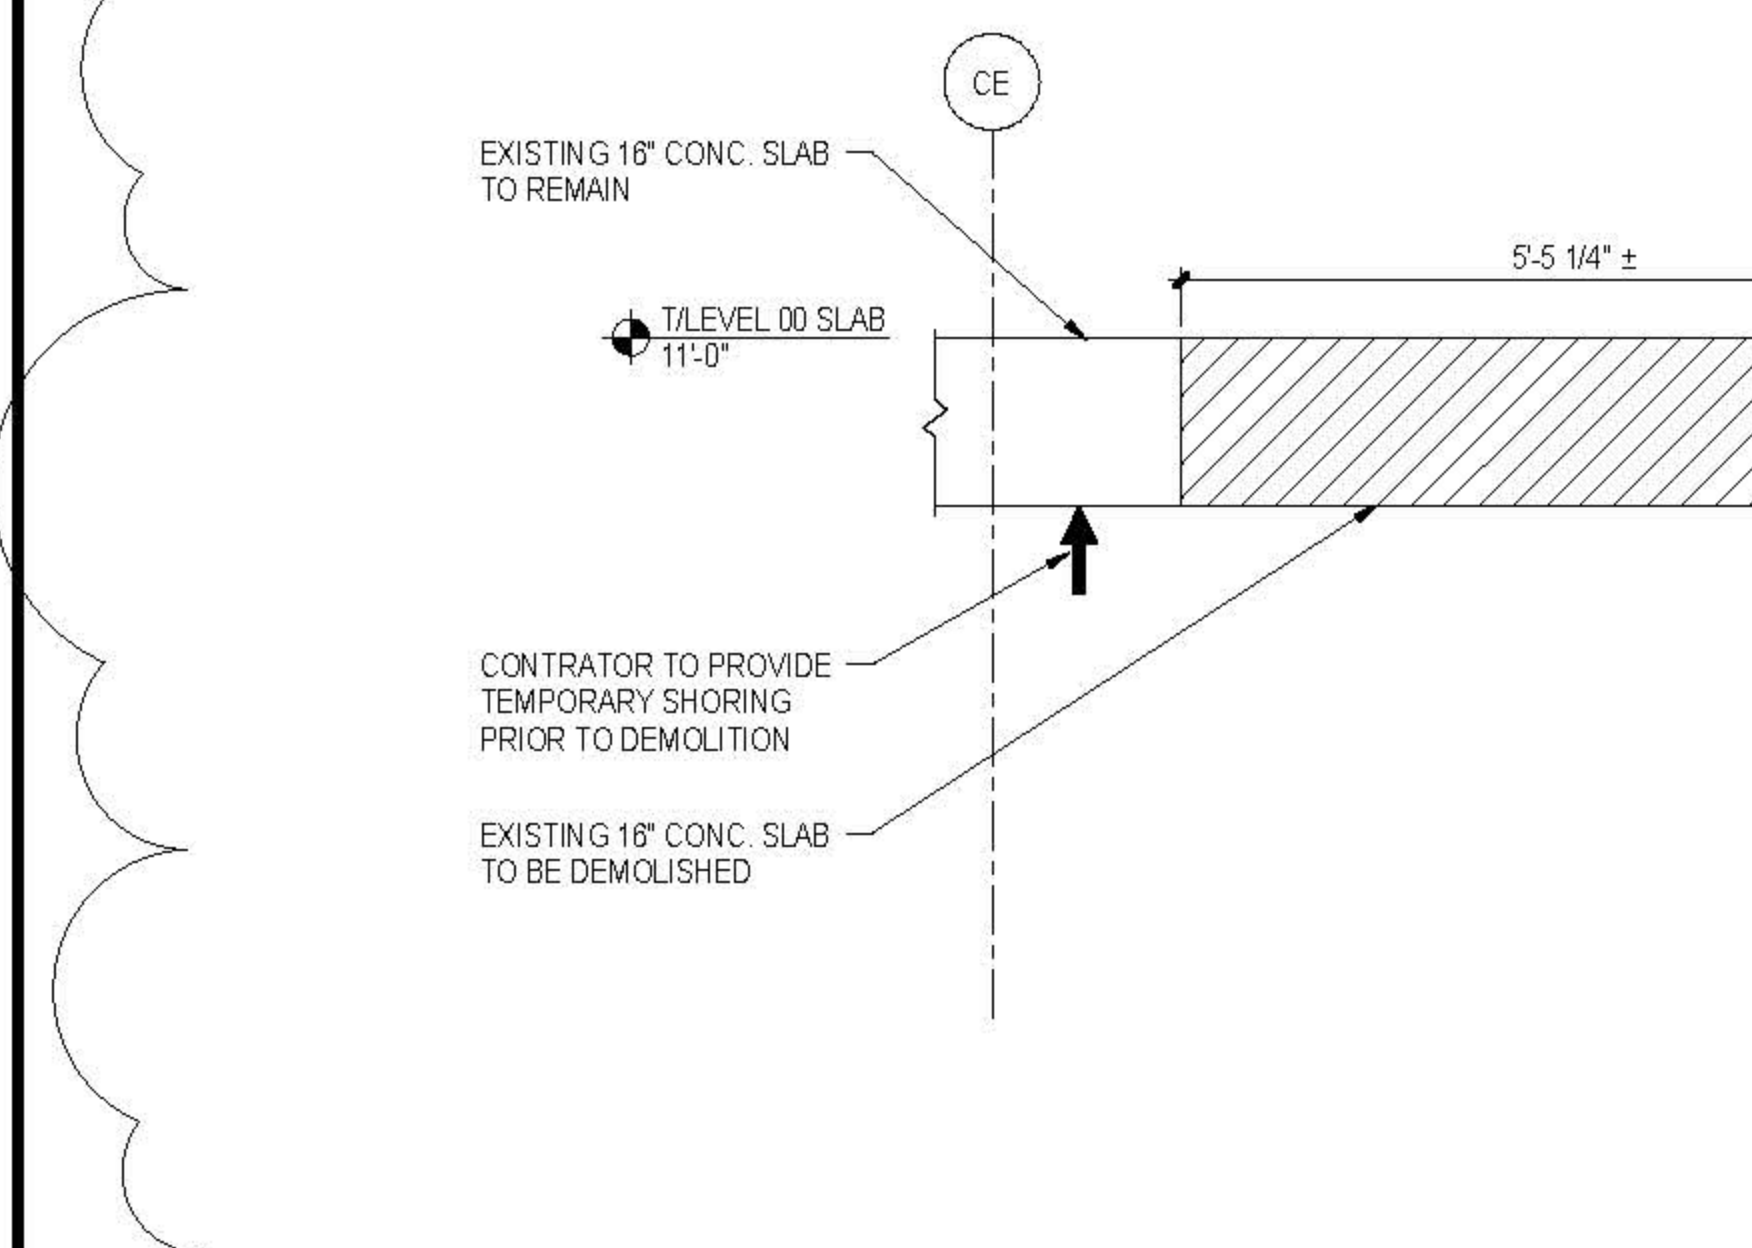


4 DEMOLITION SECTION AT ESCALATOR SLAB OPENING
3/4" = 1'-0"

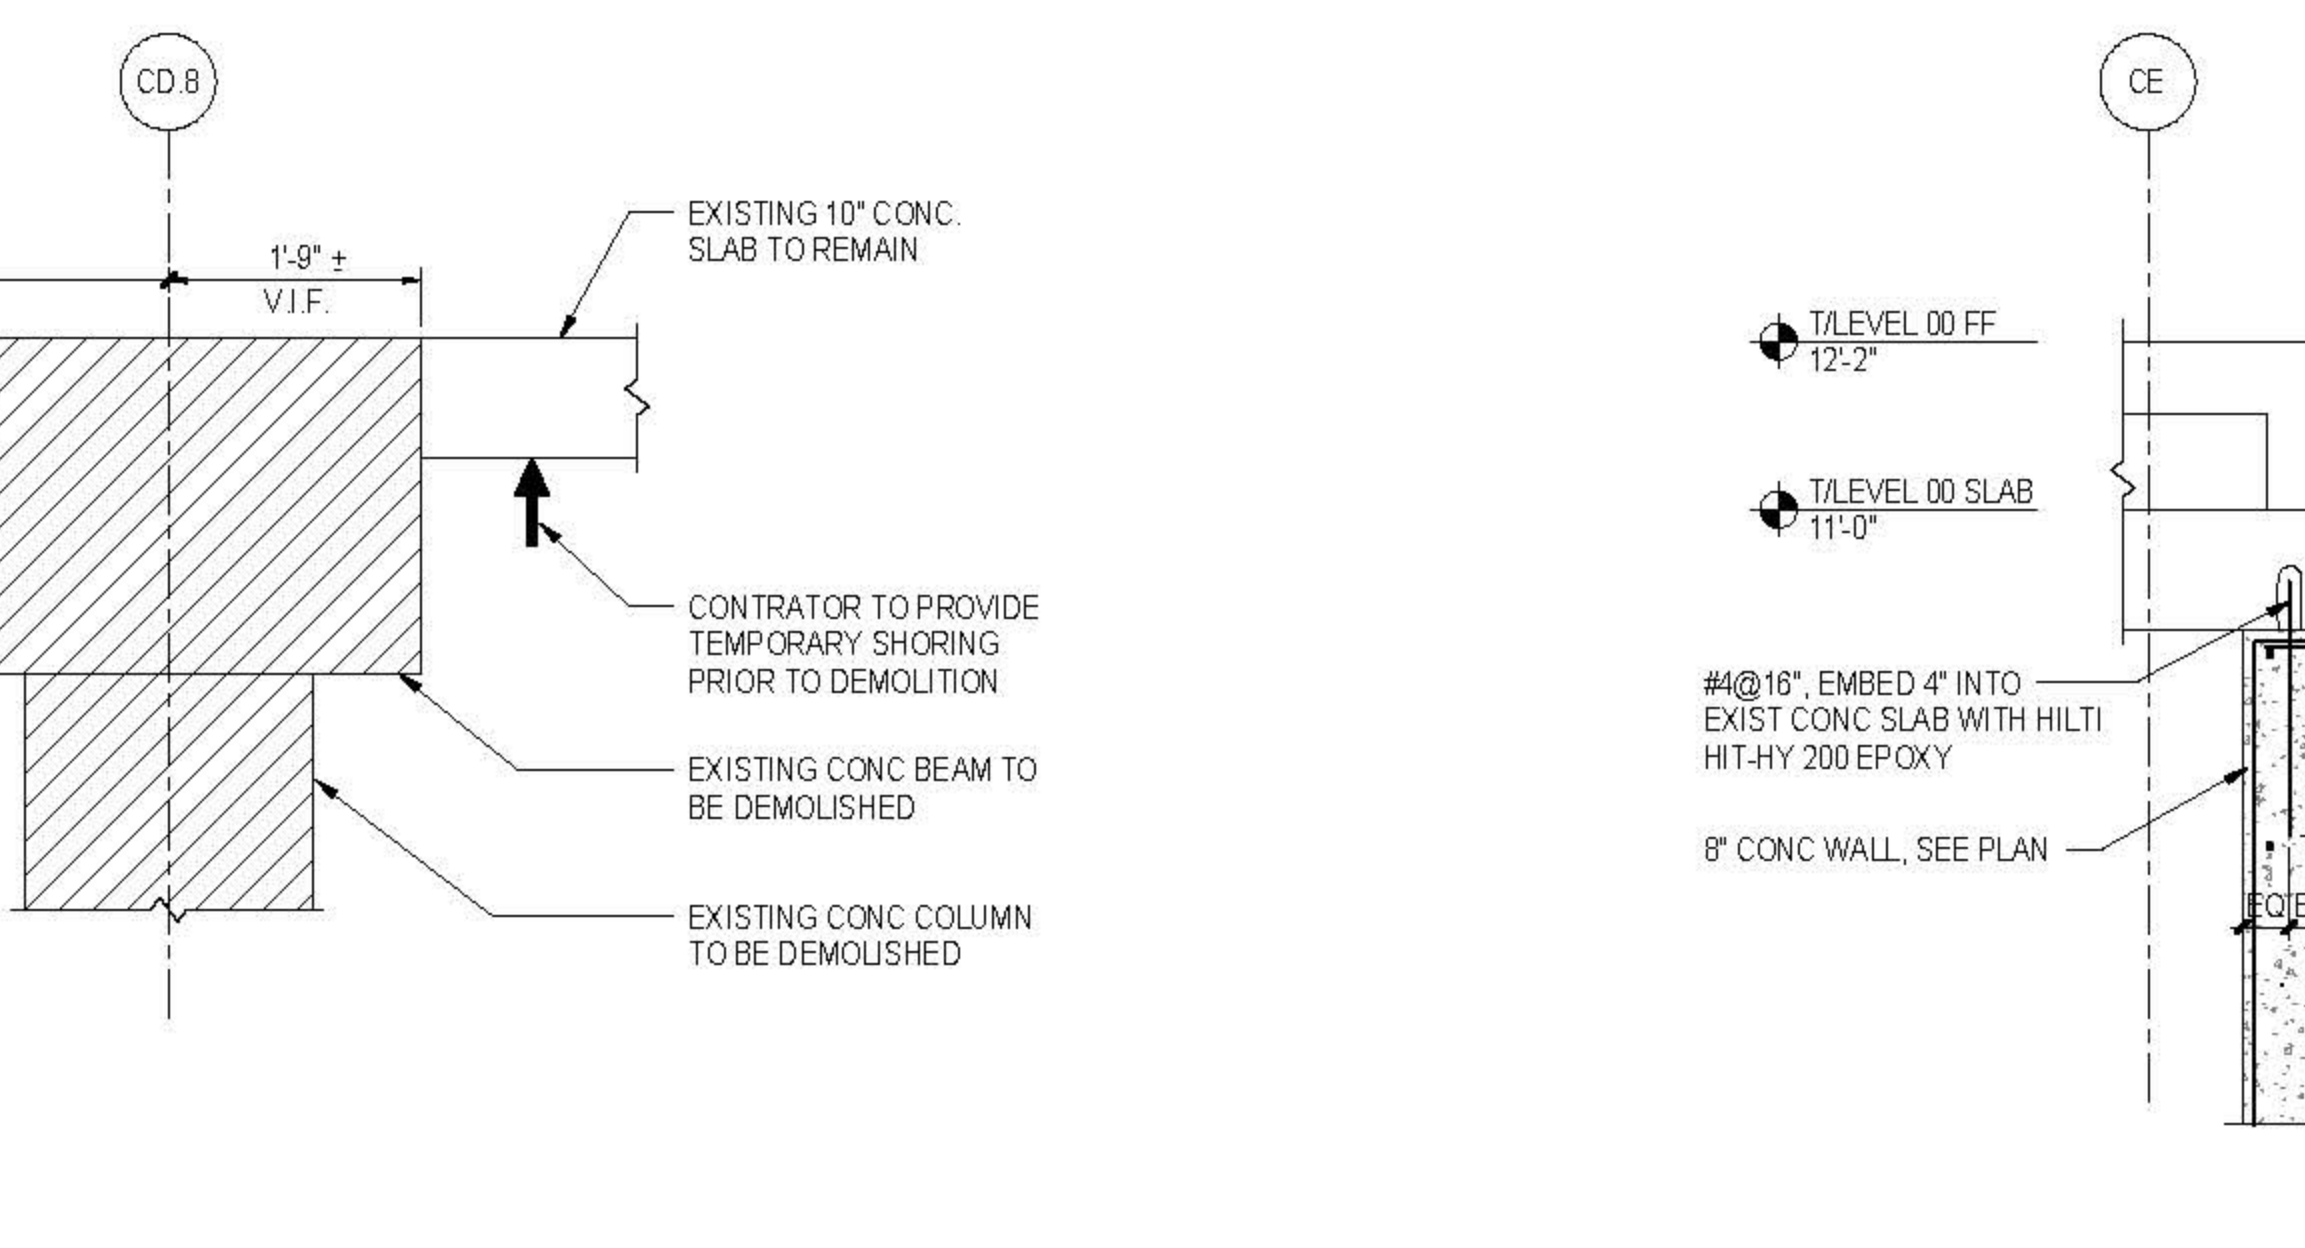


5 NEW CONSTRUCTION SECTION AT ESCALATOR SLAB OPENING
3/4" = 1'-0"

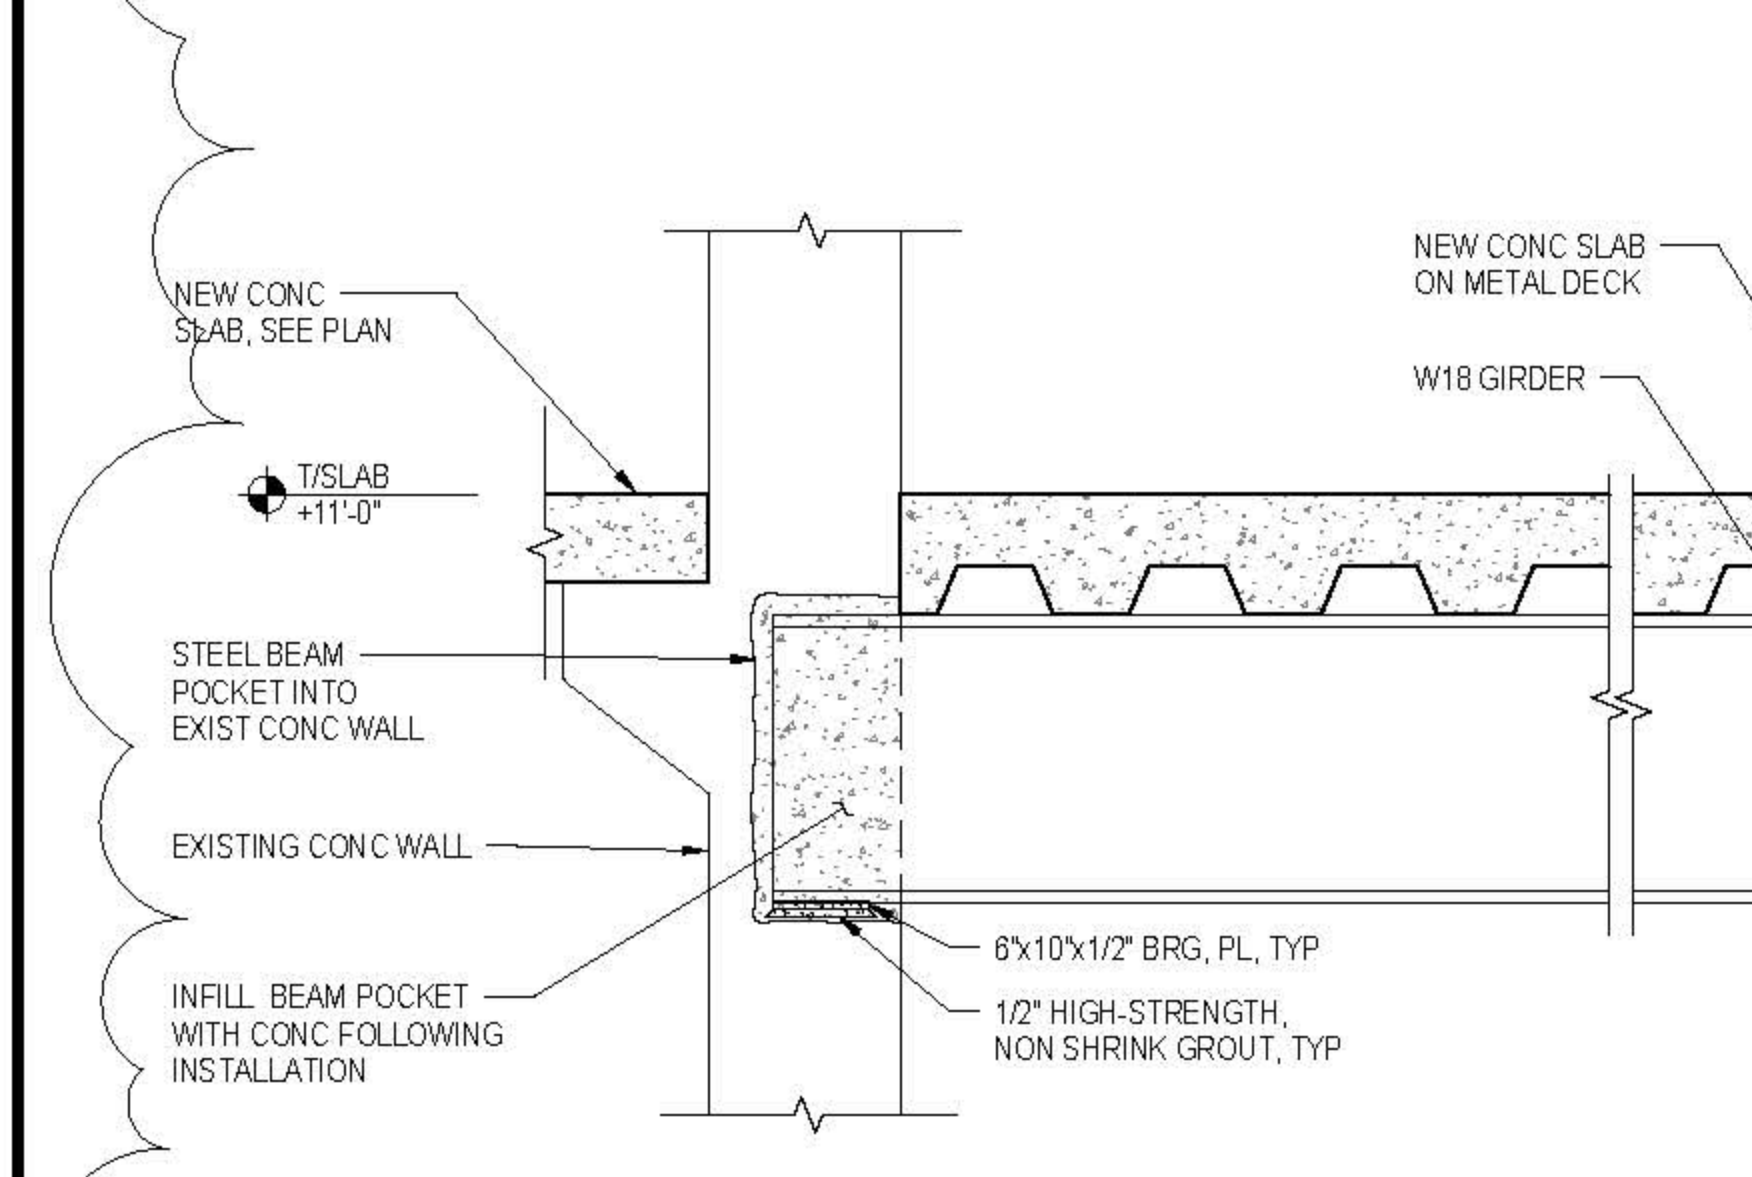


6 SECTION AT SLAB INFILL
1" = 1'-0"

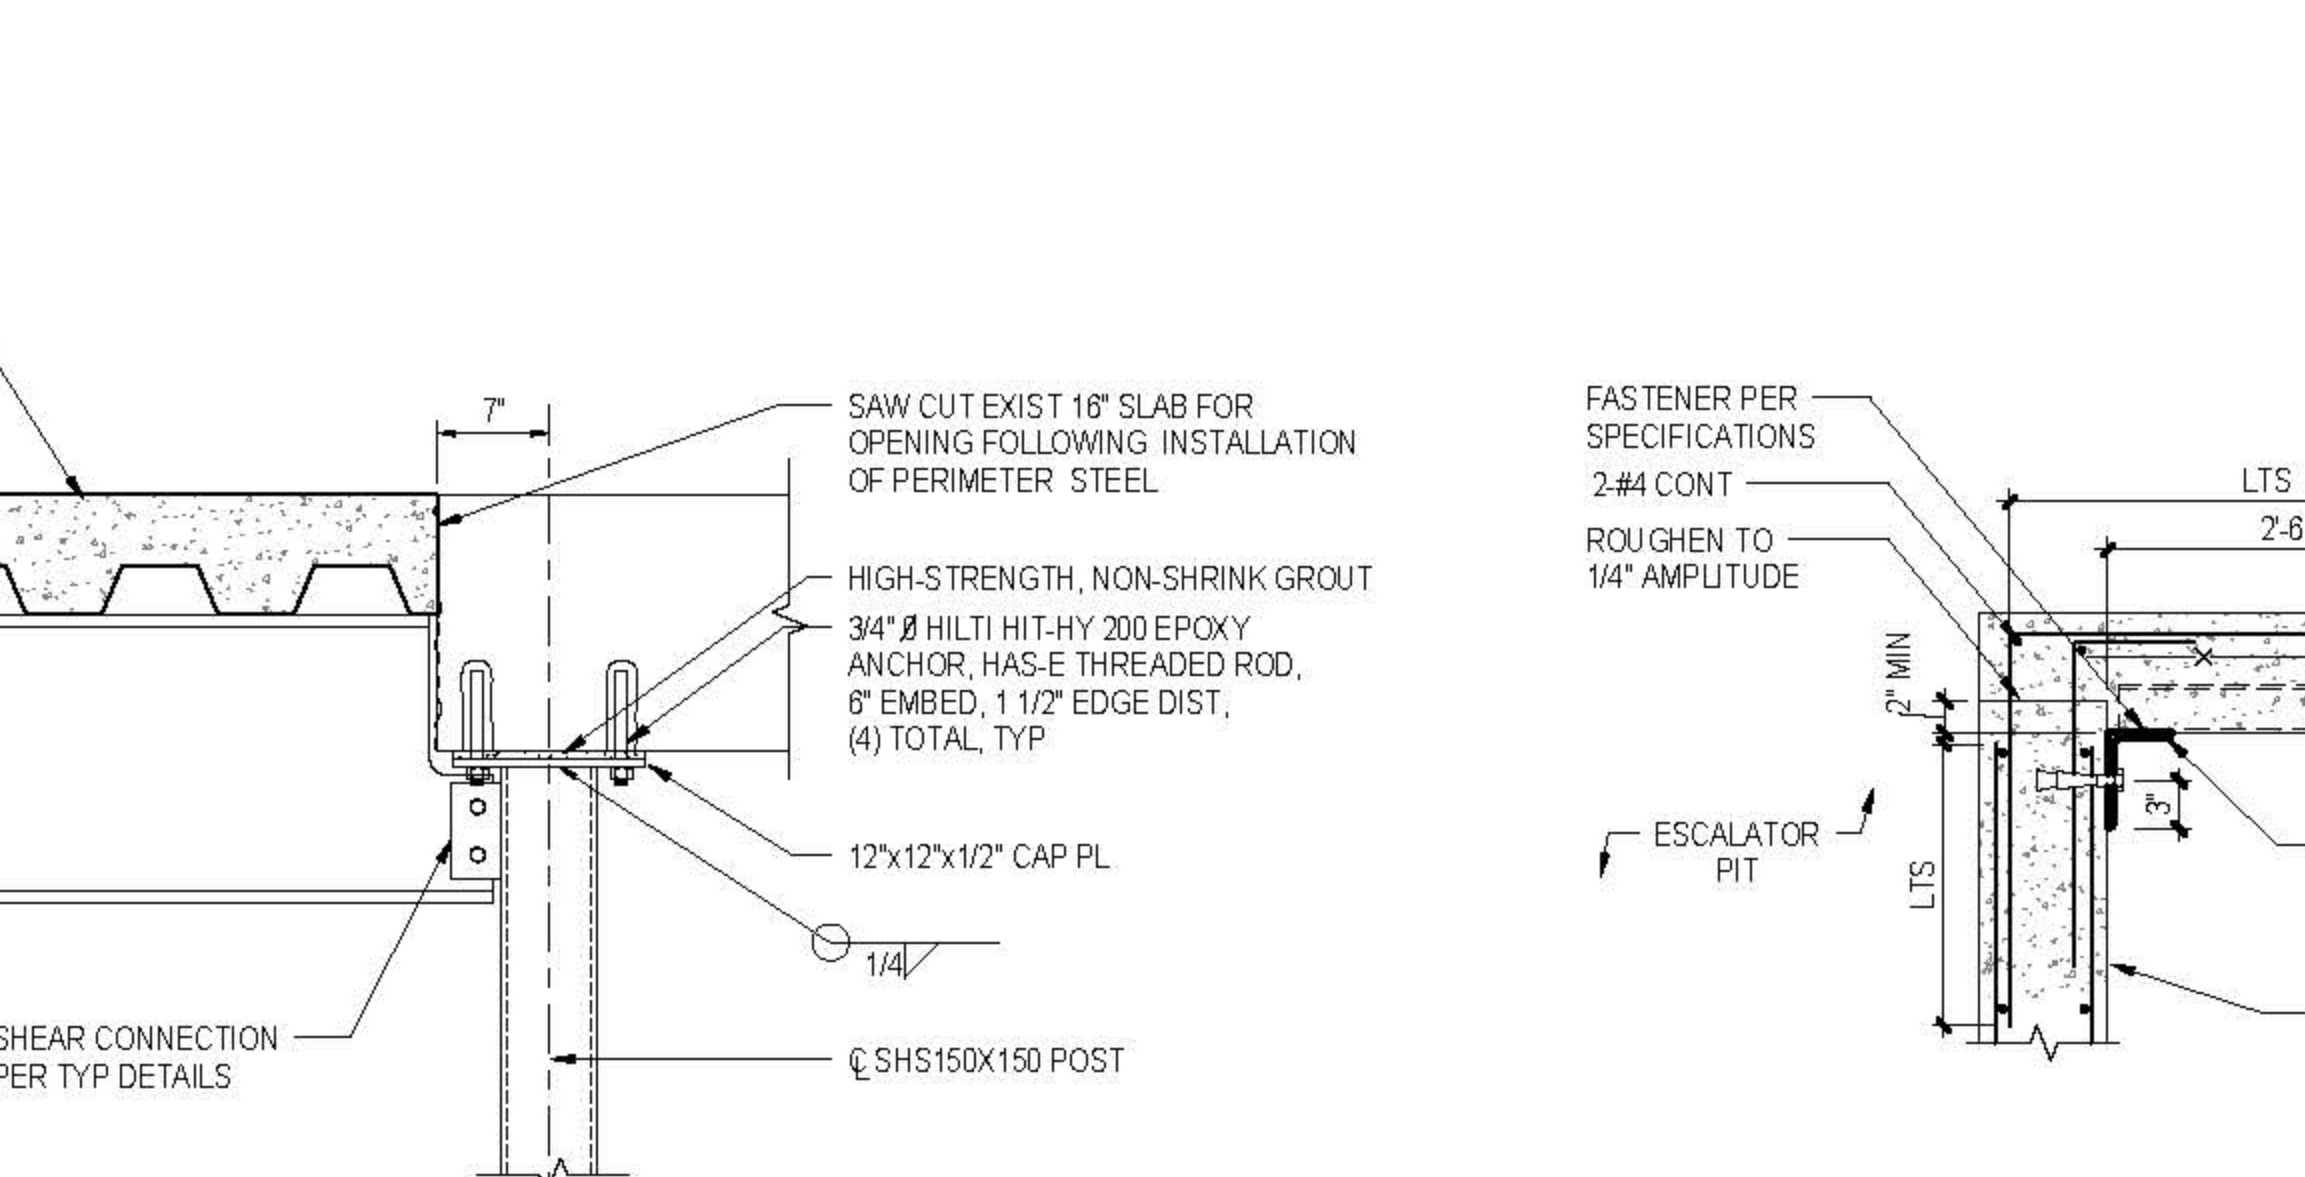


7 SECTION AT NEW SLAB CONN TO EXIST SLAB
1" = 1'-0"

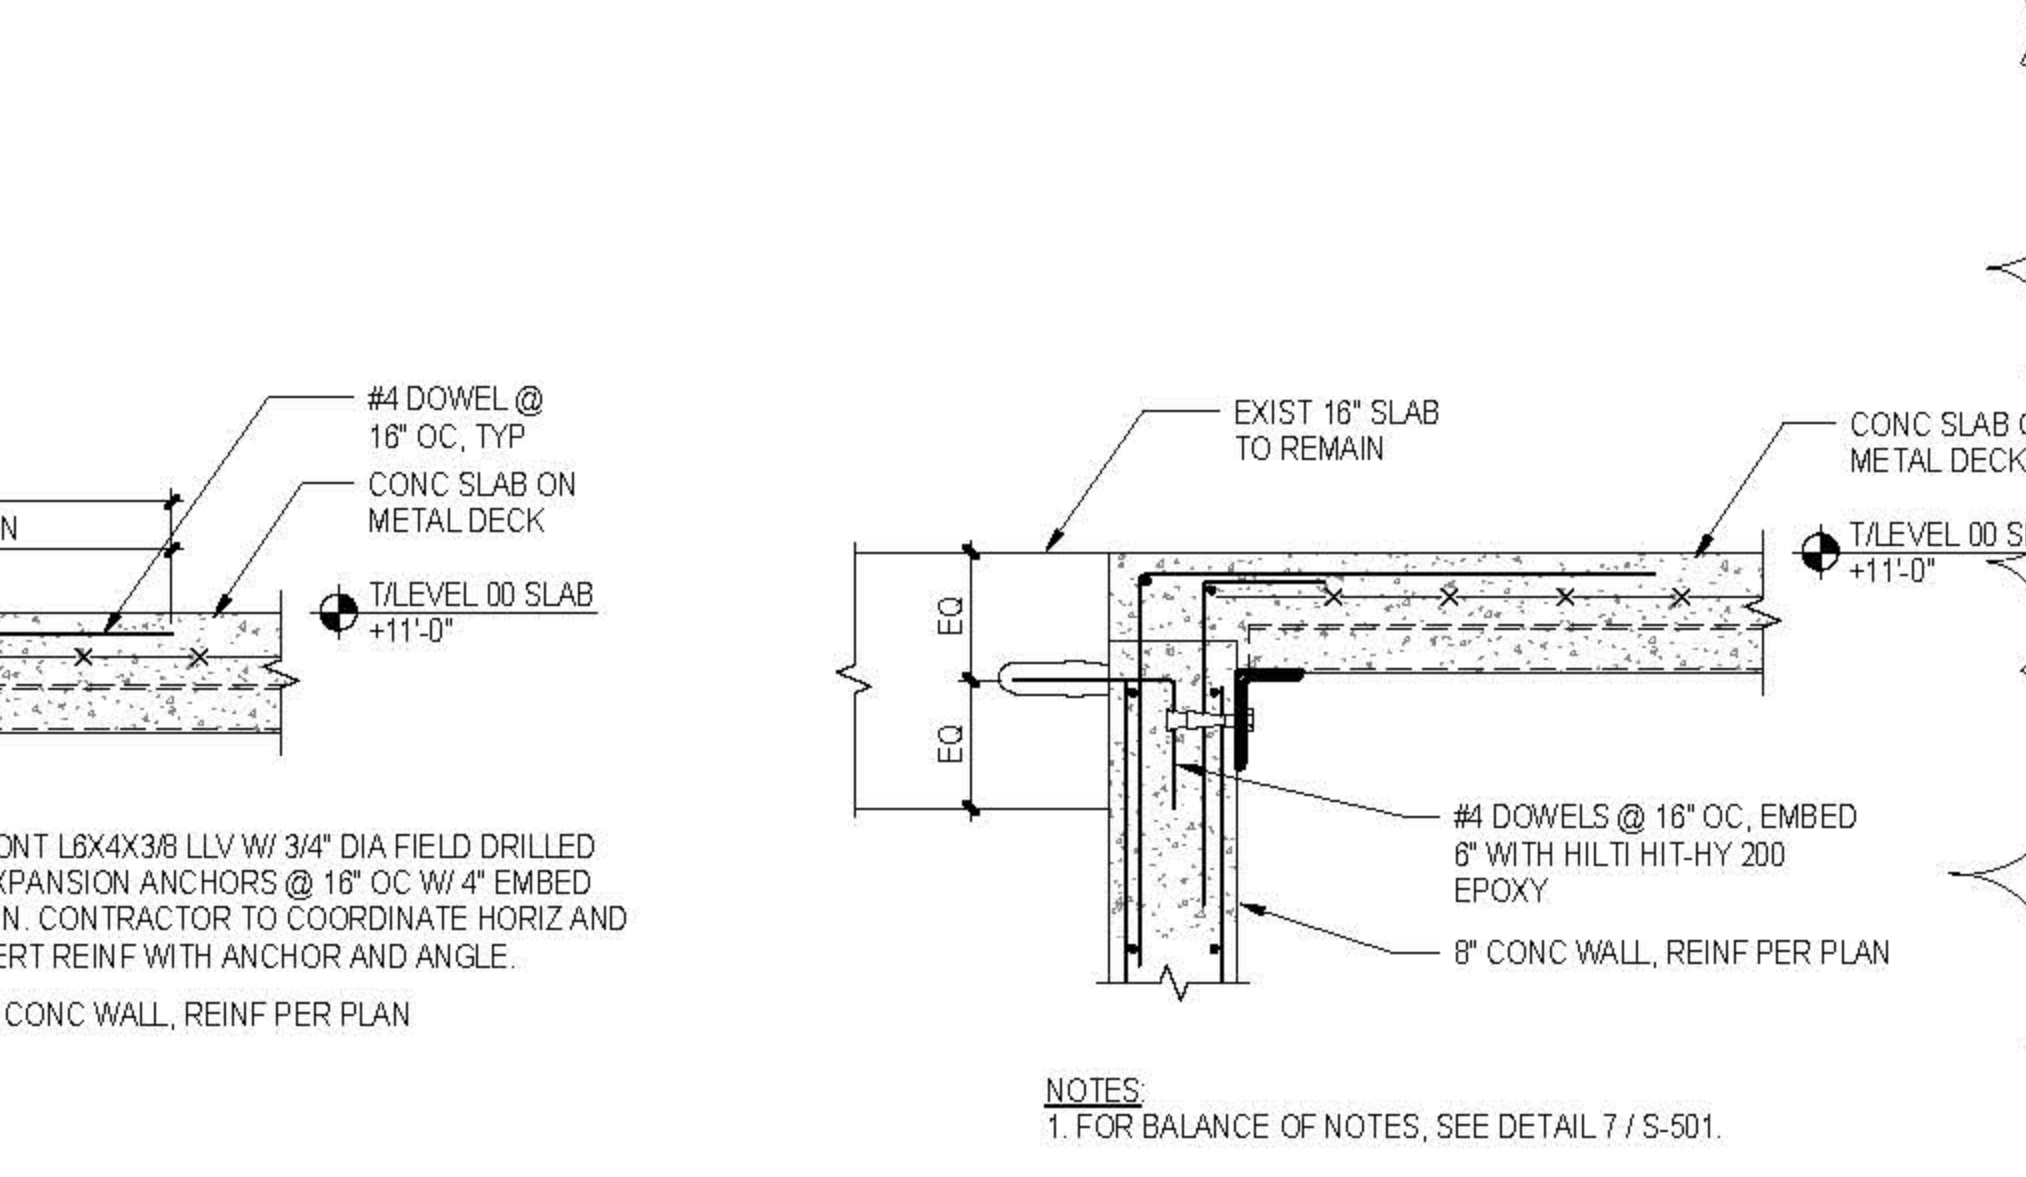


8 SECTION AT NEW SLAB CONN TO EXIST SLAB
1" = 1'-0"

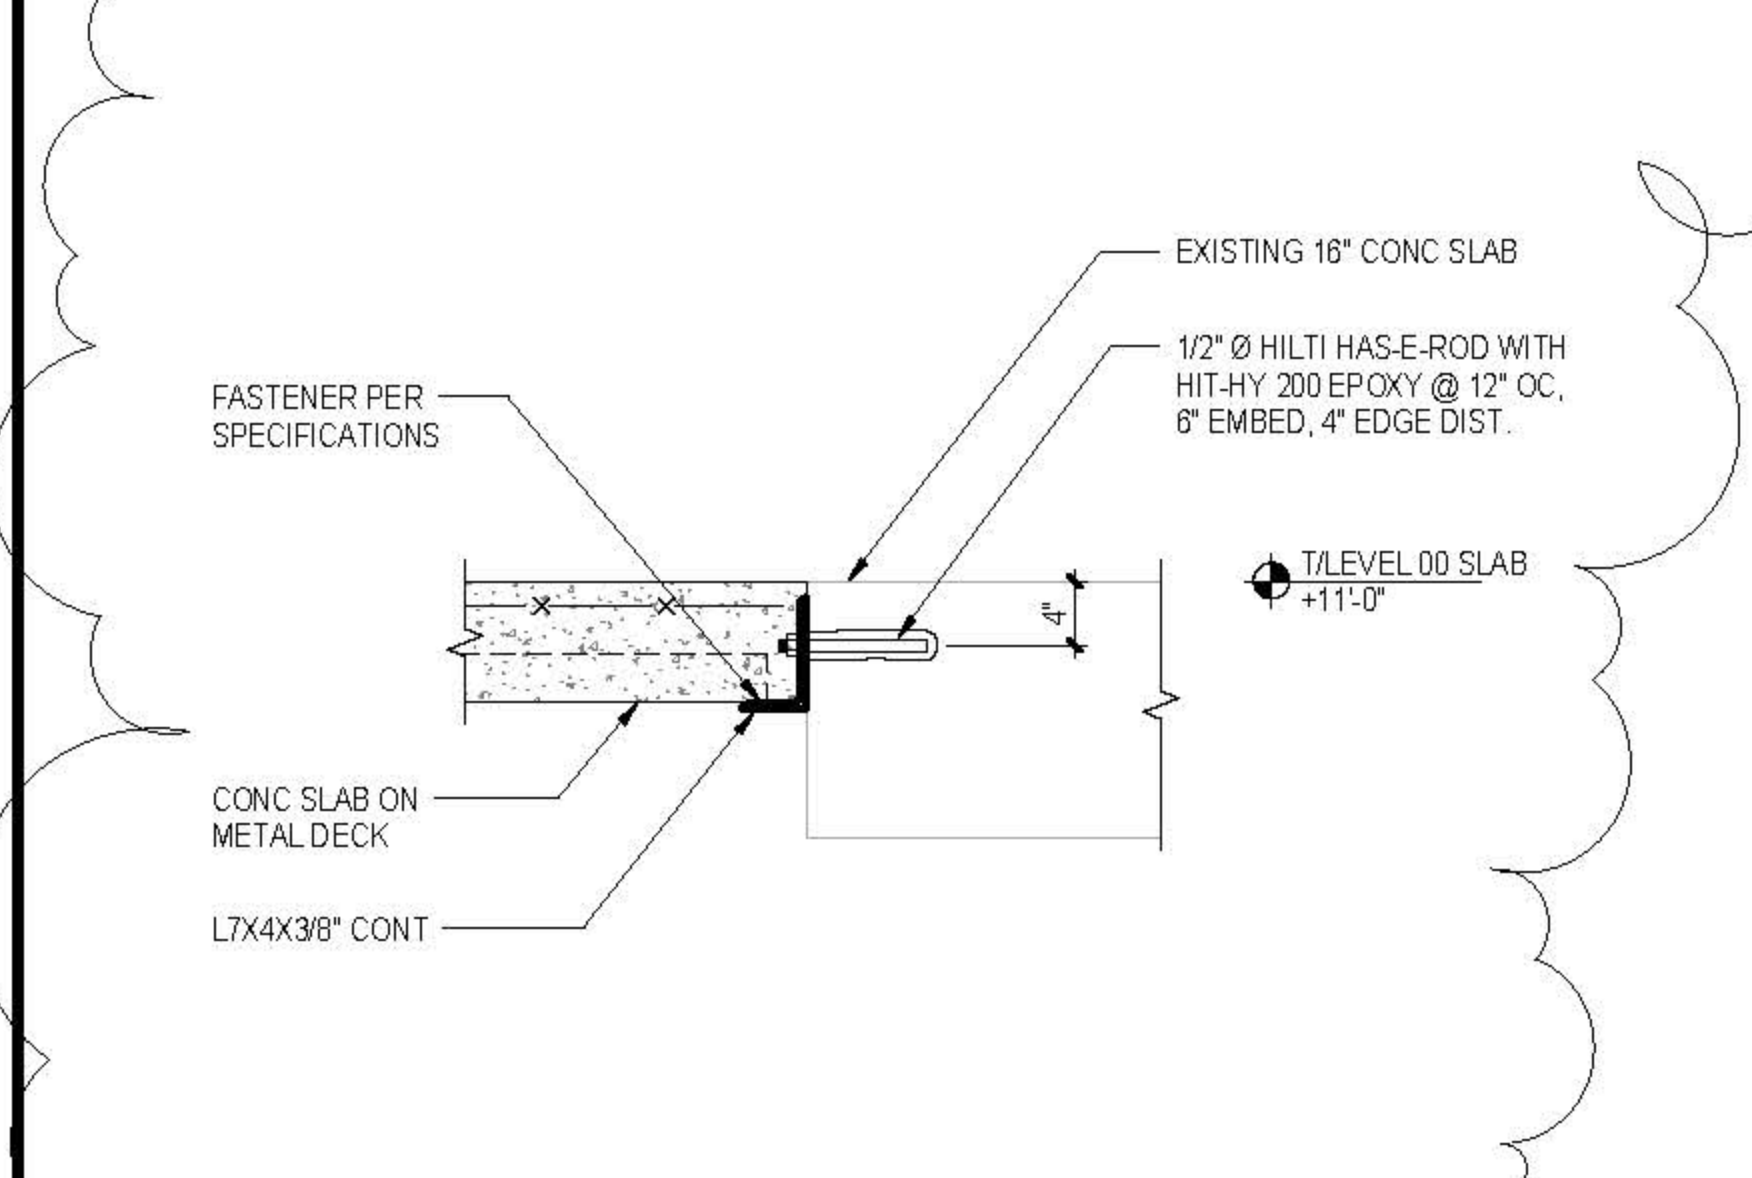

9 SECTION AT NEW SLAB CONN TO EXIST SLAB
1" = 1'-0"

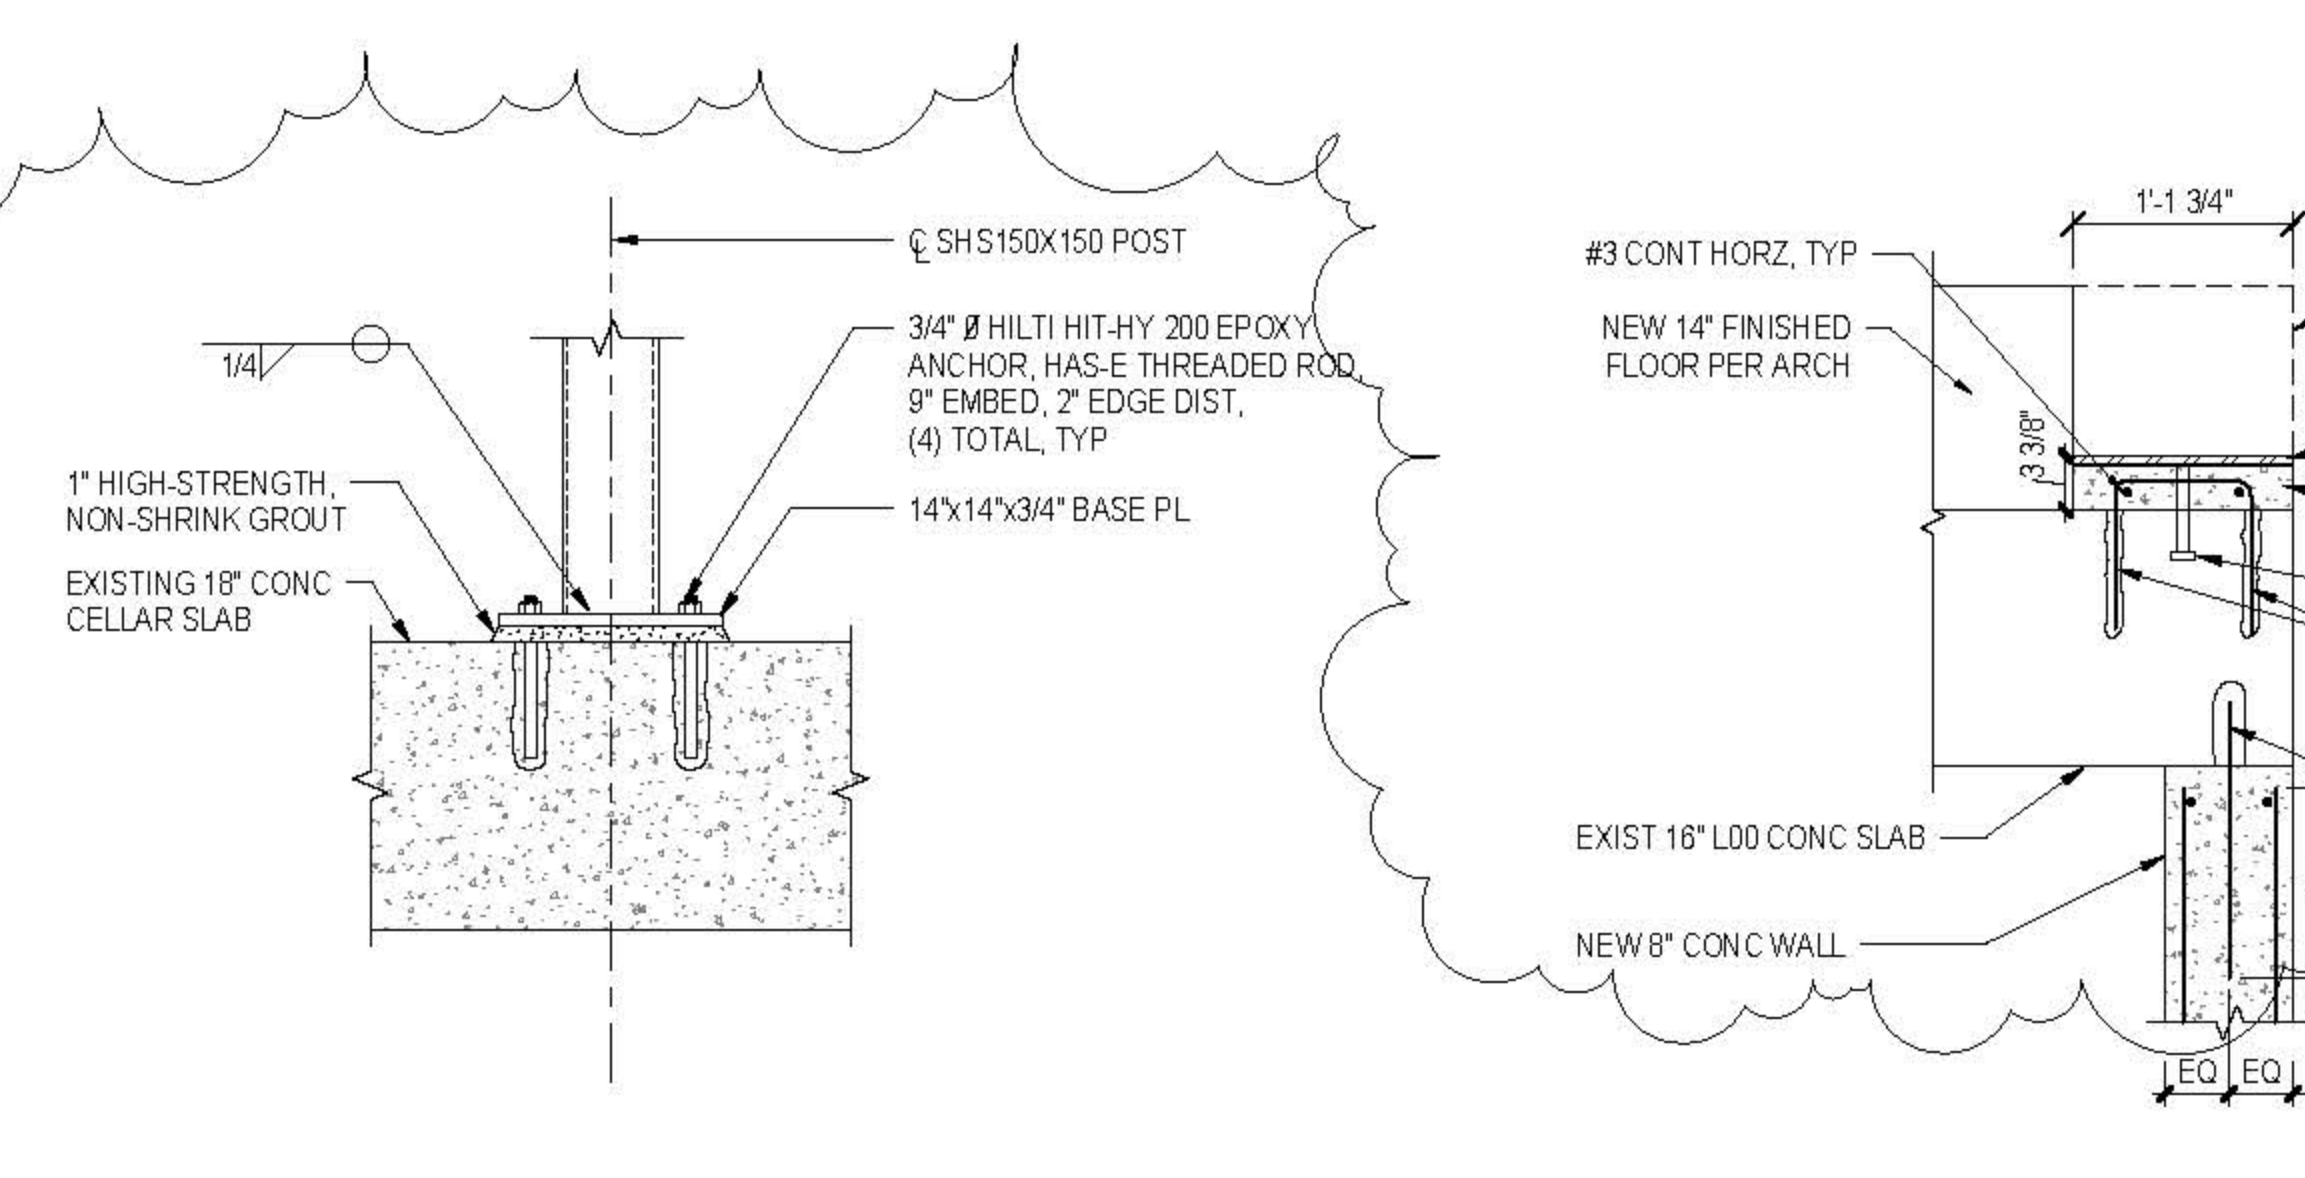


10 TYPICAL SECTION AT SHS POST BASE PLATE
1" = 1'-0"

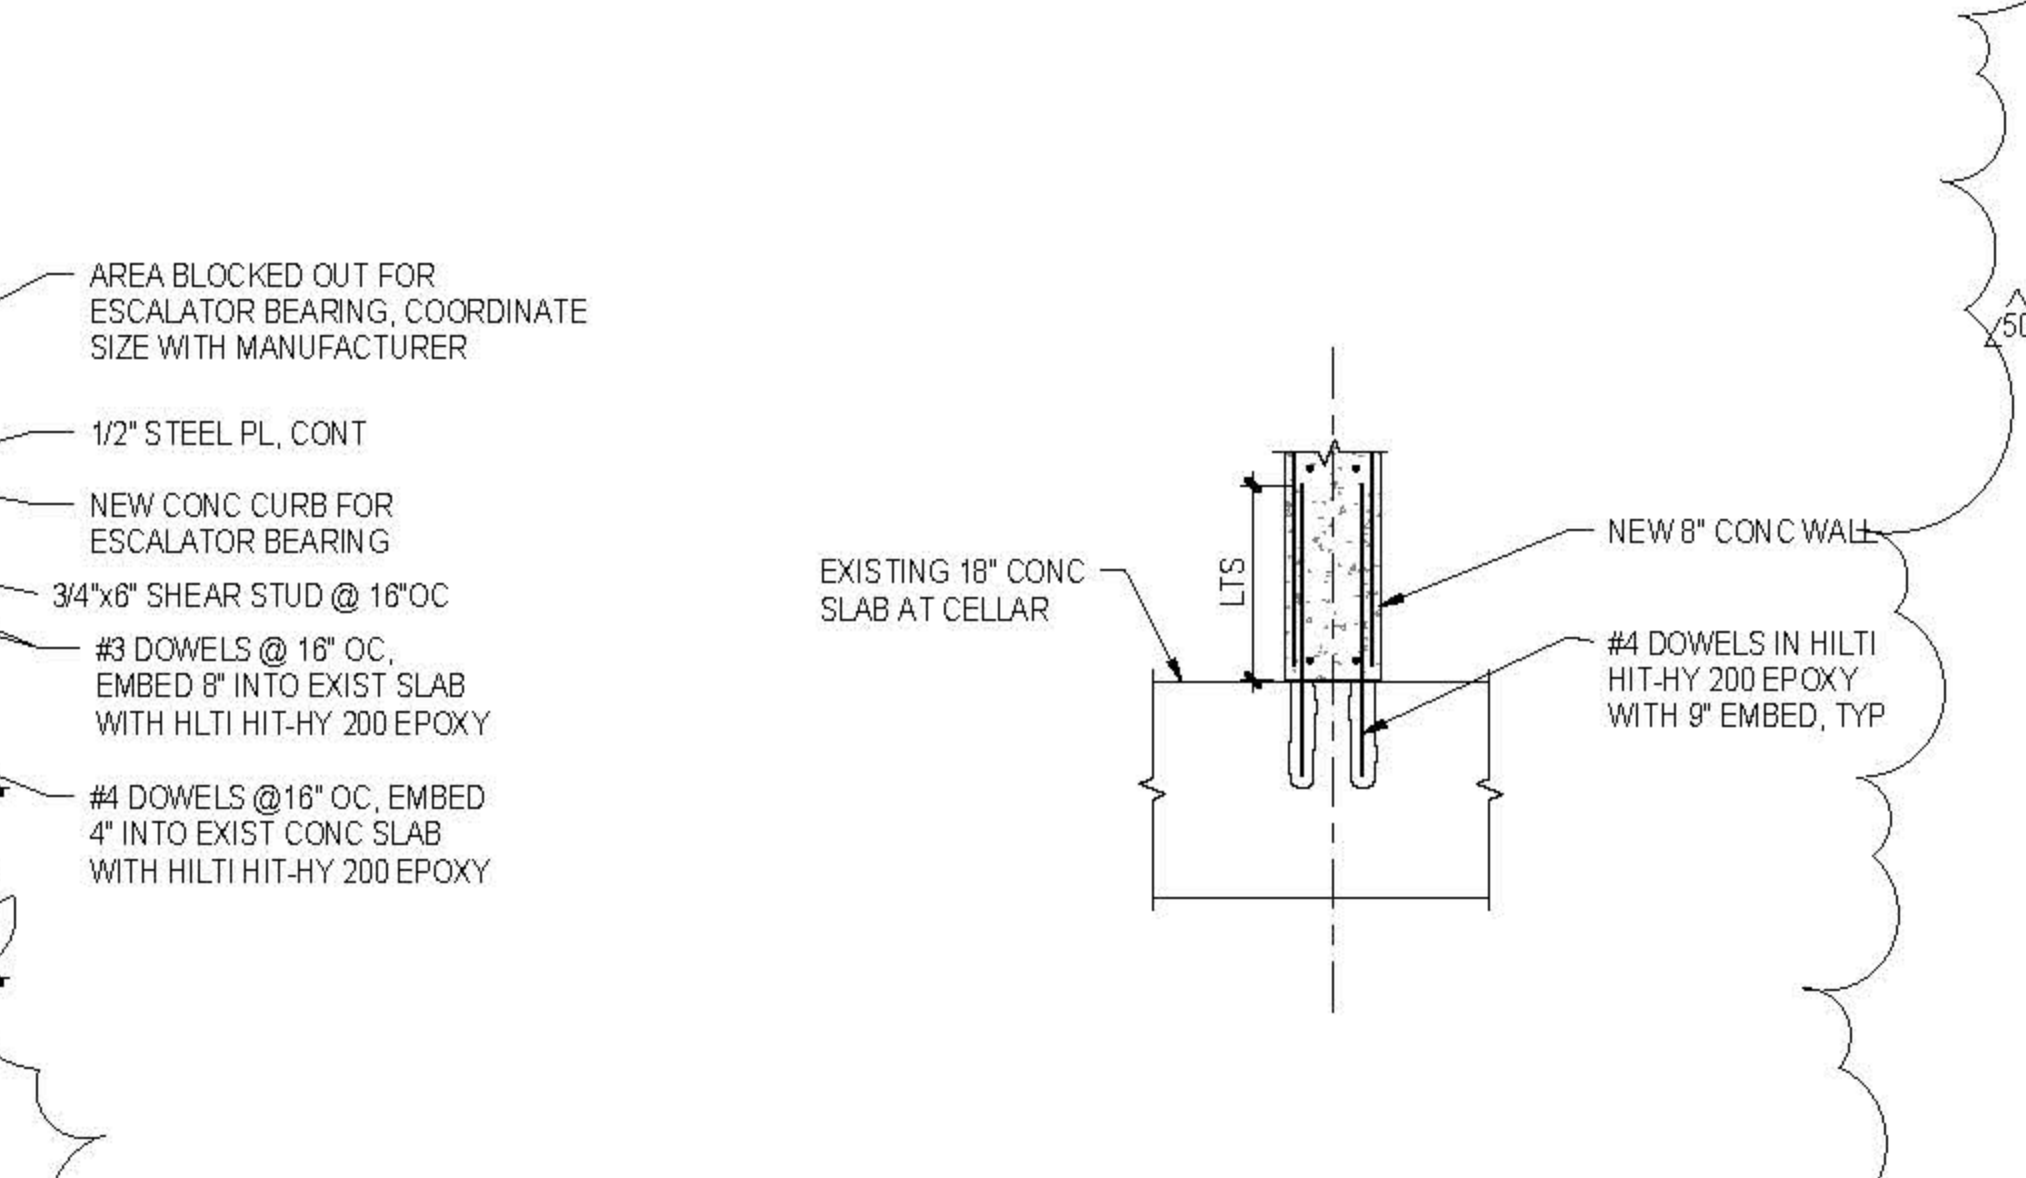

11 SECTION AT ESCALATOR SUPPORT
1" = 1'-0"



12 SECTION AT BASE OF CONC WALL
3/4" = 1'-0"

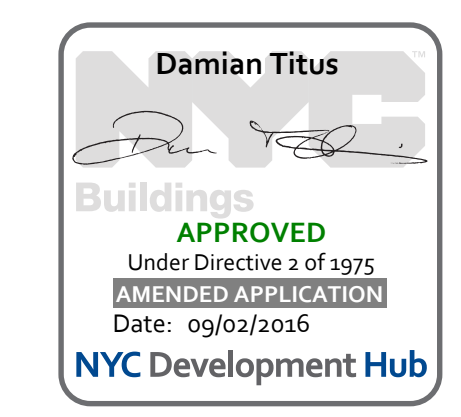

CULTURE SHED

540 West 30th Street
New York, New York 10001

OWNER
CULTURE SHED INC.

ARCHITECTS
Olin Scaife + Renfro Architects, DPC
601 West 25 Street #815
New York, New York 10001
T: 212.463.0334
F: 212.463.0335

rockwellgroup
51 Union St, West, 6th Flr
New York, New York 10003
T: 212.463.0334
F: 212.463.0335

STRUCTURAL ENGINEER
Thornton Tomasetti
51 Madison Avenue
New York, New York 10010
T: 917.861.7800
F: 917.861.7801

MEP ENGINEER
Jana Baum & Bolles
43 Park Street
New York, New York 10005
T: 212.530.9300
F: 212.266.6544

FACADE CONSULTANT
Thornton Tomasetti
51 Madison Avenue
New York, New York 10010
T: 917.861.7800
F: 917.861.7801

KINETICS ENGINEER
Hardy & Hanover
1501 Broadway
New York, New York 10036
T: 212.944.1150
F: 212.391.0329

LIGHTING DESIGNER
Tilston Design Associates
40 North Street #1650
New York, New York 10013
T: 212.675.7760

THEATRE PLANNING & DESIGN
Theatre Design Associates
22 West 15th Street
New York, New York 10011
T: 212.691.3000

LIFE SAFETY
Code Consultants, Inc.
215 West 43rd St, 15th Flr
New York, New York 10018
T: 212.216.9596

ENERGY MODELLED
Vindian
60 Washington Street
Norwalk, CT 06854
T: 203.298.1411

ACOUSTIC/AUDIO-VISUAL
Arenville
93 North Main Street
South Norwalk, CT 06854
T: 347.210.5540

VERTICAL TRANSPORTATION
Van Dusen & Associates
5 Regent Street, Suite 524
Lakewood, NJ 07038
T: 973.994.9200

SPE CERTIFICATIONS
Construction Specifications Inc.
PO Box 489
227 Arden Road
Morganville, NJ 07751
T: 732.970.0700
F: 732.970.0750


SECURITY
Duchella Venter & Santoro
1100 Sherman Avenue
Hartford, CT 06114
T: 203.286.6490

WATERPROOFING
James R. Gaffney AIA Consulting Architects PC
104 West 27th Street
New York, NY 10001
T: 212.736.3344

FACADE MAINTENANCE
Kirk Engineering PLLC
162 Arden Street
New York, NY 10005
T: 212.998.3000

BRANDING GRAPHICS
C&A Global Design Consultancy
180 Varck Street 15th Floor
New York, NY 10014
T: 212.647.1170

KEY PLAN

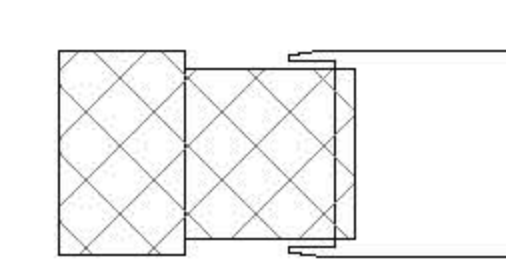

ISSUE PRINTING DATE

NO.	DESCRIPTION	DATE
01	DOB AMENDMENT 7	08.29.2016
02	ADVISORY BULLETIN (M)	09.07.2016
11	ADV. PROCUREMENT ADDENDUM 6	04.10.2015
10	100% CONSTRUCTION DOCUMENTS	03.18.2015
09	PRELIMINARY EOB SUBMISSION	12.30.2014
03	ADV. PROCUREMENT ADDENDUM 1	10.09.2014
01	ADVANCED PROCUREMENT BID SET	06.16.2014

STAMP



DRAWN BY: *Autum* CHECKED BY: *Chris*


PROJECT NUMBER: N11318.00

TITLE: MODIFICATION PART PLANS AND DETAILS, FIXED BUILDING LEVEL 02 - 1


DRAWING NO.: S-504.01

B.SCAN NO.: S-504.01


82 of 123

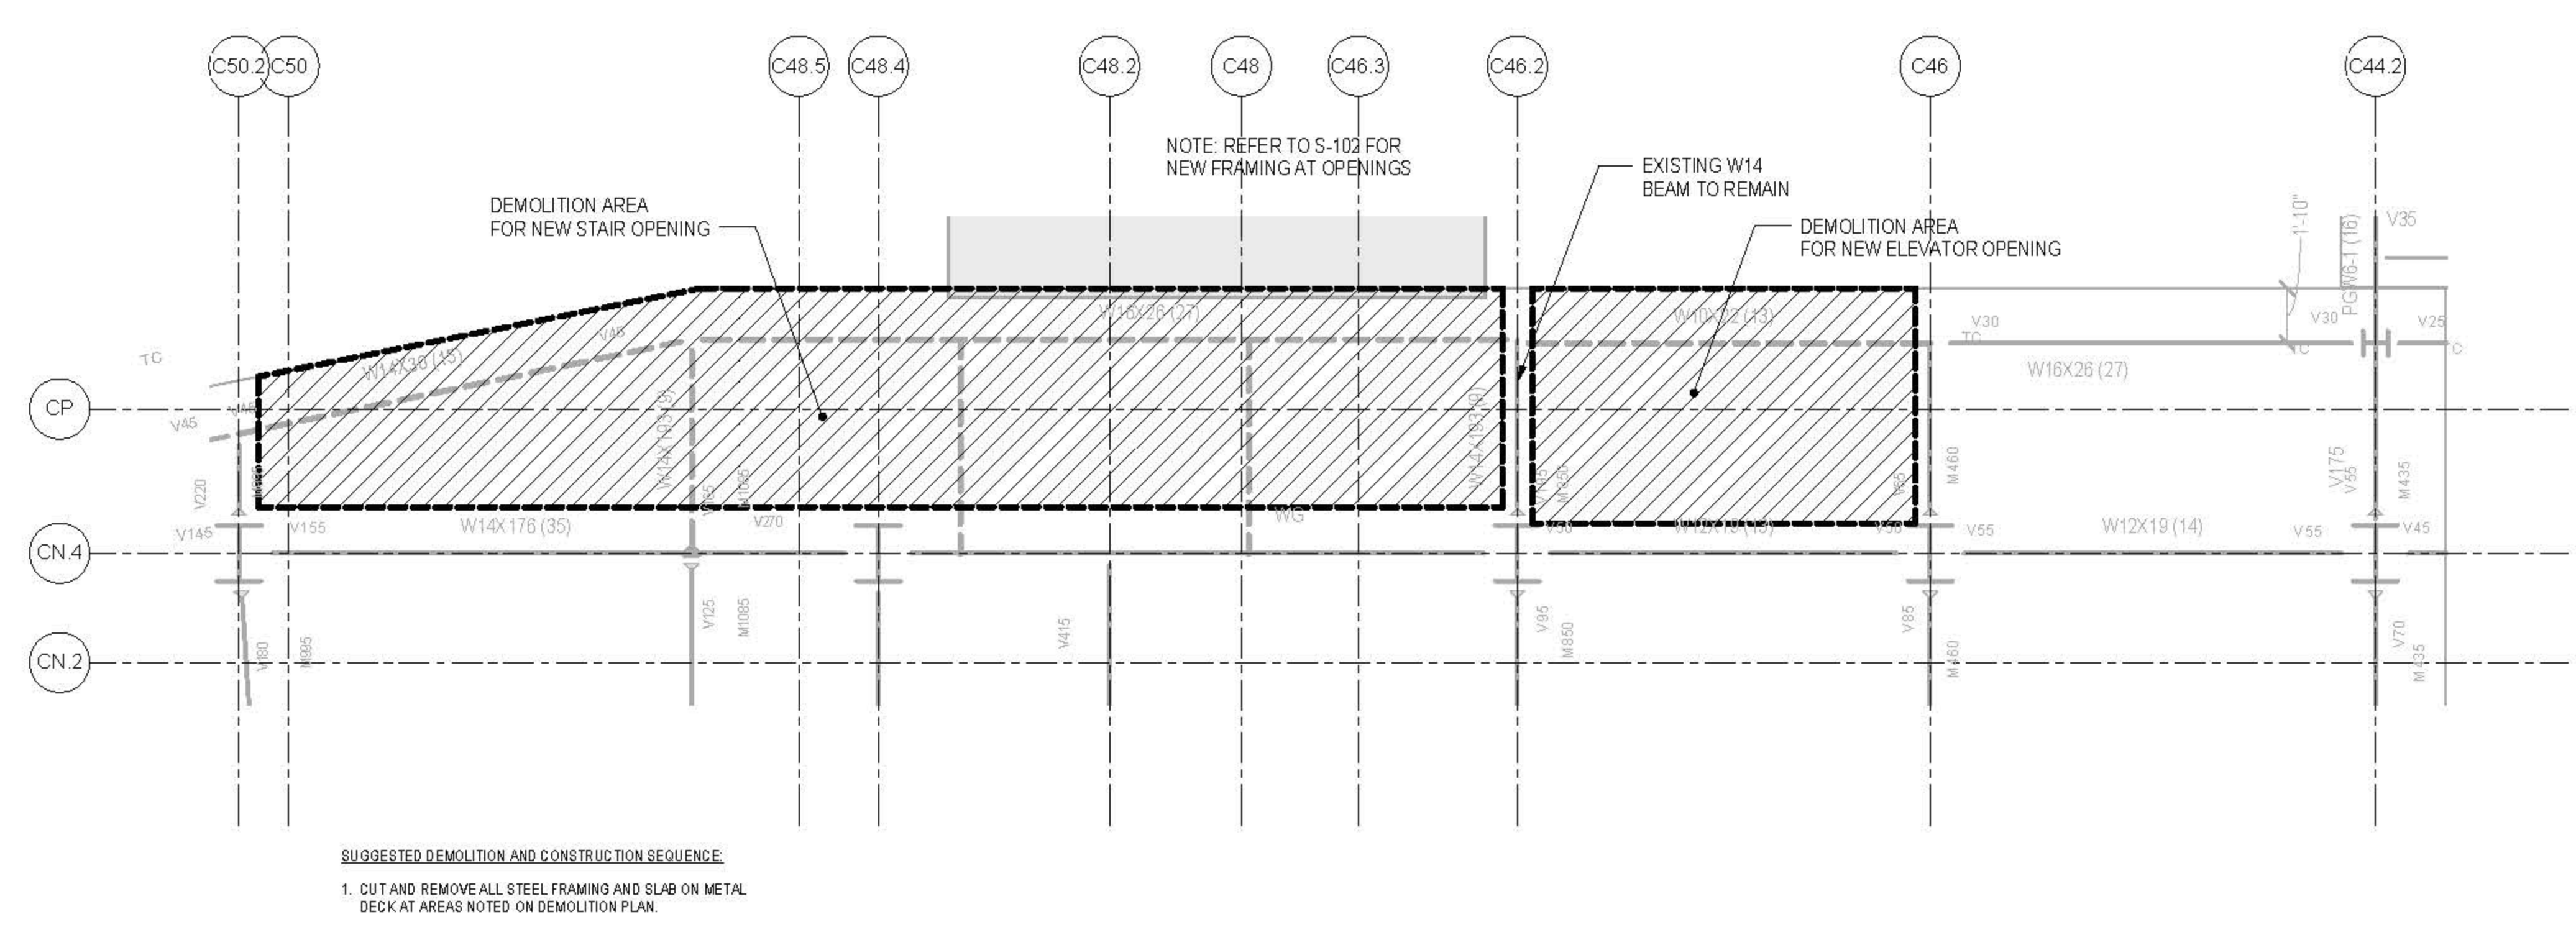


3 DEMOLITION PART PLAN AT L02 STAIR AND ELEVATOR SE-1 OPENINGS
1/4" = 1'-0"

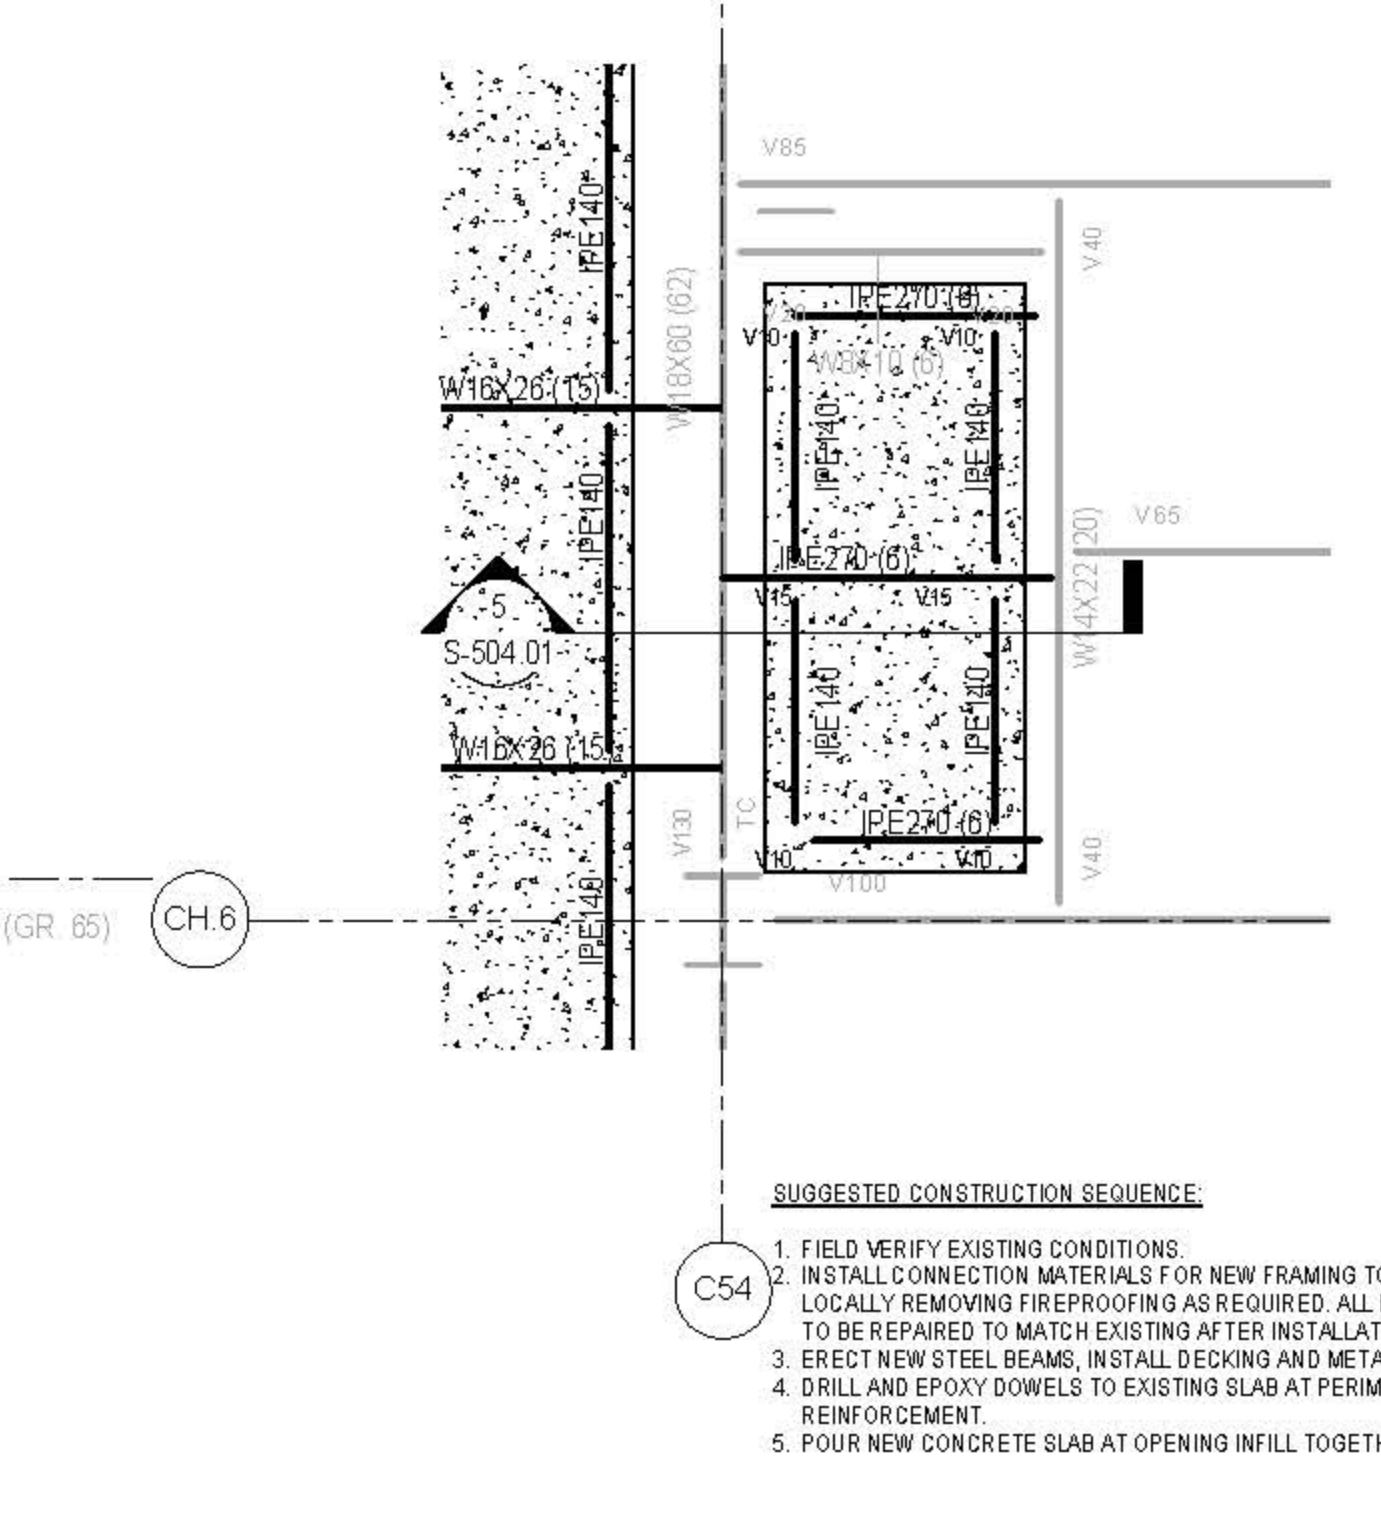


2 PART PLAN SLAB INFILL AT EXISTING L02 OPENING ON C54
1/4" = 1'-0"

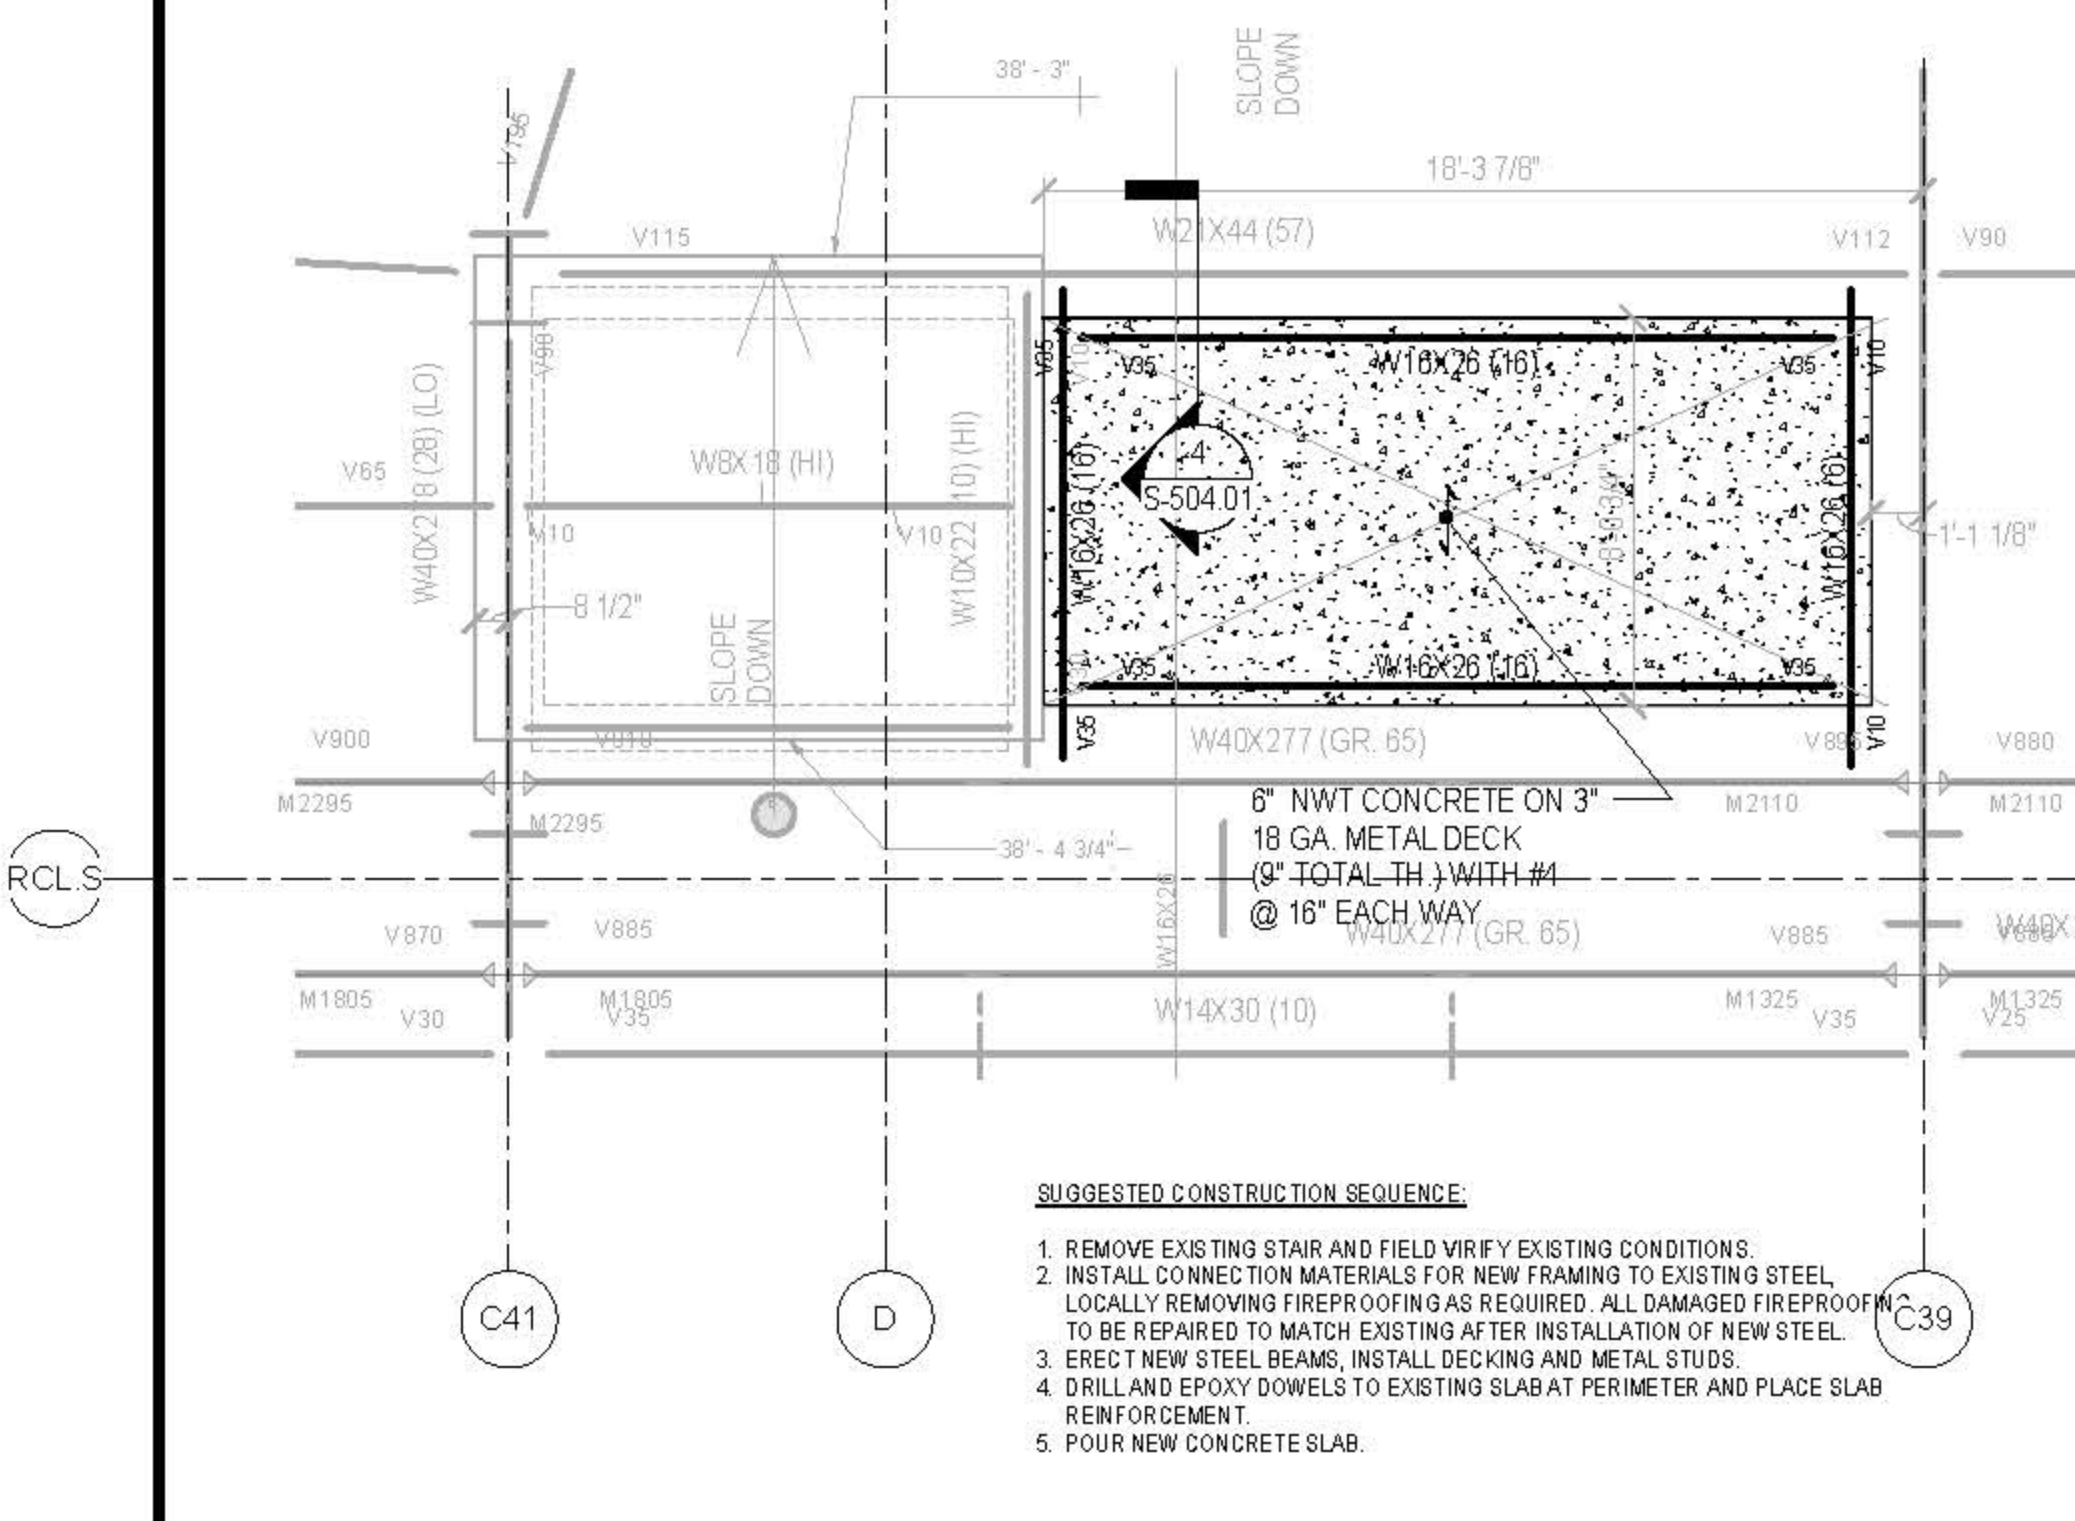


1 PART PLAN OF SLAB INFILL AT EXISTING L02 STAIR
1/4" = 1'-0"

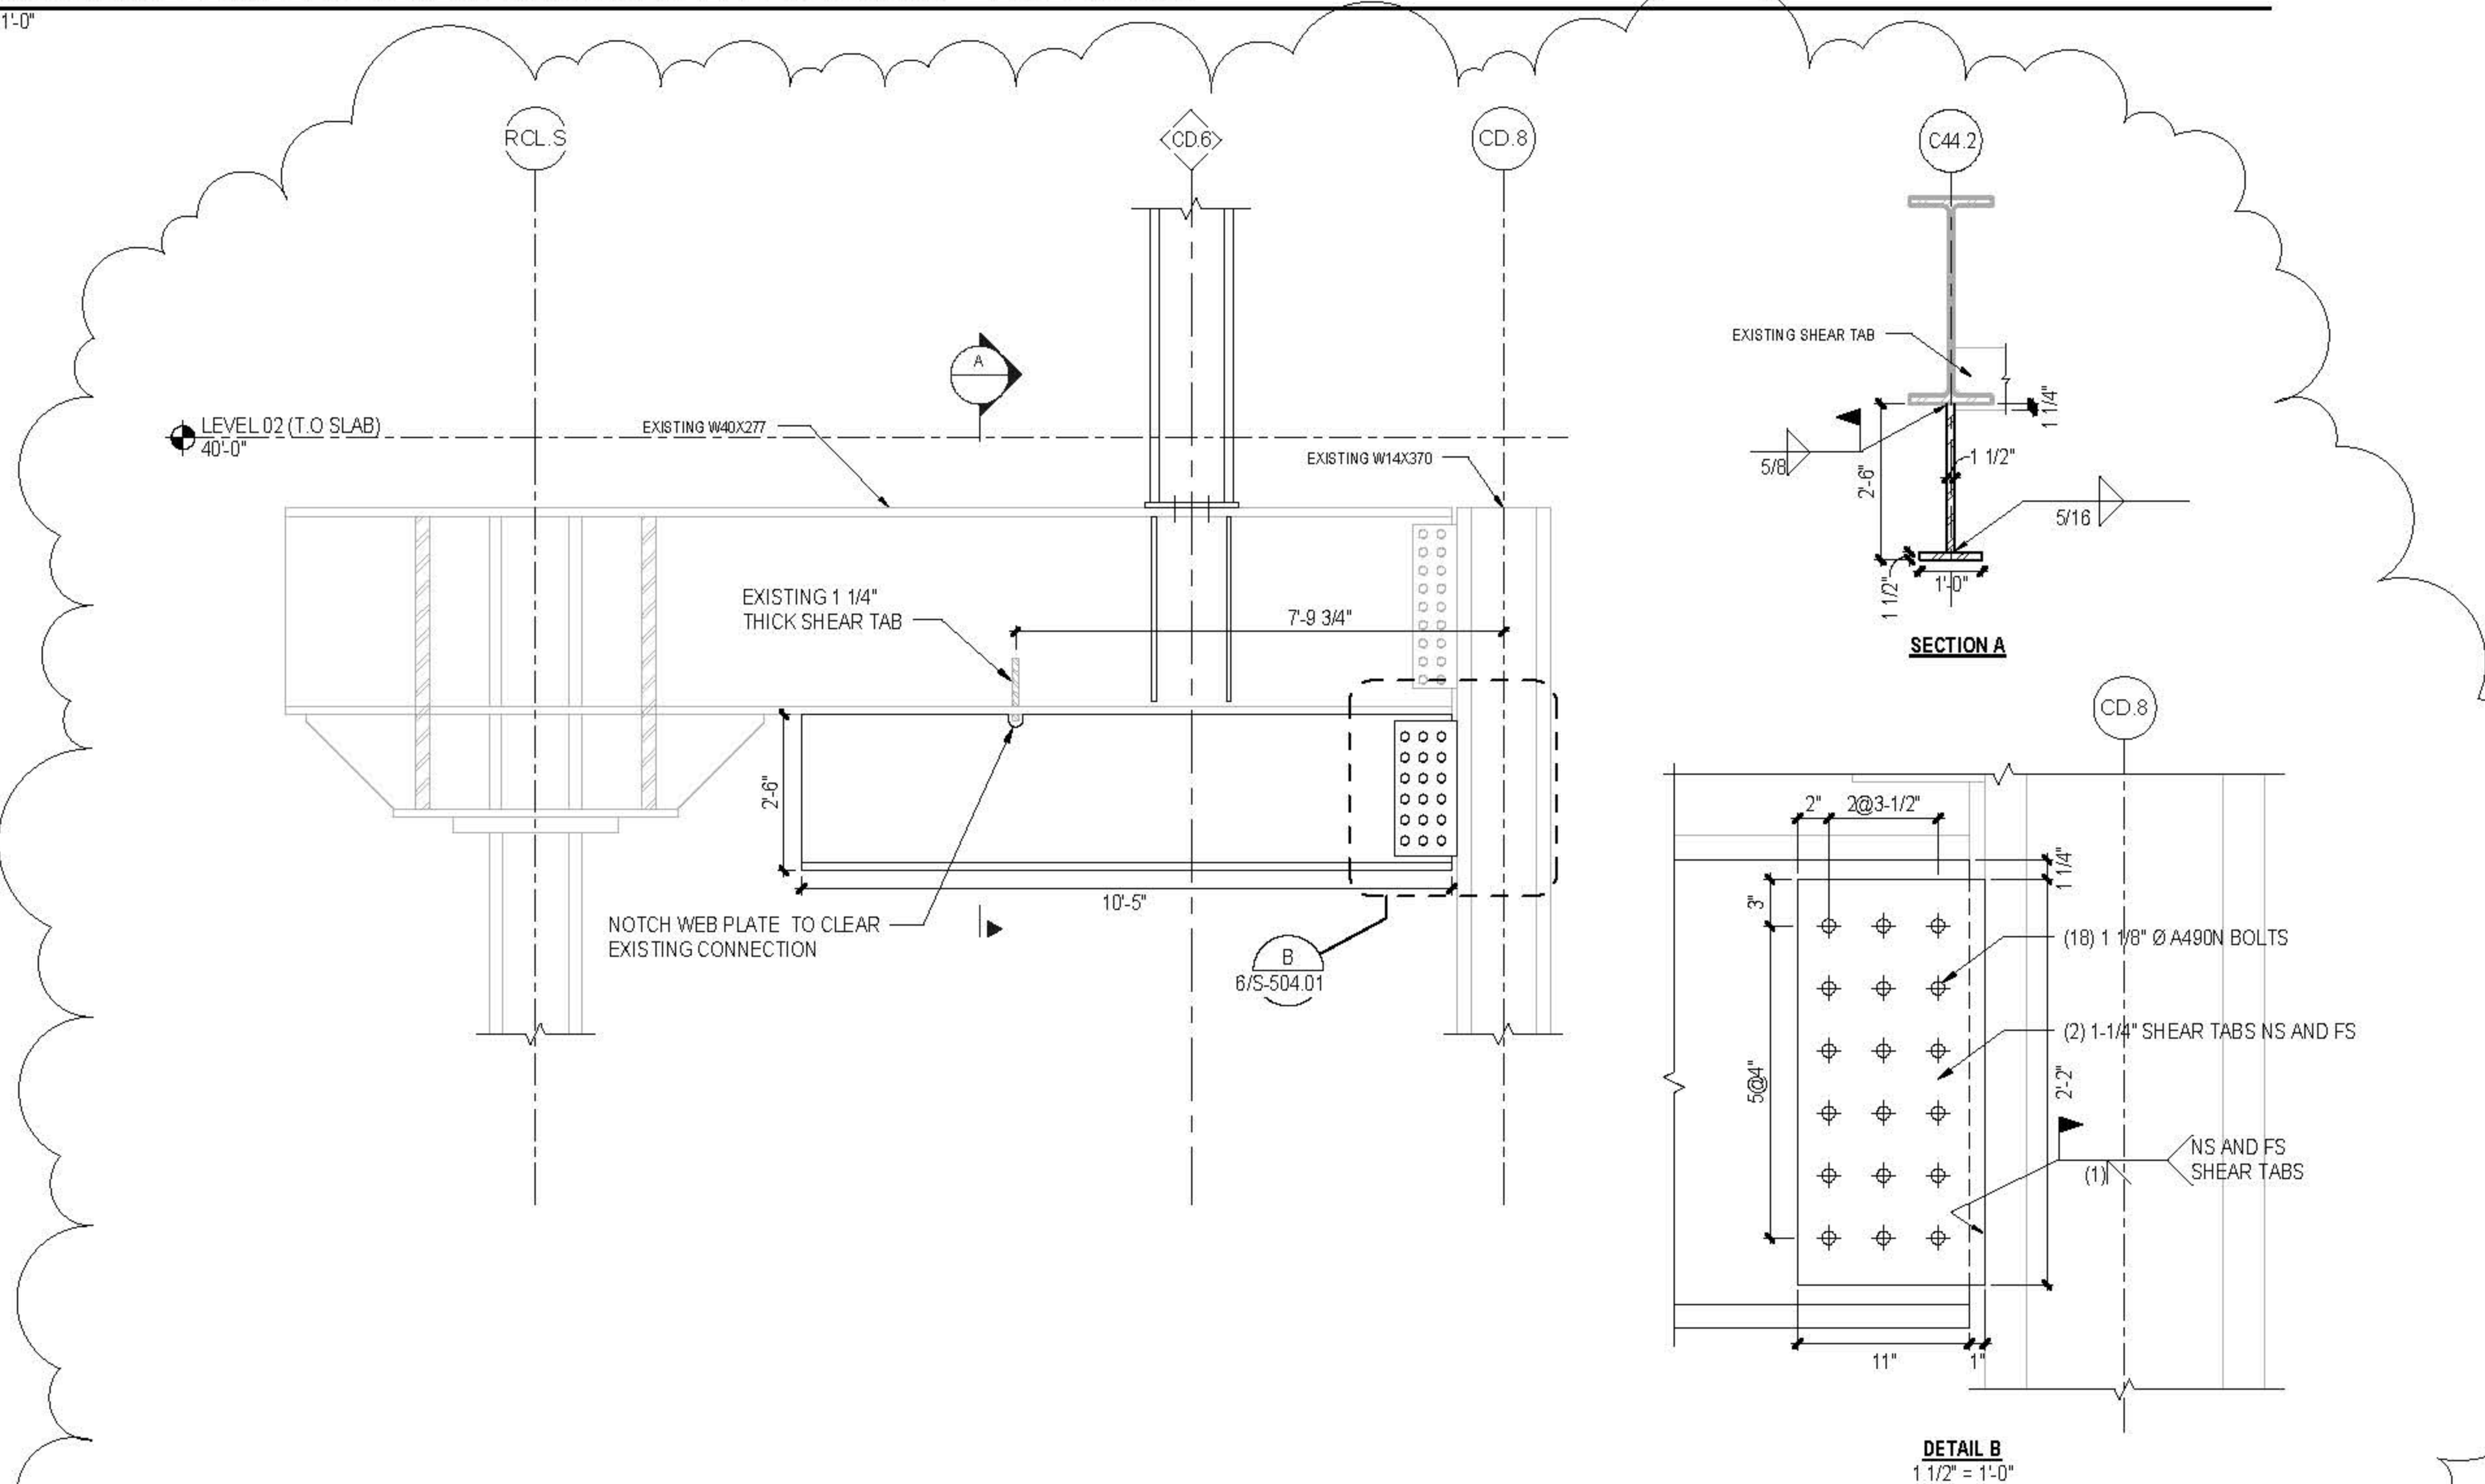


6 C44.2 W40X277 REINFORCEMENT DETAILS
1/2" = 1'-0"

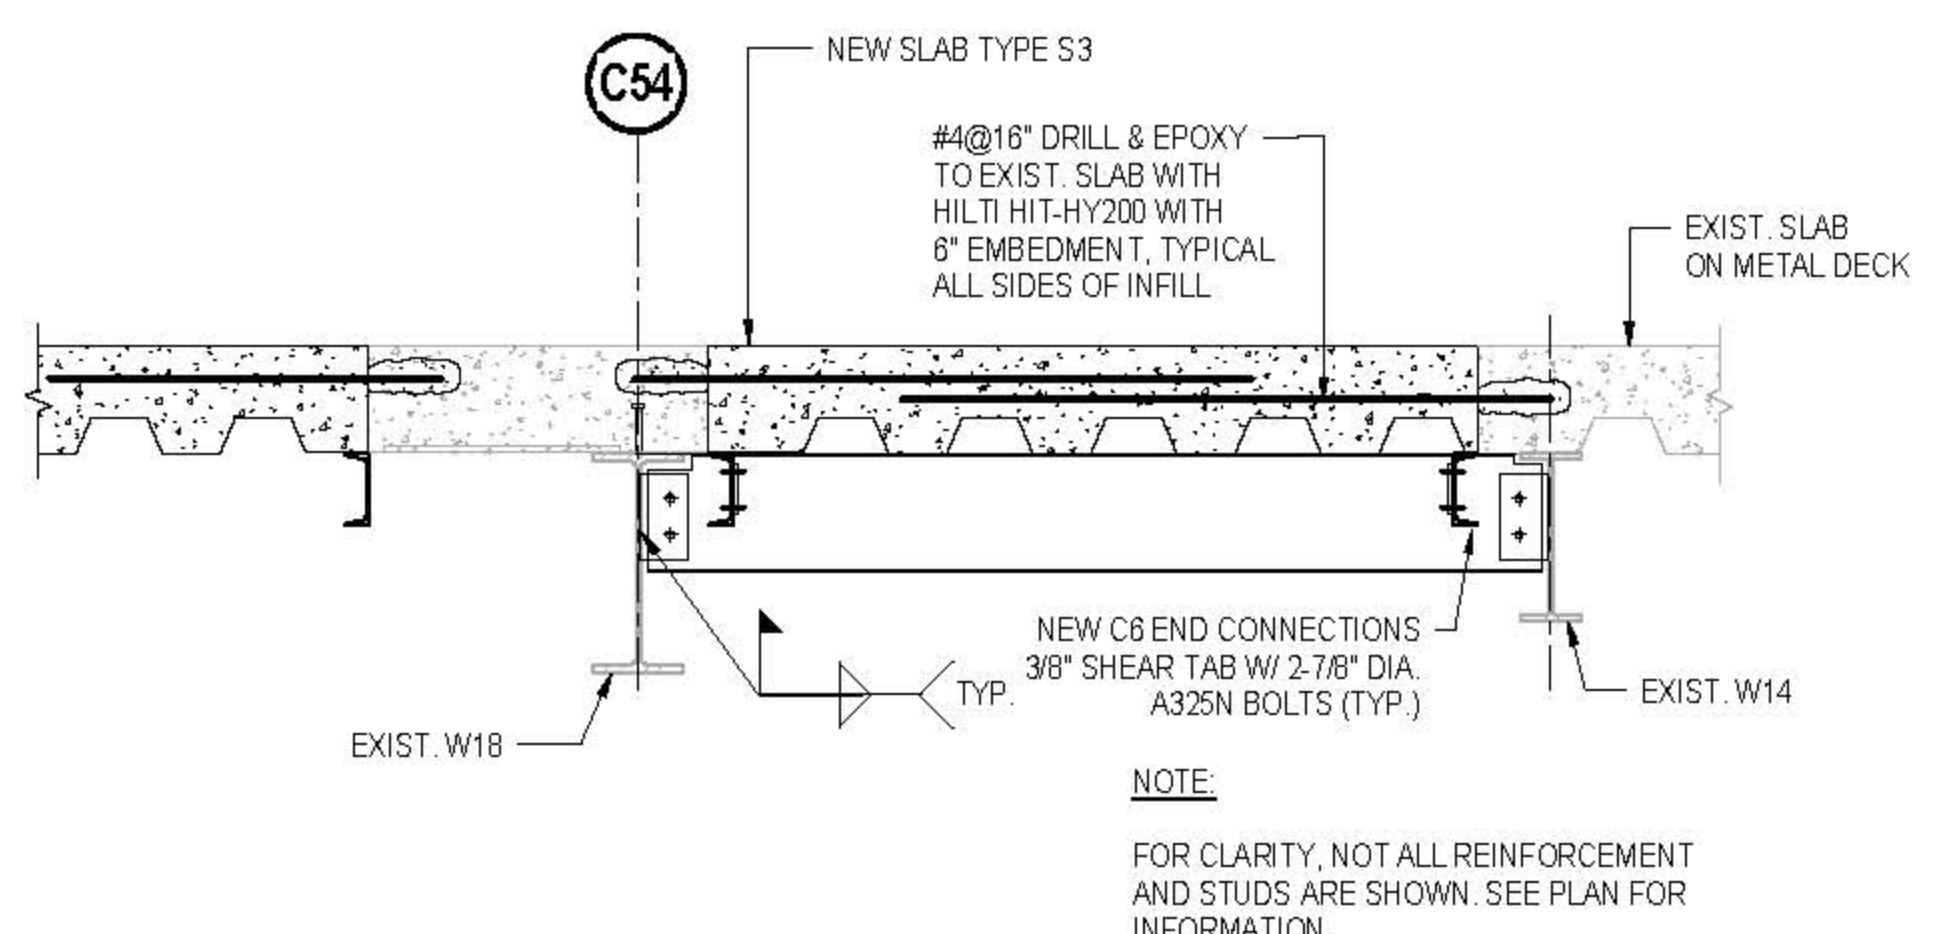


5 SECTION AT L02 OPENING-INFILL ON C54
3/4" = 1'-0"

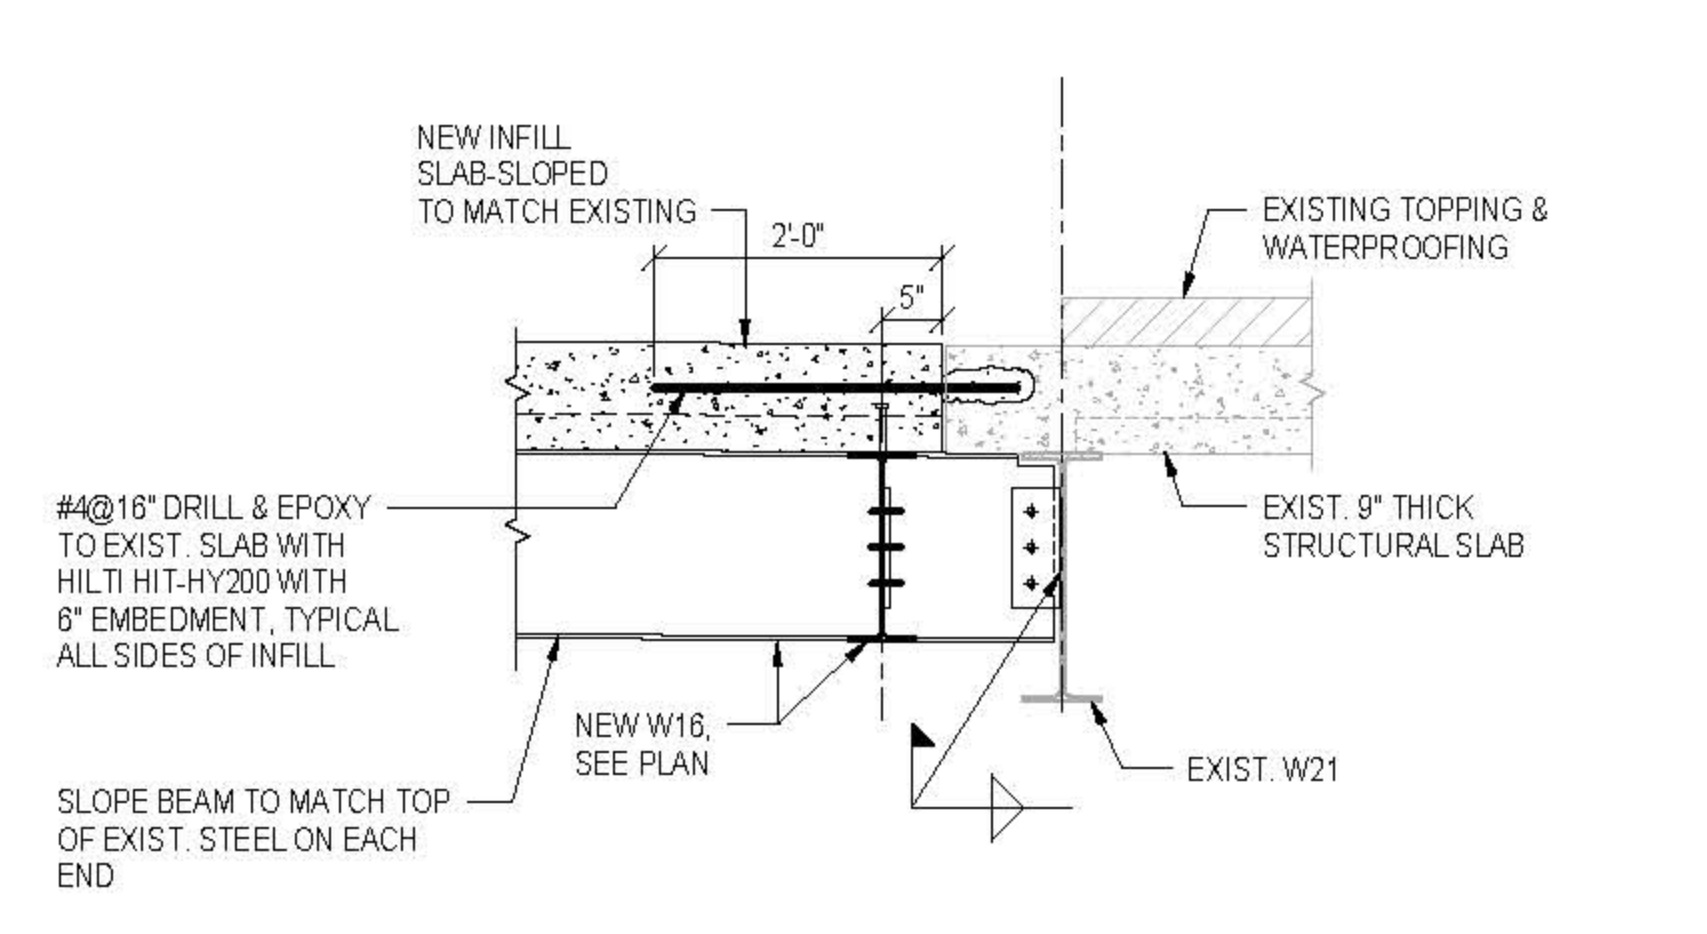


4 SECTION AT INFILL AT L02 STAIR
3/4" = 1'-0"

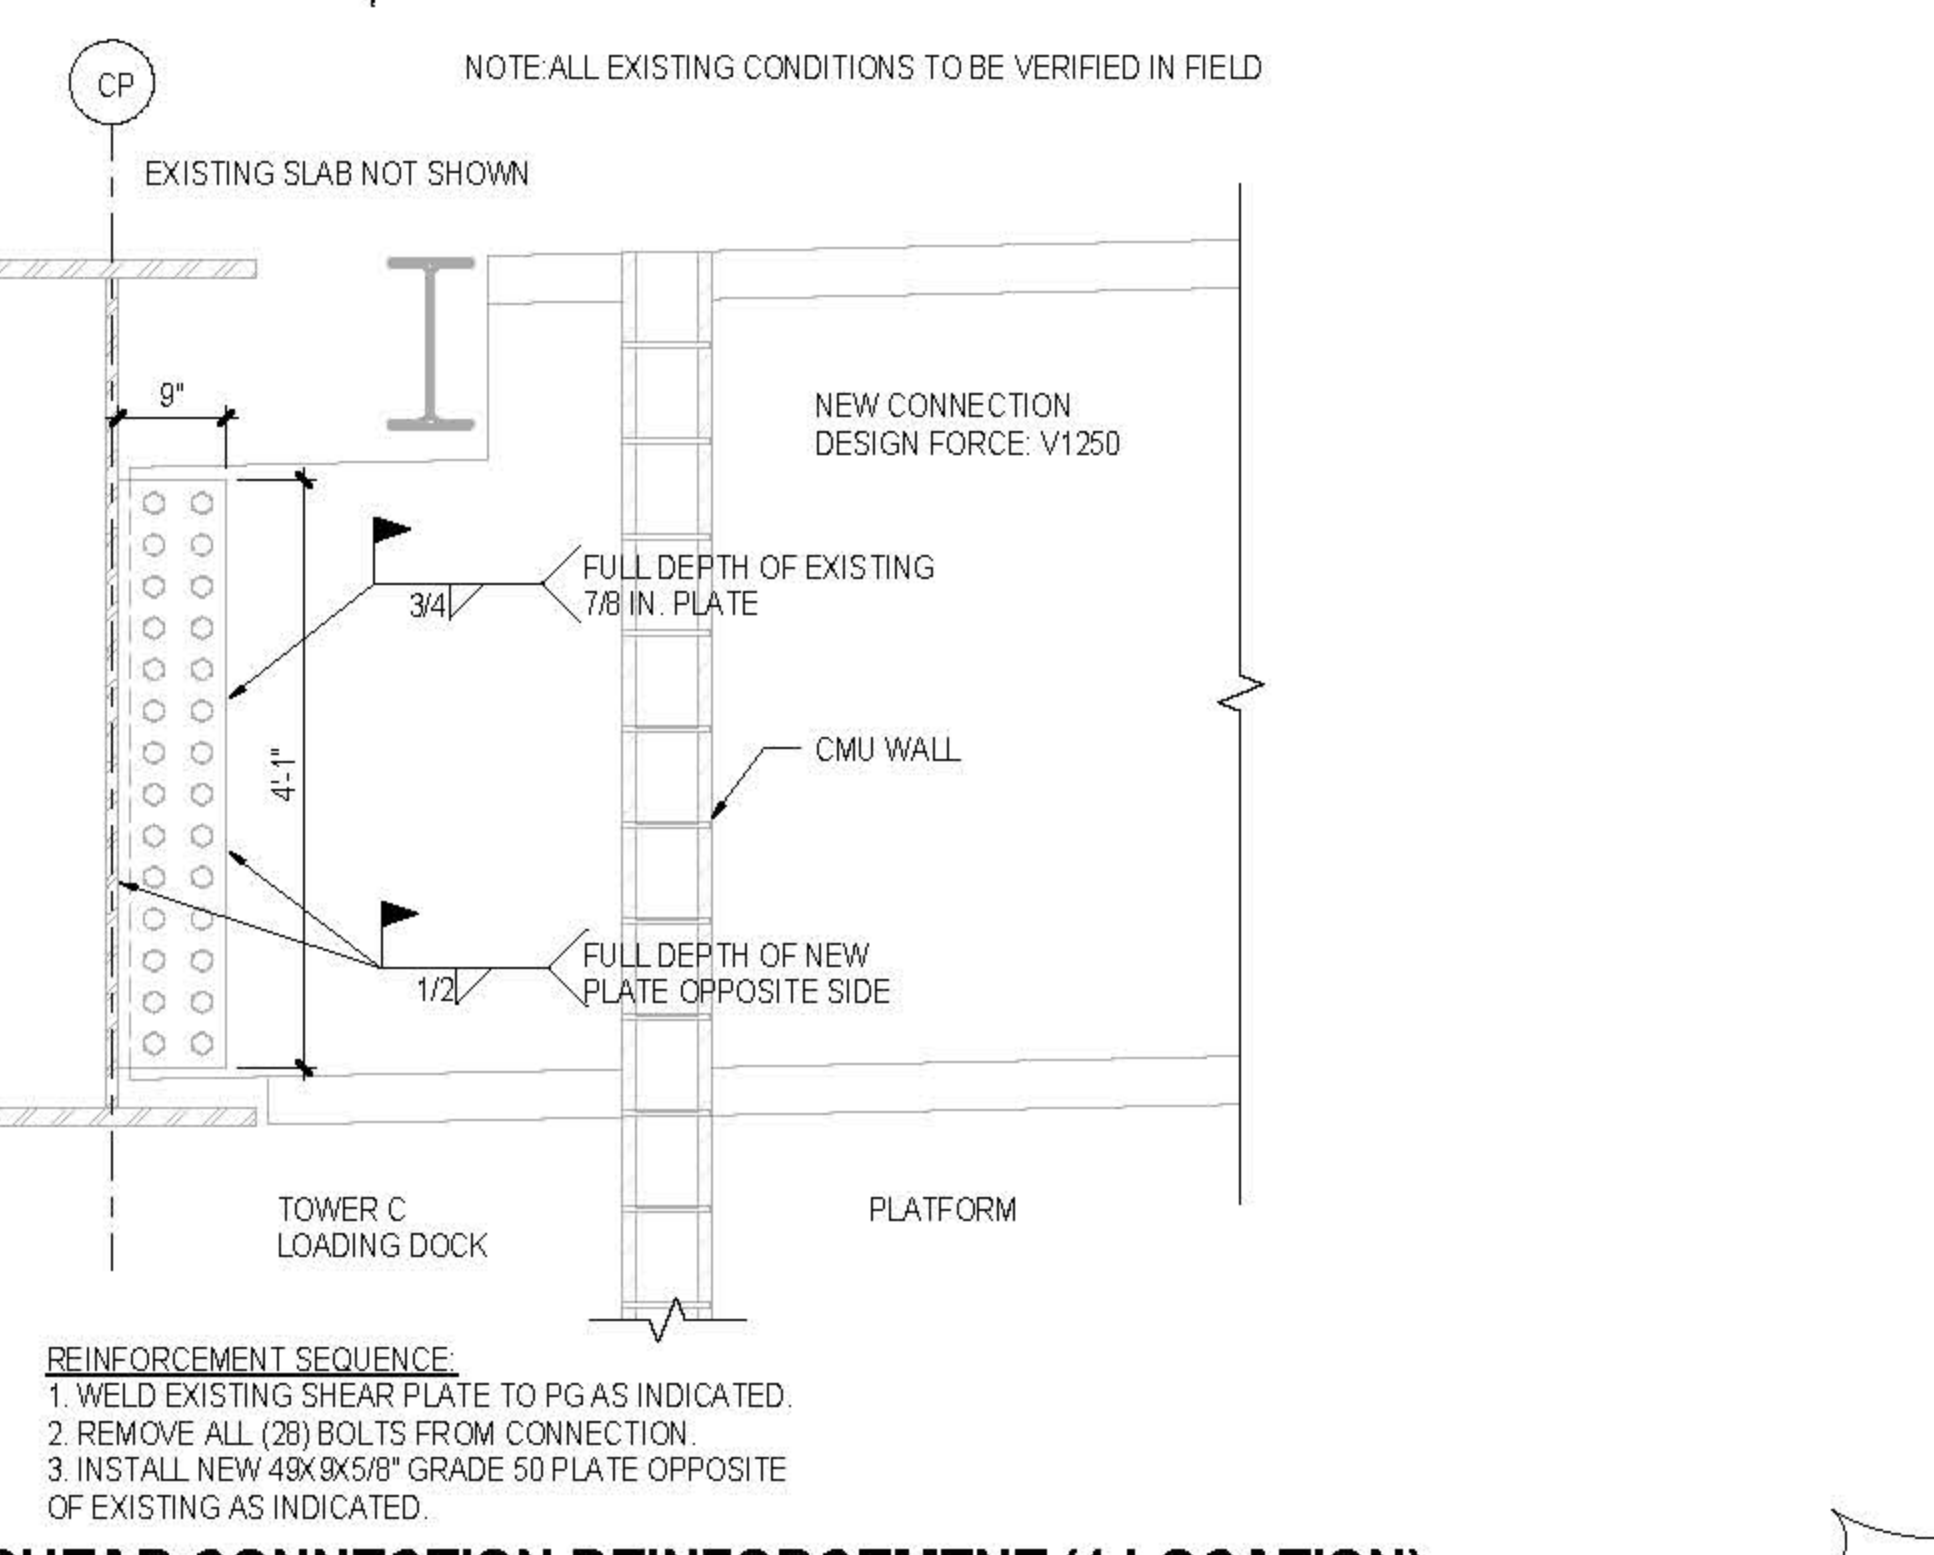

8 SHEAR CONNECTION REINFORCEMENT (1 LOCATION)
3/4" = 1'-0"

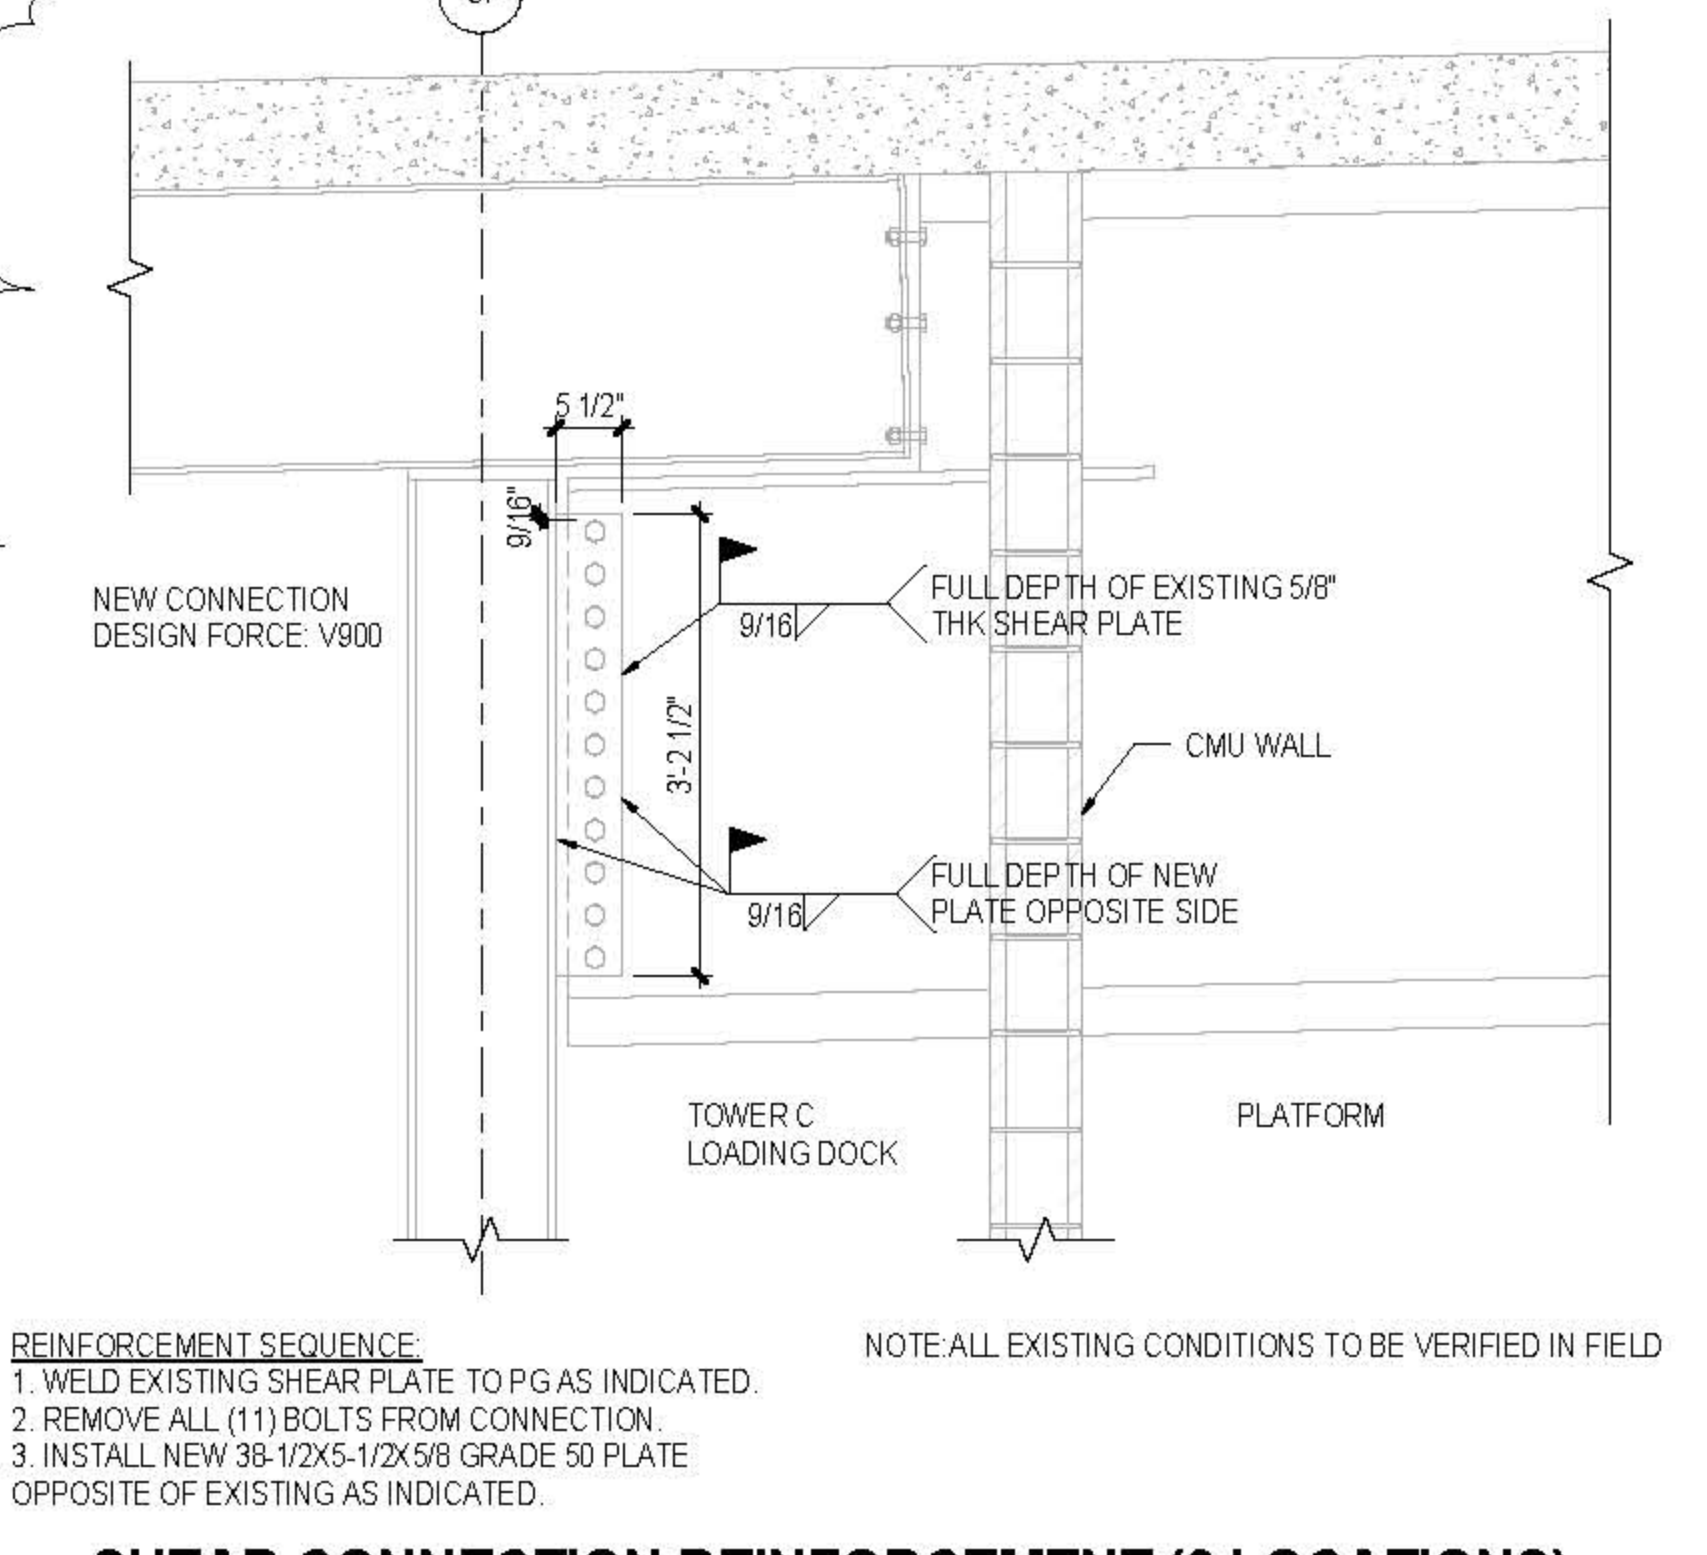

7 SHEAR CONNECTION REINFORCEMENT (3 LOCATIONS)
3/4" = 1'-0"

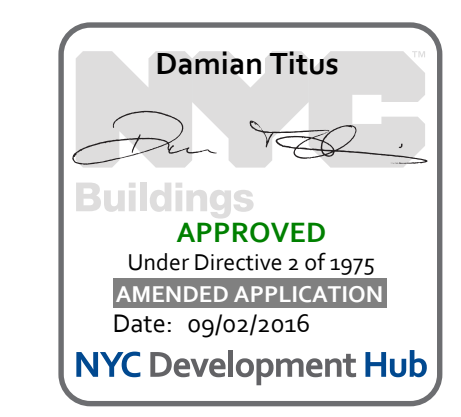

CULTURE SHED

540 West 30th Street
New York, New York 10001

OWNER
CULTURE SHED INC.

ARCHITECTS
Oller Scaffolds + Renfro Architects, DPC
601 West 30th Street #815
New York, New York 10001
T: 212.463.0334
F: 212.463.0335

STRUCTURAL ENGINEER
Thornton Tomasetti
51 Madison Avenue
New York, New York 10010
T: 917.861.7800
F: 917.861.7801

MEP ENGINEER
Jana Baum & Bolles
60 Pine Street
New York, New York 10005
T: 212.530.9300
F: 212.265.6564

FACADE CONSULTANT
Thornton Tomasetti
51 Madison Avenue
New York, New York 10010
T: 917.861.7800
F: 917.861.7801

KINETICS ENGINEER
Hardisty & Hanover
1501 Broadway
New York, New York 10036
T: 212.944.1150
F: 212.391.0397

LIGHTING DESIGNER
Tilston Design Associates
40 North Street #160
New York, New York 10013
T: 212.675.7760

THEATRE PLANNING & DESIGN
Fisher Dachs Associates
22 West 15th Street
New York, New York 10011
T: 212.691.3000

LIFE SAFETY
Code Consultants, Inc.
215 West 43rd St, 15th Fl.
New York, New York 10018
T: 212.216.9596

ENERGY MODEL ALEED
Vindian
60 Washington Street
Norwalk, CT 06854
T: 203.298.1411

ACOUSTIC/AUDIO-VISUAL
Avalon
93 North Main Street
South Norwalk, CT 06854
T: 347.210.5540

VERTICAL TRANSPORTATION
Van Dusen & Associates
5 Regent Street, Suite 524
Livingston, NJ 07039
T: 973.994.9220

SPECIFICATIONS
Construction Specifications Inc.
PO Box 489
227 Fenwick Road
Morganville, NJ 07751
T: 732.970.0700
F: 732.970.0700


SECURITY
Duchella Venter & Santoro
1100 Sherman Avenue
Hartford, CT 06114
T: 203.286.6490

WATERPROOFING
James R. Galford AIA Consulting Architects PC
104 West 27th Street
New York, NY 10001
T: 212.736.3344

FACADE MAINTENANCE
Erick Engineering PLLC
106 Ave. Street
New York, NY 10005
T: 212.986.3000

BRANDING GRAPHICS
21st Global Design Consultancy
180 Varck Street 15th Floor
New York, NY 10014
T: 212.647.1170

KEY PLAN

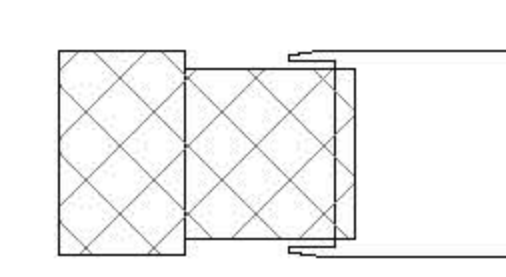

ISSUE PRINTING DATE

NO.	DESCRIPTION	DATE
01	50 - 0105 AMENDMENT 7	08.19.2016
02	ASME (BULLETIN 4)	09.17.2016
11	5 - ADV. PROCEDURE ADDENDUM 5	04.10.2015

STAMP



DRAWN BY: Damian Titus
CHECKED BY: [Signature]


PROJECT NUMBER: N11318.00

TITLE: MODIFICATION PART PLANS AND DETAILS, FIXED BUILDING LEVEL 02 - II


DRAWING NO.: S-505.00

B.SCAN NO.: S-505.00


83 of 123

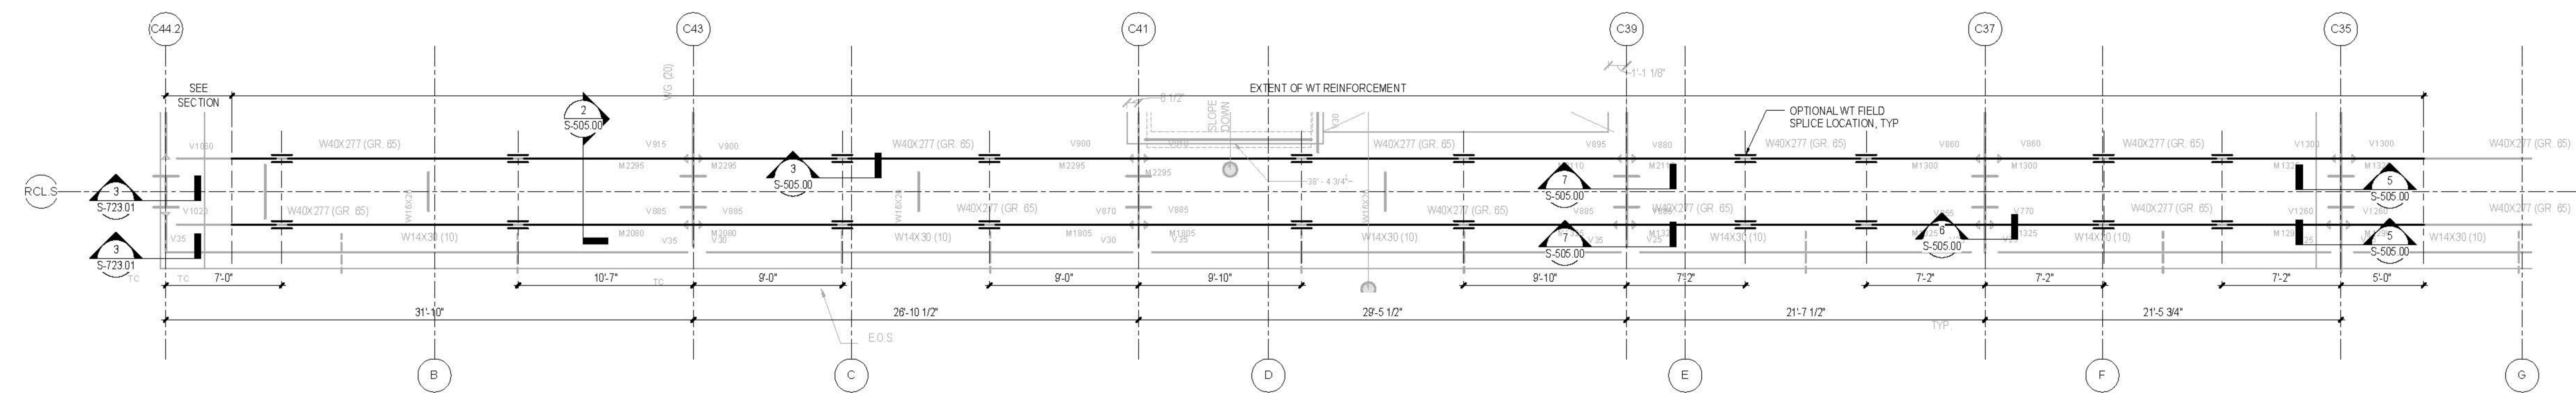


1 PART PLAN WT REINFORCEMENT OF W40X277 RAIL BEAMS
3/4" = 1'-0"

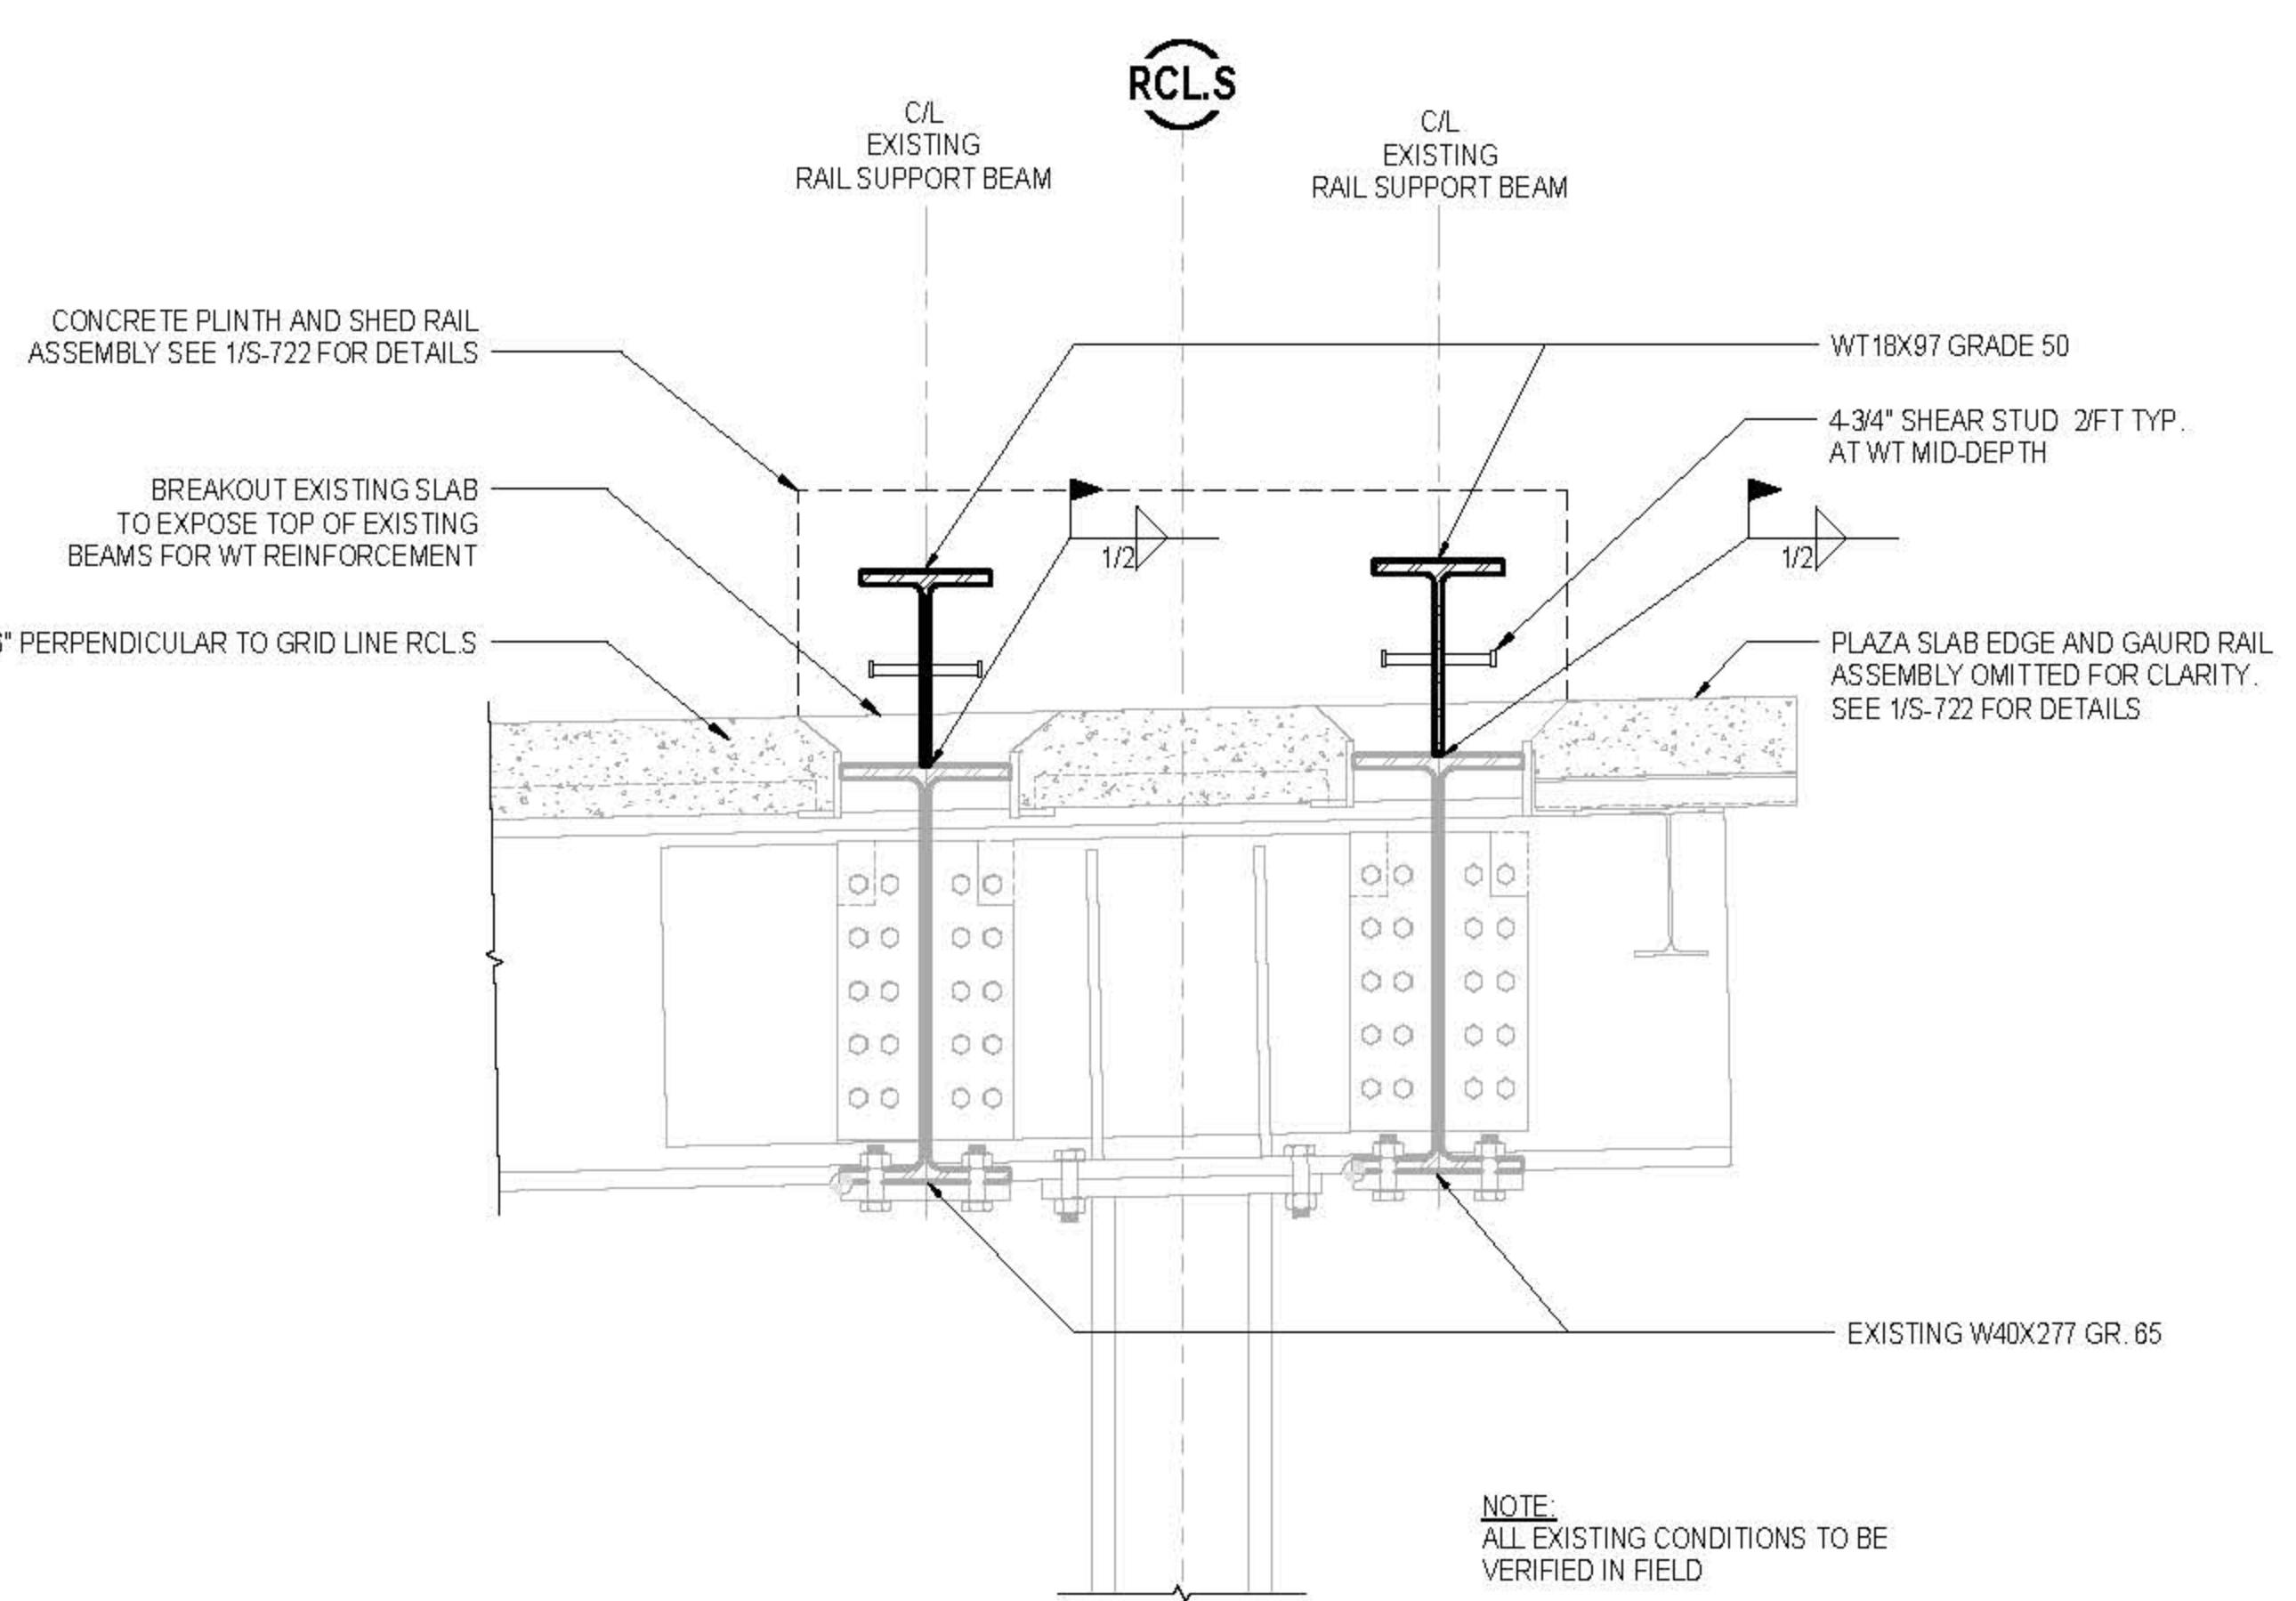


2 TYPICAL SECTION OF SOUTH RAILS AT PLAZA
3/4" = 1'-0"

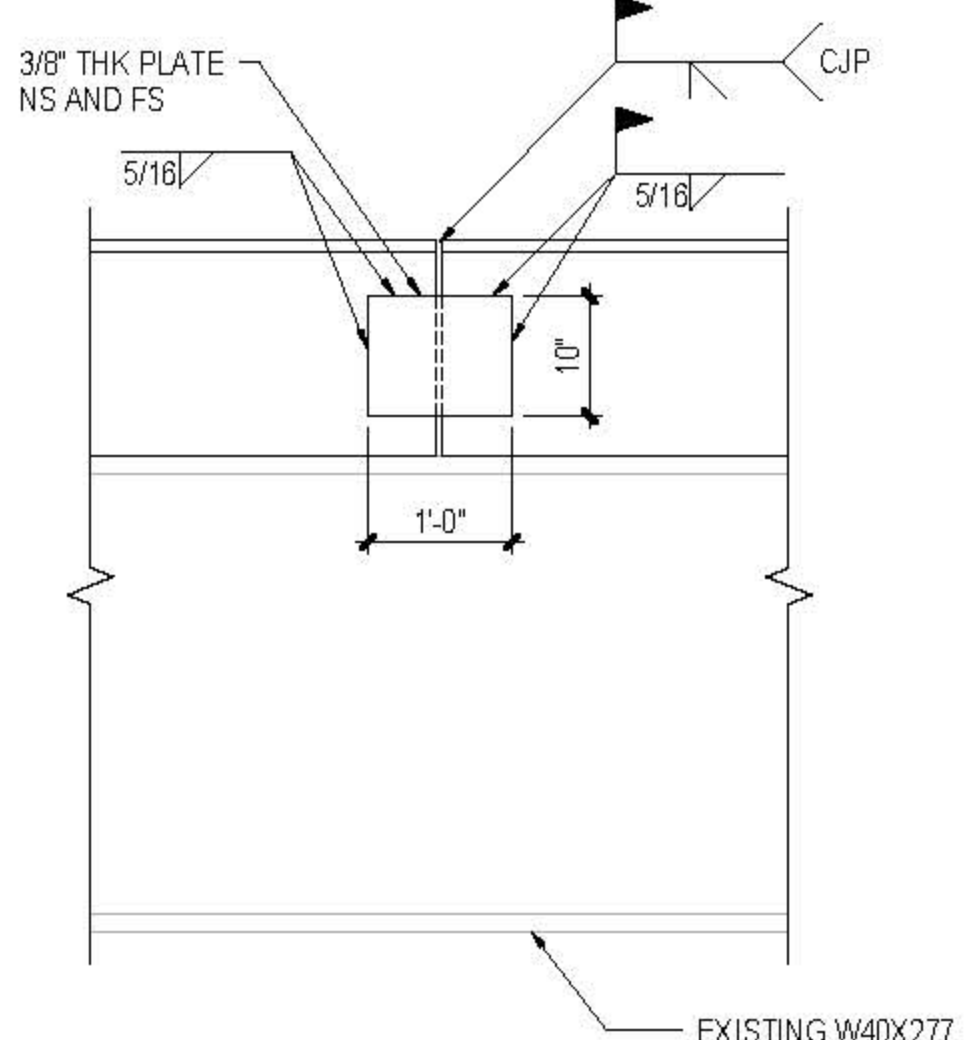


3 WT TYPICAL SPLICE DETAIL
3/4" = 1'-0"

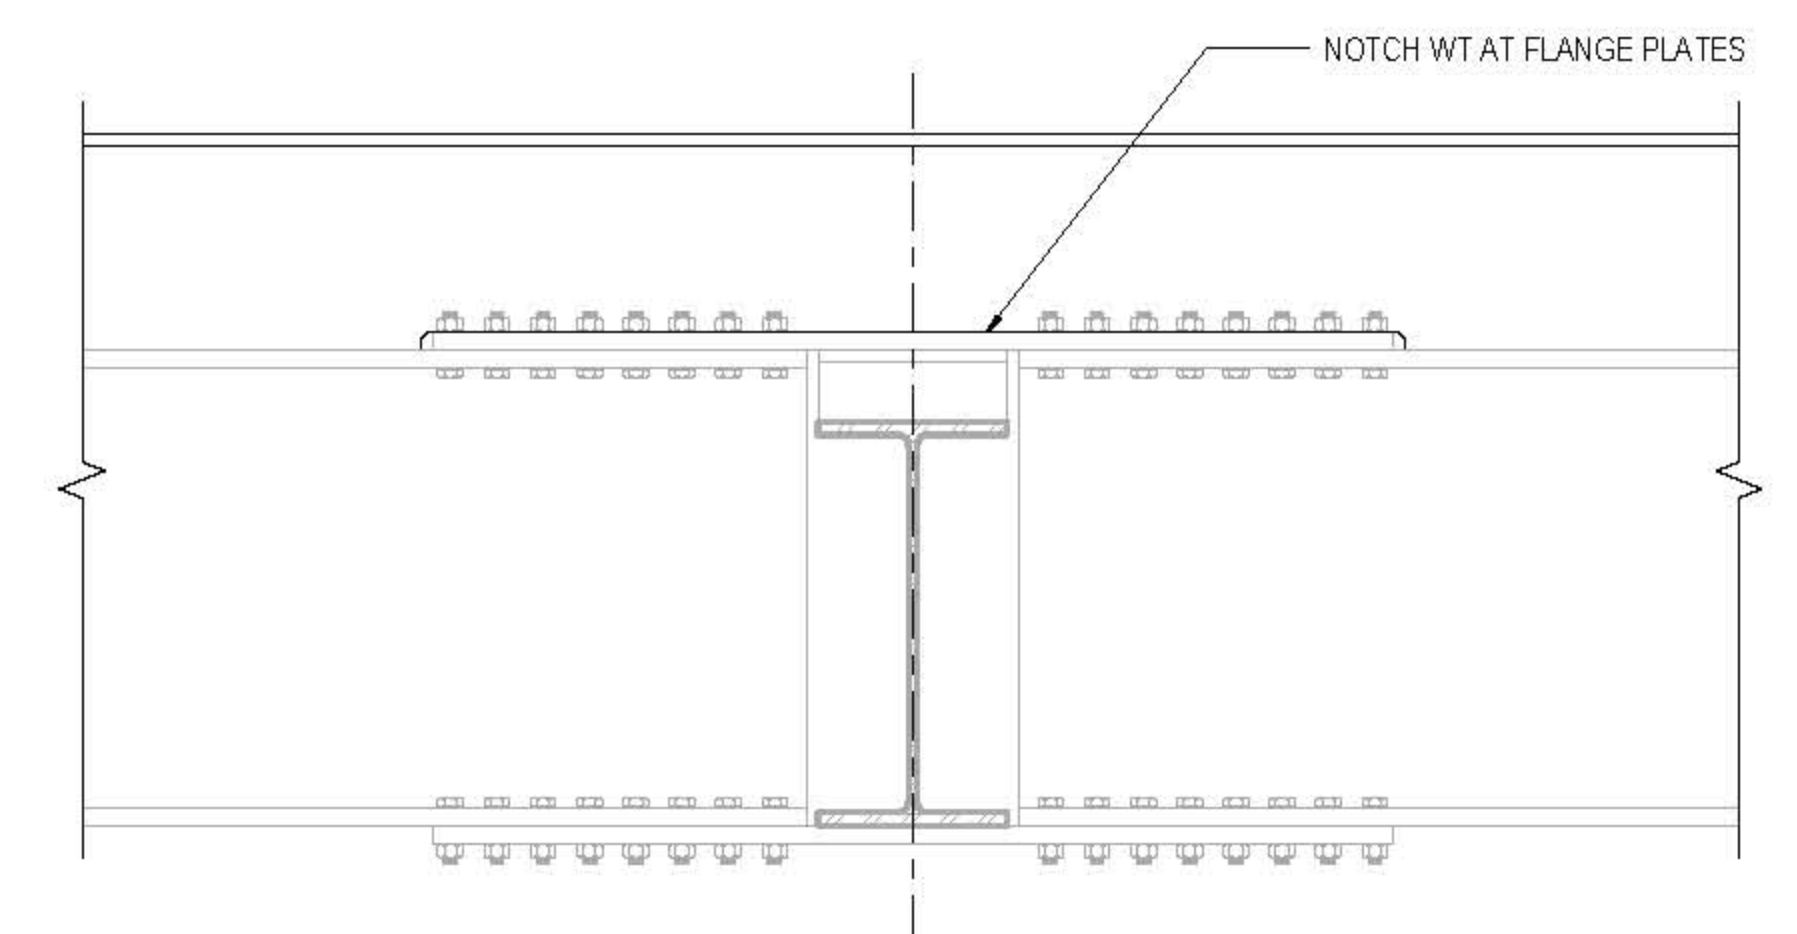


4 WT TYPICAL DETAIL AT MOMENT CONNECTIONS
3/4" = 1'-0"

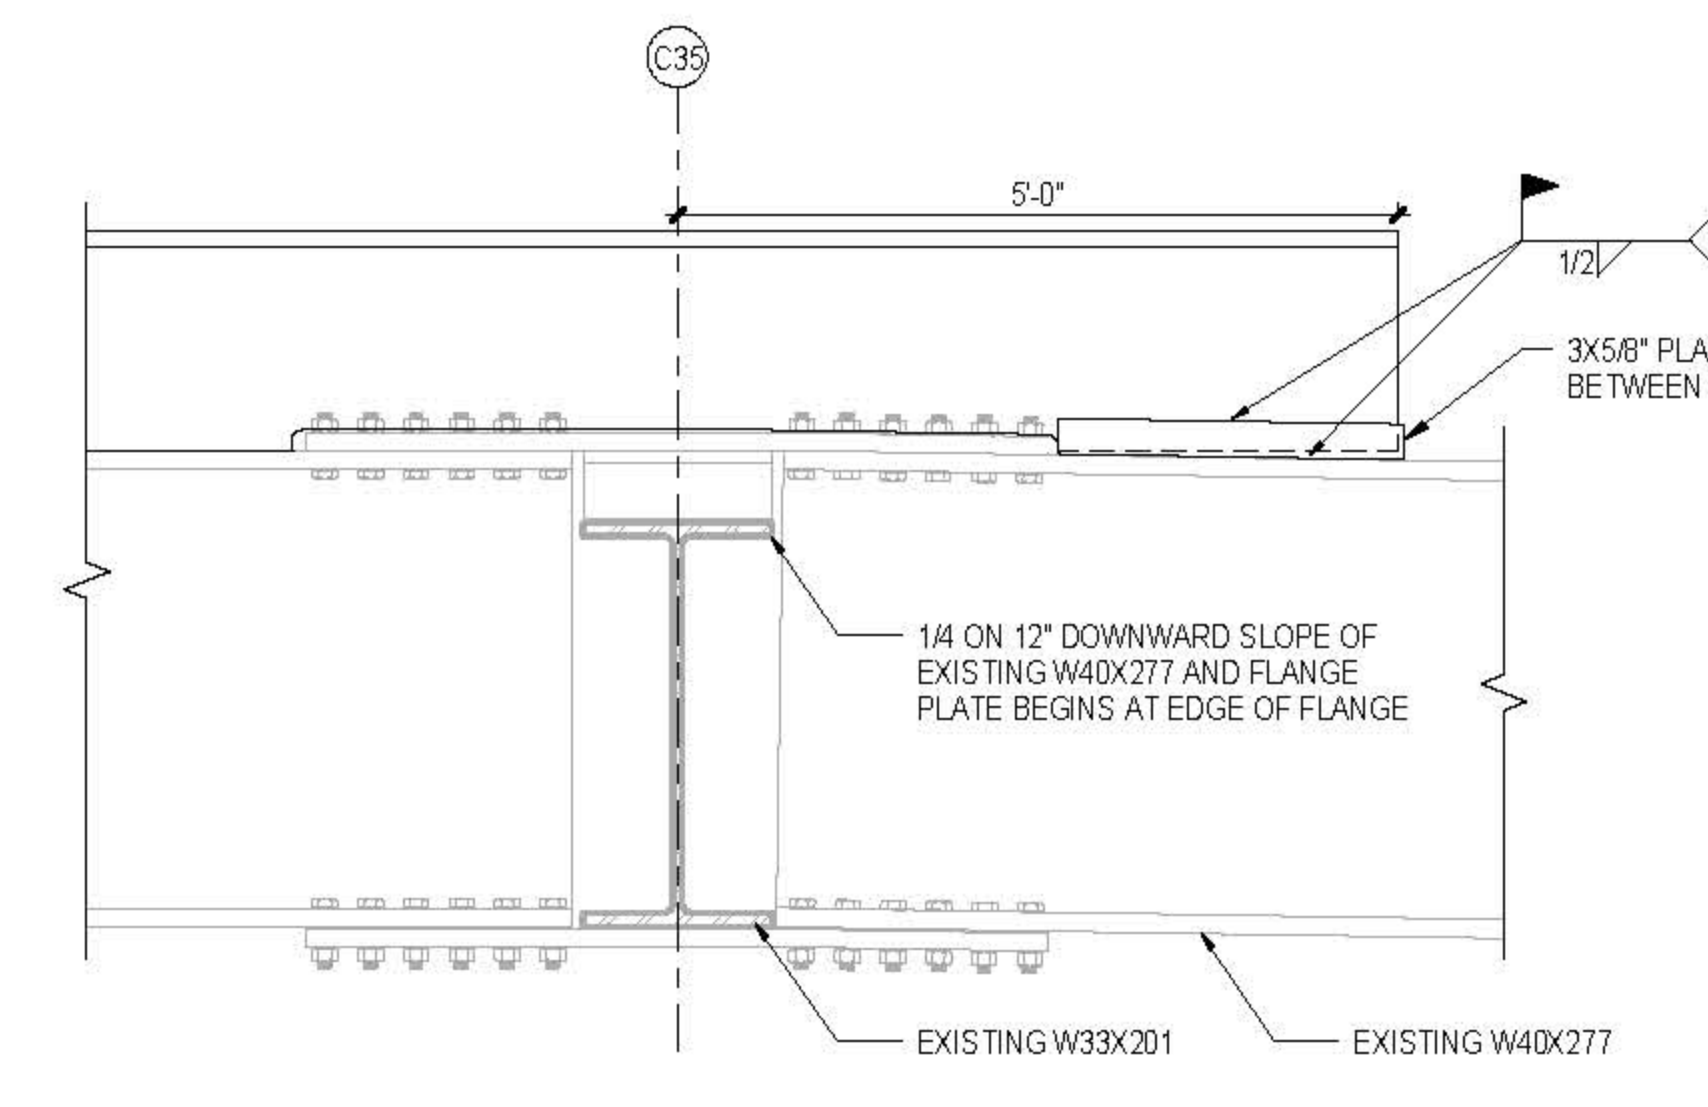


5 WT ATTACHMENT AT SLOPED RAIL BEAM
3/4" = 1'-0"

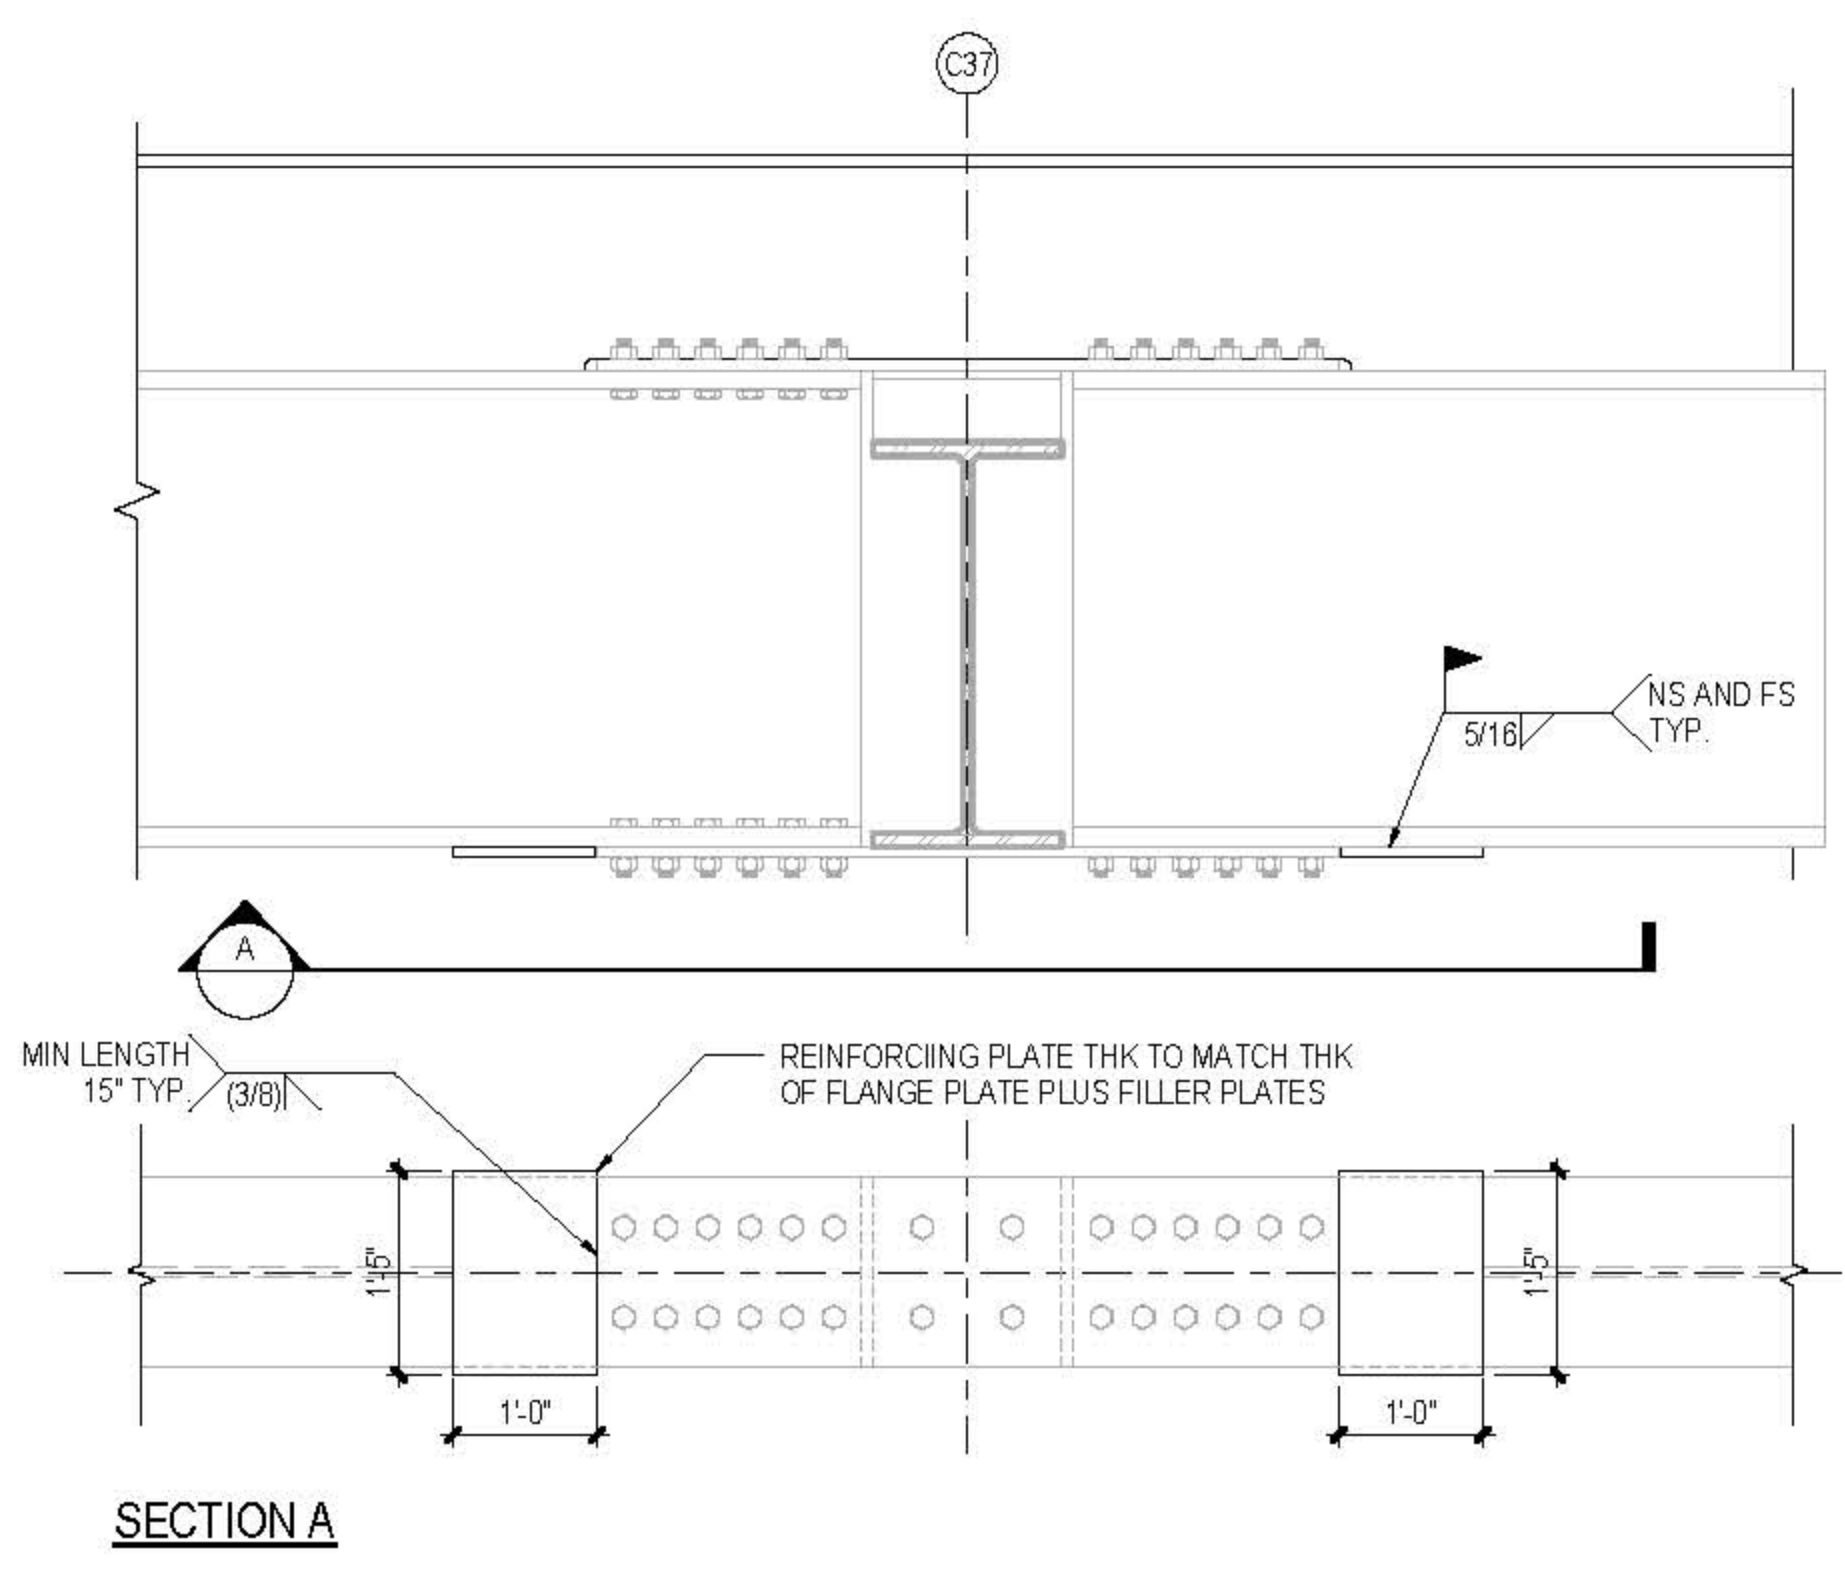

6 BOTTOM FLANGE REINFORCEMENT AT C37
3/4" = 1'-0"

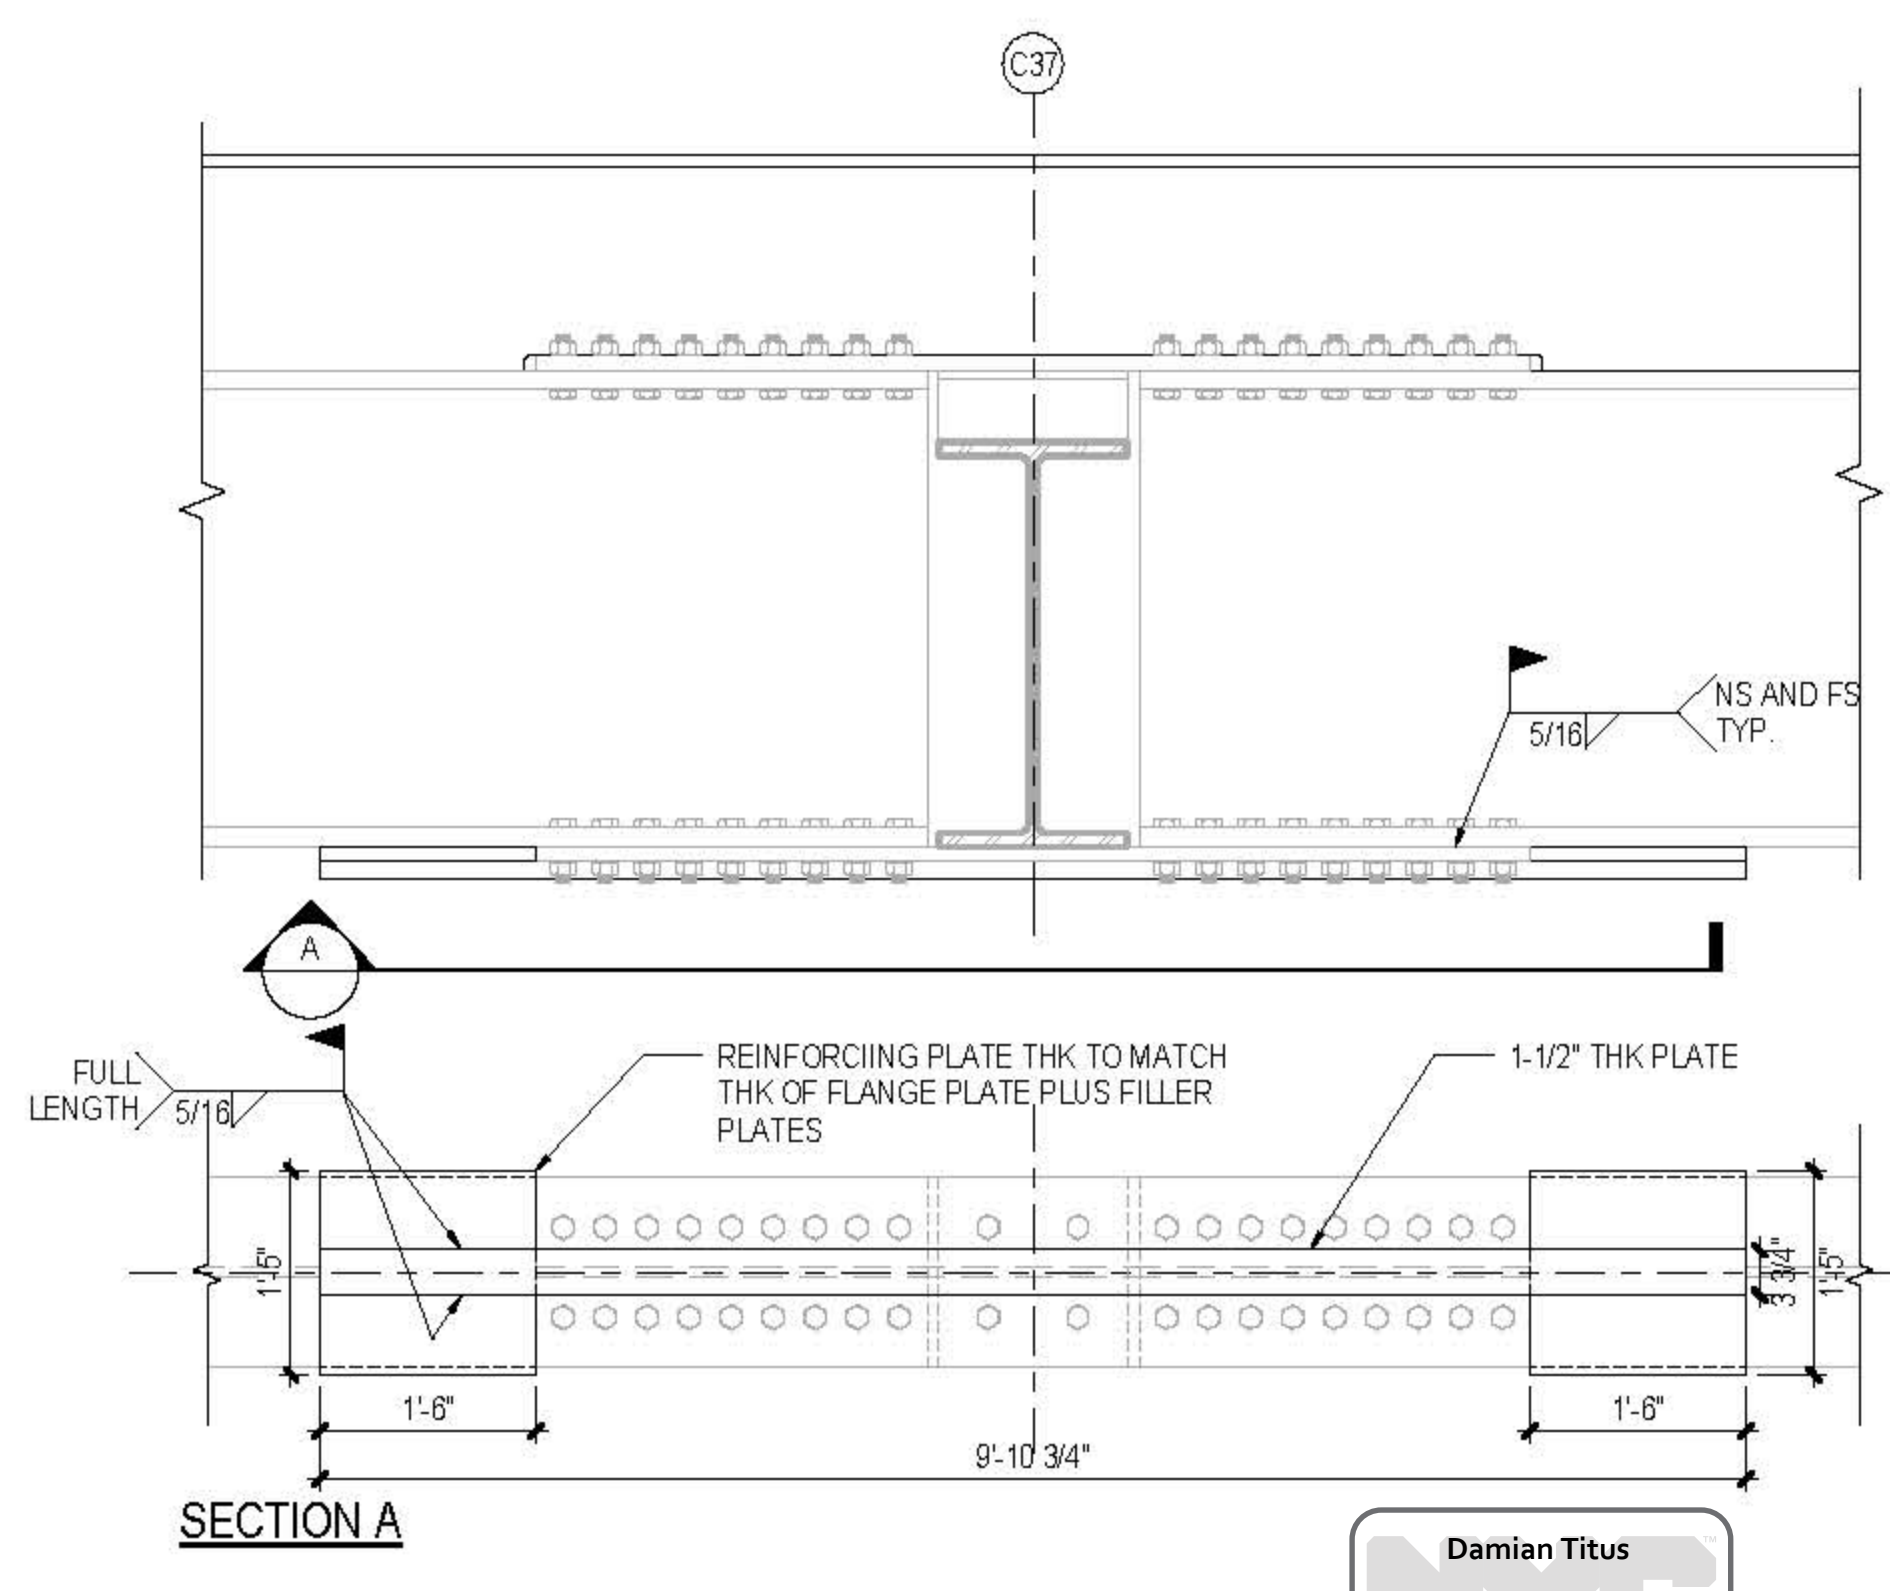

7 BOTTOM FLANGE REINFORCEMENT AT C39
3/4" = 1'-0"

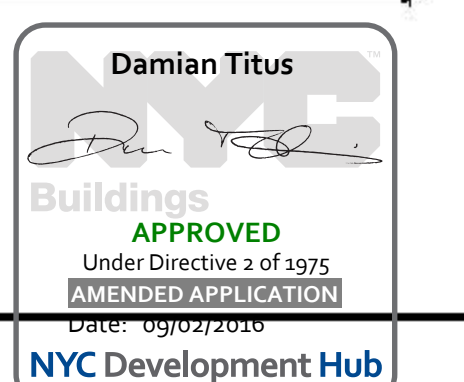

CULTURE SHED

540 West 30th Street
New York, New York 10001

OWNER
CULTURE SHED INC.

ARCHITECTS
Oller Scalfaro + Renfro Architects, DPC
601 West 30 Street #815
New York, New York 10001
T: 212.263.7971

rockwellgroup
5 Union St. West, 6th Flr
New York, New York 10003
T: 212.463.0334
F: 212.463.0335

STRUCTURAL ENGINEER
Thornton Tomasetti
51 Madison Avenue
New York, New York 10010
T: 917.661.7800
F: 917.661.7811

MEP ENGINEER
Jana Baum & Bolles
60 Park Street
New York, New York 10005
T: 212.530.9300
F: 212.266.6944

FACADE CONSULTANT
Thornton Tomasetti
51 Madison Avenue
New York, New York 10010
T: 917.661.7800
F: 917.661.7811

KINETICS ENGINEER
Hudess & Hanover
1501 Broadway
New York, New York 10036
T: 212.944.1150
F: 212.399.0337

LIGHTING DESIGNER
Thorton Design Associates
40 North Street #1650
New York, New York 10013
T: 212.675.7760

THEATRE PLANNING & DESIGN
Fisher Dachs Associates
22 West 15th Street
New York, New York 10011
T: 212.691.3000

LIFE SAFETY
Code Consultants, Inc.
215 West 40th St, 15th Flr
New York, New York 10018
T: 212.216.9596

ENERGY MODEL/LEED
Vindian
60 Washington Street
Norwalk, CT 06854
T: 203.298.1411

ACOUSTIC/AUDIO-VISUAL
Avalon
93 North Main Street
South Norwalk, CT 06854
T: 347.210.5540

VERTICAL TRANSPORTATION
Van Dusen & Associates
5 Regent Street, Suite 524
Livingston, NJ 07039
T: 973.994.9220

SPECIFICATIONS
Construction Specifications Inc.
PO Box 489
22 Tenthel Road
Morganville, NJ 07751
T: 732.970.0700
F: 732.970.0700


SECURITY
Duchella Venter & Santoro
1020 Sherman Avenue
Hartford, CT 06114
T: 203.286.6490

WATERPROOFING
James R. Galford AIA Consulting Architects PC
104 West 27th Street
New York, NY 10001
T: 212.736.3344

FACADE MAINTENANCE
Erick Engineering PLLC
162 Ave. Street
New York, NY 10005
T: 212.696.3000

BRANDING/GRAPHICS
24d Global Design Consultancy
180 Varck Street 15th Floor
New York, NY 10014
T: 212.647.1170

KEY PLAN

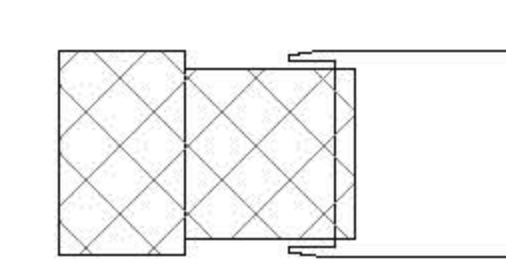

ISSUE PRINTING DATE

ISSUE	PRINTING	DATE
61	60	DOB AMENDMENT 7
		08/19/2016

STAMP



DRAWN BY: **AD/ny** CHECKED BY: **CR/ny**


PROJECT NUMBER: **N11318.00**

TITLE: **MODIFICATION PART PLANS AND DETAILS, FIXED BUILDING LEVEL 02 - V**


DRAWING NO.: **S-508.00**

B.SCAN NO.: **S-508.00**


84 of 123

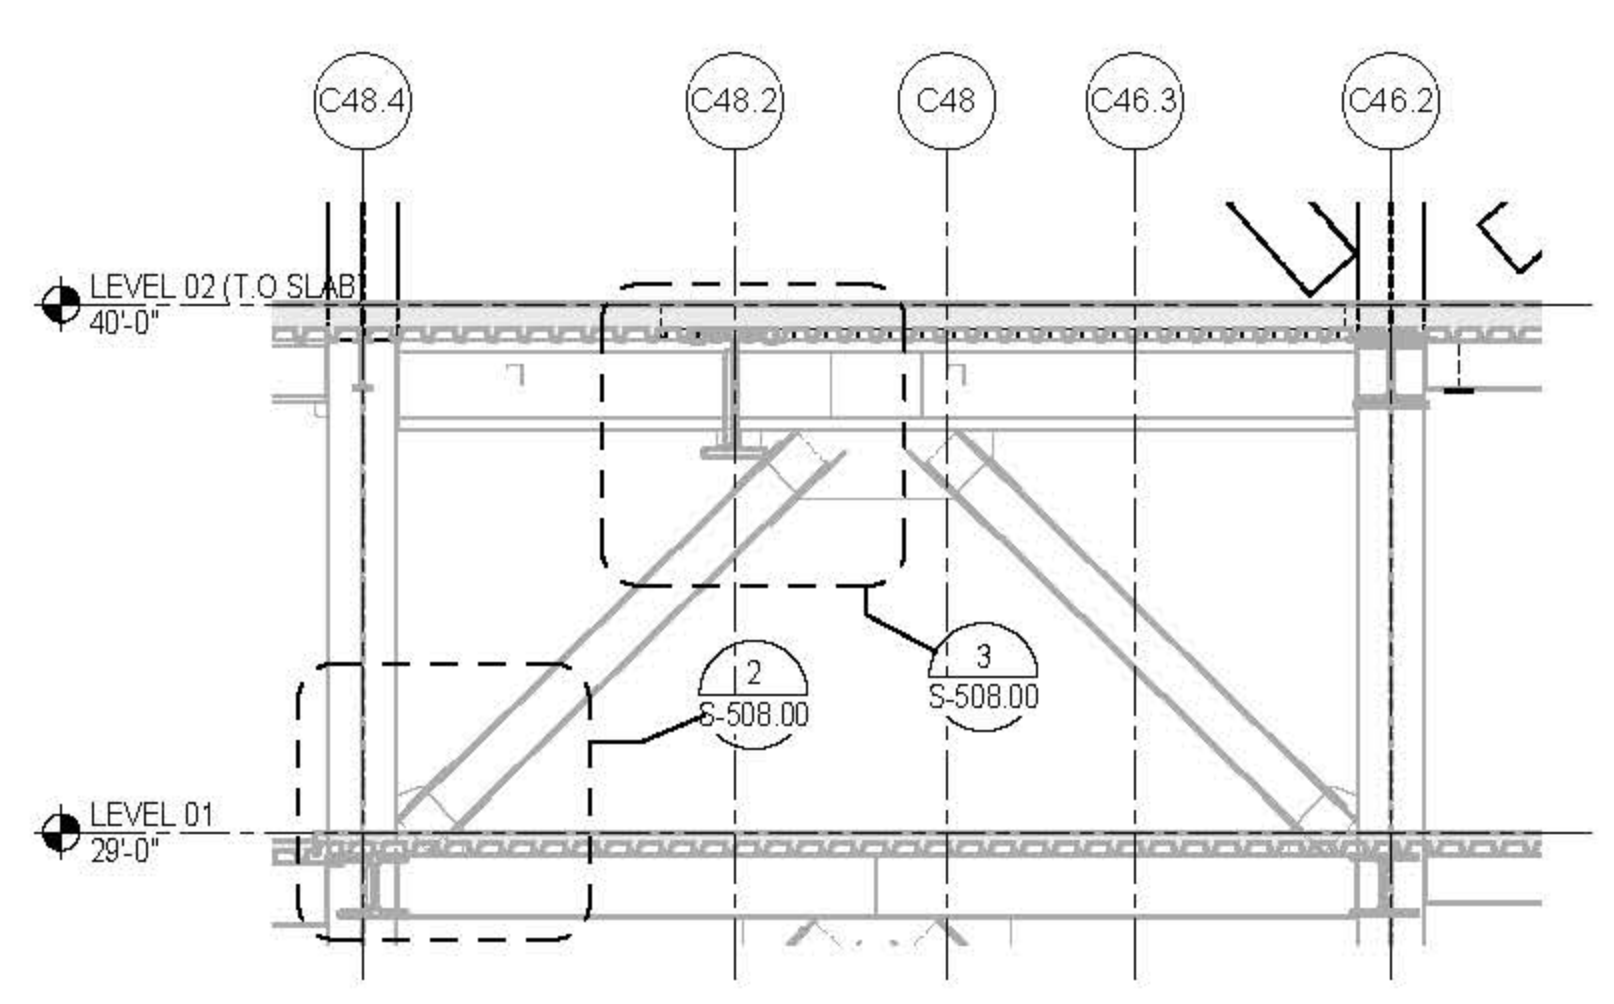

1 CN.4/C48.4-C46 BRACING ELEVATION
1/4" = 1'-0"

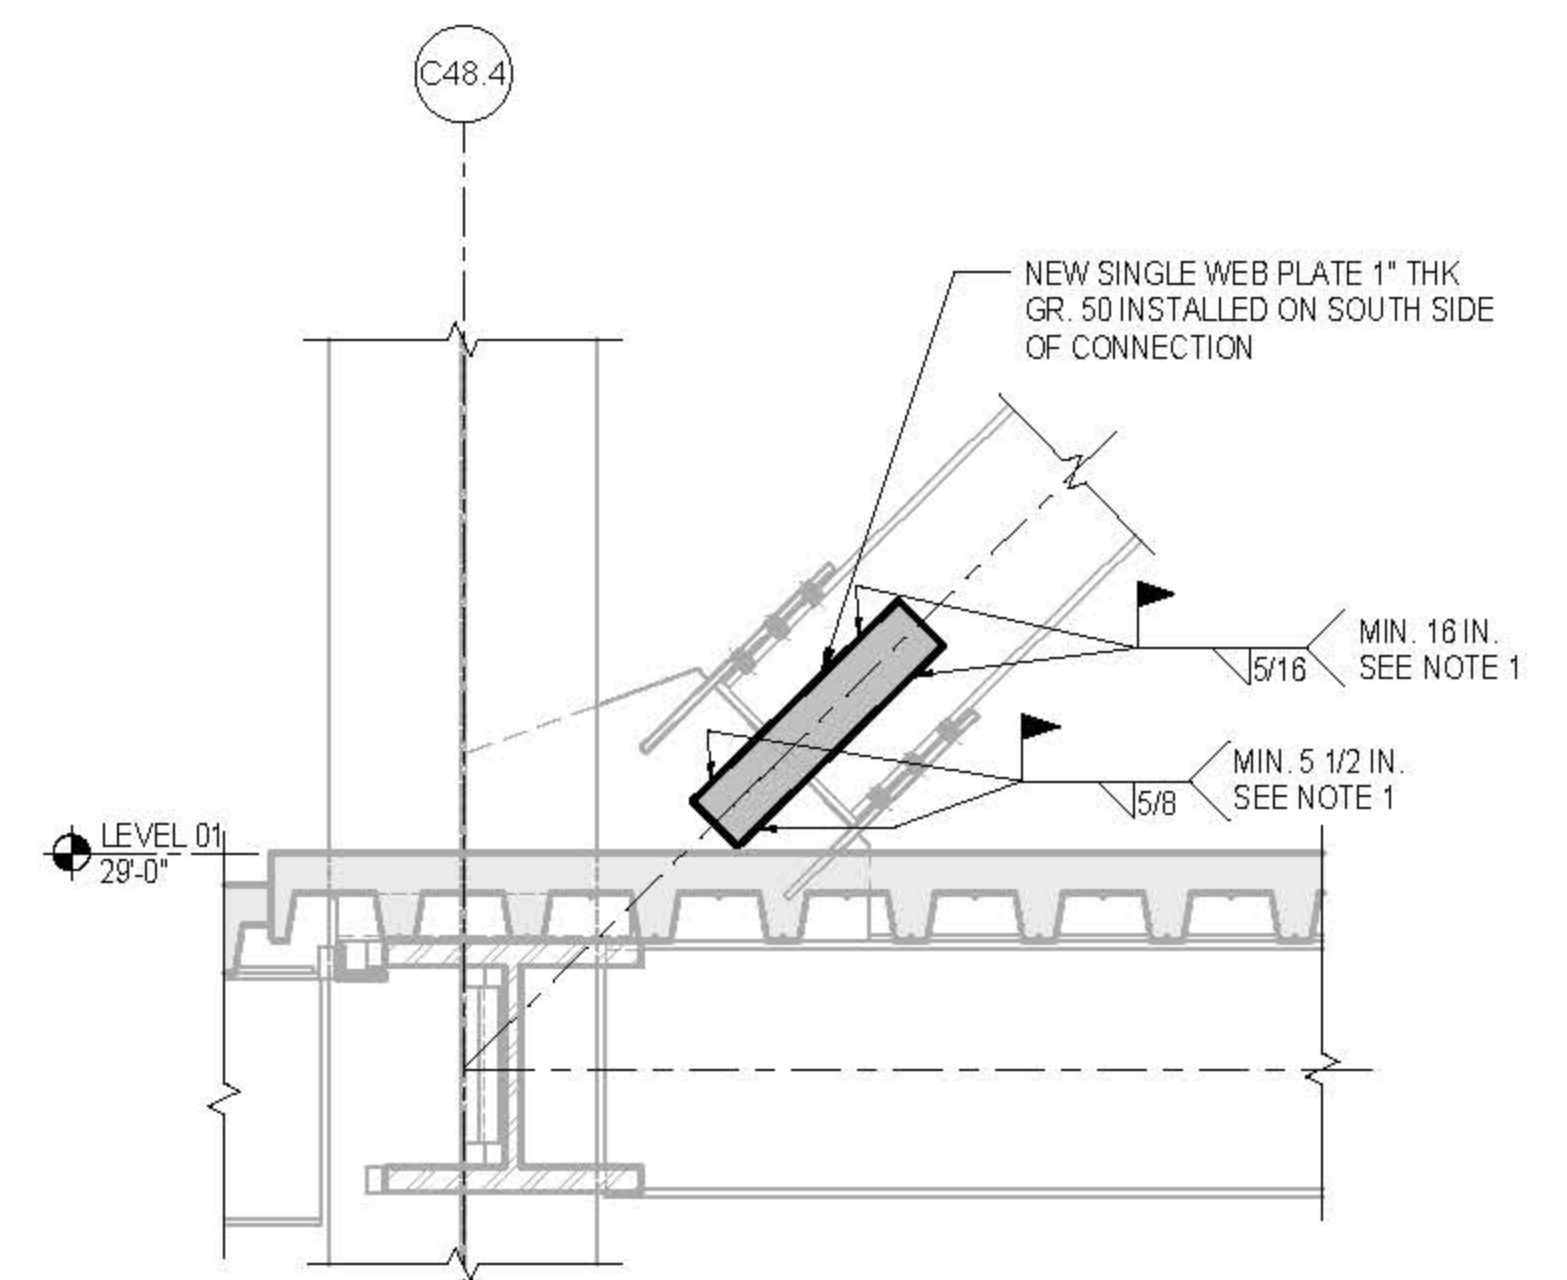

2 CN.4/C48.4 BRACE CONNECTION REINFORCEMENT
1" = 1'-0"

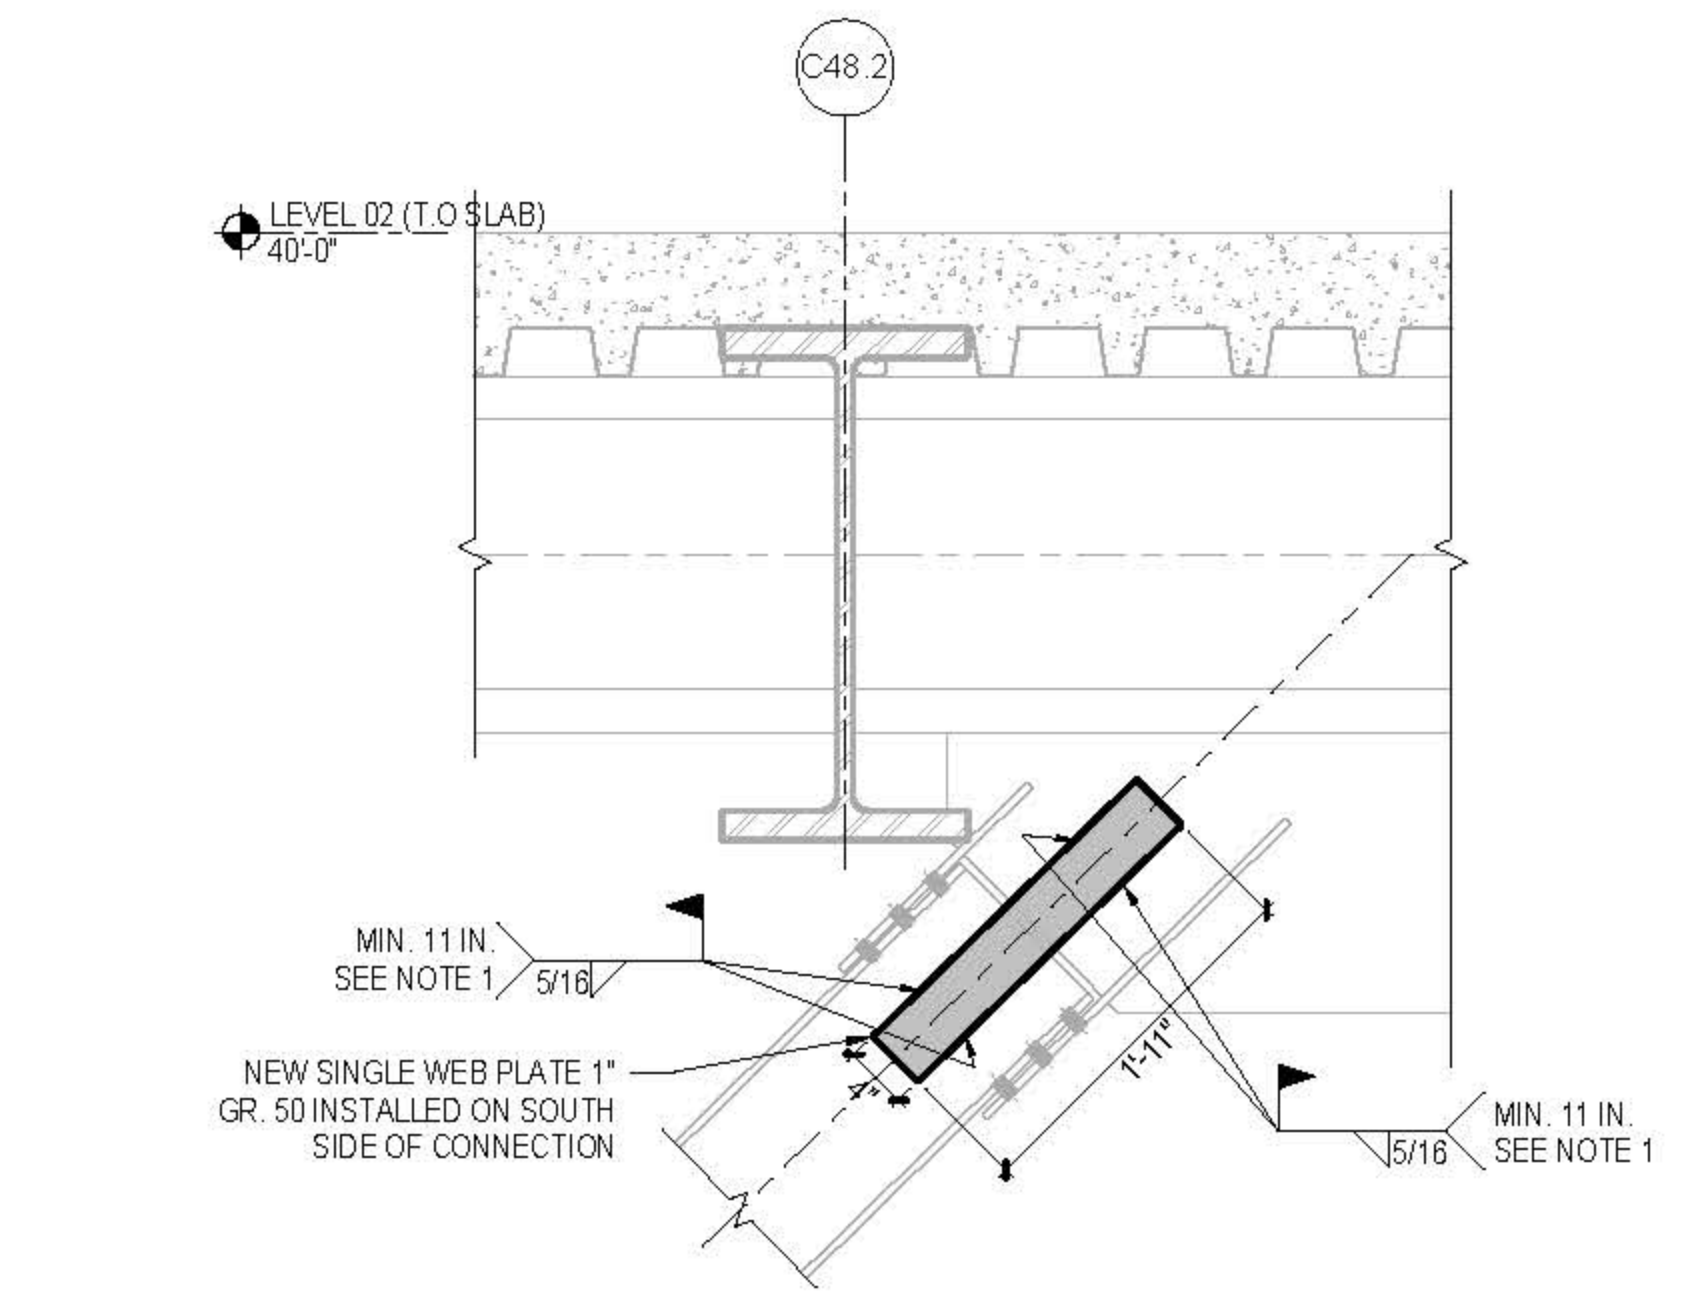


3 CN.4/C48.4-C46 BRACE CONNECTION REINFORCEMENT
1" = 1'-0"

GENERAL REINFORCEMENT NOTES:

1. INSURE ALL WEB PLATES FLAT TO HIGHER SURFACE, BRACE WEB OR GUSSETT, AND INCREASE LOWER SIDE FILLET WELD SIZE BY DIMENSION OF RESULTING GAP IF GREATER THAN 1/16", BUT NOT MORE THAN 3/16"
2. LOCALLY REMOVE EXISTING SPRAY-ON FIREPROOFING FOR SURFACE PREPARATION AND RESTORE FOLLOWING COMPLETION OF REINFORCEMENT.
3. ALL EXISTING CONDITIONS TO BE VERIFIED IN FIELD.

TYPICAL BRACING REINFORCEMENT NOTES

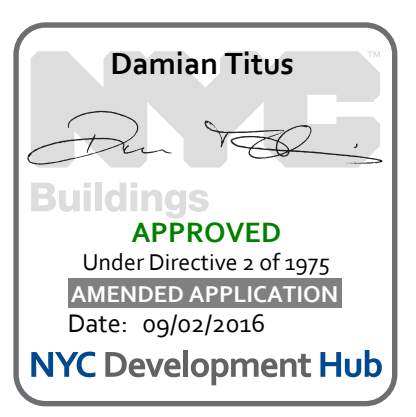

CULTURE SHED

540 West 30th Street
New York, New York 10001

OWNER
CULTURE SHED INC.

ARCHITECTS
Office Sclafino + Renfro Architects, DPC
601 West 20th Street #815
New York, New York 10001
T: 212.263.7971

rockwellgroup
5 Union St. West, 6th Flr
New York, New York 10003
T: 212.463.0334
F: 212.463.0335

STRUCTURAL ENGINEER
Thornton Tomasetti
51 Madison Avenue
New York, New York 10010
T: 917.961.7800
F: 917.691.7801

MEP ENGINEER
Jana Baum & Bolles
50 Park Street
New York, New York 10005
T: 212.530.9300
F: 212.266.6544

FACADE CONSULTANT
Thornton Tomasetti
51 Madison Avenue
New York, New York 10010
T: 917.961.7800
F: 917.691.7801

KINETICS ENGINEER
Hardisty & Hanover
1501 Broadway
New York, New York 10036
T: 212.944.1150
F: 212.391.0297

LIGHTING DESIGNER
Tilston Design Associates
40 North Street #160
New York, New York 10013
T: 212.675.7760

THEATRE PLANNING & DESIGN
Fisher Dodge Associates
22 West 15th Street
New York, New York 10011
T: 212.699.3000

LIfe SAFETY
Code Consultants, Inc.
215 West 43rd St., 15th Flr
New York, New York 10018
T: 212.216.9596

ENERGY MODELLED
Vindian
50 Washington Street
Norwalk, CT 06854
T: 203.298.1411

ACOUSTIC/AUDIO VISUAL
Avalon
50 North Main Street
South Norwalk, CT 06854
T: 347.210.5540

VERTICAL TRANSPORTATION
Van Duusen & Associates
5 Regent Street, Suite 224
Langston, NJ 07038
T: 973.994.9200

SPECIFICATIONS
Construction Specifications Inc.
PO Box 489
227 Fenwick Road
Morristown, NJ 07851
T: 732.970.0700
F: 732.970.0750


SECURITY
Duchella Venter & Santoro
1020 Sherman Avenue
Hartford, CT 06114
T: 203.286.6490

WATERPROOFING
James R. Gahfort AIA Consulting Architects PC
104 West 27th Street
New York, NY 10001
T: 212.736.3344

FACADE MAINTENANCE
Erick Engineering PLLC
186 Ave. Street
New York, NY 10005
T: 212.698.3000


BRANDING GRAPHICS
214 Global Design Consultancy
180 York Street 15th Floor
New York, NY 10014
T: 212.647.1170

KEY PLAN

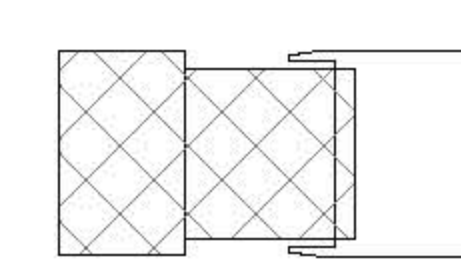

ISSUE PRINTING DATE

NO.	DESCRIPTION	DATE
01	50 DOB AMENDMENT 7	08.19.2016
02	37 26 061 #01	02.12.2016
03	CONTRACTOR SET	10.09.2016
04	ADV. PROCUREMENT ADDENDUM 6	04.10.2016
05	100% CONSTRUCTION DOCUMENTS	03.18.2016
06	90% CONSTRUCTION DOCUMENTS	02.16.2016
07	PRELIMINARY DOB SUBMISSION	12.10.2014
08	ADVANCED PROCUREMENT BID SET	06.16.2014

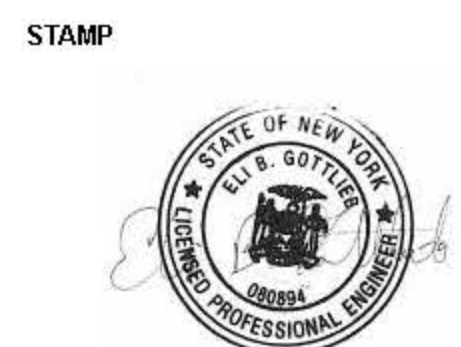


DRAWN BY: Audrey
CHECKED BY: Chris
PROJECT NUMBER: N1318.00

TITLE: TYPICAL STEEL BEAM DETAILS II

DRAWING NO.: S-703.01

B-SCAN NO.: S-703.01

MARK	TYPE	MAXIMUM SIZE (IN)				PLATES (L x WIDTH (IN))			ADDL. SLAB REINF. REQ. SEE NOTE 4	REMARKS
		W	H	DIAMETER	e	TOP	BOTTOM	SIDE		
01A	U	22	9	-	-	-	-	-	-	
01B	U	-	-	24	32.5	-	-	-	-	
01C	U	-	-	24	35.5	-	-	-	-	
01D	U	-	-	24	39.5	-	-	-	-	
02A	U	-	-	10.5	-	-	-	-	-	
02B	U	16	10	-	-	-	-	-	-	
02C	S	24	18	-	-	1/2x4.5	1/2x4.5	-	1/4	FIELD CUT IN EXISTING BEAM
02D	U	14	9	-	-	-	-	-	-	
02E	U	22	9	-	-	-	-	-	-	
02F	U	18	9	-	-	-	-	-	-	
02G	U	24	24	-	-	-	-	-	-	
02H	U	-	-	14	17	-	-	-	-	
02I	U	-	-	14	26	-	-	-	-	
02J	U	-	-	14	28	-	-	-	-	
02K	U	-	-	14	29	-	-	-	-	
02L	U	-	-	14	31	-	-	-	-	
02M	U	-	-	16	26	-	-	-	-	
02N	U	-	-	16	29	-	-	-	-	
02O	U	-	-	14	-	-	-	-	-	
02P	U	18	18	-	-	-	-	-	-	TR-1, SEE S-401 FOR LOCATION
02Q	U	-	-	8	-	-	-	-	-	TR-1, SEE S-401 FOR LOCATION
02R	U	52	28	-	-	-	-	-	-	
02S	U	36	12	-	-	-	-	-	-	TR-1, SEE S-401 FOR LOCATION
02T	U	20	9	-	-	-	-	-	-	
02U	U	-	-	8	-	-	-	-	-	
02V	U	-	-	10	-	-	-	-	-	
02W	S-ALT	-	-	8	-	1/2x4.5	1/2x4.5	-	1/4	
02X	U	-	-	14	22	-	-	-	-	
02Y	U	-	-	14	25	-	-	-	-	
02Z	U	-	-	14	33	-	-	-	-	
02AA	U	-	-	14	37	-	-	-	-	
04A	S-ALT	24	24	-	-	-	-	-	-	PLACE STIFFENERS ON SOUTH SIDE OF PG
04B	S-ALT	26	12	-	-	-	-	-	-	PLACE STIFFENERS ON SOUTH SIDE OF PG
04C	S-ALT	18	32	-	-	-	-	-	-	PLACE STIFFENERS ON SOUTH SIDE OF PG
04D	S-ALT	29	29	-	-	-	-	-	-	PLACE STIFFENERS ON SOUTH SIDE OF PG
06A	S-ALT	29	29	-	-	-	-	-	-	PLACE STIFFENERS ON SOUTH SIDE OF PG
06B	S-ALT	26	12	-	-	-	-	-	-	PLACE STIFFENERS ON SOUTH SIDE OF PG
06C	S-ALT	18	32	-	-	-	-	-	-	PLACE STIFFENERS ON SOUTH SIDE OF PG
06D	S-ALT	60	30	-	-	-	-	-	-	PLACE STIFFENERS ON NORTH SIDE OF PG
06E	S-ALT	34	16	-	-	-	-	-	-	PLACE STIFFENERS ON NORTH SIDE OF PG
06F	S-ALT	36	16	-	-	-	-	-	-	
06G	S-ALT	24	24	-	-	-	-	-	-	
06A	S-ALT	28	28	-	-	-	-	-	-	
06B	S-ALT	44	32	-	-	-	-	-	-	
06C	S-ALT	42	34	-	-	-	-	-	-	
06D	S-ALT	64	34	-	-	-	-	-	-	
06A	U	67	36	-	-	-	-	-	-	
06B	U	24	24	-	-	-	-	-	-	
06C	U	22	14	-	16.5	-	-	-	-	
06D	S	18	18	-	-	-	-	-	-	
06E	S	36	28	-	-	-	-	-	-	
06F	U	56	30	-	-	-	-	-	-	
06G	U	54	30	-	-	-	-	-	-	
06H	S	60	32	-	-	-	-	-	-	
06I	S	24	32	-	32.75	-	-	-	-	
06J	S	17	30	-	-	-	-	-	-	
06K	U	32	16	-	-	-	-	-	-	
06L	S	36	20	-	35	-	-	-	-	
06M	S	67	36	-	-	-	-	-	-	
06N	U	36	24	-	-	-	-	-	-	
06O	S	38	26	-	-	-	-	-	-	
06P	S	34	22	-	-	-	-	-	-	
06Q	S	16	16	-	-	-	-	-	-	
06R	S	21	21	-	-	-	-	-	-	PLACE STIFFENERS ON SOUTH SIDE OF PG
06S	S	12	12	-	-	-	-	-	-	PLACE STIFFENERS ON SOUTH SIDE OF PG
06T	S	50	36	-	-	-	-	-	-	
06U	S-ALT	67	36	-	-	1/2x4.5	1/2x4.5	1/2x4.5	1/4	
06V	U	32	18	-	-	-	-	-	-	
06W	S	24	18	-	-	-	-	-	-	
06X	S	24	30	-	-	-	-	-	-	
06Y	U	24	16	-	16.5	-	-	-	-	
06Z	U	40	26	-	-	-	-	-	-	
06AA	U	64	30	-	-	-	-	-	-	
06AB	S	56	30	-	-	-	-	-	-	
06AC	S	20	14	-	-	-	-	-	-	
06AD	U	24	16	-	-	-	-	-	-	
06AE	S	24	16	-	-	-	-	-	-	

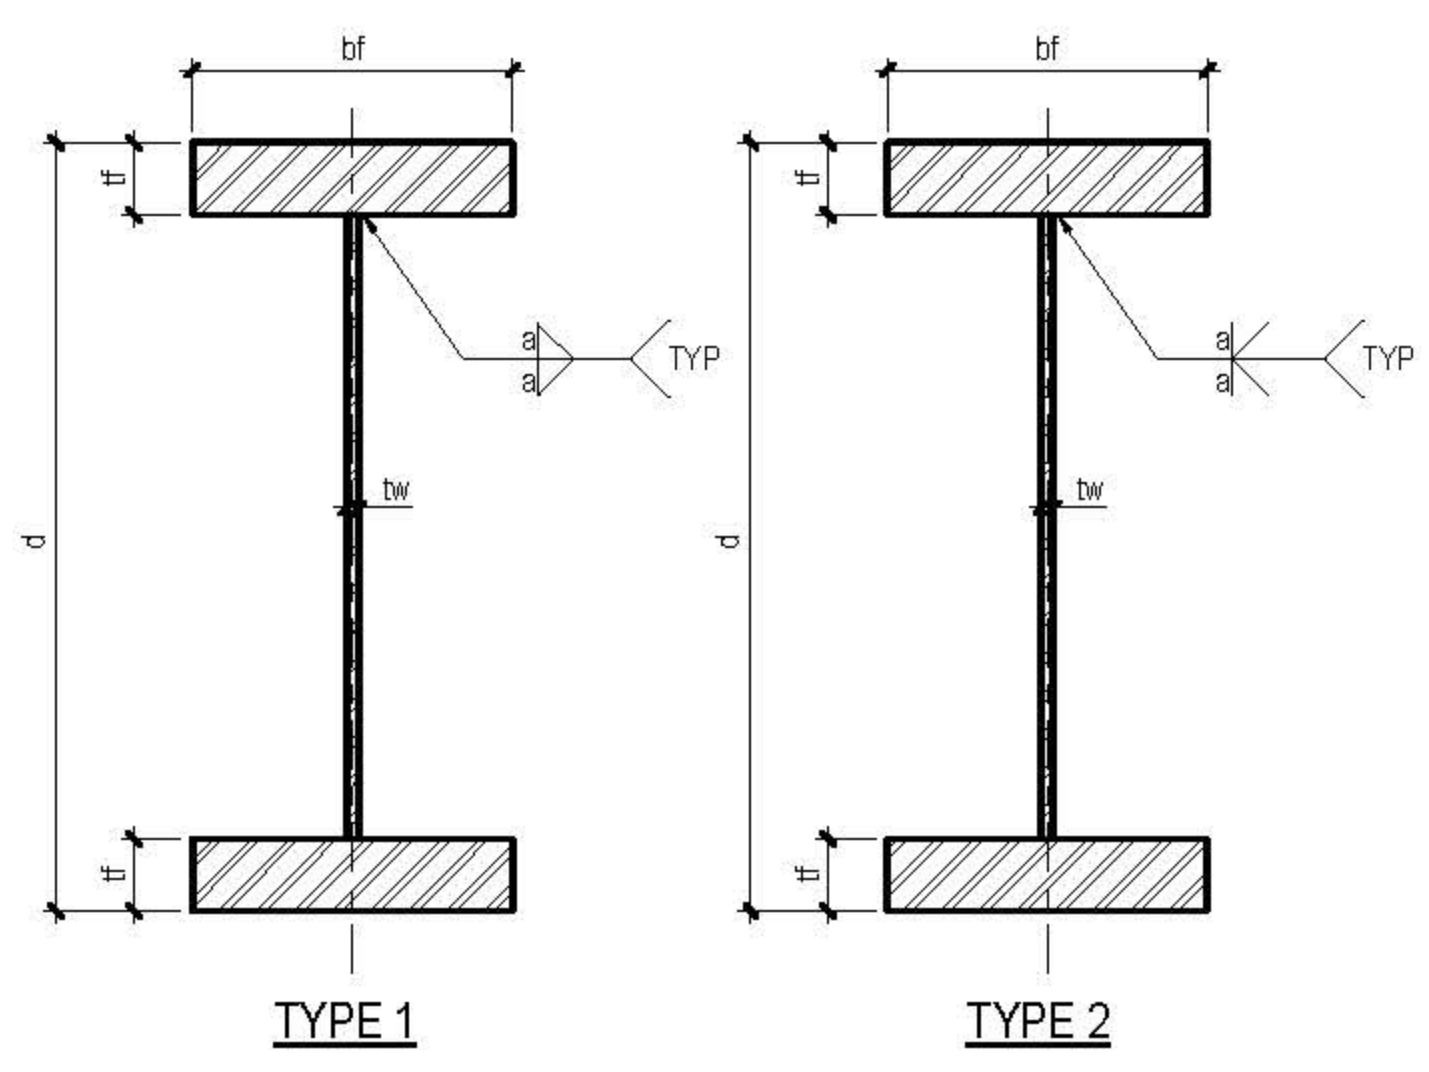


- NOTES:
- SIZE OF WELD ASSUMES SHELDED METAL ARC WELDING (SMAW)
 - ALL WELDS ARE CONTINUOUS UN
 - PLATE GIRDER DESIGNED FOR THE FOLLOWING PLATE GRADE:
If $t_w \leq 4"$, ASTM A572 Fy = 50 KSI
If $4 < t_w \leq 6"$, ASTM A572 Fy = 42 KSI
If $6 < t_w \leq 8"$, ASTM A572 Fy = 36 KSI

MARK	d (in)	FLANGE		WEB	WELD	REMARKS
		tf (in)	tf (in)			
PG8X24	8	6.5	0.375	25	3/16	TYPE 1
PG10X19	10.25	4.00	0.500	0.25	5/16	TYPE 1
PG12X45	12	8.00	0.625	0.375	5/16	TYPE 1
PG18X71	18.5	7.625	0.875	0.50	3/8	TYPE 1
PG24X117	24.25	12.75	0.875	0.625	1/2	TYPE 1
PG24X162	25	13.00	1.25	0.75	9/16	TYPE 1
PG27X178	27.75	14.00	1.25	0.75	9/16	TYPE 1
PG27X194	28	14.00	1.50	0.75	9/16	TYPE 1
PG30X108	30	10.50	0.75	0.625	1/2	TYPE 1
PG30X173	30.5	15.00	1.25	0.625	1/2	TYPE 1
PG30X211	31	15.00	1.50	0.75	9/16	TYPE 1
PG36X150	36	12.00	1.00	0.625	1/2	TYPE 1
PG36X210	36.75	12.25	1.50	0.75	9/16	TYPE 1
PG6.5	9.5	10.5	0.625	0.375	1/4	TYPE 1
PG18X85	18.5	7.625	0.75	0.50	5/16	TYPE 1
PG14X189	15.5	15.75	1.50	0.875	5/8	TYPE 1
PG60.6	60	24.00	2.00	1.00	3/4	TYPE 1

2 TYPICAL PLATE GIRDER DETAIL AND SCHEDULE


NOT TO SCALE

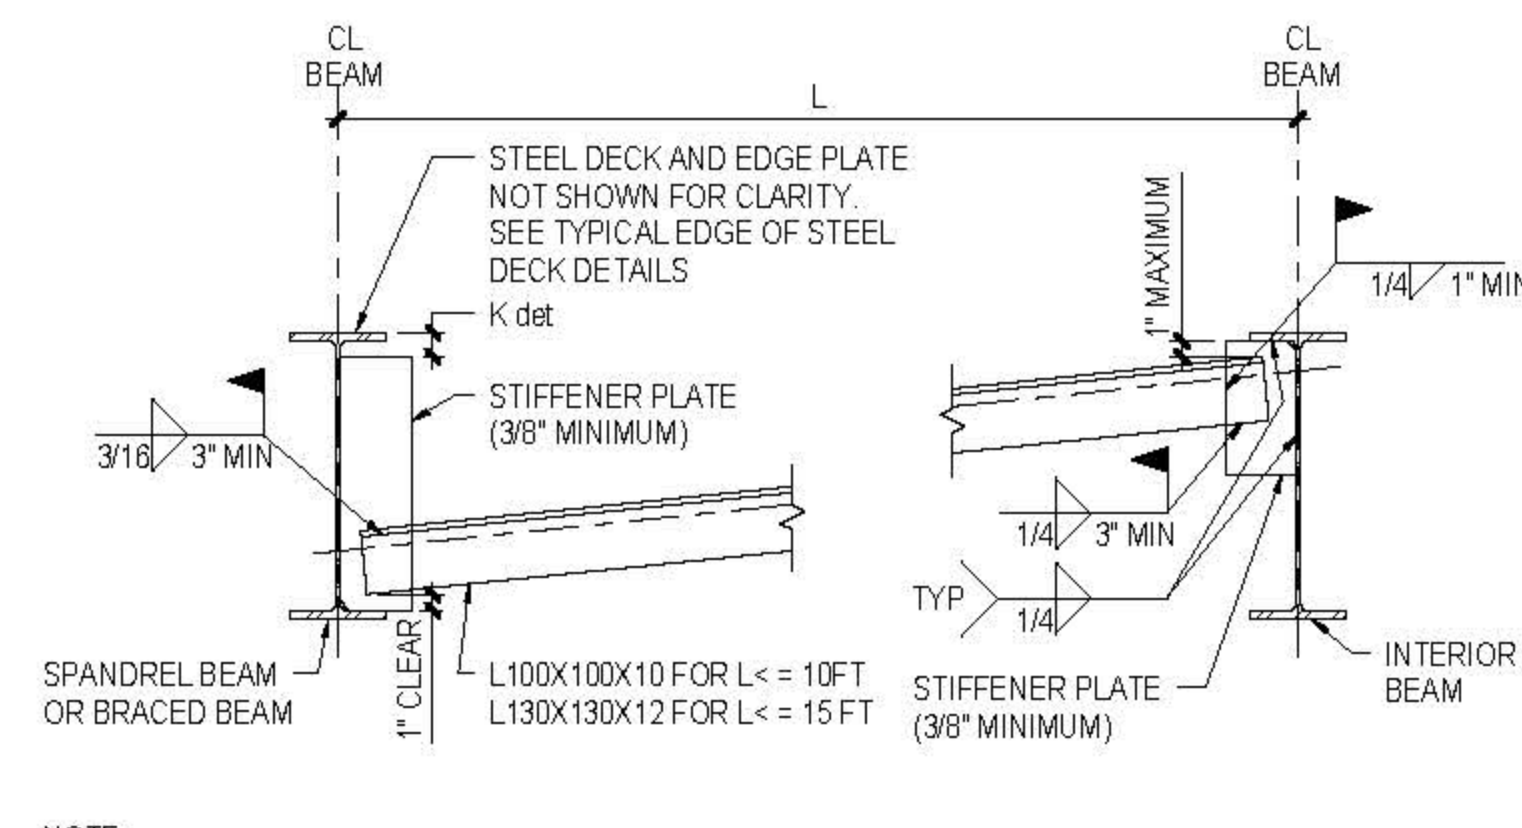

- NOTE:
- SEE PLAN FOR LOCATIONS OR SPACING

3 TYPICAL SPANDREL OR BRACED BEAM KICKER CONNECTION


NOT TO SCALE

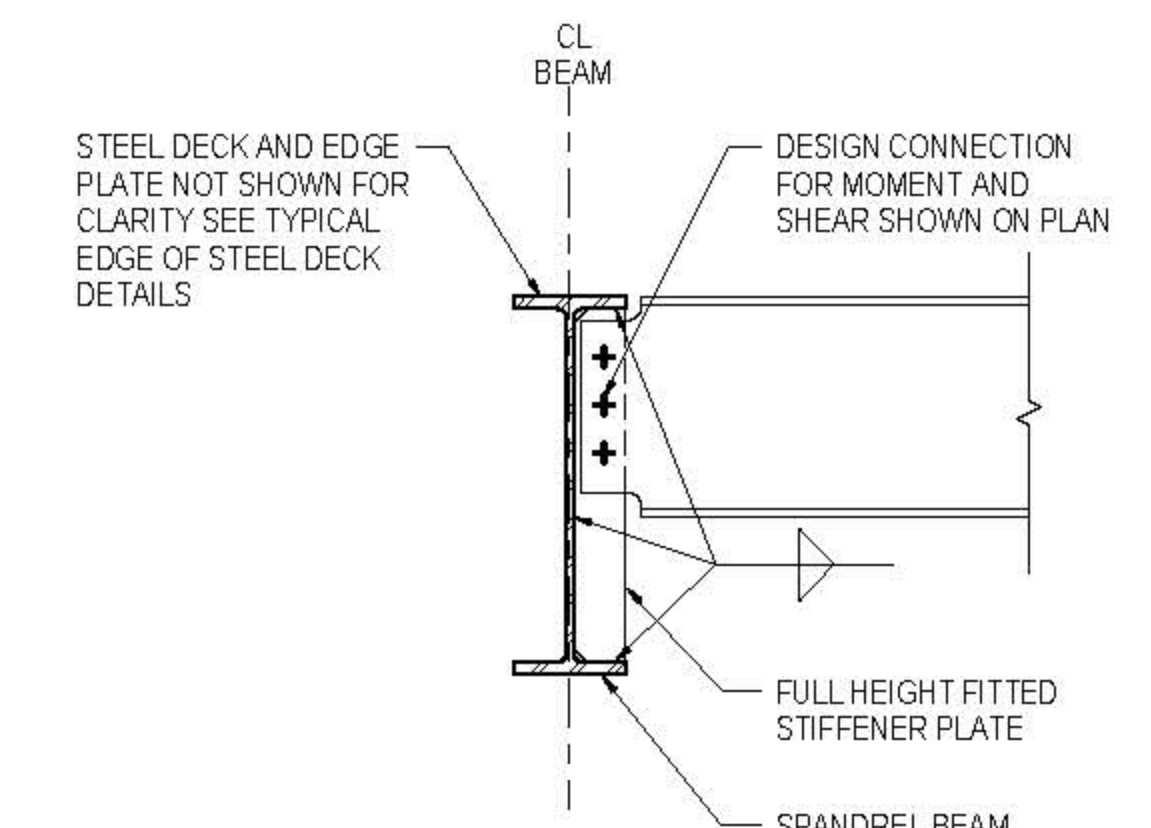

- NOTE:
- SEE PLAN FOR LOCATIONS

4 TYPICAL FULL HEIGHT FITTED STIFFENER AT SPANDREL OR BRACED BEAM CONNECTION


NOT TO SCALE

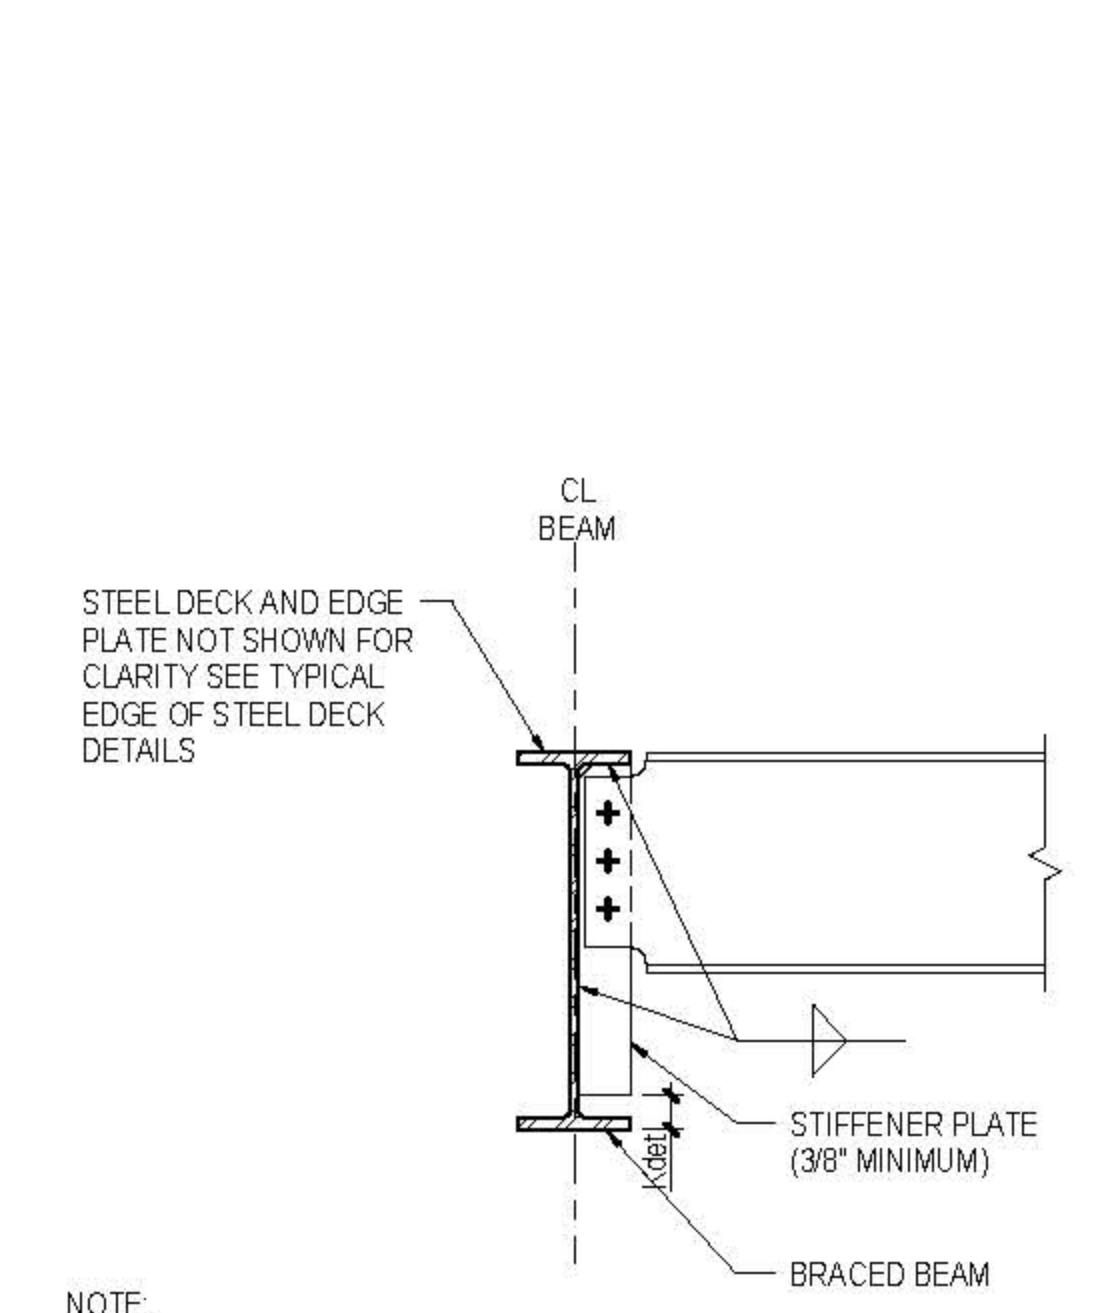

- NOTE:
- SEE PLAN FOR LOCATIONS

5 TYPICAL FULL HEIGHT UNFITTED STIFFENER AT BRACED BEAM CONNECTION

NOT TO SCALE

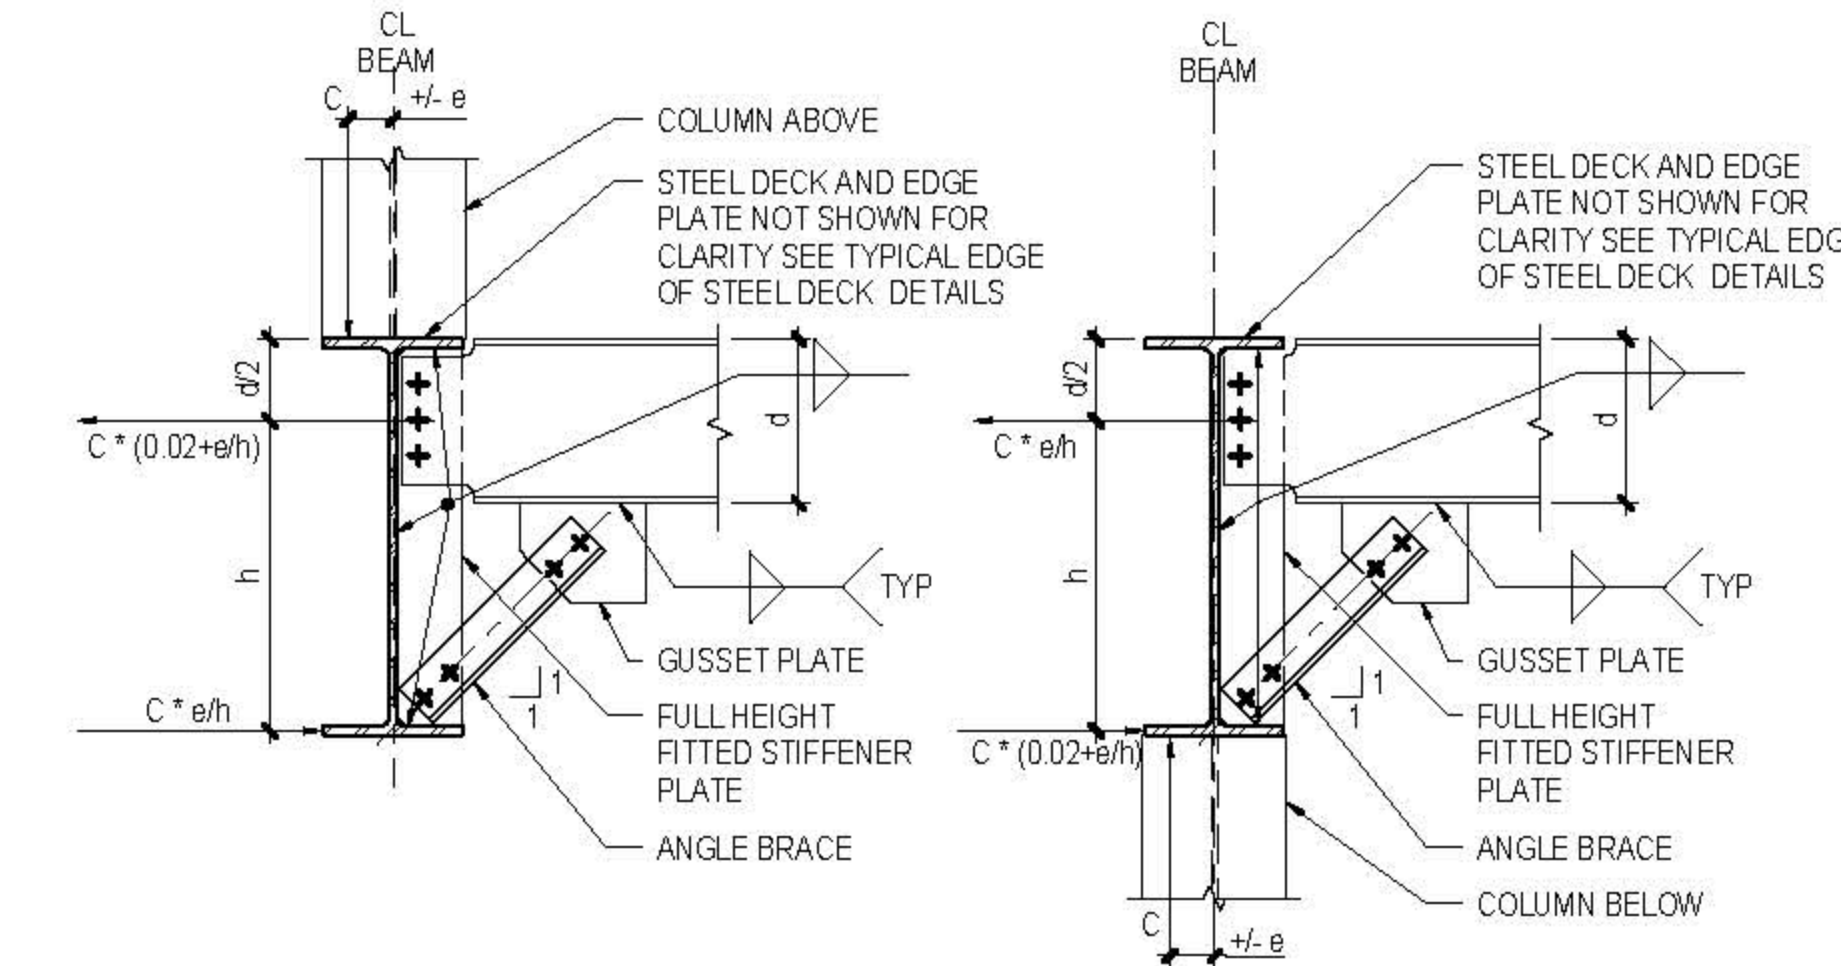

- NOTES:
- DESIGN CONNECTION FOR FORCES BASED ON COLUMN AXIAL LOAD AS SHOWN AND FOR FORCES SHOWN ON COLUMN
 - C = COLUMN AXIAL FORCE
e = 1/2" ACCIDENTAL ECCENTRICITY

COLUMN ABOVE

COLUMN BELOW

Damian Titus
Professional Engineer
No. 13092

DATE: 09/29/2016
TIME: 10:00 AM
PROJECT: CULTURE SHED

1 BEAM WEB PENETRATION SCHEDULE

NOT TO SCALE

- NOTES:
- TYPE REFERS TO TYPICAL BEAM WEB PENETRATION DETAILS.
 - THE MINIMUM CLEAR SPACE BETWEEN TWO ADJACENT PENETRATIONS SHALL BE GREATER OF THE LARGEST PENETRATION DIMENSION OR TWO TIMES THE BEAM DEPTH UN.
 - SEE STRUCTURAL DRAWINGS FOR QUANTITY AND LOCATIONS OF PENETRATIONS ALL BEAM PENETRATIONS SHALL BE SHOWN ON THE SHOP DRAWINGS FOR REVIEW BY THE ARCHITECT/ENGINEER. NO PENETRATIONS SHALL BE MADE WITHOUT PRIOR REVIEW OF THE ARCHITECT/ENGINEER.
 - SEE TYPICAL COMPOSITE STEEL DECK DETAIL AT BEAM WEB PENETRATIONS WITH ADDITIONAL STUDS AND SLAB REINFORCEMENT.

CULTURE SHED

540 West 30th Street
New York, New York 10001

OWNER
CULTURE SHED INC.

ARCHITECTS
Olin Scaife + Renfro Architects, DPC
601 West 20th Street #815
New York, New York 10011
T: 212.463.0334
F: 212.463.0335

rockwellgroup
5 Union Sq West, 8th Flr
New York, New York 10003
T: 212.463.0334
F: 212.463.0335

STRUCTURAL ENGINEER
Thornton Tomasetti
51 Madison Avenue
New York, New York 10010
T: 917.991.7800
F: 917.991.7801

MEP ENGINEER
Jana Baum & Bolles
31 Park Street
New York, New York 10005
T: 312.530.9300
F: 212.265.6544

FACADE CONSULTANT
Thornton Tomasetti
51 Madison Avenue
New York, New York 10010
T: 917.991.7800
F: 917.991.7801

KINETICS ENGINEER
Hardesy & Hanover
1501 Broadway
New York, New York 10036
T: 212.944.1150
F: 212.265.6544

LIGHTING DESIGNER
Tilston Design Associates
40 North Street #1650
New York, New York 10013
T: 212.675.7760

THEATRE PLANNING & DESIGN
Fisher Dodge Associates
22 West 15th Street
New York, New York 10011
T: 212.691.3000

LIFE SAFETY
Code Consultants, Inc.
215 West 43rd St, 15th Flr
New York, New York 10018
T: 212.216.9596

ENERGY MODEL/LEED
Vidisan
10 Washington Street
Norwalk, CT 06854
T: 203.298.1411

ACOUSTIC/AUDIO-VISUAL
Acoustic
93 North Main Street
South Norwalk, CT 06854
T: 347.210.5540

VERTICAL TRANSPORTATION
Van Dusen & Associates
3 Pleasant Street, Suite 524
Lakewood, NJ 07038
T: 873.994.9220

SPECIFICATIONS
Construction Specifications Inc.
90 Bow 489
227 Tenth Road
Morganville, NJ 07751
T: 732.970.0700
F: 732.970.0700


SECURITY
Duchella Venter & Santoro
1100 Sherman Avenue
Hartford, CT 06114
T: 203.286.6490

WATERPROOFING
James R. Gahfort AIA Consulting Architects PC
104 West 27th Street
New York, NY 10001
T: 212.736.3344

FACADE MAINTENANCE
Etek Engineering PLLC
162 Arden Street
New York, NY 10005
T: 212.698.3003

BRANDING GRAPHICS
214 Global Design Consultancy
180 York Street 15th Floor
New York, NY 10014
T: 212.647.1170

KEY PLAN

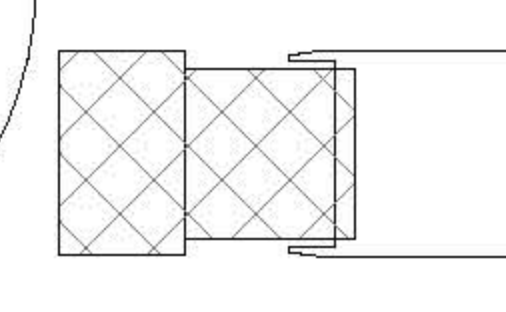

ISSUE PRINTING DATE

01	01	01B AMENDMENT 7	08.19.2015
11	5	ADV. PROCUREMENT ADDENDUM 6	04.10.2015
10	4	100% CONSTRUCTION DOCUMENTS	03.18.2015

STAMP



DRAWN BY
Audrey

CHECKED BY
Chris


PROJECT NUMBER
N1318.00

TITLE
SECTIONS AND DETAILS, FKED BUILDING LOBBY II


DRAWING NO.
8-721B.01

B.SCAN NO.
S-722.01


80 of 123

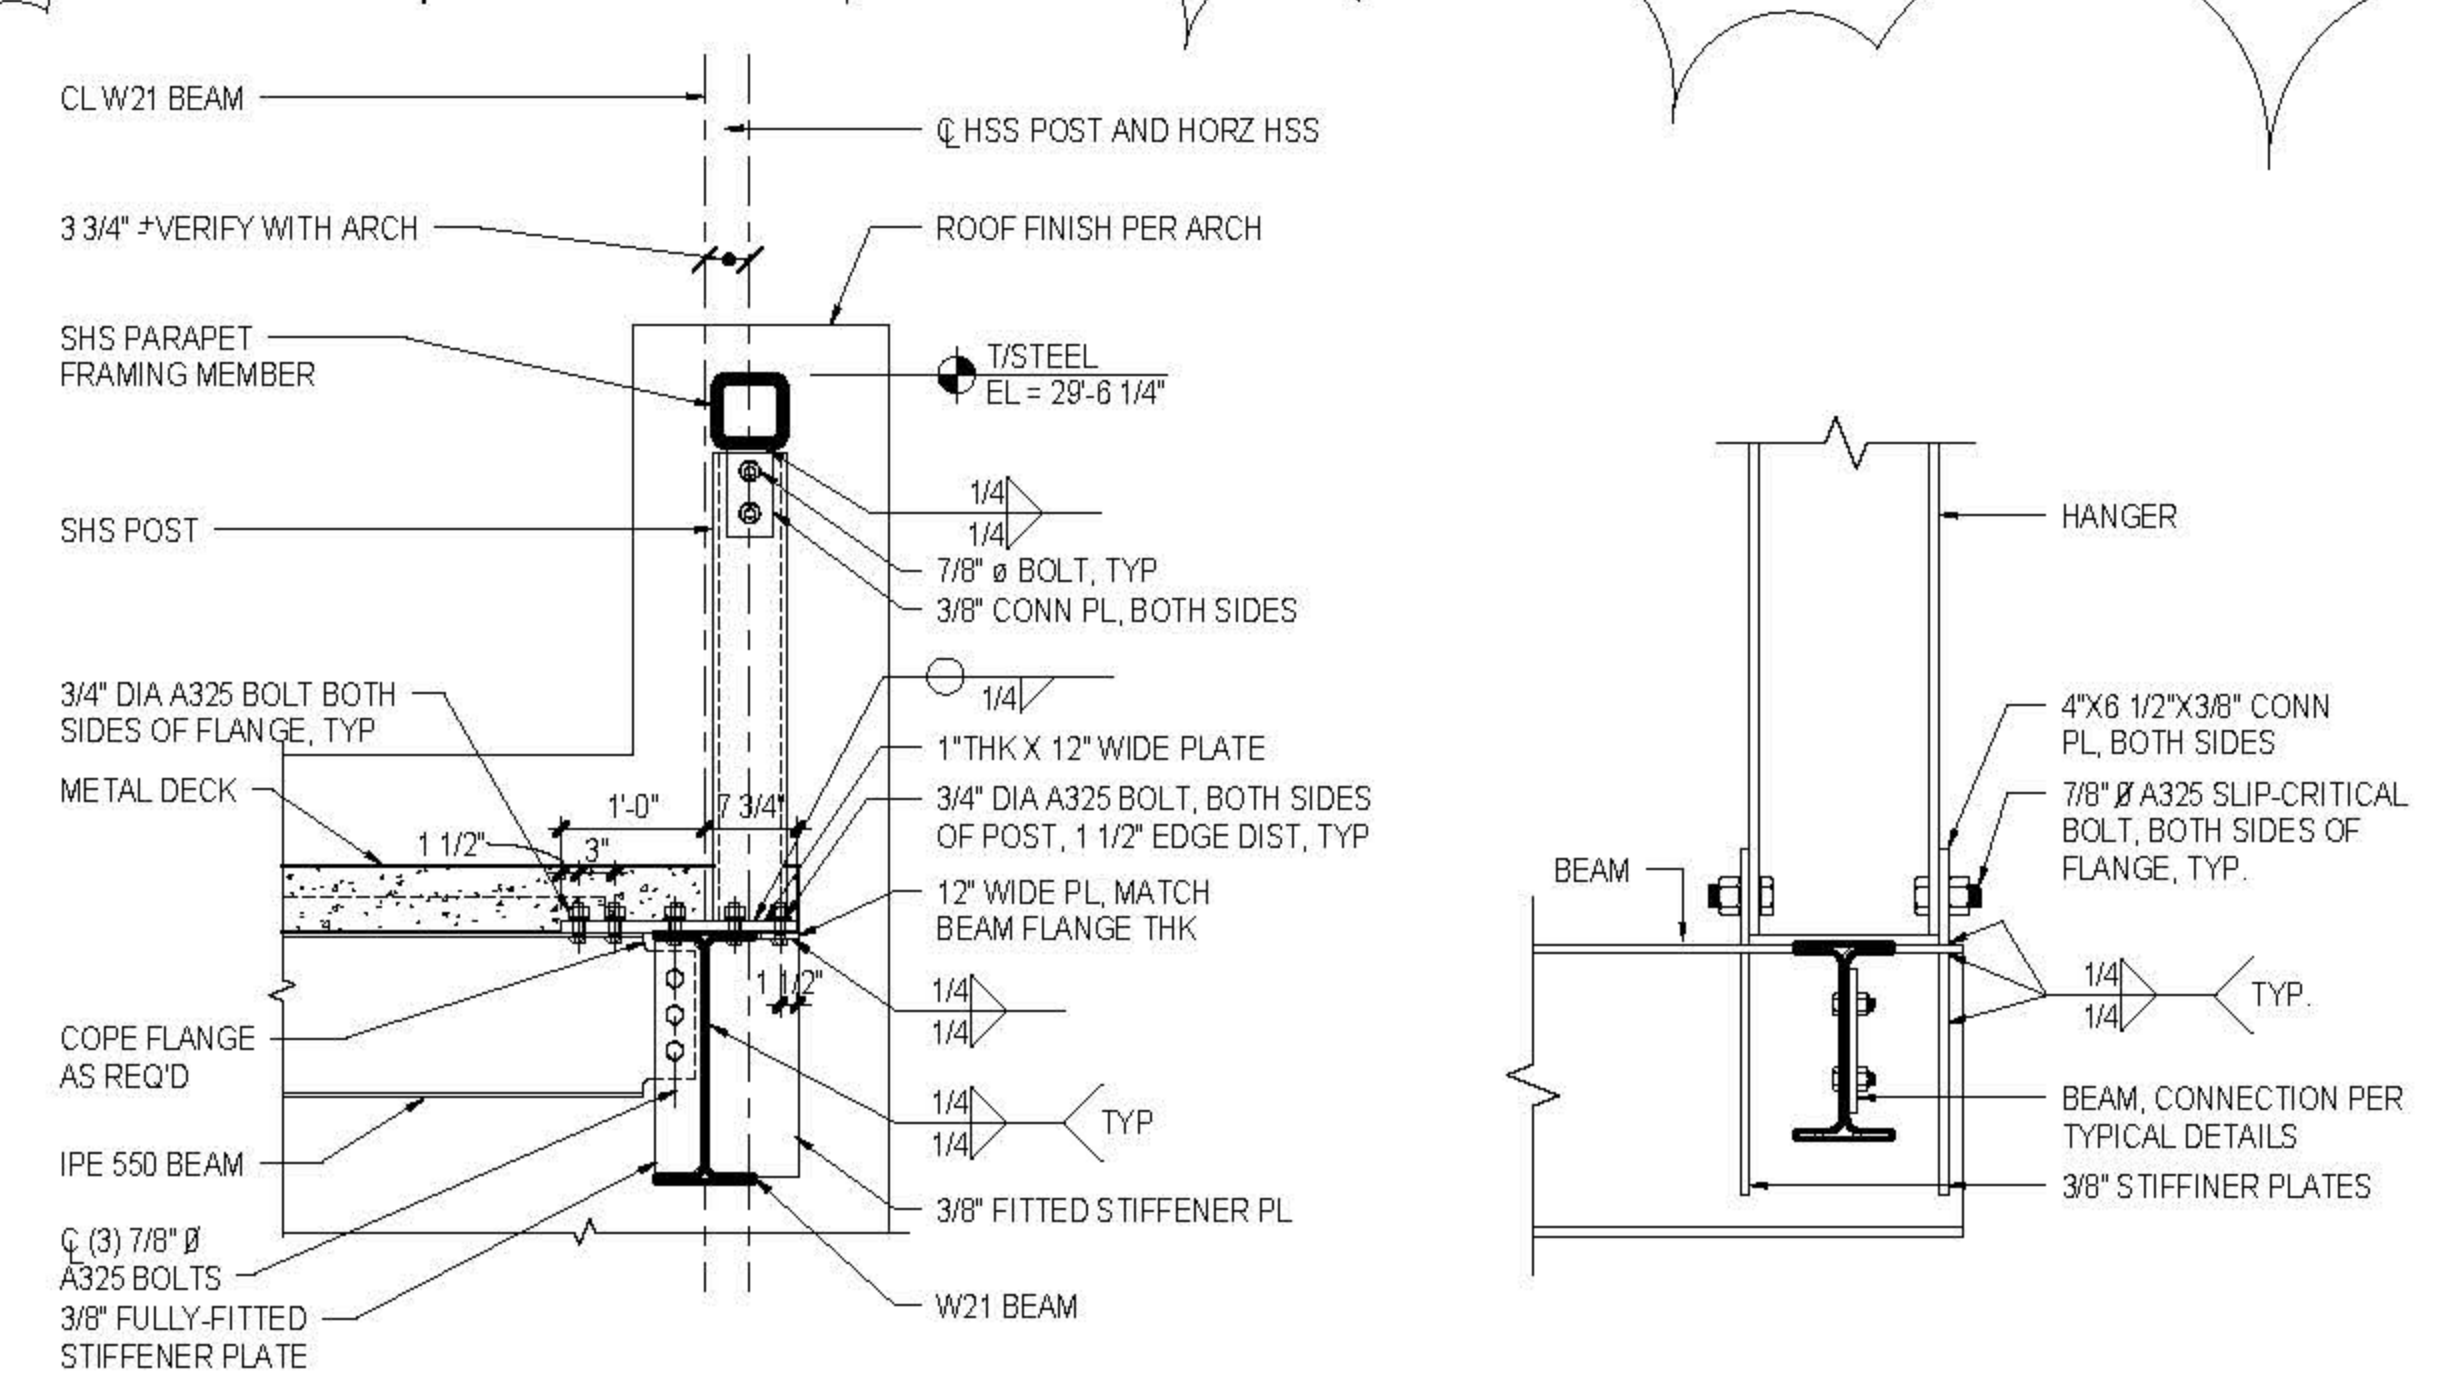


1 EAST PARAPET SHS CONN TO SHS POST
1/4" = 1'-0"

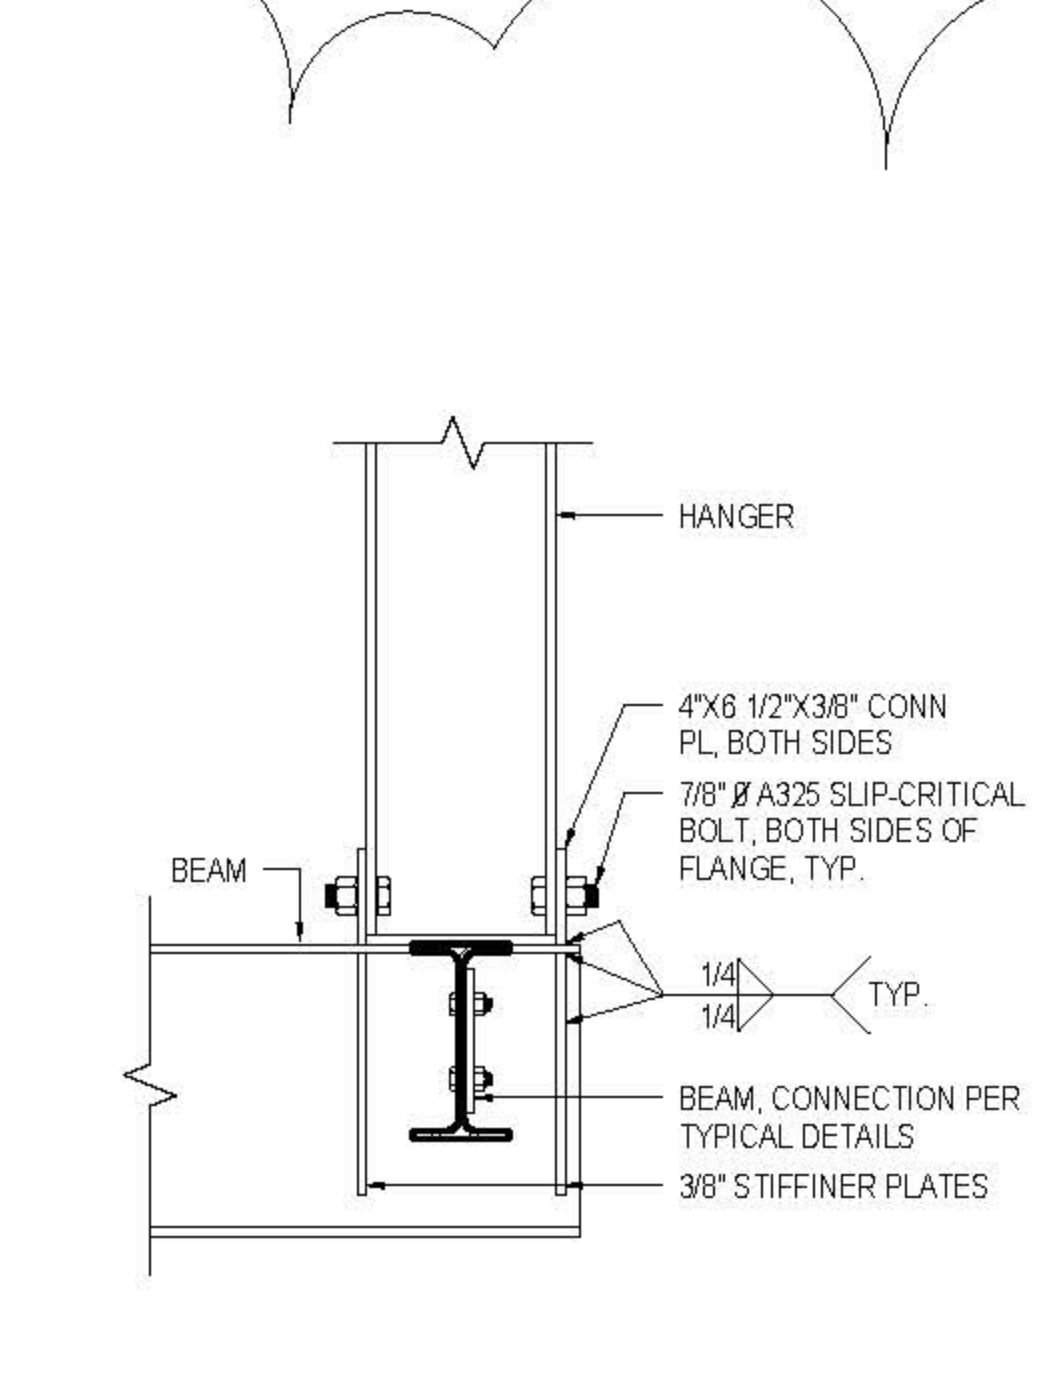


2 SECTION AT WF HANGER
1 1/2" = 1'-0"

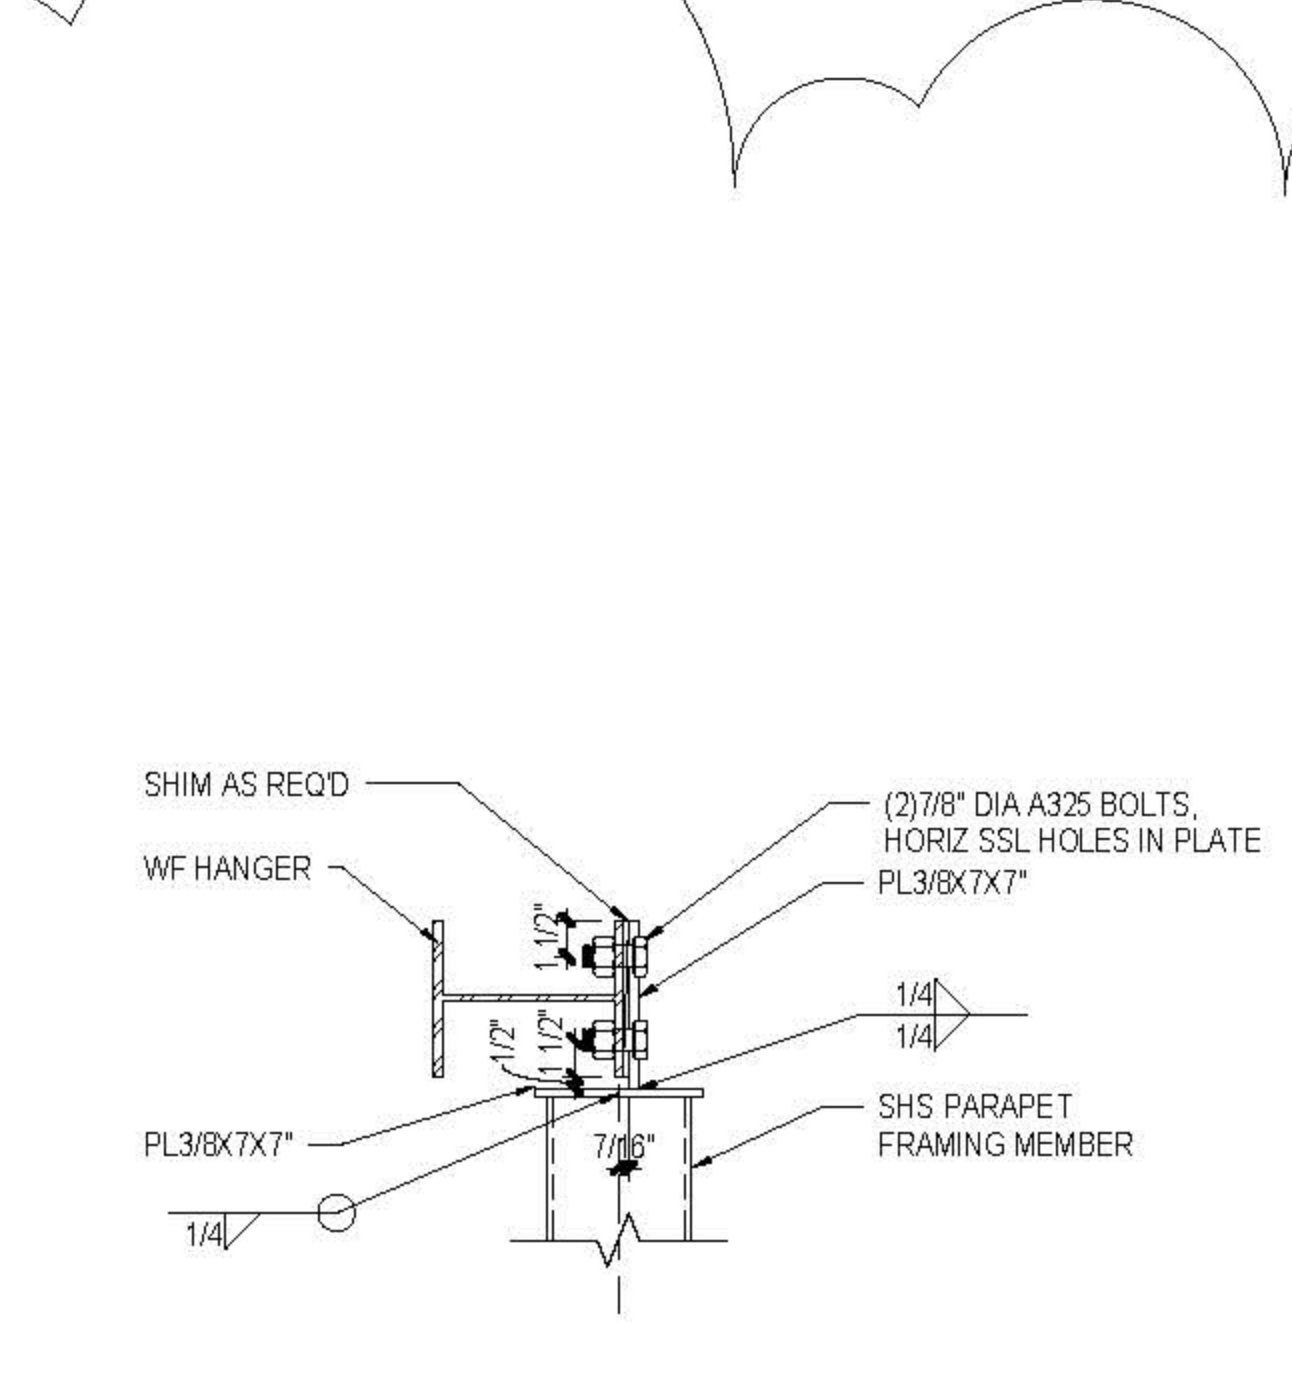


3 EAST PARAPET CONN TO WF HANGER
1 1/2" = 1'-0"

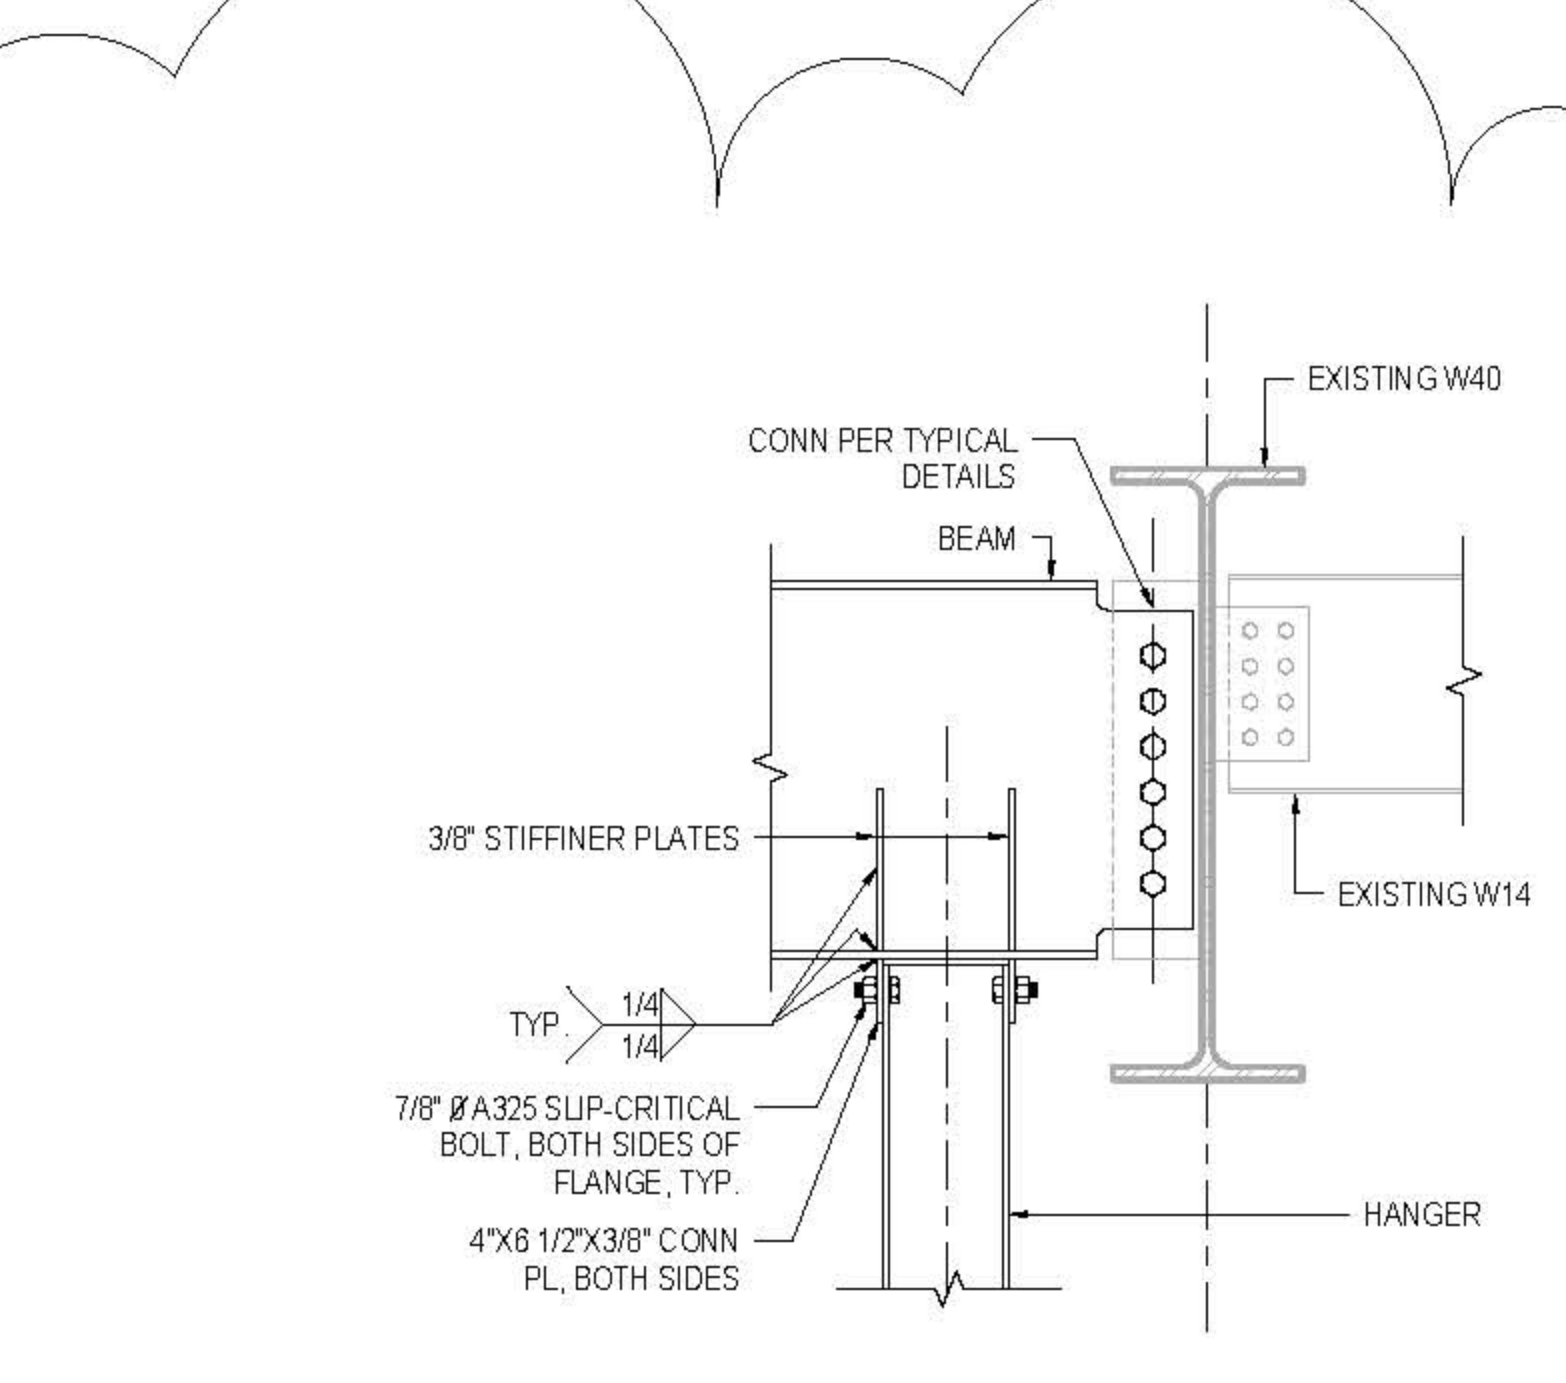


4 SECTION AT WF HANGER
1" = 1'-0"

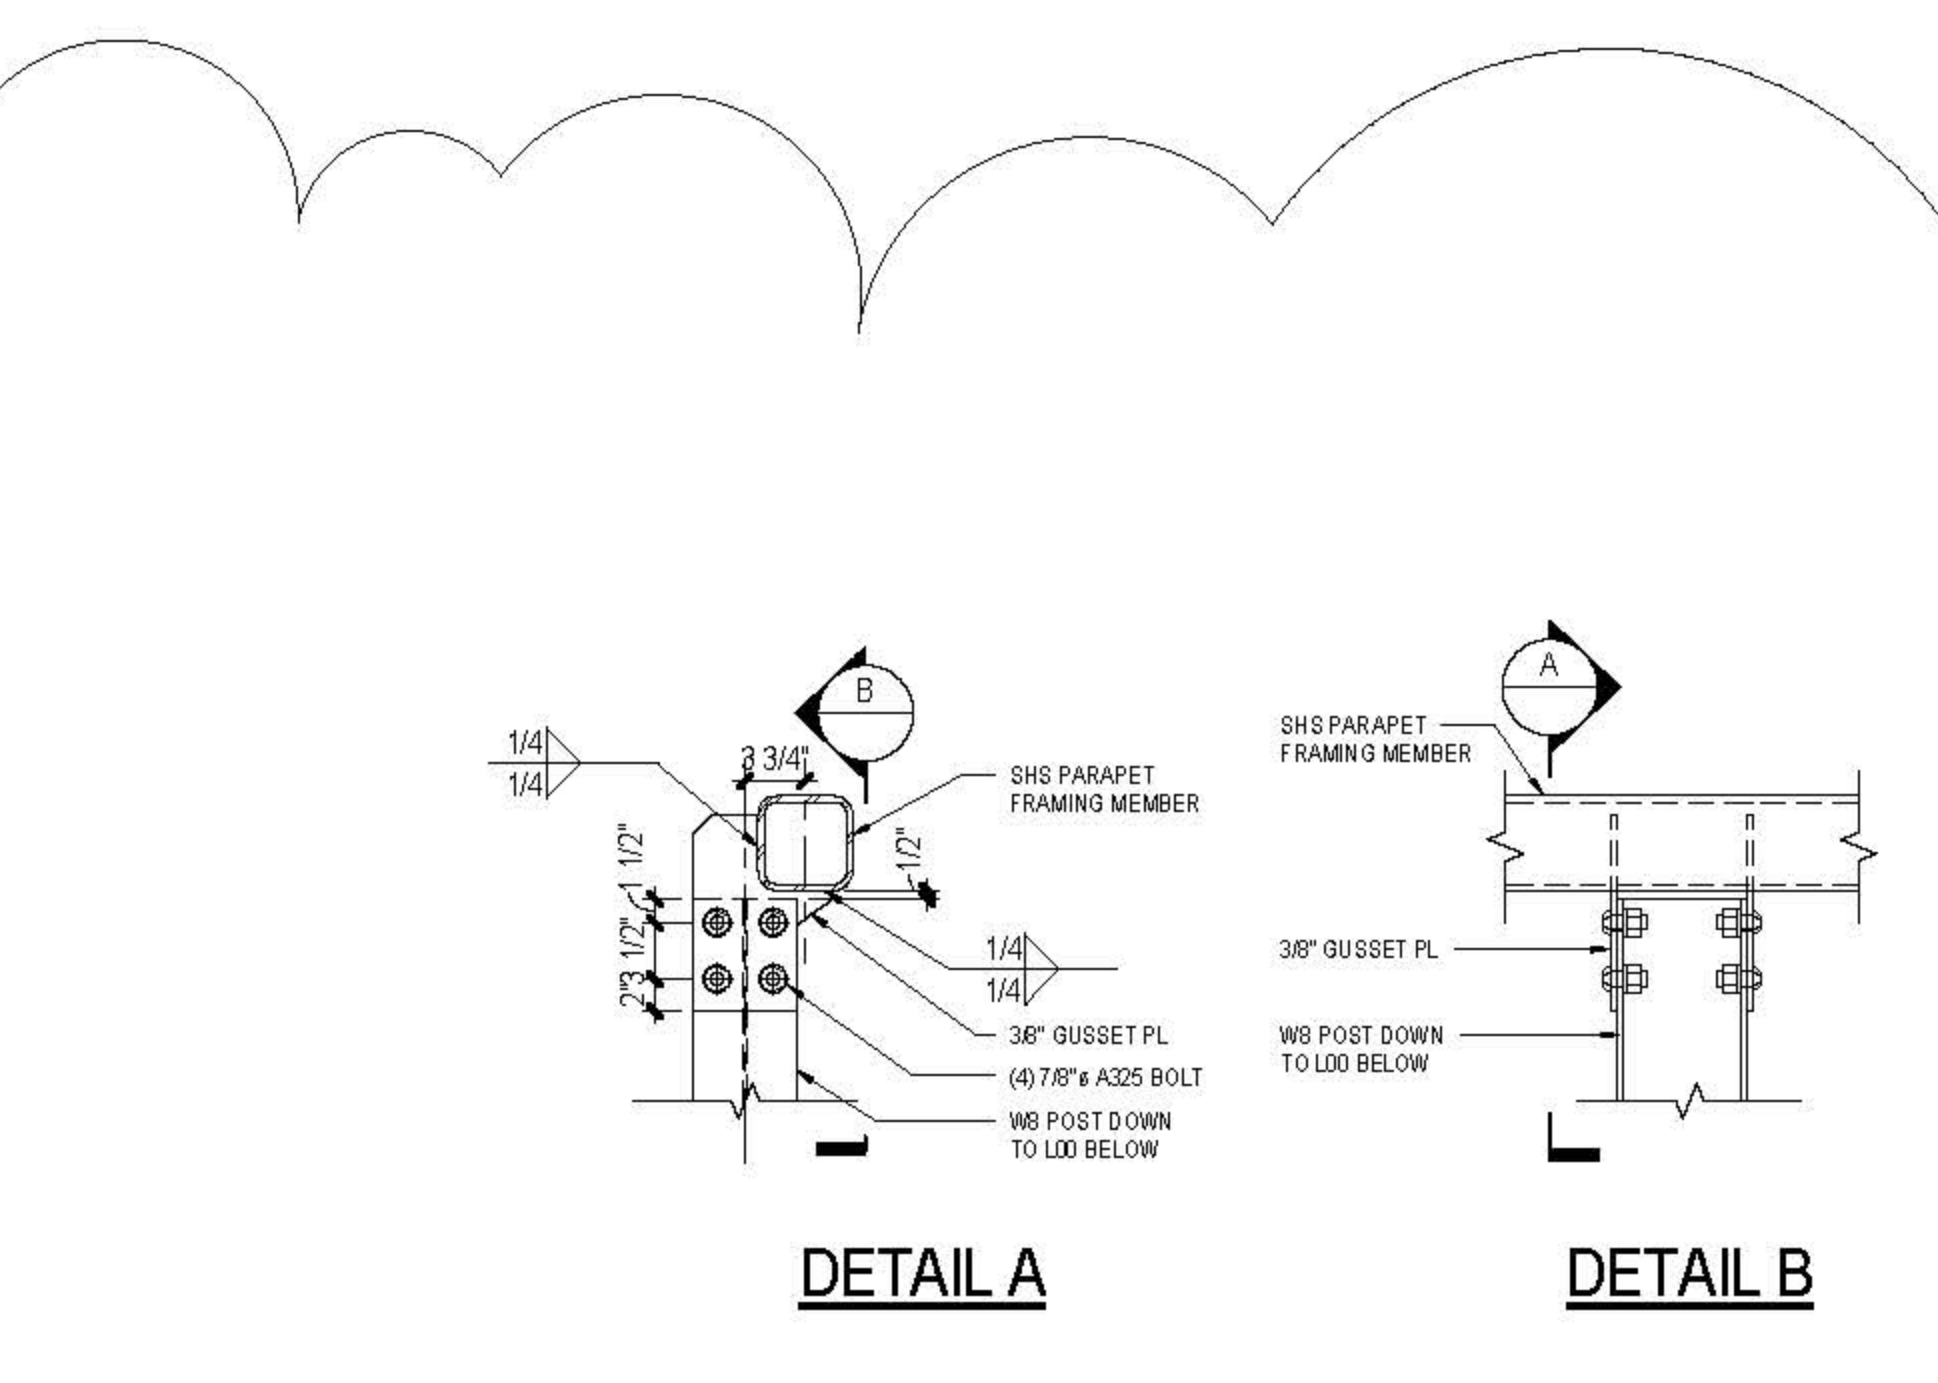


5 EAST PARAPET SHS CONN TO W8 COLUMN
1" = 1'-0"

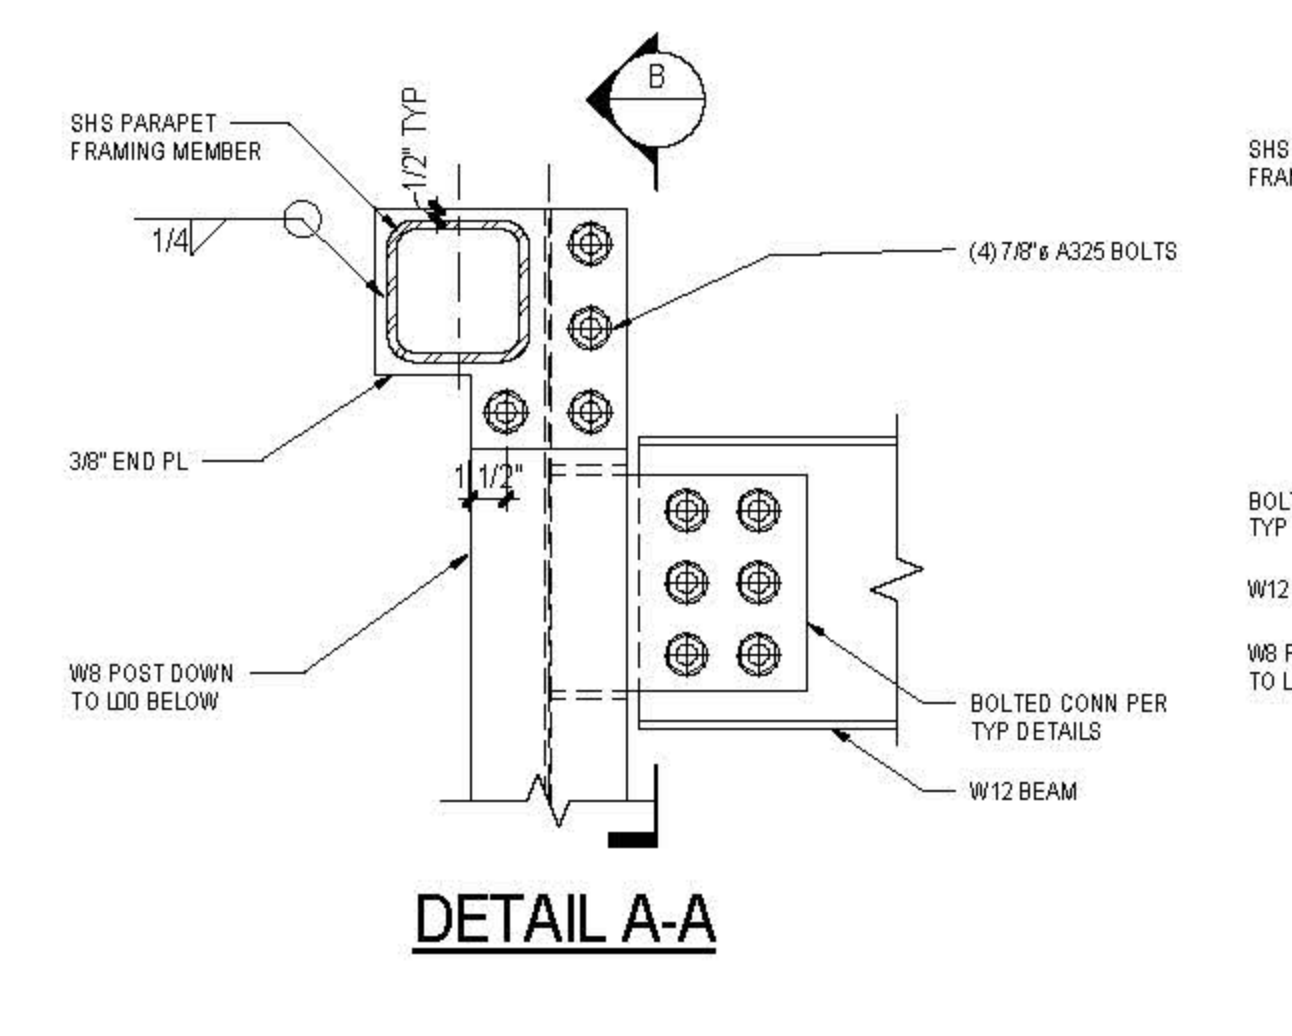


6 EAST PARAPET CONN TO WF HANGER
1 1/2" = 1'-0"

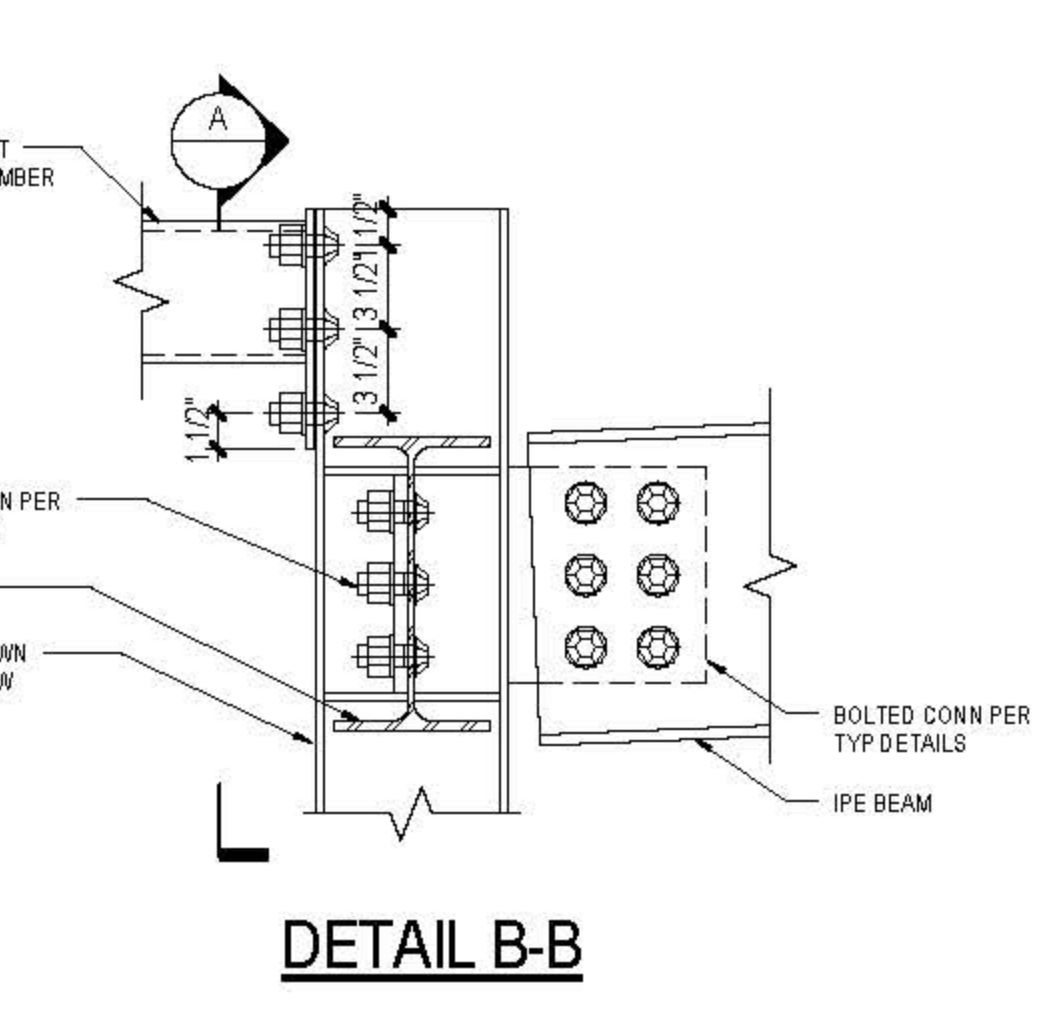


7 WEST LOBBY ROOF FRAMING ELEVATION
1/2" = 1'-0"

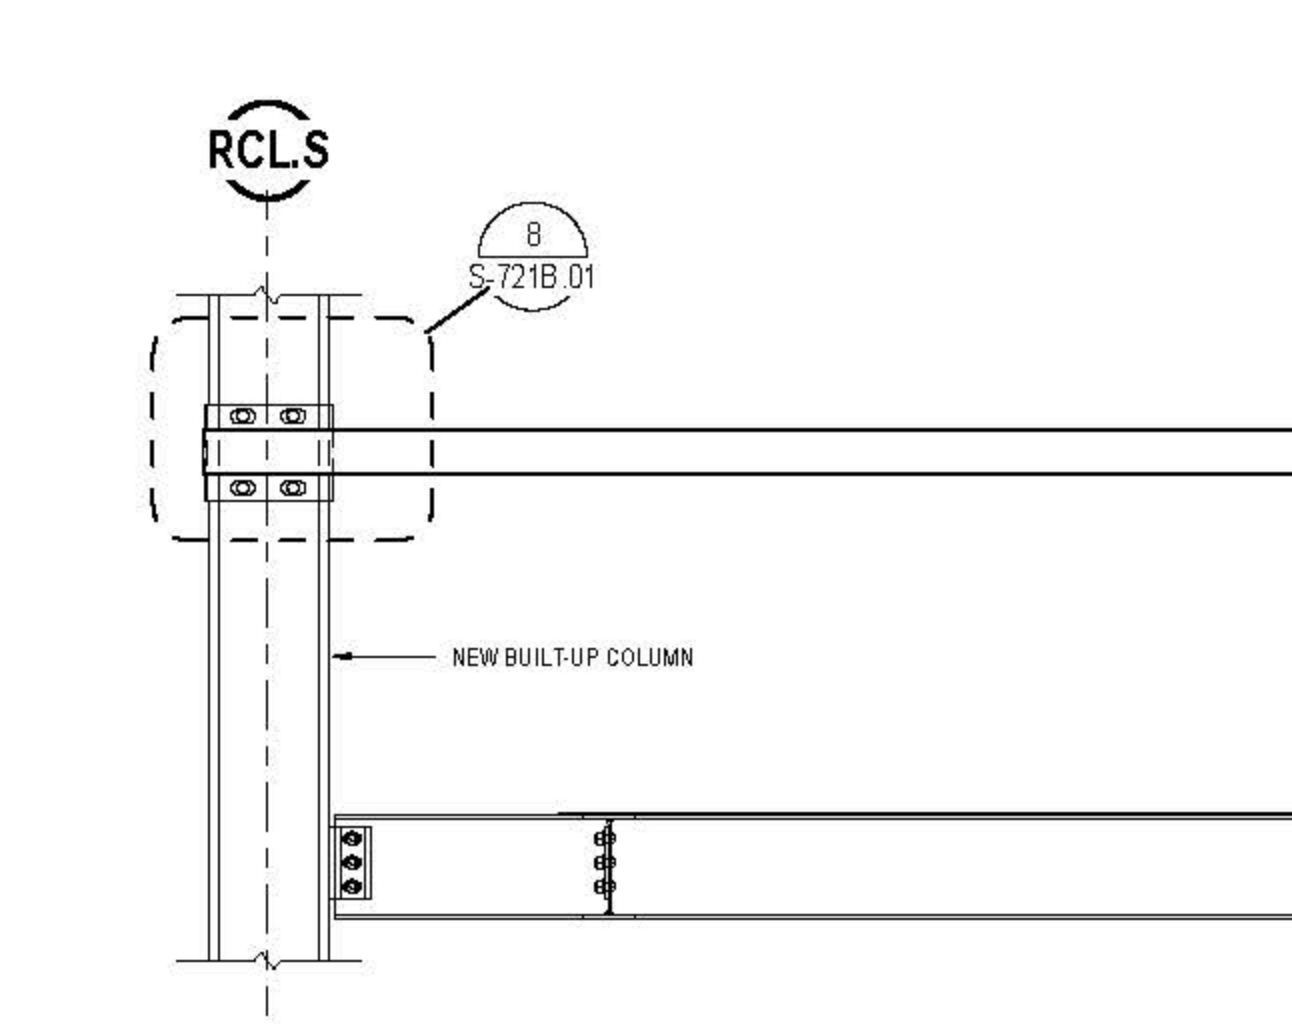


8 PARAPET SHS CONN TO BUILT-UP COLUMN
1" = 1'-0"

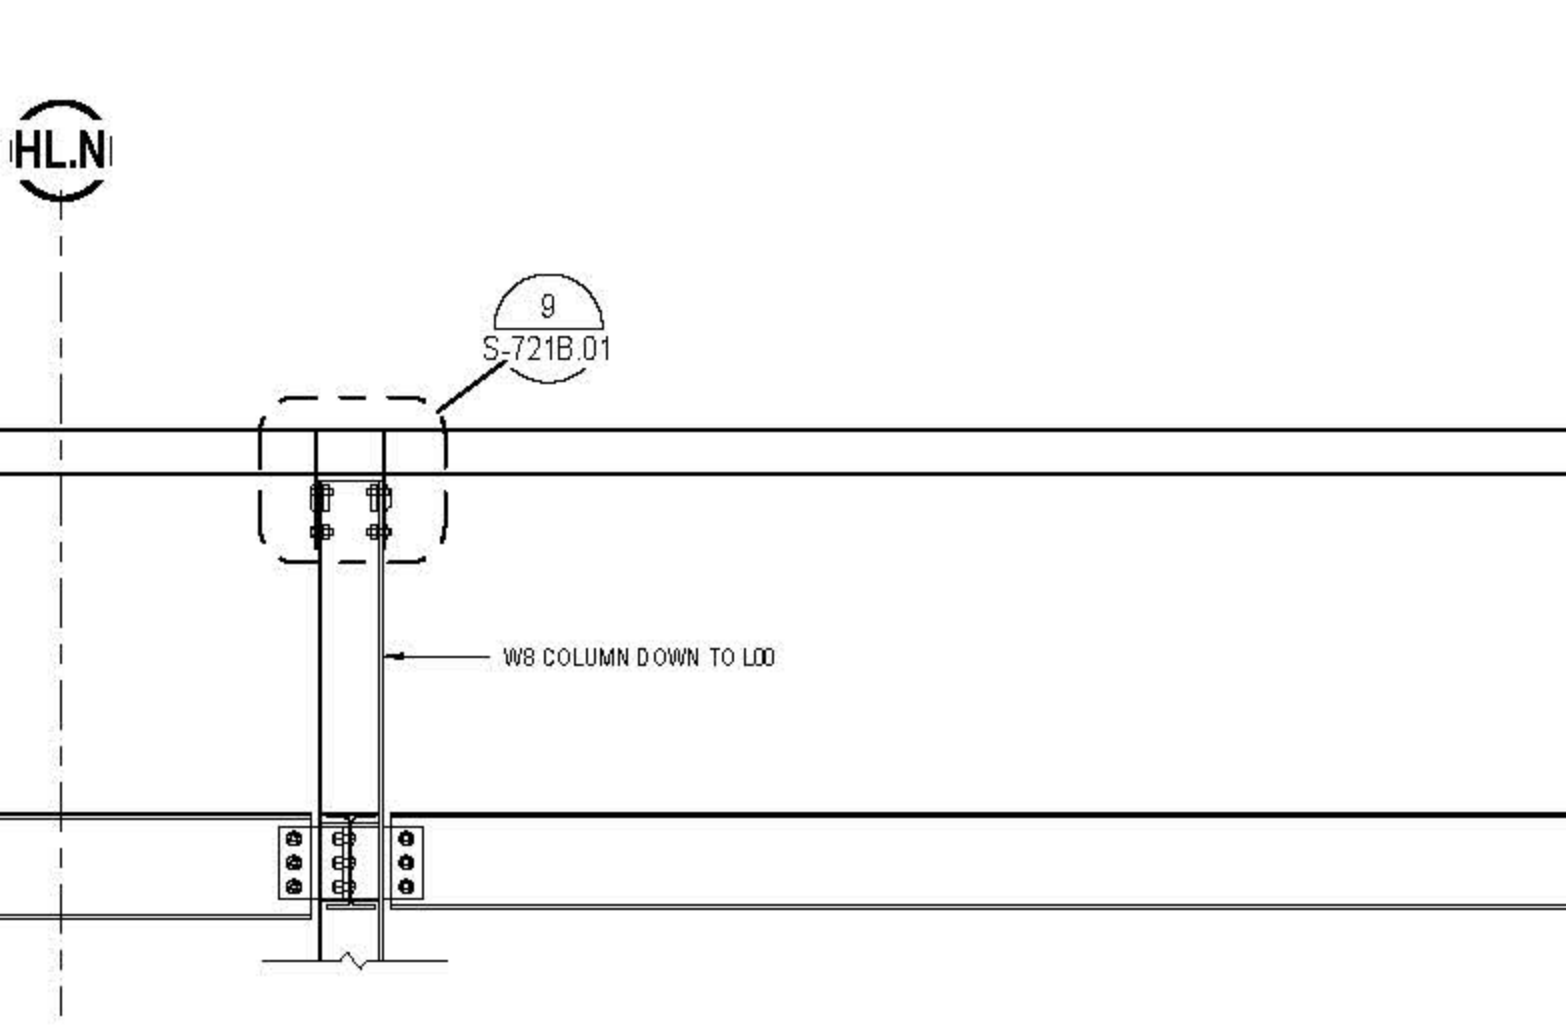


9 PARAPET SHS CONN TO W8 COLUMN
1" = 1'-0"

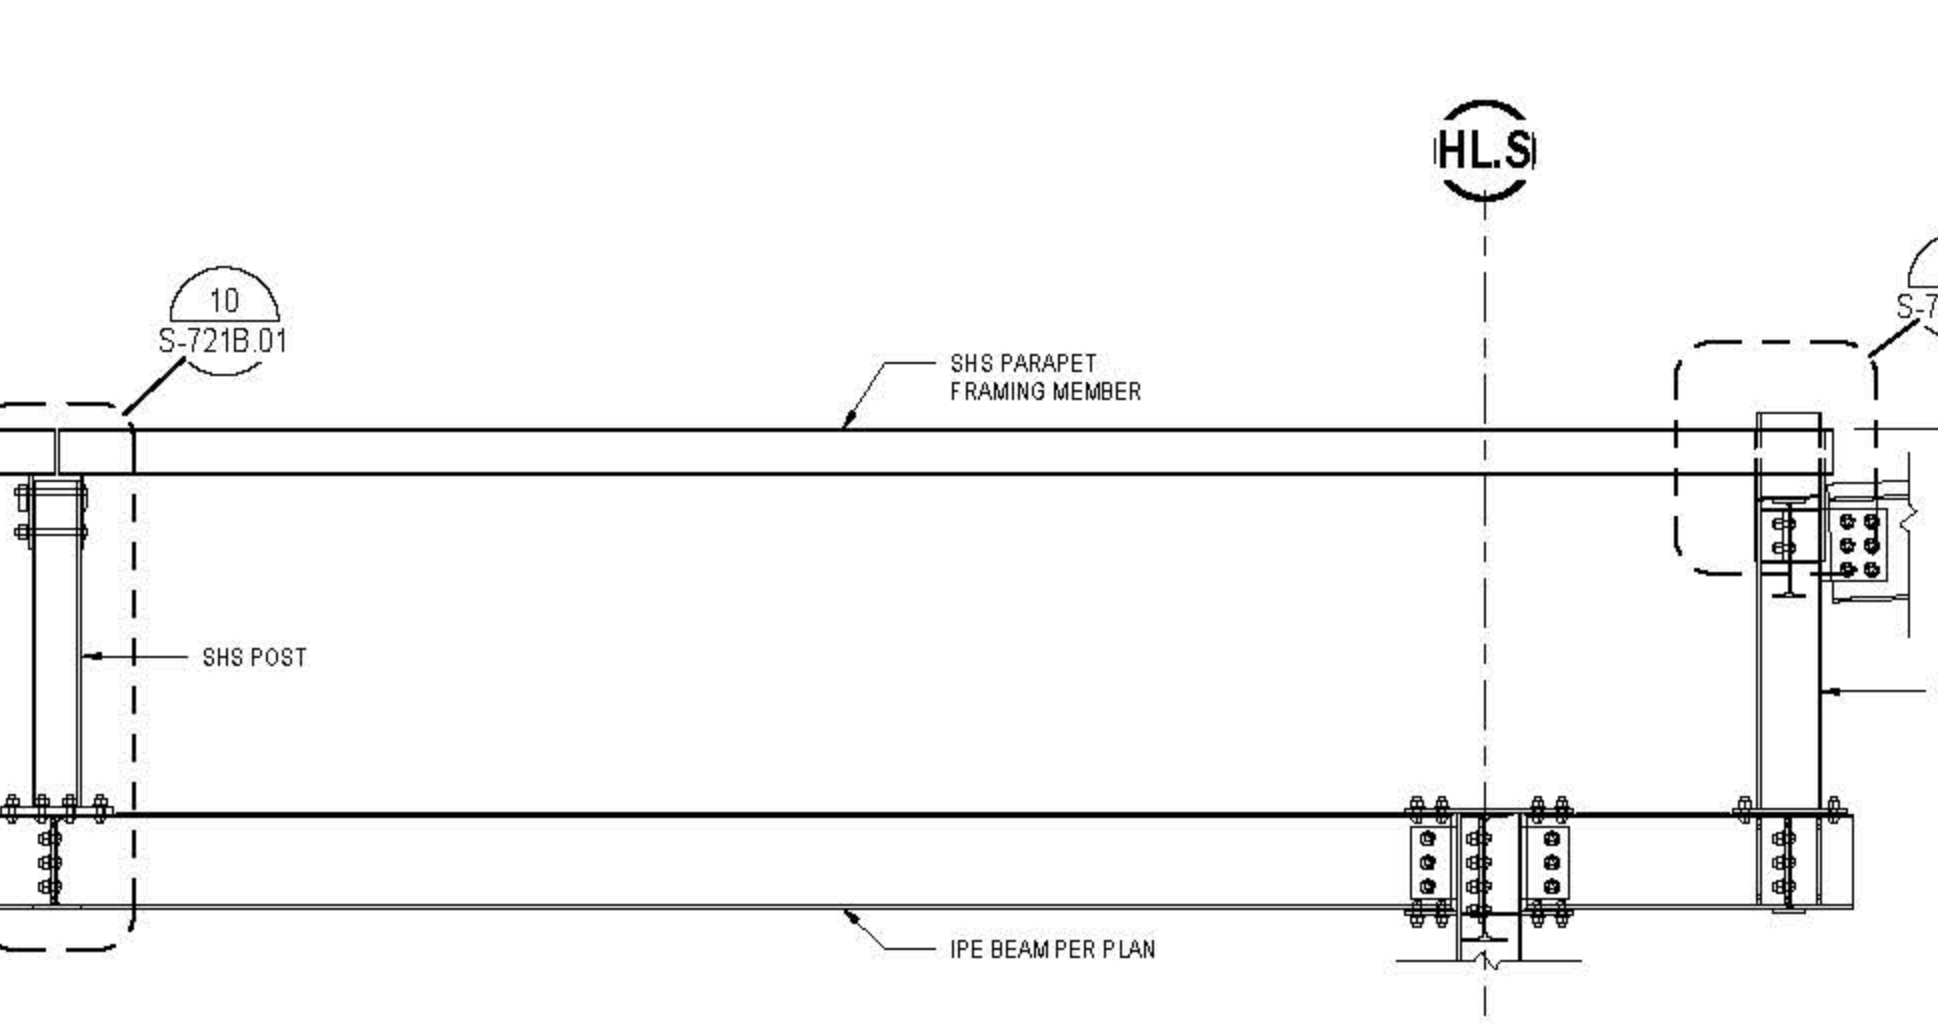


10 PARAPET SHS CONN TO SHS POST
1" = 1'-0"

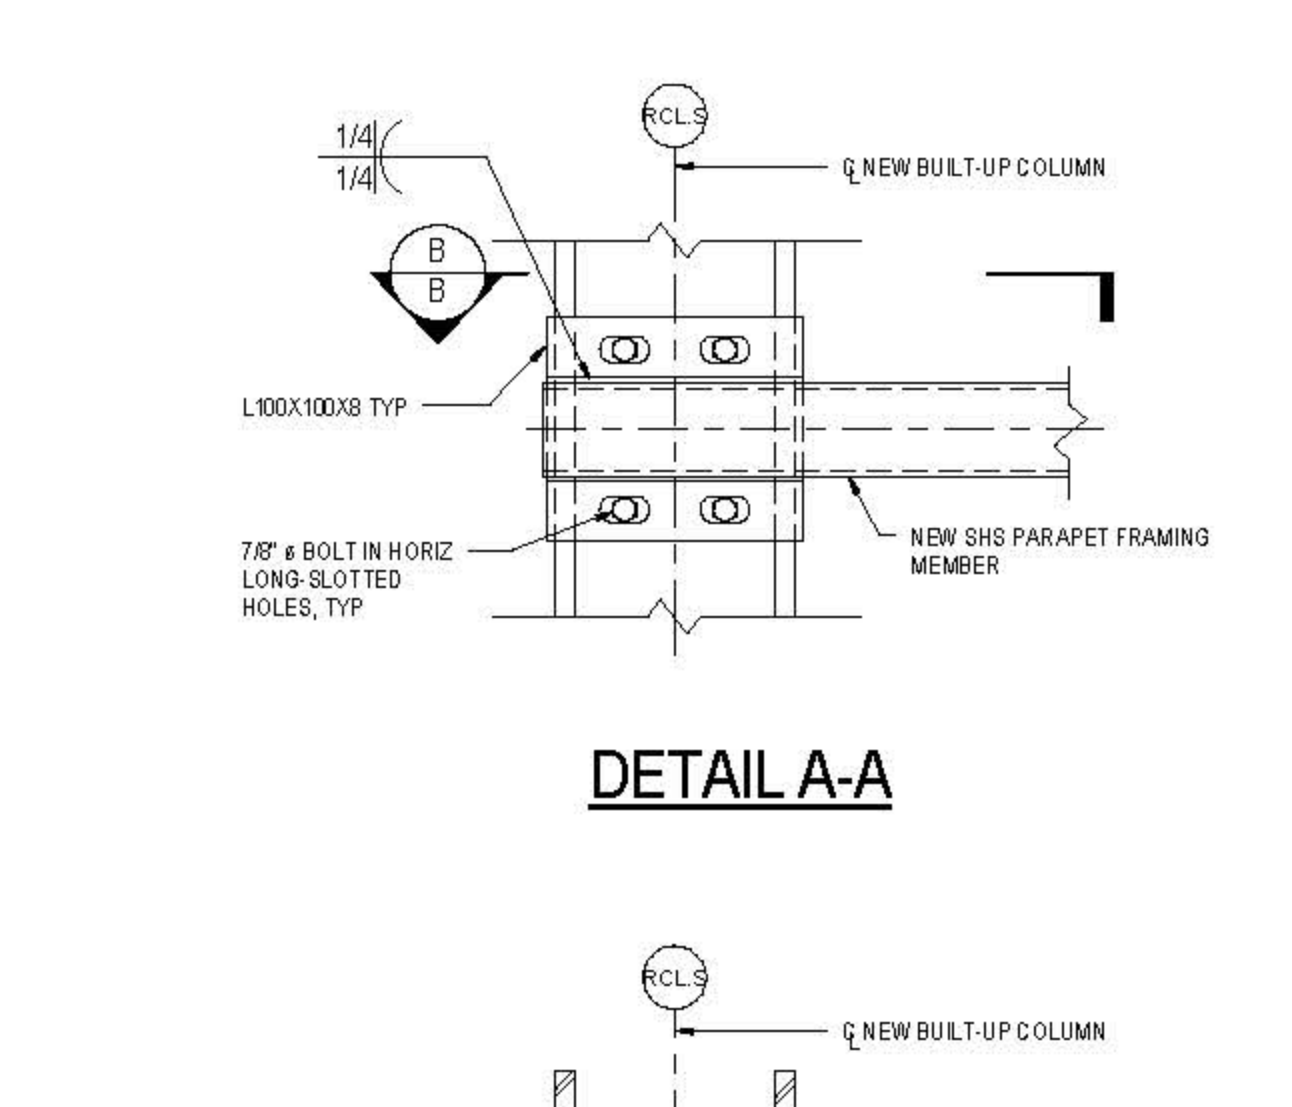


11 PARAPET SHS CONN TO W8 POST
1" = 1'-0"

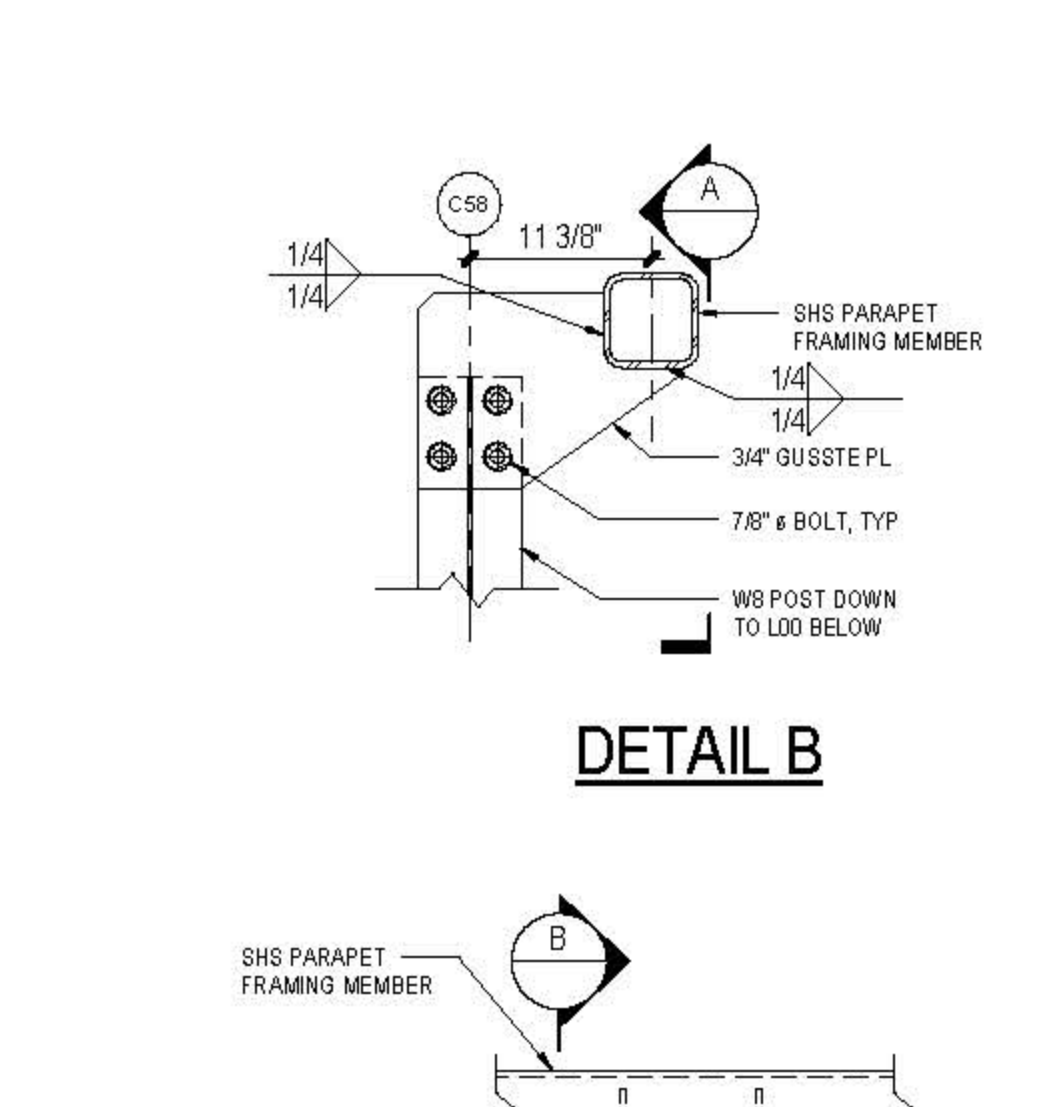


12 PARAPET SHS CONN TO BUILT-UP COLUMN
1" = 1'-0"

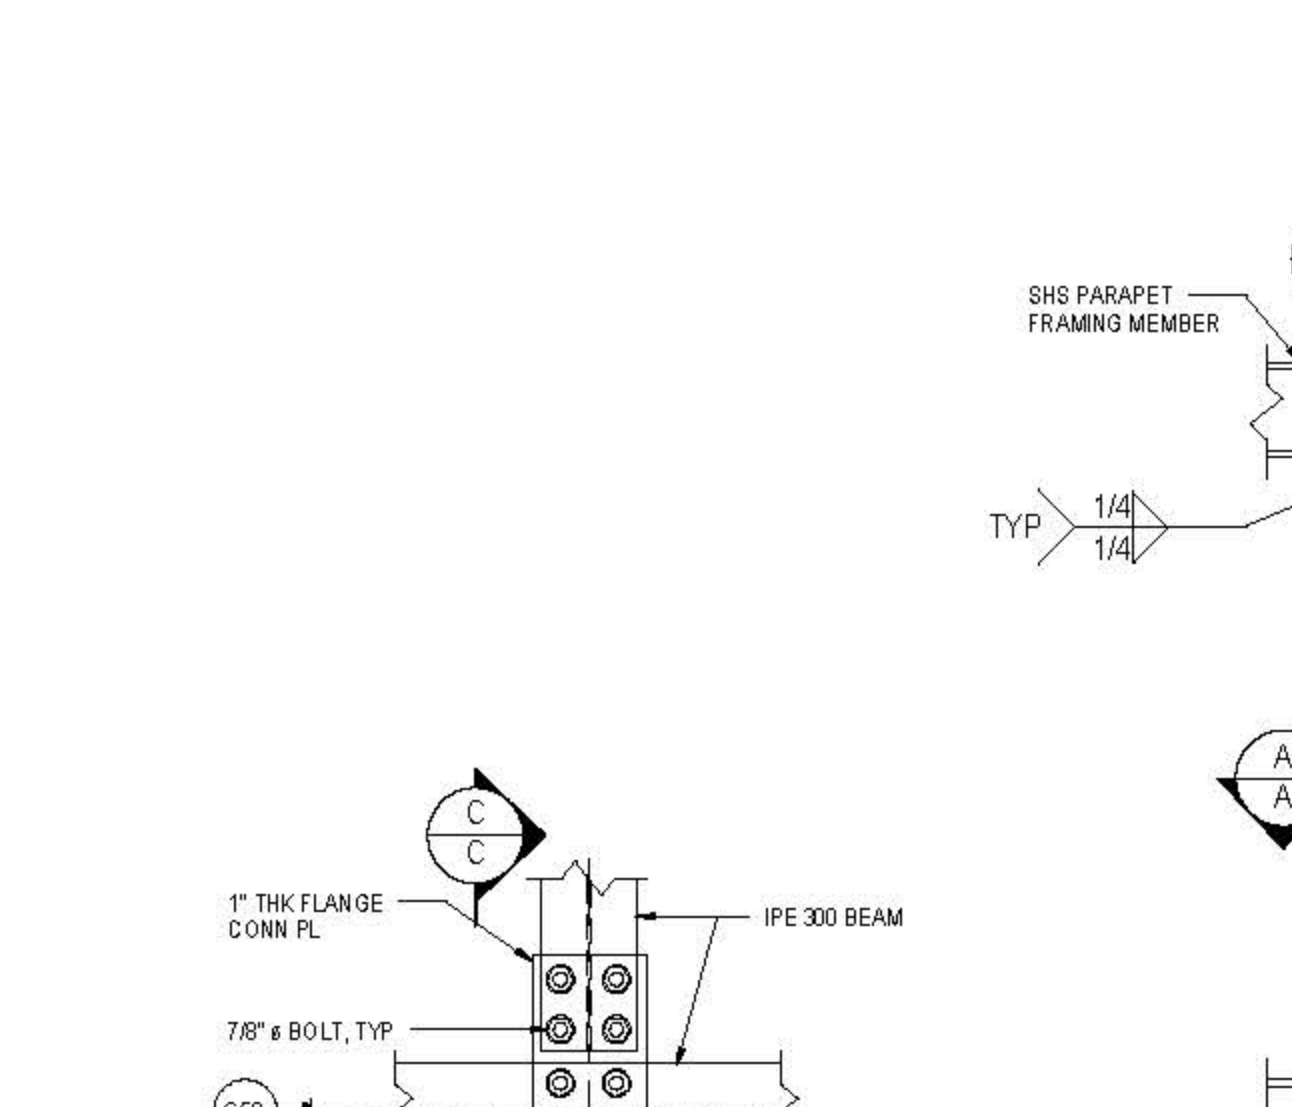


13 PARAPET SHS CONN TO W8 COLUMN
1" = 1'-0"

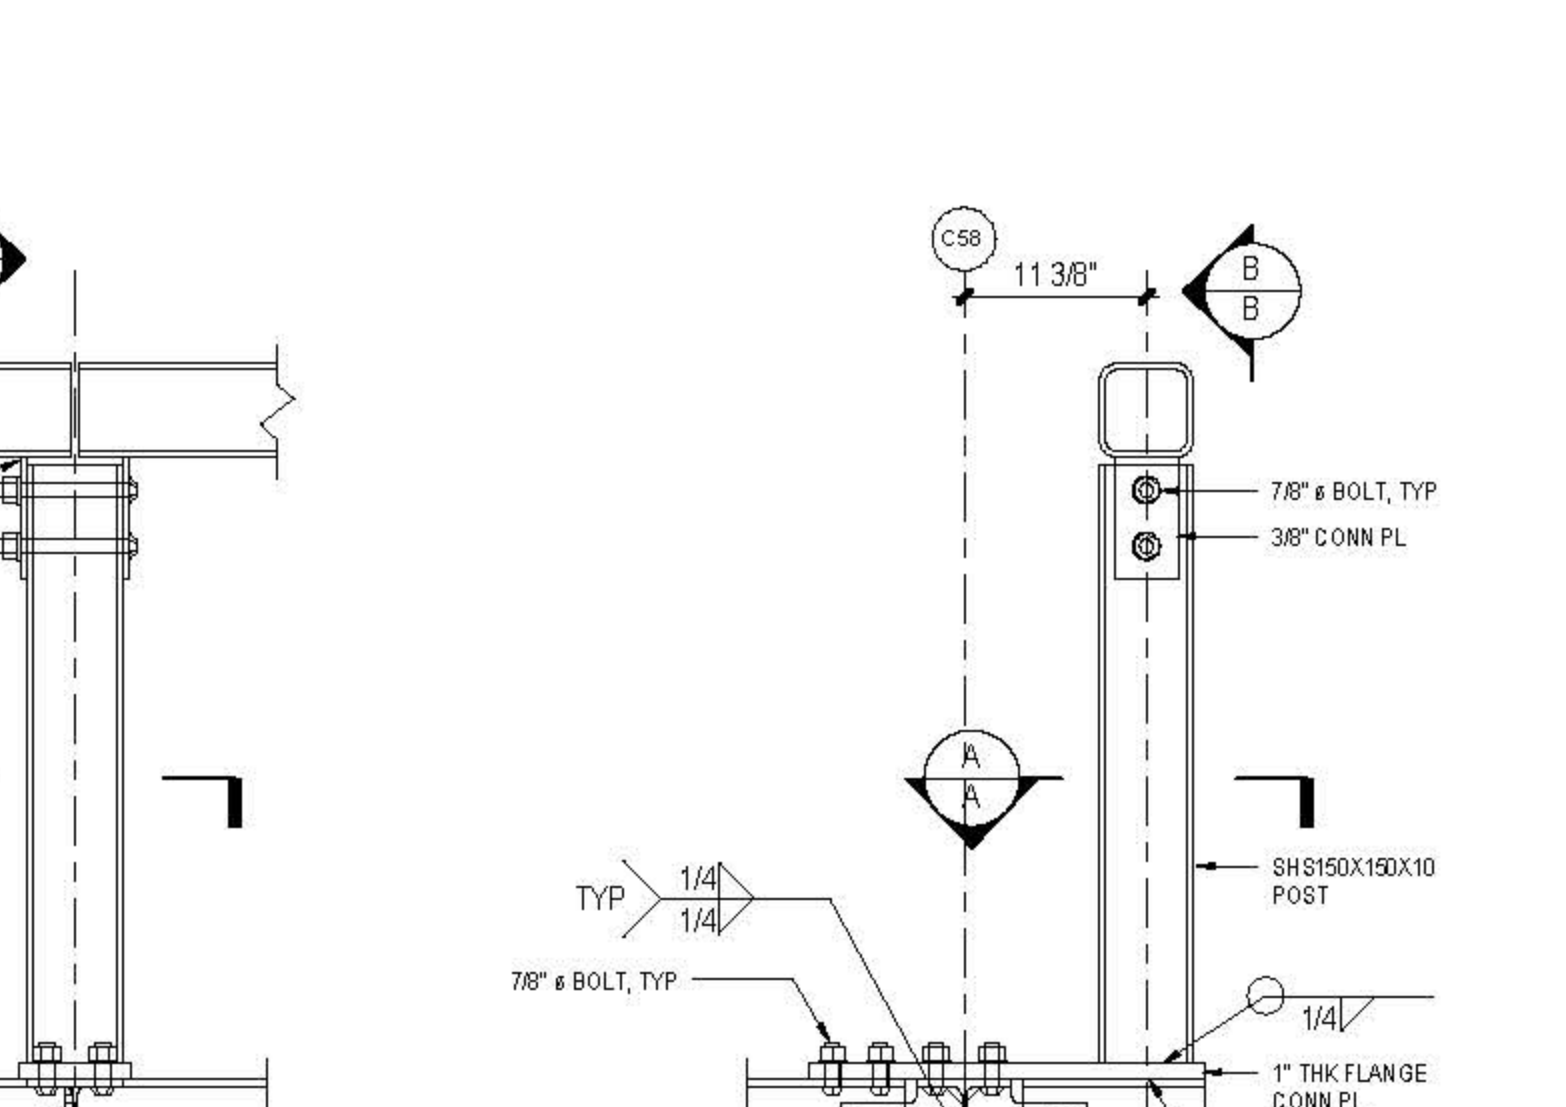

14 PARAPET SHS CONN TO SHS POST
1" = 1'-0"

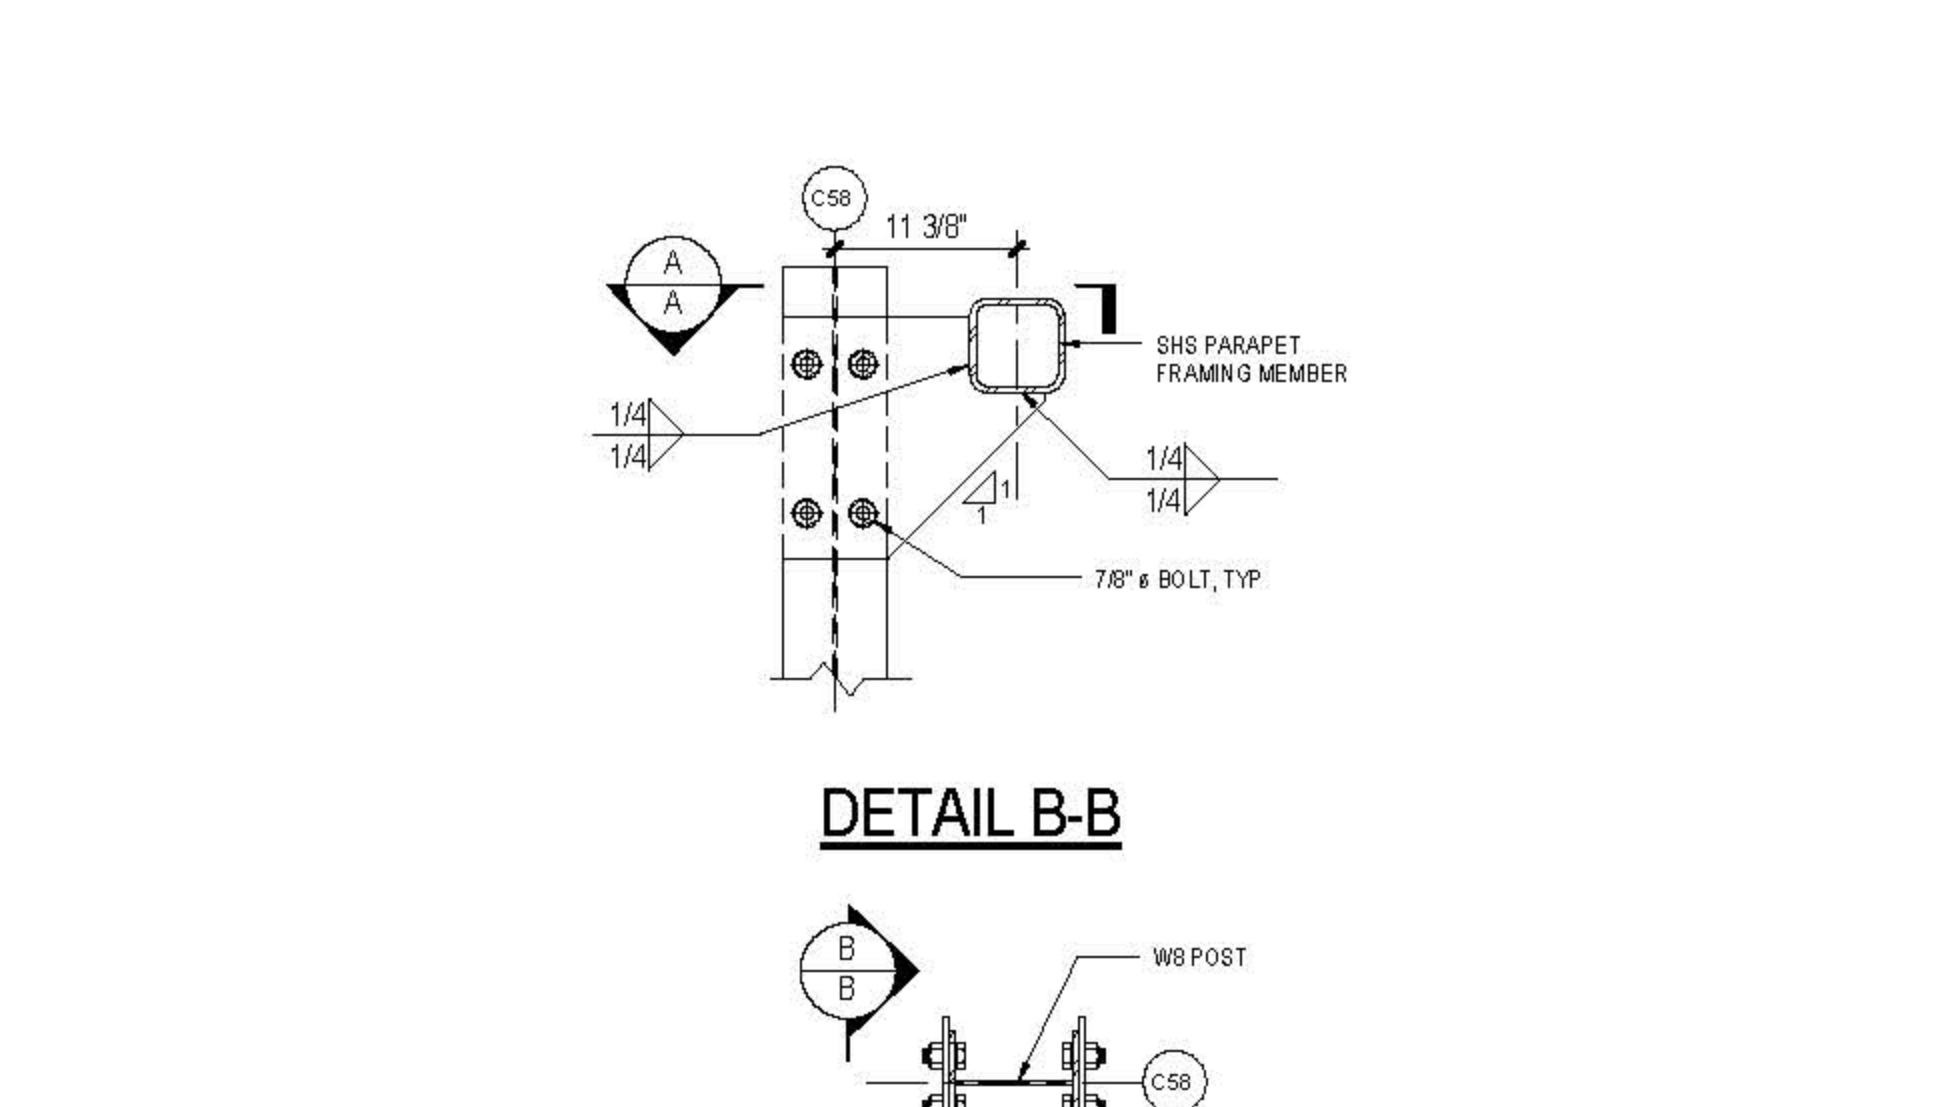

15 PARAPET SHS CONN TO W8 POST
1" = 1'-0"

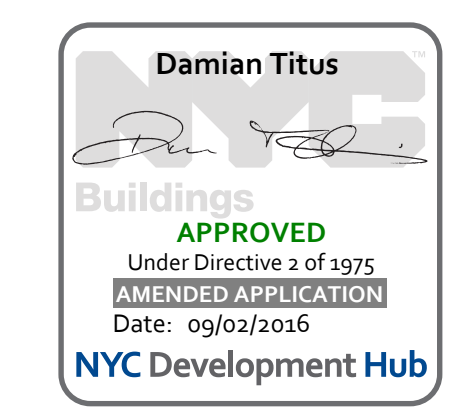

CULTURE SHED

540 West 30th Street
New York, New York 10001

OWNER
CULTURE SHED INC.

ARCHITECTS
Olin Scaletto + Renfro Architects, DPC
601 West 20th Street #815
New York, New York 10001
T: 212.263.7971

STRUCTURAL ENGINEER
Thornton Tomasetti
51 Madison Avenue
New York, New York 10010
T: 917.861.7800
F: 917.861.7801

MEP ENGINEER
Jana Baum & Bolles
63 Park Street
New York, New York 10005
T: 212.530.9300
F: 212.265.6564

MEP ENGINEER
Jana Baum & Bolles
63 Park Street
New York, New York 10005
T: 212.530.9300
F: 212.265.6564


MEP ENGINEER
Jana Baum & Bolles
63 Park Street
New York, New York 10005
T: 212.530.9300
F: 212.265.6564

MEP ENGINEER
Jana Baum & Bolles
63 Park Street
New York, New York 10005
T: 212.530.9300
F: 212.265.6564
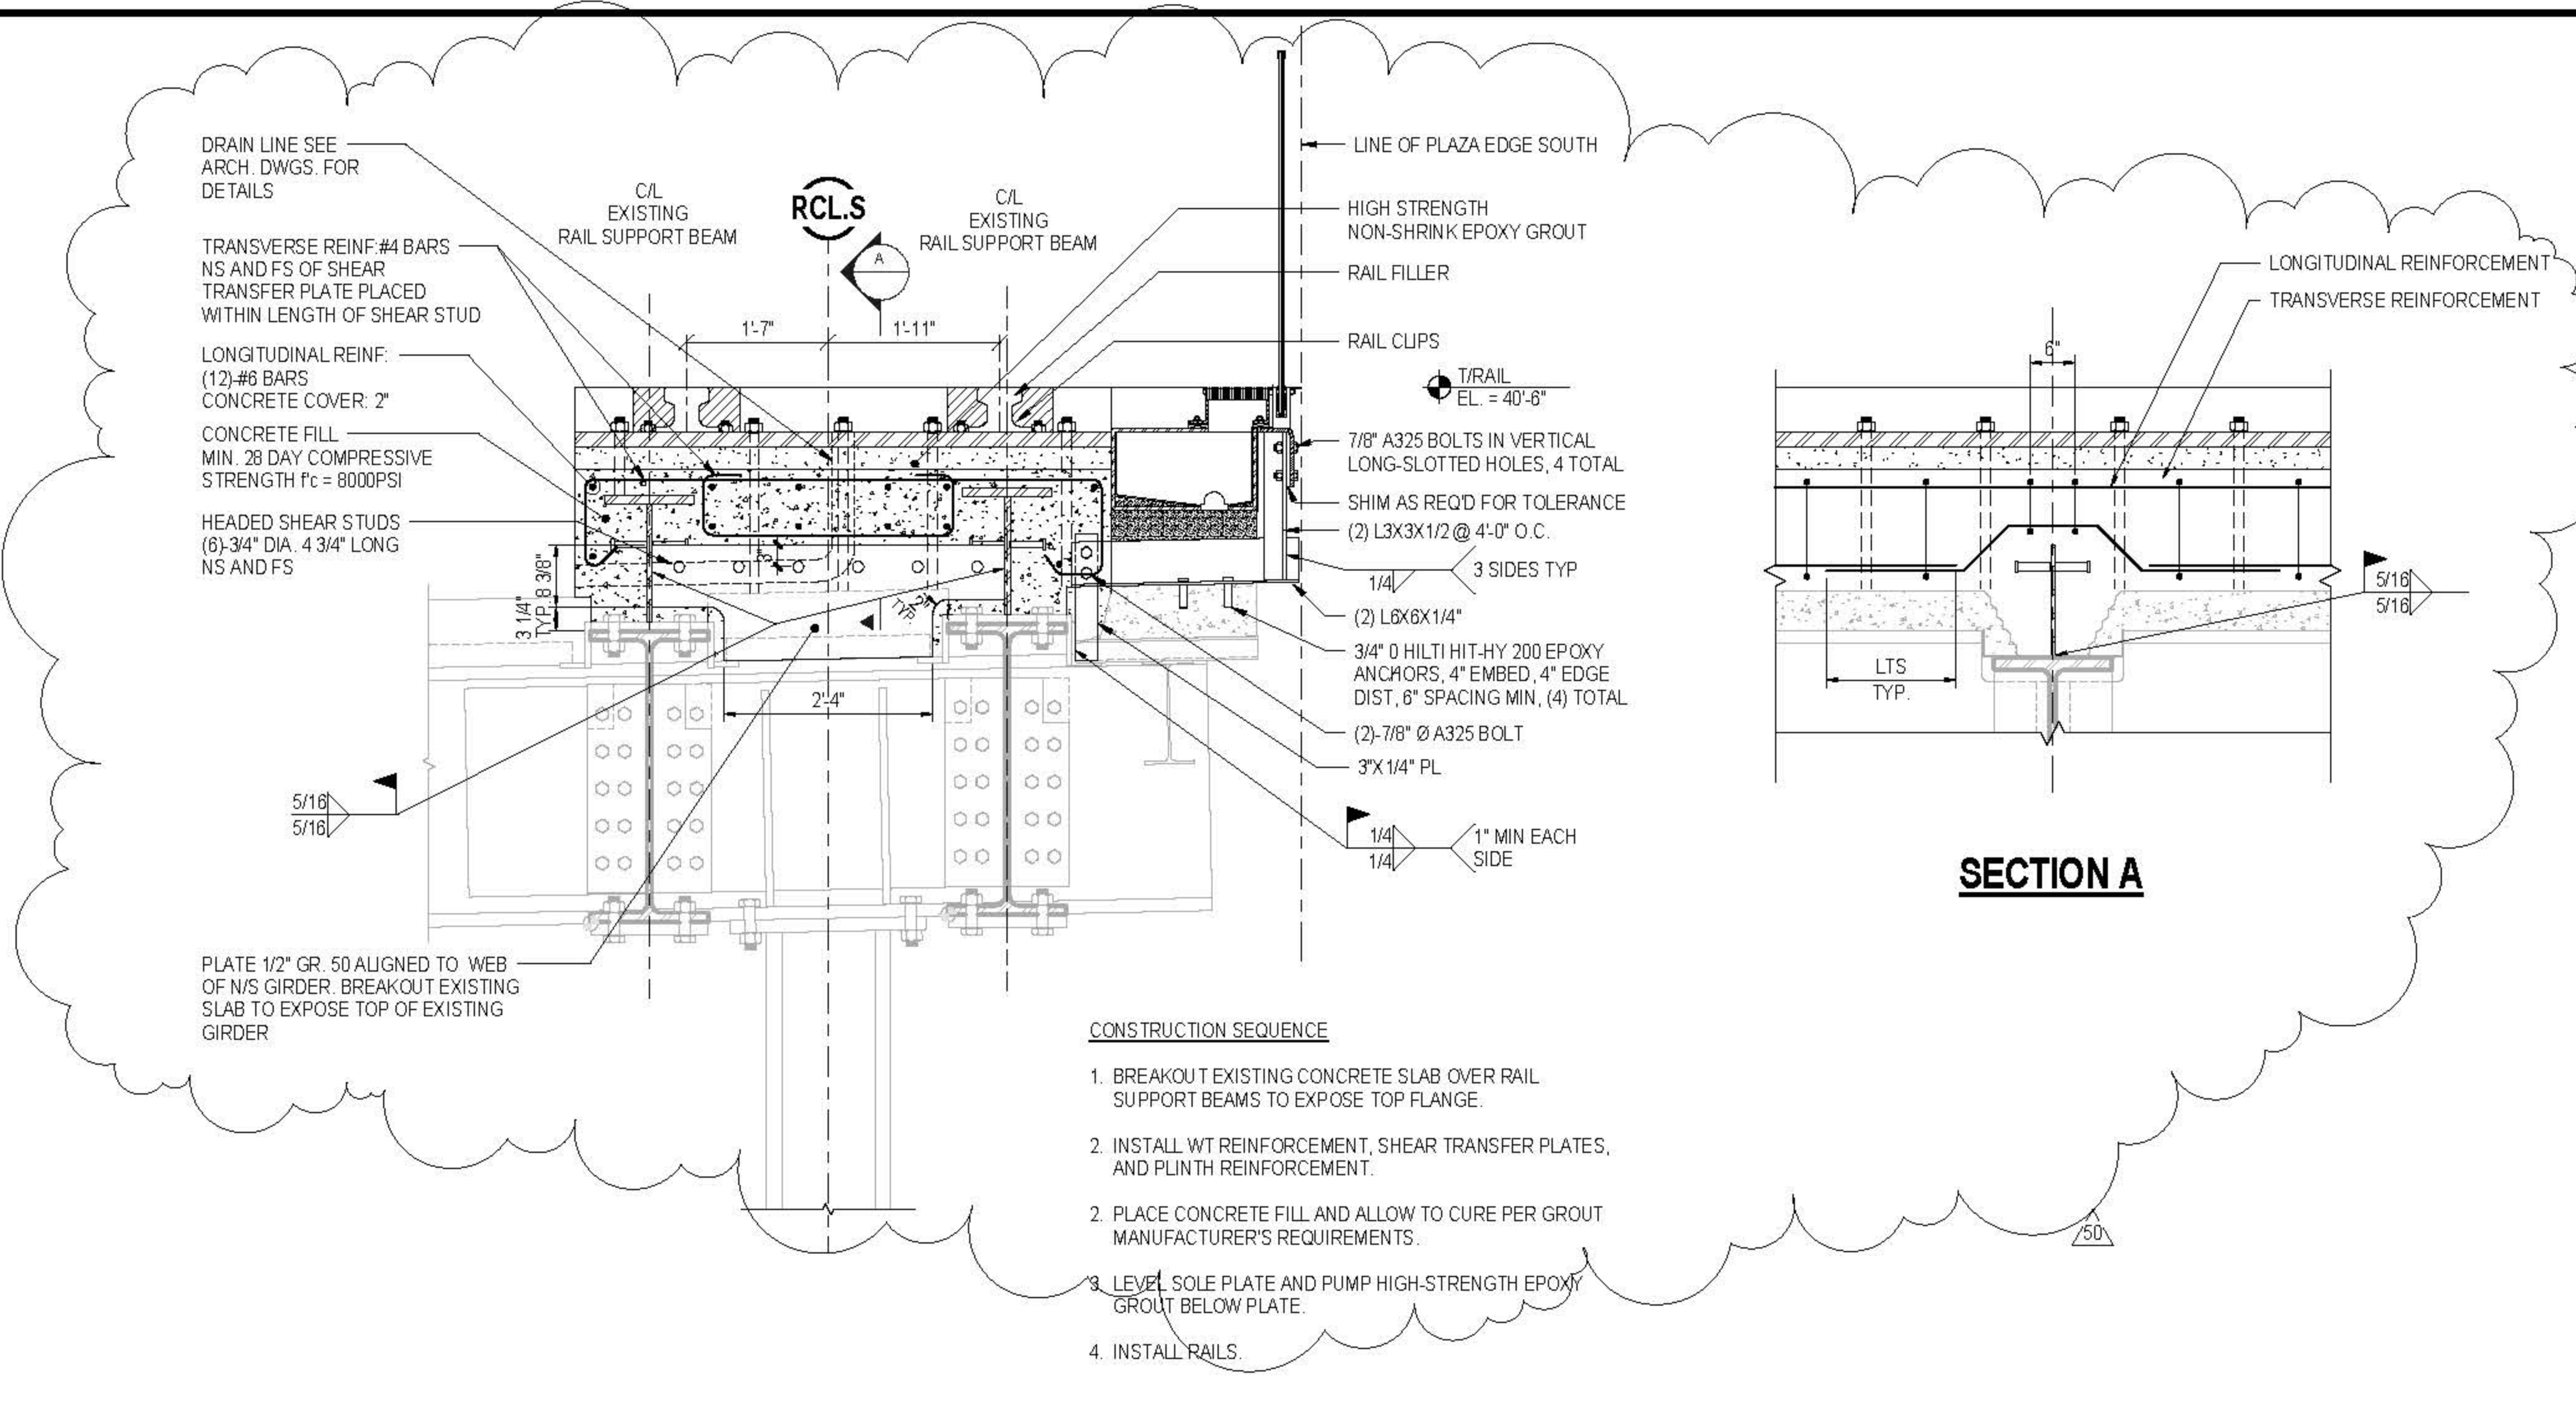


1 SECTION OF SOUTH RAILS AT PLAZA COLUMNS C43, C41, C39, C37, AND C35

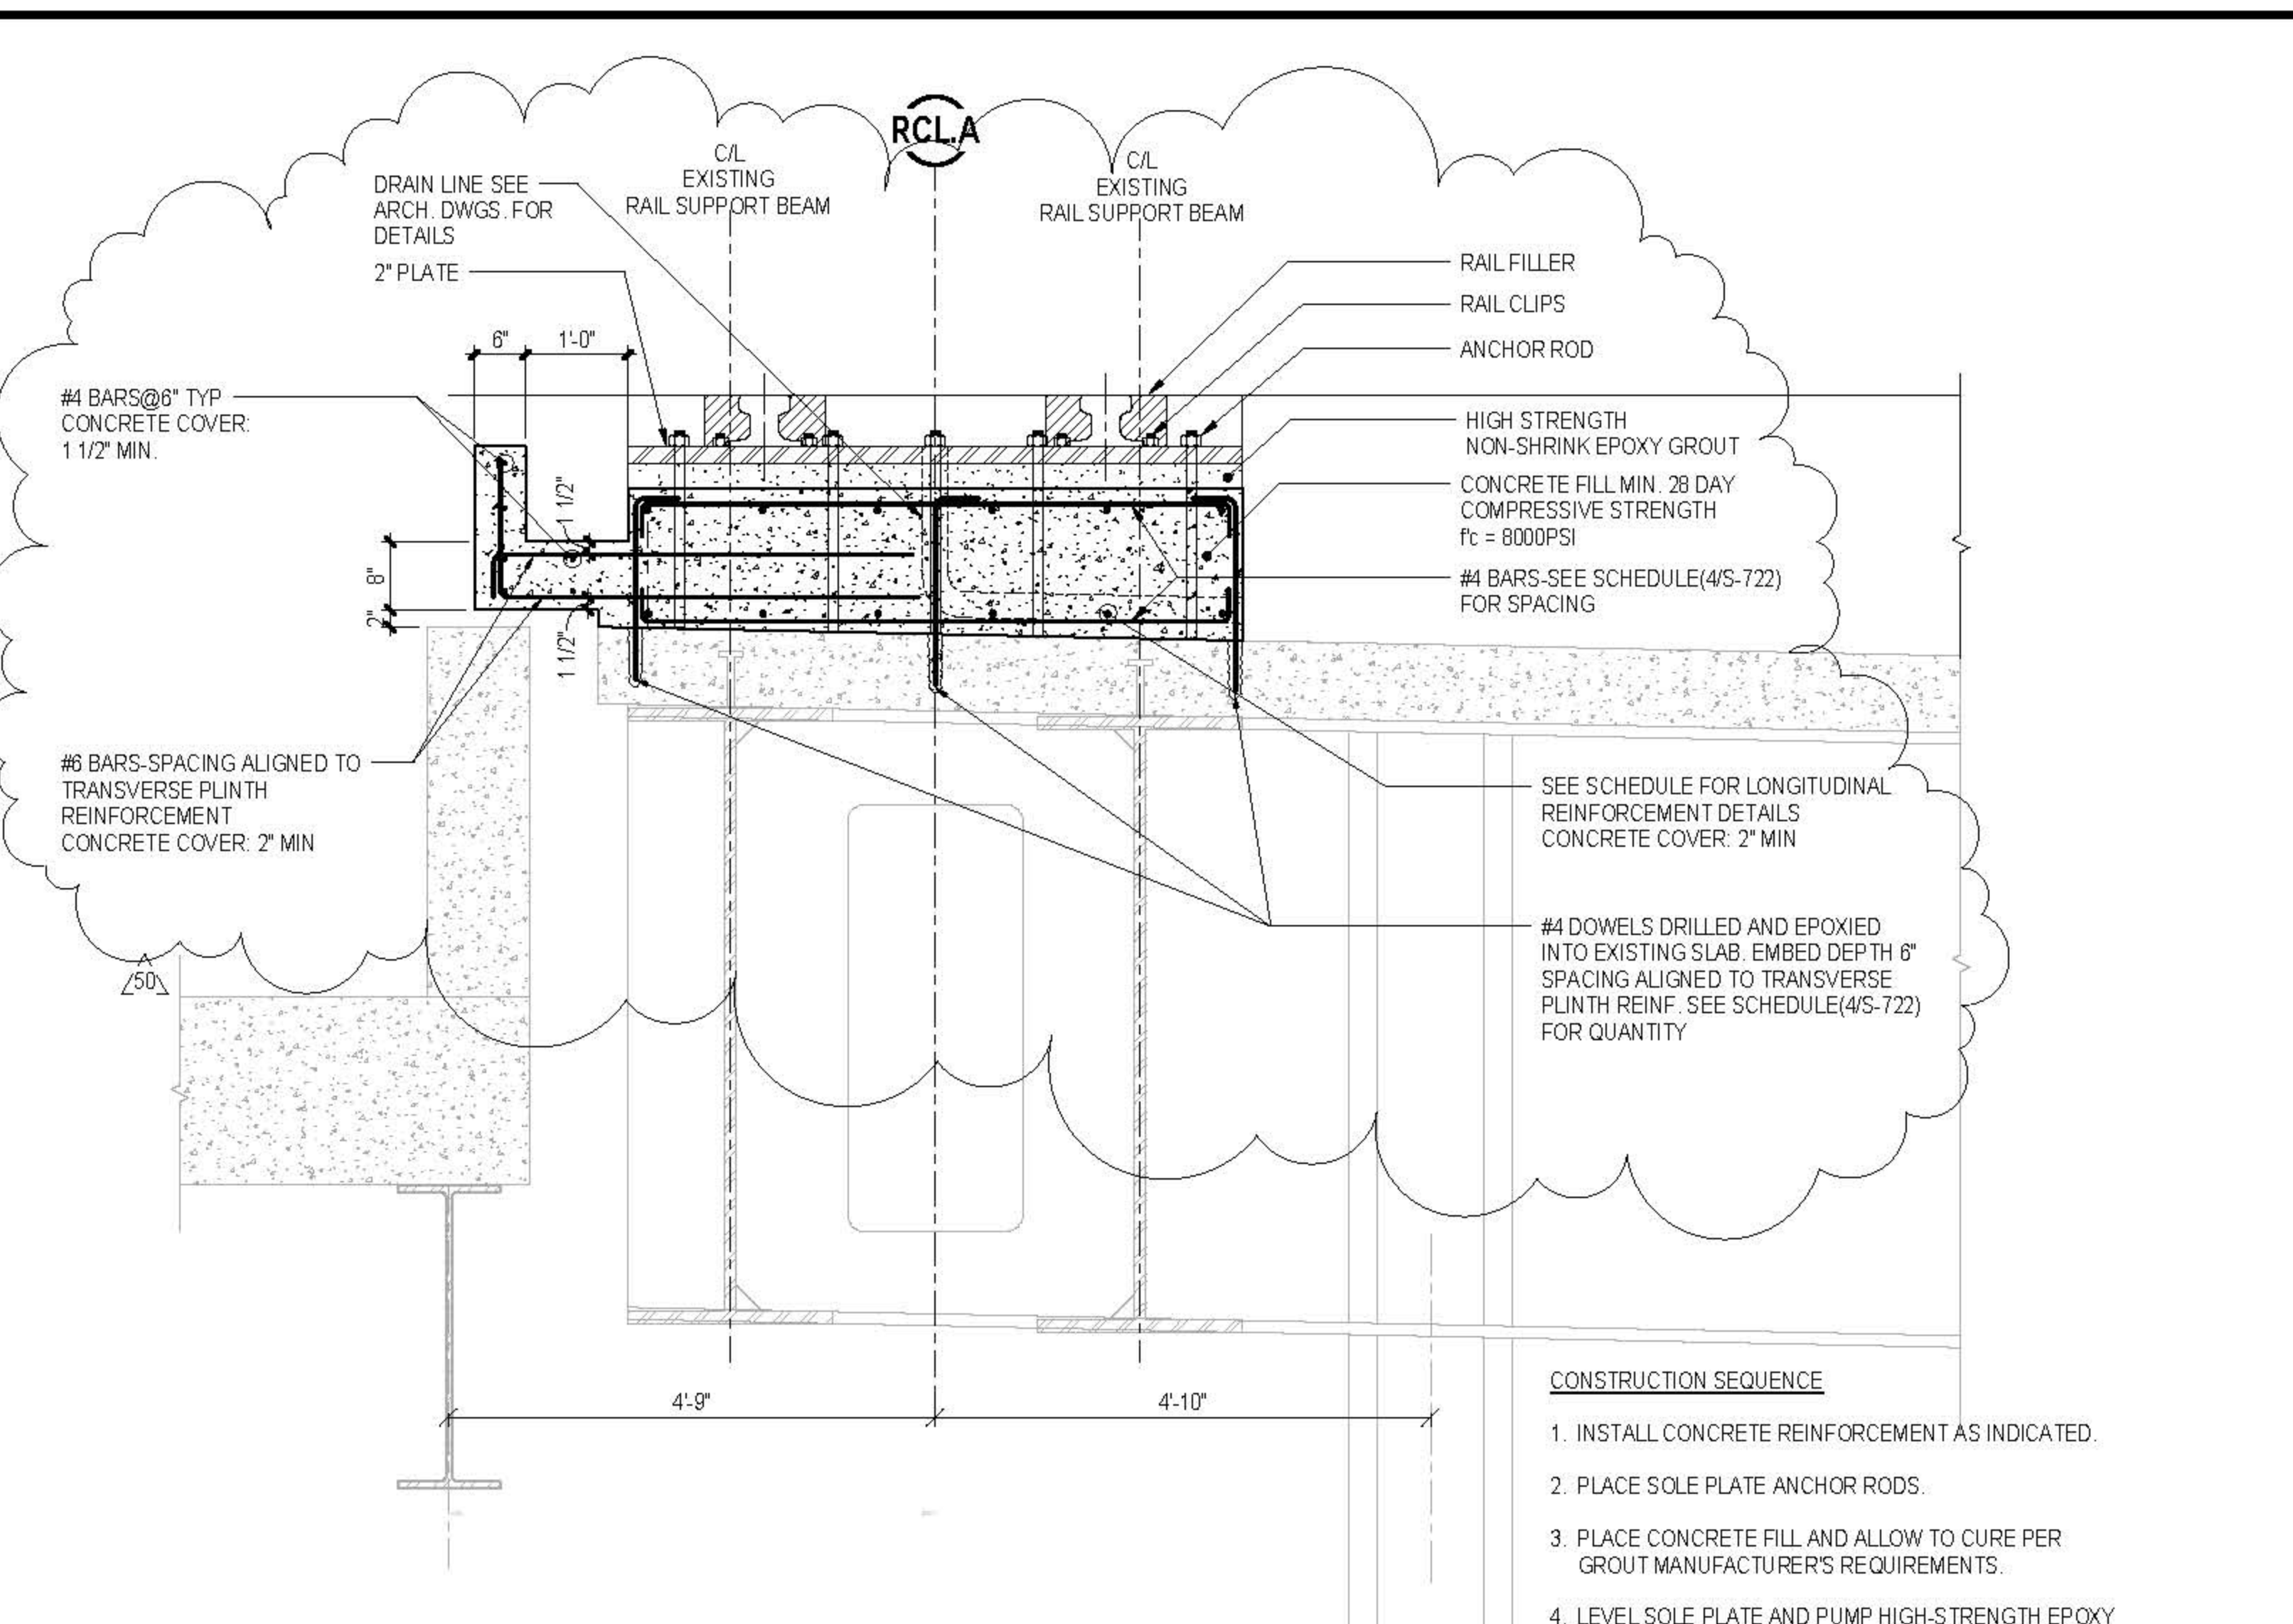

2 TYPICAL SECTION OF NORTH RAILS AT PLAZA

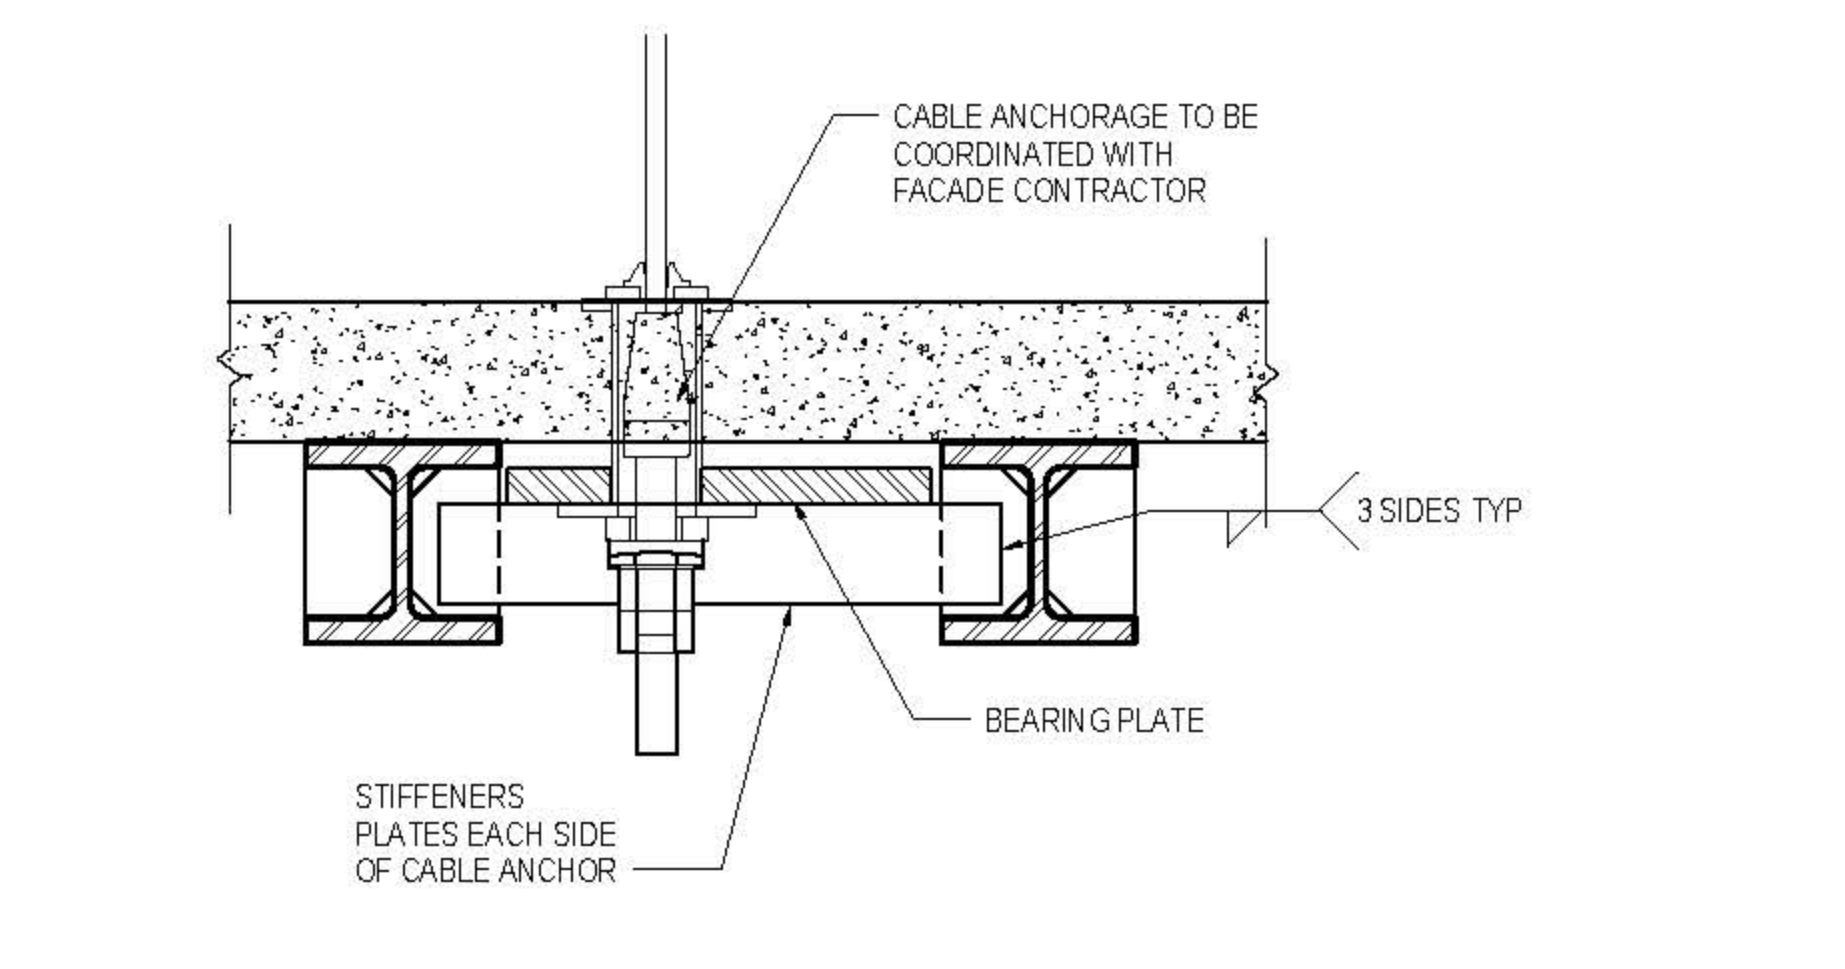

3 TYPICAL CABLE WALL ANCHOR AT L02 NORTH SIDE

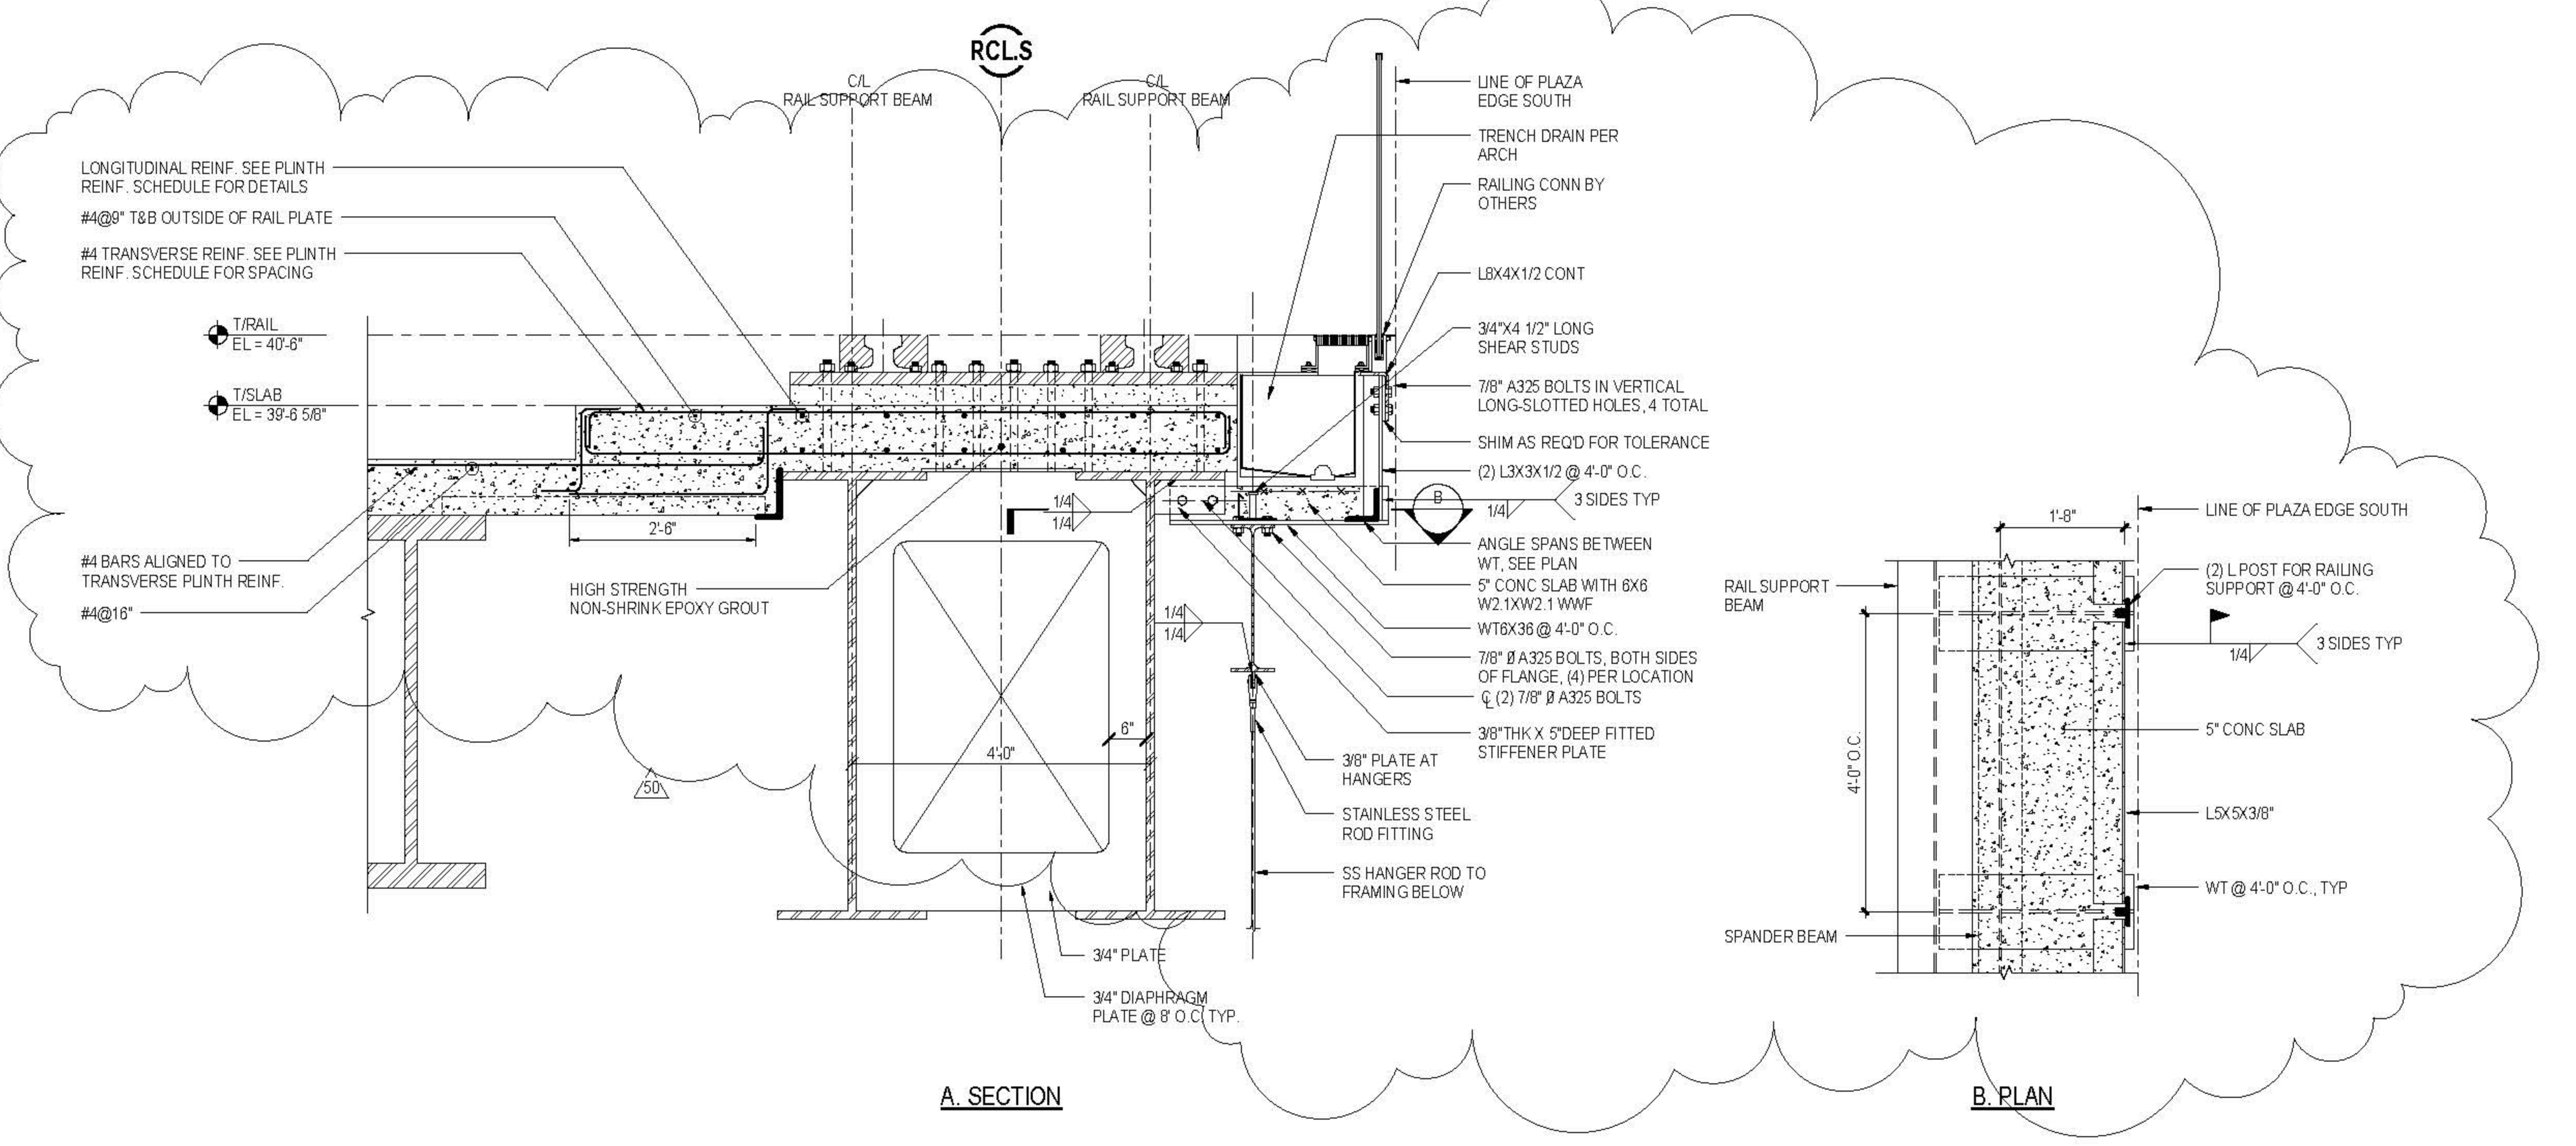


6 TYPICAL SECTION OF SOUTH RAILS AT FIXED BUILDING

PLINTH REINFORCEMENT SCHEDULE


PATTERN	LONGITUDINAL BAR SIZE	# LONGITUDINAL OF BARS	TRANSVERSE REINFORCEMENT SPACING	DOWEL BARS # OF ROWS
A	#6	6 T8B	12IN. O.C.	3
B	#6	6 T8B	16IN. O.C.	2
C	#11	6 T8B	12IN. O.C.	N/A

NOTE: DOWELS ONLY REQUIRED ON RCL EAST OF C44.2


4 PLINTH REINFORCEMENT SCHEDULE

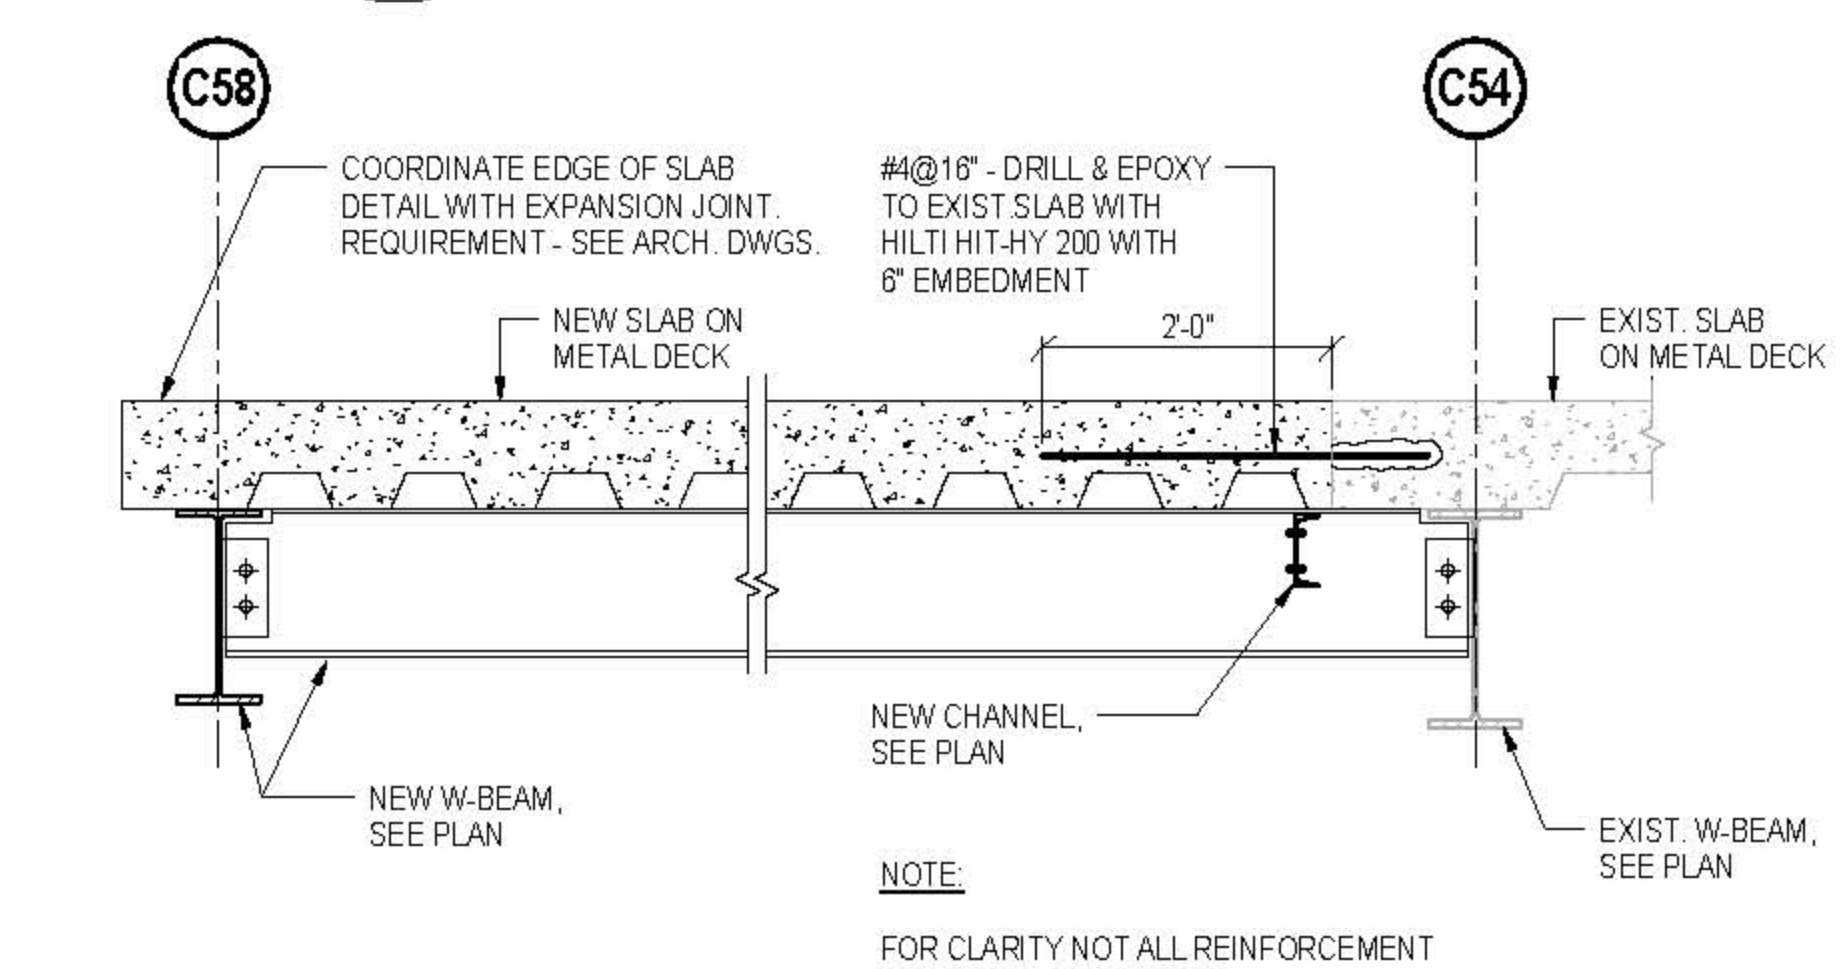

7 TYPICAL SECTION AT L02 C58 - C54 INFILL

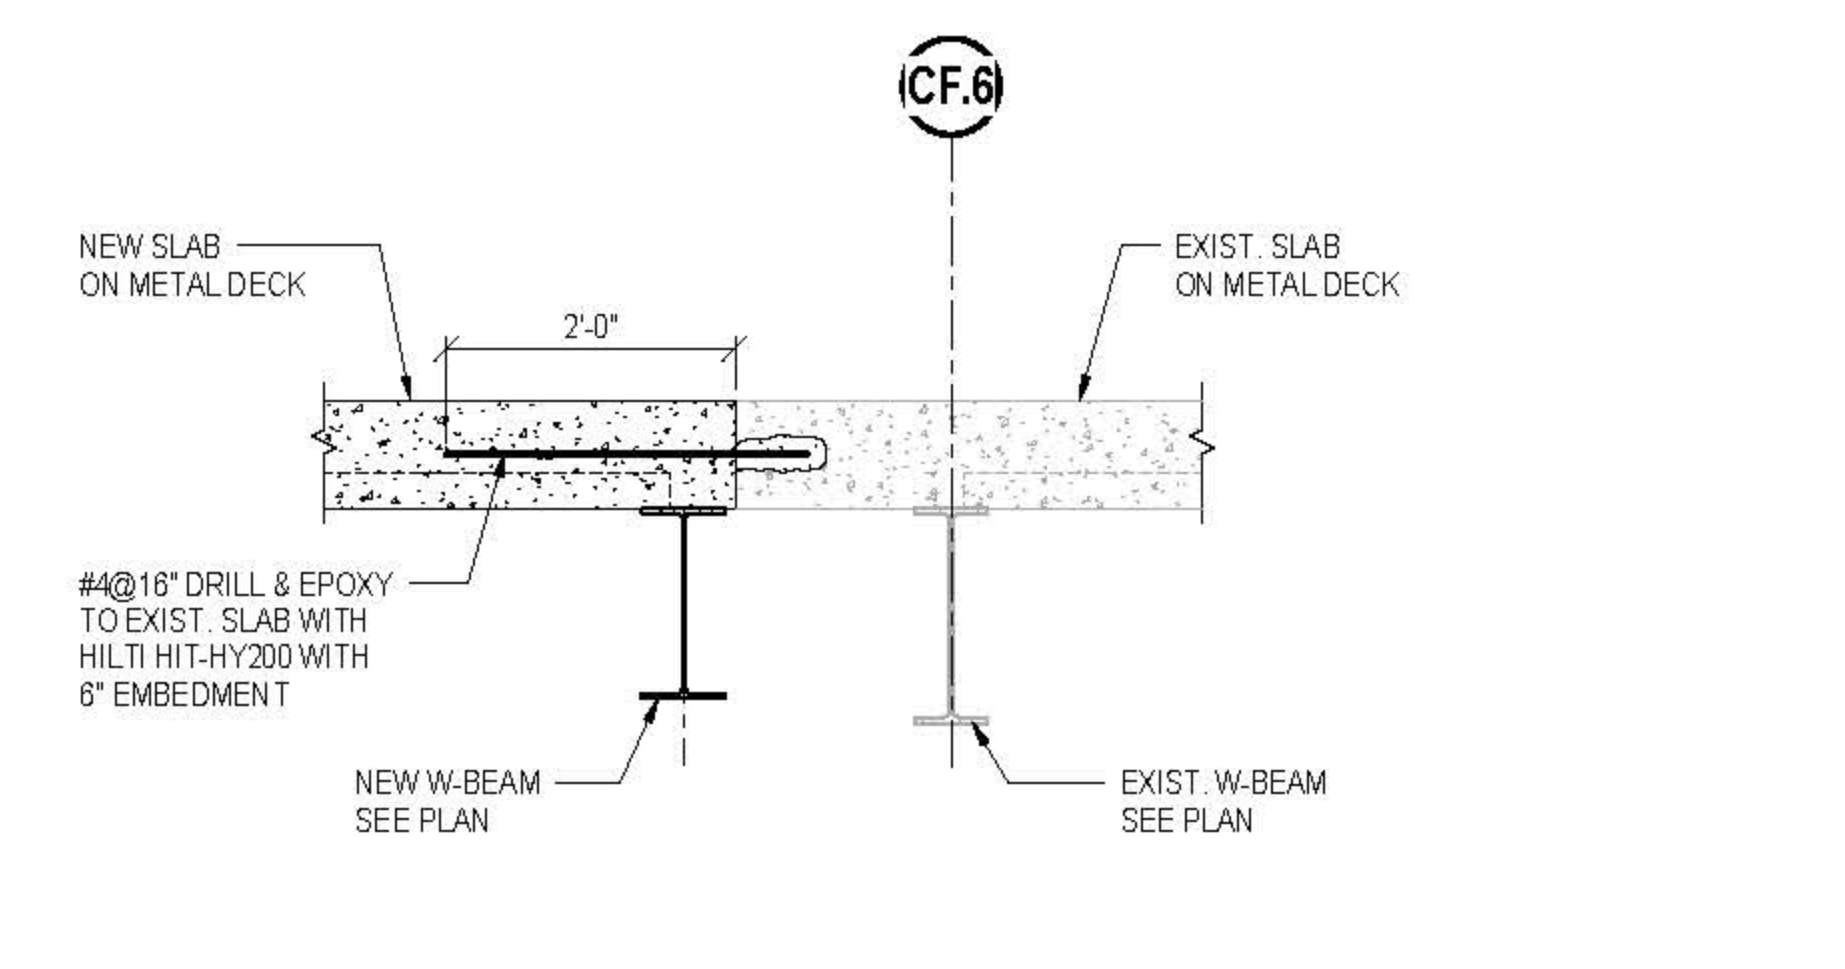


8 TYPICAL SECTION L02 NEW TO EXISTING CONSTRUCTION AT CF.6

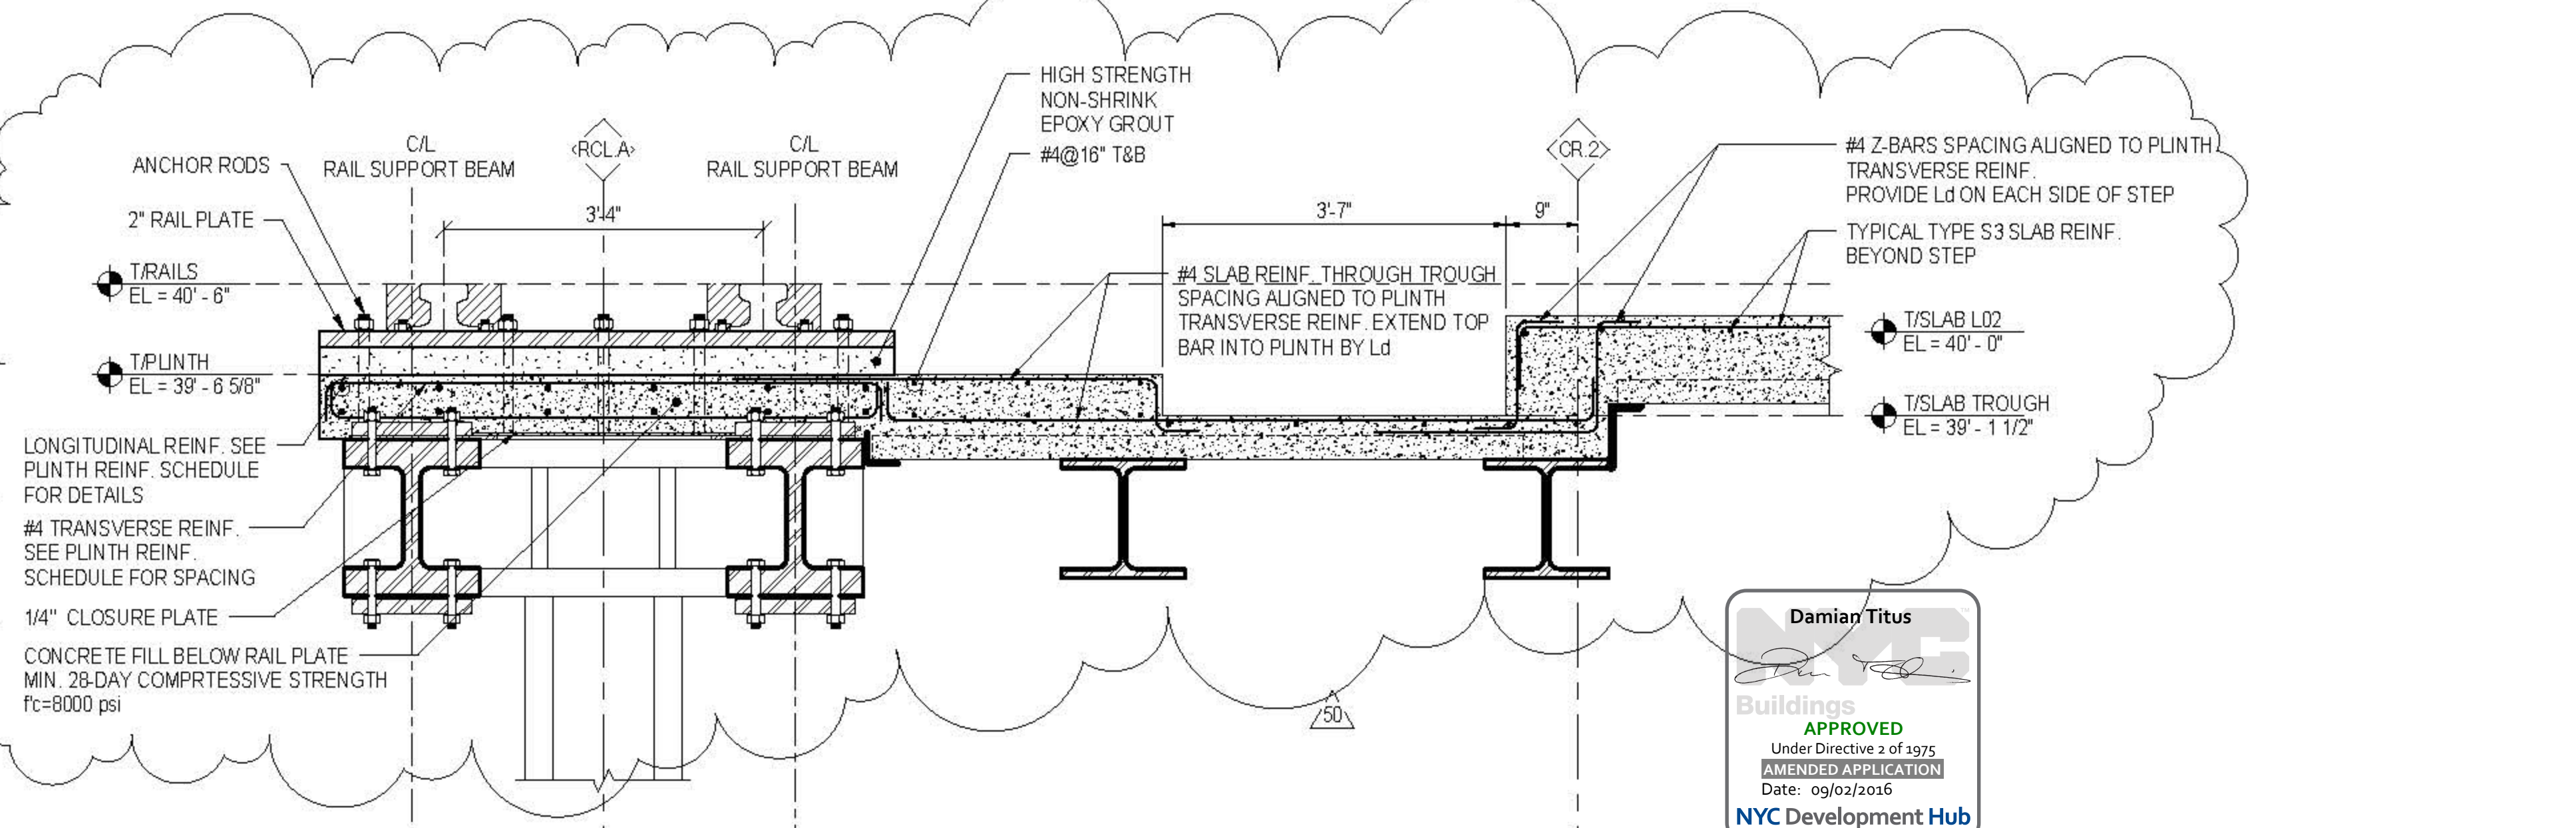

9 TYPICAL SECTION AT NORTH RAILS AT FIXED BUILDING

KEY PLAN

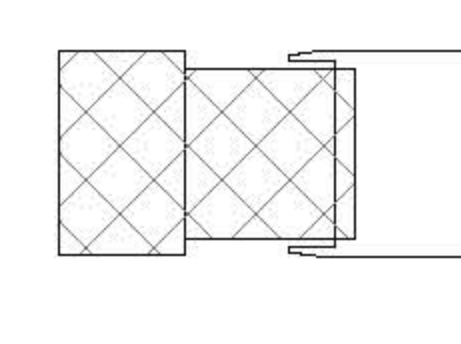

ISSUE

NO.	DESCRIPTION	DATE
01	ISSUE FOR PERMITTING	08/19/2015
02	FOR CONSTRUCTION	08/19/2015
03	FOR CONSTRUCTION	08/19/2015
04	FOR CONSTRUCTION	08/19/2015
05	FOR CONSTRUCTION	08/19/2015
06	FOR CONSTRUCTION	08/19/2015
07	FOR CONSTRUCTION	08/19/2015
08	FOR CONSTRUCTION	08/19/2015
09	FOR CONSTRUCTION	08/19/2015
10	FOR CONSTRUCTION	08/19/2015

STAMP



DRAWN BY: *[Signature]* CHECKED BY: *[Signature]*

PROJECT NUMBER: N1318.00

TITLE: SECTIONS AND DETAILS, FIXED BUILDING LEVEL 02 - 1

DRAWING NO.: S-723.01

B.SCAN NO.: 81 of 123

CULTURE SHED

540 West 30th Street
New York, New York 10001

OWNER
CULTURE SHED INC.

ARCHITECTS
Oller Scaletta + Renfro Architects, DPC
601 West 26 Street #815
New York, New York 10001
T: 212.260.7971

STRUCTURAL ENGINEER
Thornton Tomasetti
51 Madison Avenue
New York, New York 10010
T: 917.661.7800
F: 917.661.7801

MEP ENGINEER
Jana Baum & Bolles
63 Park Street
New York, New York 10005
T: 212.530.9300
F: 212.260.6944

FACADE CONSULTANT
Thornton Tomasetti
51 Madison Avenue
New York, New York 10010
T: 917.661.7800
F: 917.661.7801

KINETICS ENGINEER
Hudspeth & Hanover
1607 Broadway
New York, New York 10036
T: 212.944.1150
F: 212.391.0397

LIGHTING DESIGNER
Tilston Design Associates
40 North Street #160
New York, New York 10013
T: 212.675.7760

THEATRE PLANNING & DESIGN
Flaher Dachs Associates
22 West 15th Street
New York, New York 10011
T: 212.691.3000

ENERGY MODELER
Vindian
63 Washington Street
Norwalk, CT 06854
T: 203.298.1411

ACOUSTIC/AUDIO-VISUAL
Avalonville
93 North Main Street
South Norwalk, CT 06854
T: 347.210.5540

VERTICAL TRANSPORTATION
Van Duusen & Associates
6 Regent Street, Suite 524
Livingston, NJ 07039
T: 973.994.9220

SPECIFICATIONS
Construction Specifications Inc.
PO Box 489
227 Emmet Road
Morganville, NJ 07751
T: 732.970.0700
F: 732.970.0750

SECURITY
Duchella Venter & Santoro
1020 Sherman Avenue
Hartford, CT 06114
T: 203.286.6490

WATERPROOFING
James R. Gofford AIA Consulting Architects PC
154 West 27th Street
New York, NY 10001
T: 212.736.3344

FACADE MAINTENANCE
Eink Engineering PLLC
162 Ave. Street
New York, NY 10005
T: 212.698.3000

BRANDING GRAPHICS
21st Global Design Consultancy
180 Varck Street 15th Floor
New York, NY 10014
T: 212.647.1170

ISSUE PRINTING DATE

ISSUE	PRINTING	DATE
01	60	DOB AMENDMENT 7 08.19.2016
02	ADVISORY (BULLET TRACK)	09.07.2016
11	E	ADV. PROCEEDMENT ACCIDENT #6 04.10.2015
10	4	100% CONSTRUCTION DOCUMENTS 03.18.2015
09	6	PRELIMINARY EOB SUBMISSION 12.30.2014
3	1	ADV. PROCEEDMENT ACCIDENT #1 10.09.2014
1		ADVANCED PROCEEDMENT BID SET 06.16.2014

STAMP



DRAWN BY
Autum

CHECKED BY
Chris

PROJECT NUMBER
N11318.00


TITLE
SECTIONS AND DETAILS, FIXED BUILDING
LEVEL 02 - B

DRAWING NO.
S-723.01


B.SCAN NO.
S-724.01

82 of 123


Copyright © 2016 by Oller Scaletta + Renfro Architects, D.P.C. All rights reserved.

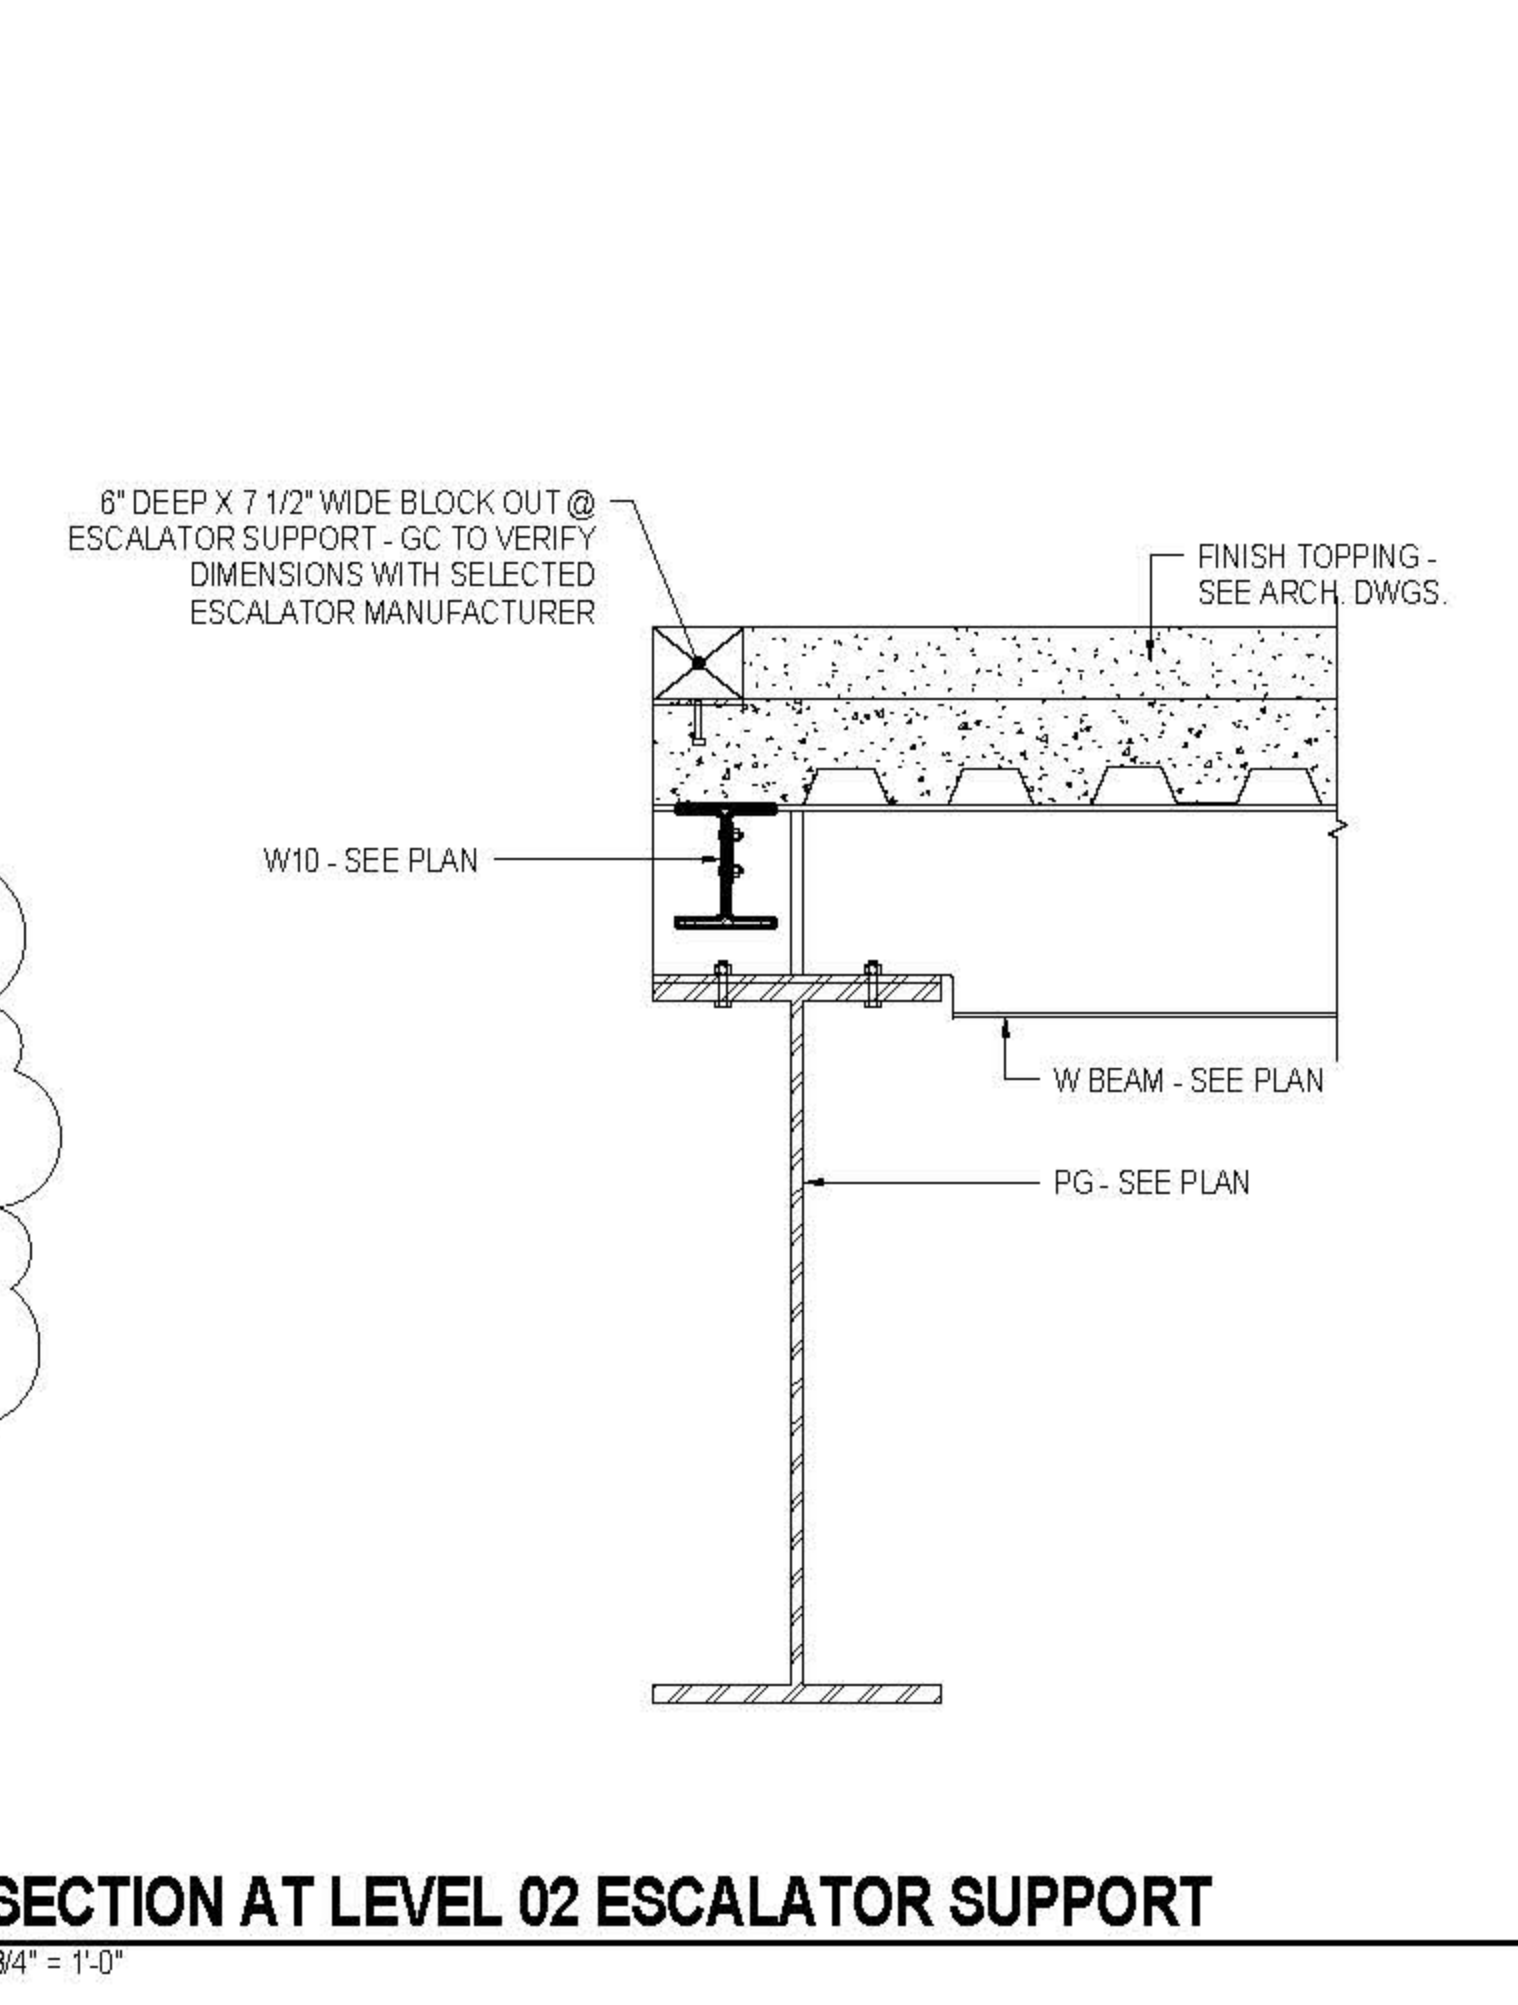


4 SECTION AT LEVEL 02 ESCALATOR SUPPORT
3/4" = 1'-0"

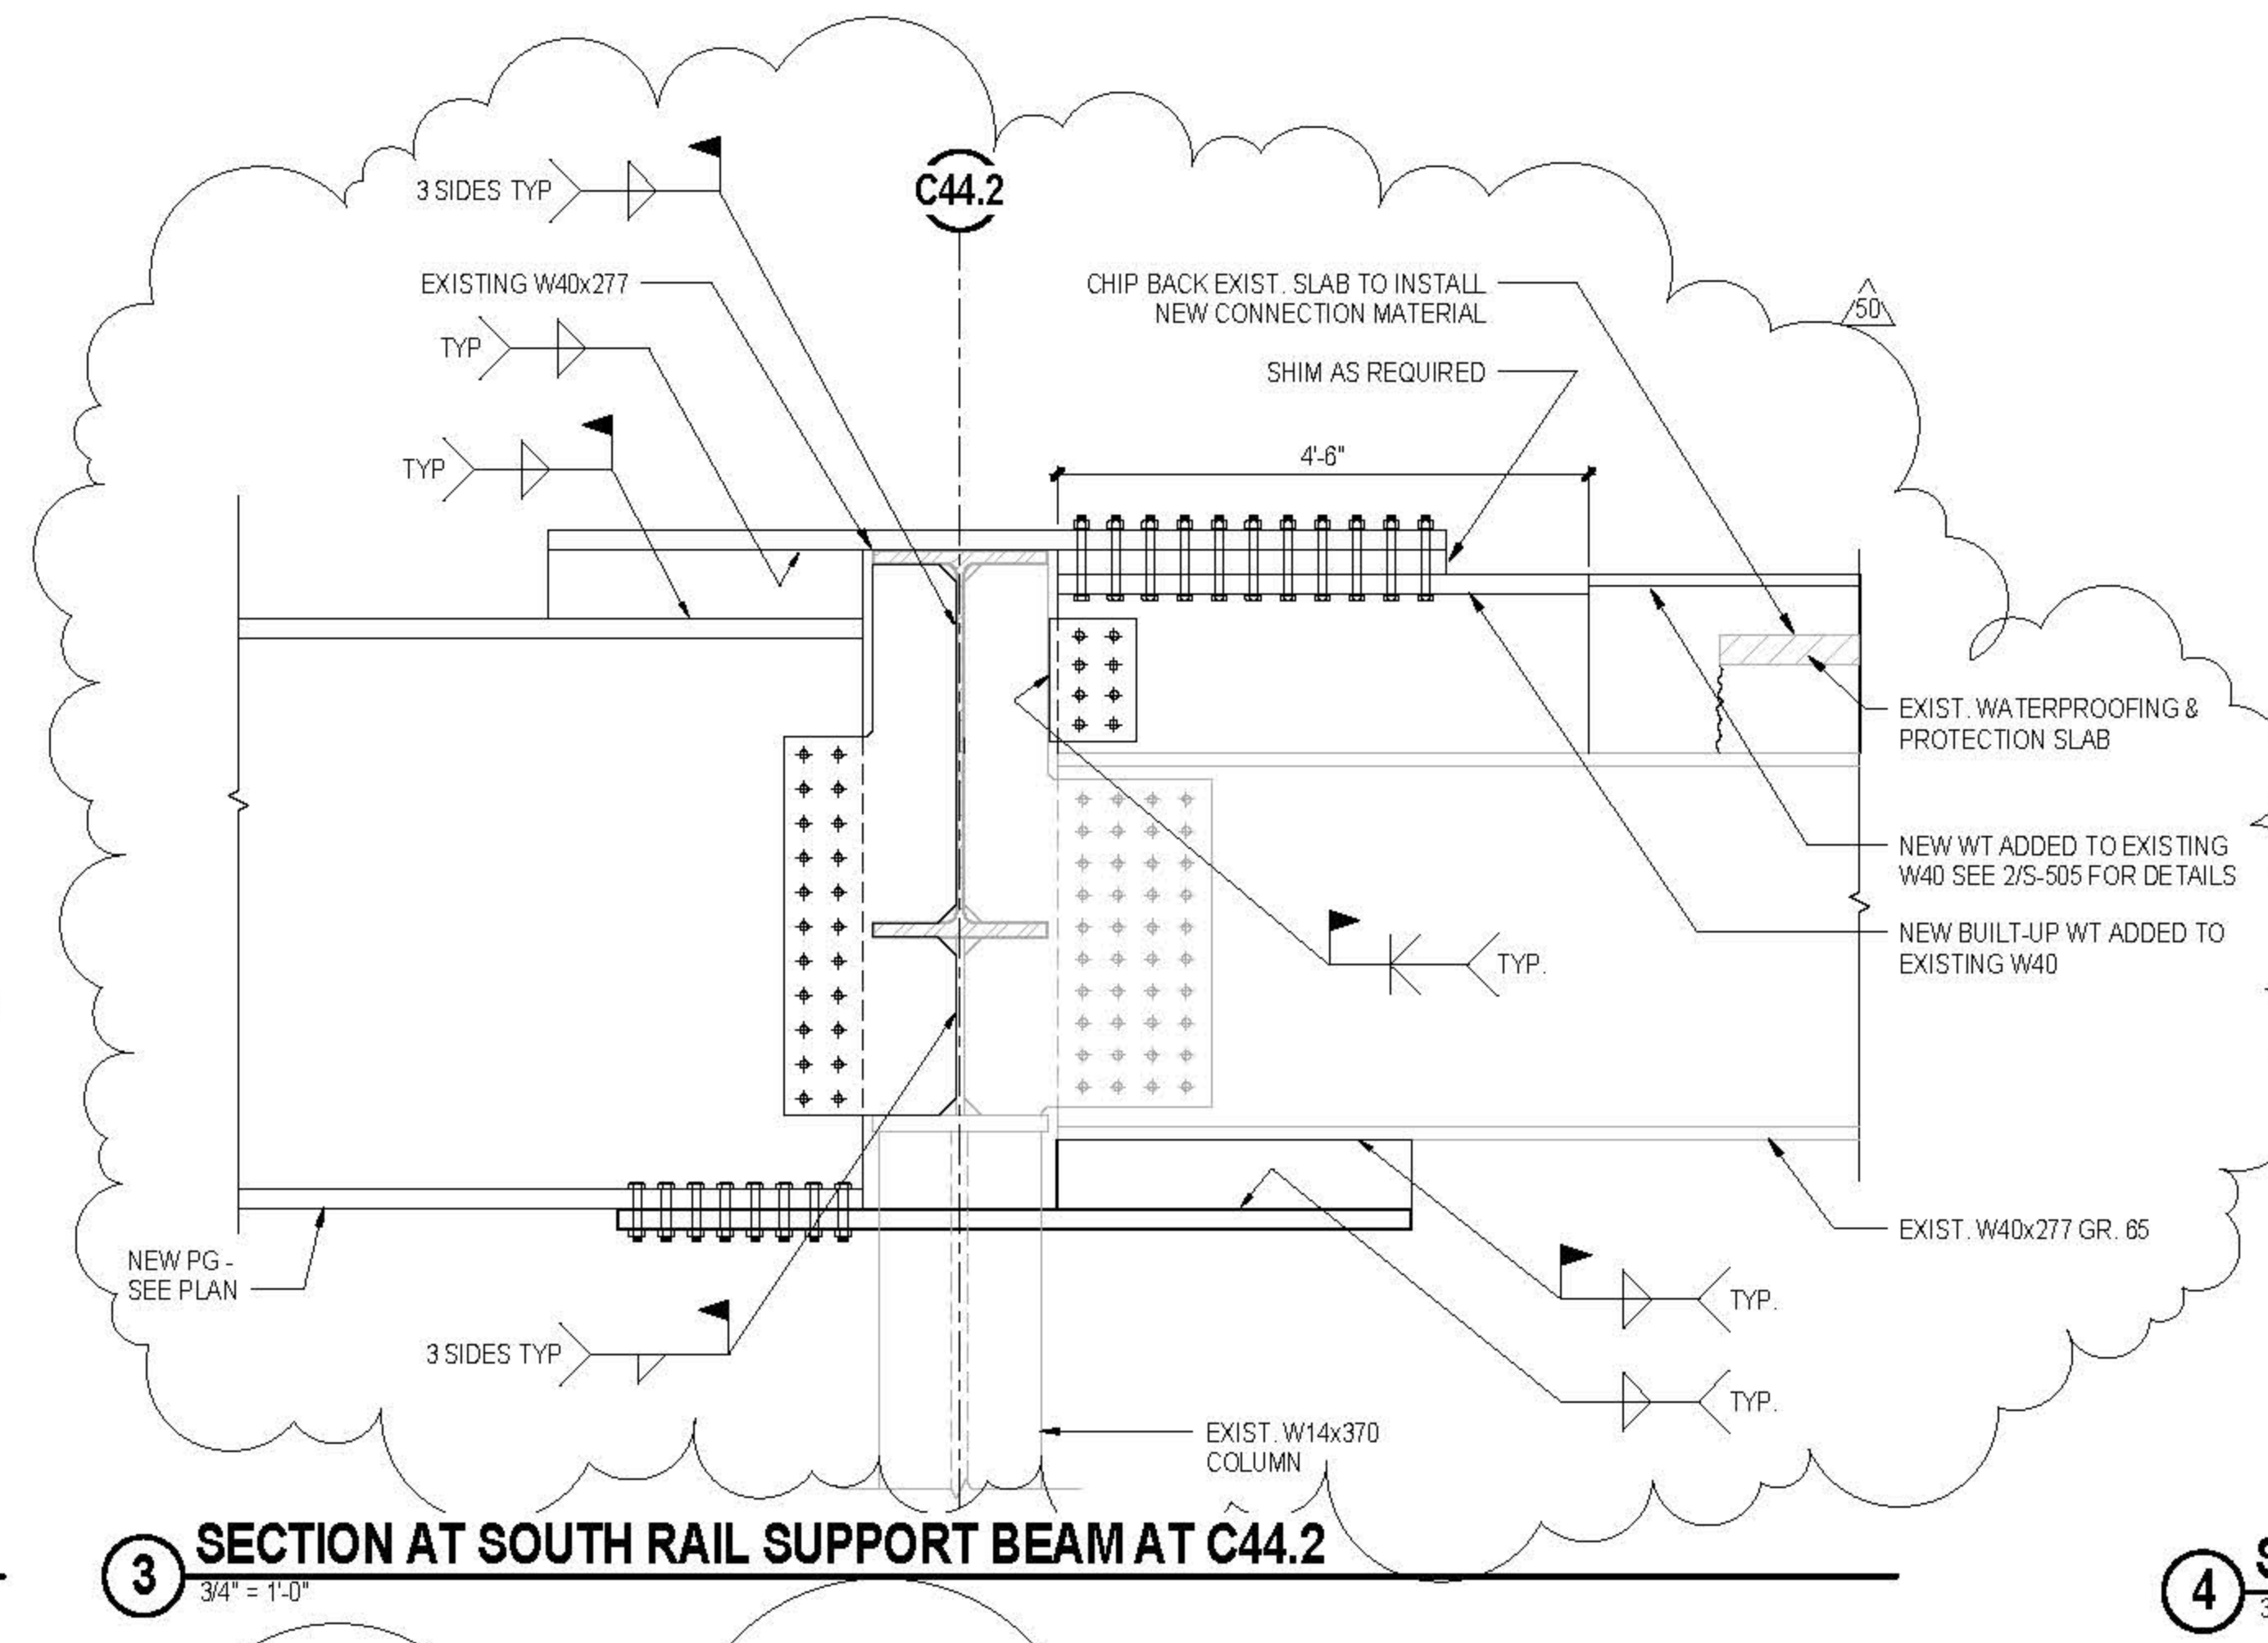


3 SECTION AT SOUTH RAIL SUPPORT BEAM AT C44.2
3/4" = 1'-0"

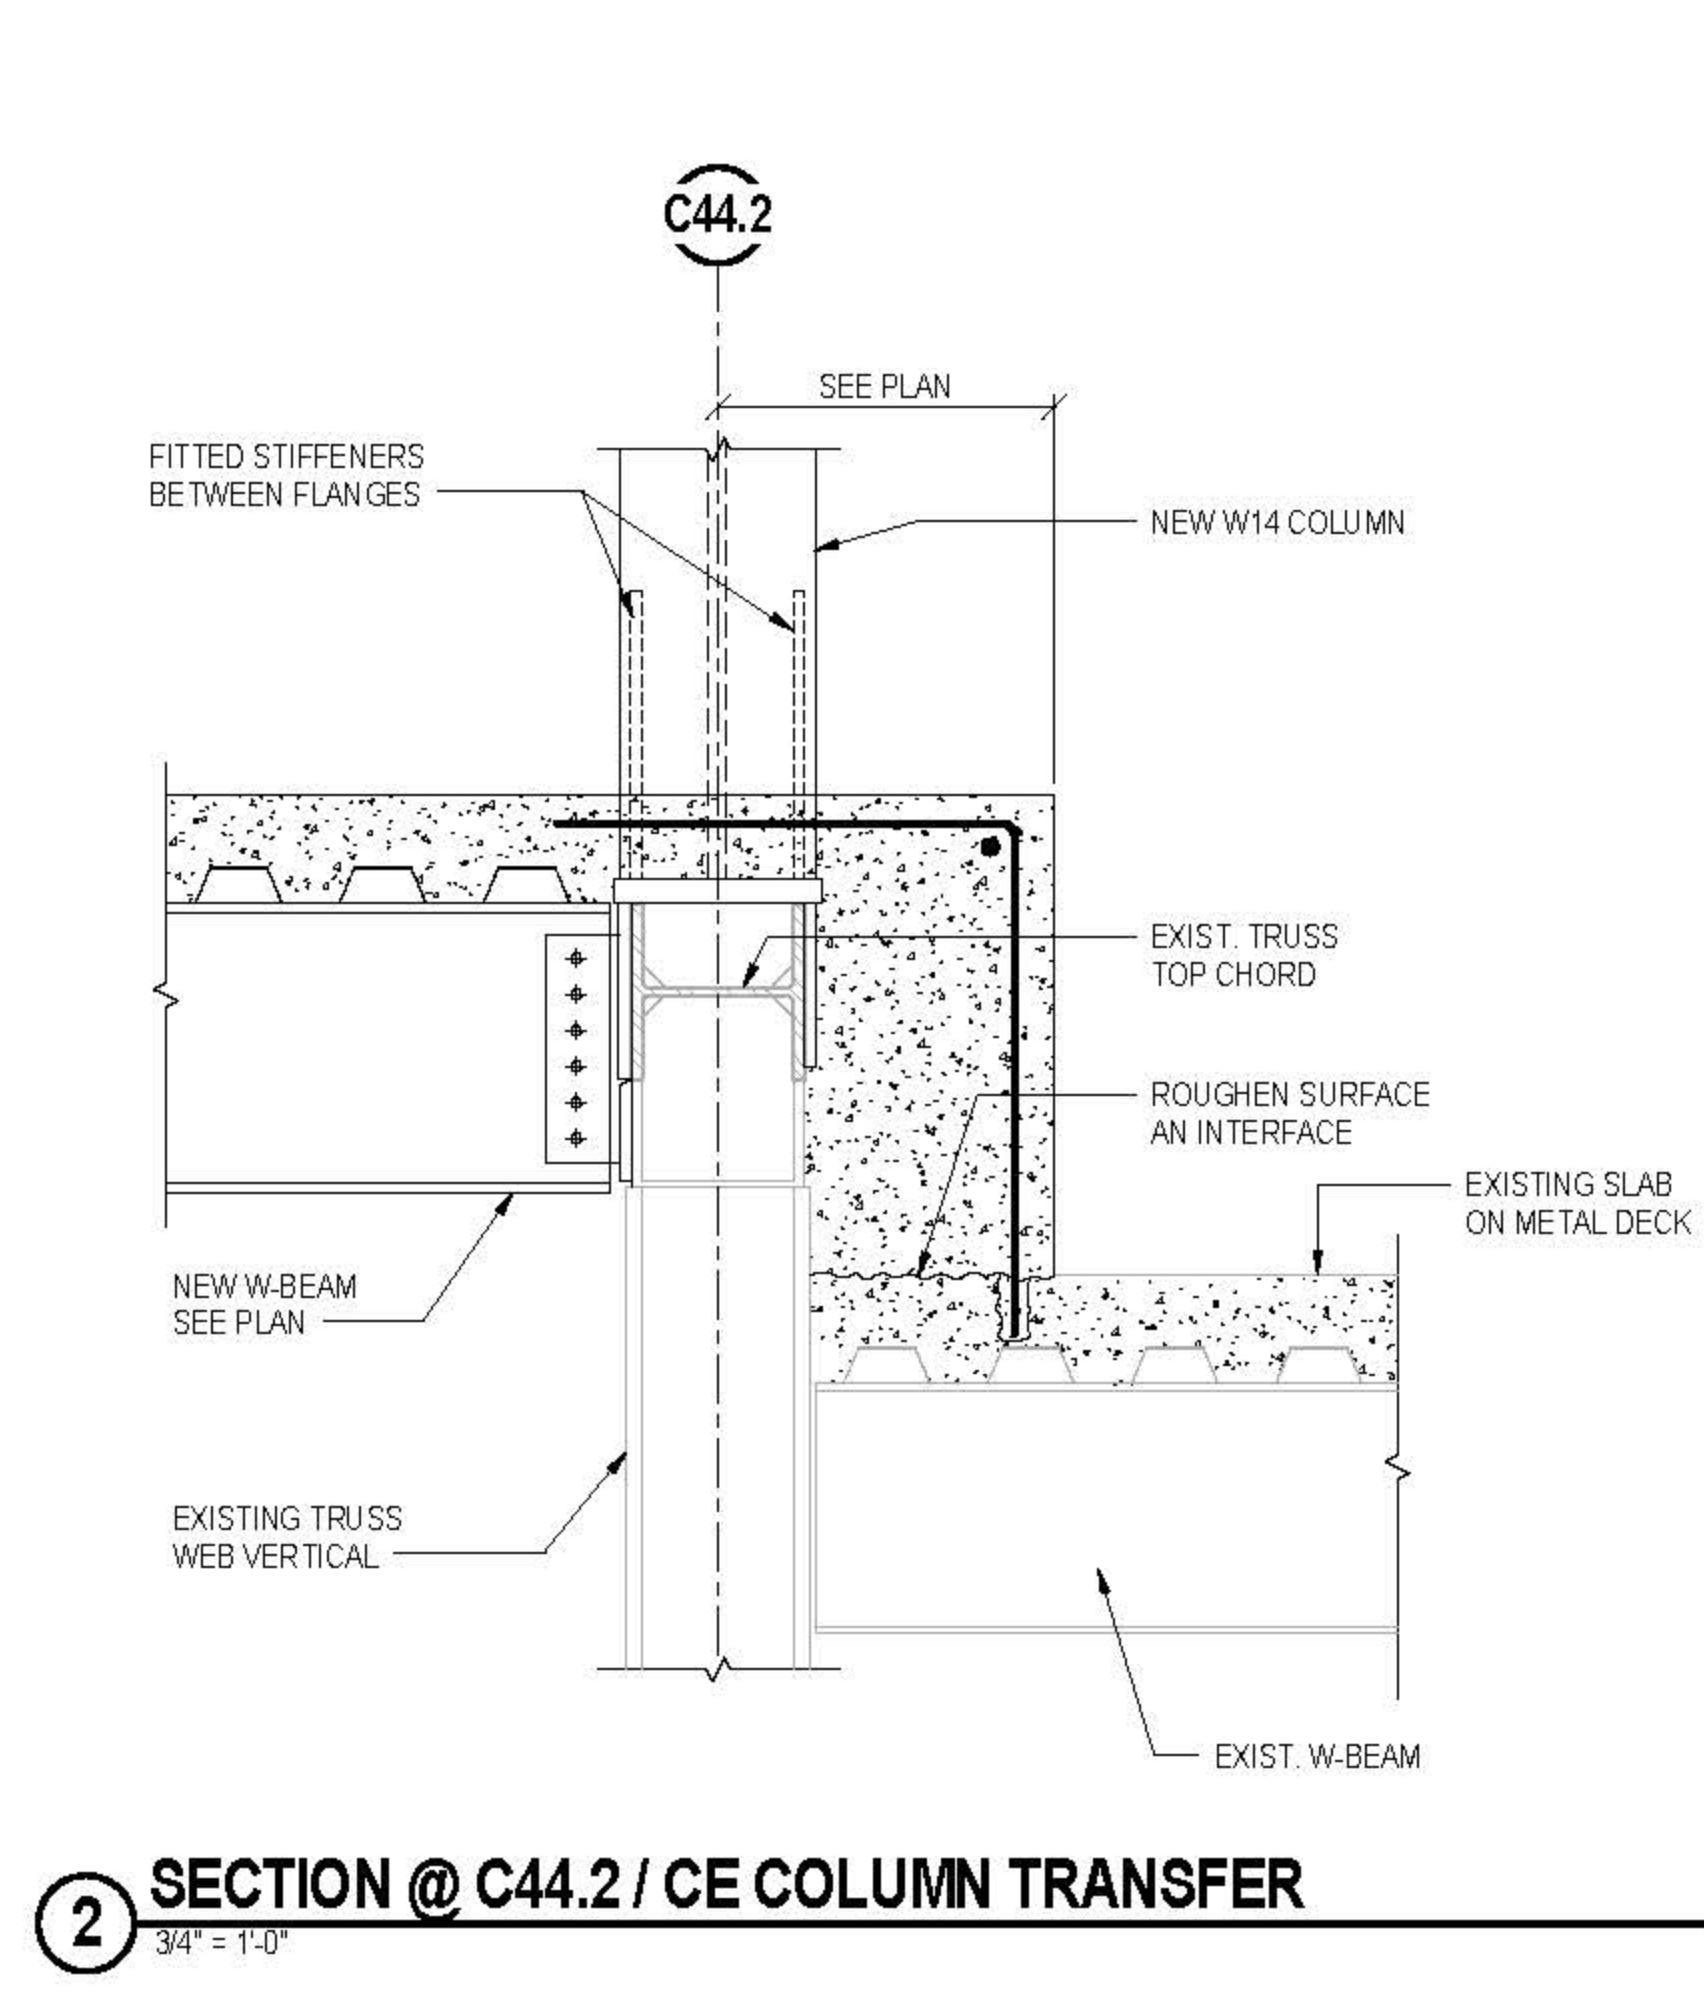


2 SECTION @ C44.2 / CE COLUMN TRANSFER
3/4" = 1'-0"

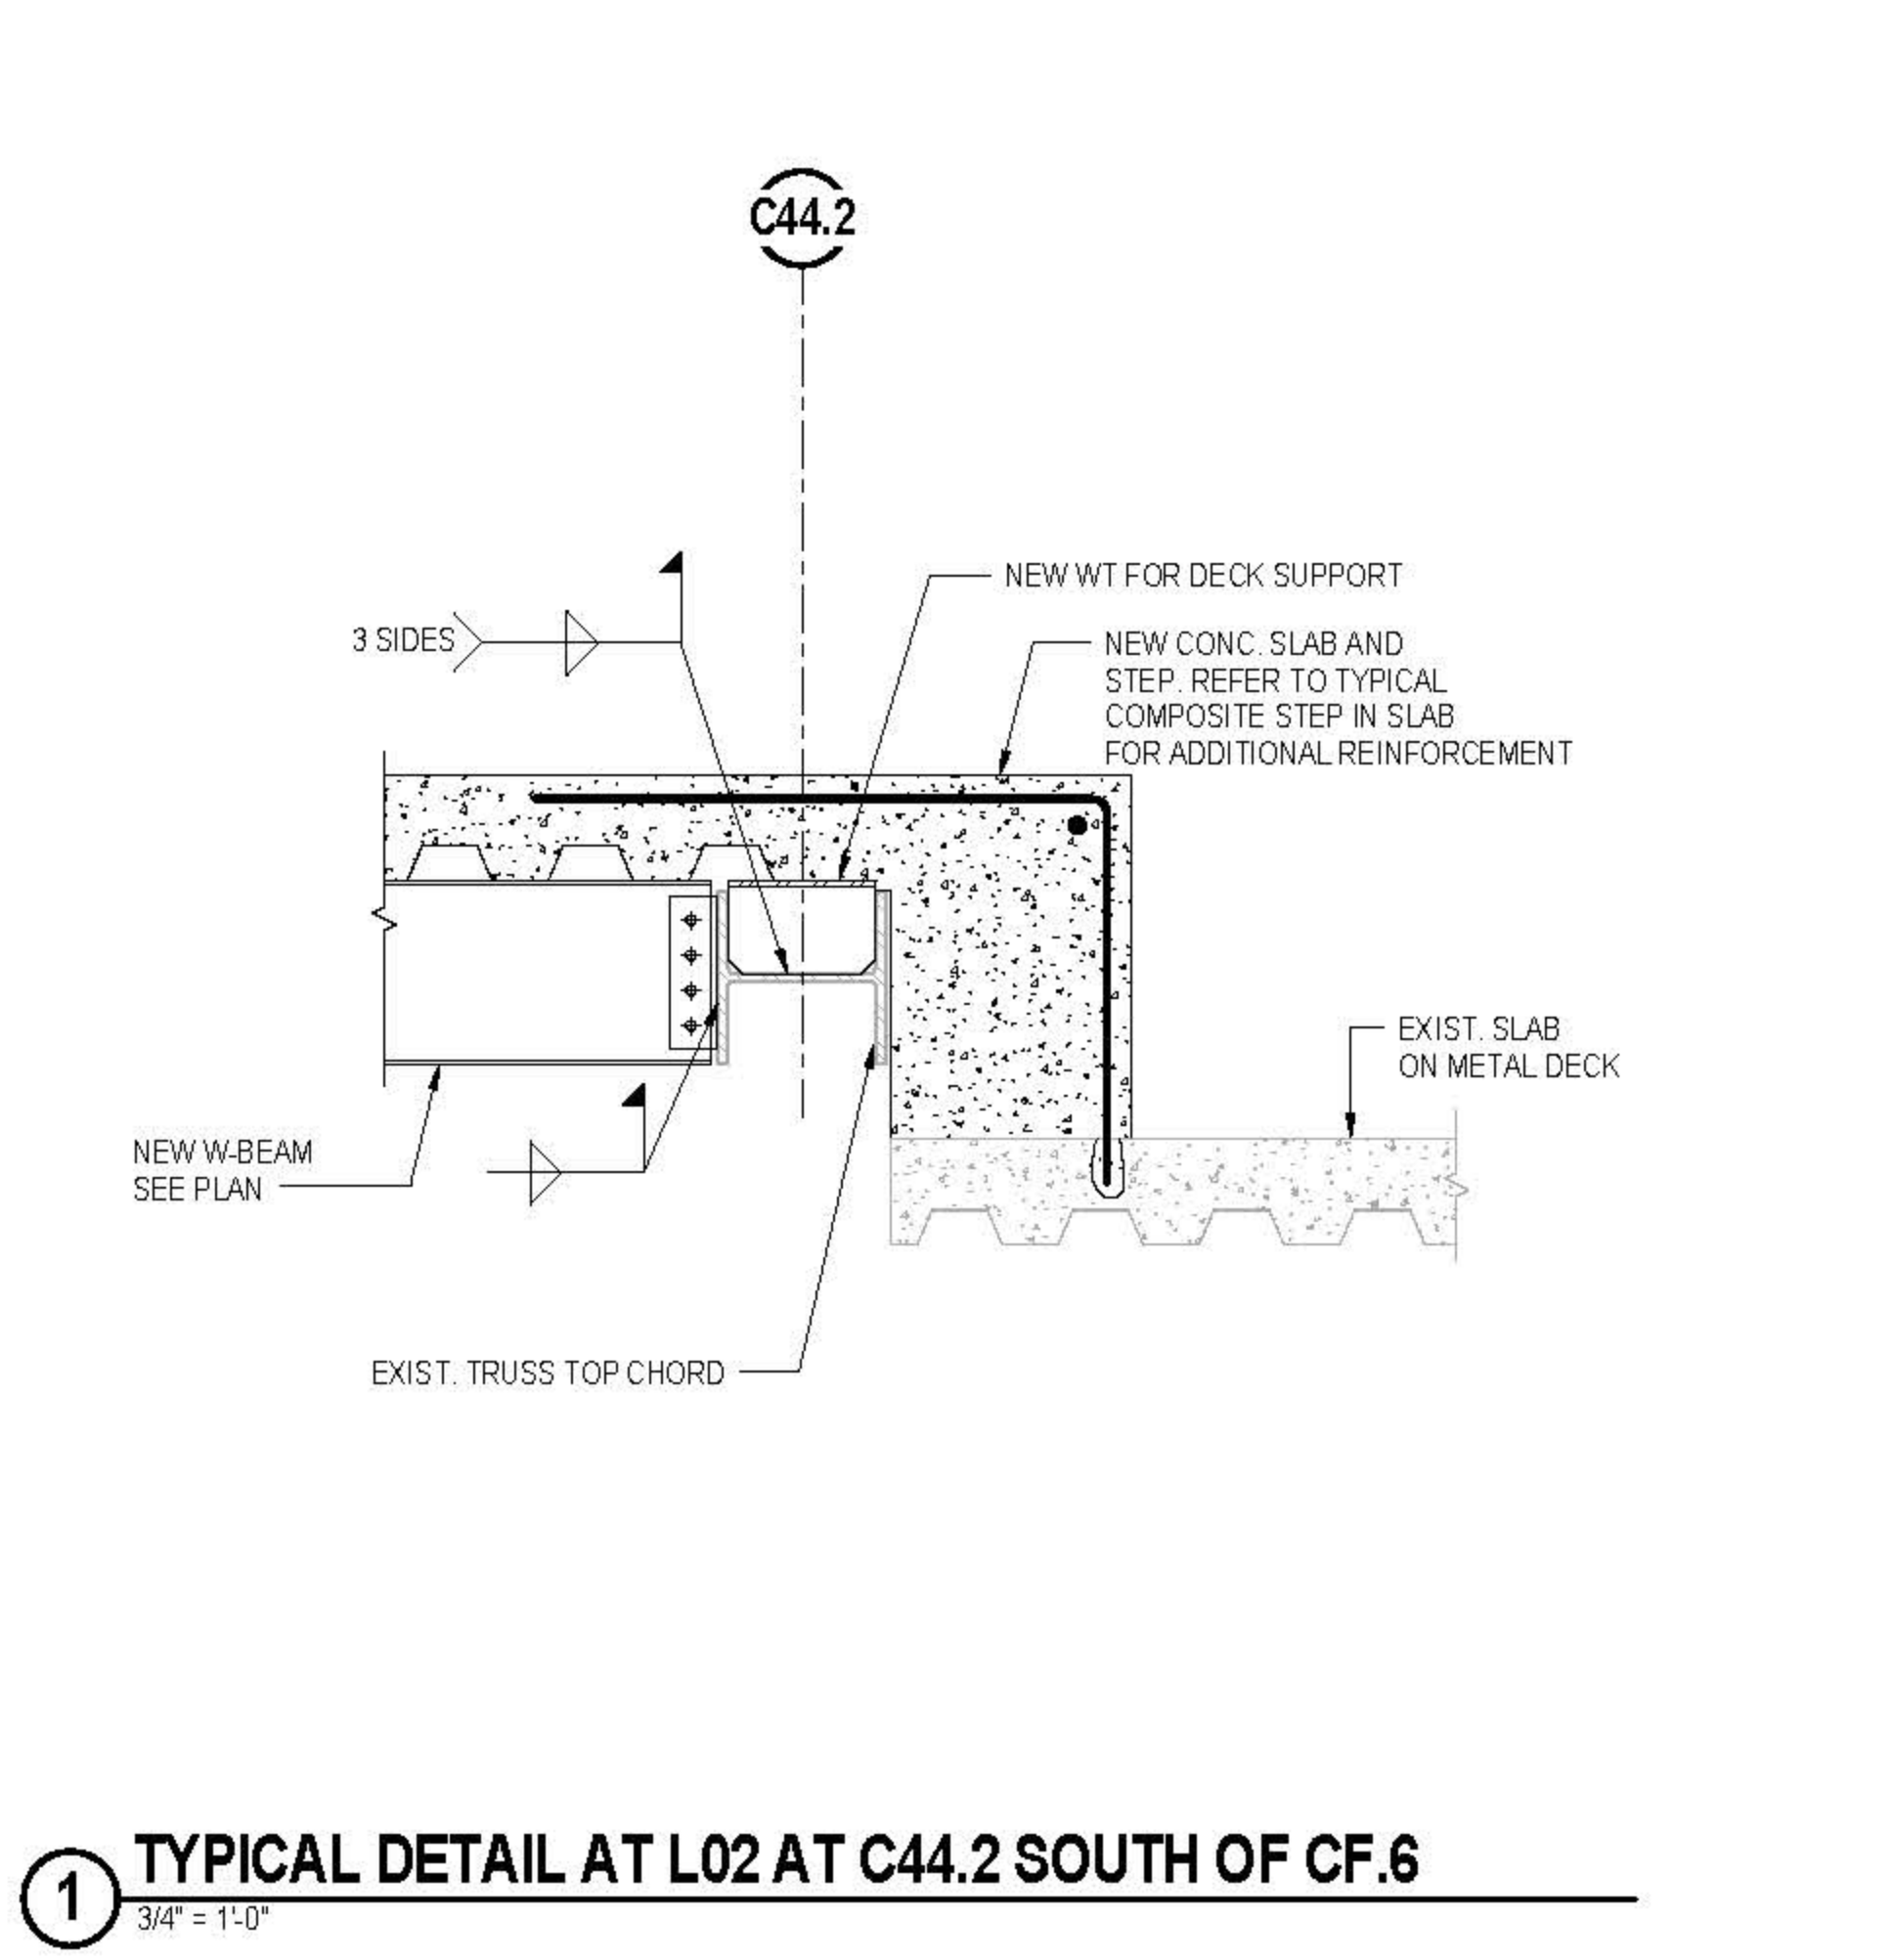


1 TYPICAL DETAIL AT L02 AT C44.2 SOUTH OF CF.6
3/4" = 1'-0"

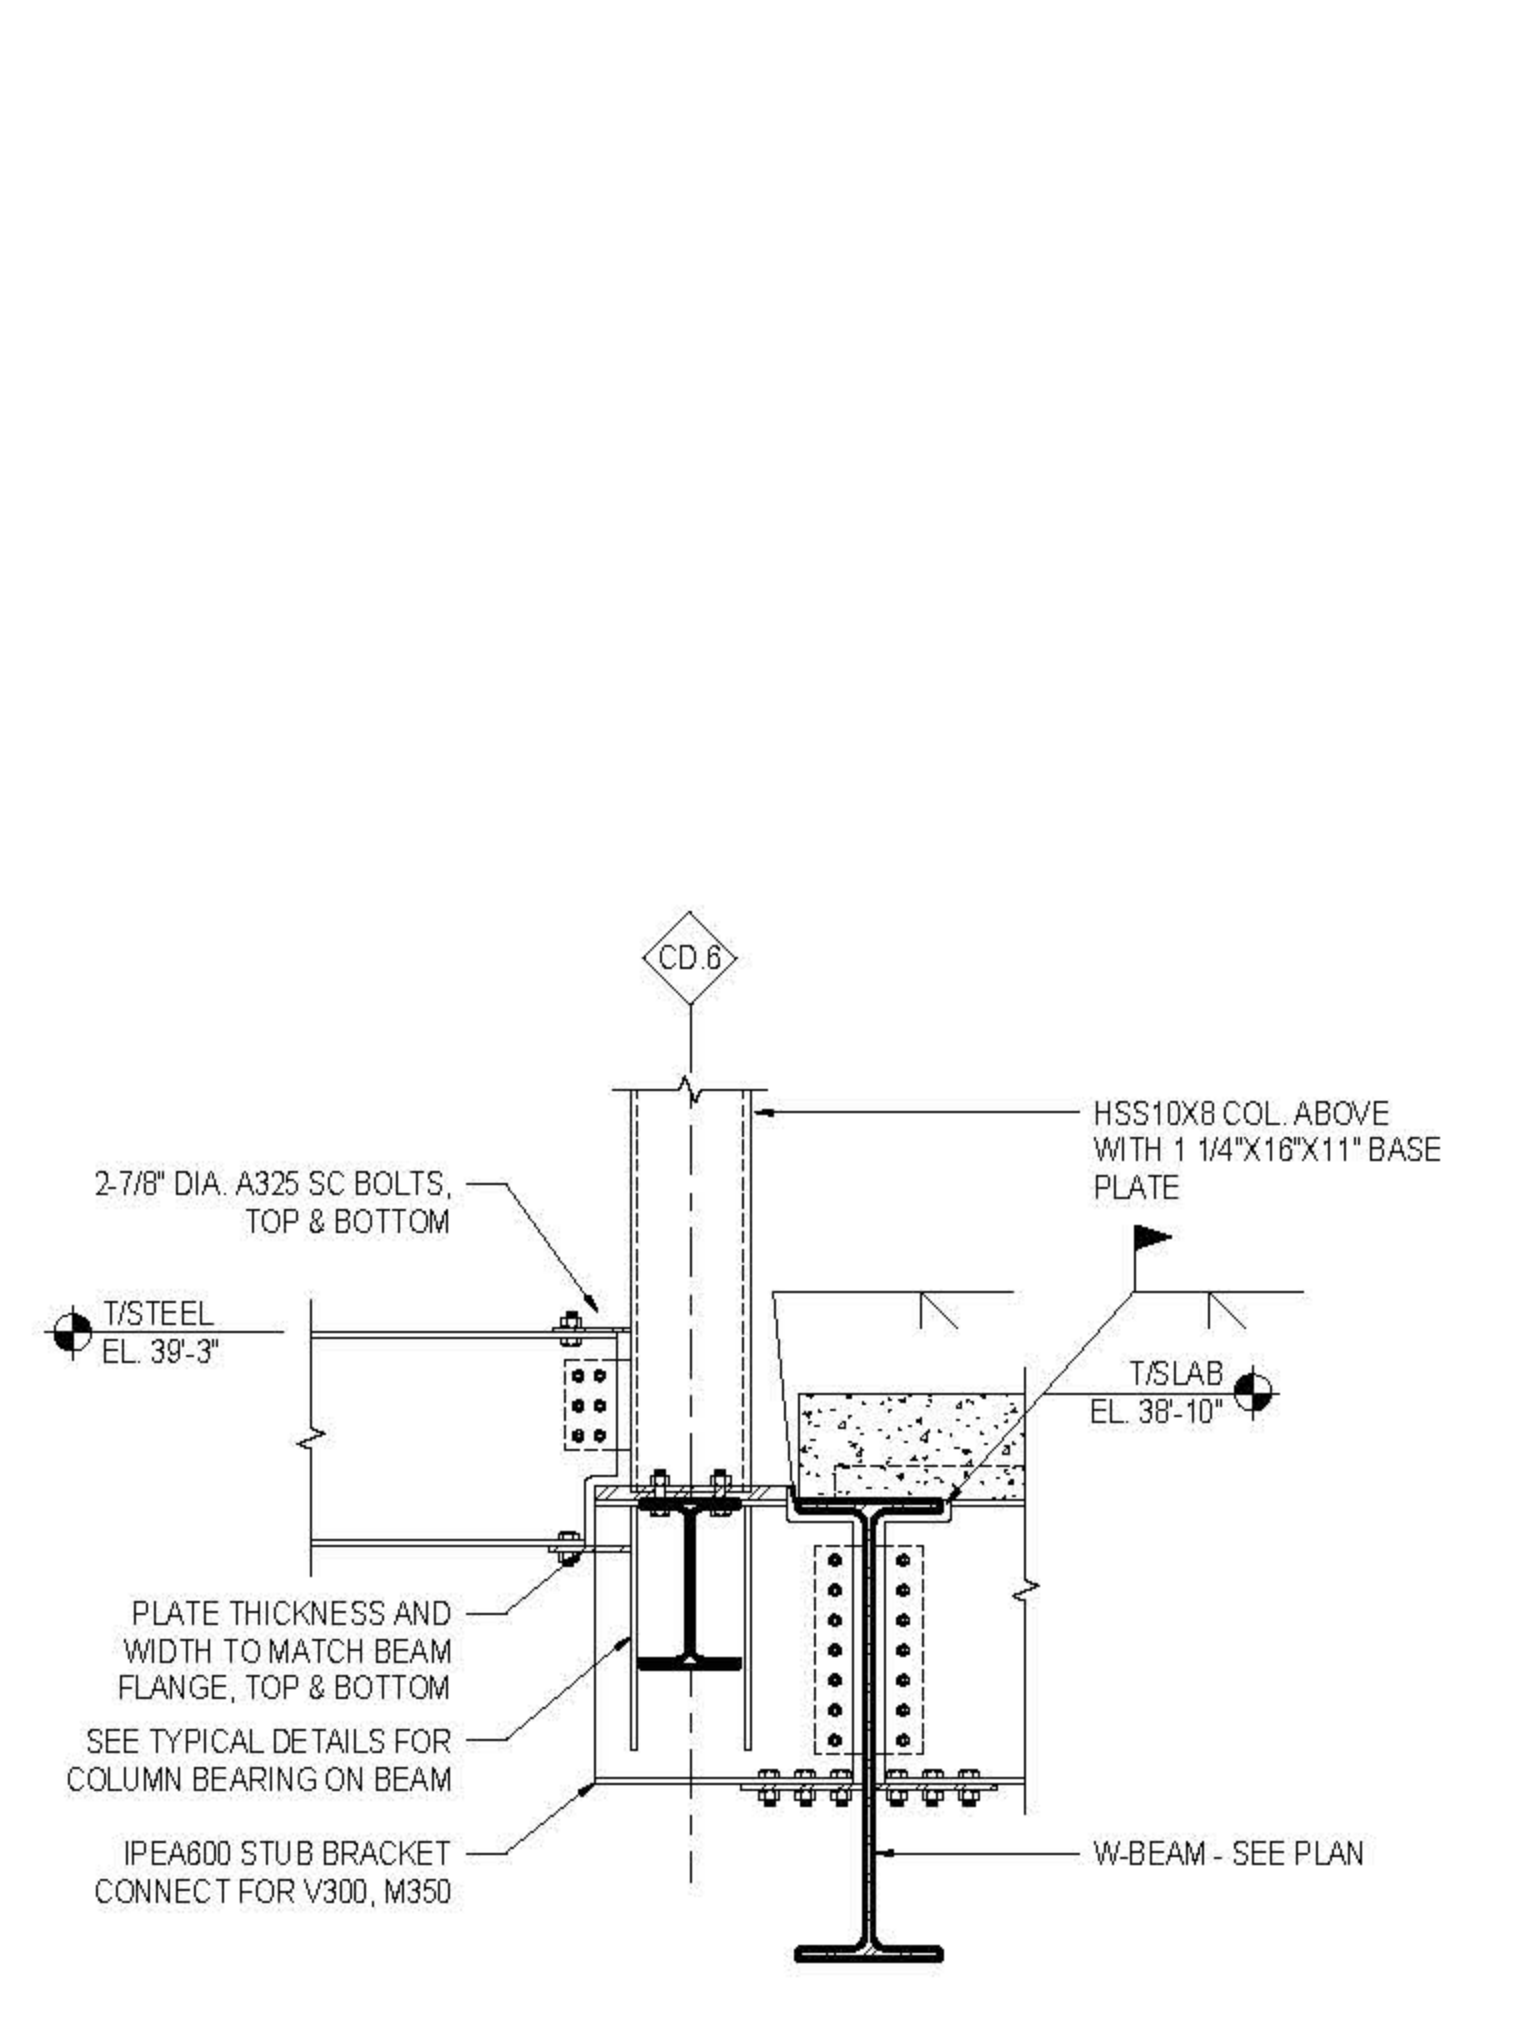


7 SECTION @ CORE E COLUMN TRANSFER
3/4" = 1'-0"

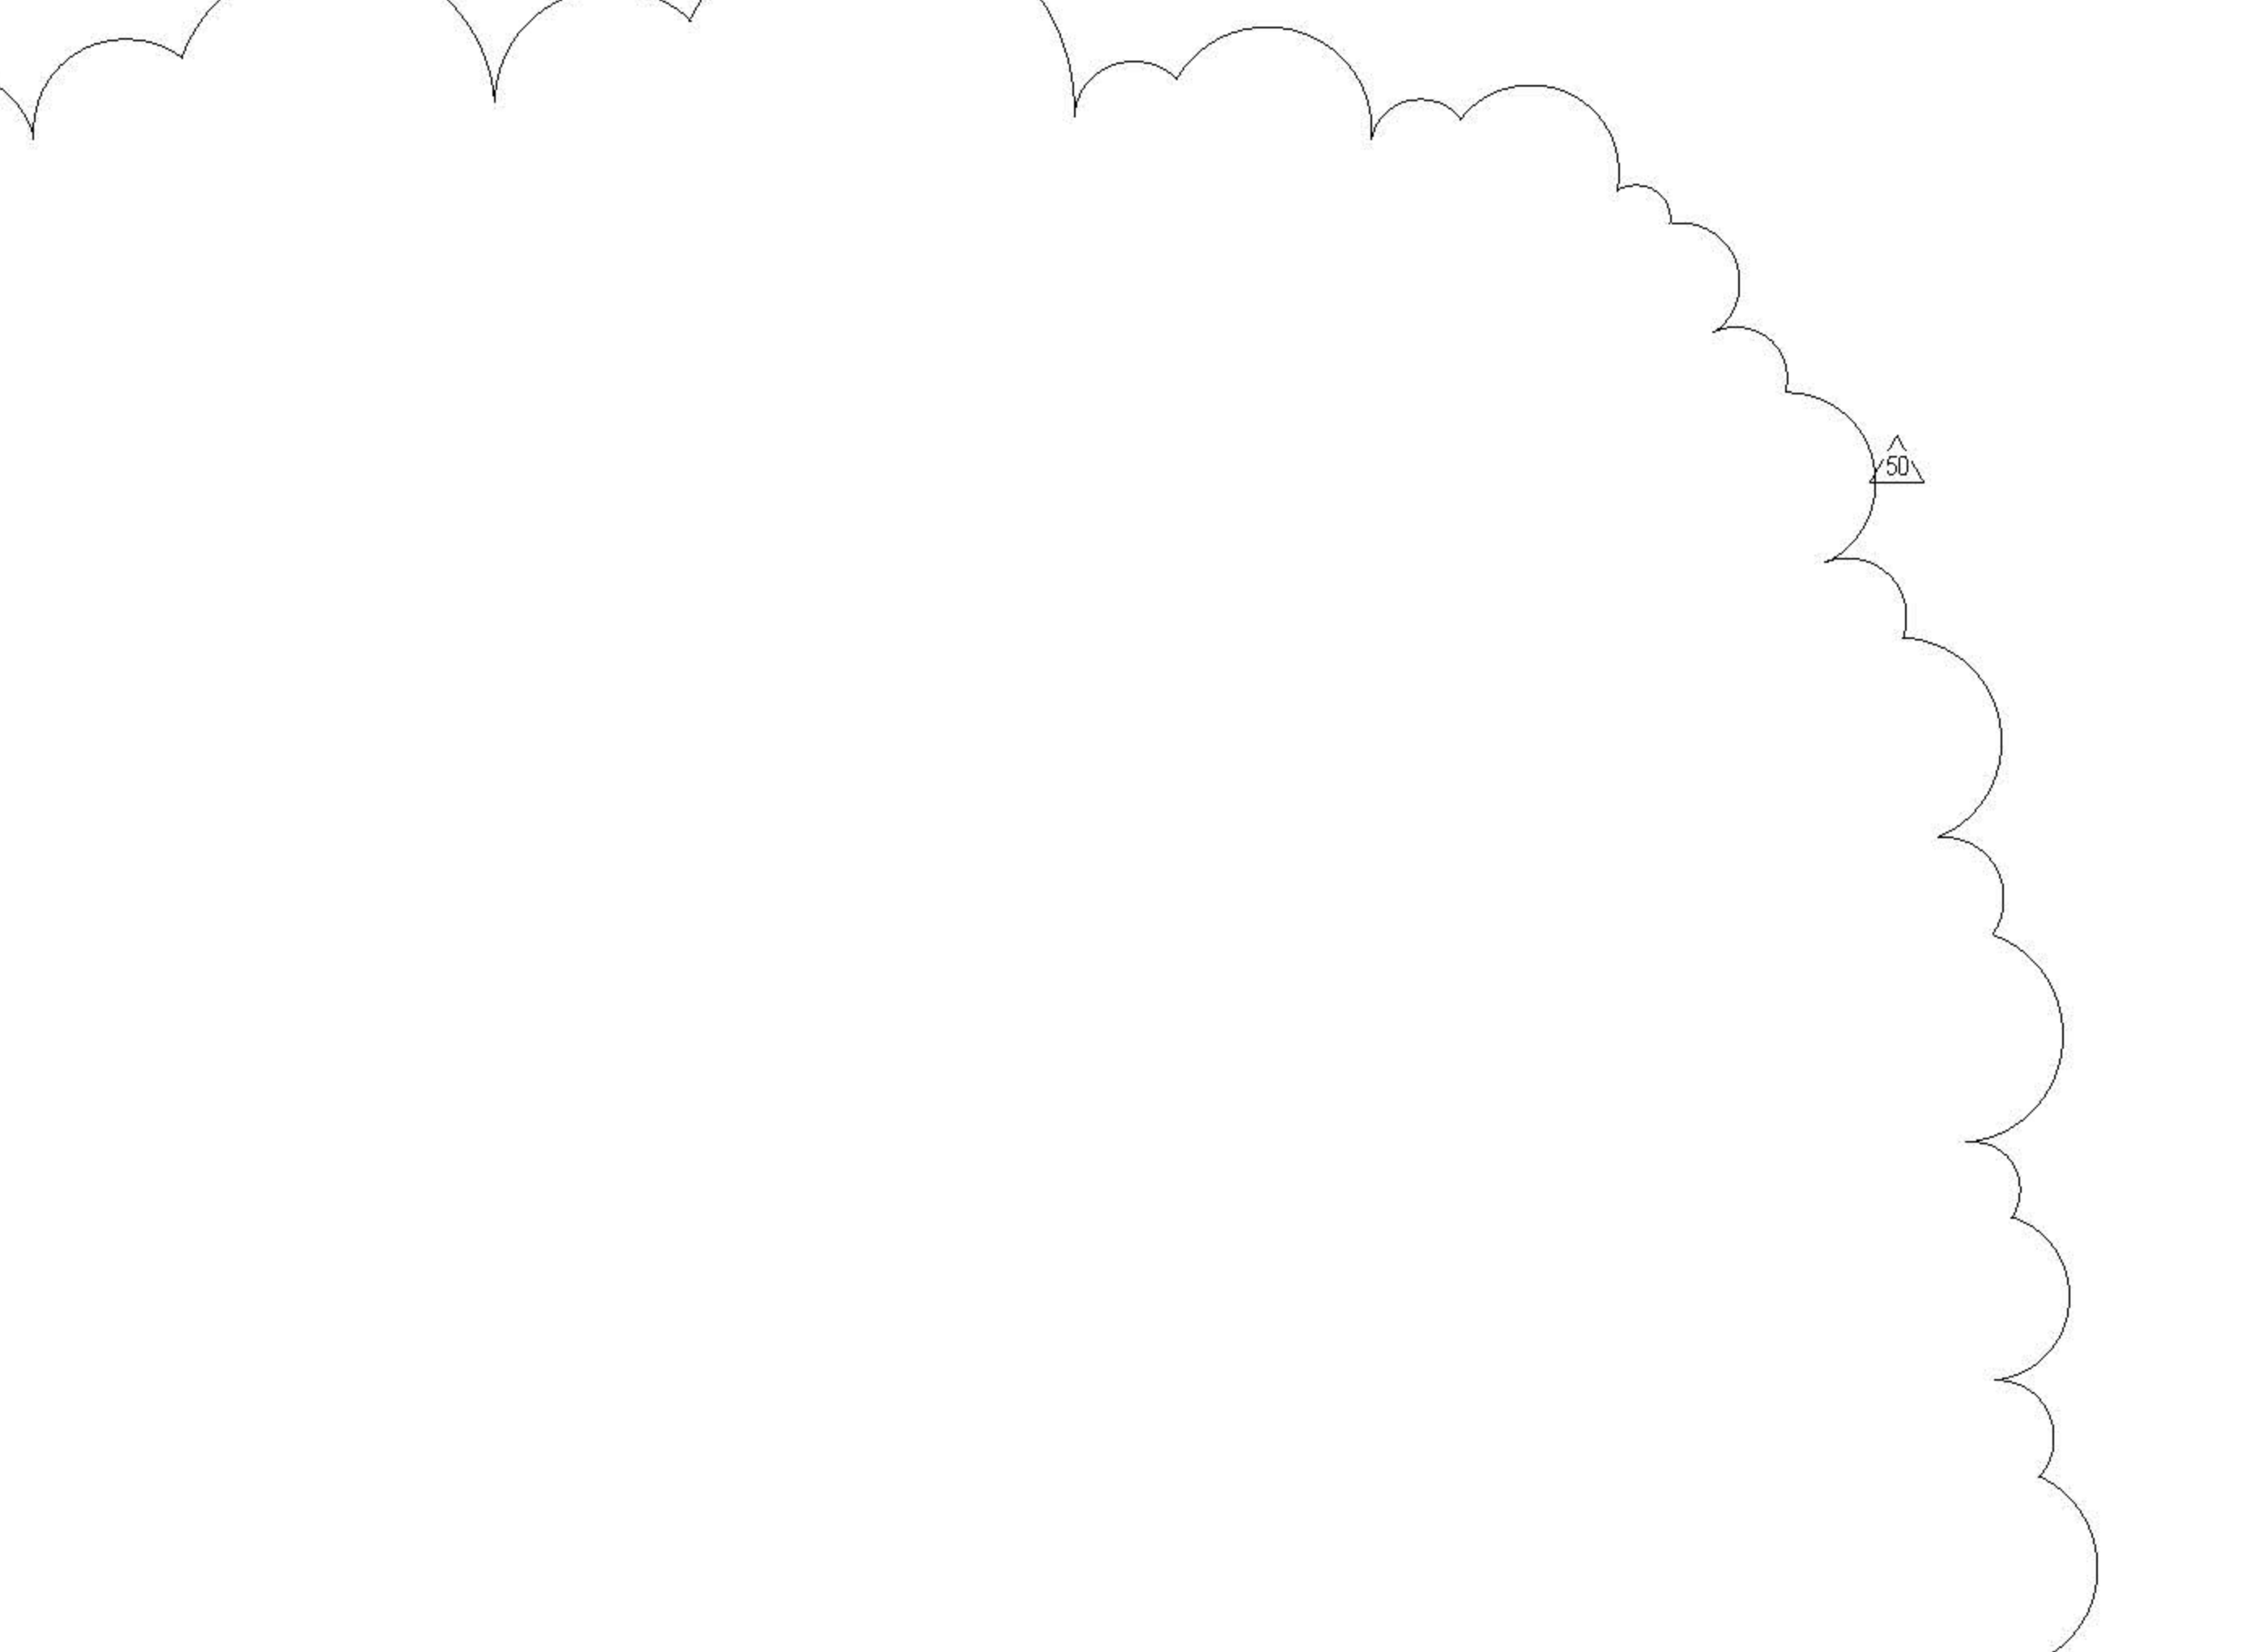


8 SECTION @ C46.3/CD.6 COLUMN TRANSFER
3/4" = 1'-0"

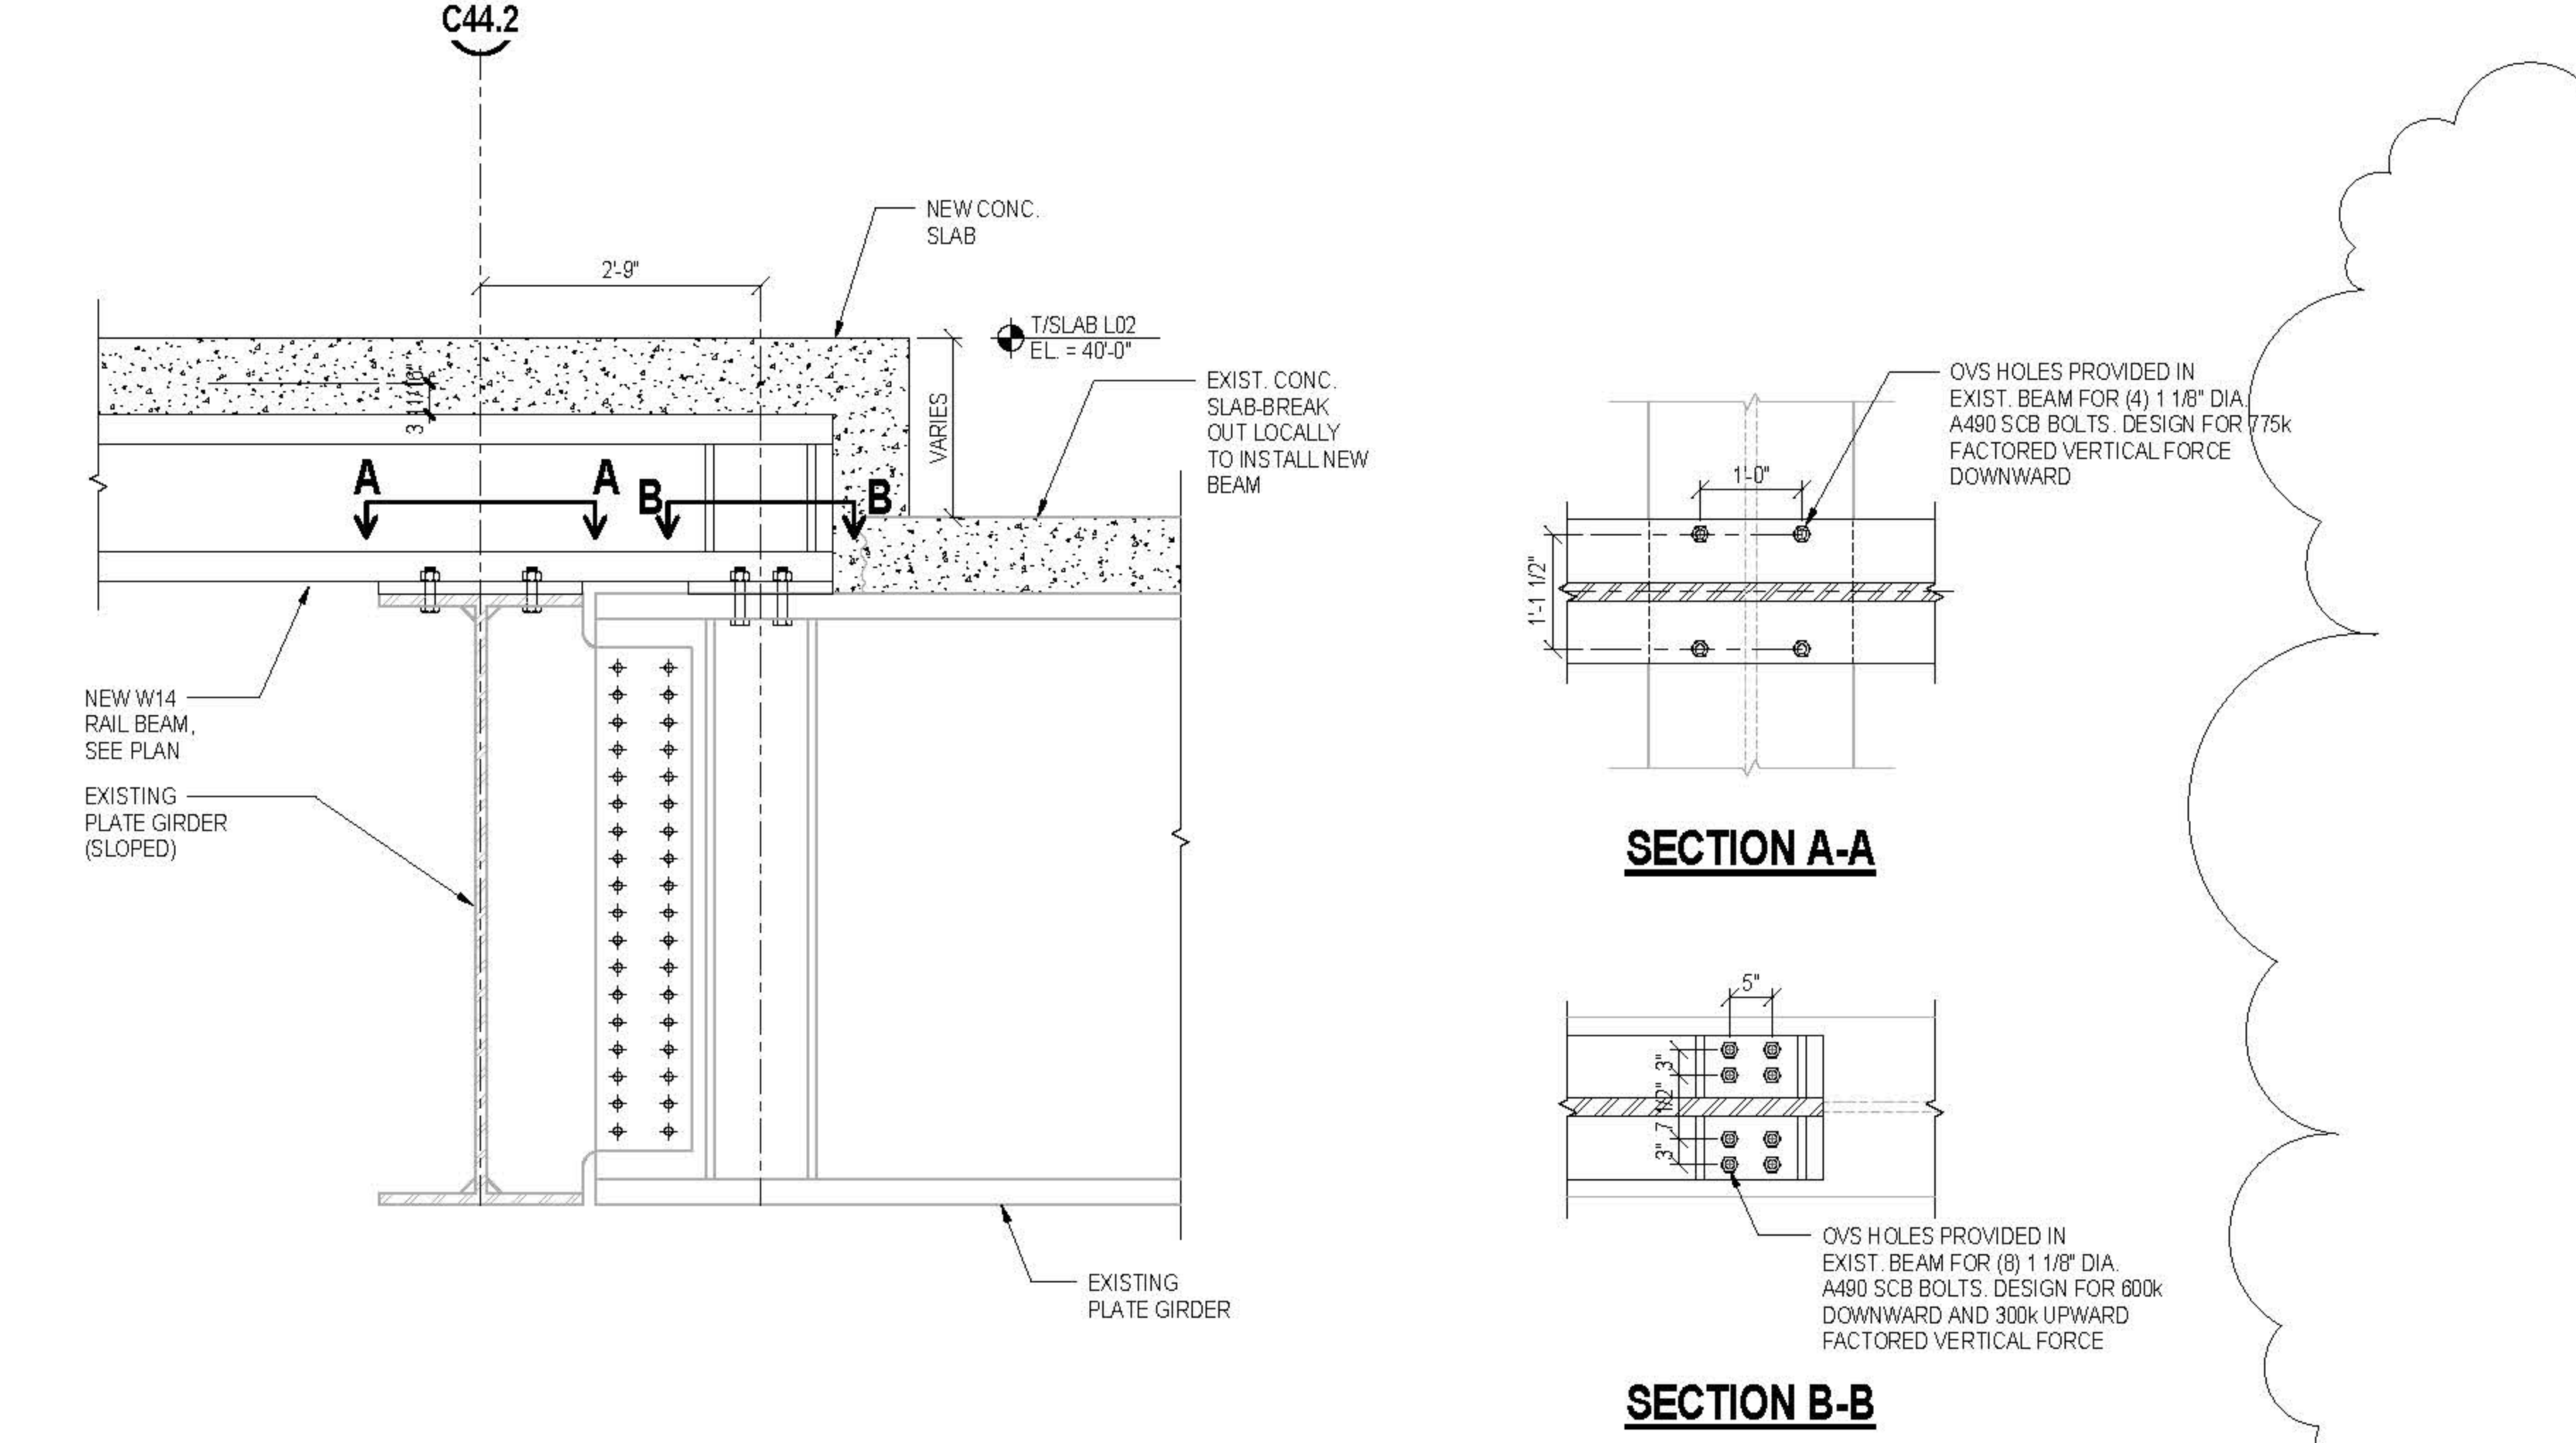

6 SECTION AT NORTH RAIL BEAM CONNECTION TO EXISTING
3/4" = 1'-0"

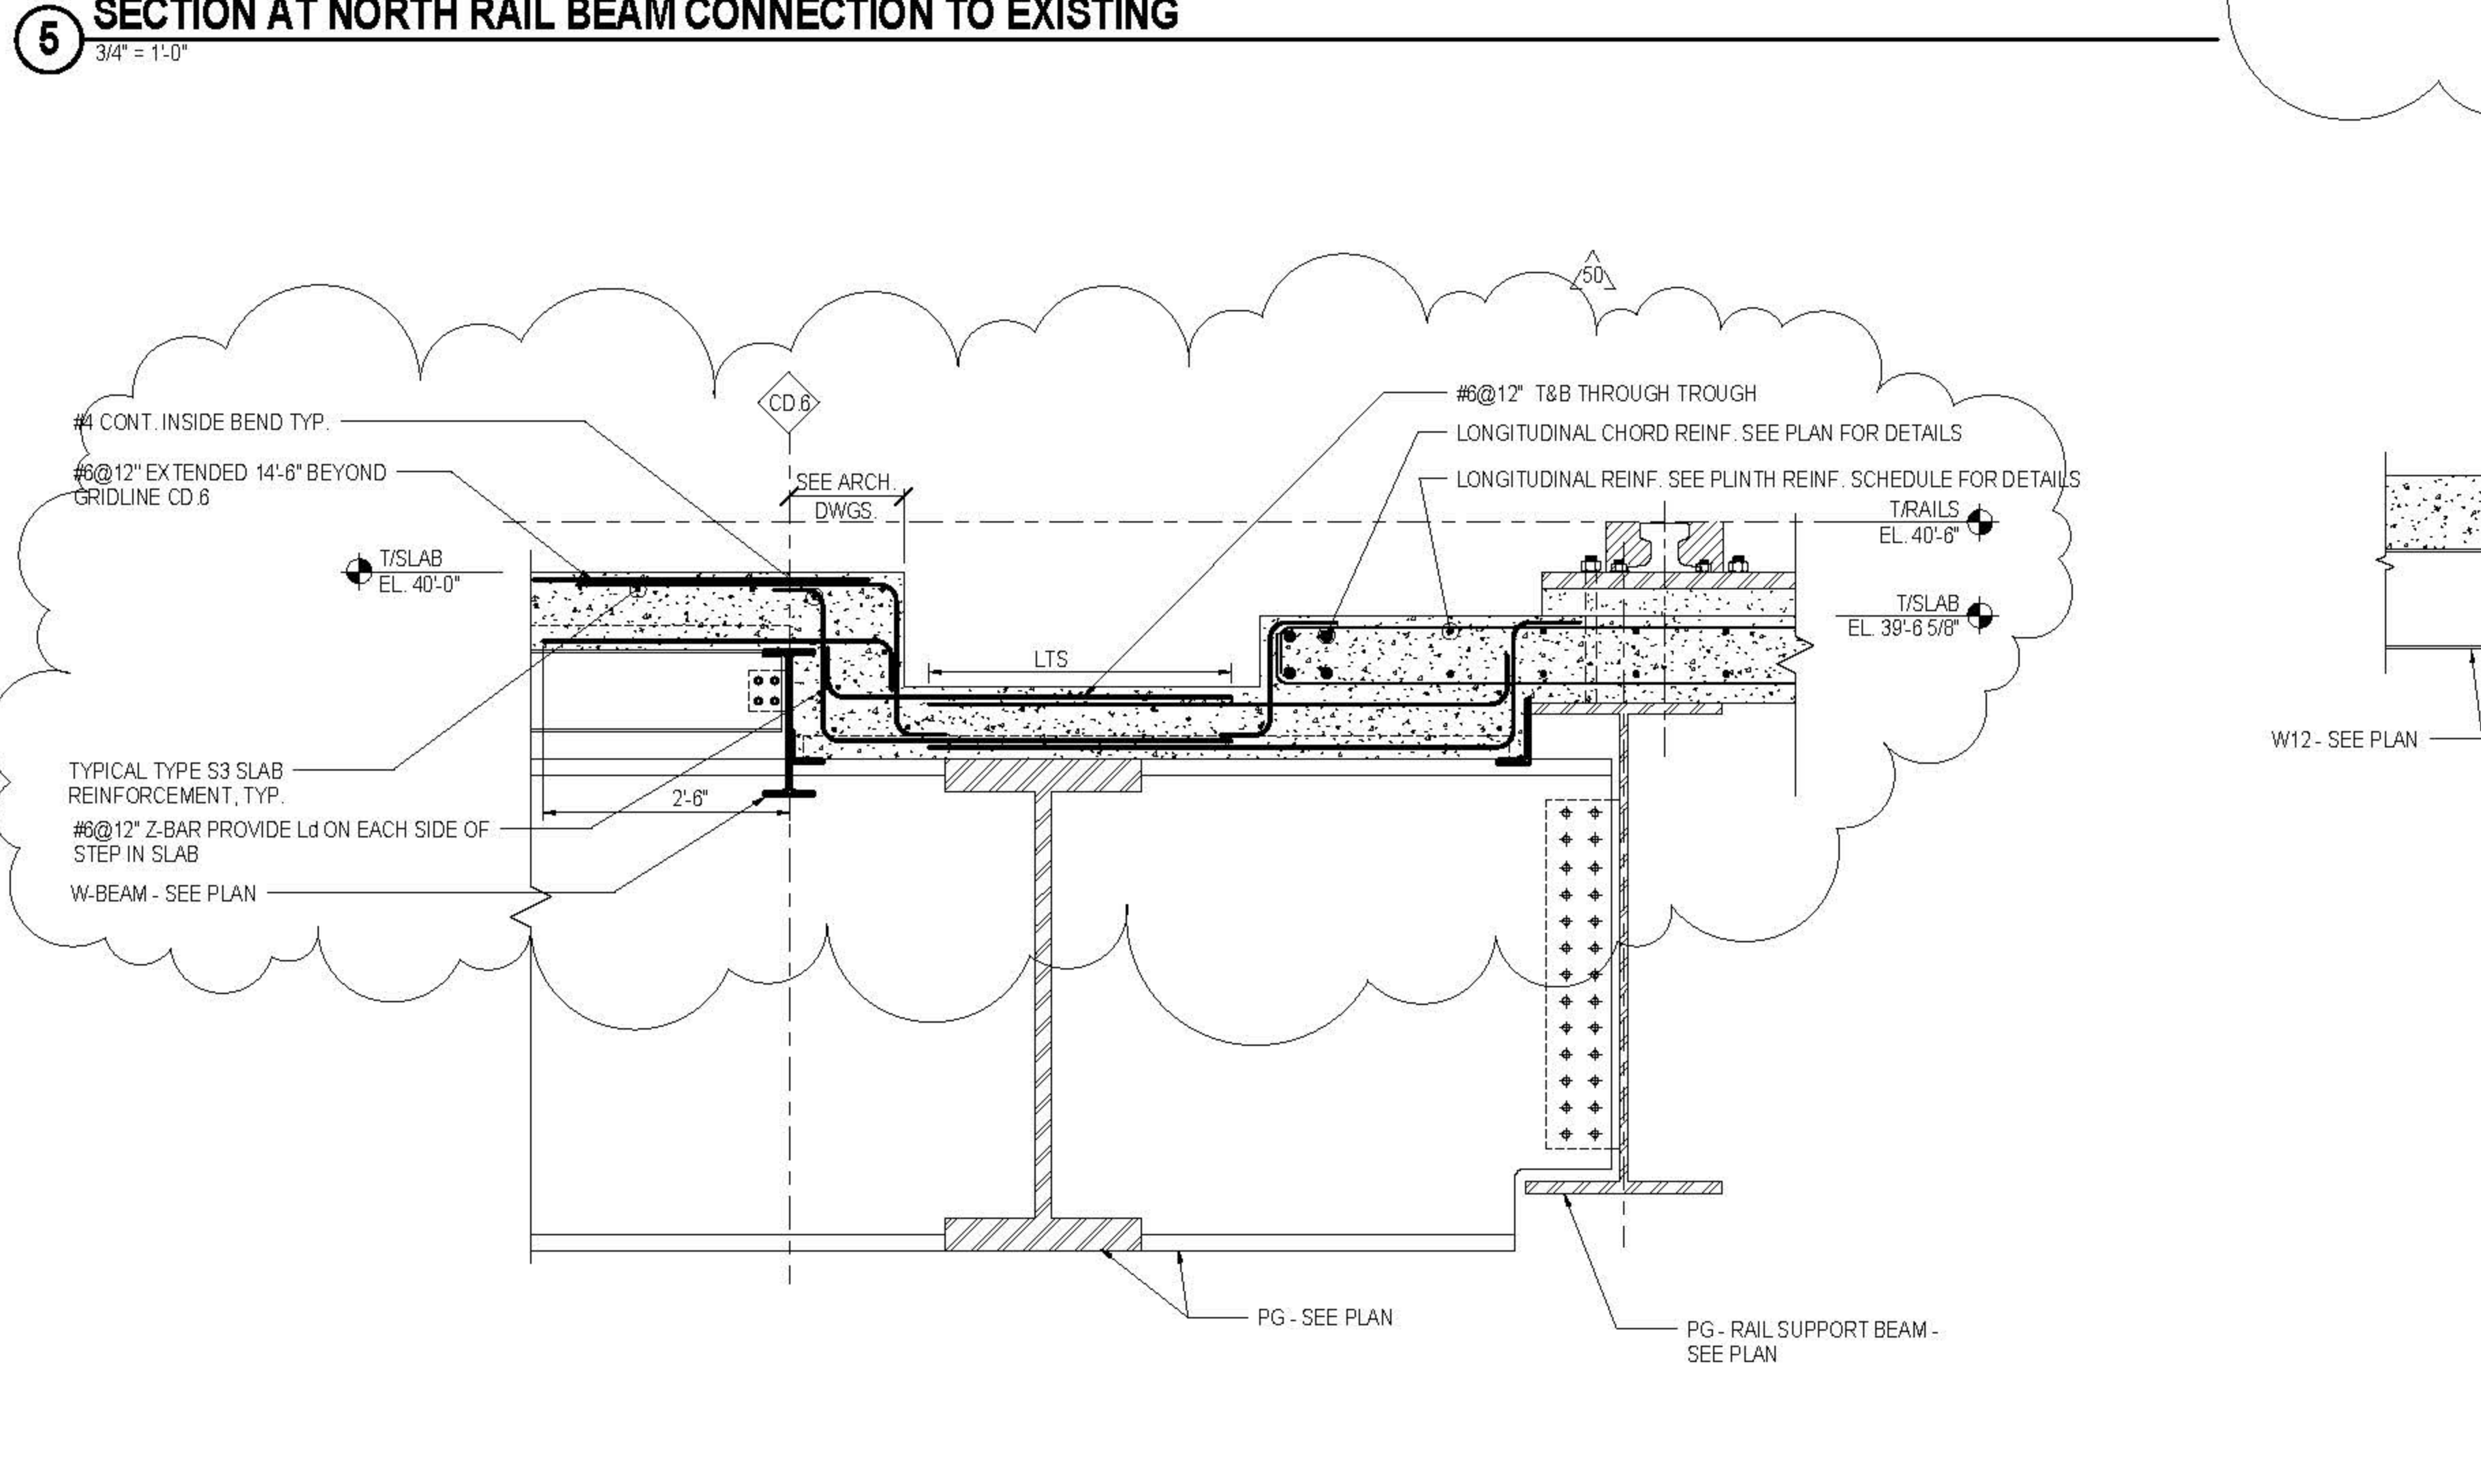


8 SECTION AT LEVEL 02 SOUTH SLAB STEPS
3/4" = 1'-0"

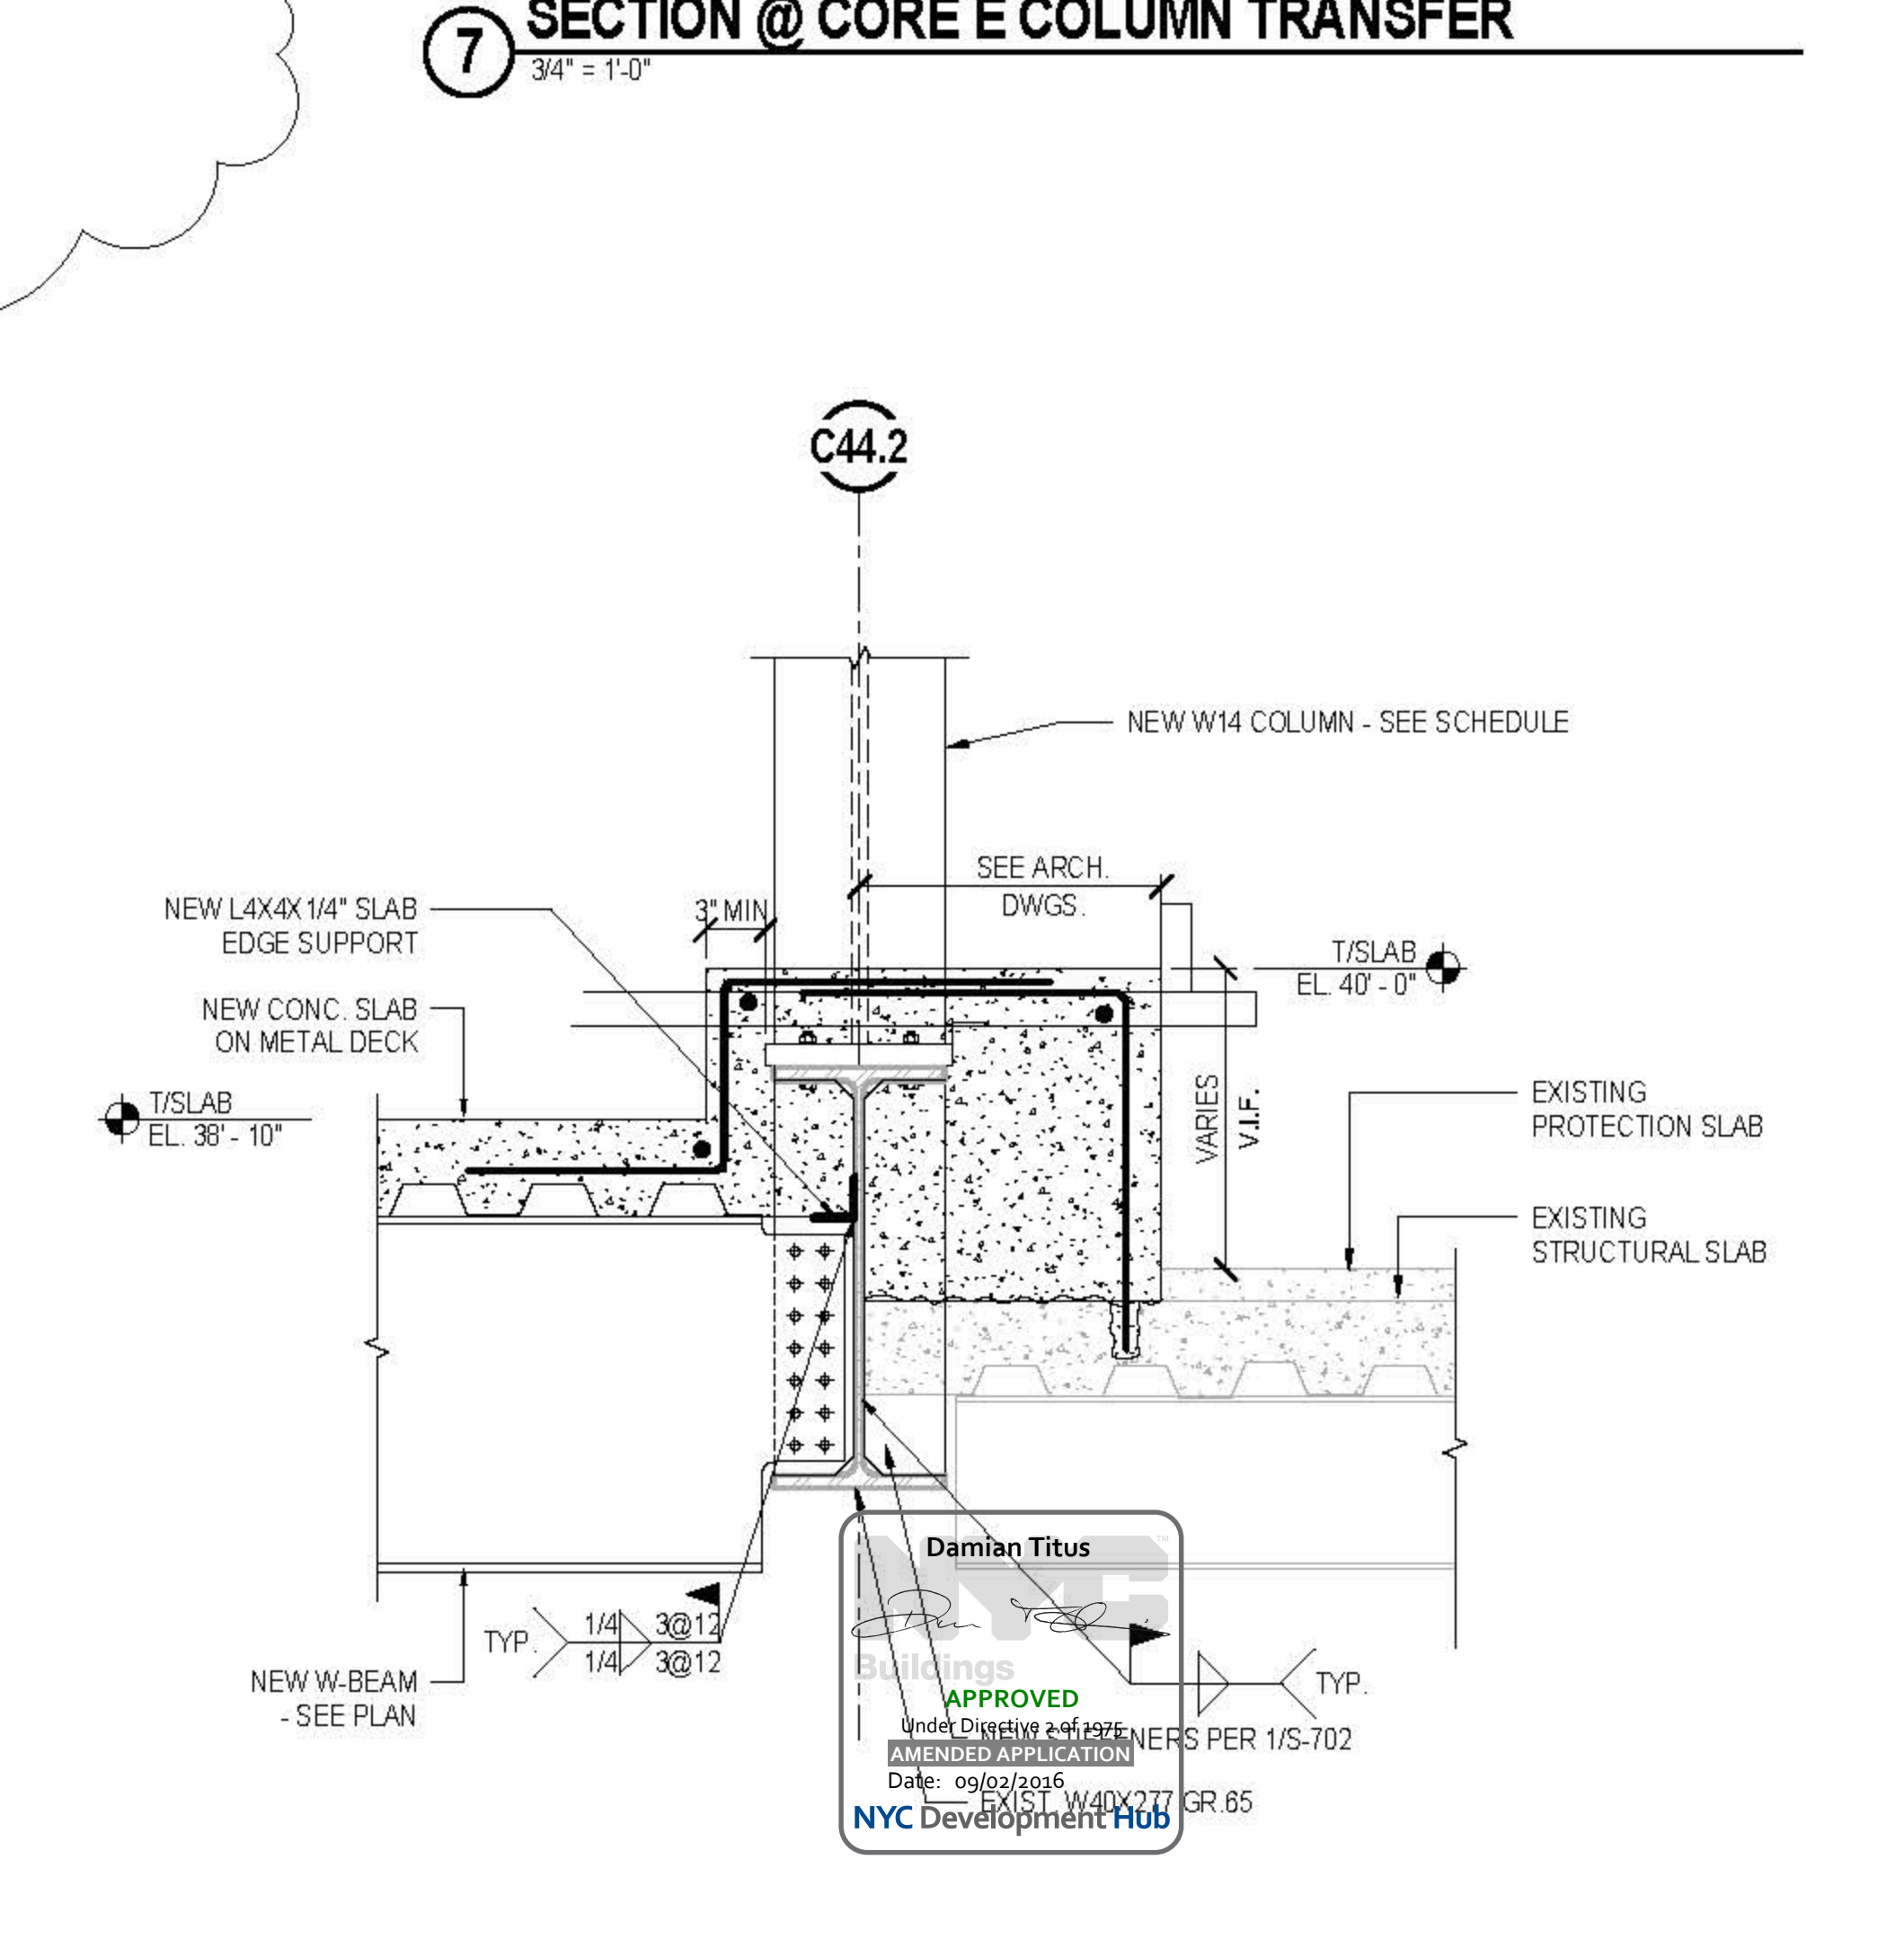

10 SECTION @ C44.2/CD.6 COLUMN TRANSFER
3/4" = 1'-0"

KEY PLAN

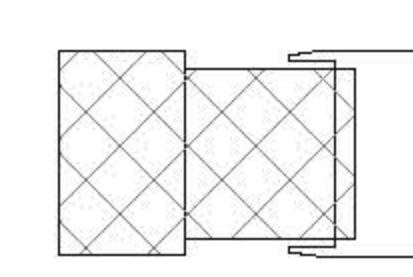

ISSUE PRINTING DATE

ISSUE	PRINTING	DATE
01	60	DOB AMENDMENT 7 08.19.2016
02	ADVISORY (BULLET TRACK)	09.07.2016
11	E	ADV. PROCEEDMENT ACCIDENT #6 04.10.2015
10	4	100% CONSTRUCTION DOCUMENTS 03.18.2015
09	6	PRELIMINARY EOB SUBMISSION 12.30.2014
3	1	ADV. PROCEEDMENT ACCIDENT #1 10.09.2014
1		ADVANCED PROCEEDMENT BID SET 06.16.2014



DRAWN BY
Autum

CHECKED BY
Chris

PROJECT NUMBER
N11318.00

TITLE
SECTIONS AND DETAILS, FIXED BUILDING
LEVEL 02 - B

DRAWING NO.
S-723.01

B.SCAN NO.
S-724.01

82 of 123

Copyright © 2016 by Oller Scaletta + Renfro Architects, D.P.C. All rights reserved.

CULTURE SHED

545 West 30th Street
New York, New York 10001

OWNER
CULTURE SHED INC.

ARCHITECTS
Oller Scaffaro + Renfro Architects, DPC
601 West 26th Street #815
New York, New York 10001
T: 212.260.7971

rockwellgroup
6 Union St. West, 6th Fl.
New York, New York 10003
T: 212.463.0334
F: 212.463.0335

STRUCTURAL ENGINEER
Thornton Tomasetti
51 Madison Avenue
New York, New York 10010
T: 917.961.7800
F: 917.961.7801

MEP ENGINEER
Jana Baum & Bolles
60 Park Street
New York, New York 10005
T: 212.530.9300
F: 212.260.6664

FACADE CONSULTANT
Thornton Tomasetti
51 Madison Avenue
New York, New York 10010
T: 917.961.7800
F: 917.961.7801

KINETICS ENGINEER
Hardisty & Hanover
1501 Broadway
New York, New York 10036
T: 212.944.1150
F: 212.391.0337

LIGHTING DESIGNER
Tilston Design Associates
40 North Street #1650
New York, New York 10013
T: 212.675.7760

THEATRE PLANNING & DESIGN
Fisher Dachs Associates
22 West 19th Street
New York, New York 10011
T: 212.691.3000

LIFE SAFETY
Code Consultants, Inc.
215 West 43rd St, 15th Fl.
New York, New York 10018
T: 212.216.9596

ENERGY MODEL/LEED
Vindian
60 Washington Street
Norwalk, CT 06854
T: 203.298.1411

ACOUSTIC/AUDIO-VISUAL
Avenelle
93 North Main Street
South Norwalk, CT 06854
T: 347.210.5540

VERTICAL TRANSPORTATION
Van Dusen & Associates
5 Regent Street, Suite 624
Livingston, NJ 07039
T: 973.994.9220

SPECIFICATIONS
Construction Specifications Inc.
PO Box 489
227 Tenth Road
Morganville, NJ 07751
T: 732.970.0700
F: 732.920.0700


SECURITY
Duchella Venter & Santoro
1020 Sherman Avenue
Hartford, CT 06114
T: 203.286.6490

WATERPROOFING
James R. Galford AIA Consulting Architects PC
104 West 27th Street
New York, NY 10001
T: 212.736.3344

FACADE MAINTENANCE
Erick Engineering PLLC
356 Ave. Street
New York, NY 10005
T: 212.698.3000

BRANDING/GRAPHICS
21st Global Design Consultancy
180 Varck Street 15th Floor
New York, NY 10014
T: 212.647.1170

KEY PLAN

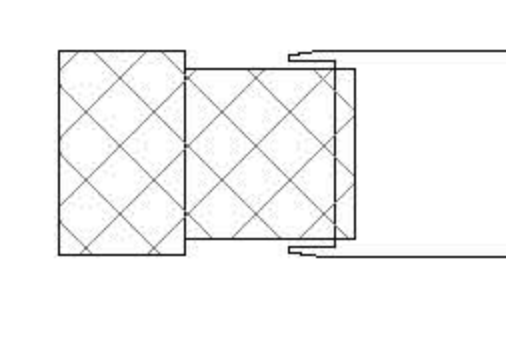

ISSUE PRINTING DATE

ISSUE	PRINTING	DATE
01	50 DOB AMENDMENT 7	08.19.2016
11	6 ADV. PROCUREMENT ADDENDUM 6	04.19.2016
10	4 100% CONSTRUCTION DOCUMENTS	03.31.2015
5	PRELIMINARY DOB SUBMISSION	12.10.2014
1	ADVANCED PROCUREMENT BID SET	06.16.2014

STAMP



DRAWN BY: **Autum** CHECKED BY: **Chris**


PROJECT NUMBER: **N11318.00**

TITLE: **SECTIONS AND DETAILS, FIXED BUILDING L04 TO L08 - 1**


DRAWING NO.: **8-724.01**

B.SCAN NO.: **S-725.01**


83 of 123

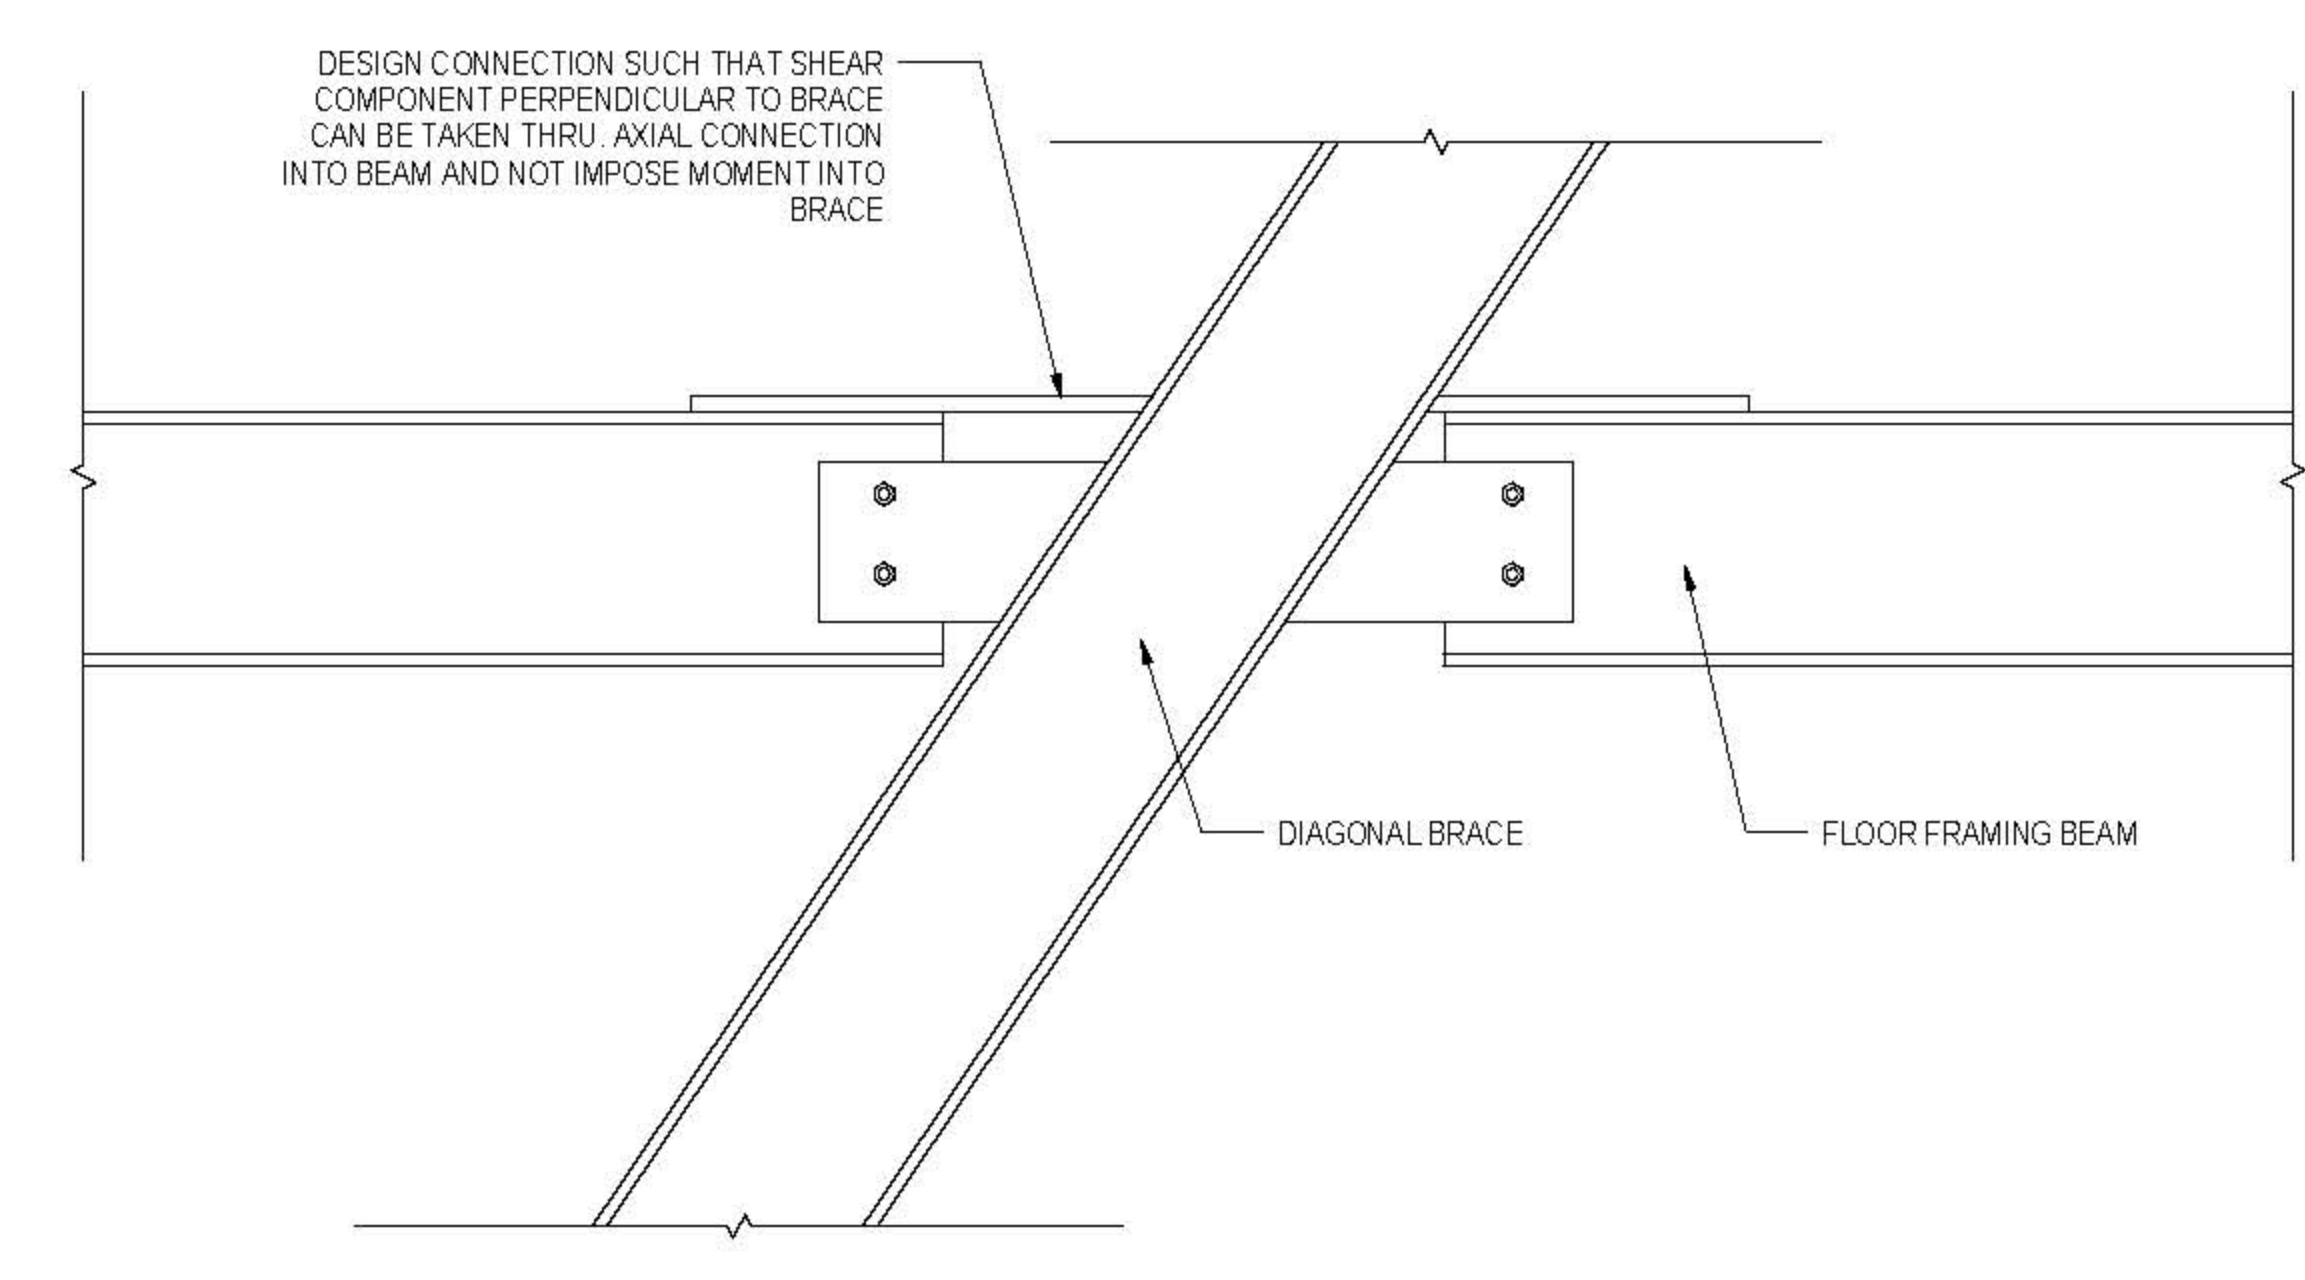


1 BEAM CONNECTION DETAIL AT DIAGONAL BRACE
1" = 1'-0"

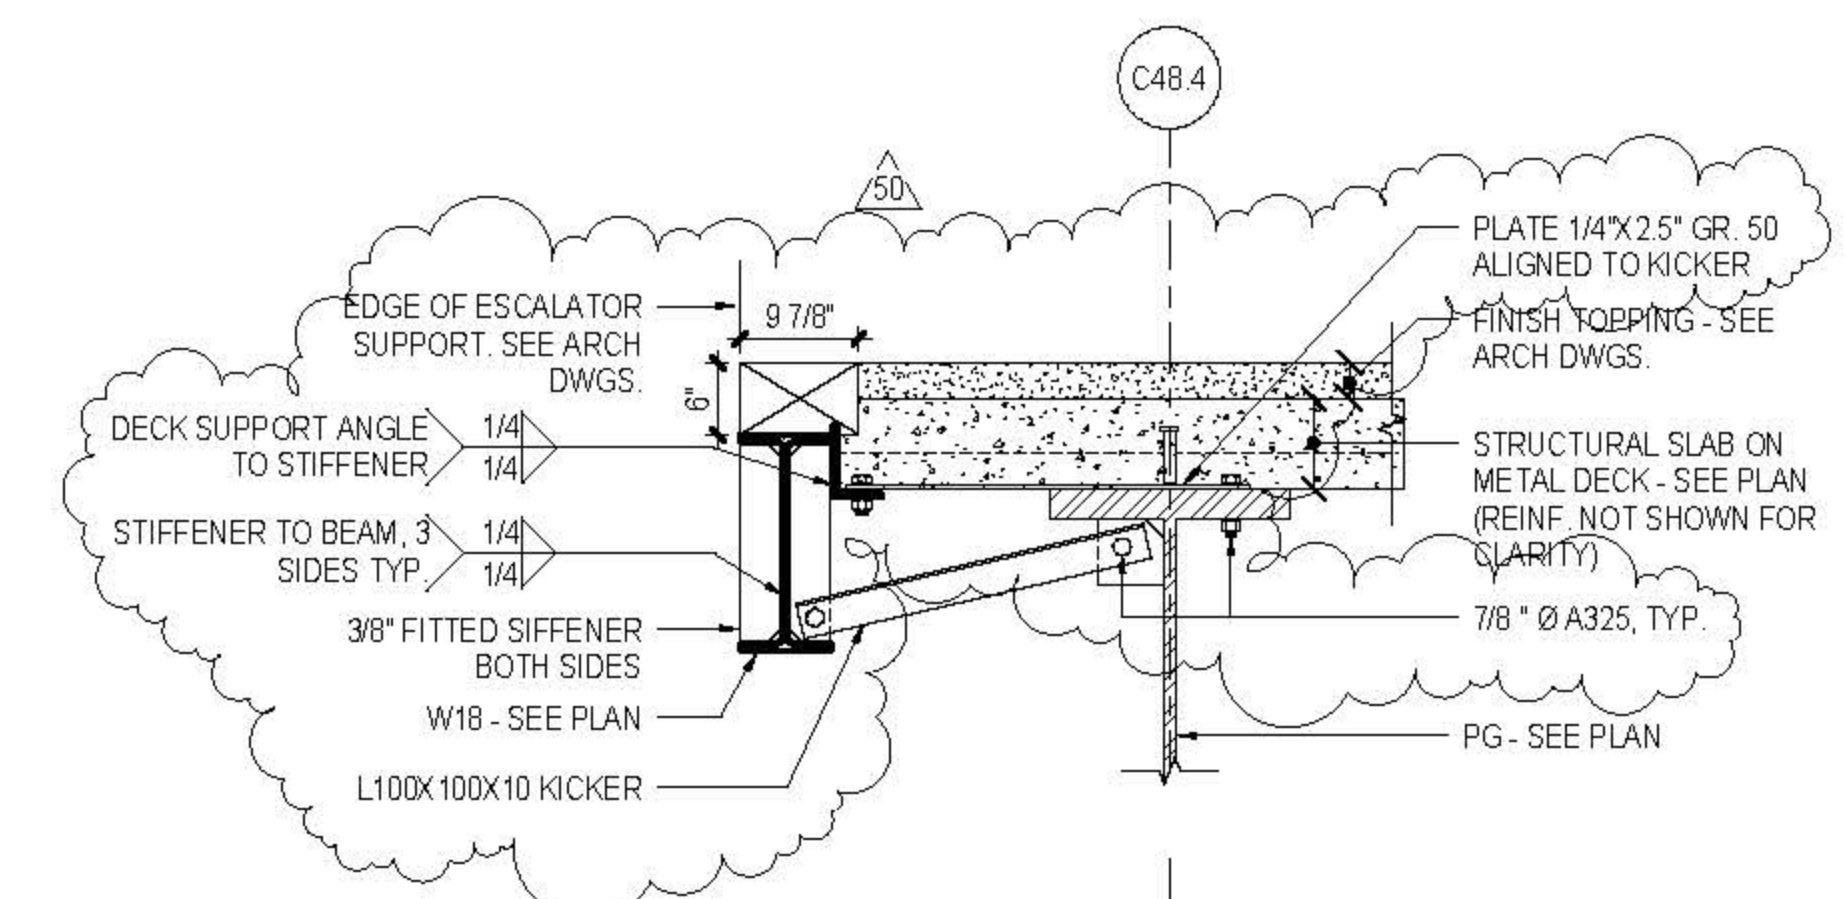


3 SECTION AT LEVEL 04 EAST ESCALATOR SUPPORT
3/4" = 1'-0"

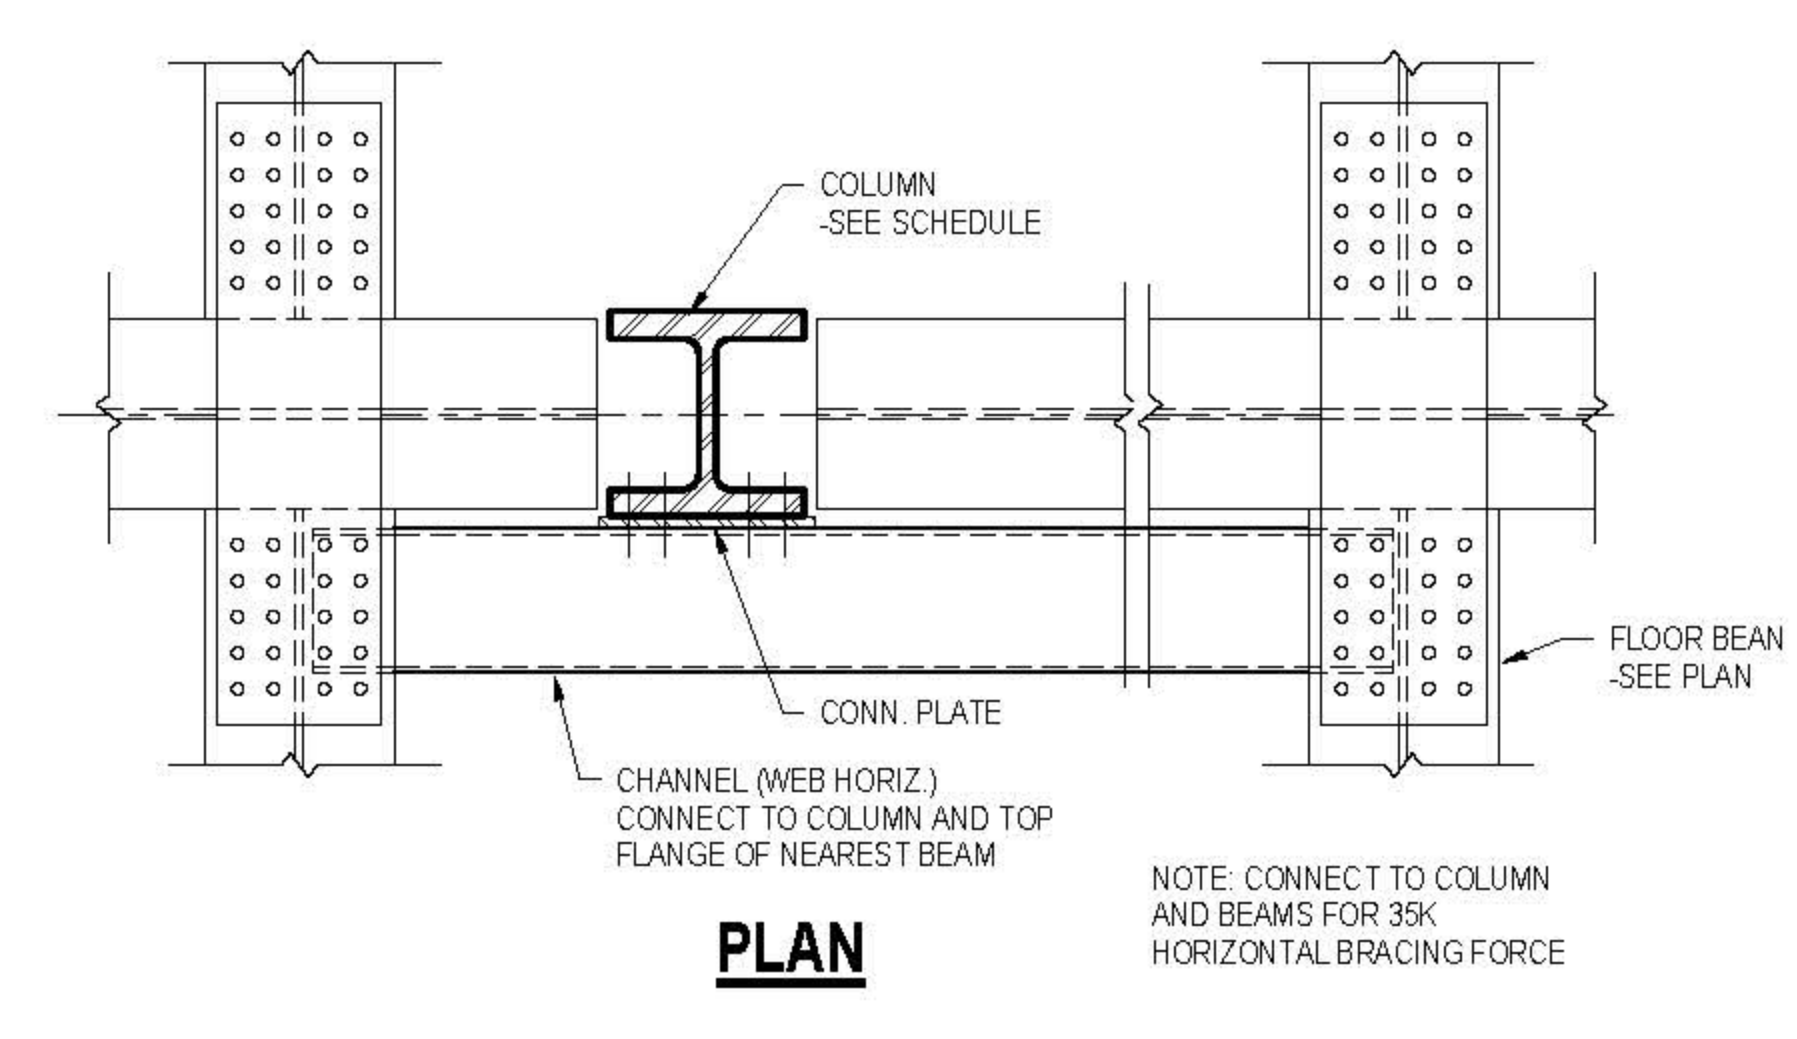


4 TYPICAL COLUMN BRACING AT OFFSET FLOOR BEAMS
3/4" = 1'-0"

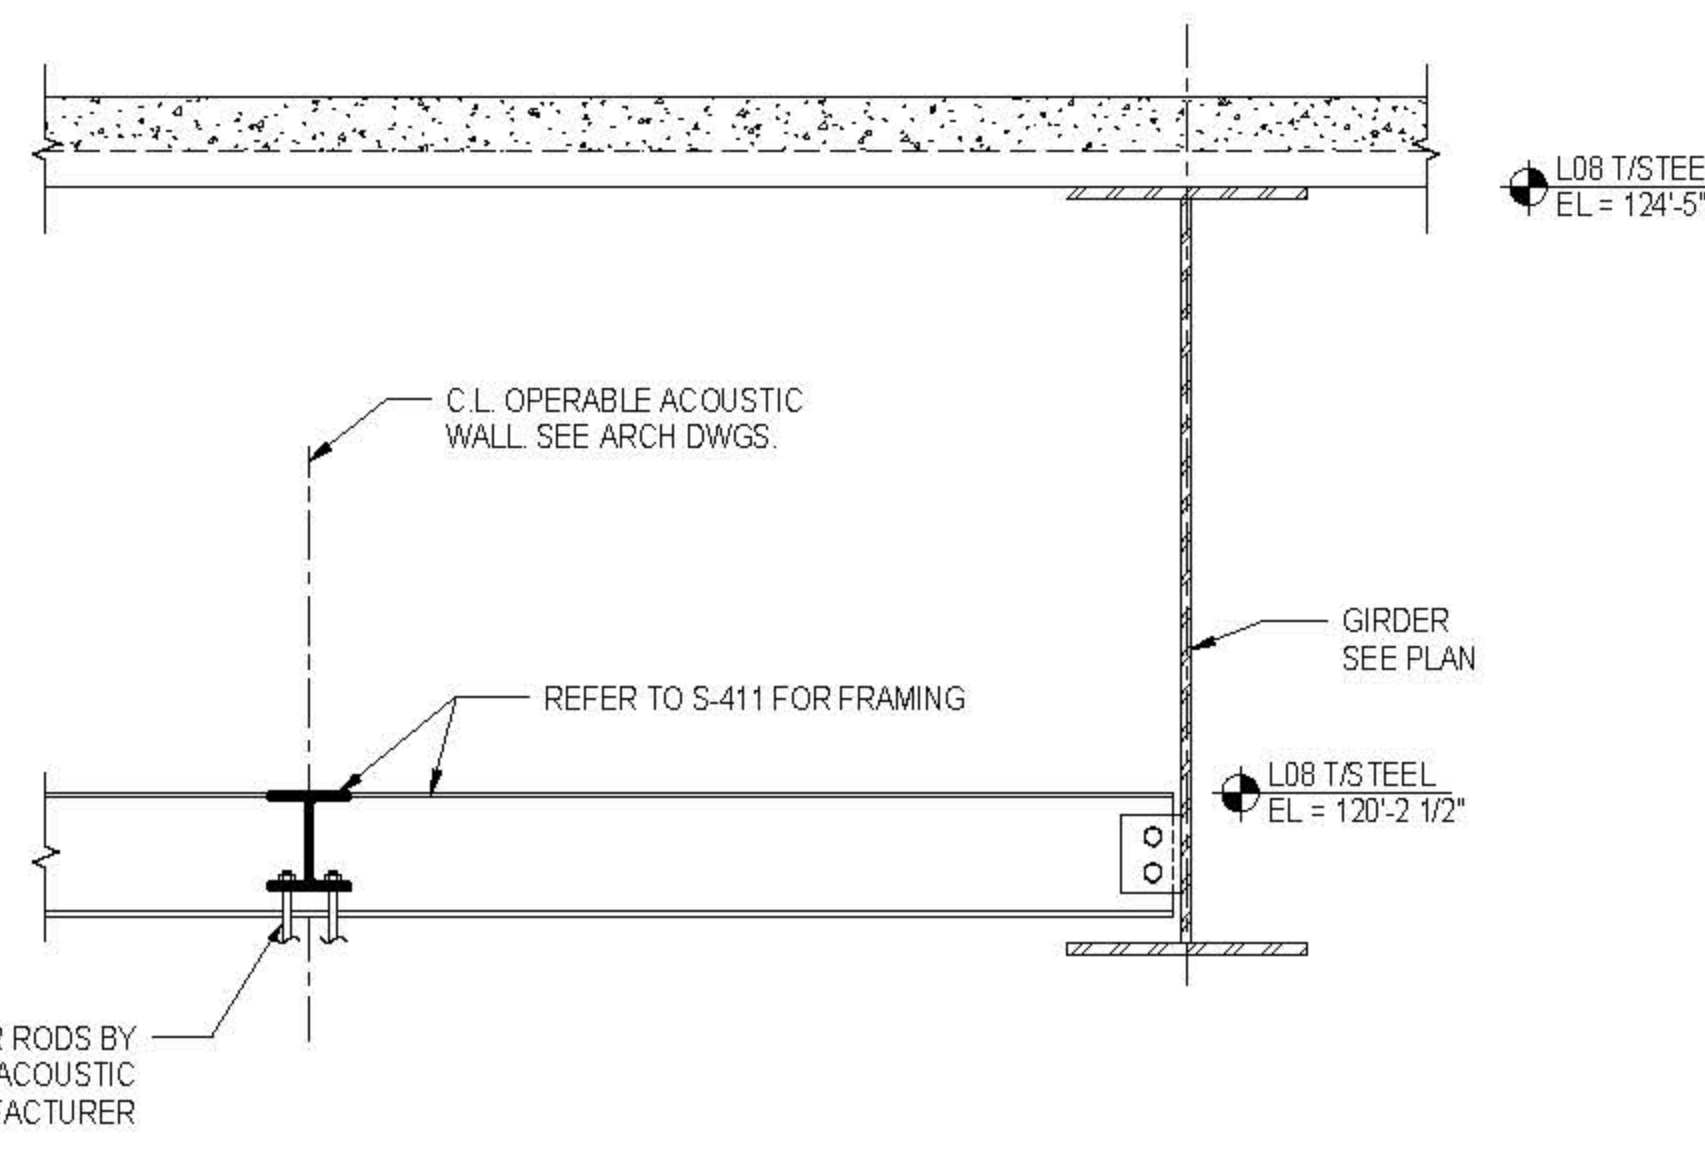



5 SECTION AT OPERABLE ACOUSTIC PARTITION SUPPORTS
3/4" = 1'-0"

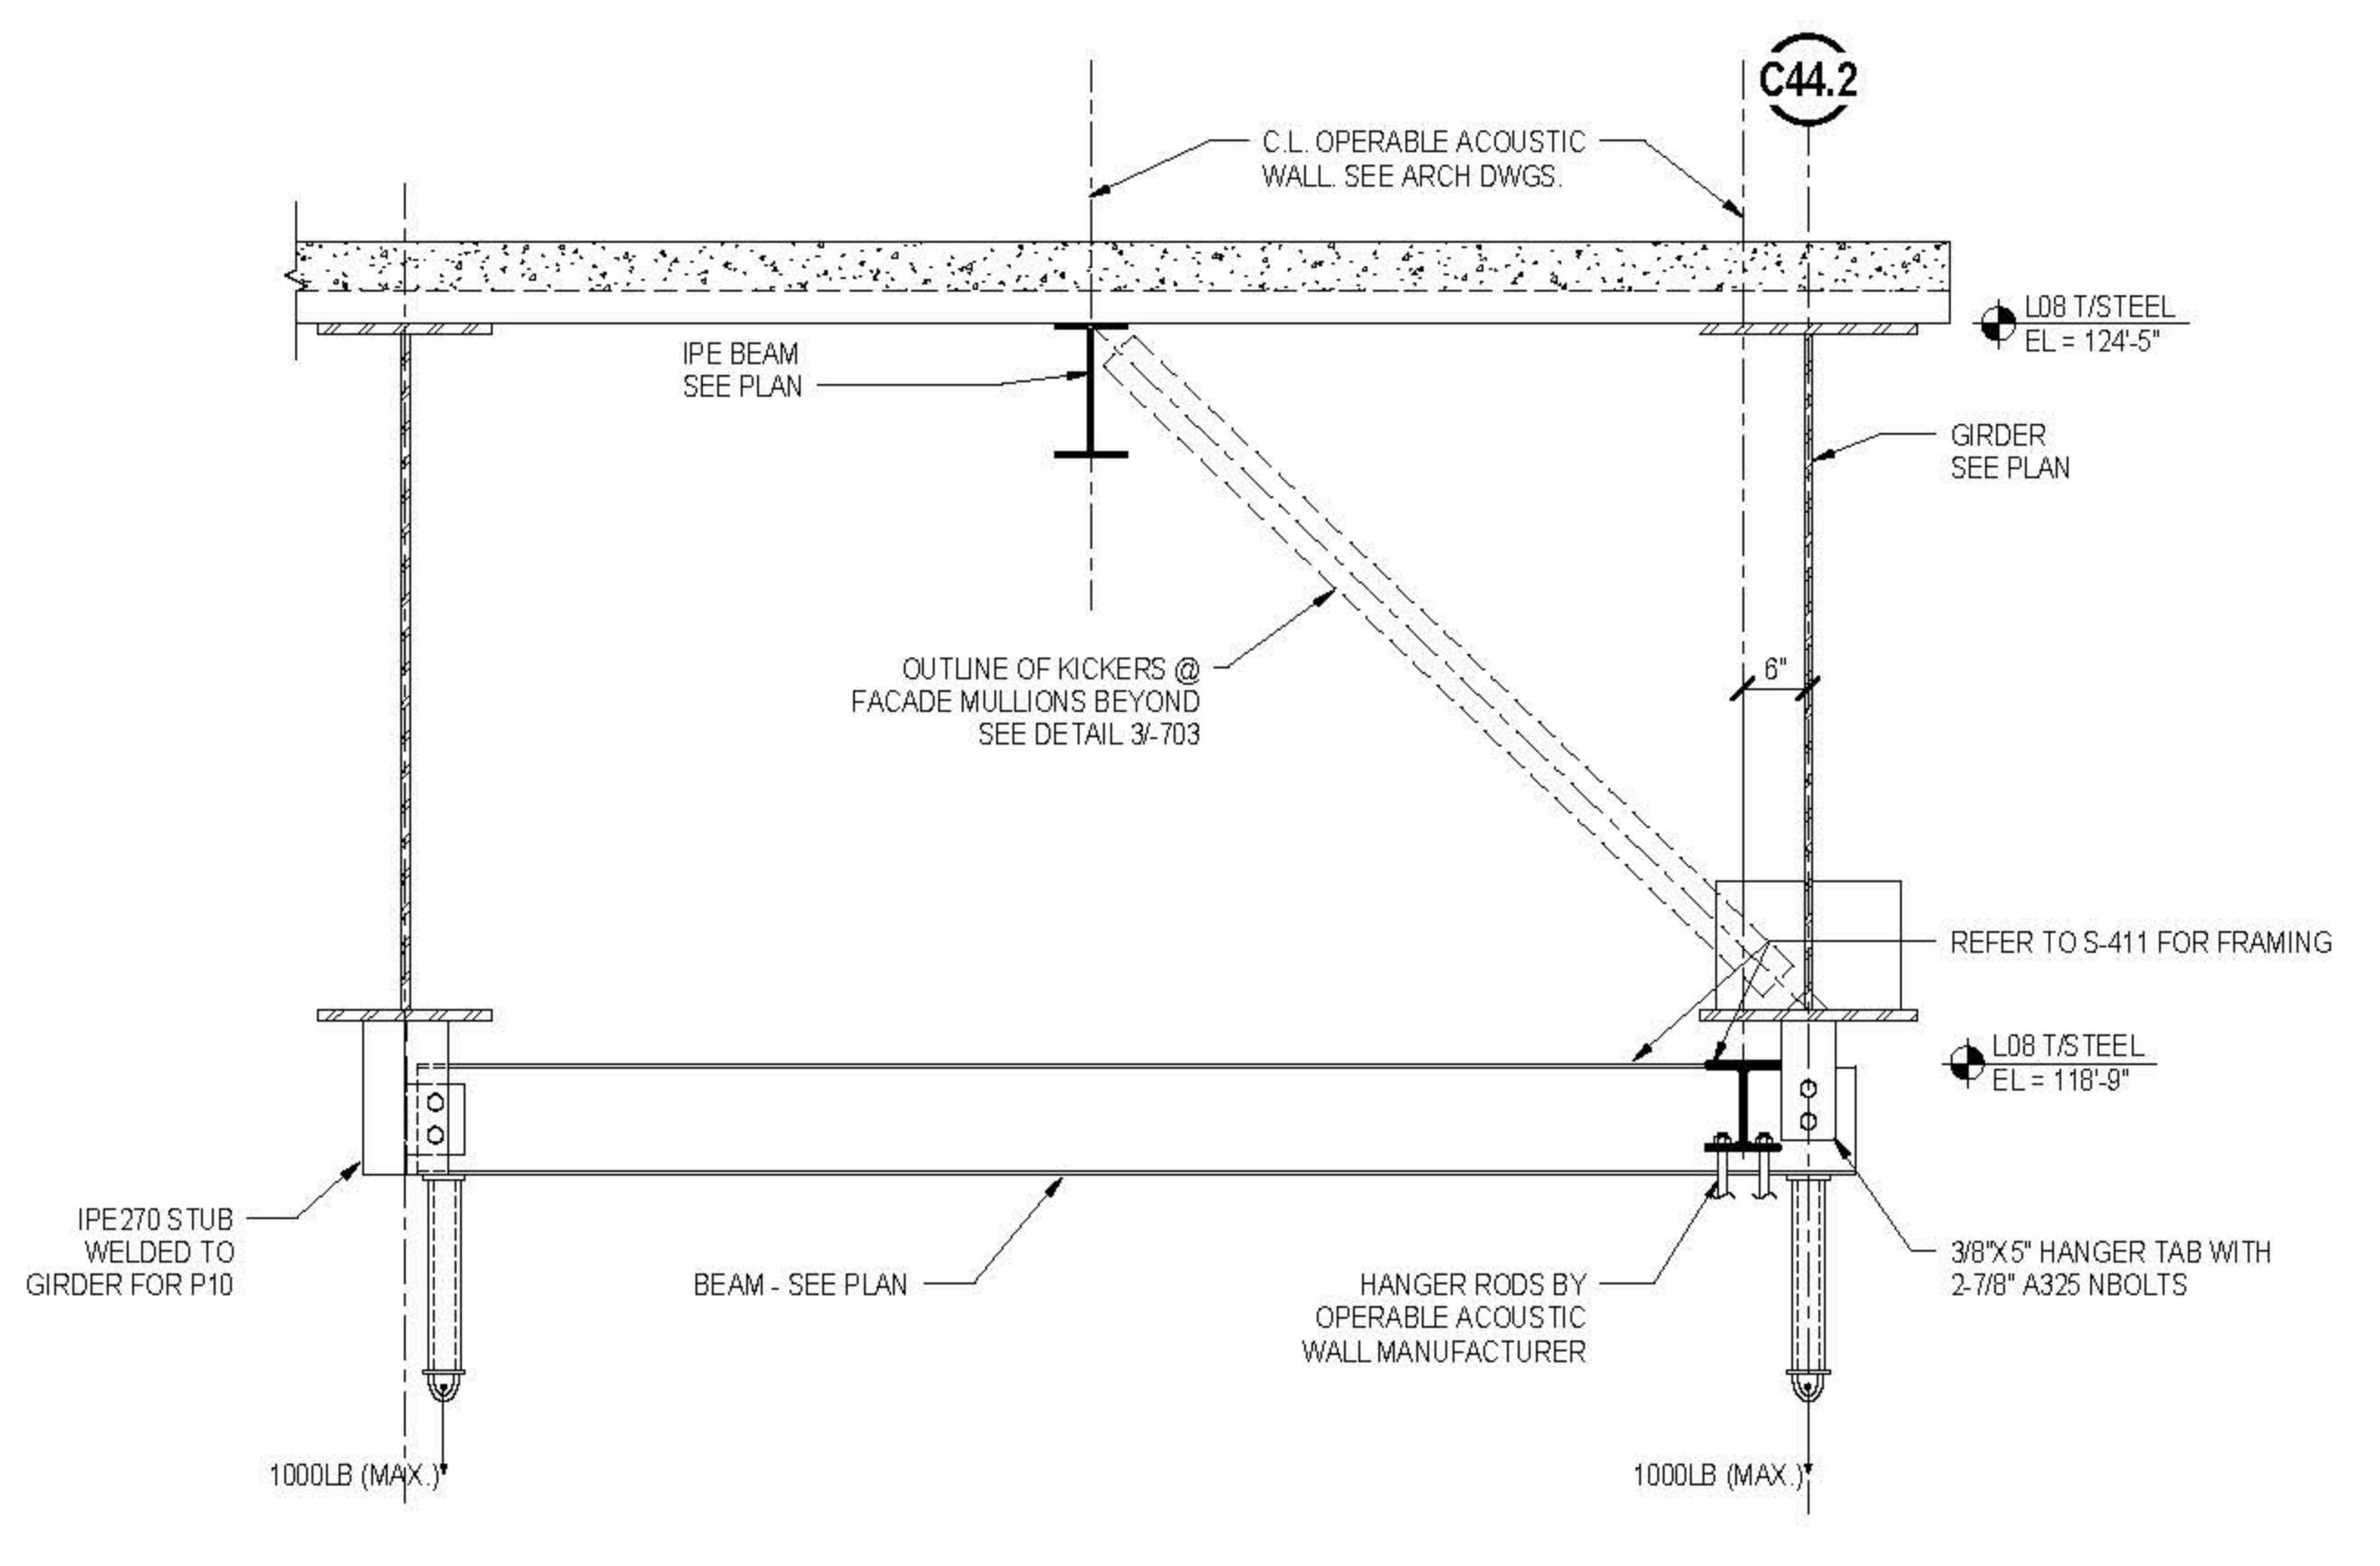


6 SECTION AT EAST OPERABLE ACOUSTIC PARTITION SUPPORT
3/4" = 1'-0"

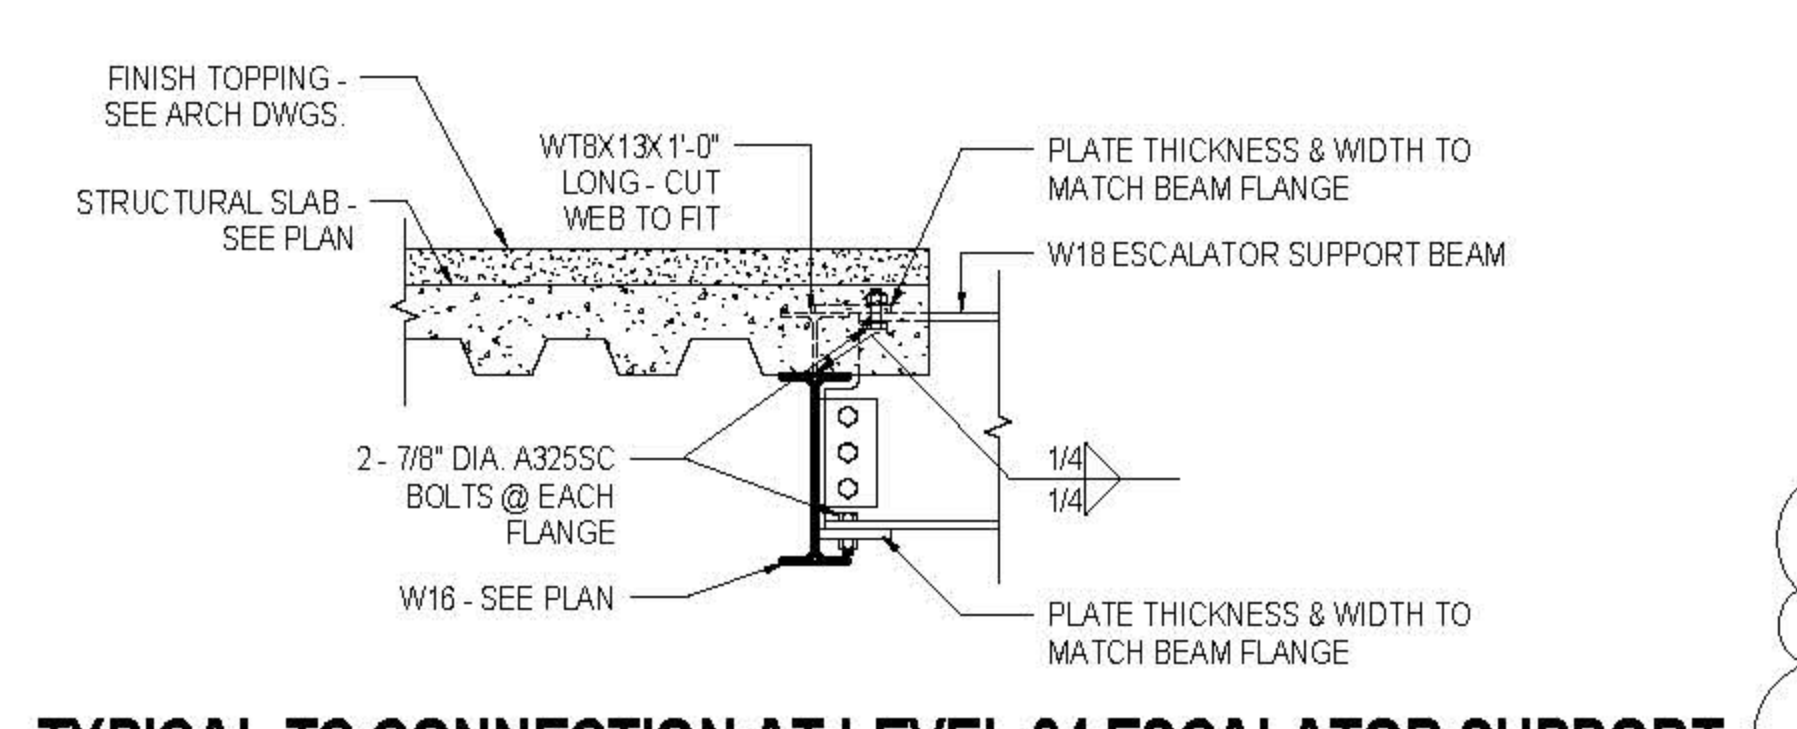


7 TYPICAL TC CONNECTION AT LEVEL 04 ESCALATOR SUPPORT
3/4" = 1'-0"

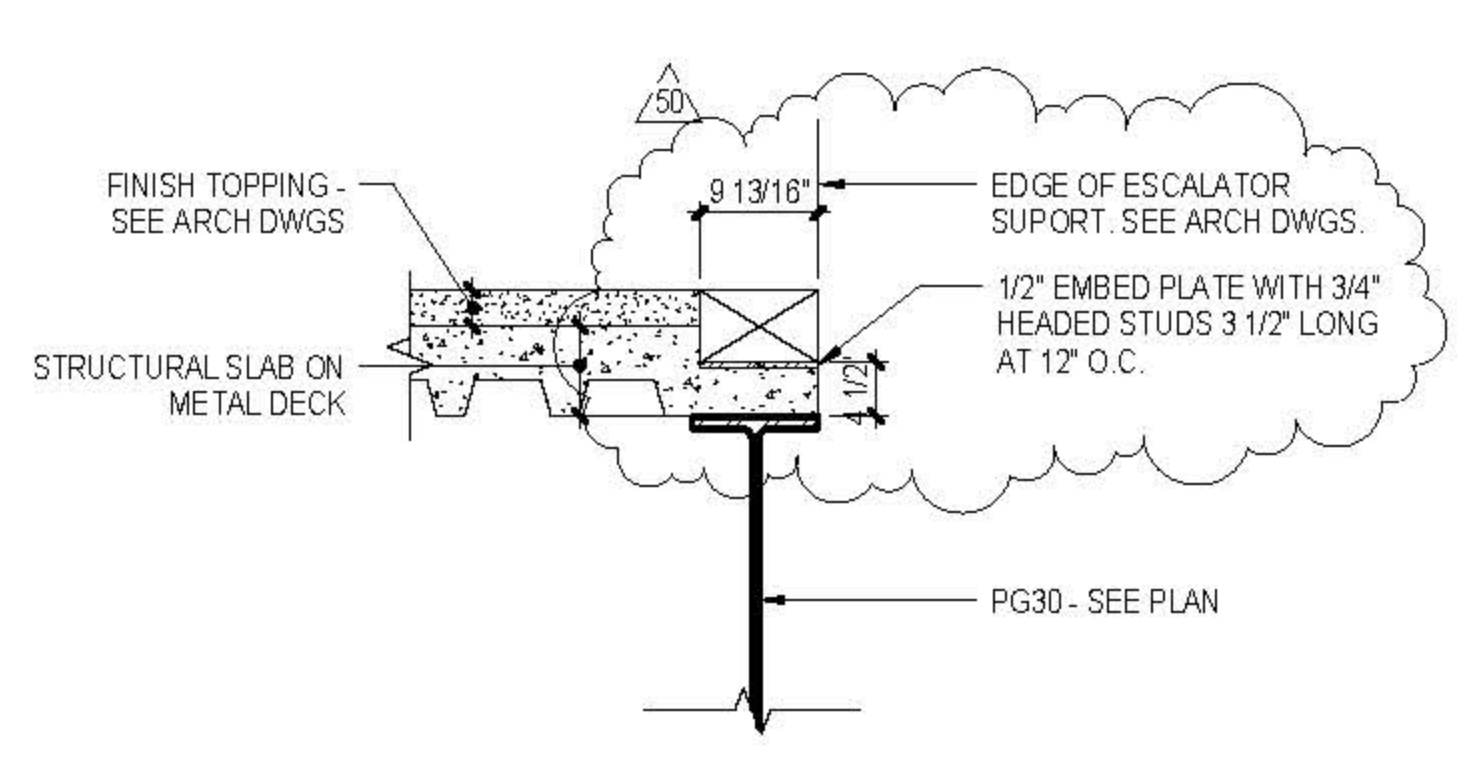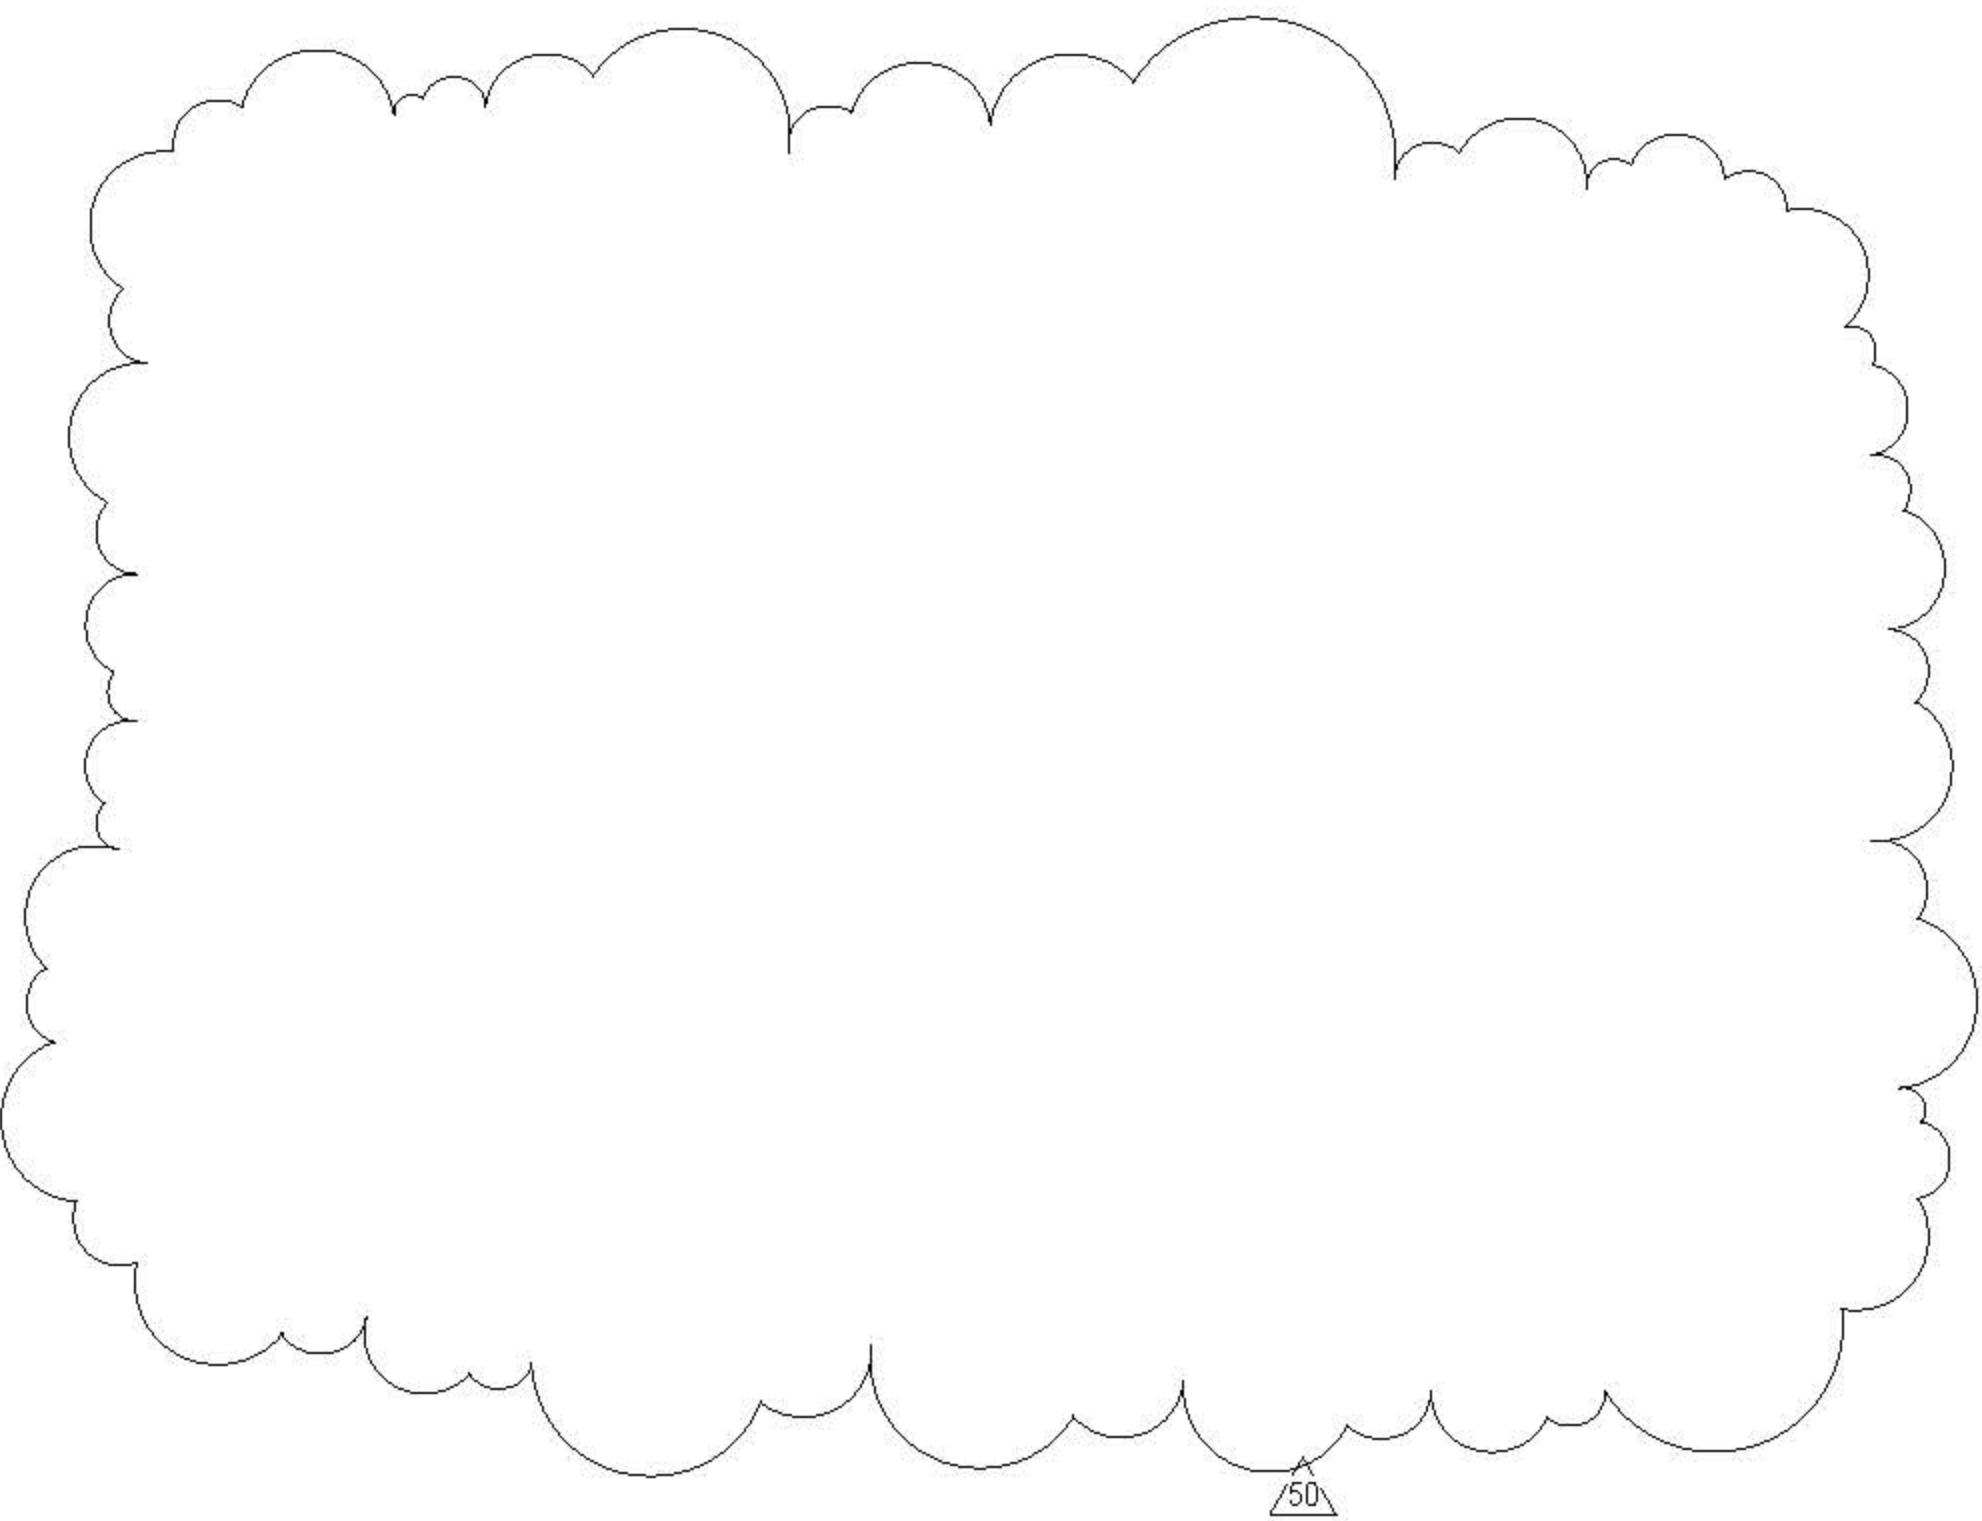


9 SECTION AT LEVEL 04 WEST ESCALATOR SUPPORT
3/4" = 1'-0"

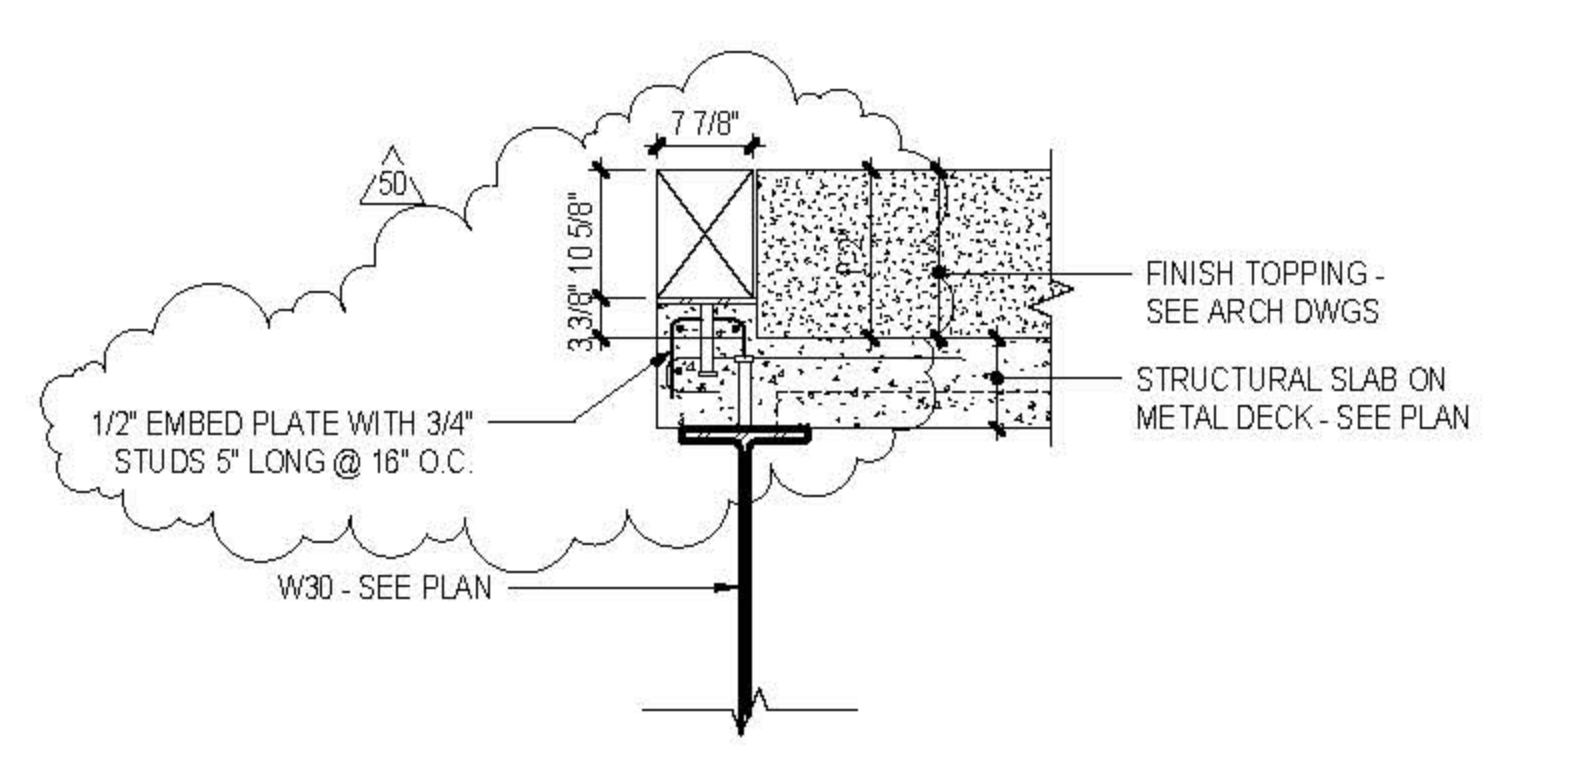

10 TYPICAL SECTION AT LEVEL 06 ESCALATOR SUPPORT
3/4" = 1'-0"

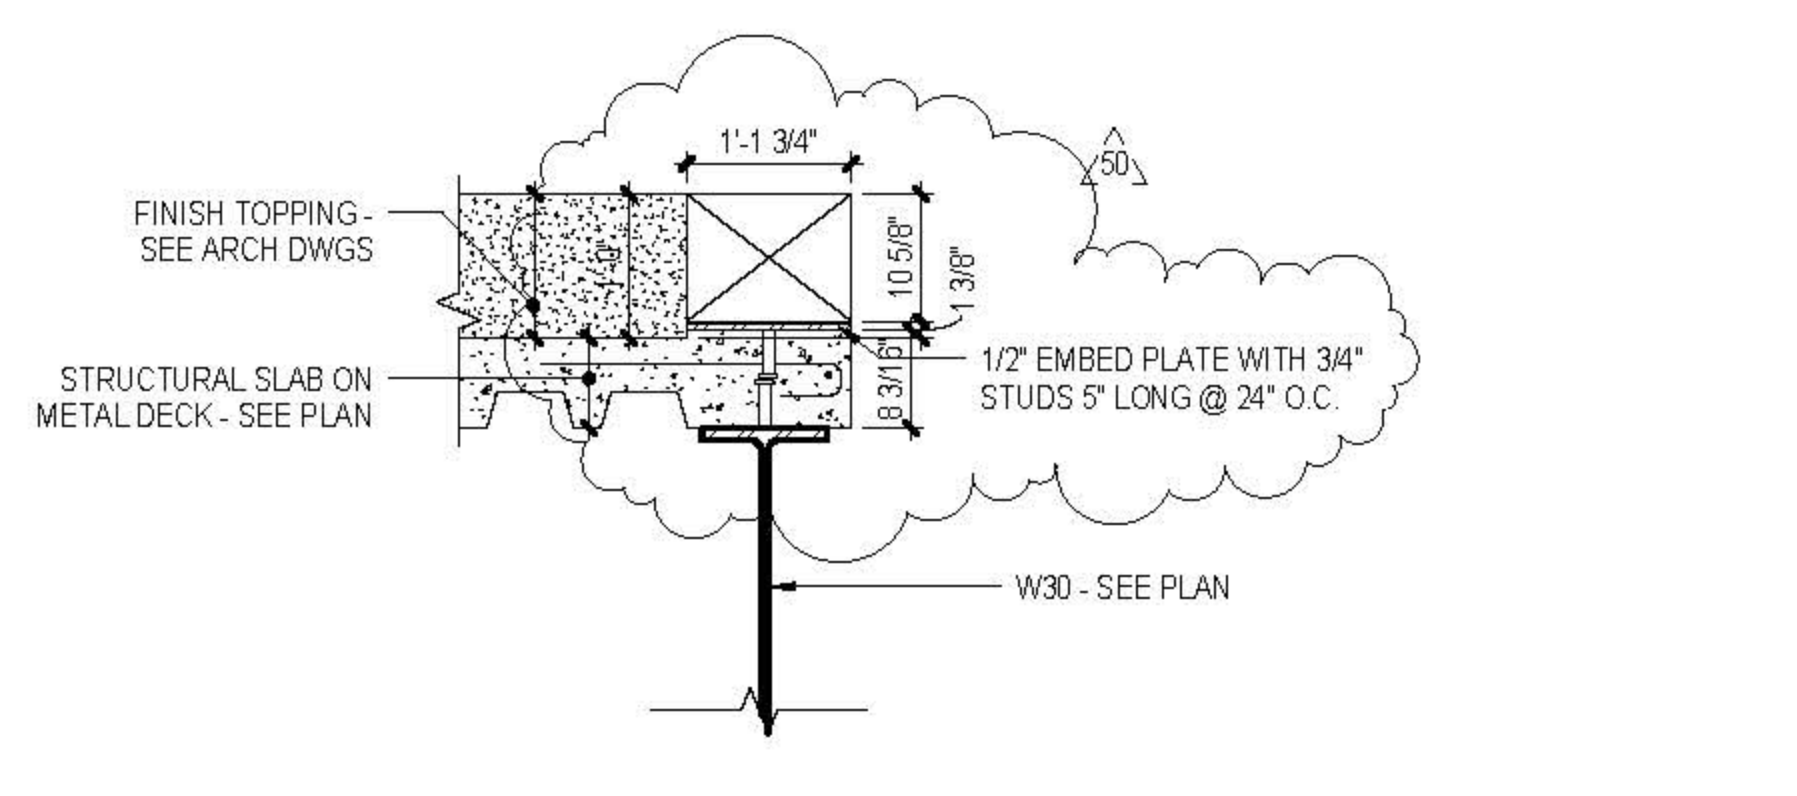

11 TYPICAL SECTION AT LEVEL 08 ESCALATOR SUPPORT
3/4" = 1'-0"

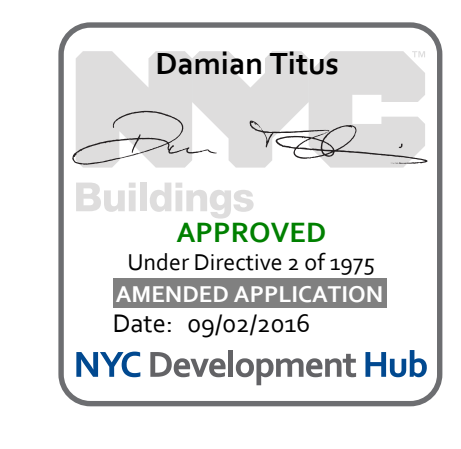

CULTURE SHED

540 West 30th Street
New York, New York 10001

OWNER
CULTURE SHED INC.

ARCHITECTS
Olin Scaife + Renfro Architects, DPC
601 West 20 Street #815
New York, New York 10001
T: 212.260.7971

rockwellgroup
51 Union St. West, 6th Flr
New York, New York 10003
T: 212.463.0334
F: 212.463.0335

STRUCTURAL ENGINEER
Thornton Tomasetti
51 Madison Avenue
New York, New York 10010
T: 917.661.7800
F: 917.661.7801

MEP ENGINEER
Jana Baum & Bolles
50 Park Street
New York, New York 10005
T: 212.530.9300
F: 212.260.6944

FACADE CONSULTANT
Thornton Tomasetti
51 Madison Avenue
New York, New York 10010
T: 917.661.7800
F: 917.661.7801

KINETICS ENGINEER
Hudess & Hanover
1501 Broadway
New York, New York 10036
T: 212.944.1150
F: 212.391.0297

LIGHTING DESIGNER
Tilston Design Associates
40 North Street #160
New York, New York 10013
T: 212.675.7760

THEATRE PLANNING & DESIGN
Fisher Dachs Associates
22 West 15th Street
New York, New York 10011
T: 212.691.3000

LIFE SAFETY
Code Consultants, Inc.
215 West 40th St, 15th Flr
New York, New York 10018
T: 212.216.9596

ENERGY MODEL/LEED
Vindian
50 Washington Street
Norwalk, CT 06854
T: 203.298.1411

ACOUSTIC/AUDIO-VISUAL
Avalon
50 North Main Street
South Norwalk, CT 06854
T: 347.210.5540

VERTICAL TRANSPORTATION
Van Dusen & Associates
5 Regent Street, Suite 524
Lakewood, NJ 07038
T: 973.994.9220

SPECIFICATIONS
Construction Specifications Inc.
PO Box 489
22 Tenthel Road
Morganville, NJ 07751
T: 732.970.0700
F: 732.970.0700


SECURITY
Duchella Venter & Santoro
1100 Sherman Avenue
Hartford, CT 06114
T: 203.286.6490

WATERPROOFING
James R. Gahfort AIA Consulting Architects PC
104 West 27th Street
New York, NY 10001
T: 212.736.3344

FACADE MAINTENANCE
Erick Engineering PLLC
156 Ave. Street
New York, NY 10005
T: 212.698.3000

BRANDING GRAPHICS
2nd Global Design Consultancy
180 Varck Street 15th Floor
New York, NY 10014
T: 212.647.1170

KEY PLAN

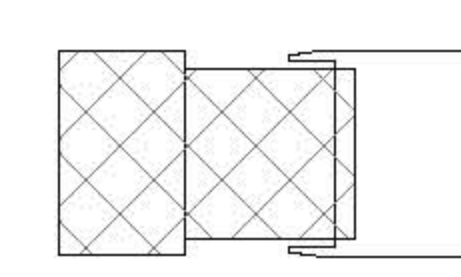

ISSUE

ISSUE	PRINTING	DATE	
01	50	DOB AMENDMENT 7	08.19.2016
37	26	RE #01	02.12.2016
25		CONSTRUCTION SET	10.09.2015
11	6	ADV. PROCUREMENT ADDENDUM 6	04.10.2015
10	4	100% CONSTRUCTION DOCUMENTS	03.18.2015
9		90% CONSTRUCTION DOCUMENTS	02.16.2015
6		PRELIMINARY JOB SUBMISSION	12.10.2014
1		ADVANCED PROCUREMENT BID SET	06.16.2014

STAMP



DRAWN BY
Aulmy

CHECKED BY
Chris


PROJECT NUMBER
N11318.00

TITLE
SECTIONS AND DETAILS, FIXED BUILDING
L04 TO L08 - II


DRAWING NO.
S-726.01

B.SCAN NO.
S-726.01


84 of 123

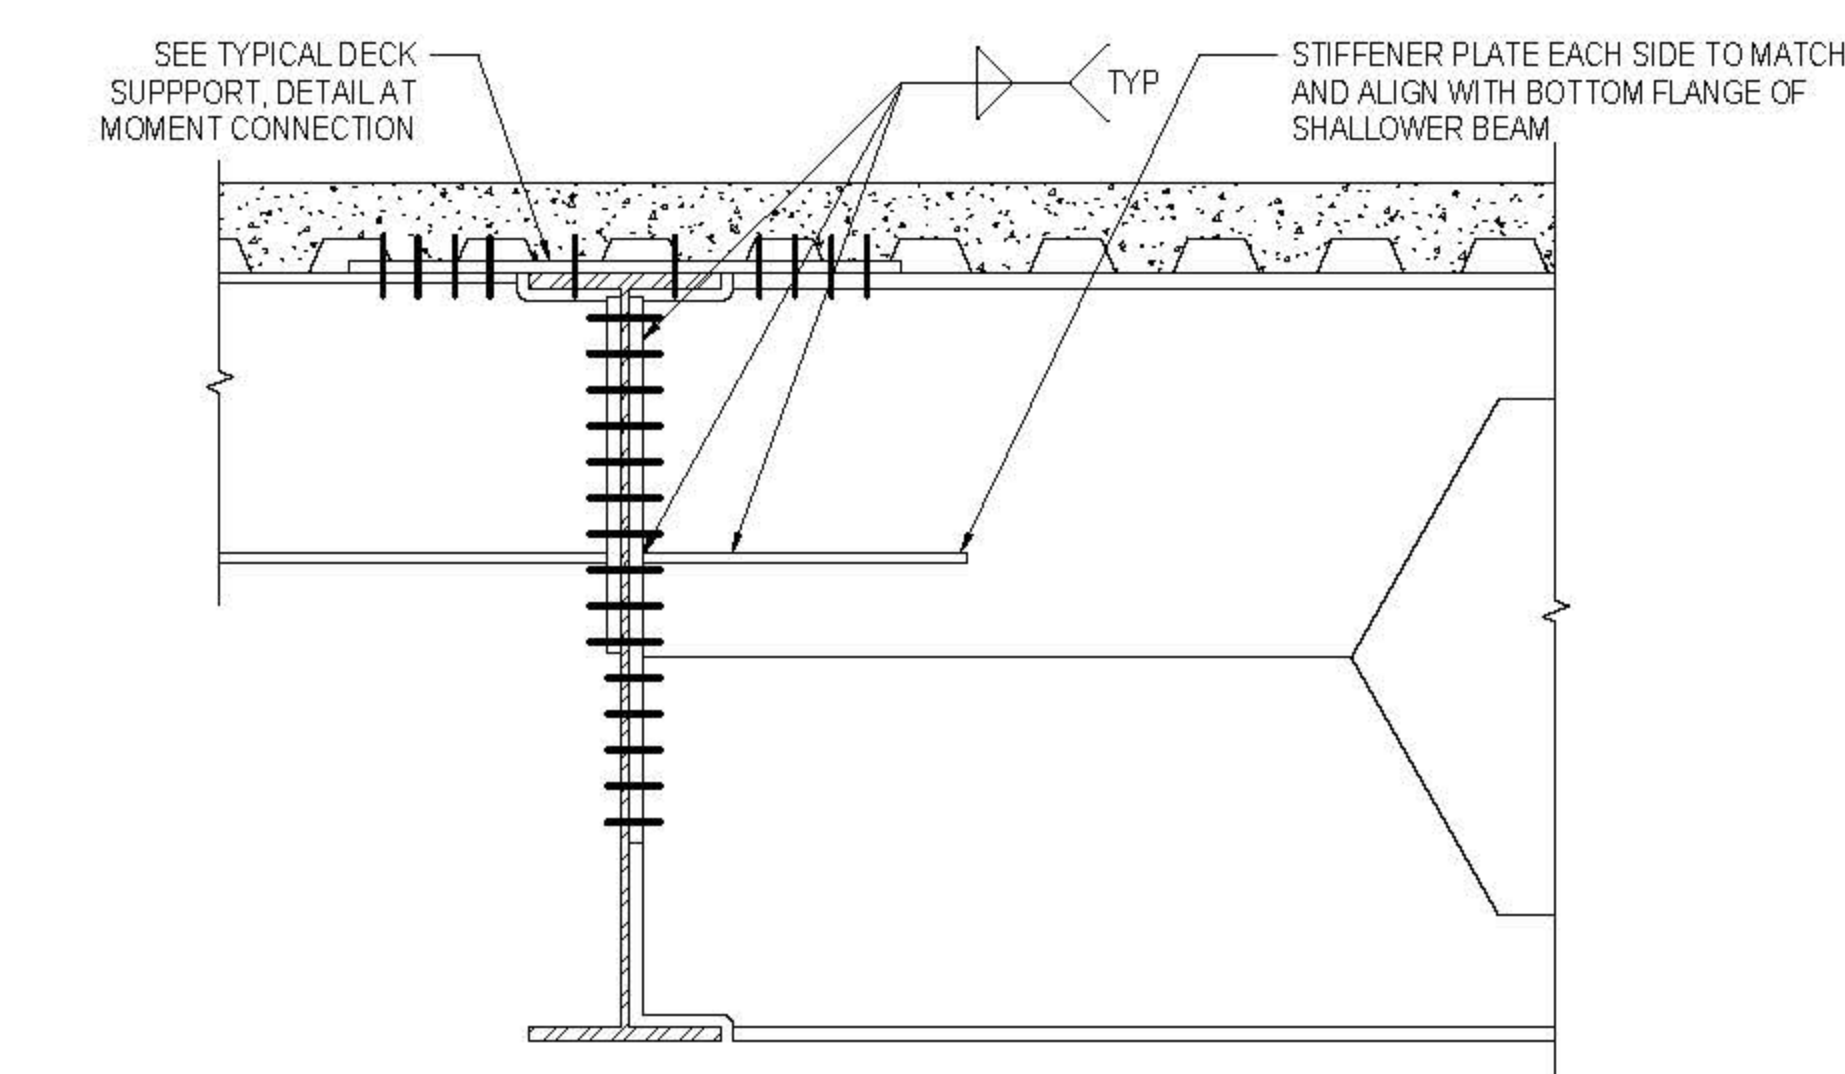

1 TYPICAL MOMENT CONNECTION AT VARIED DEPTH BOLTED END PLATE
3/4" = 1'-0"

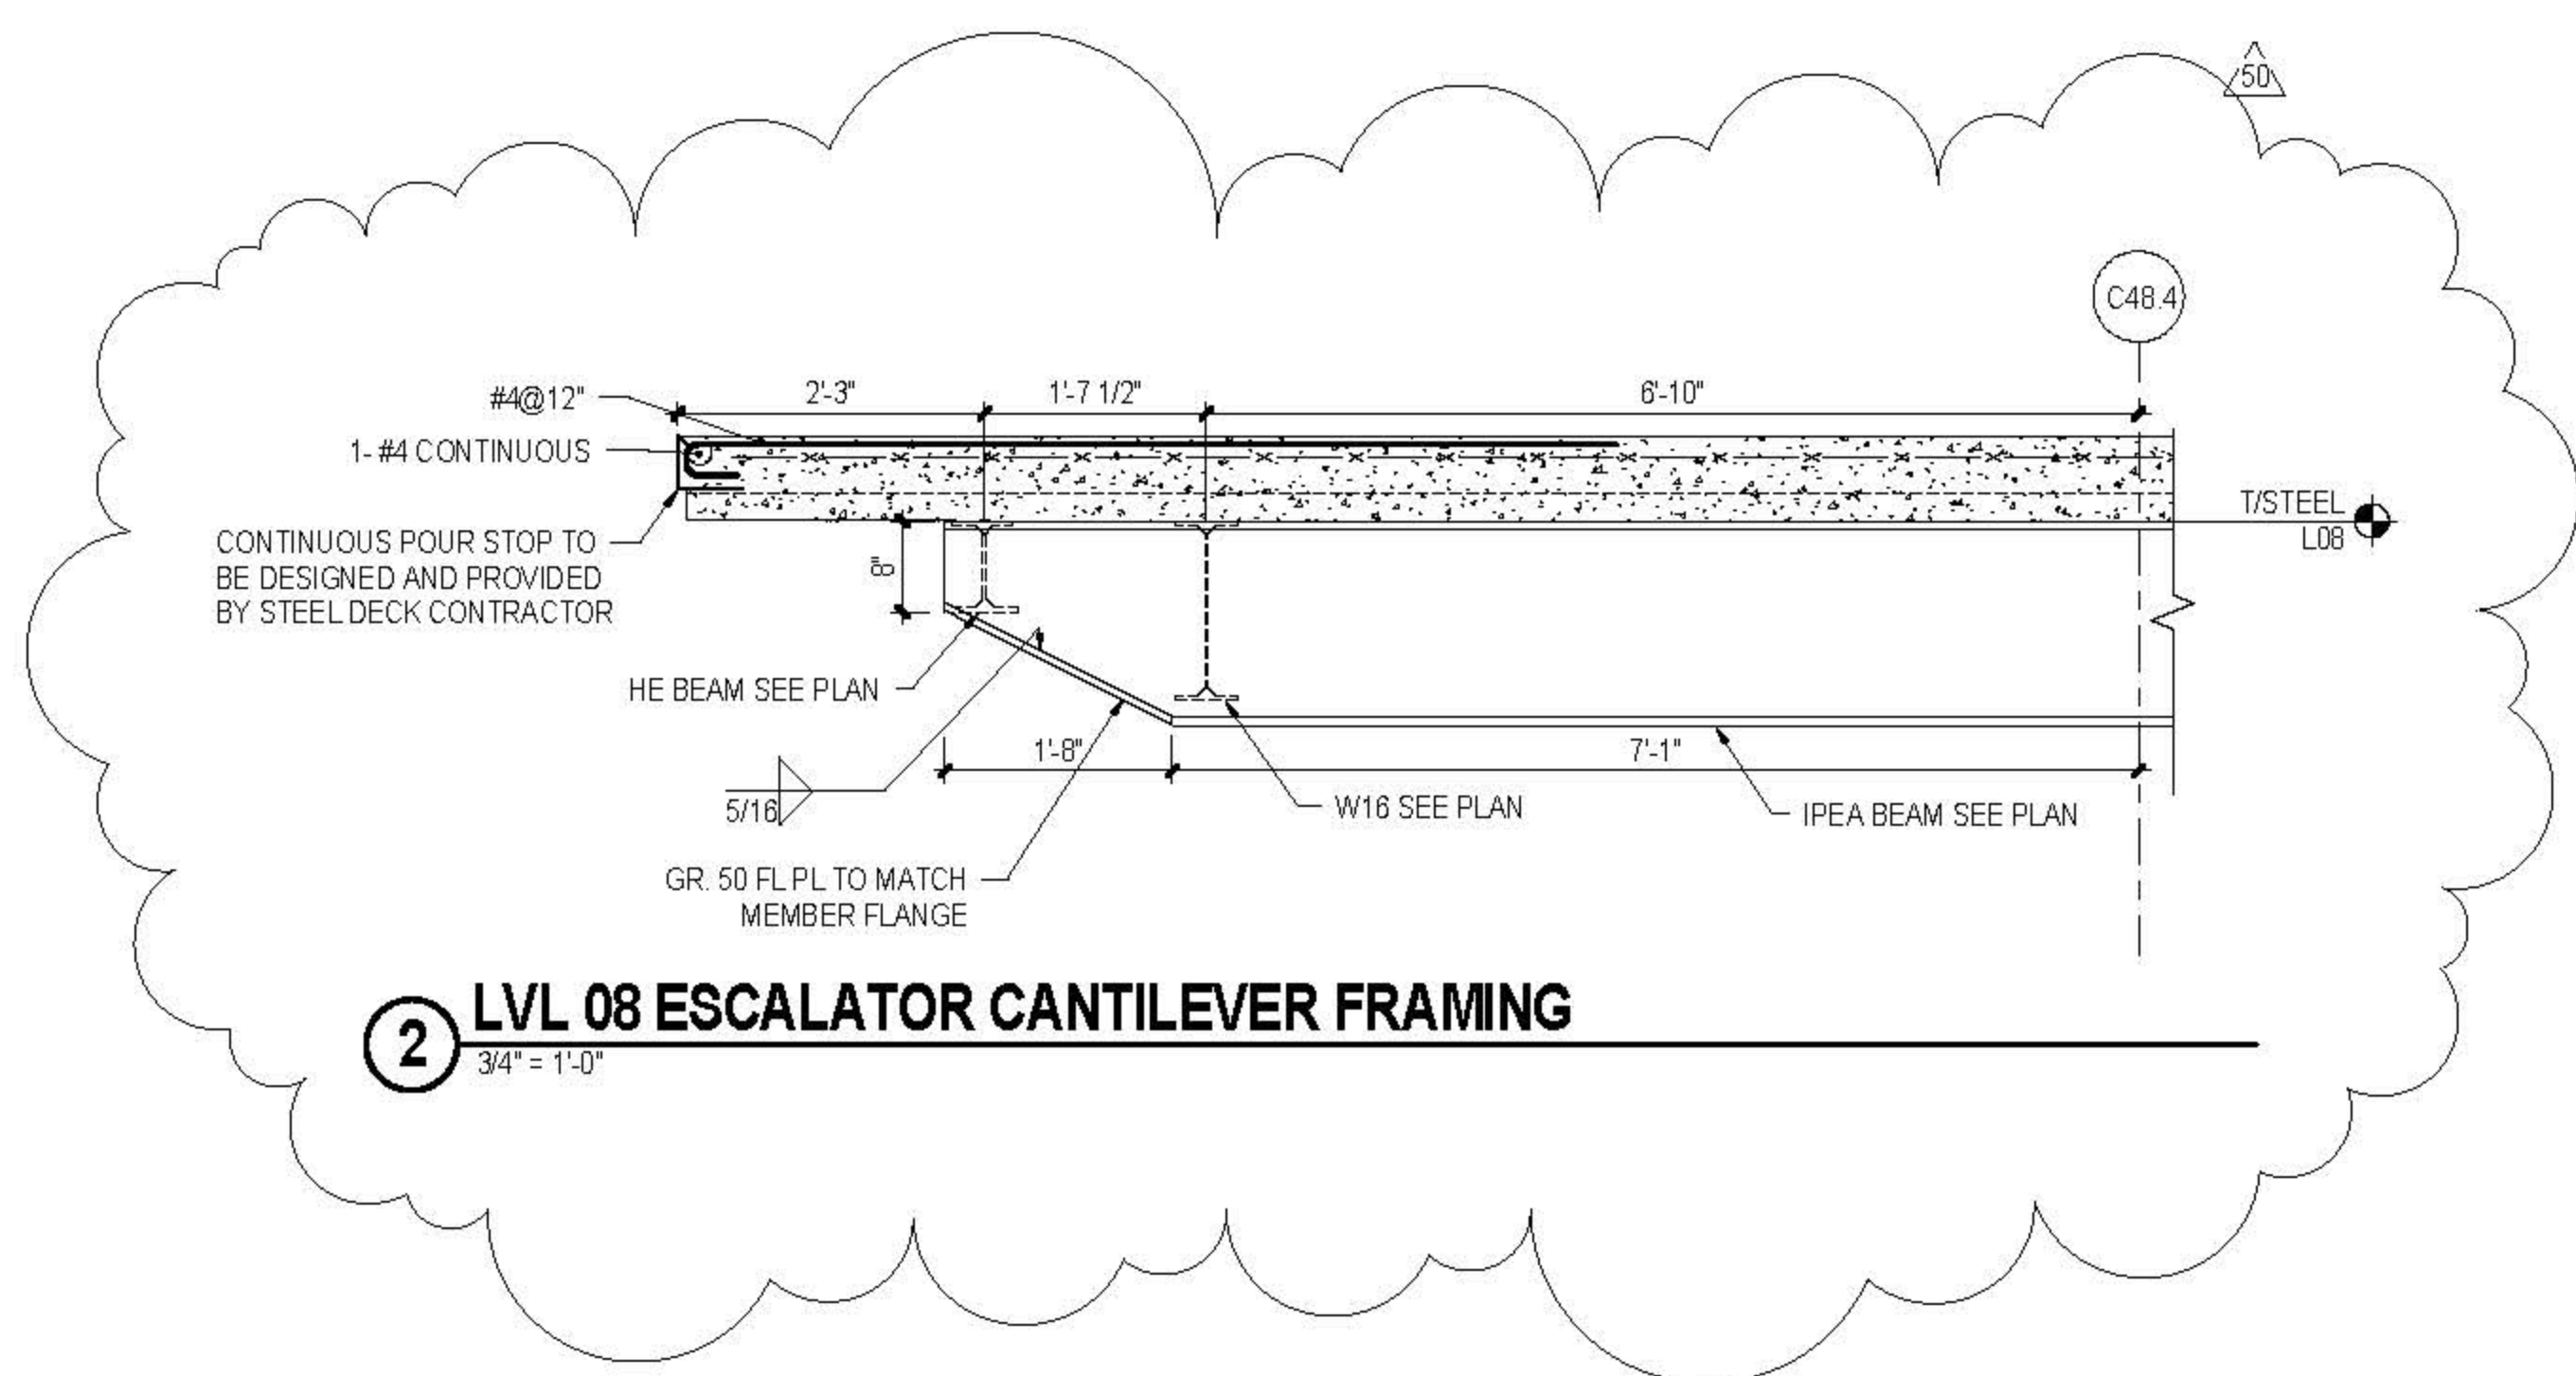

2 LVL 08 ESCALATOR CANTILEVER FRAMING
3/4" = 1'-0"

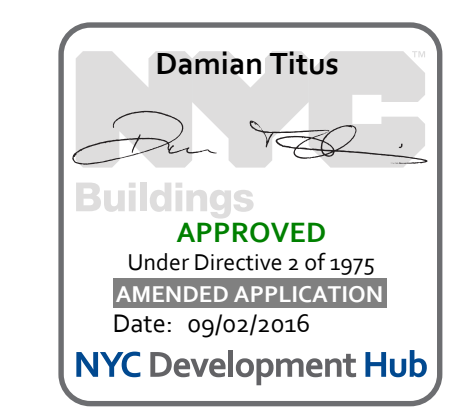

APPROVED
Under Directive 1 of 1975
DATE: 09/21/2015
NYC Development Hub

CULTURE SHED

540 West 30th Street
New York, New York 10001

OWNER
CULTURE SHED INC.

ARCHITECTS
Olin Scudato + Renfro Architects, DPC
601 West 20 Street #815
New York, New York 10001
T: 212.260.7971

rockwellgroup
5 Union St. West, 6th Flr
New York, New York 10003
T: 212.463.0334
F: 212.463.0335

STRUCTURAL ENGINEER
Thornton Tomasetti
51 Madison Avenue
New York, New York 10010
T: 917.661.7800
F: 917.661.7801

MEP ENGINEER
Jana Baum & Bolles
60 Park Street
New York, New York 10005
T: 212.530.9300
F: 212.266.6944

FACADE CONSULTANT
Thornton Tomasetti
51 Madison Avenue
New York, New York 10010
T: 917.661.7800
F: 917.661.7801

KINETICS ENGINEER
Hardisty & Hanover
1601 Broadway
New York, New York 10036
T: 212.944.1150
F: 212.391.0297

LIGHTING DESIGNER
Tilston Design Associates
40 North Street #1650
New York, New York 10013
T: 212.675.7760

THEATRE PLANNING & DESIGN
Fisher Dodge Associates
22 West 15th Street
New York, New York 10011
T: 212.691.3000

LIFE SAFETY
Code Consultants, Inc.
215 West 43rd St, 15th Flr
New York, New York 10018
T: 212.216.9596

ENERGY MODEL/LEED
Vindian
60 Washington Street
Norwalk, CT 06854
T: 203.298.1411

ACOUSTIC/AUDIO-VISUAL
Avalonville
93 North Main Street
South Norwalk, CT 06854
T: 347.210.5540

VERTICAL TRANSPORTATION
Van Dusen & Associates
5 Regent Street, Suite 524
Livingston, NJ 07039
T: 973.994.9220

SPECIFICATIONS
Construction Specifications Inc.
PO Box 489
22 Tenth Road
Morganville, NJ 07751
T: 732.970.0700
F: 732.970.0700


SECURITY
Duchella Venter & Santoro
1100 Sherman Avenue
Hartford, CT 06114
T: 203.286.6490

WATERPROOFING
James R. Galtfort AIA Consulting Architects PC
104 West 27th Street
New York, NY 10001
T: 212.736.3344

FACADE MAINTENANCE
Erick Engineering PLLC
362 Ave. Street
New York, NY 10005
T: 212.696.3000

BRANDING GRAPHICS
21st Global Design Consultancy
180 Varck Street 15th Floor
New York, NY 10014
T: 212.647.1170

KEY PLAN

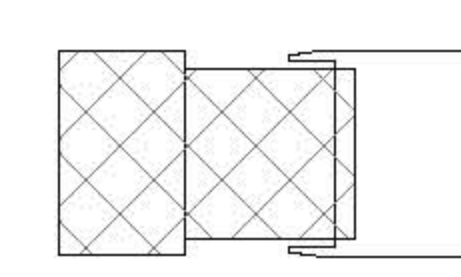

ISSUE PRINTING DATE

ISSUE	PRINTING	DATE

09	50	0106 AMENDMENT 7	08.19.2016
11	6	ADV. PROCUREMENT ADDENDUM 6	04.10.2015
10	4	100% CONSTRUCTION DOCUMENTS	03.18.2015

STAMP



DRAWN BY: **Autmy** CHECKED BY: **Chris M**


PROJECT NUMBER: **N11318.00**

TITLE: **SECTIONS AND DETAILS, FKED BUILDING ROOF II**


DRAWING NO.: **8-727.01**

B.SCAN NO.: **S-728.01**


86 of 123

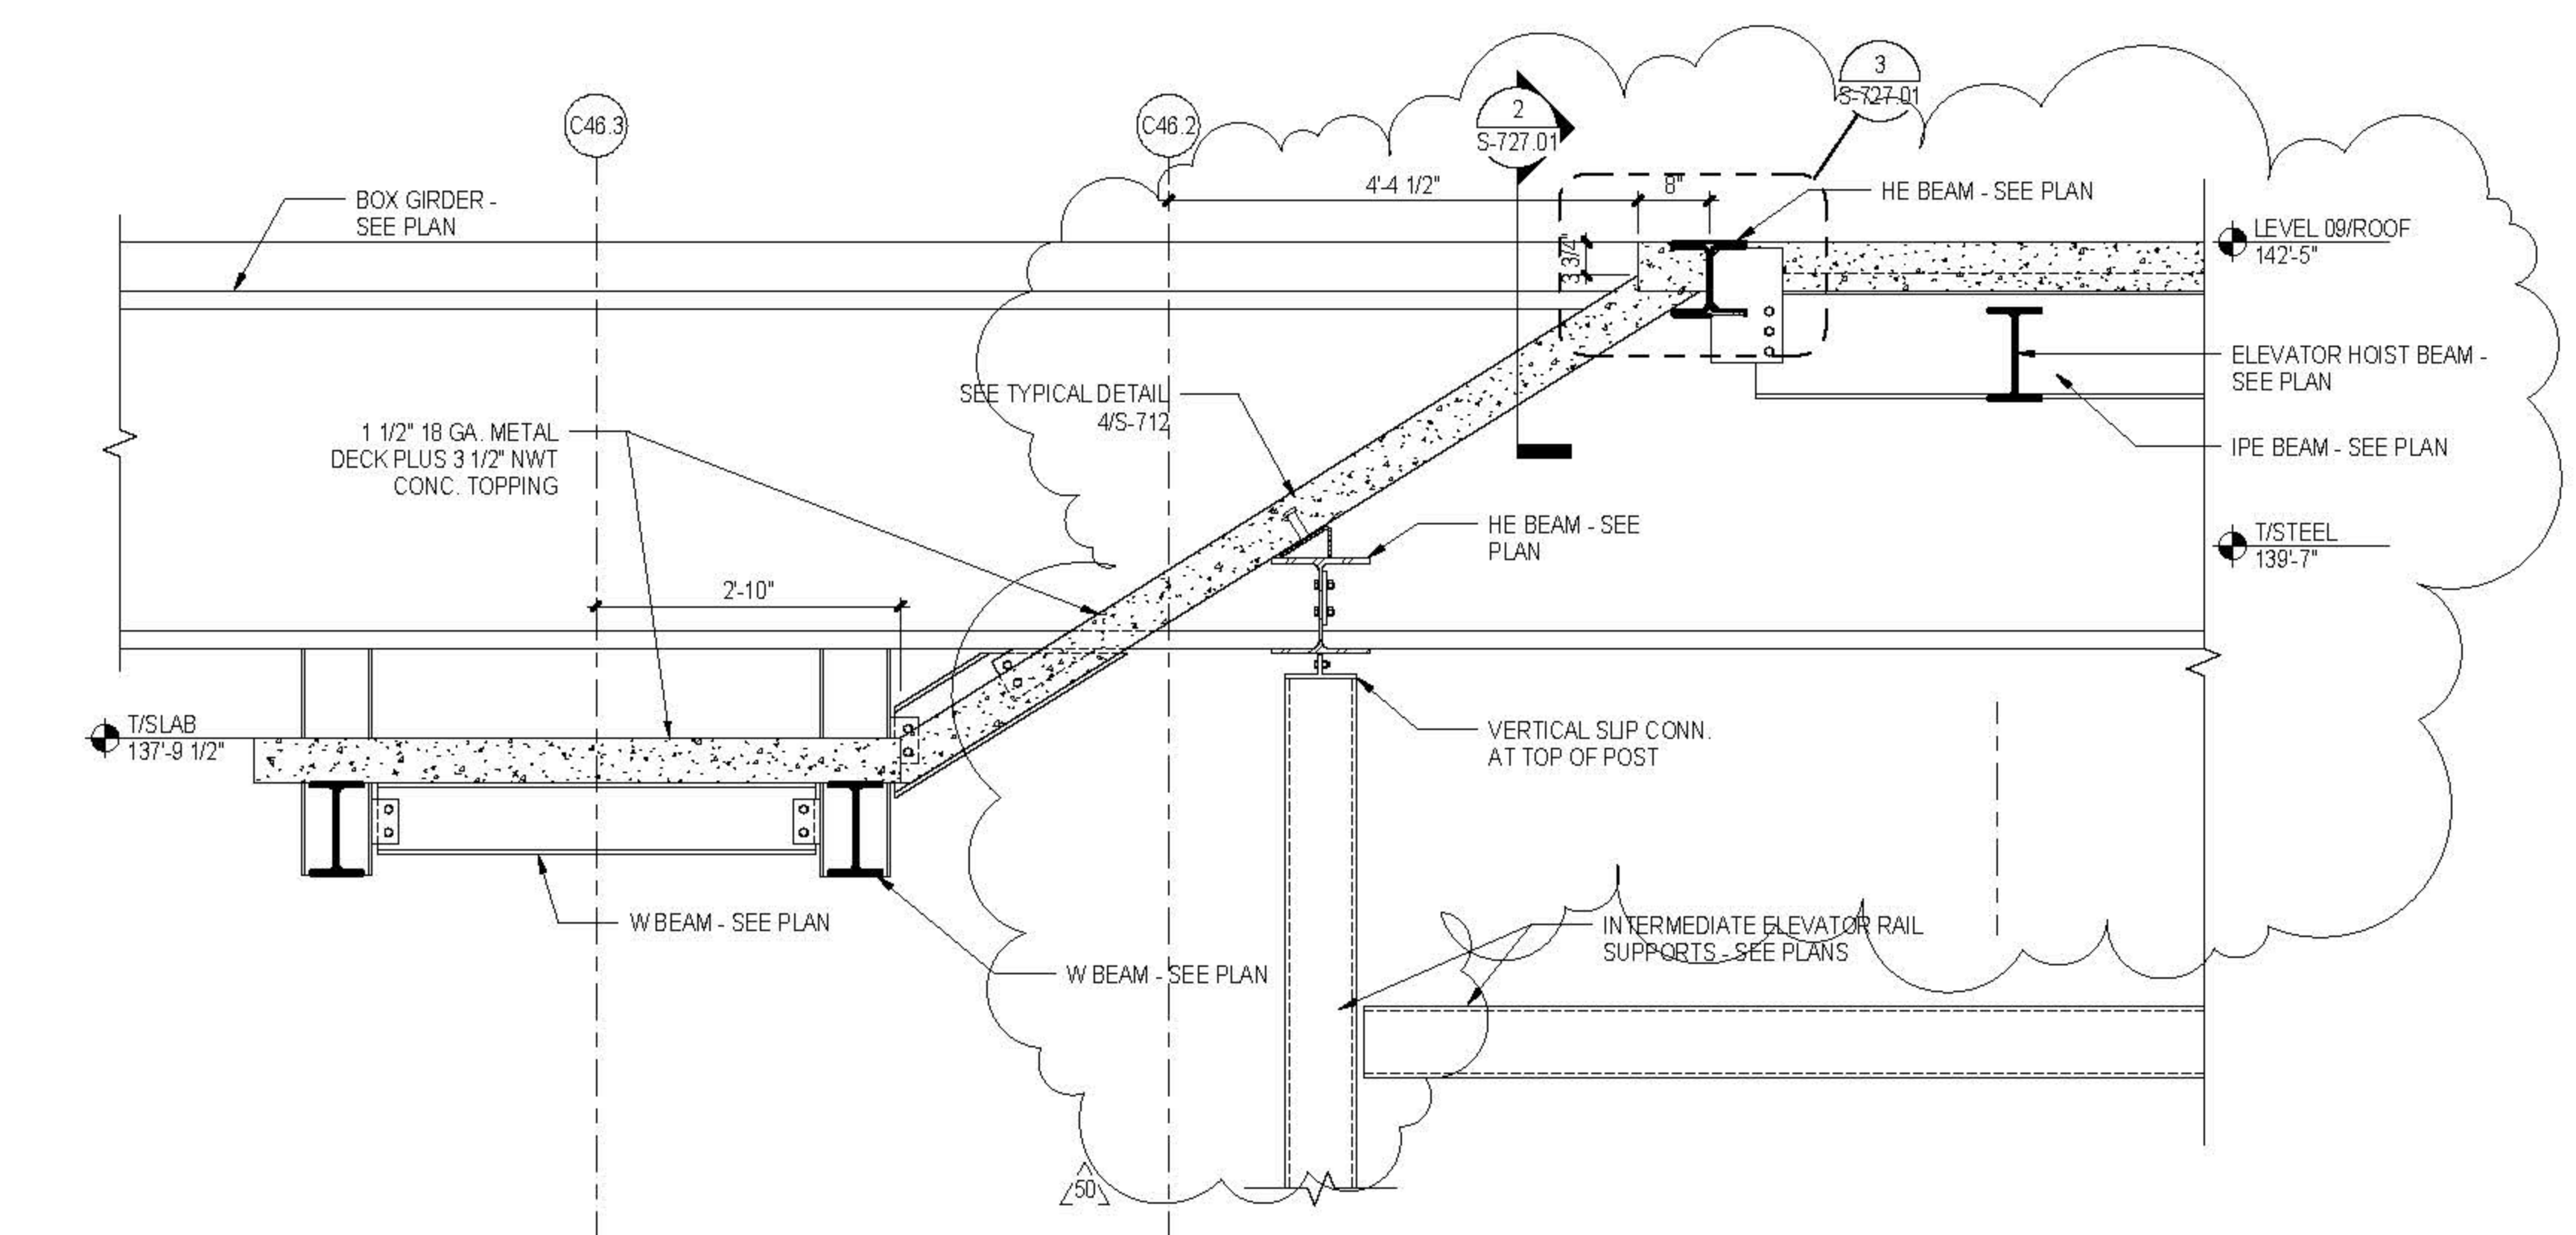


1 SECTION AT RECESS FOR ROOF STAIR
3/4" = 1'-0"

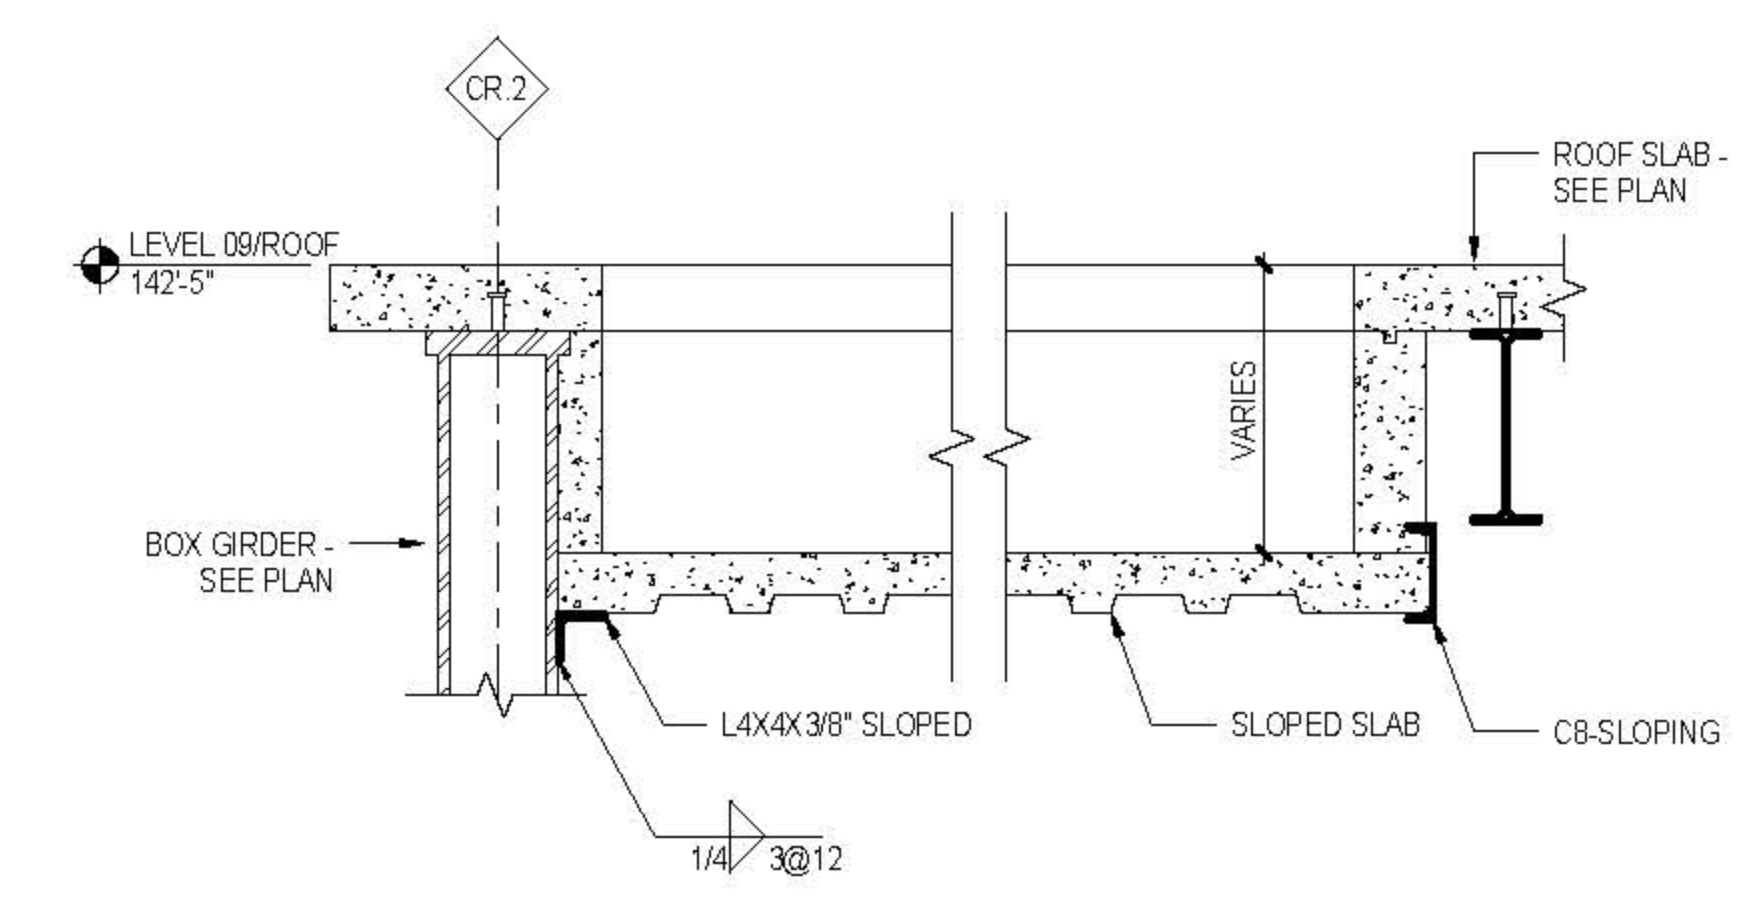


2 SECTION THROUGH INCLINED SLAB AT ROOF STAIR
3/4" = 1'-0"

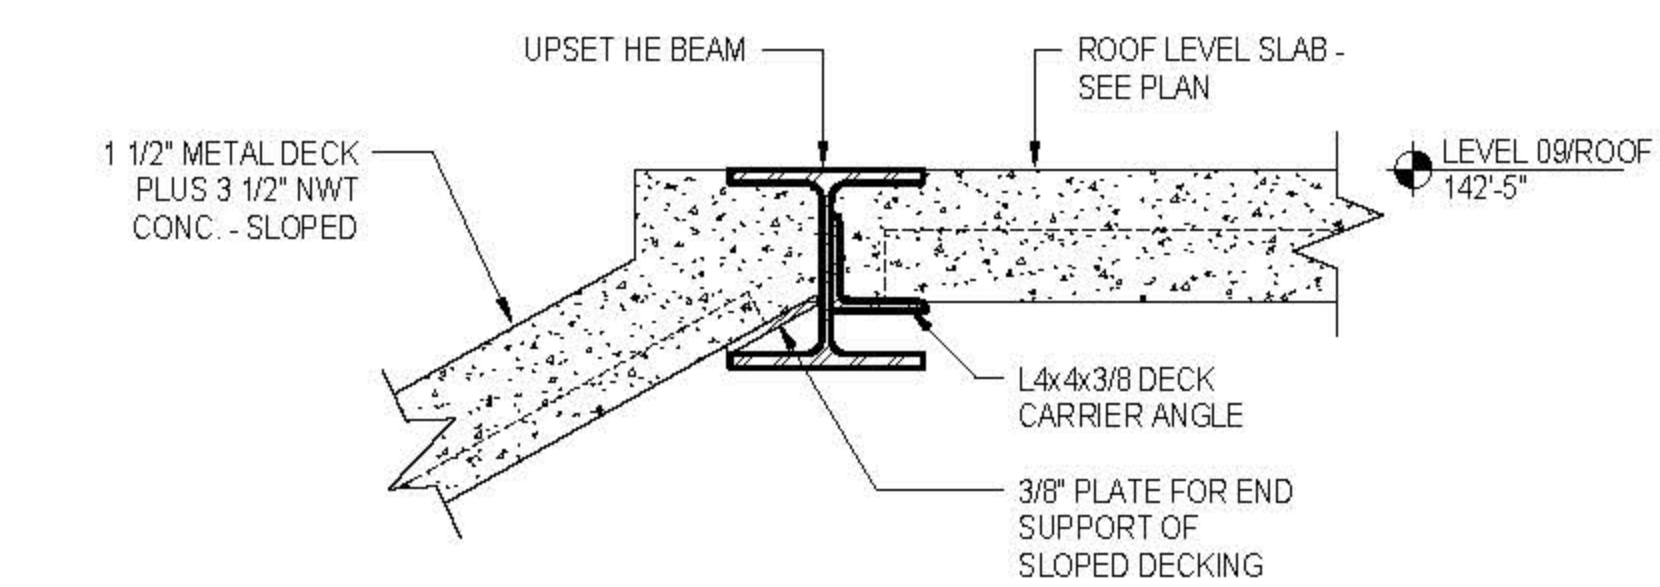

3 DETAIL AT TOP OF SLOPED SLAB AT ROOF STAIR
1 1/2" = 1'-0"

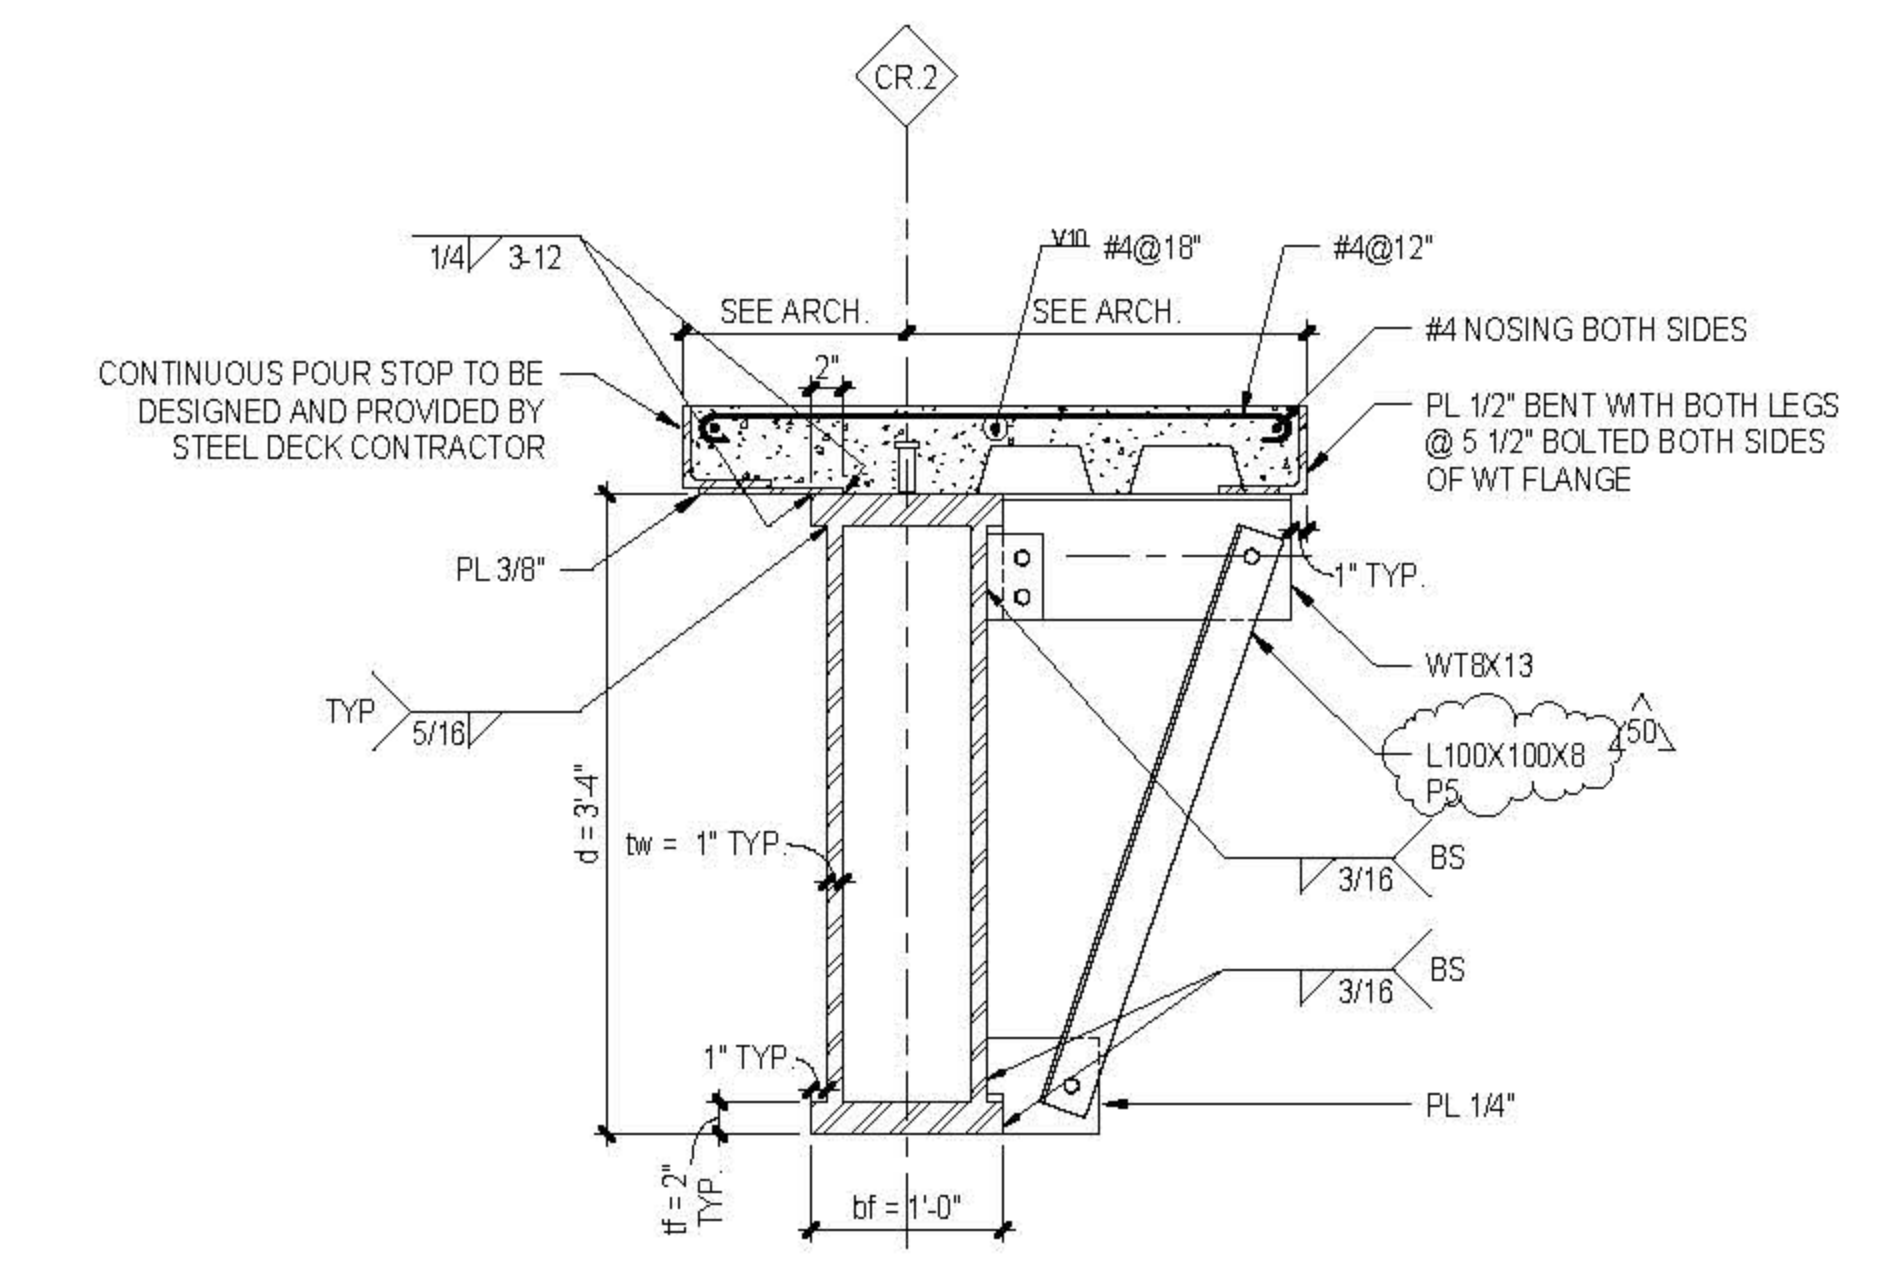

4 SECTION AT ROOF STAIR SLAB EDGE
1" = 1'-0"

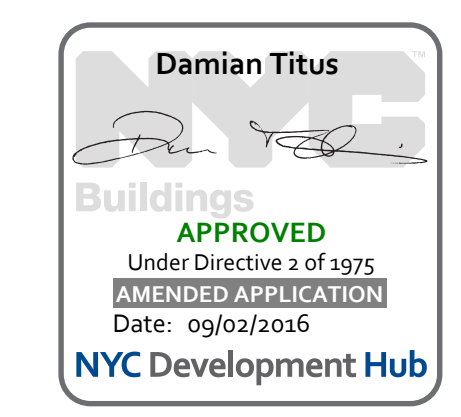

CULTURE SHED

540 West 30th Street
New York, New York 10001

OWNER
CULTURE SHED INC.

ARCHITECTS
Oller Scaletto + Renfro Architects, DPC
601 West 26 Street #815
New York, New York 10001
T: 212.260.7971
F: 212.260.7971

rockwellgroup
150 West 30th Street, 6th Fl.
New York, New York 10003
T: 212.463.0334
F: 212.463.0335

STRUCTURAL ENGINEER
Thornton Tomasetti
51 Madison Avenue
New York, New York 10010
T: 917.861.7800
F: 917.861.7801

MEP ENGINEER
Jana Baum & Bolles
60 Park Street
New York, New York 10005
T: 212.530.9300
F: 212.260.6944

FAÇADE CONSULTANT
Thornton Tomasetti
51 Madison Avenue
New York, New York 10010
T: 917.861.7800
F: 917.861.7801

KINETICS ENGINEER
Hardess & Hanover
1501 Broadway
New York, New York 10036
T: 212.944.1150
F: 212.399.0297

LIGHTING DESIGNER
Tilston Design Associates
40 North Street #160
New York, New York 10013
T: 212.675.7760

THEATRE PLANNING & DESIGN
Fisher Design Associates
22 West 15th Street
New York, New York 10011
T: 212.691.3000

LIFE SAFETY
Code Consultants, Inc.
215 West 43rd St, 15th Fl.
New York, New York 10018
T: 212.216.9596

ENERGY MODELLED
Vindian
60 Washington Street
Norwalk, CT 06854
T: 203.290.1411

ACOUSTIC/AUDIO-VISUAL
Avenelle
53 North Main Street
South Norwalk, CT 06854
T: 347.210.5540

VERTICAL TRANSPORTATION
Van Duusen & Associates
5 Regent Street, Suite 524
Livingston, NJ 07039
T: 973.994.9200

SPECIFICATIONS
Construction Specifications Inc.
PO Box 489
227 Emmet Road
Morganville, NJ 07751
T: 732.970.0700
F: 732.970.0700


SECURITY
Duchella Venter & Santoro
100 Sherman Avenue
Hartford, CT 06114
T: 203.286.6490

WATERPROOFING
James R. Gofford AIA Consulting Architects PC
104 West 27th Street
New York, NY 10001
T: 212.736.3344

FAÇADE MAINTENANCE
Enka Engineering PLLC
166 Arden Street
New York, NY 10005
T: 212.696.3000

BRANDING GRAPHICS
214 Global Design Consultancy
180 Varck Street 15th Floor
New York, NY 10014
T: 212.647.1170

KEY PLAN

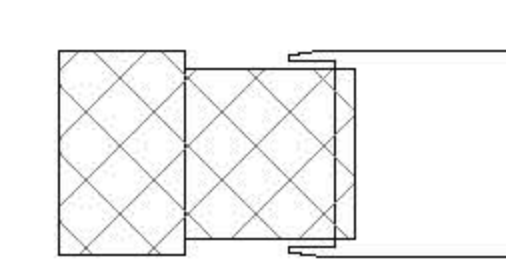

ISSUE PRINTING DATE

NO.	DESCRIPTION	DATE
01	ISSUE	03/18/2016
11	ADV. PROCUREMENT ADDENDUM 6	04/10/2016
12	ADV. PROCUREMENT ADDENDUM 7	04/10/2016
13	ADV. PROCUREMENT ADDENDUM 8	10/02/2016

STAMP



DRAWN BY: *Autum* CHECKED BY: *Chadler*


PROJECT NUMBER: N1318.00

TITLE: RAIL BASE DETAILS L02


DRAWING NO.: S-730.00

B.SCAN NO.: S-730.00


97 of 123

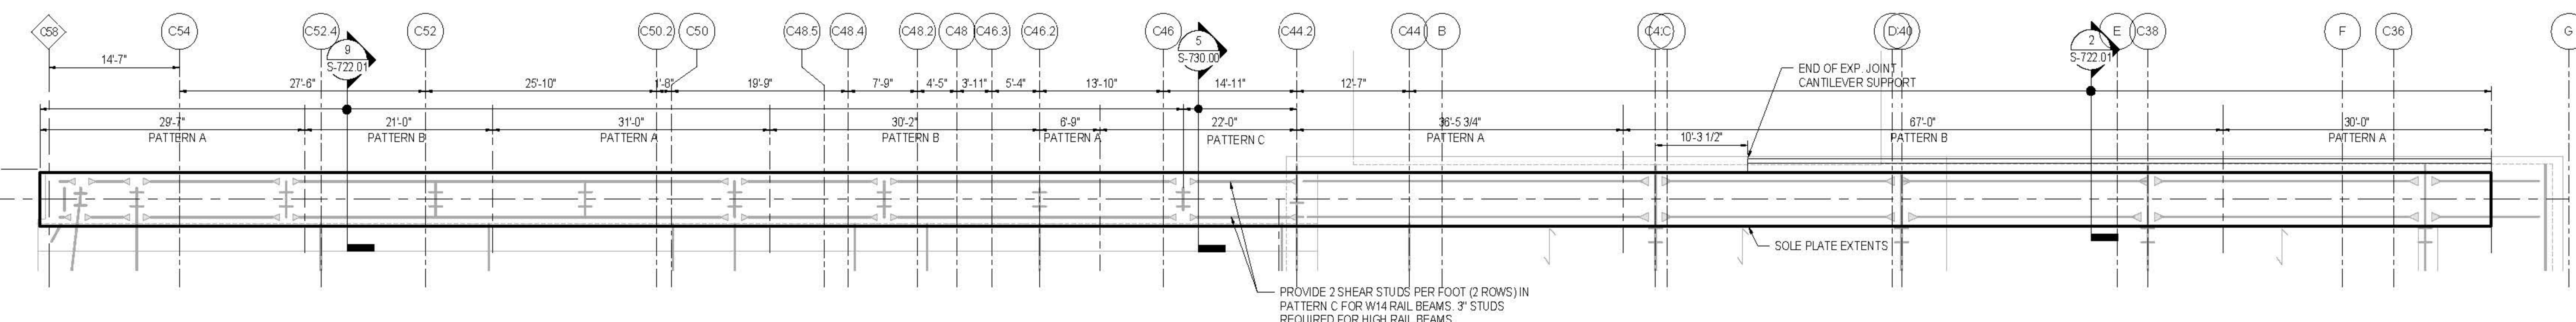


1 PLAN-RCL.A RAIL BASE DETAILS
1/8" = 1'-0"

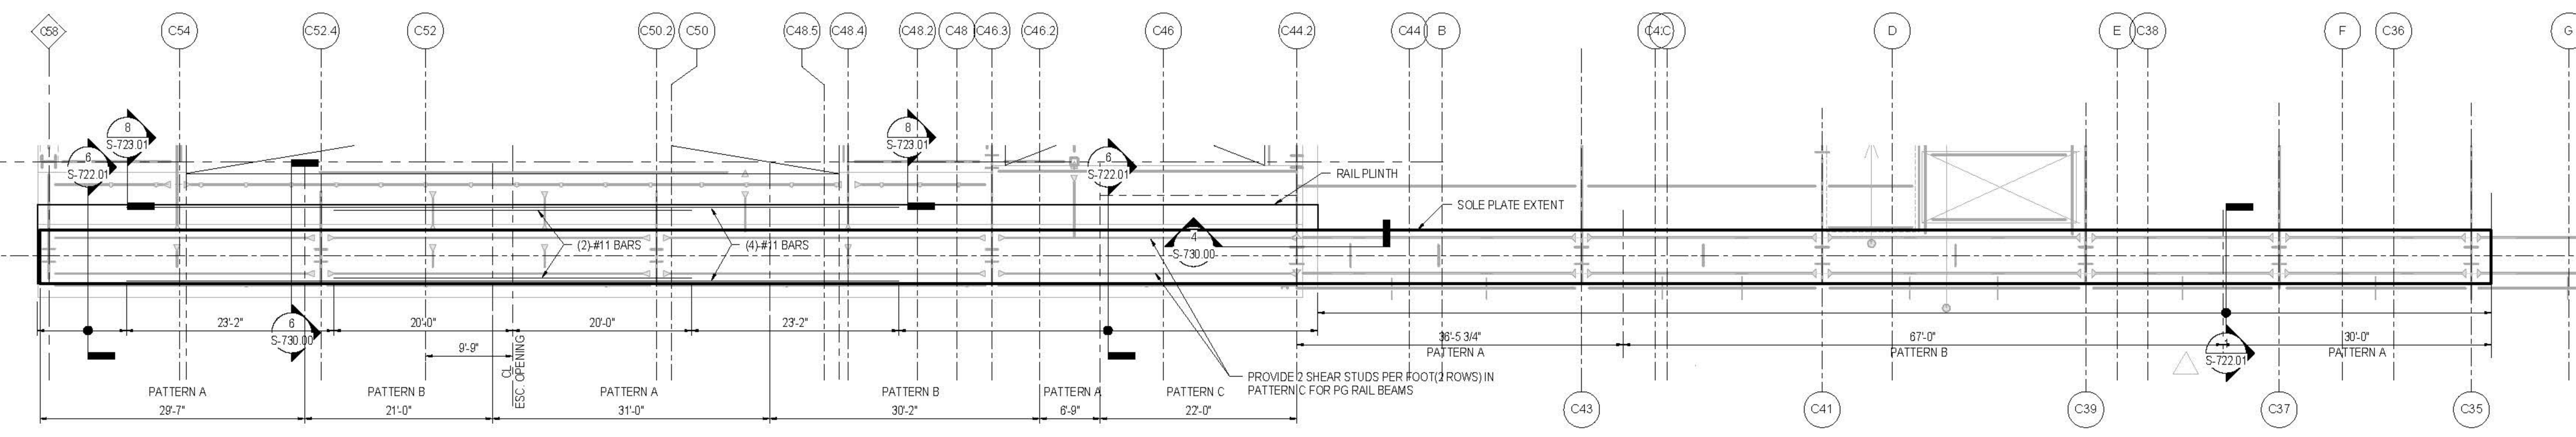


2 PLAN-RCL.S RAIL BASE DETAILS
1/8" = 1'-0"

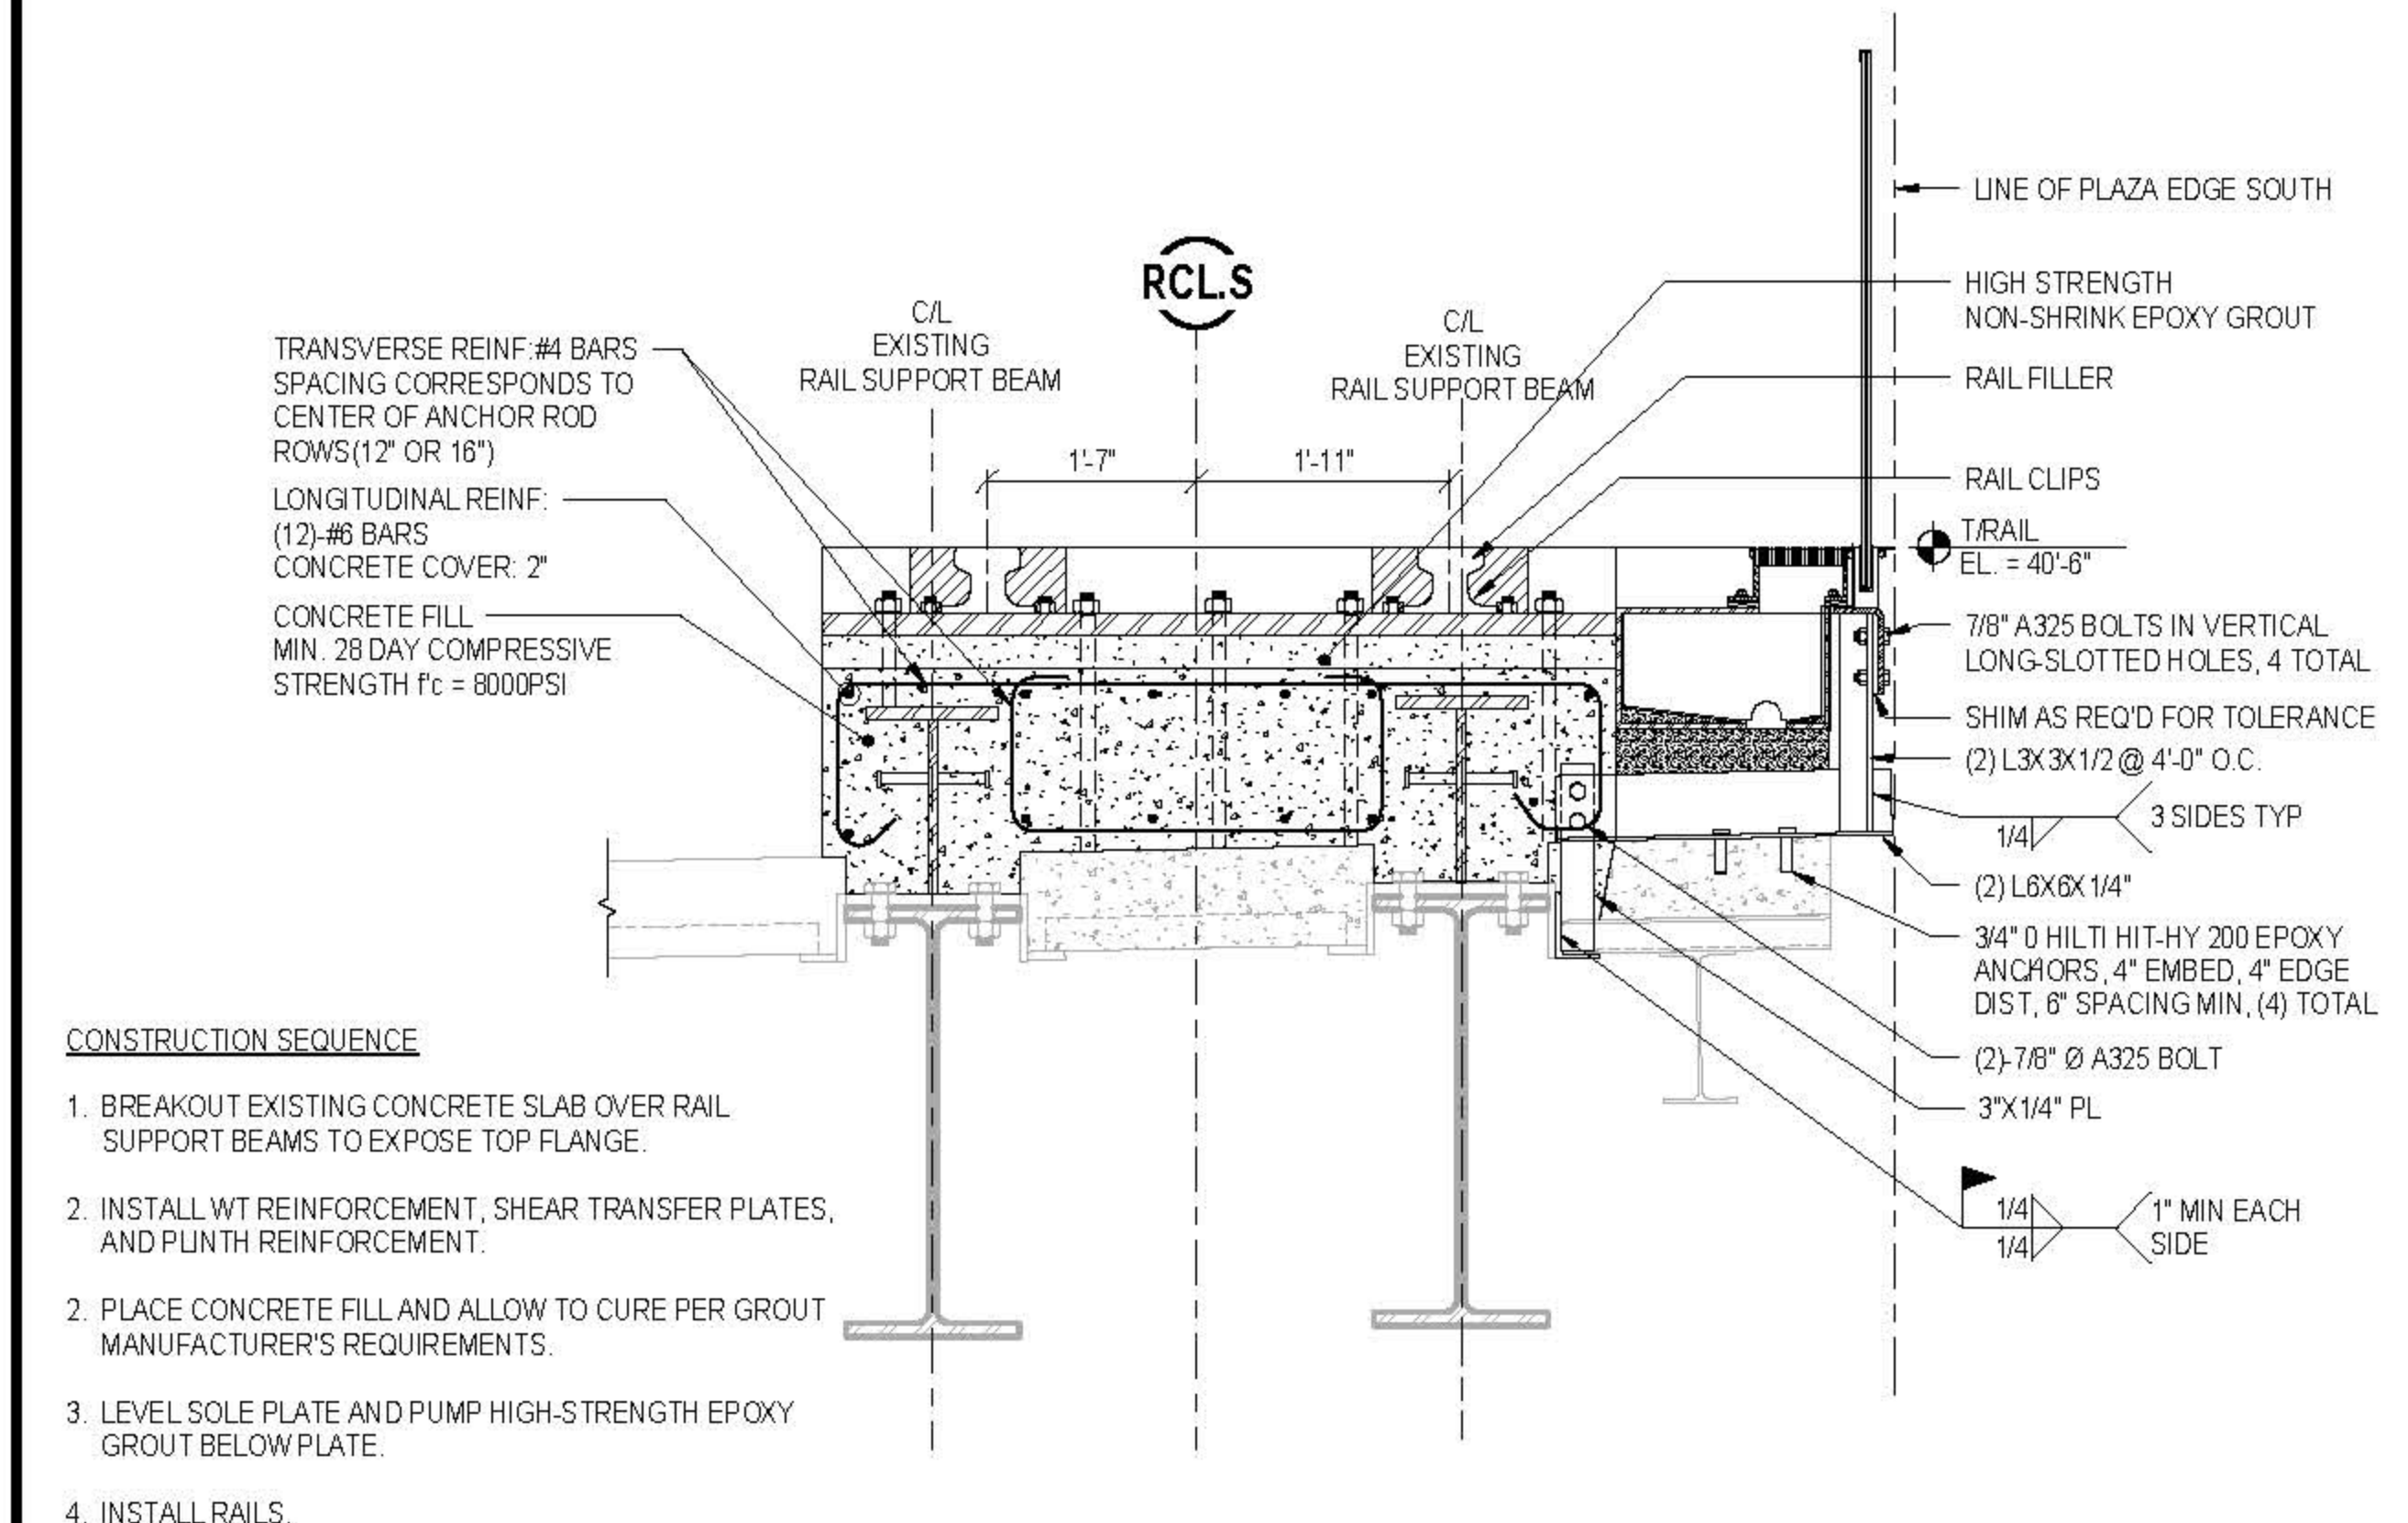


3 TYPICAL SECTION OF SOUTH RAILS AT PLAZA
3/4" = 1'-0"

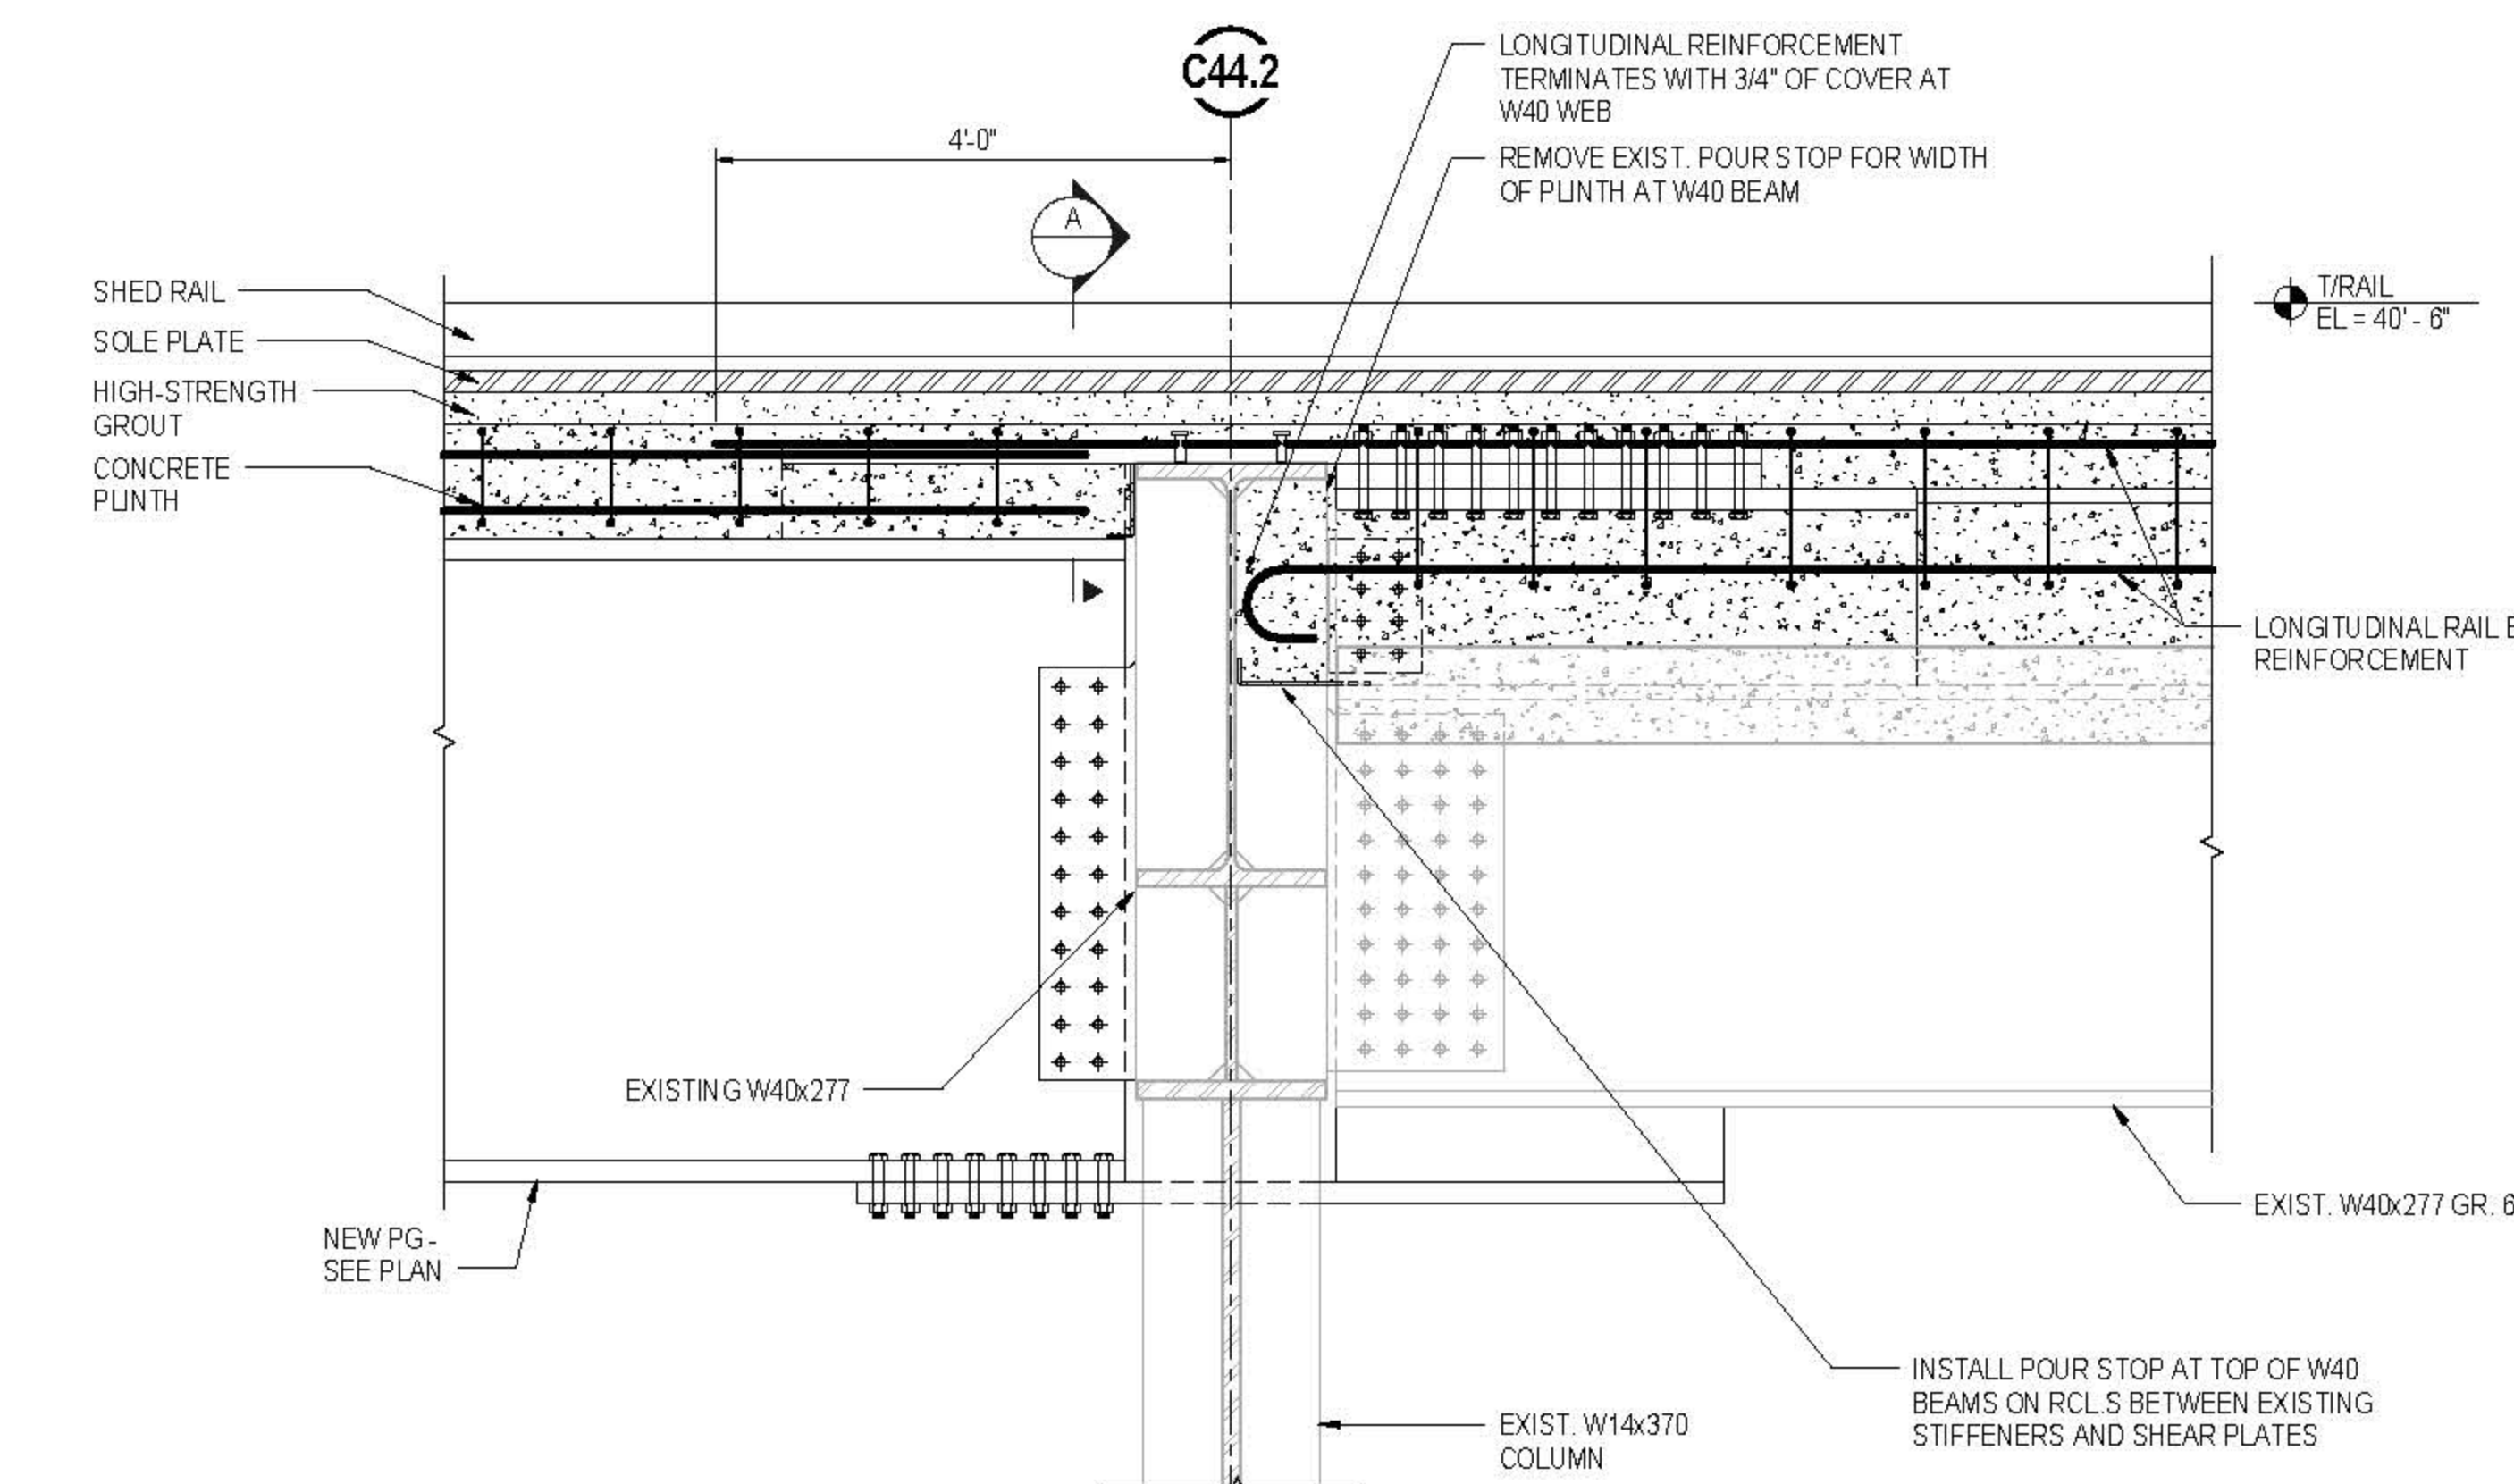


4 SECTION AT SOUTH RAIL SUPPORT BEAM AT C44.2
3/4" = 1'-0"

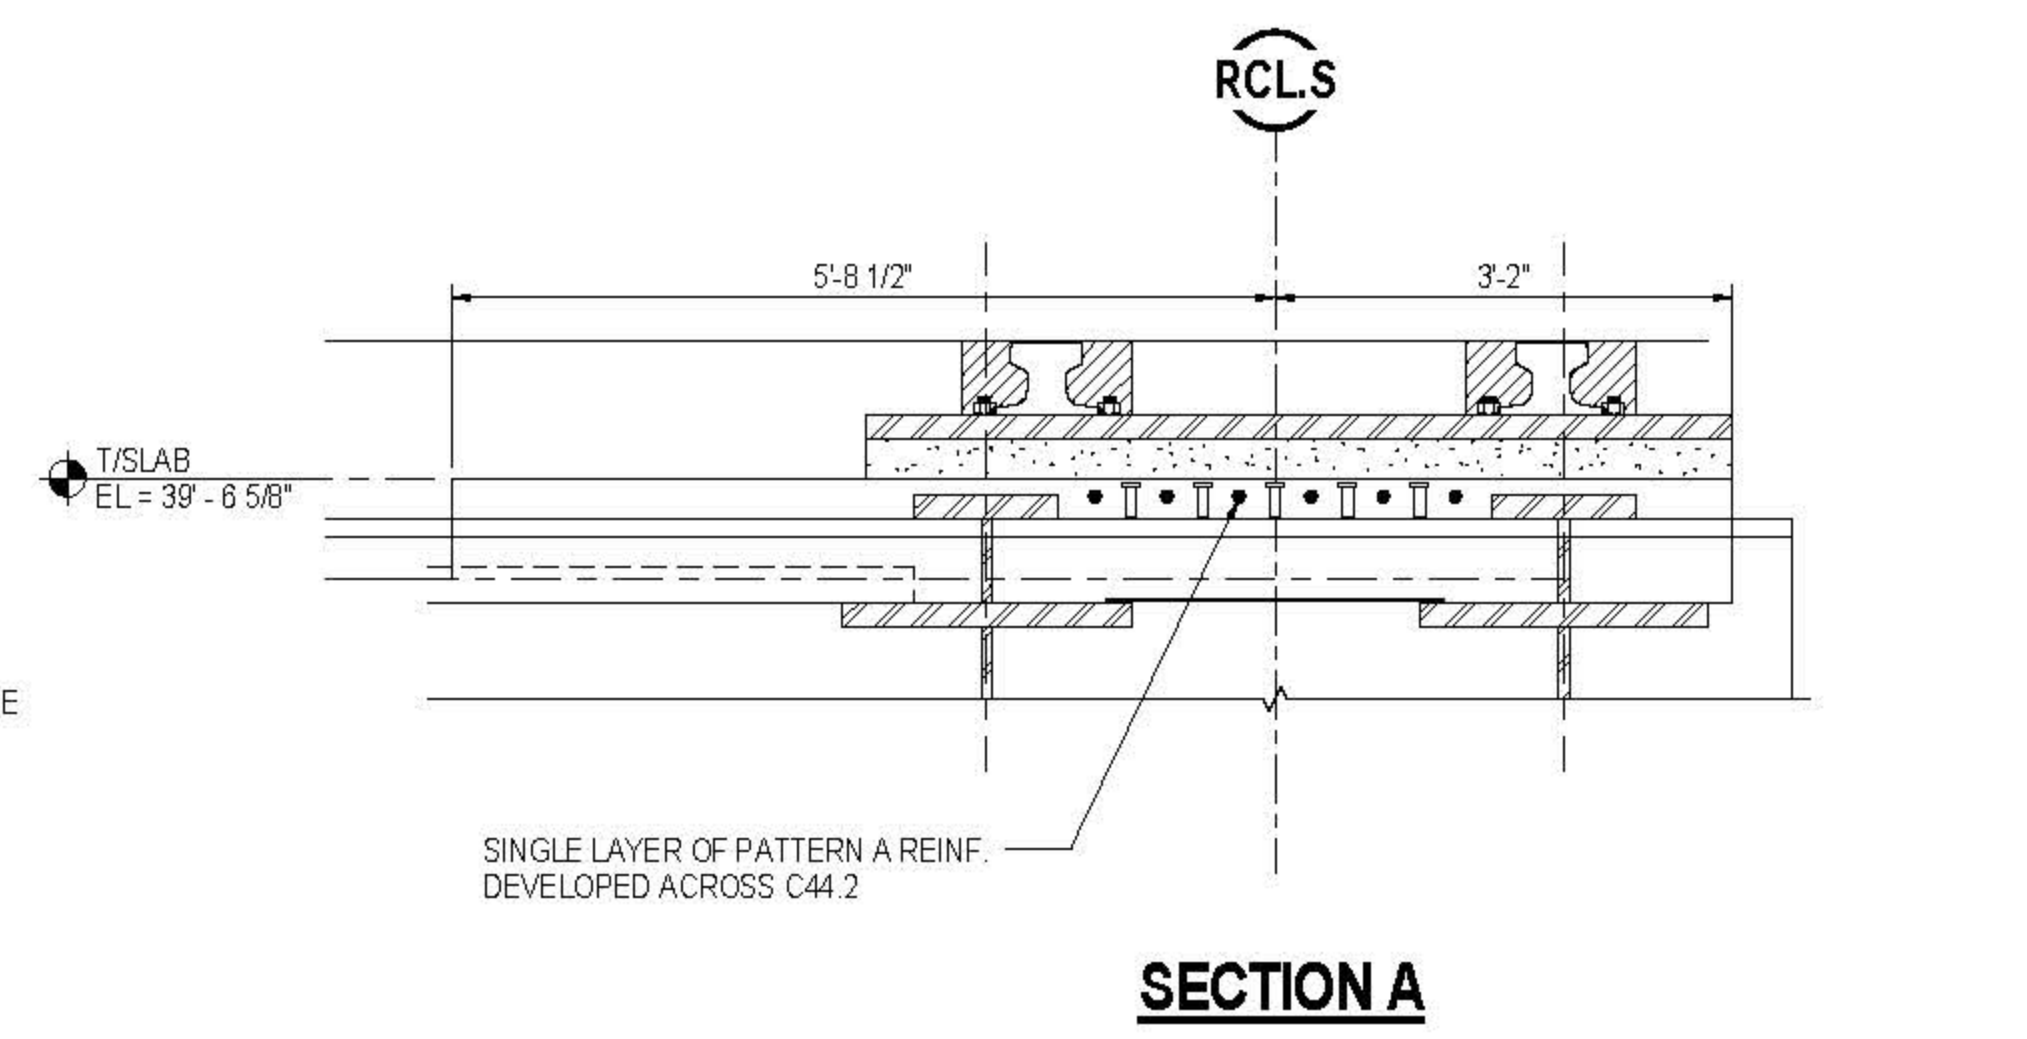


SECTION A

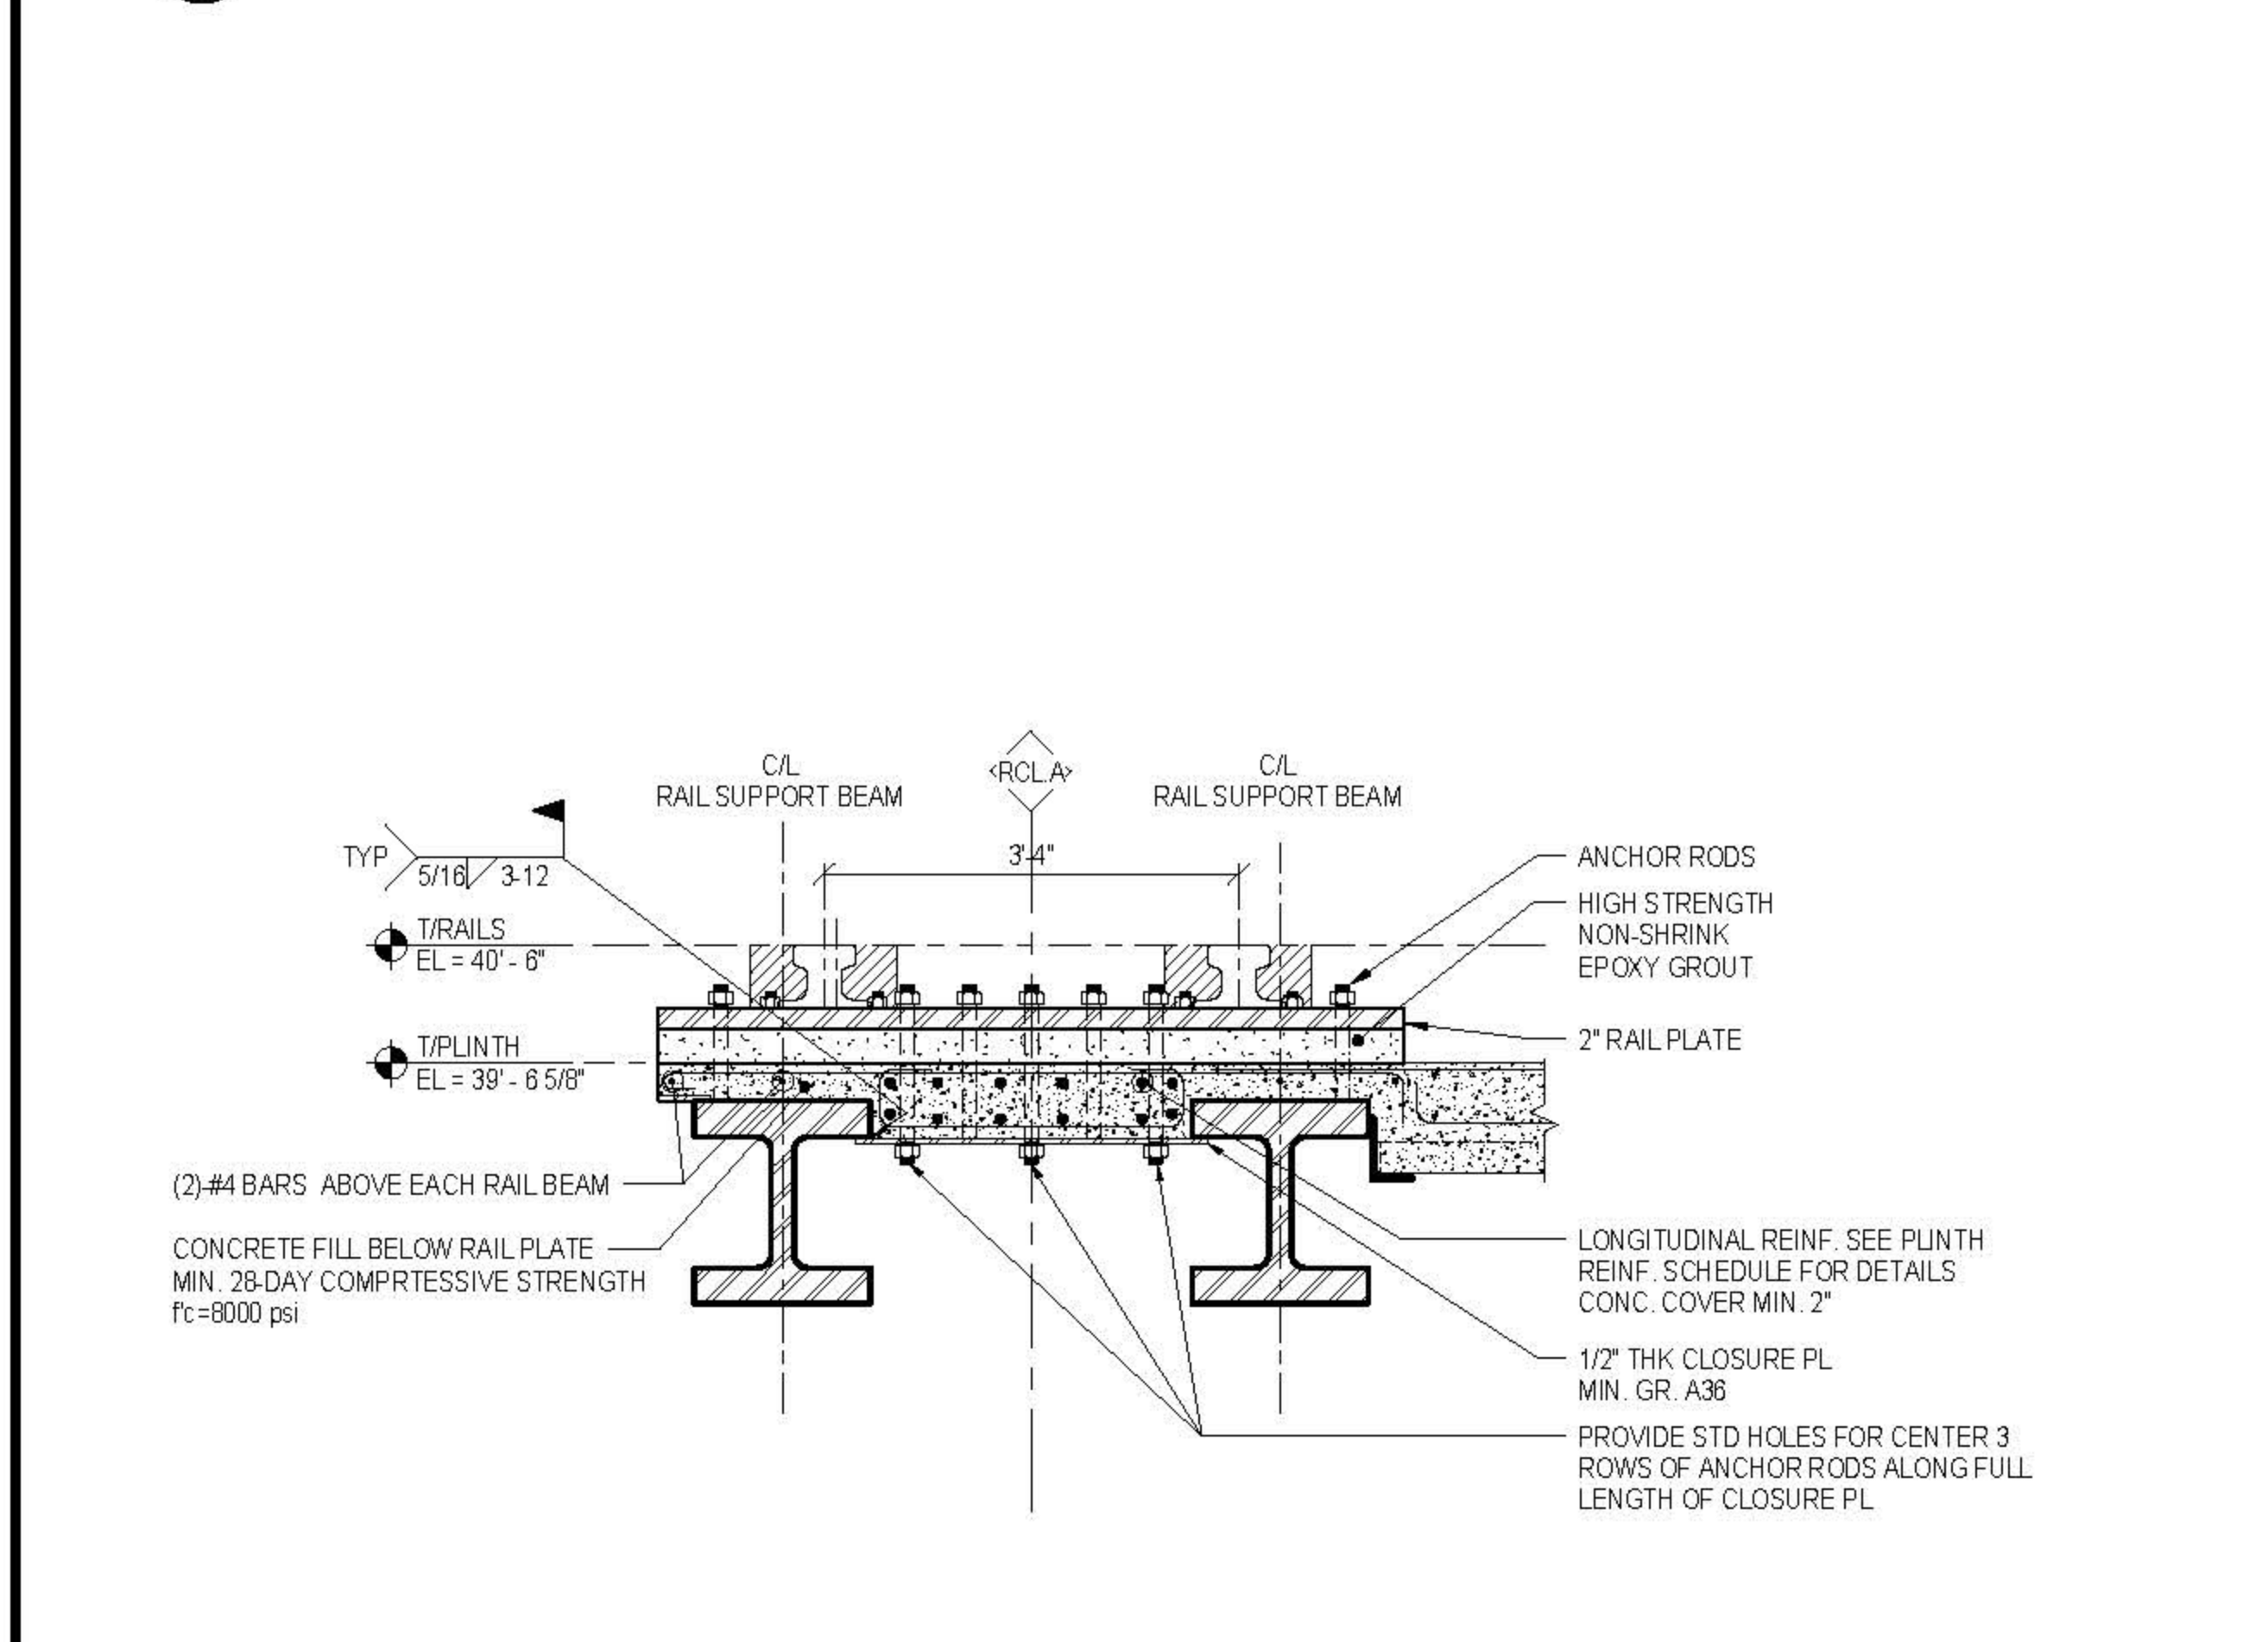


6 SECTION AT NORTH RAILS AT FIXED BUILDING-LOW CLOSURE PLATE
3/4" = 1'-0"

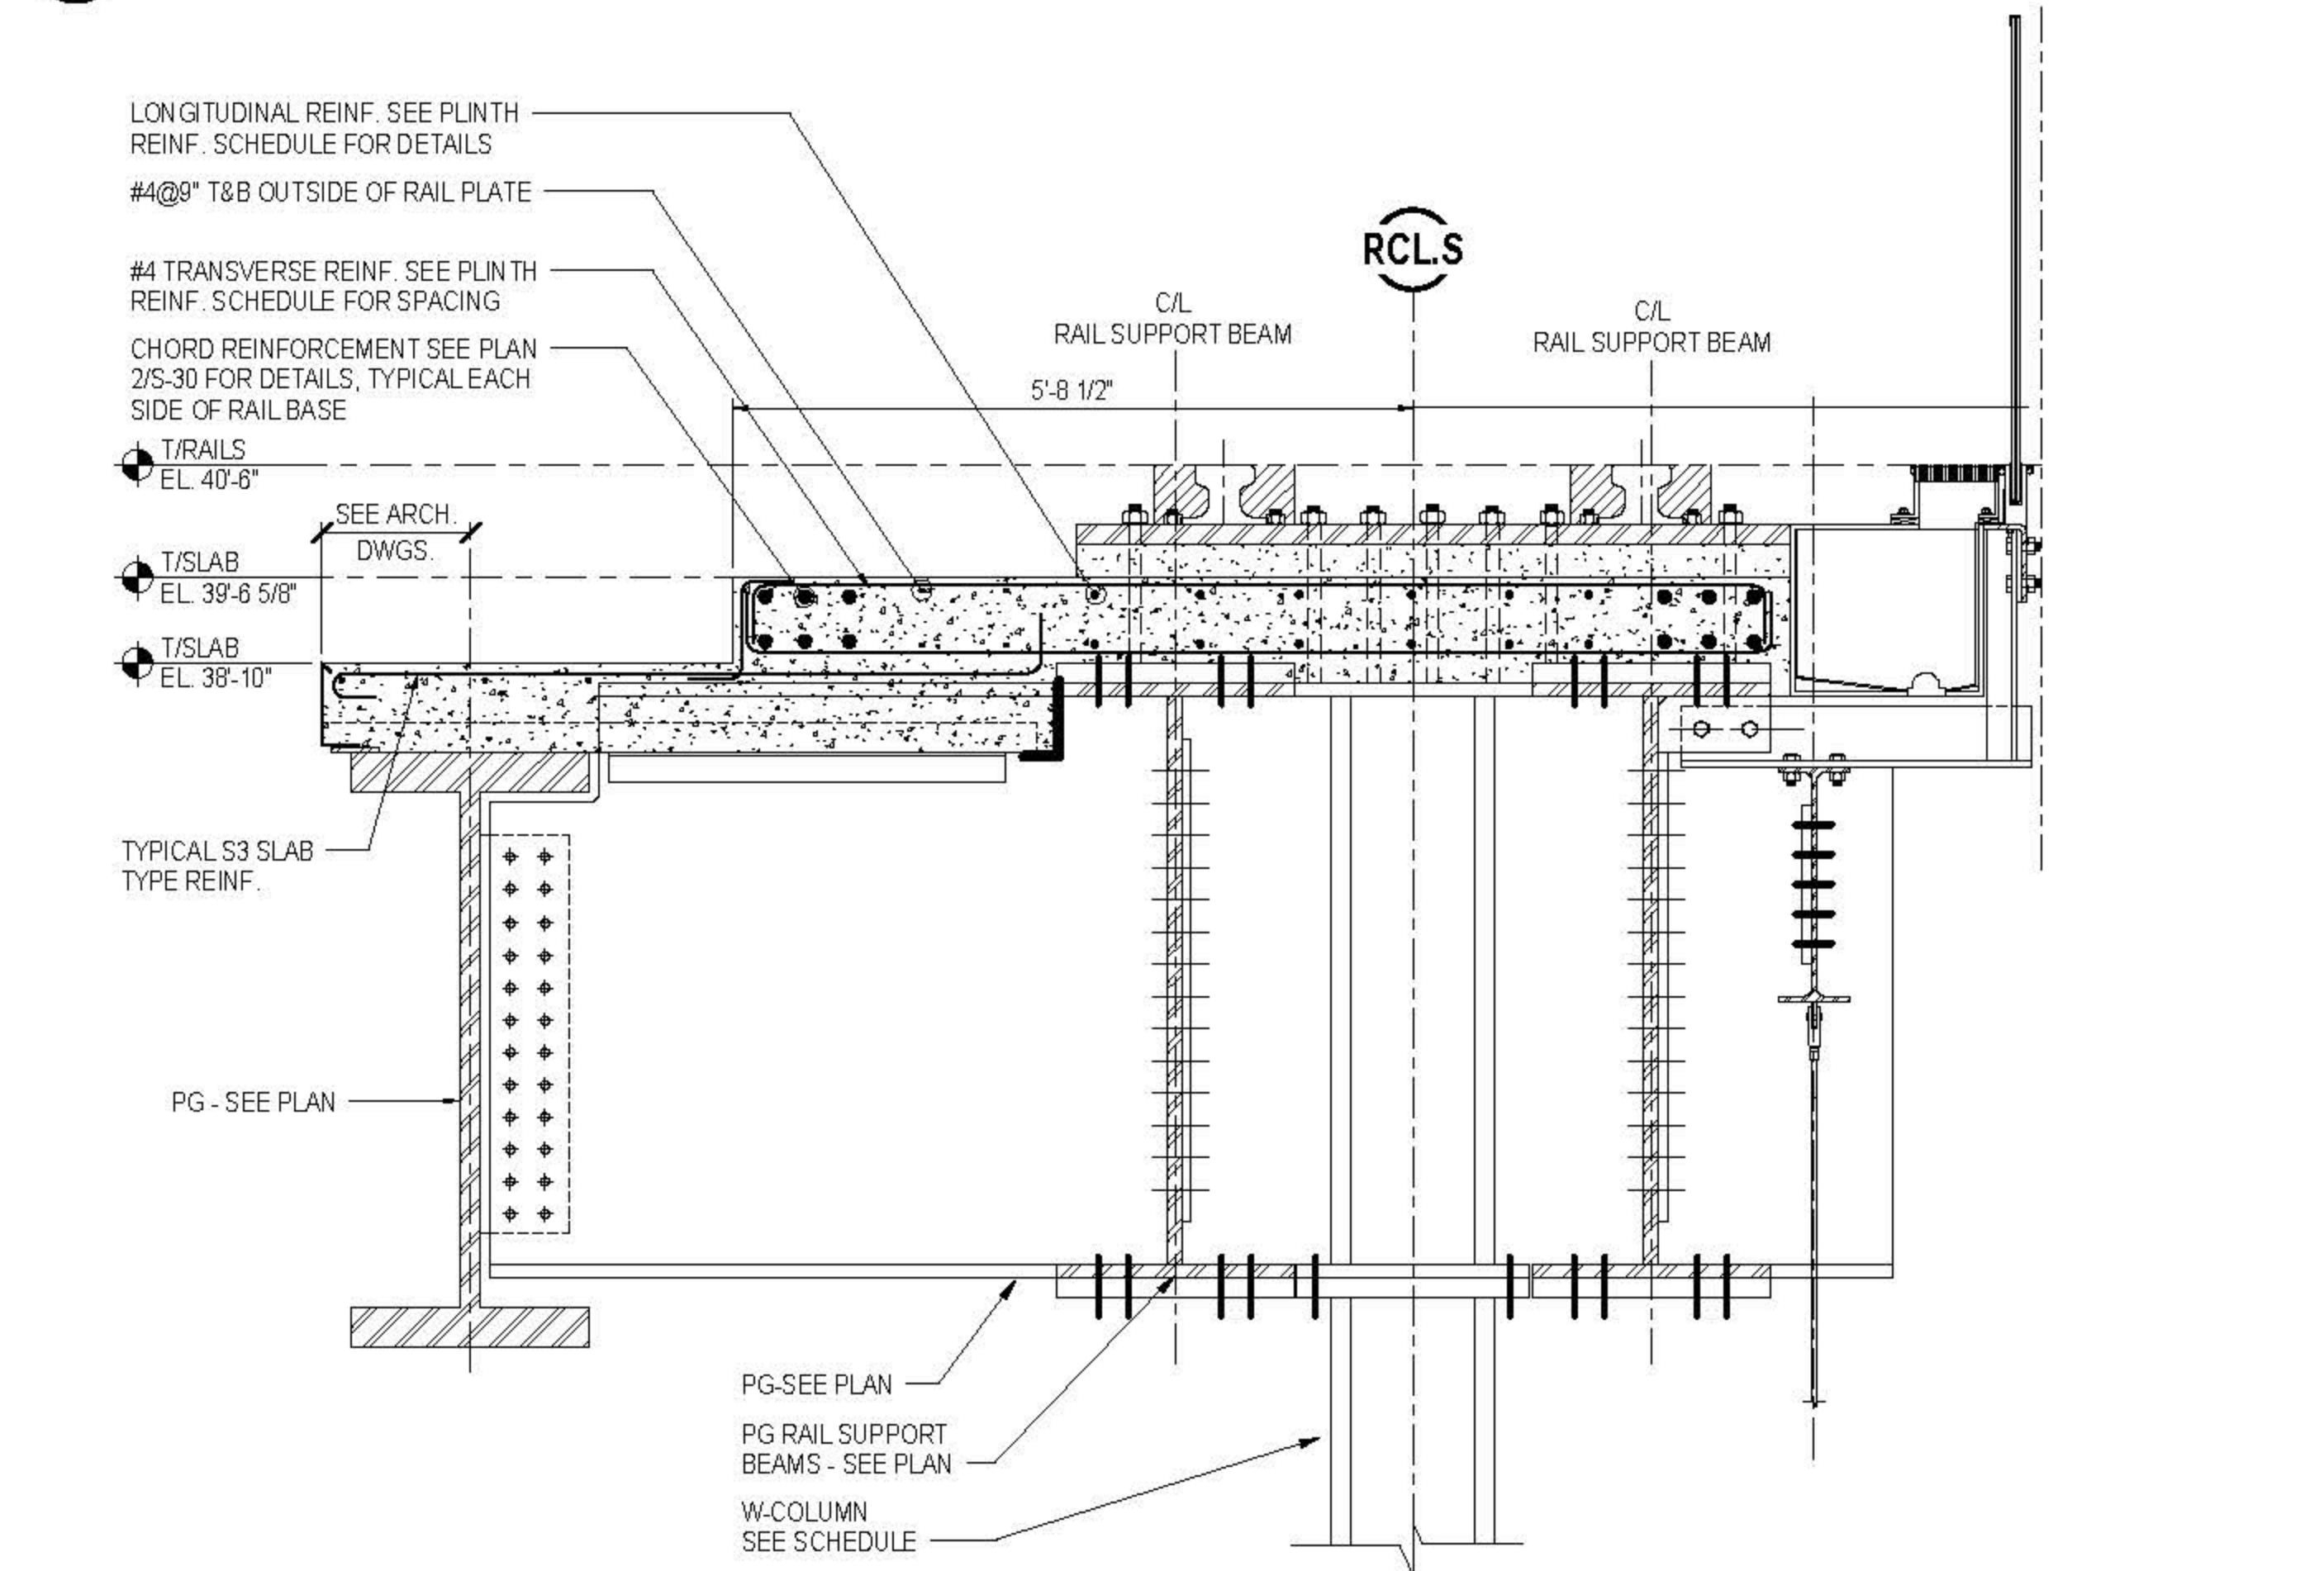

6 SECTION OF SOUTH RAIL BASE AT ESCALATOR OPENING
3/4" = 1'-0"

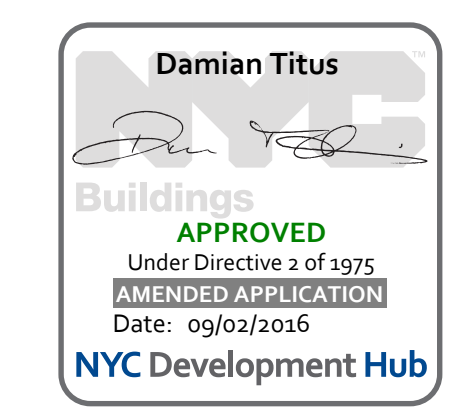

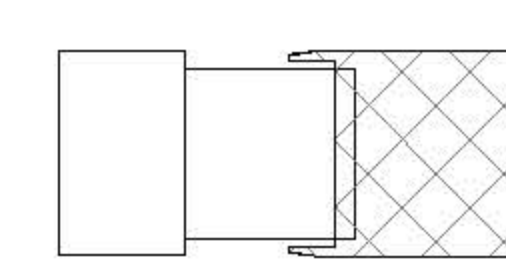

ISSUE	PRINTING	DATE
03	60	DOB AMENDMENT 7
04	30	DOB AMENDMENT 6
21		CONSTRUCTION SET
10	4	100% CONSTRUCTION DOCUMENTS
9		90% CONSTRUCTION DOCUMENTS
6		PRELIMINARY JOB SUBMISSION
1		ADVANCED PROCUREMENT BID SET



DRAWN BY: *Audrey* CHECKED BY: *Chris*

PROJECT NUMBER: N1318.00





TITLE: DETAILS, DEPLOYED SHED NORTH/SOUTH TYPICAL WALL SECTIONS

DRAWING NO.: S-750.01




B-SCAN NO.: S-750.01

88 of 123

GEOMETRY, DIMENSIONS AND SURFACE CONTOURING, BLENDING AND INTERSECTION OF SECTIONS ILLUSTRATED IN THE STRUCTURAL DRAWINGS ARE PROVIDED FOR REFERENCE AND GENERATION OF STRUCTURAL ARRANGEMENT AND DETAILS ONLY. THE 3D MODEL ISSUED BY THE ARCHITECT DEFINES THE EXTERIOR SURFACE AND SHALL BE ADHERED TO FOR THE FINAL GEOMETRY FOR DETAILS OF SECONDARY STEEL, INCLUDING STRUCTURAL CLADDING REFER TO ARCHITECTURE DRAWINGS. IT IS THE RESPONSIBILITY OF THE CONTRACTOR TO IDENTIFY ANY DISCREPANCIES OR AMBIGUITIES FOR DISCUSSION, RESOLUTION AND DIRECTION FROM THE ARCHITECT AND SER.

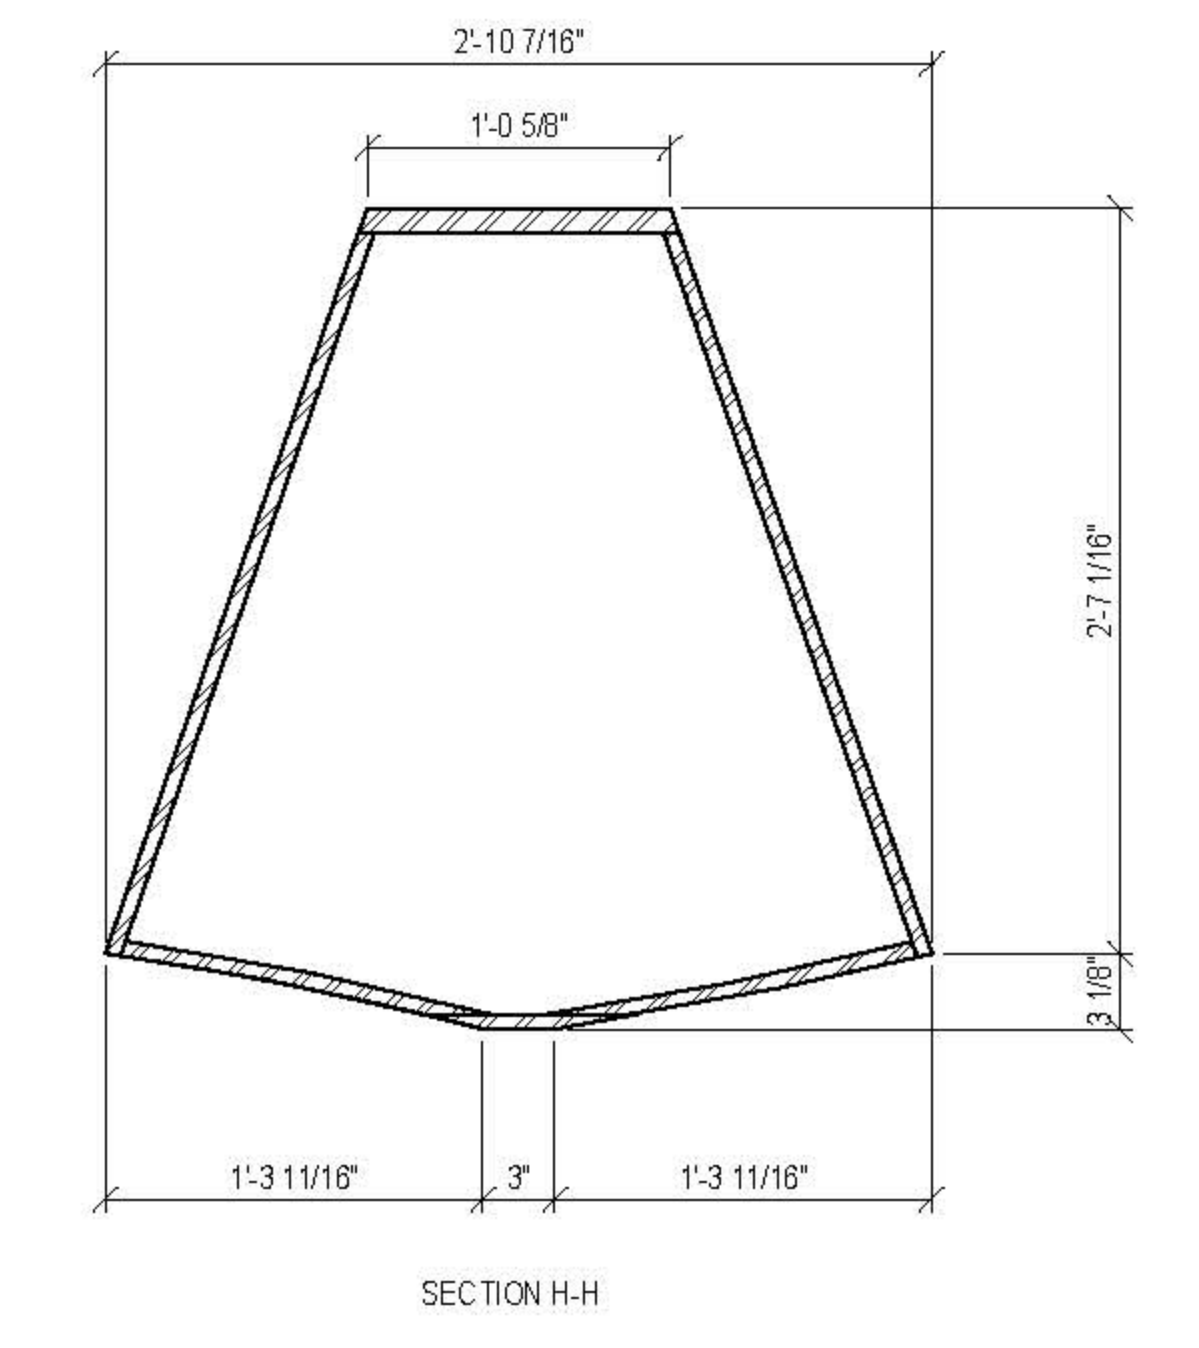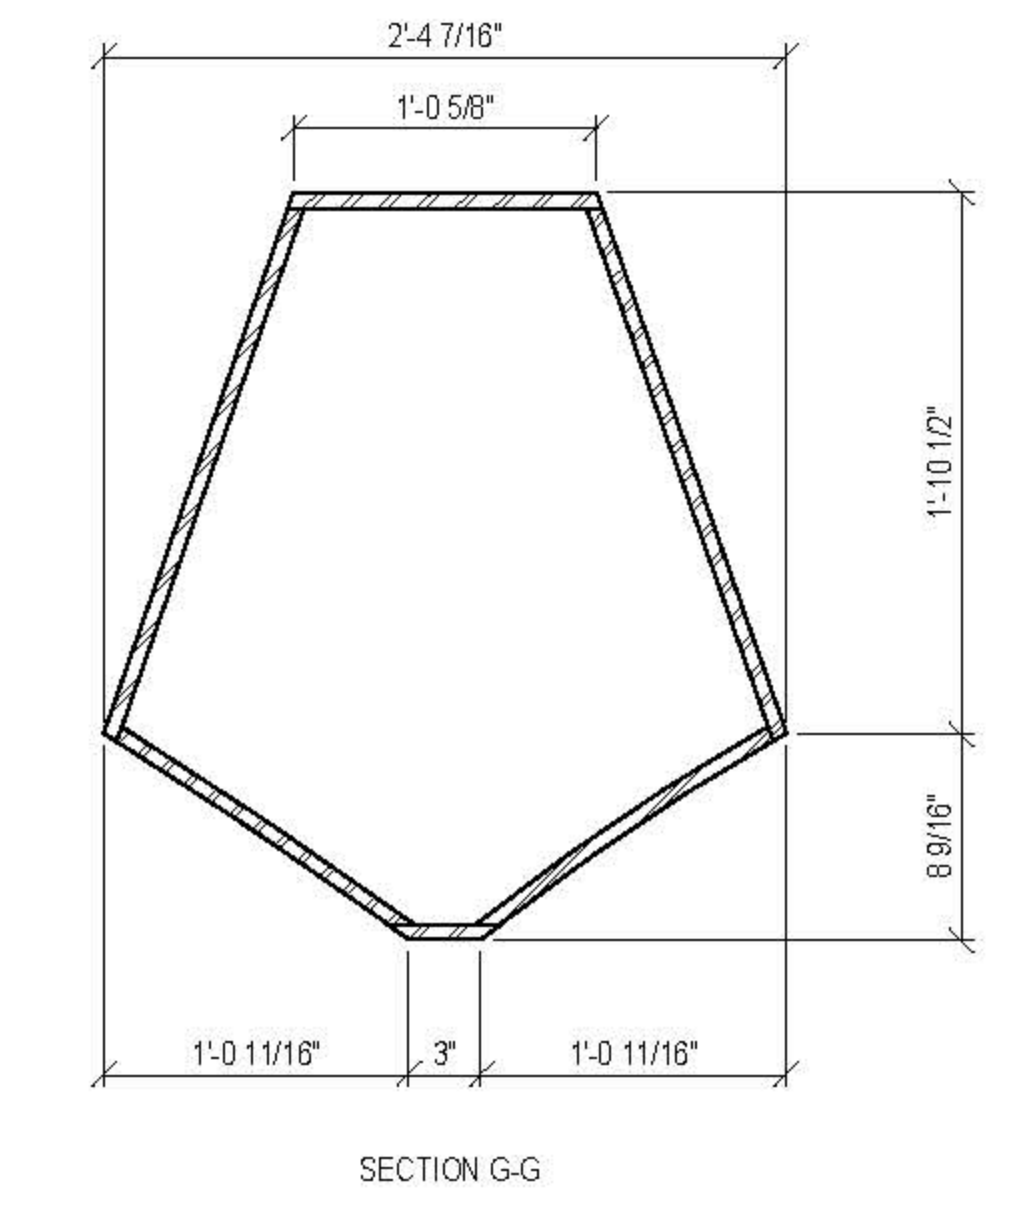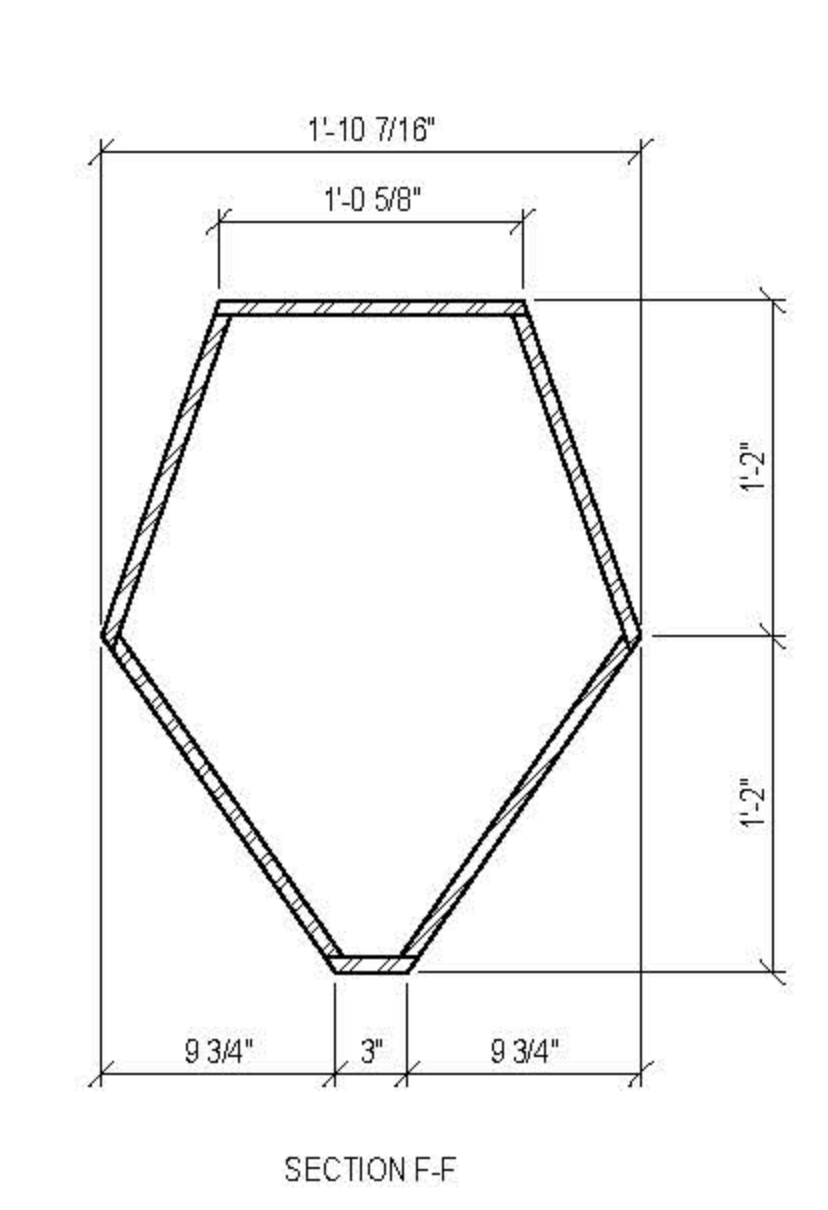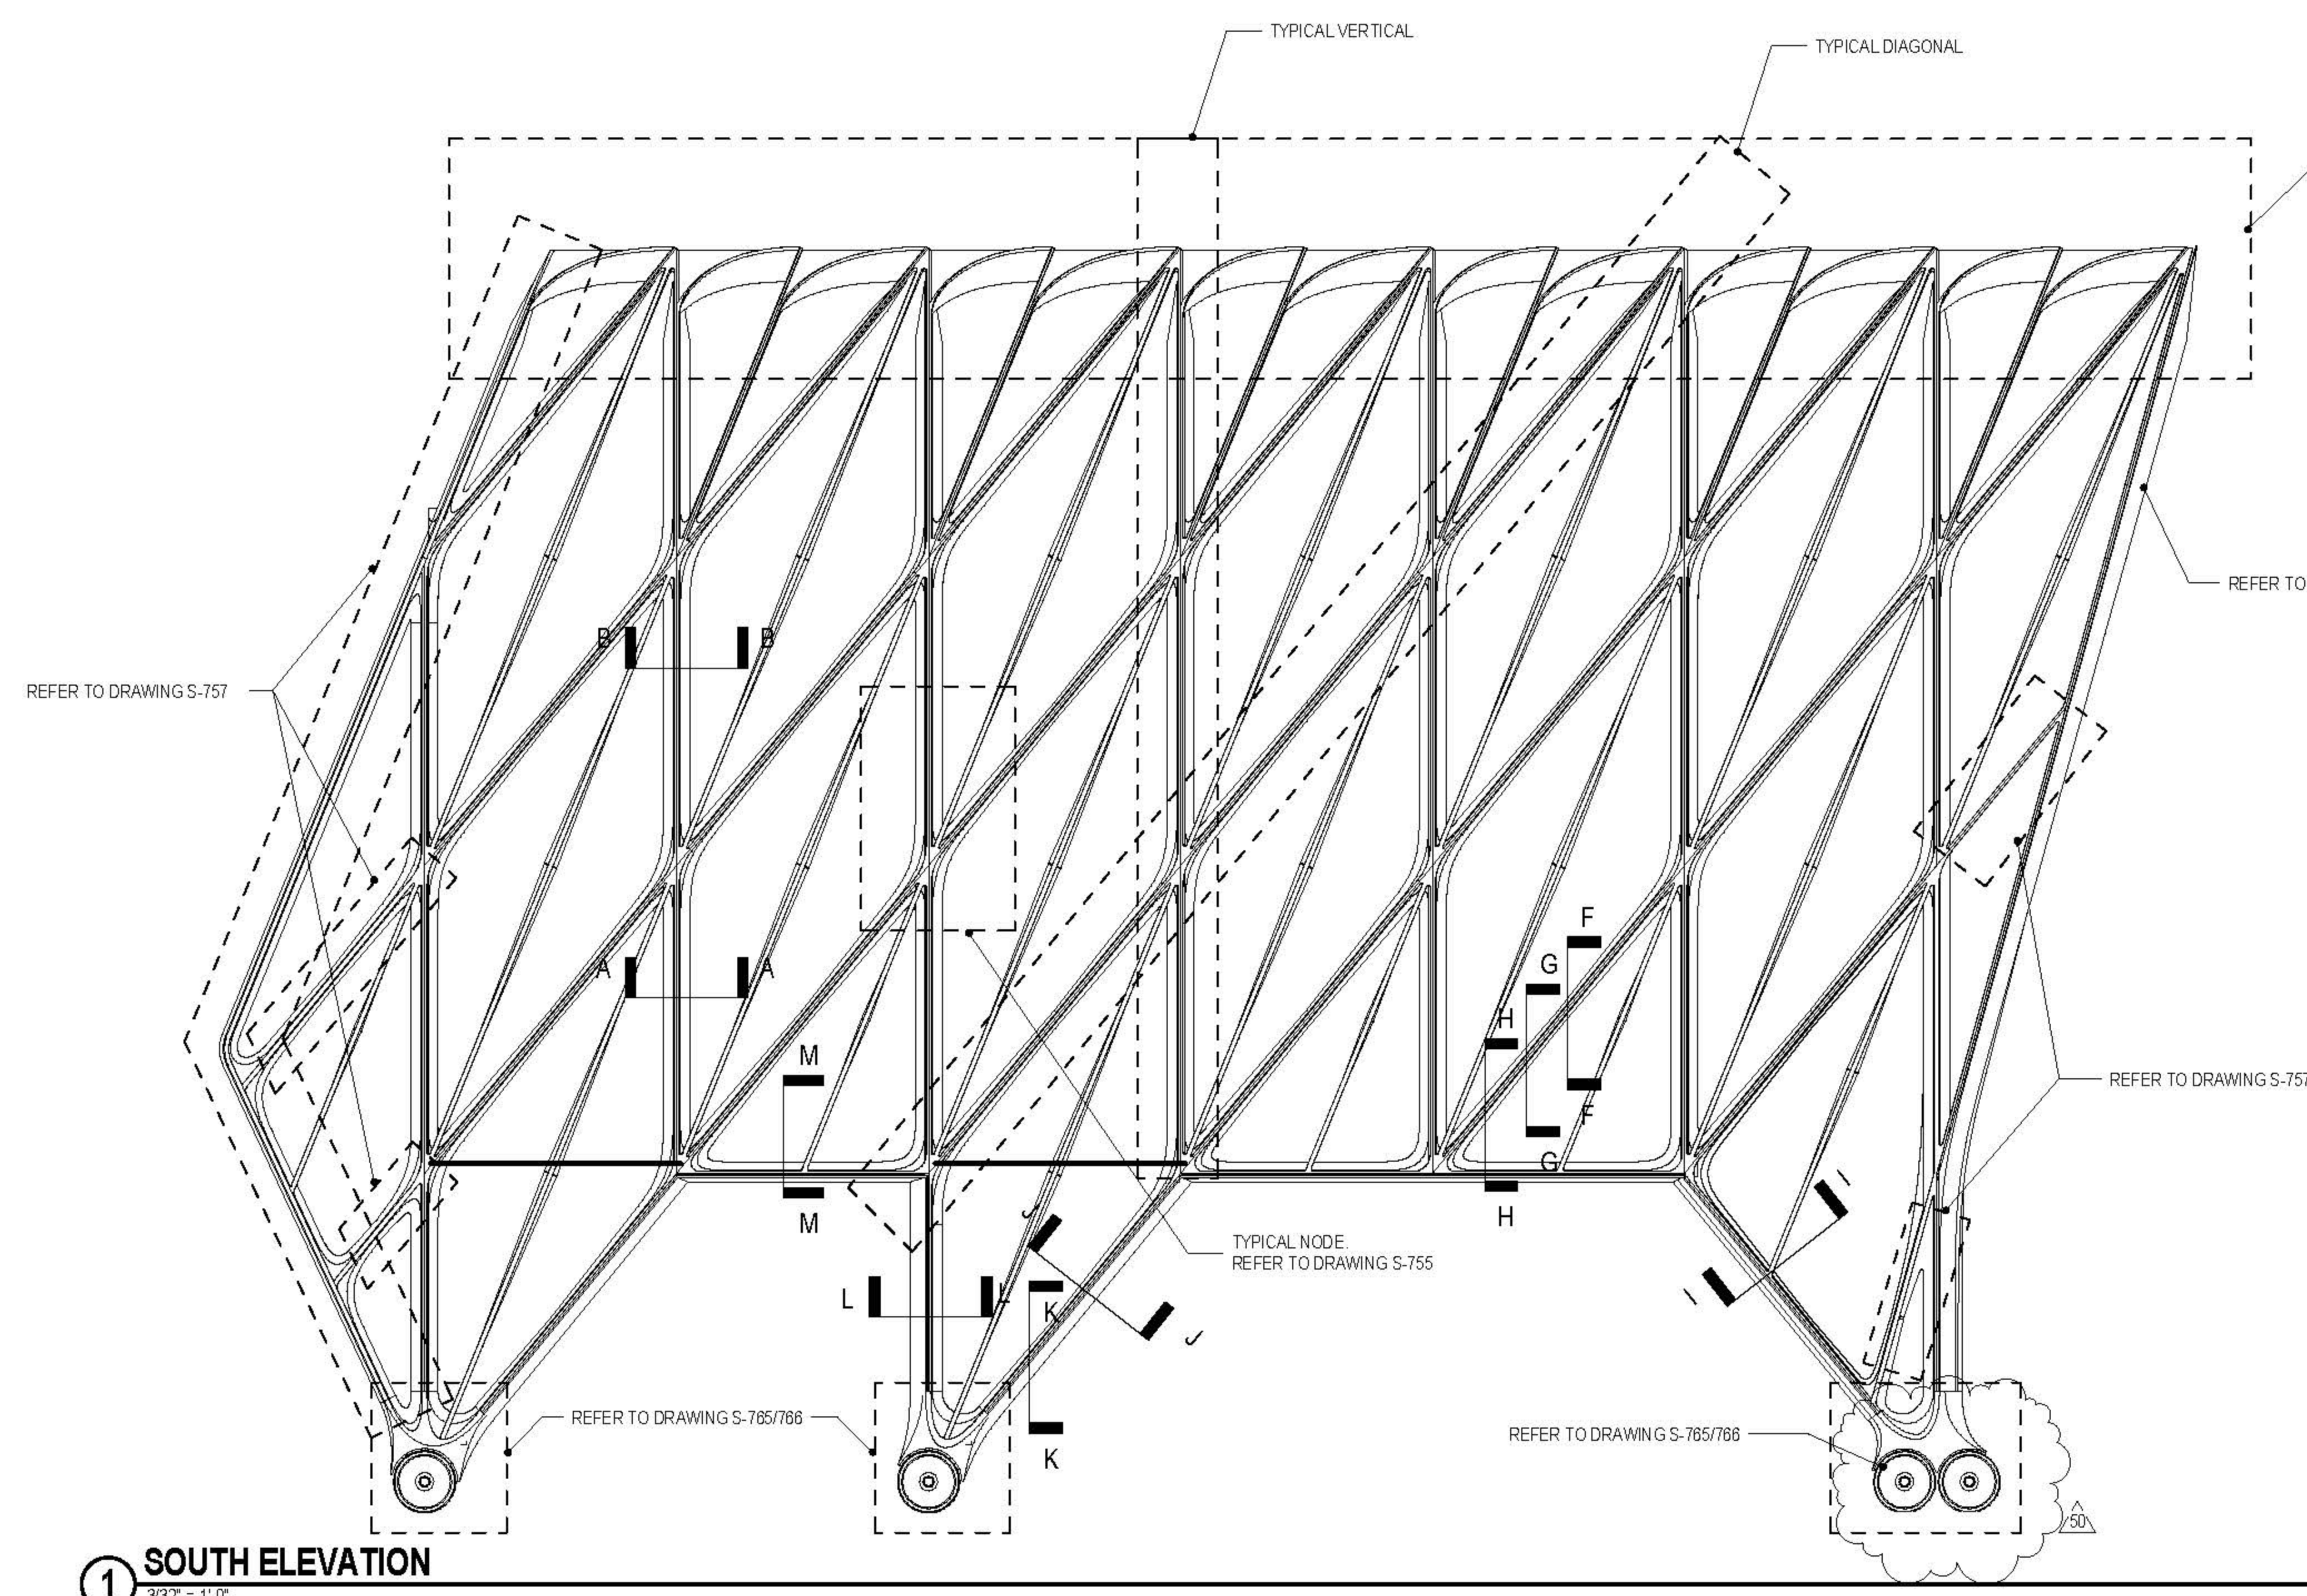


5 TYPICAL DIAGONAL SECTION DIAPHRAGM
1 1/2" = 1'-0"

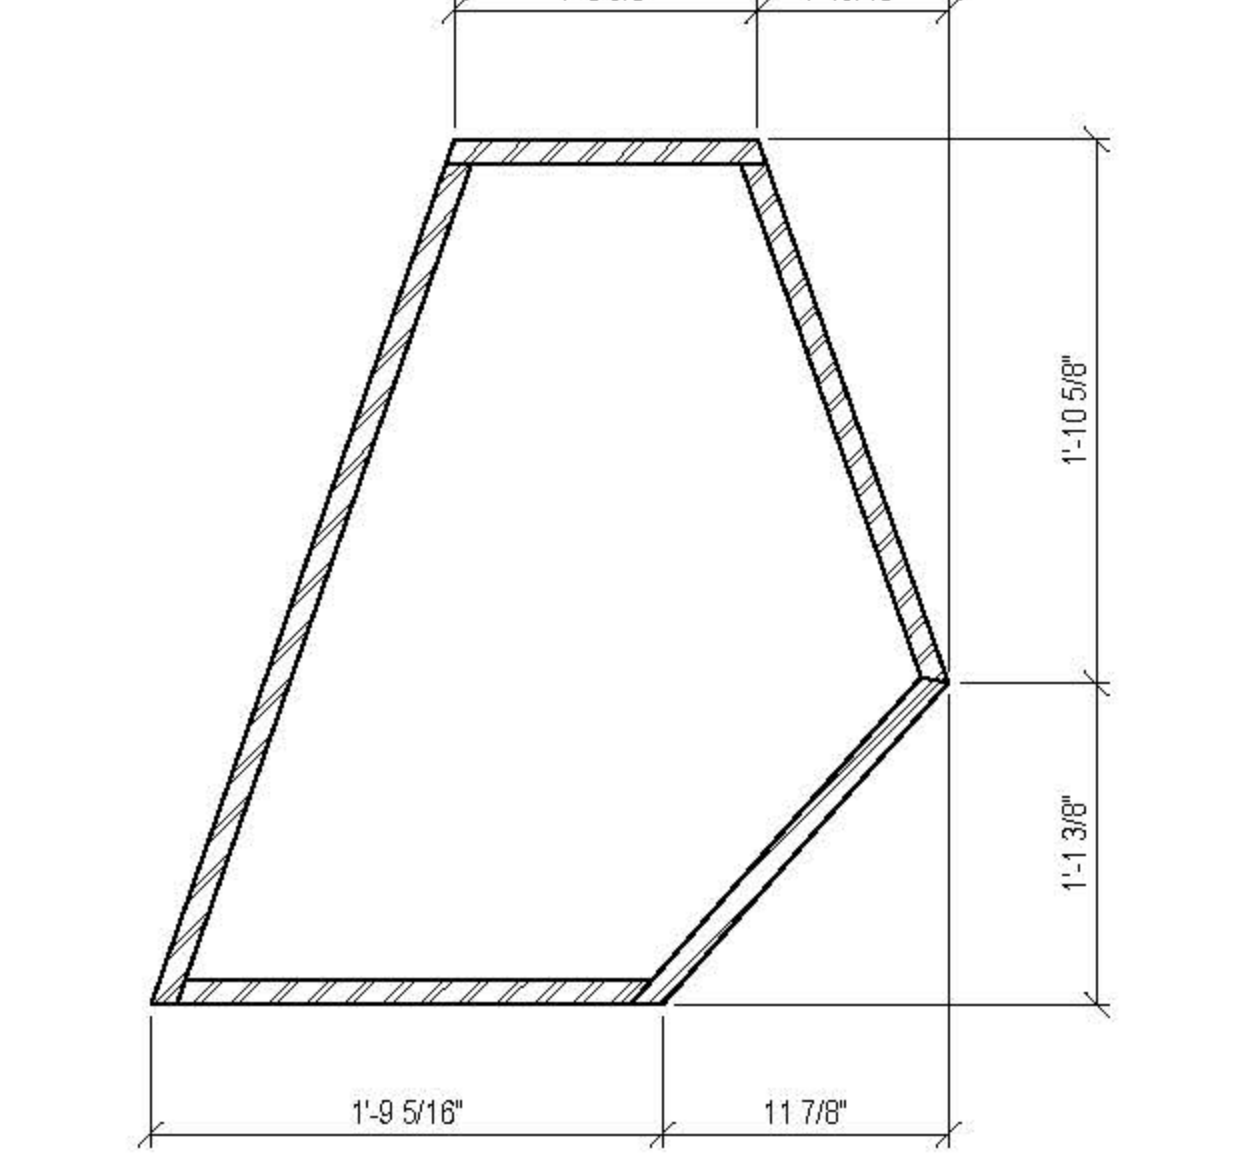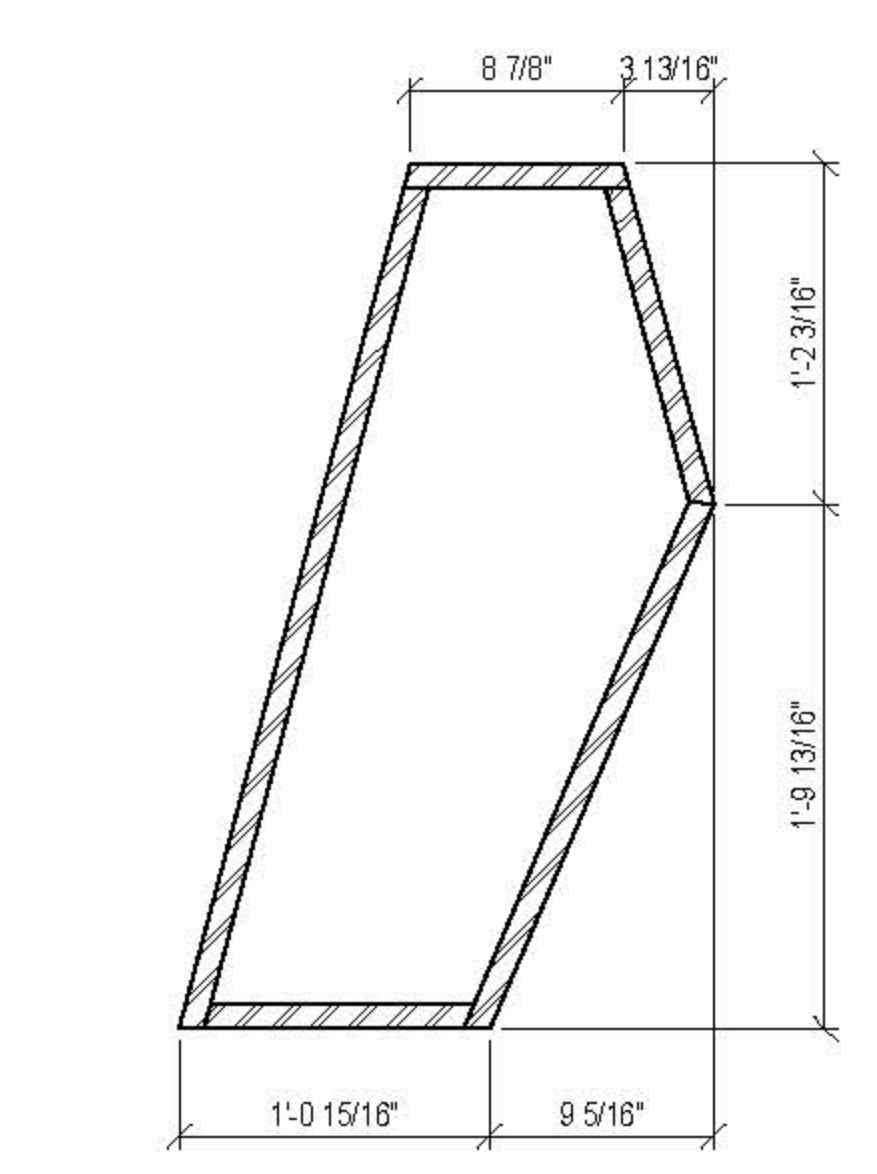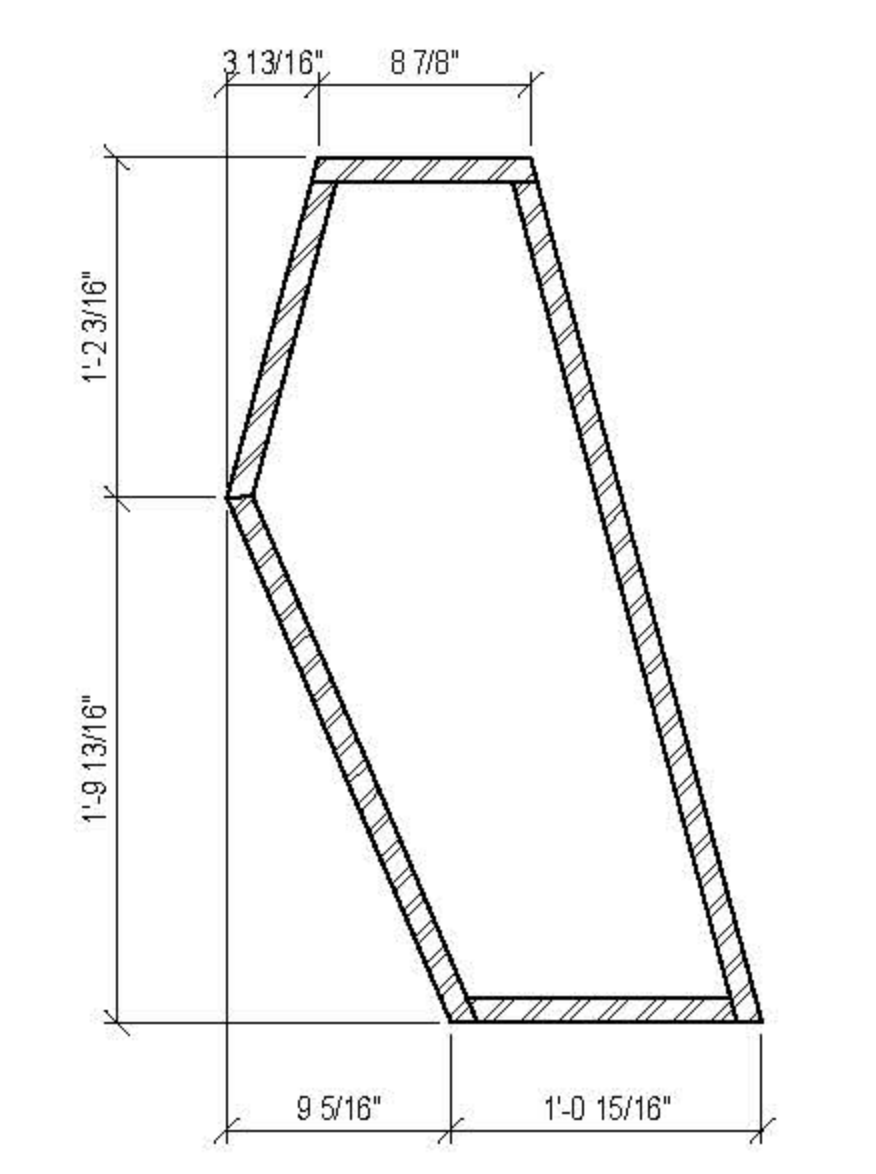


6 SECTION I-I
1 1/2" = 1'-0"

7 SECTION J-J
1 1/2" = 1'-0"


8 SECTION K-K
1 1/2" = 1'-0"

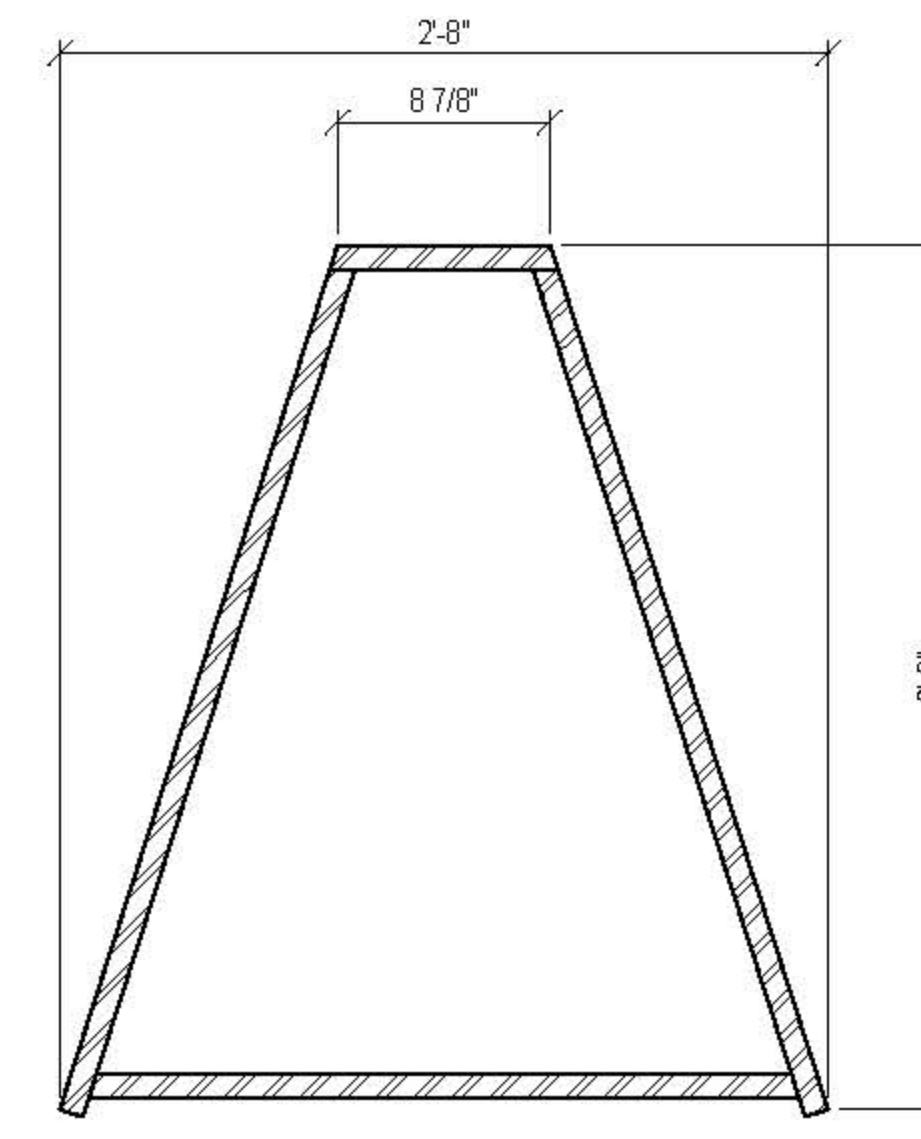


9 SECTION L-L
1 1/2" = 1'-0"

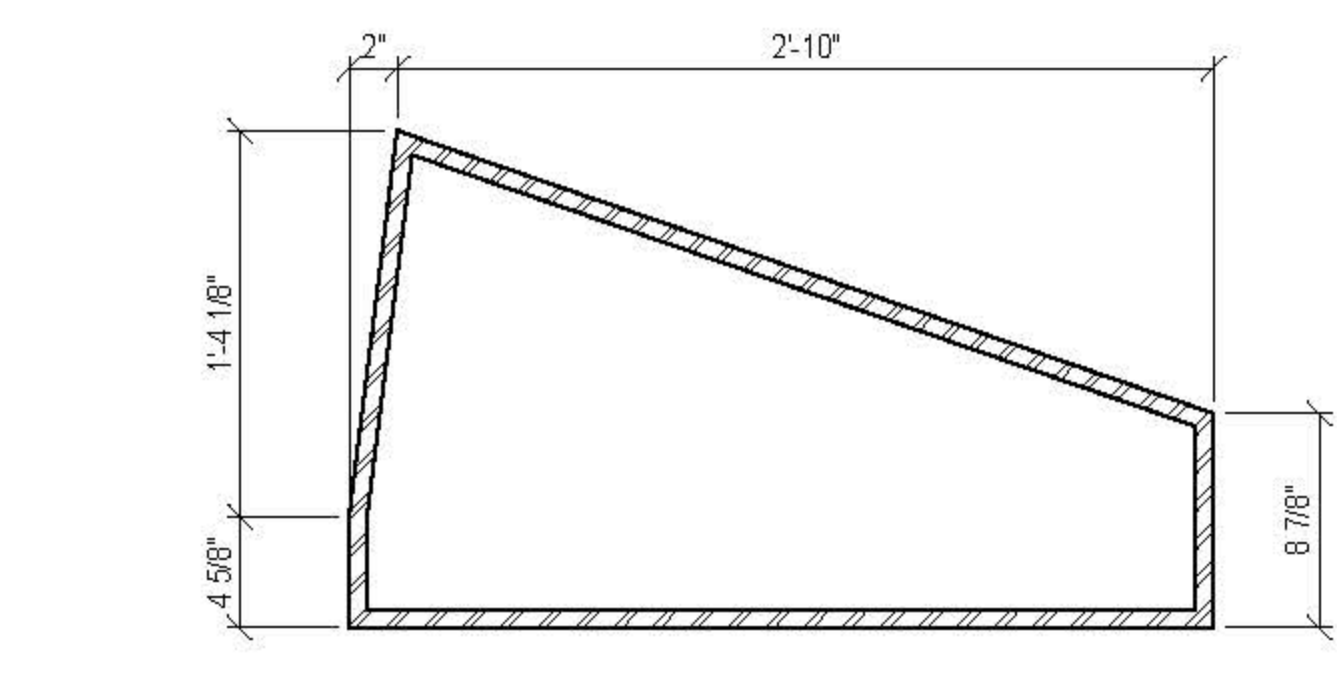

10 SECTION M-M
1 1/2" = 1'-0"

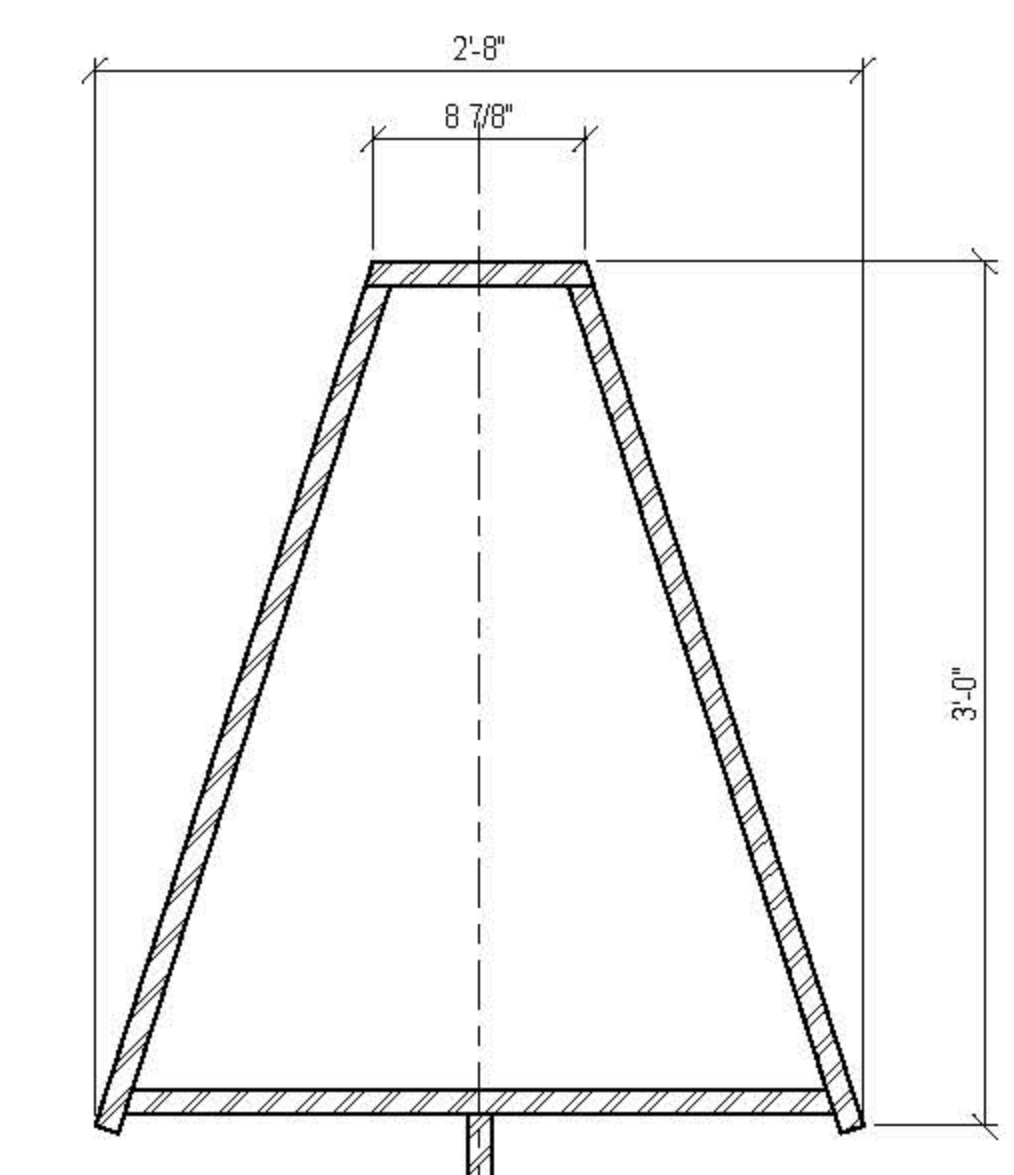

2 SECTION A-A-TYPICAL VERTICAL SECTION
1 1/2" = 1'-0"

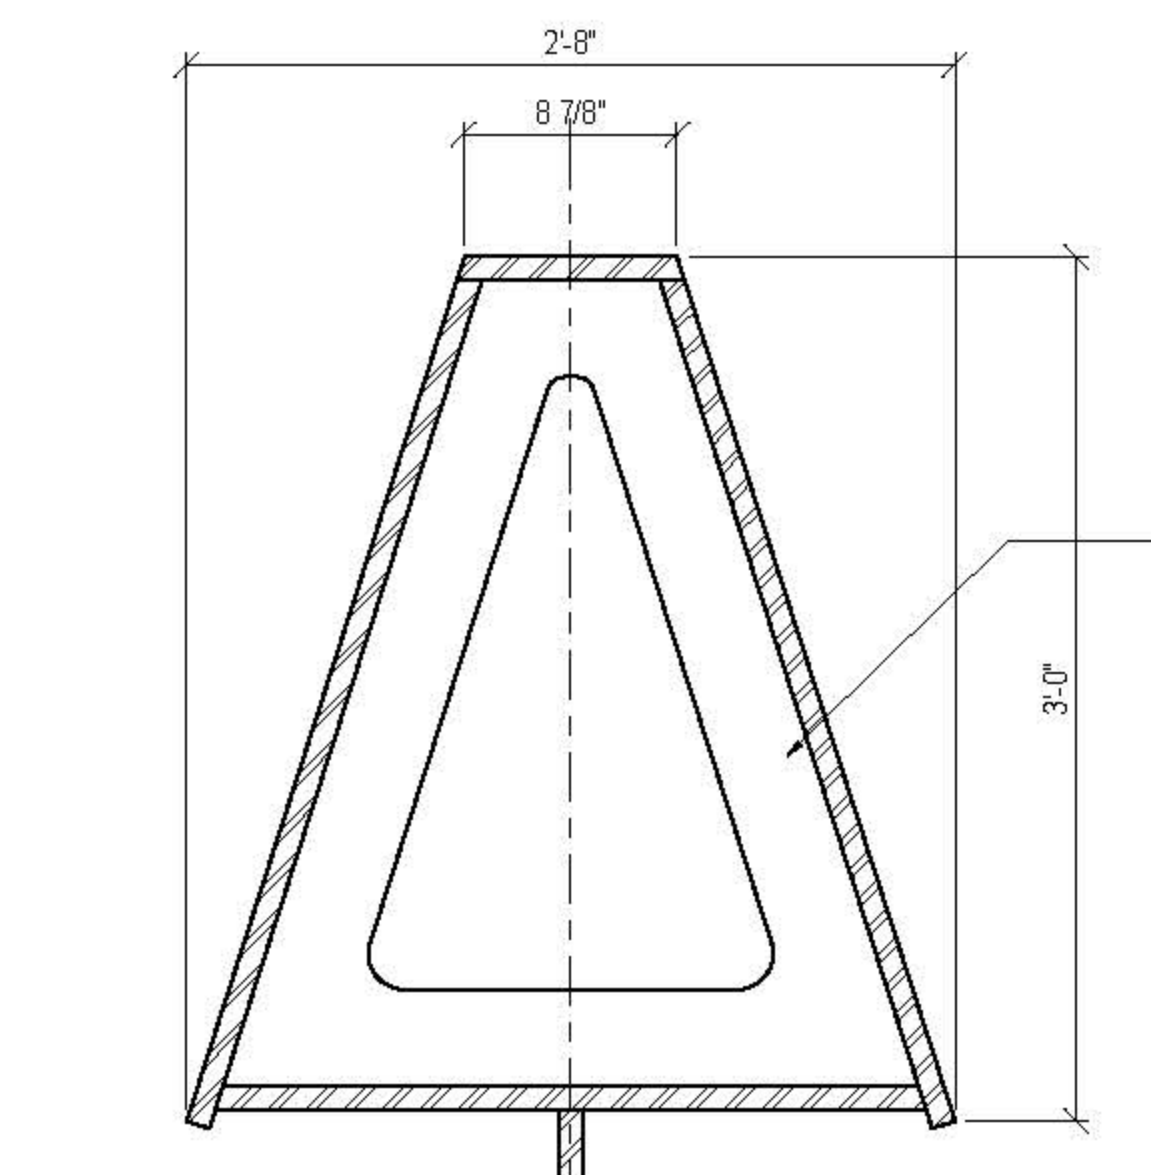

3 SECTION B-B-TYPICAL VERTICAL SECTION AT DIAPHRAGM
1 1/2" = 1'-0"


MECHANICAL DUCTWORK REFER TO S-786

MECHANICAL DUCTWORK REFER TO S-786

4"x3/8" PLATE DIAPHRAGM
DIAPHRAGMS SHOWN INDICATIVELY FOR FABRICATION. FABRICATOR TO PROPOSE DETAIL AND SPACING (TYP 8" C/C)

NOTES: REFER TO DRAWING S-751 FOR TYPICAL PLATE THICKNESSES NORTH WALL SIMILAR REFER TO S-753 & S-754 FOR WELD DETAILS

PENDING COORDINATION DURING DESIGN ASSIST. SUBJECT TO FINAL FORCES AND PLATE THICKNESSES TBD

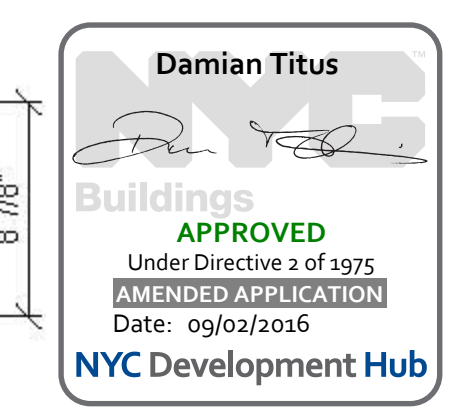

GEOMETRY, DIMENSIONS AND SURFACE CONTOURING, BLENDING AND INTERSECTION OF SECTIONS ILLUSTRATED IN THE STRUCTURAL DRAWINGS ARE PROVIDED FOR REFERENCE AND GENERATION OF STRUCTURAL ARRANGEMENT AND DETAILS ONLY. THE 3D MODEL ISSUED BY THE ARCHITECT DEFINES THE EXTERIOR SURFACE AND SHALL BE ADHERED TO FOR THE FINAL GEOMETRY. FOR DETAILS OF SECONDARY STEEL, INCLUDING STRUCTURAL CLADDING REFER TO ARCHITECTURE DRAWINGS. IT IS THE RESPONSIBILITY OF THE CONTRACTOR TO IDENTIFY ANY DISCREPANCIES OR AMBIGUITIES FOR DISCUSSION, RESOLUTION AND DIRECTION FROM THE ARCHITECT AND SER.

THE GEOMETRY CREATED BY THE INTERSECTING ELEMENTS SHALL BE IN ACCORDANCE WITH THE 3D MODEL. THE LEVEL OF QUALITY IS TO BE SIMILAR TO THE COMMISSIONED MOCK-UP FOR THE TYPICAL NODE. THE GENERAL CONCEPT IS THAT EDGES FLOW SMOOTHLY AND CONTINUOUSLY BETWEEN THE EDGE OF THE ELEMENT TO THE CORRESPONDING EDGE OF THE ADJACENT ELEMENT AND THE INTERLYING SURFACES BETWEEN THESE EDGES ARE BLENDED AND CONTOURED TO DEFINE A SMOOTH, UNINTERRUPTED TRANSITION.

NOTE: TONNAGES ARE PROVIDED BASED ON THE MINIMUM PLATE THICKNESSES SHOWN IN S-751 INTERSECTING AT NODES. THIS DRAWING REPRESENTS A PROPOSAL TO AID FABRICATION TO PROVIDE A UNIFORM THICKNESS THROUGH ANY GIVEN NODE FOR DIAGONALS AND VERTICALS RESPECTIVELY. A UNIFORM PLATE THICKNESS THROUGH THE ENTIRE NODE MAY BE PROPOSED BY THE FABRICATOR SUBJECT TO APPROVAL BY ARCHITECT AND SER.

ARCHITECTS
Oiler Scudiero + Renfro Architects, DPC
601 West 26 Street #815
New York, New York 10001
T: 212.260.7971

STRUCTURAL ENGINEER
Thornton Tomasetti
51 Madison Avenue
New York, New York 10010
T: 917.861.7800
F: 917.861.7801

MEP ENGINEER
Jawa Baum & Bolles
60 Pine Street
New York, New York 10005
T: 212.530.9300
F: 212.266.6944

FACADE CONSULTANT
Thornton Tomasetti
51 Madison Avenue
New York, New York 10010
T: 917.861.7800
F: 917.861.7801

KINETICS ENGINEER
Hardisty & Hanover
1501 Broadway
New York, New York 10036
T: 212.944.1150
F: 212.391.0397

LIGHTING DESIGNER
Tilston Design Associates
40 North Street #160
New York, New York 10013
T: 212.675.7760

THEATRE PLANNING & DESIGN
Fisher Dodge Associates
22 West 15th Street
New York, New York 10011
T: 212.691.3000

LIFE SAFETY
Code Consultants, Inc.
215 West 43rd St, 15th Fl.
New York, New York 10018
T: 212.216.9596

ENERGY MODEL AEEED
Vindian
60 Washington Street
Norwalk, CT 06854
T: 203.298.1411

ACOUSTIC/AUDIO-VISUAL
Anaville
93 North Main Street
South Norwalk, CT 06854
T: 347.210.5540

VERTICAL TRANSPORTATION
Van Duunen & Associates
5 Regent Street, Suite 524
Lakewood, NJ 07038
T: 973.994.9220

SPECIFICATIONS
Construction Specifications Inc.
PO Box 489
227 Tenth Road
Morganville, NJ 07751
T: 732.970.0700
F: 732.970.0750


SECURITY
Duchella Venter & Santoro
1100 Sherman Avenue
Hartford, CT 06114
T: 203.286.6490

WATERPROOFING
James R. Galford AIA Consulting Architects PC
104 West 27th Street
New York, NY 10001
T: 212.736.3344

FACADE MAINTENANCE
Erick Engineering PLLC
186 Arden Street
New York, NY 10005
T: 212.698.3000

BRANDING GRAPHICS
2nd Global Design Consultancy
180 Varck Street 15th Floor
New York, NY 10014
T: 212.647.1170

KEY PLAN

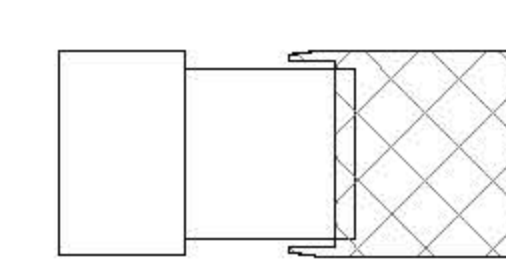

ISSUE

ISSUE	PRINTING	DATE
01	01	08/19/2016
02	02	08/23/2016
03	03	08/23/2016
04	04	08/23/2016
90	90	08/23/2016

STAMP



DRAWN BY
Autism

CHECKED BY
Chris

PROJECT NUMBER
N11318.00

TITLE
TYPICAL WALL PLATE THICKNESSES II

DRAWING NO.
S-752.01

B-SCAN NO.

S-752.01

90 of 123

PENDING COORDINATION DURING DESIGN ASSIST. SUBJECT TO FINAL FORCES AND PLATE THICKNESSES TBD

90 of 123

90 of 123


90 of 123

90 of 123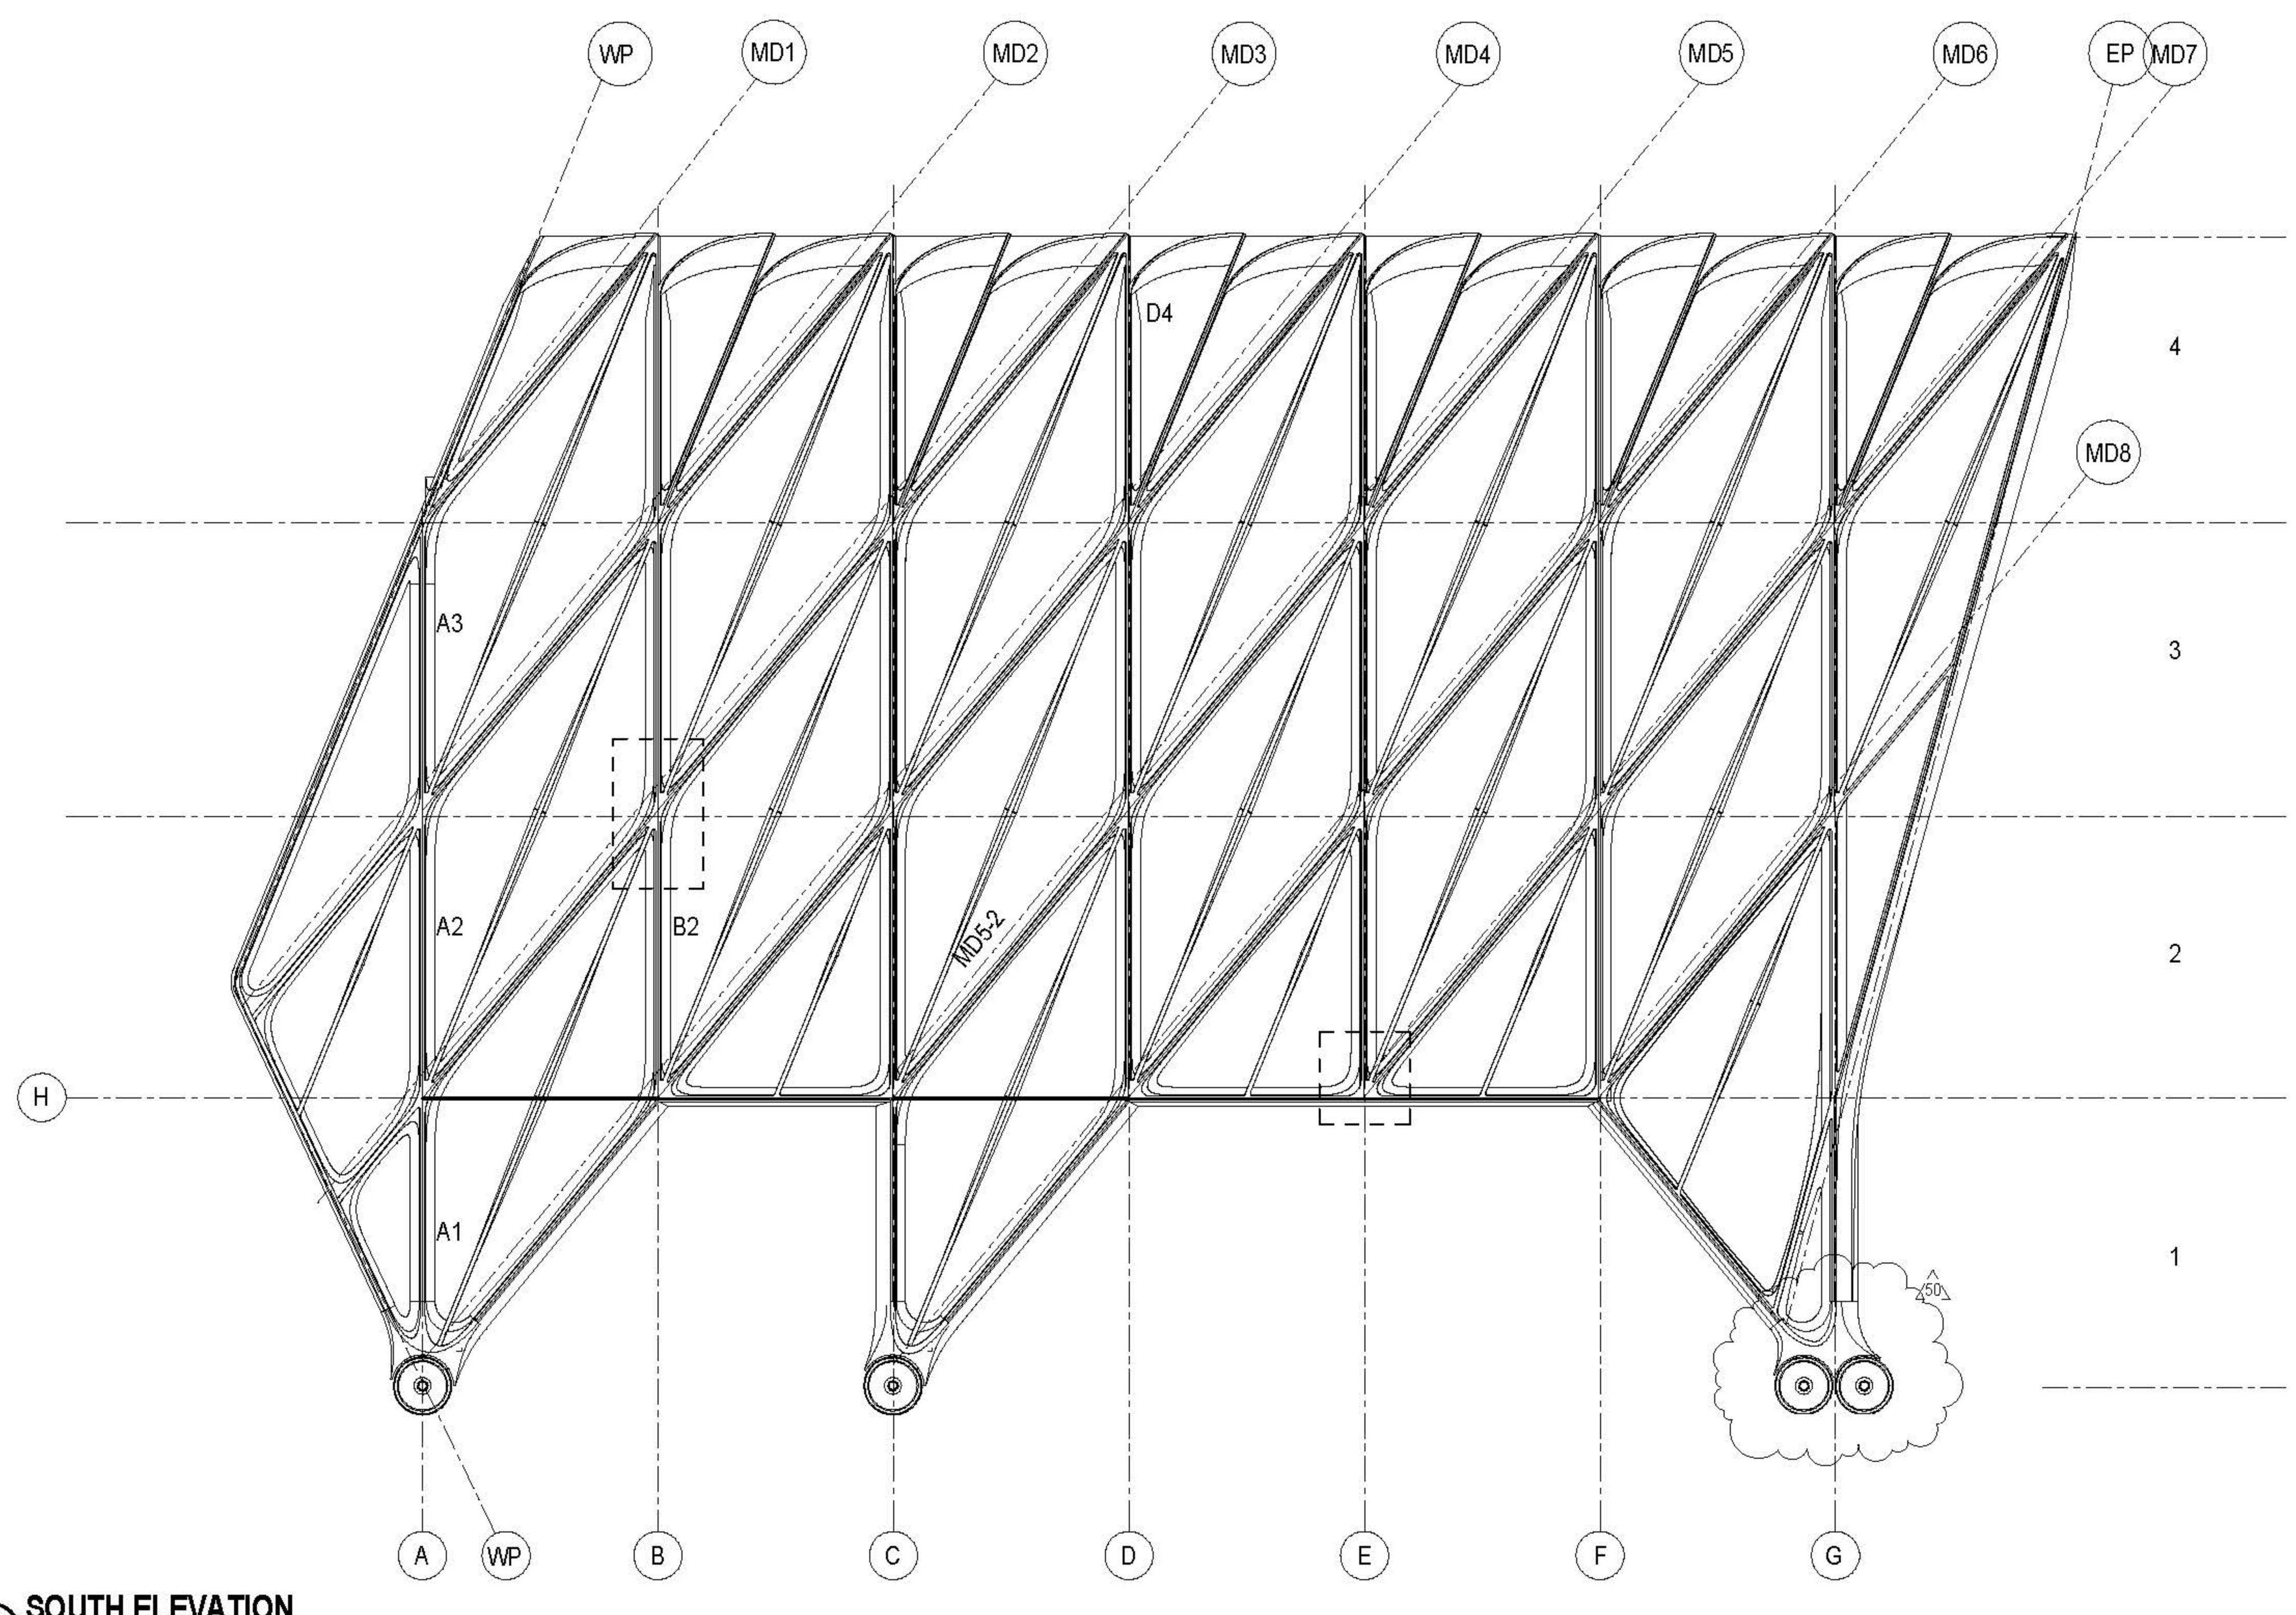


1 SOUTH ELEVATION
3/32" = 1'-0"

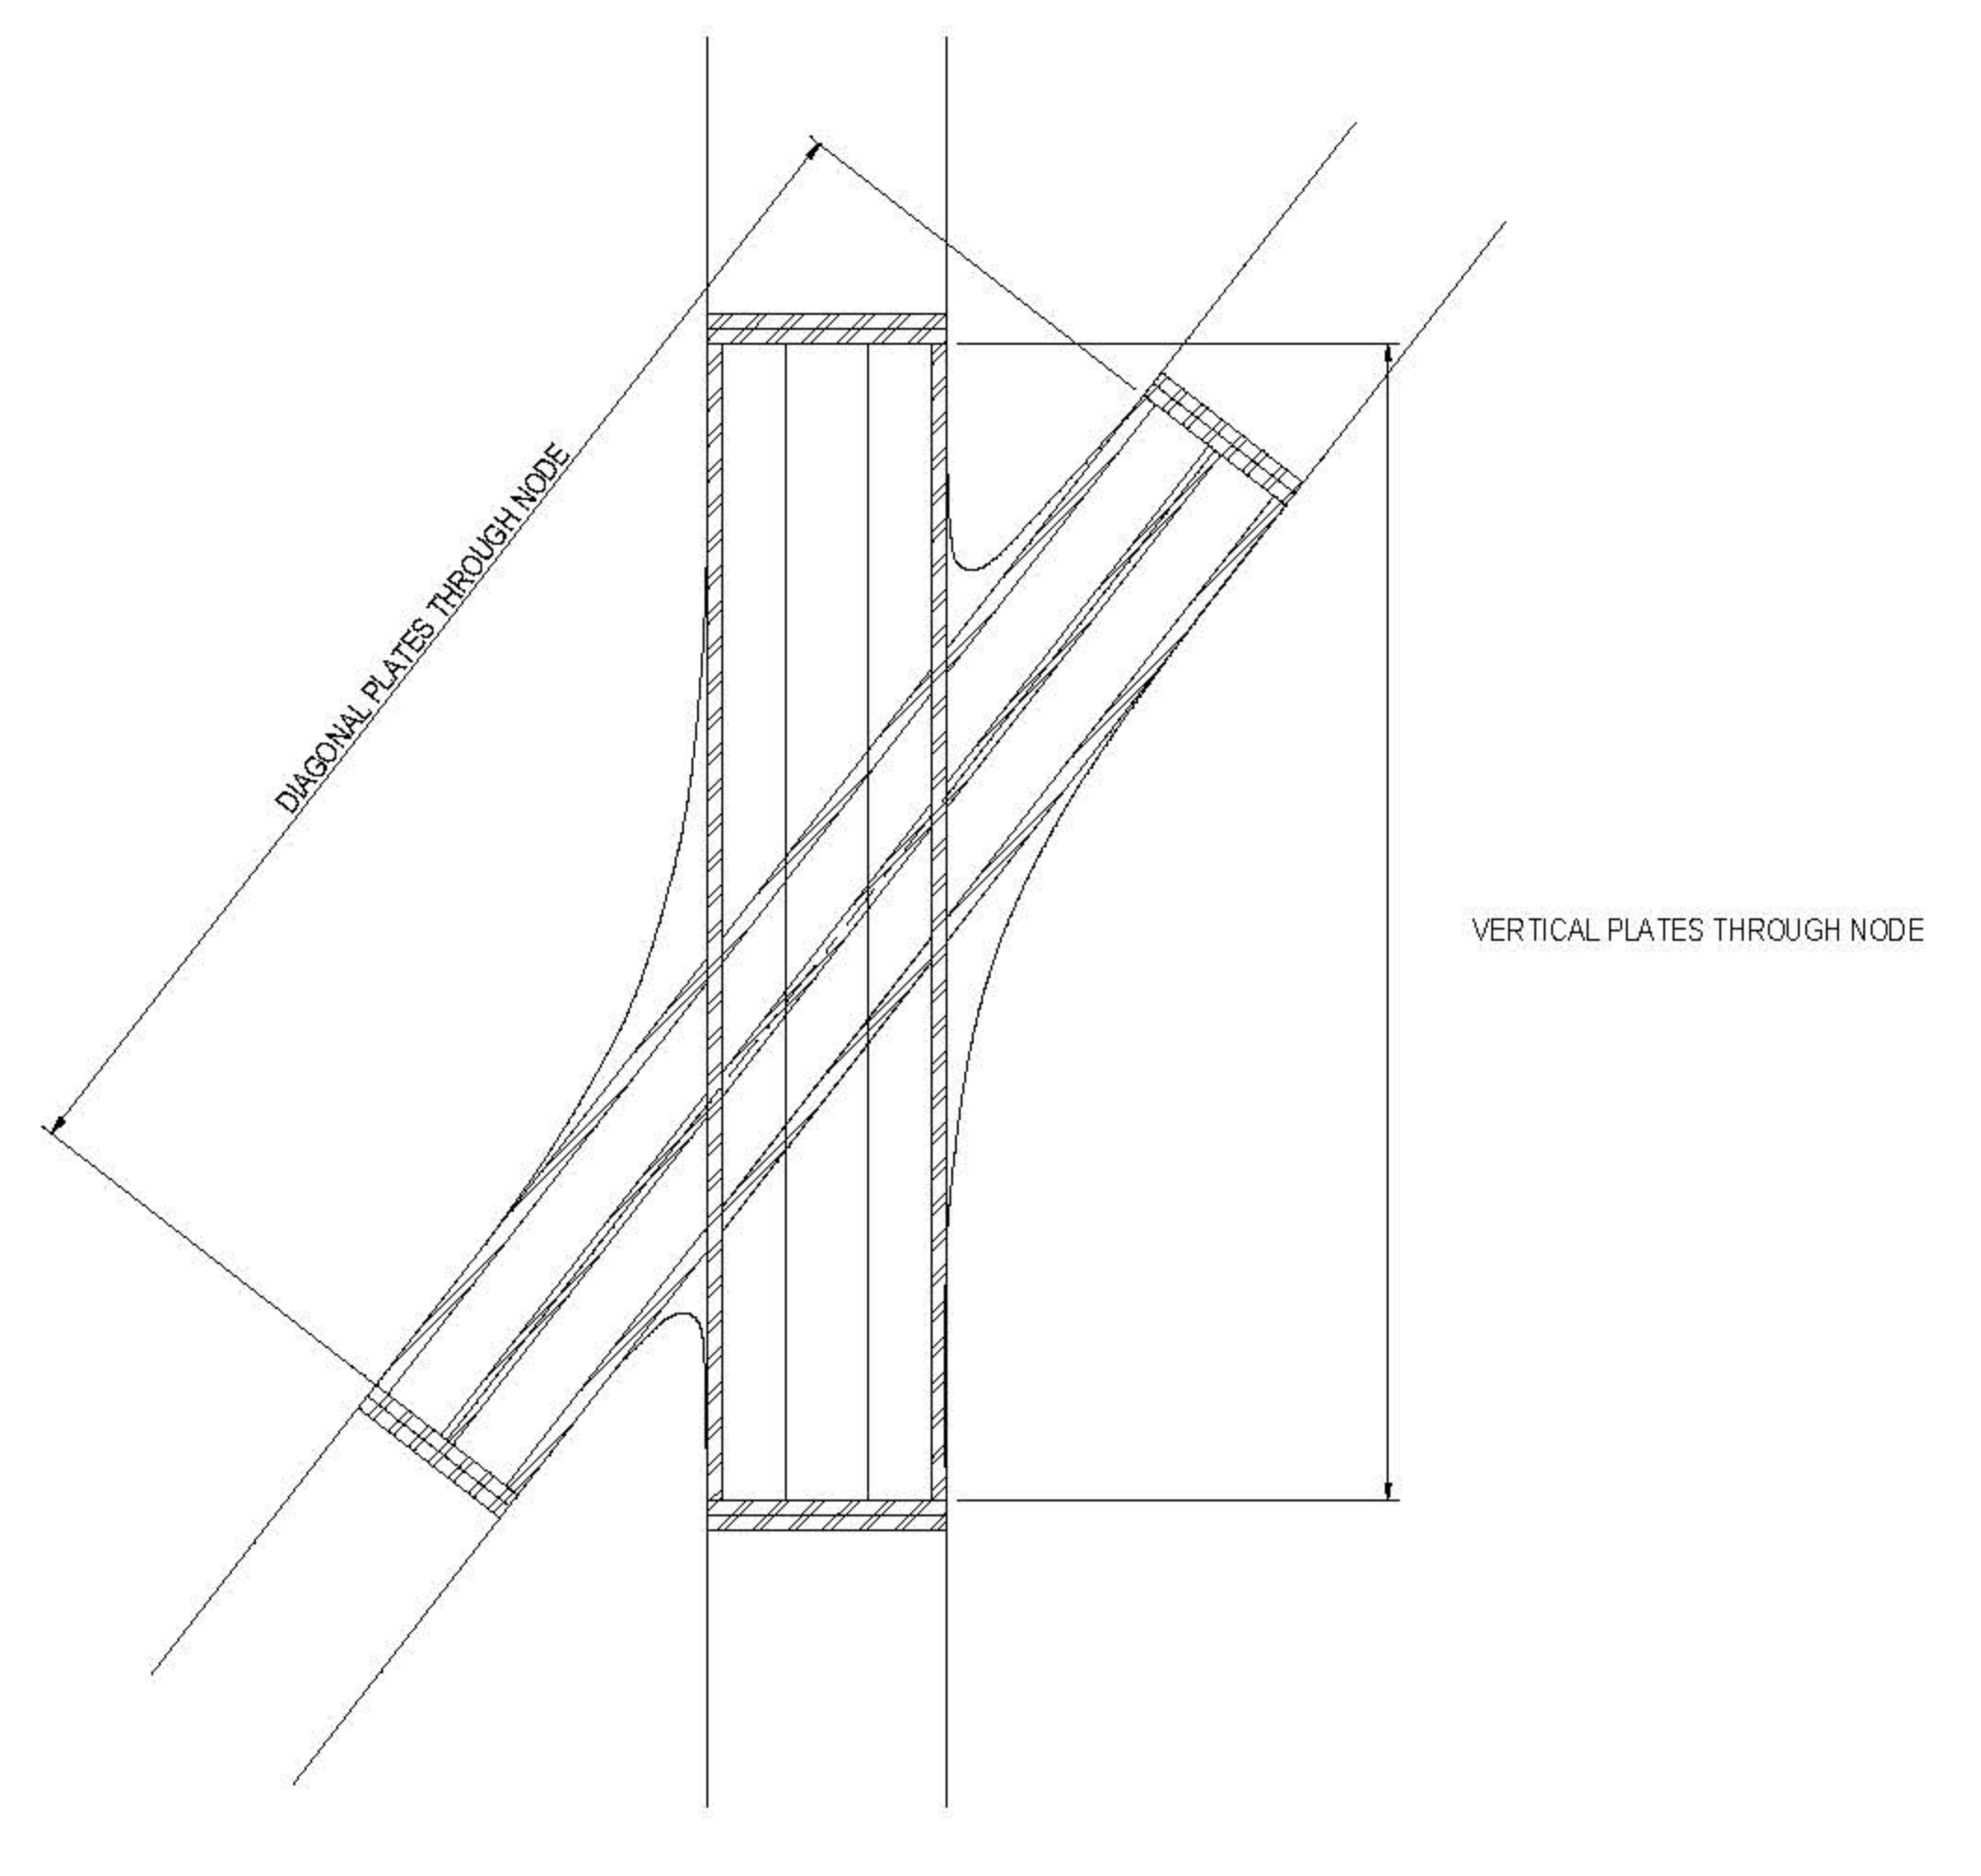

2 TYPICAL NODE SECTION
1/2" = 1'-0"

NOTE: THE GEOMETRY CREATED BY THE INTERSECTING MAIN VERTICALS AND DIAGONALS SHALL BE IN ACCORDANCE WITH THE 3D MODEL AND FOLLOW, AS A MINIMUM, THE QUALITY EXHIBITED IN THE COMMISSIONED MOCK-UP. THE GENERAL CONCEPT IS THAT EDGES FLOW SMOOTHLY AND CONTINUOUSLY BETWEEN THE STRAIGHT EDGE OF A DIAGONAL THROUGH A CURVE TO THE ADJACENT EDGE OF VERTICAL AND THE INTERLYING SURFACE BETWEEN THESE EDGES ARE BLENDED AND CONTOURED TO DEFINE A SMOOTH, UNINTERRUPTED TRANSITION.

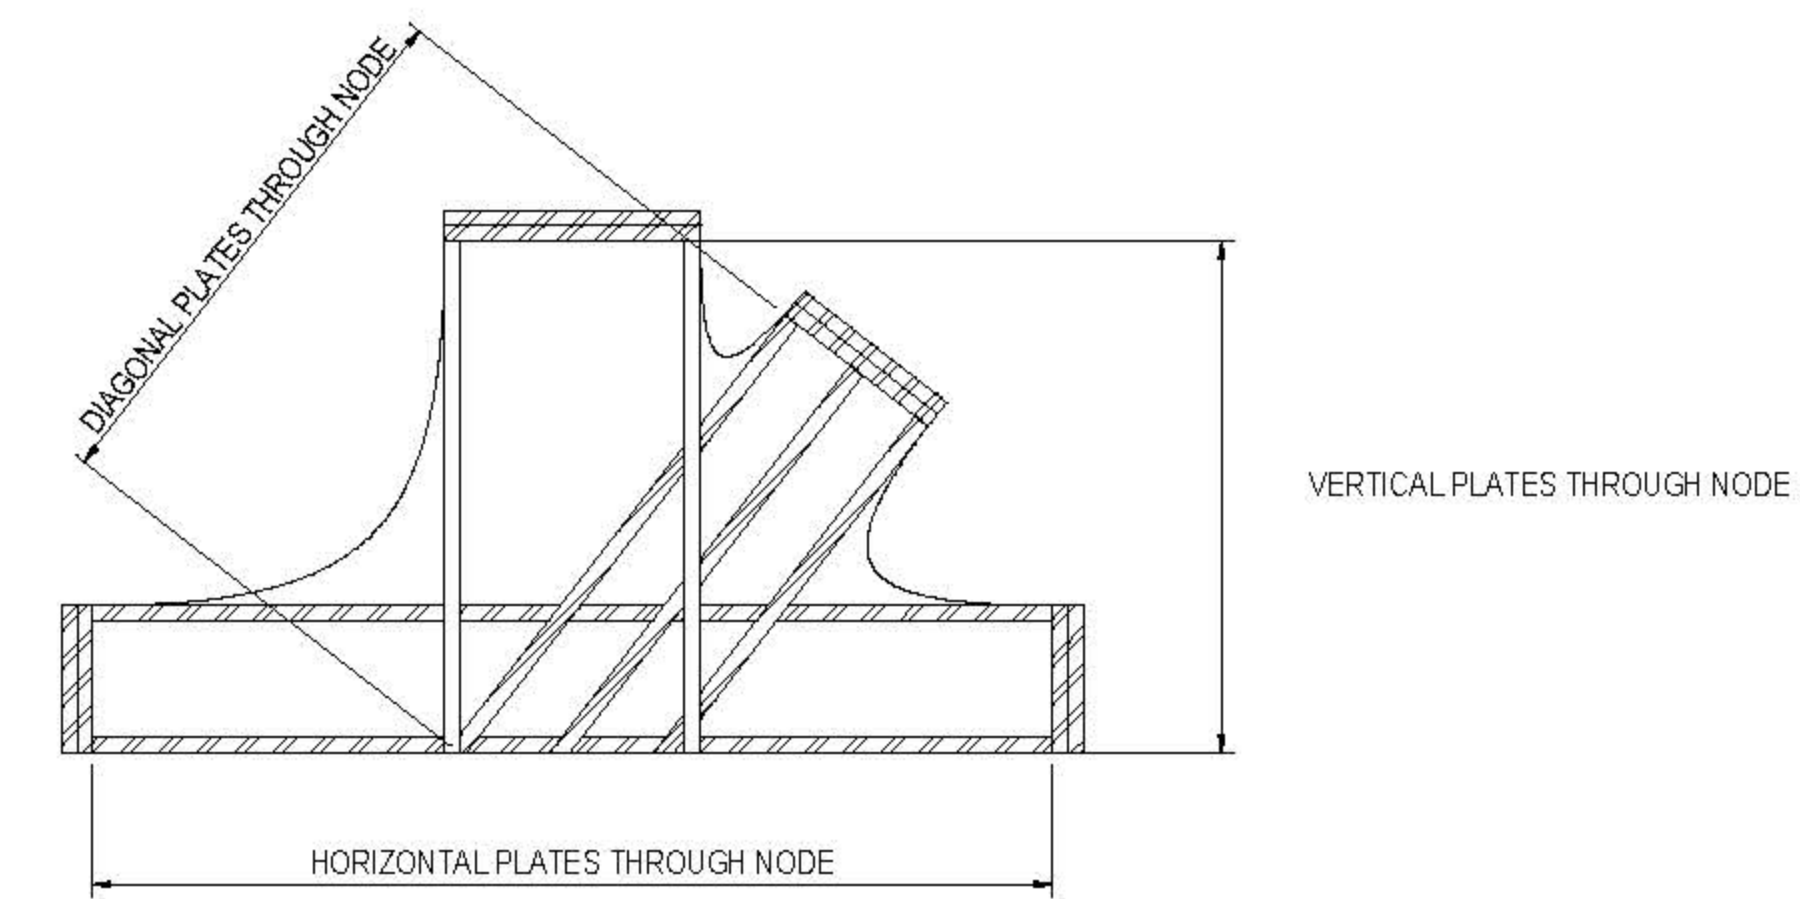


3 HEADER NODE SECTION
1/2" = 1'-0"


NODE INTERSECTION		VERTICAL PLATES THROUGH NODE*	DIAGONAL PLATES THROUGH NODE*	HORIZONTAL PLATES THROUGH NODE*
VERTICAL	DIAGONAL			
WP	WP	1/2"	1/2"	
A	MD1	3/4"	3/4"	
A	MD2	3/4"	3/4"	
A	MD3	3/4"	3/4"	
B	MD2	3/4"	3/4"	
B	MD3	3/4"	1"	
B	MD4	3/4"	3/4"	3/4"
C	MD3	1 1/2"	1"	
C	MD4	1 1/2"	1 1/4"	
C	MD5	2"	2"	2"
D	MD4	1"	1 1/4"	
D	MD5	1"	2"	
D	MD6	1"	2 1/4"	1"
E	MD5	5/8"	5/8"	
E	MD6	5/8"	1/2"	
E	MD7	5/8"	5/8"	3/4"
F	MD6	5/8"	5/8"	
F	MD7	5/8"	1"	
F	MD8	1"	1"	1"
G	MD7	1 1/2"	1"	
G	MD8	1 1/2"	1"	

3 NODE PLATE THICKNESSES
1/16" = 1'-0"

*FOR COMMON SURFACES THE LARGER THICKNESS IS TO BE ADOPTED

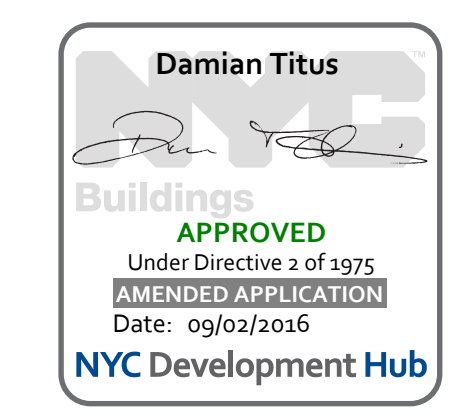


PENDING COORDINATION DURING DESIGN ASSIST. SUBJECT TO FINAL FORCES AND PLATE THICKNESSES TBD

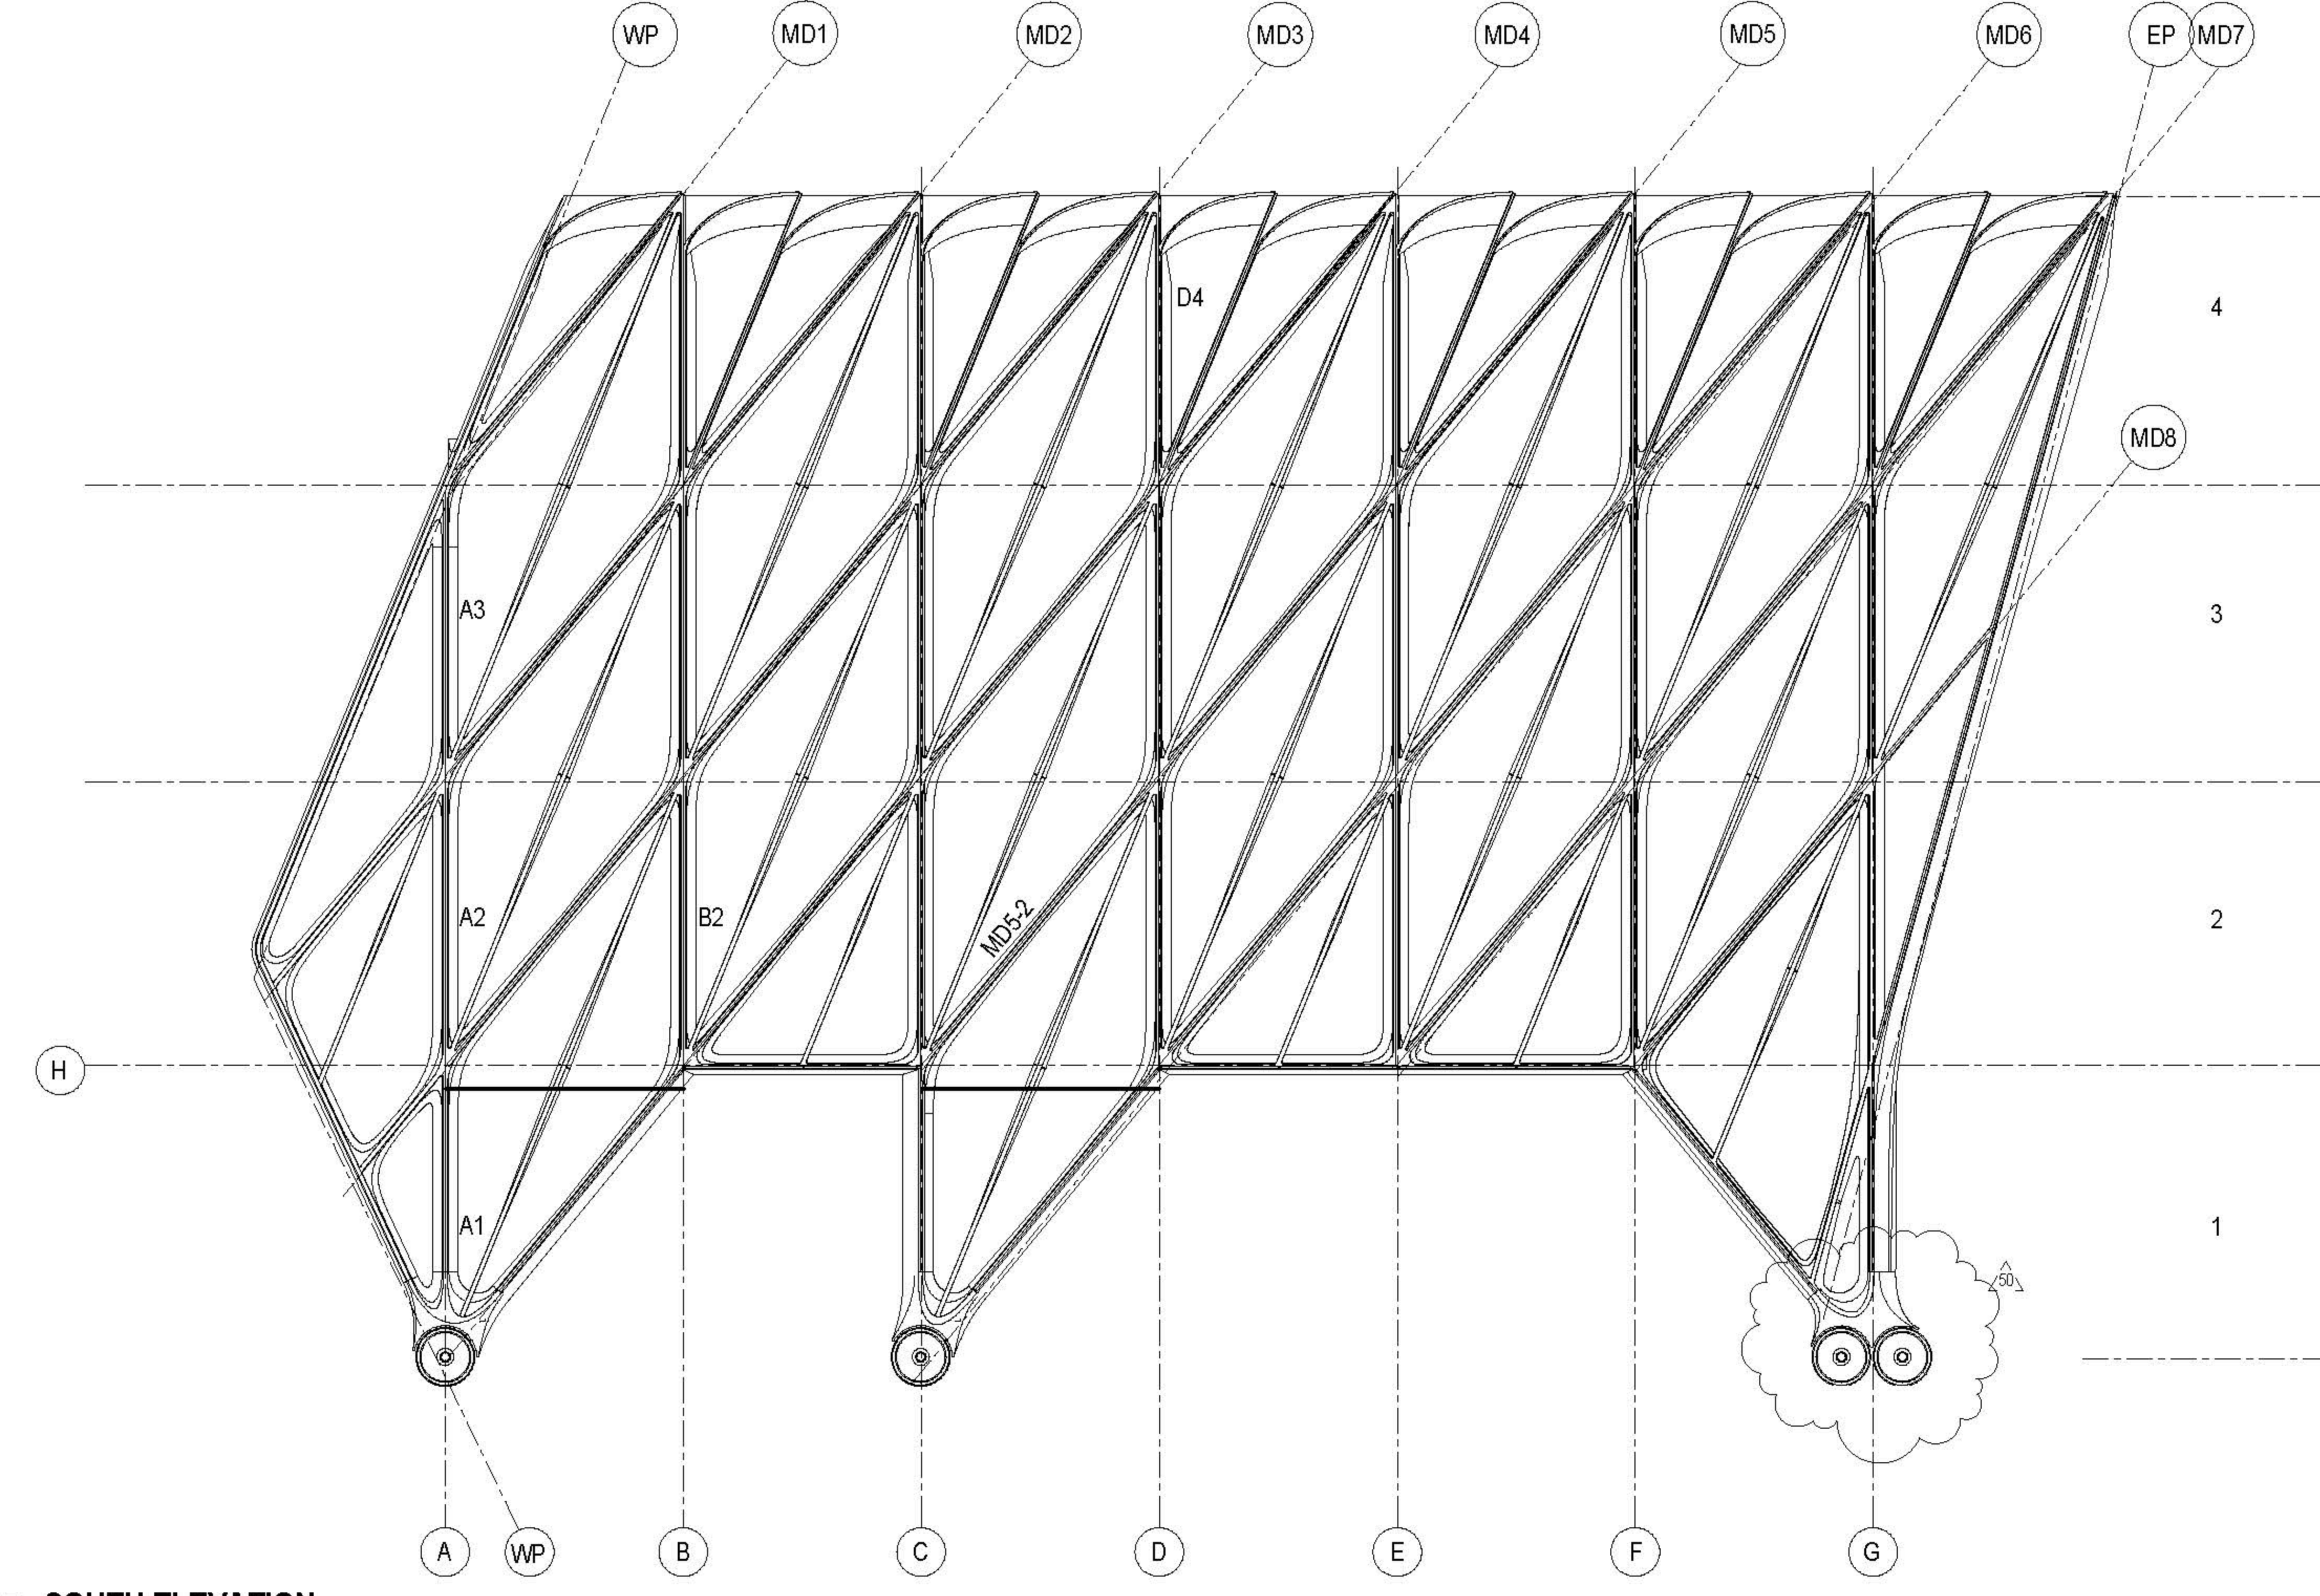

1 SOUTH ELEVATION
3/32" = 1'-0"


ELEMENT	EFFECTIVE THROAT SIZE	
	WELD A	WELD B
A1	5/16"	5/16"
A2	5/16"	5/16"
A3	5/16"	5/16"
B2	5/16"	5/16"
B3	5/16"	5/16"
B4	5/16"	5/16"
C1	3/8"	3/8"
C2	5/16"	5/16"
C3	5/16"	5/16"
C4	3/8"	7/16"
D2	5/16"	5/16"
D3	5/16"	5/16"
D4	5/16"	5/16"
E2	5/16"	5/16"
E3	5/16"	5/16"
E4	5/16"	5/16"
F2	5/16"	5/16"
F3	5/16"	5/16"
F4	5/16"	5/16"
G2	3/8"	3/8"
G3	5/16"	5/16"
G4	7/16"	1/2"

8 WELD SIZES
1/16" = 1'-0"

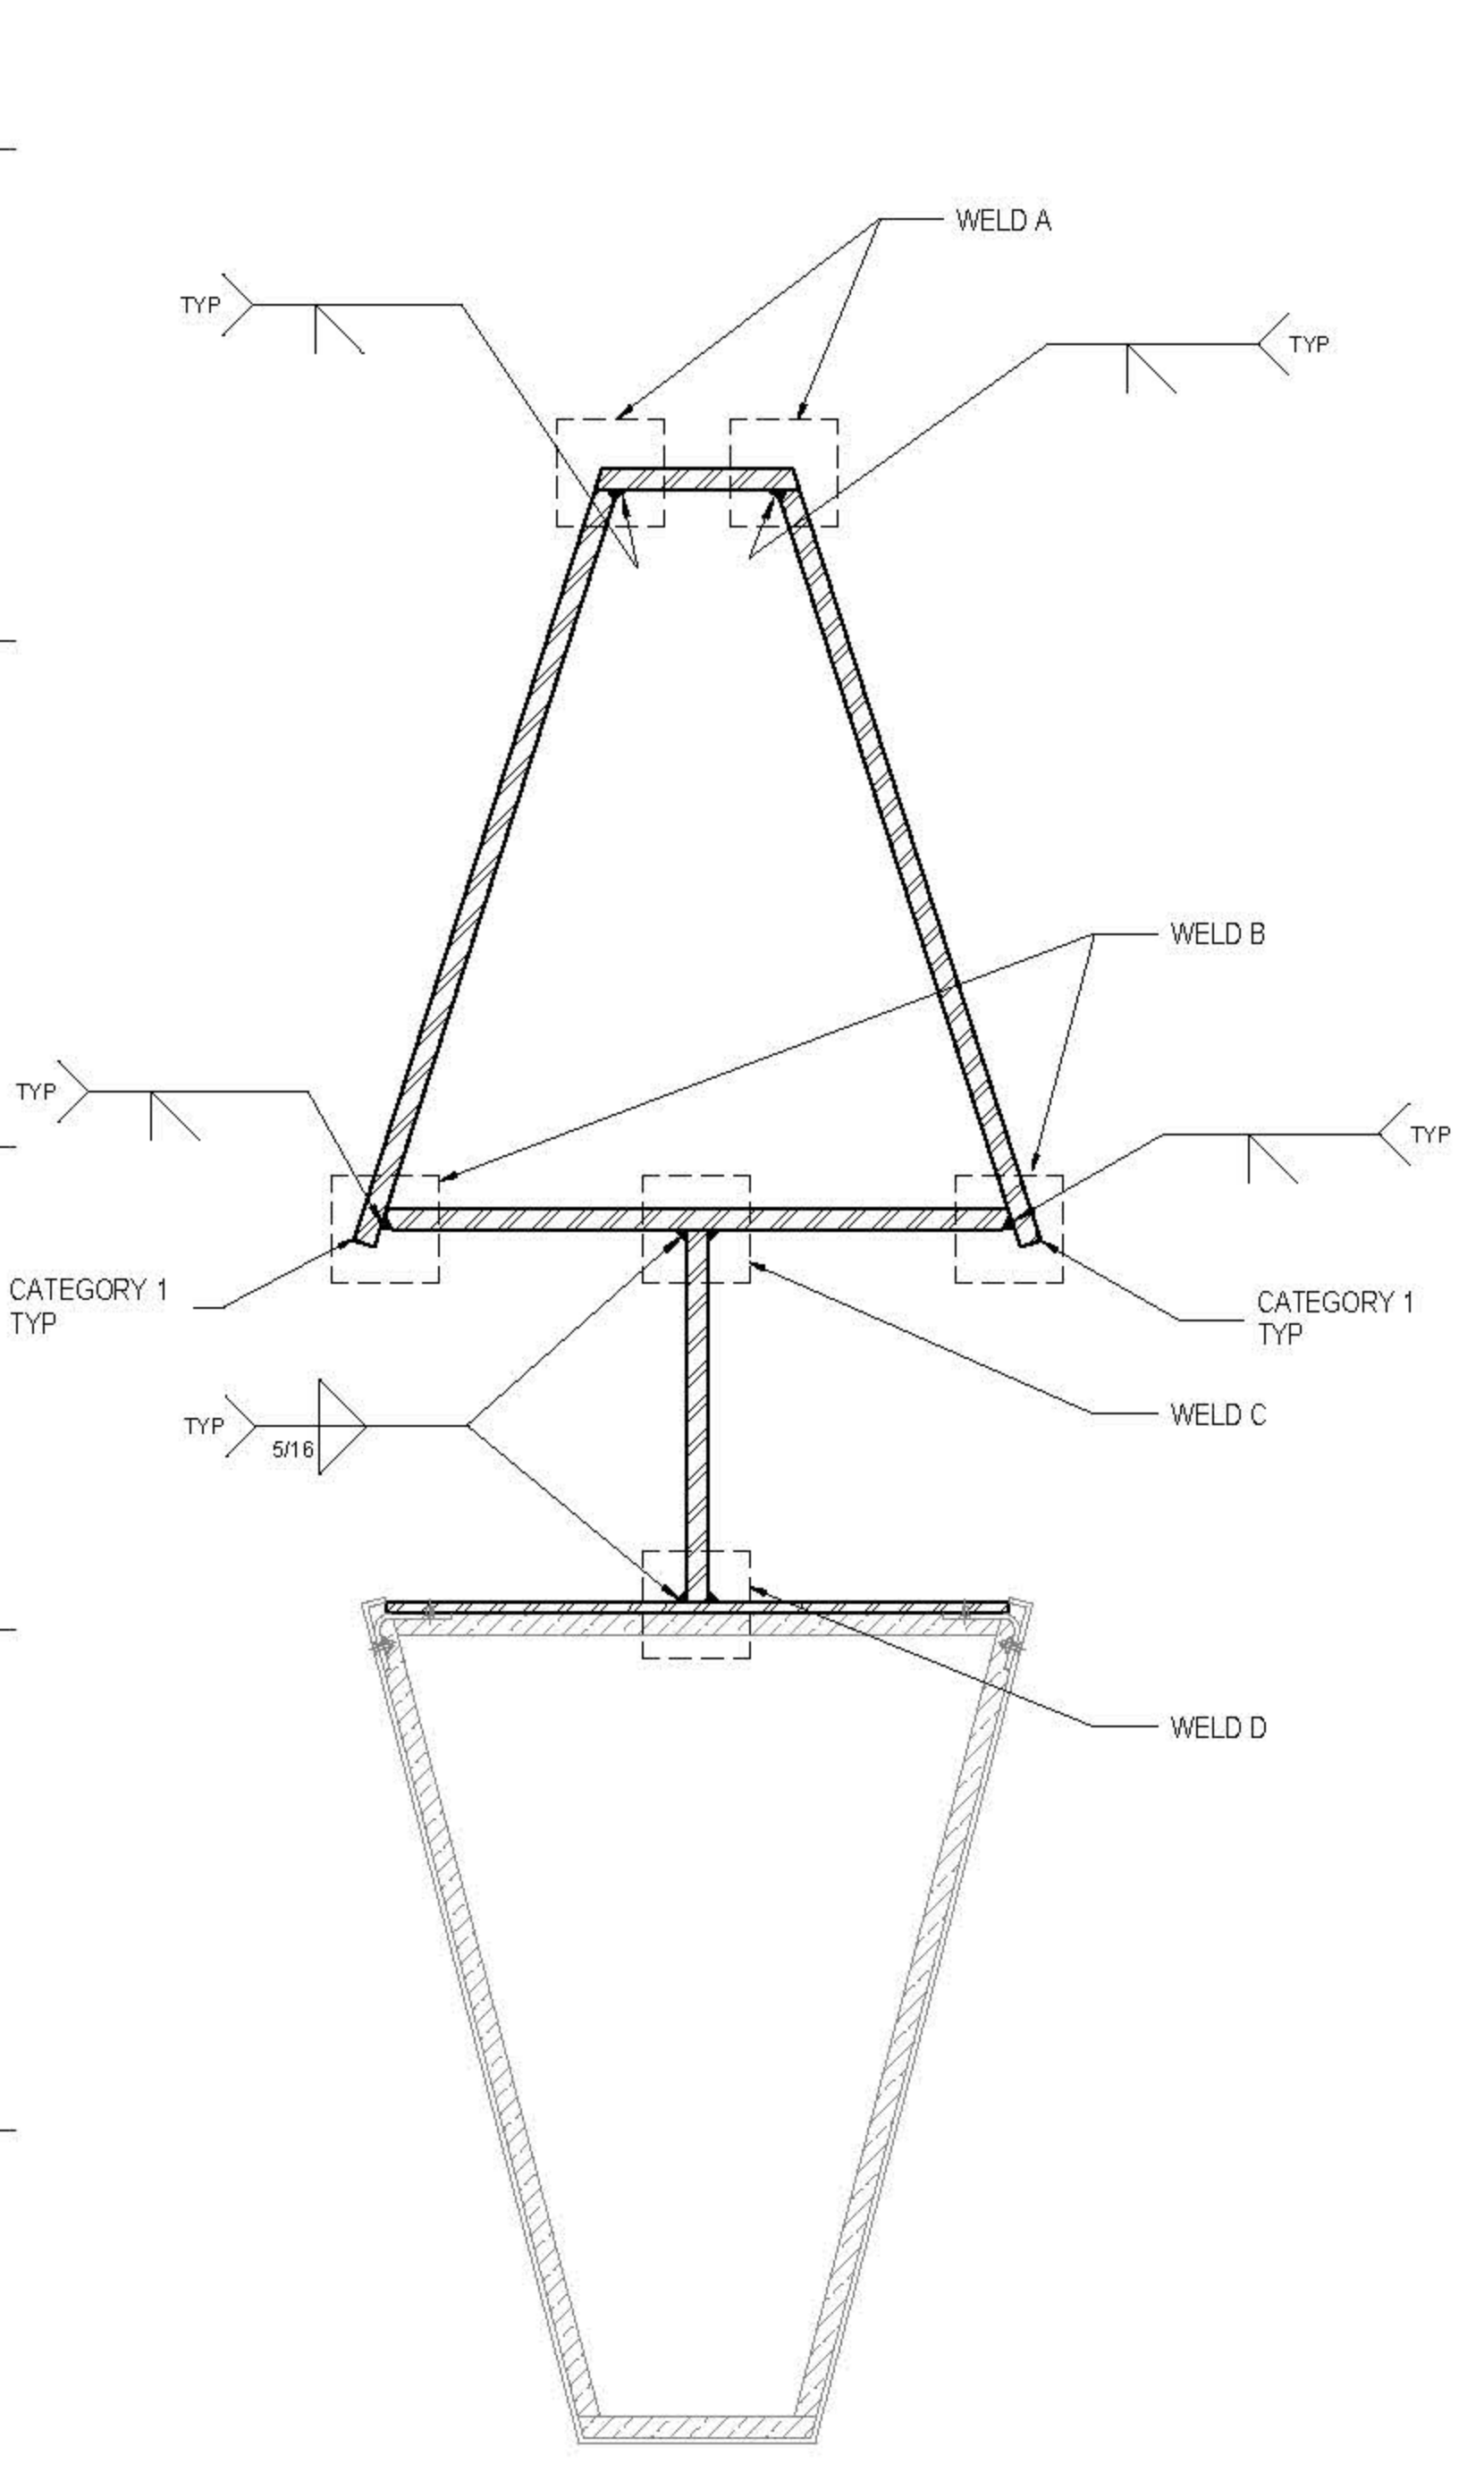


2 TYPICAL SECTION
1/16" = 1'-0"

CATEGORY 1 CORNERS: ALL CORNERS MARKED CATEGORY 1 TO HAVE A SHARP, CONTINUOUS EDGE WITH STRAIGHTNESS TO WITHIN +/- 1/16". ALL CORNERS MAY HAVE A 0.08" RADIUS. FOR NODE WELD DETAILS SEE DRAWING S-755.

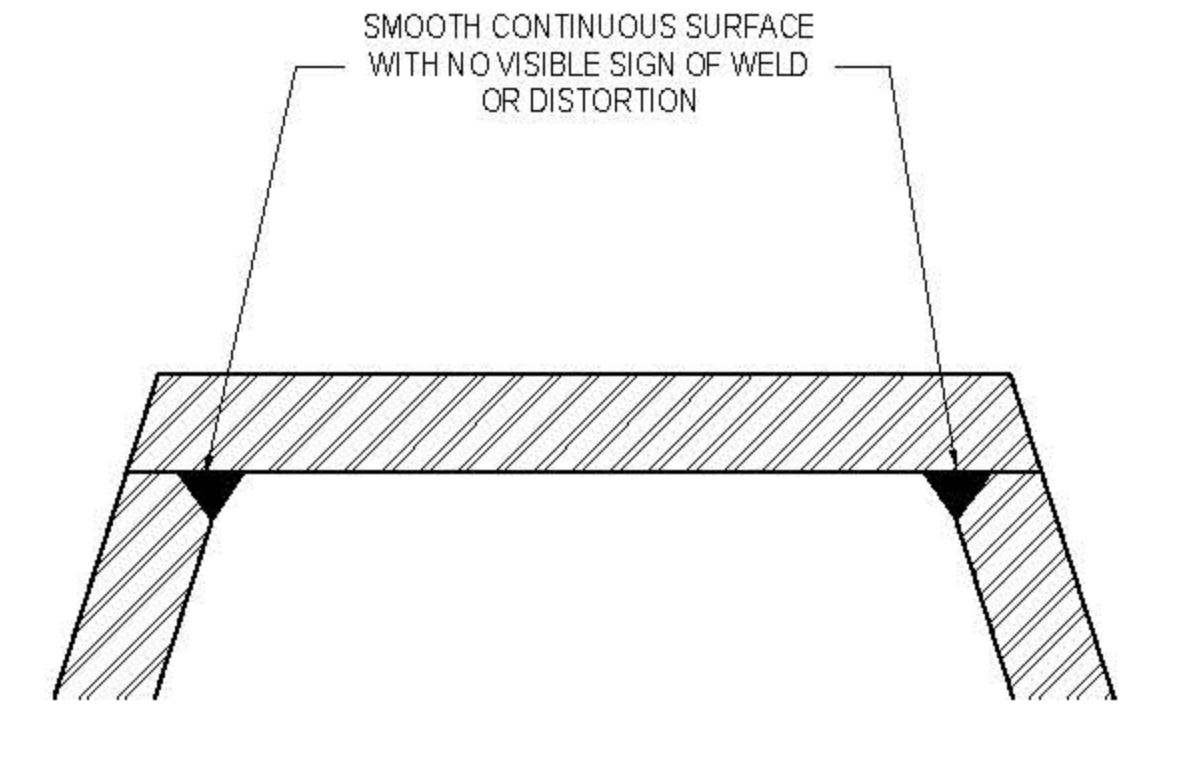


3 WELD A DETAIL
6" = 1'-0"

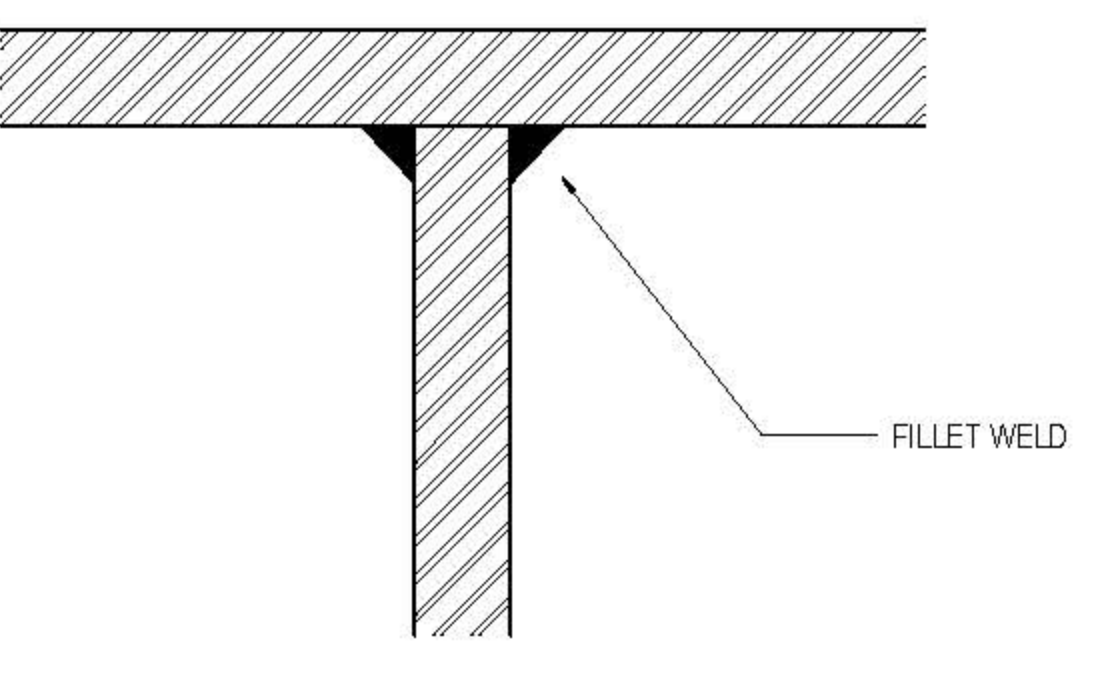


5 WELD C DETAIL
6" = 1'-0"

7 WELD SIZE REFERENCE
3/8" = 1'-0"

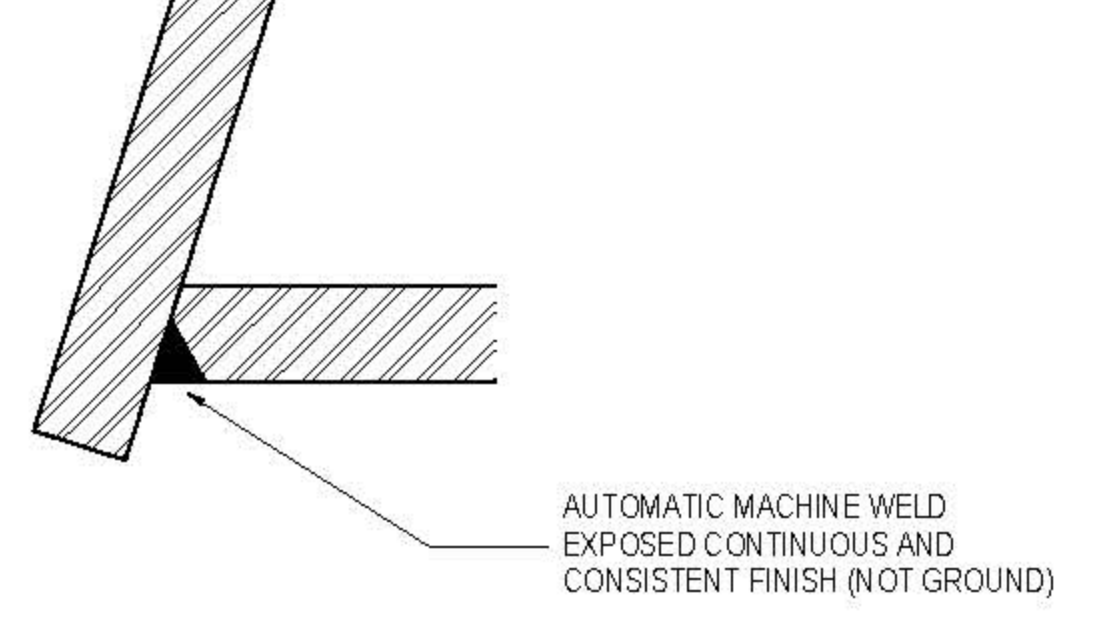

4 WELD B DETAIL
6" = 1'-0"

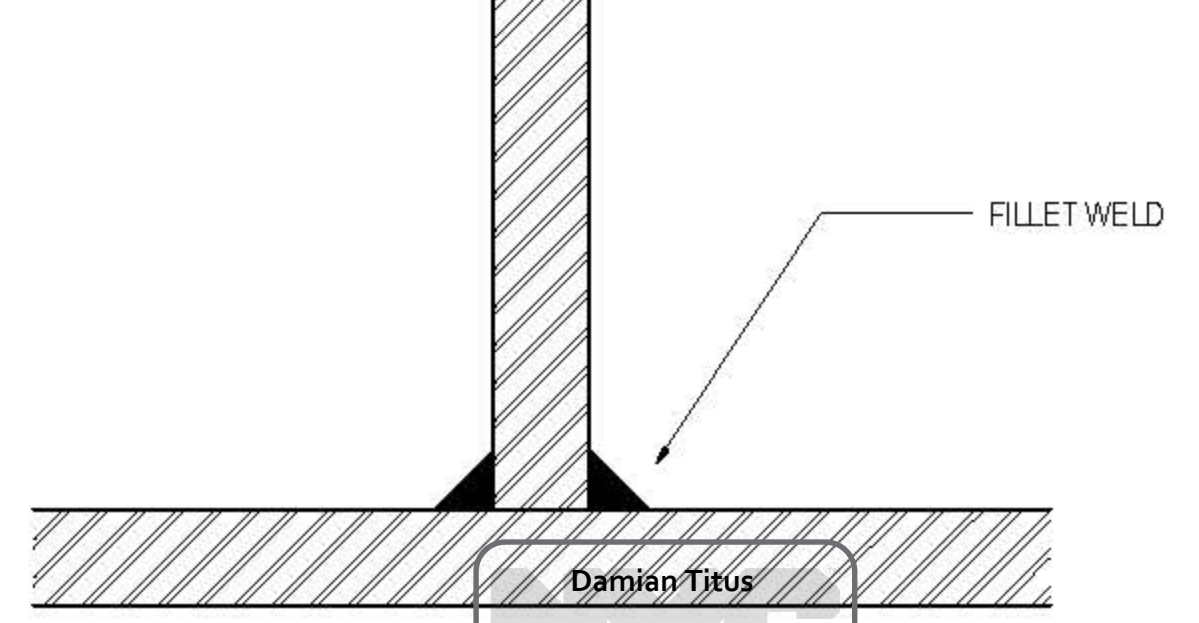


6 TYPICAL SECTION
6" = 1'-0"

NOTE: ALL VERTICAL ELEMENTS SIMILAR U.O.N.

PENDING COORDINATION DURING DESIGN ASSIST. SUBJECT TO FINAL FORCES AND PLATE THICKNESSES TBD.

KEY PLAN

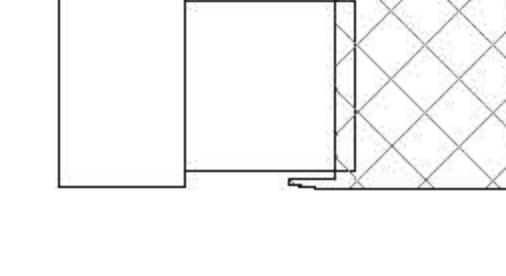

ISSUE

NO.	DESCRIPTION	DATE
03	60 DOB AMENDMENT 7	03/19/2016
44	30 DOB AMENDMENT 6	04/02/2016
21	CONSTRUCTION SET	10/08/2015
10	4 100% CONSTRUCTION DOCUMENTS	03/18/2015
9	90% CONSTRUCTION DOCUMENTS	02/16/2015
6	PRELIMINARY DOB SUBMISSION	12/10/2014
1	ADVANCED PROCUREMENT BID SET	06/16/2014

STAMP



DRAWN BY
Autism

CHECKED BY
Chris


PROJECT NUMBER
N11318.00

TITLE
MAIN VERTICAL WELD DETAILS

DRAWING NO.
S-753.01

B.SCAN NO.
S-753.01


91 of 123

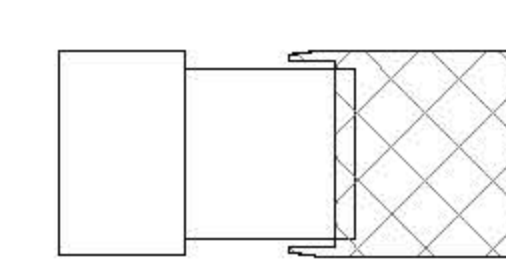


63	60	DOB AMENDMENT 7	03.19.2016
44	30	DOB AMENDMENT 6	04.09.2016
21		CONSTRUCTION SET	10.09.2015
10	4	100% CONSTRUCTION DOCUMENTS	03.18.2015
9		90% CONSTRUCTION DOCUMENTS	02.16.2015
6		PRELIMINARY DOB SUBMISSION	12.10.2014
1		ADVANCED PROCUREMENT BID SET	06.16.2014



GEOMETRY, DIMENSIONS AND SURFACE CONTOURING, BLENDING AND INTERSECTION OF SECTIONS ILLUSTRATED IN THE STRUCTURAL DRAWINGS ARE PROVIDED FOR REFERENCE AND GENERATION OF STRUCTURAL ARRANGEMENT AND DETAILS ONLY. THE 3D MODEL ISSUED BY THE ARCHITECT DEFINES THE EXTERIOR SURFACE AND SHALL BE ADHERED TO FOR THE FINAL GEOMETRY. FOR DETAILS OF SECONDARY STEEL, INCLUDING STRUCTURAL CLADDING REFER TO ARCHITECTURE DRAWINGS. IT IS THE RESPONSIBILITY OF THE CONTRACTOR TO IDENTIFY ANY DISCREPANCIES OR AMBIGUITIES FOR DISCUSSION, RESOLUTION AND DIRECTION FROM THE ARCHITECT AND SER.

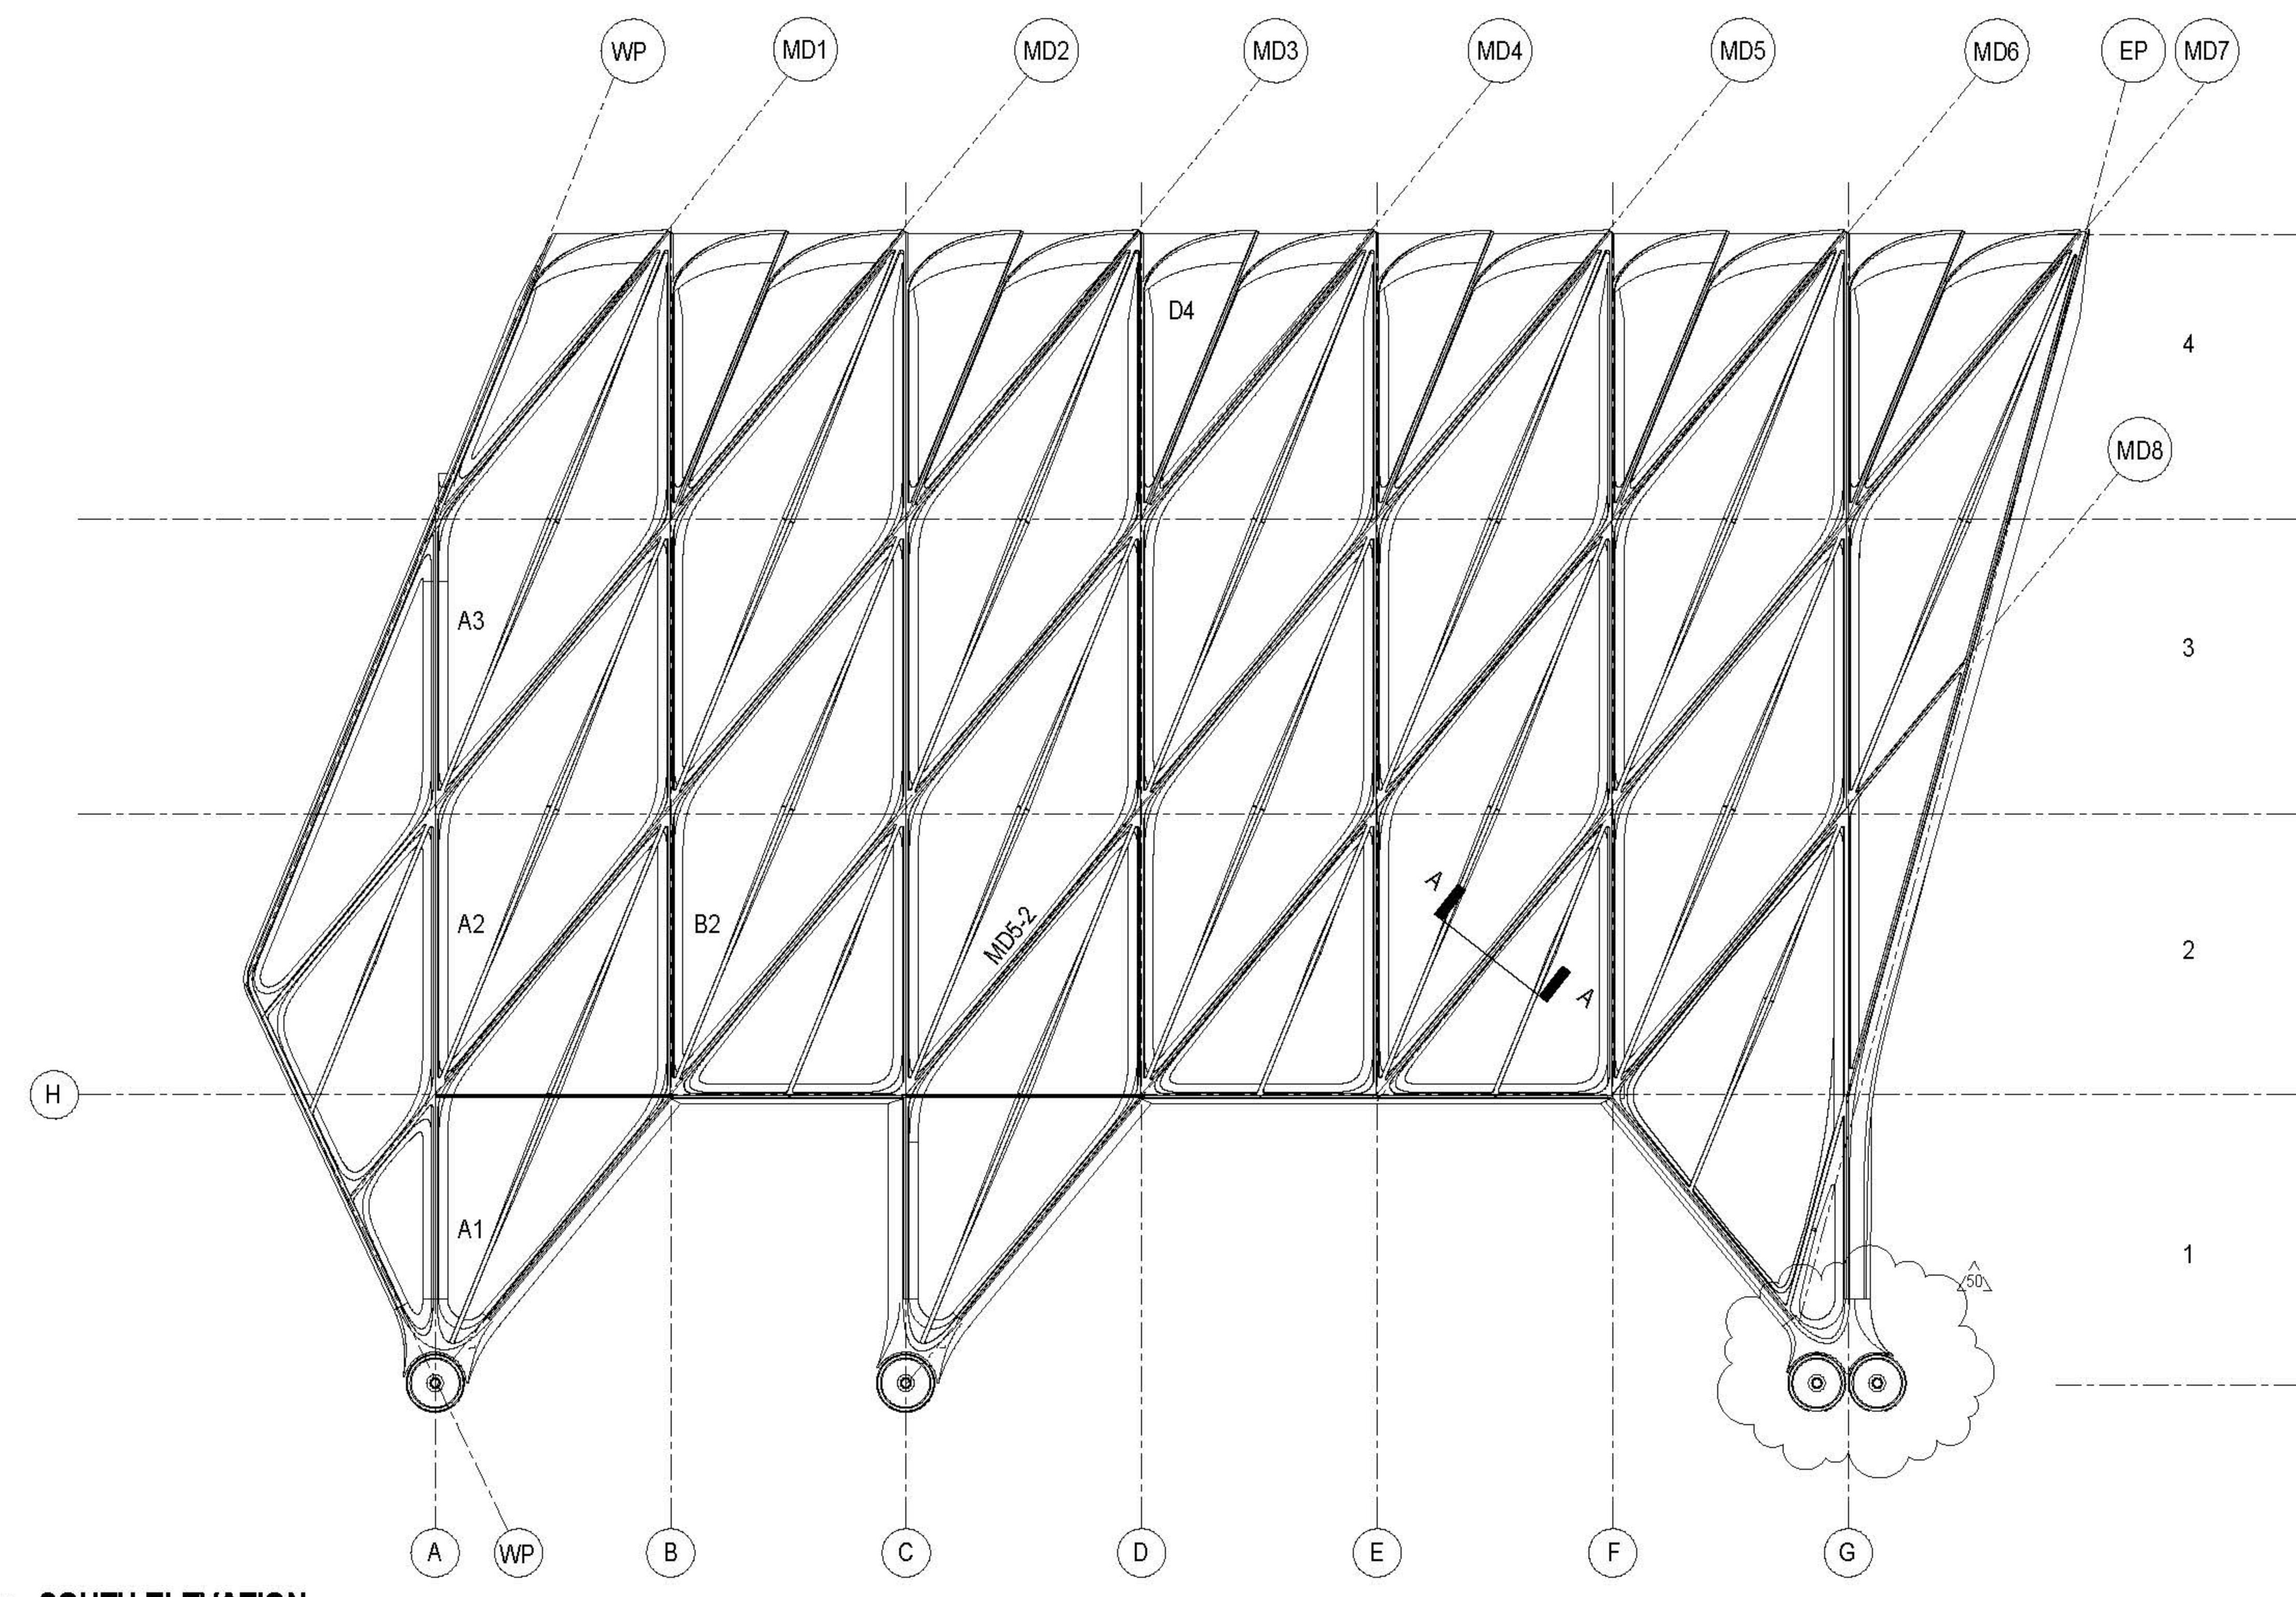


1 SOUTH ELEVATION
3/8" = 1'-0"

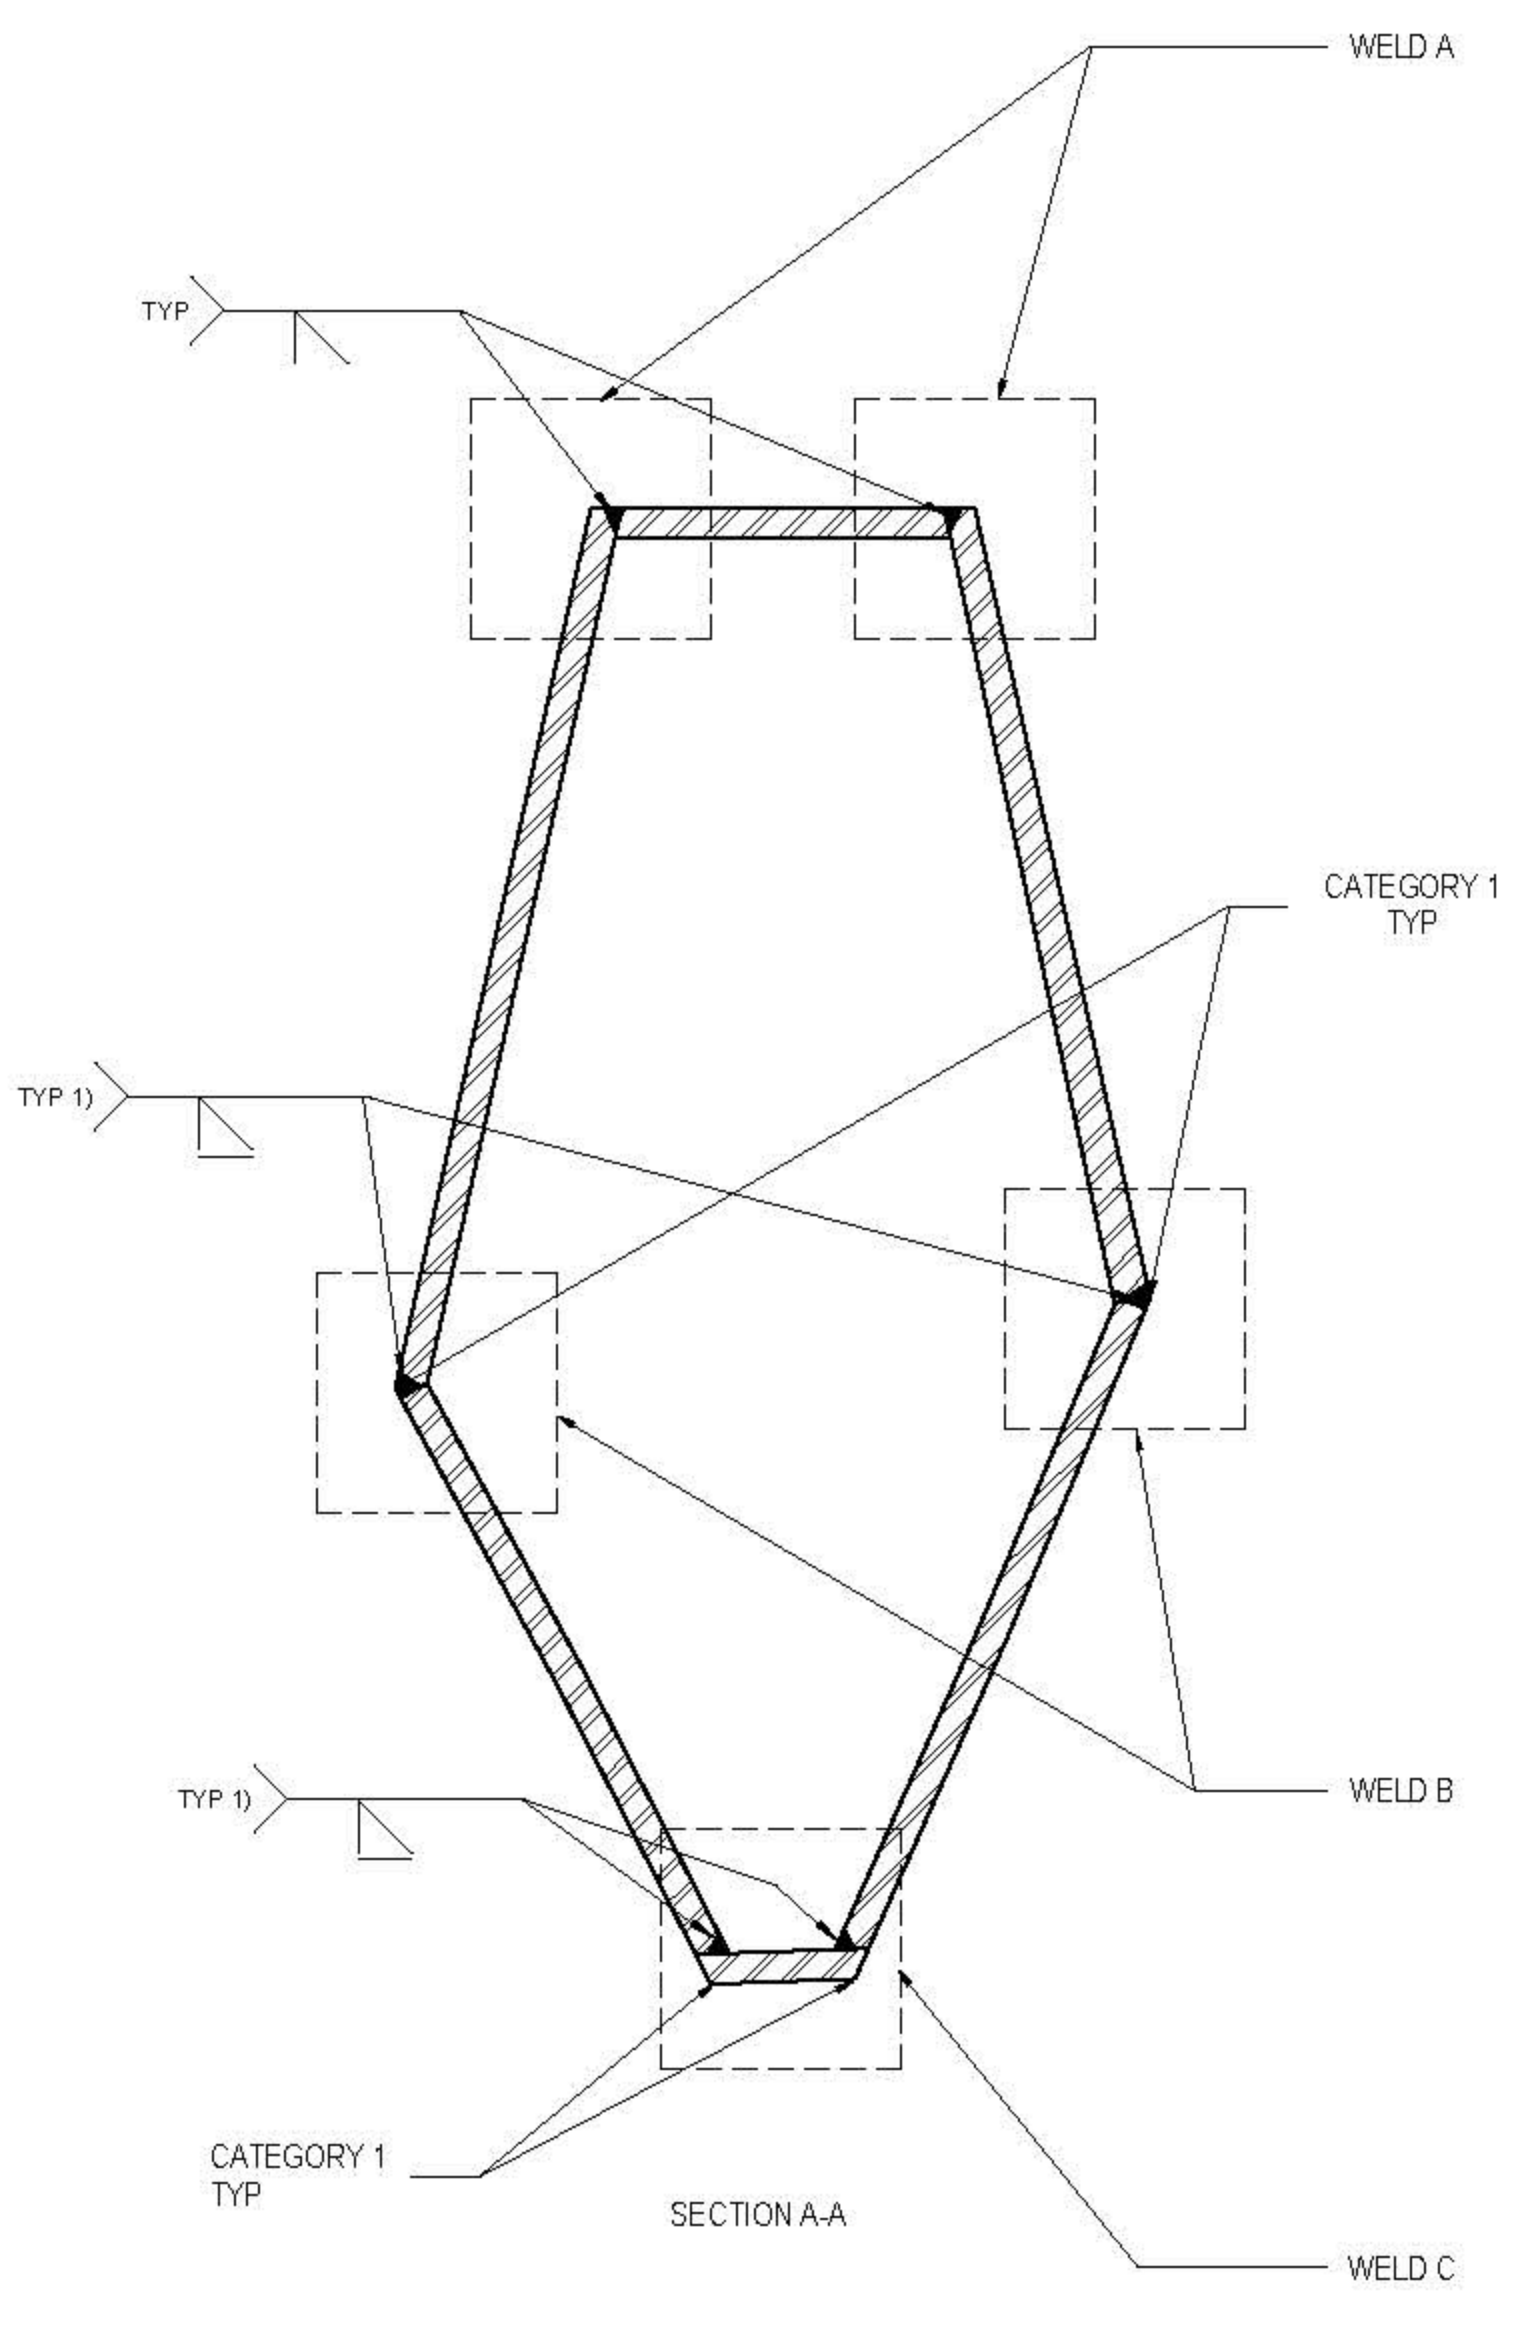


2 TYPICAL SECTION
3/8" = 1'-0"

ELEMENT	EFFECTIVE THROAT SIZE			
	WELD A	WELD B1	WELD C (E3)	WELD B2 (E4)
MD1-4	5/16"	5/16"	5/16"	
MD2-2	1/4"	1/4"	1/4"	
MD2-3	1/4"	1/4"	1/4"	
MD2-4	5/16"	5/16"	5/16"	
MD3-1	1/4"	1/4"	1/4"	
MD3-2	5/16"	5/16"	5/16"	
MD3-3	5/16"	5/16"	5/16"	5/16"
MD3-4	5/16"	5/16"	5/16"	
MD4-1	5/16"	5/16"	5/16"	
MD4-2	5/16"	5/16"	5/16"	
MD4-3	5/16"	5/16"	5/16"	5/16"
MD4-4	5/16"	5/16"	5/16"	
MD5-2	7/16"	5/16"	5/16"	1/2"
MD5-3	1/4"	1/4"	1/4"	
MD5-4	5/16"	5/16"	5/16"	
MD6-1	7/8"	5/8"	15/16"	
MD6-2	1/4"	1/4"	1/4"	
MD6-3	1/4"	1/4"	1/4"	
MD6-4	5/16"	5/16"	5/16"	
MD7-2	1/4"	1/4"	1/4"	
MD7-3	5/16"	5/16"	5/16"	5/16"
MD7-4	5/16"	5/16"	5/16"	
MD8-2	1/4"	1/4"	1/4"	
MD8-3	5/16"	7/16"	5/16"	5/16"
F-G1	5/16"	5/16"	5/16"	

7 WELD SIZES
1 1/2" = 1'-0"

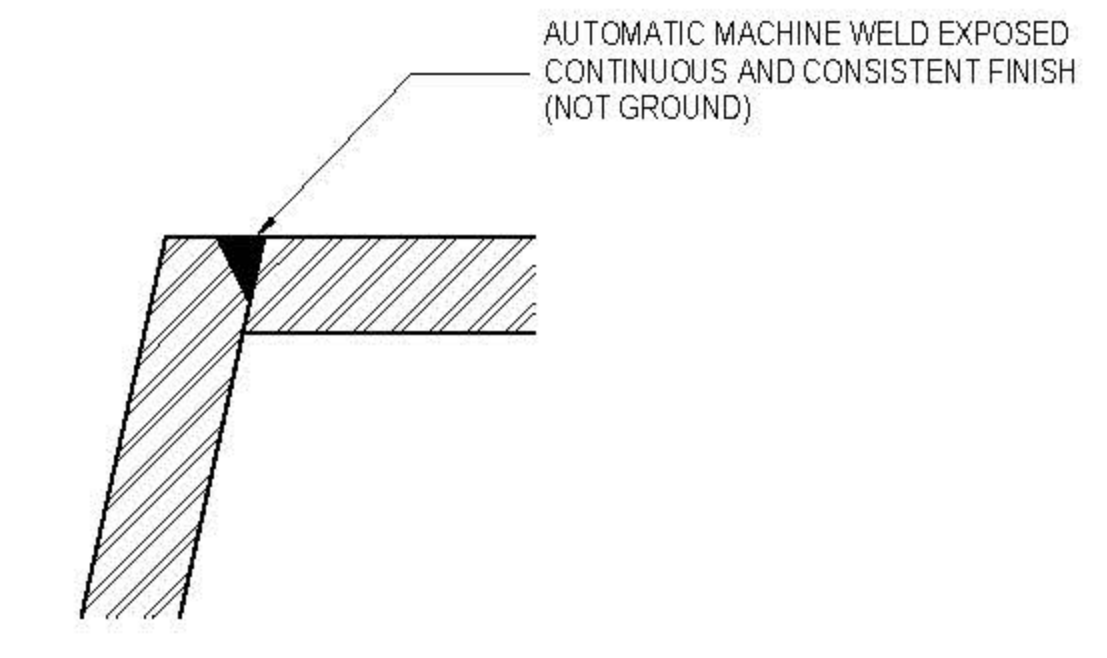


3 WELD A DETAIL
6" = 1'-0"

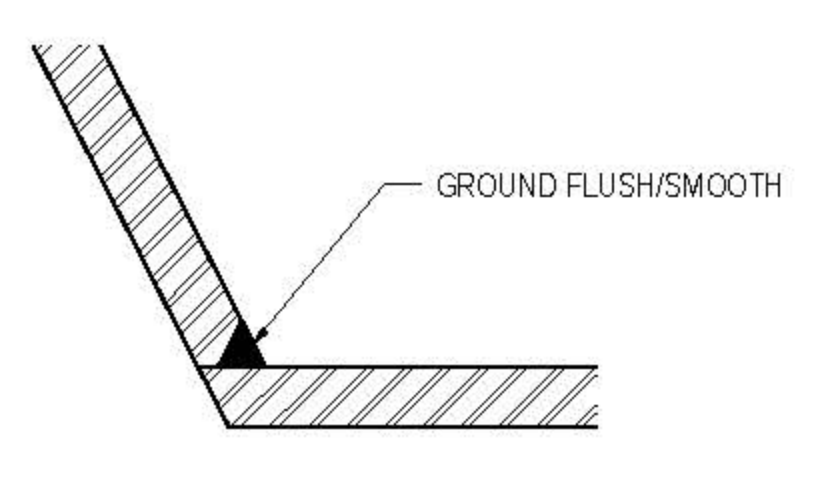

4 WELD C DETAIL
6" = 1'-0"

CATEGORY 1 CORNERS: ALL CORNERS MARKED CATEGORY 1 TO HAVE A SHARP CONTINUOUS EDGE WITH STRAIGHTNESS TO WITHIN +/- 1/16" ALL CORNERS MAY HAVE A 0.08" RADIUS


1) EXPOSED EDGE WITH CONTINUOUS AND CONSISTENT FINISH REQUIRED, EVEN ACROSS SPLICES FOR NODE WELD DETAILS SEE DRAWING S-755

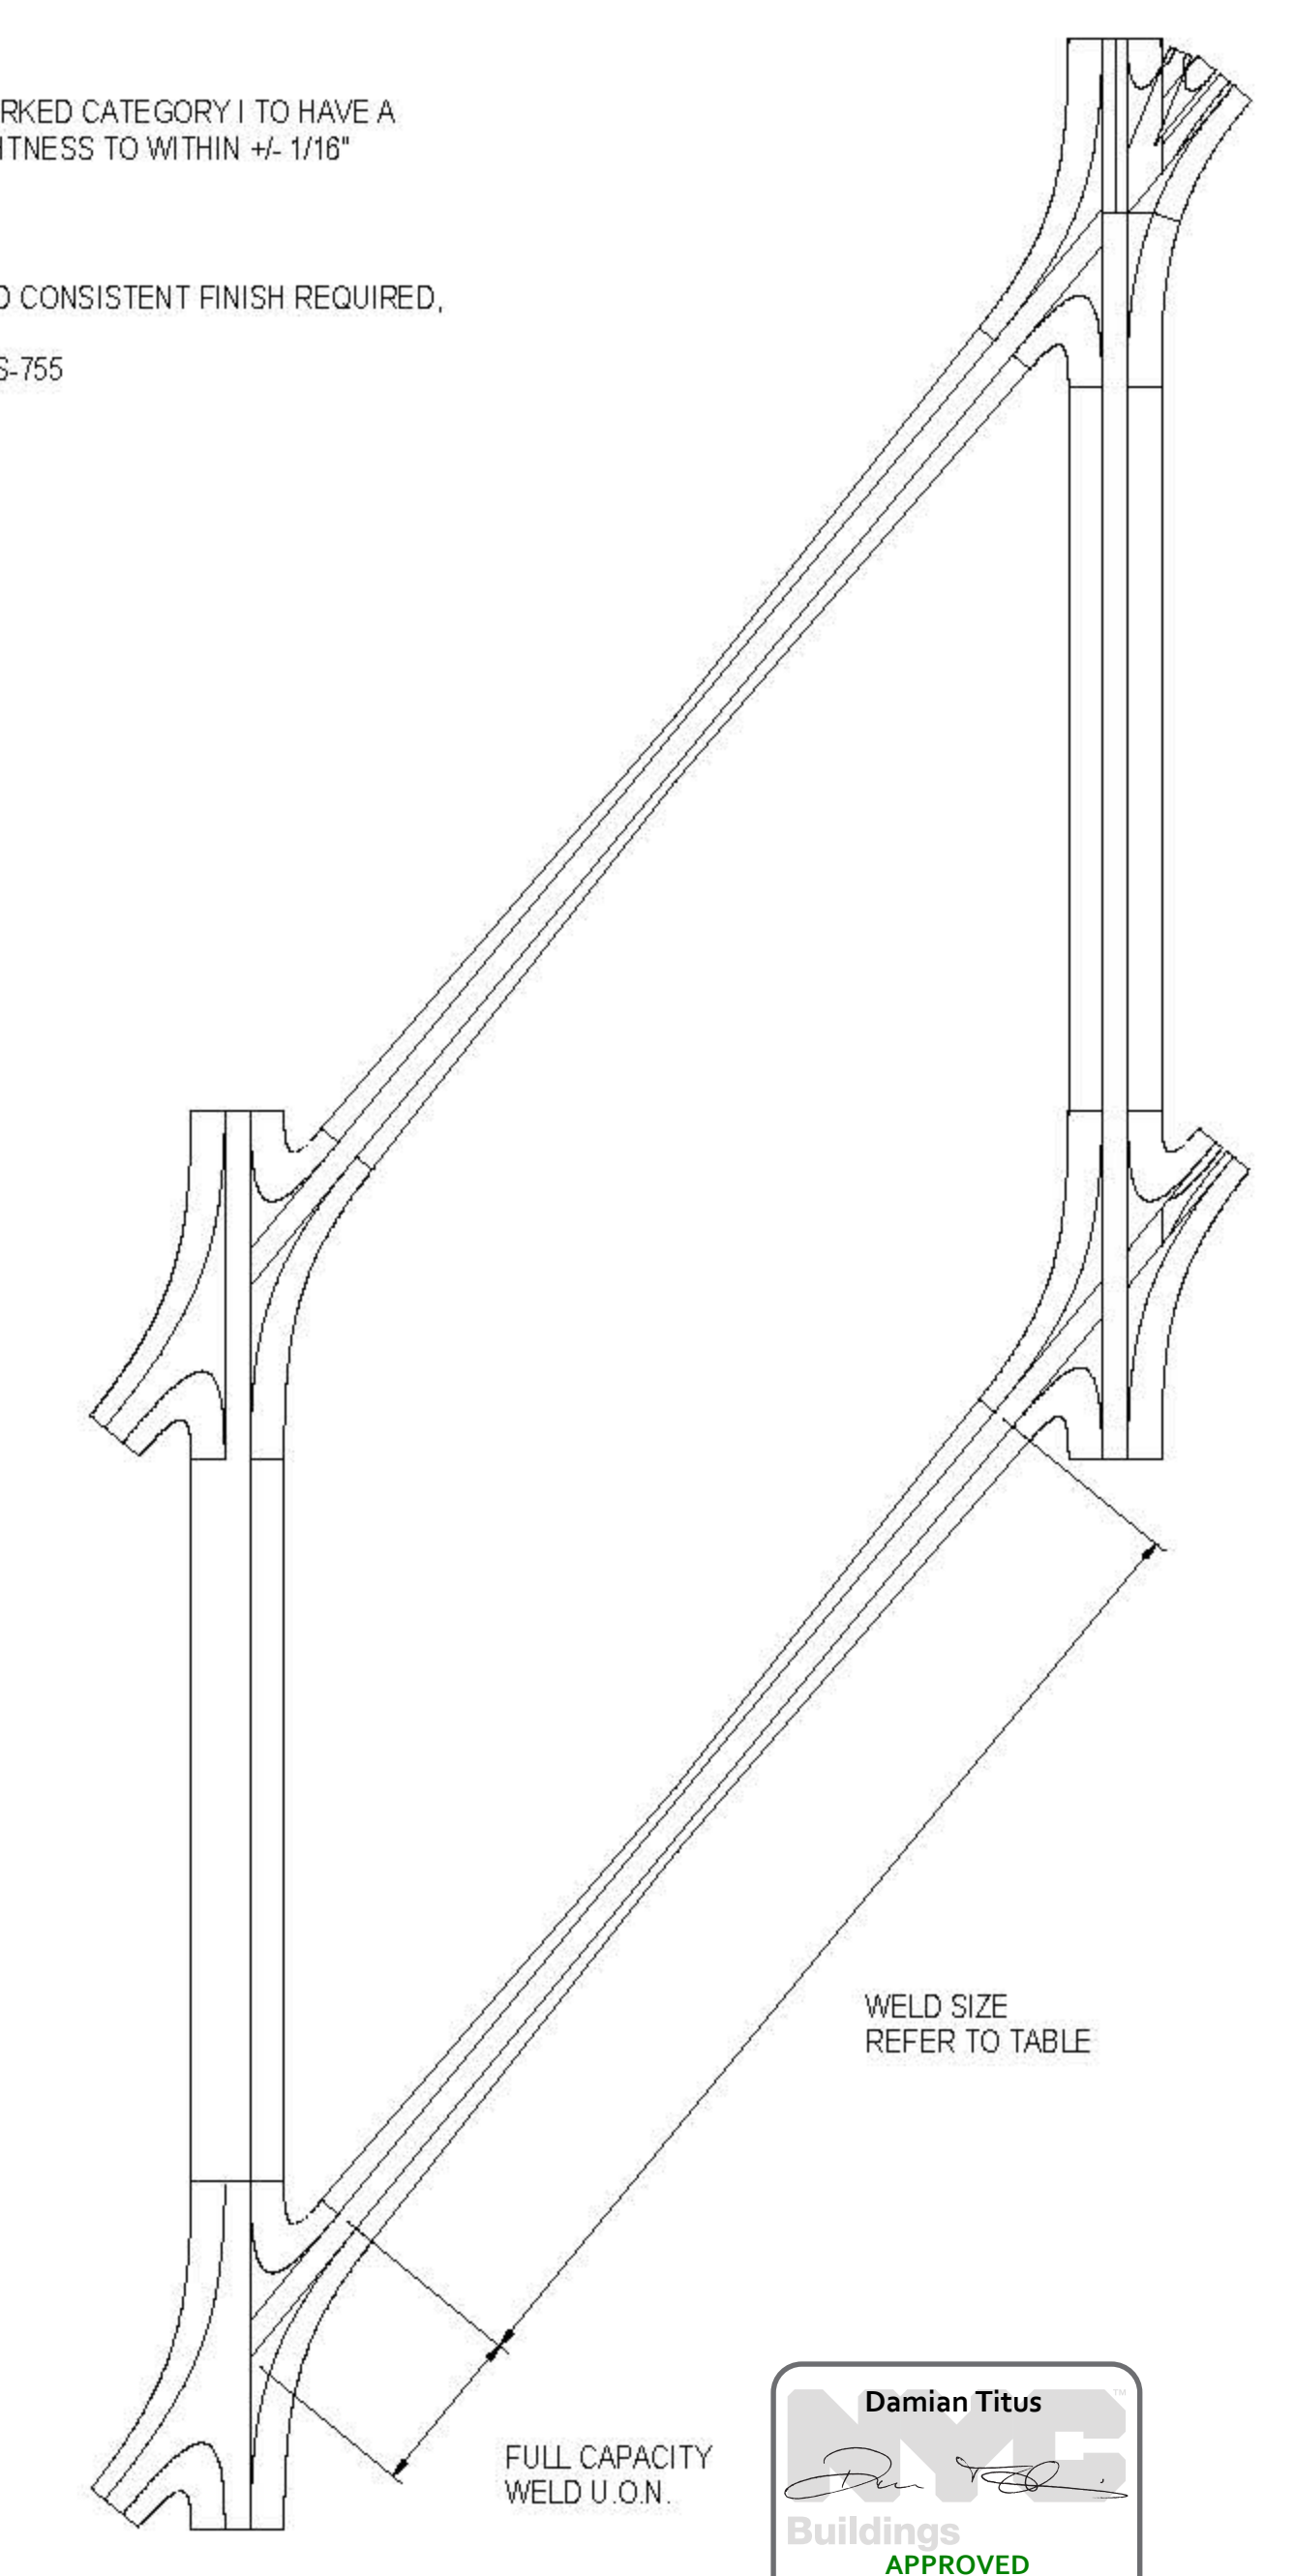


6 WELD SIZE REFERENCE
3/16" = 1'-0"

NOTE: ALL DIAGONAL ELEMENTS SIMILAR U.O.N.

PENDING COORDINATION DURING DESIGN ASSIST. SUBJECT TO FINAL FORCES AND PLATE THICKNESSES TBD

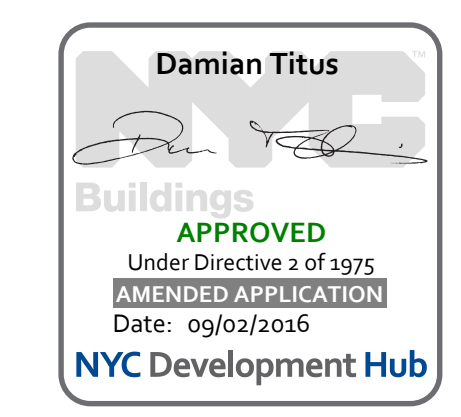

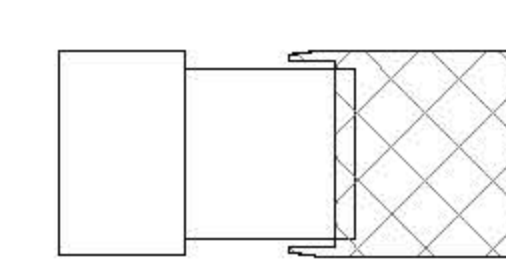

ISSUE	PRINTING	DATE
01	60	DOB AMENDMENT 7
02	30	DOB AMENDMENT 6
03	21	CONSTRUCTION SET
04	10	100% CONSTRUCTION DOCUMENTS
05	09	90% CONSTRUCTION DOCUMENTS
06	08	PRELIMINARY JOB SUBMISSION
07	01	ADVANCED PROCUREMENT BID SET



DRAWN BY: *Audrey* CHECKED BY: *Chris*

PROJECT NUMBER: N1318.00

TITLE: DEPLOYED SHED NORTH/SOUTH WALL - ATYPICAL ELEMENTS


DRAWING NO.: 8-757.01

B.SCAN NO.: S-757.01


B.SCAN NO.: 94 of 123

GEOMETRY, DIMENSIONS AND SURFACE CONTOURING, BLENDING AND INTERSECTION OF SECTIONS ILLUSTRATED IN THE STRUCTURAL DRAWINGS ARE PROVIDED FOR REFERENCE AND GENERATION OF STRUCTURAL ARRANGEMENT AND DETAILS ONLY. THE 3D MODEL ISSUED BY THE ARCHITECT, DEFINES THE EXTERIOR SURFACE AND SHALL BE ADHERED TO FOR THE FINAL GEOMETRY. FOR DETAILS OF SECONDARY STEEL, INCLUDING STRUCTURAL CLADDING REFER TO ARCHITECTURE DRAWINGS. IT IS THE RESPONSIBILITY OF THE CONTRACTOR TO IDENTIFY ANY DISCREPANCIES OR AMBIGUITIES FOR DISCUSSION, RESOLUTION AND DIRECTION FROM THE ARCHITECT AND SER.


NOTES: WELD DETAILS TYPICAL FOR SIMILAR SECTIONS REFER TO DRAWING S-751 FOR TYPICAL PLATE THICKNESSES

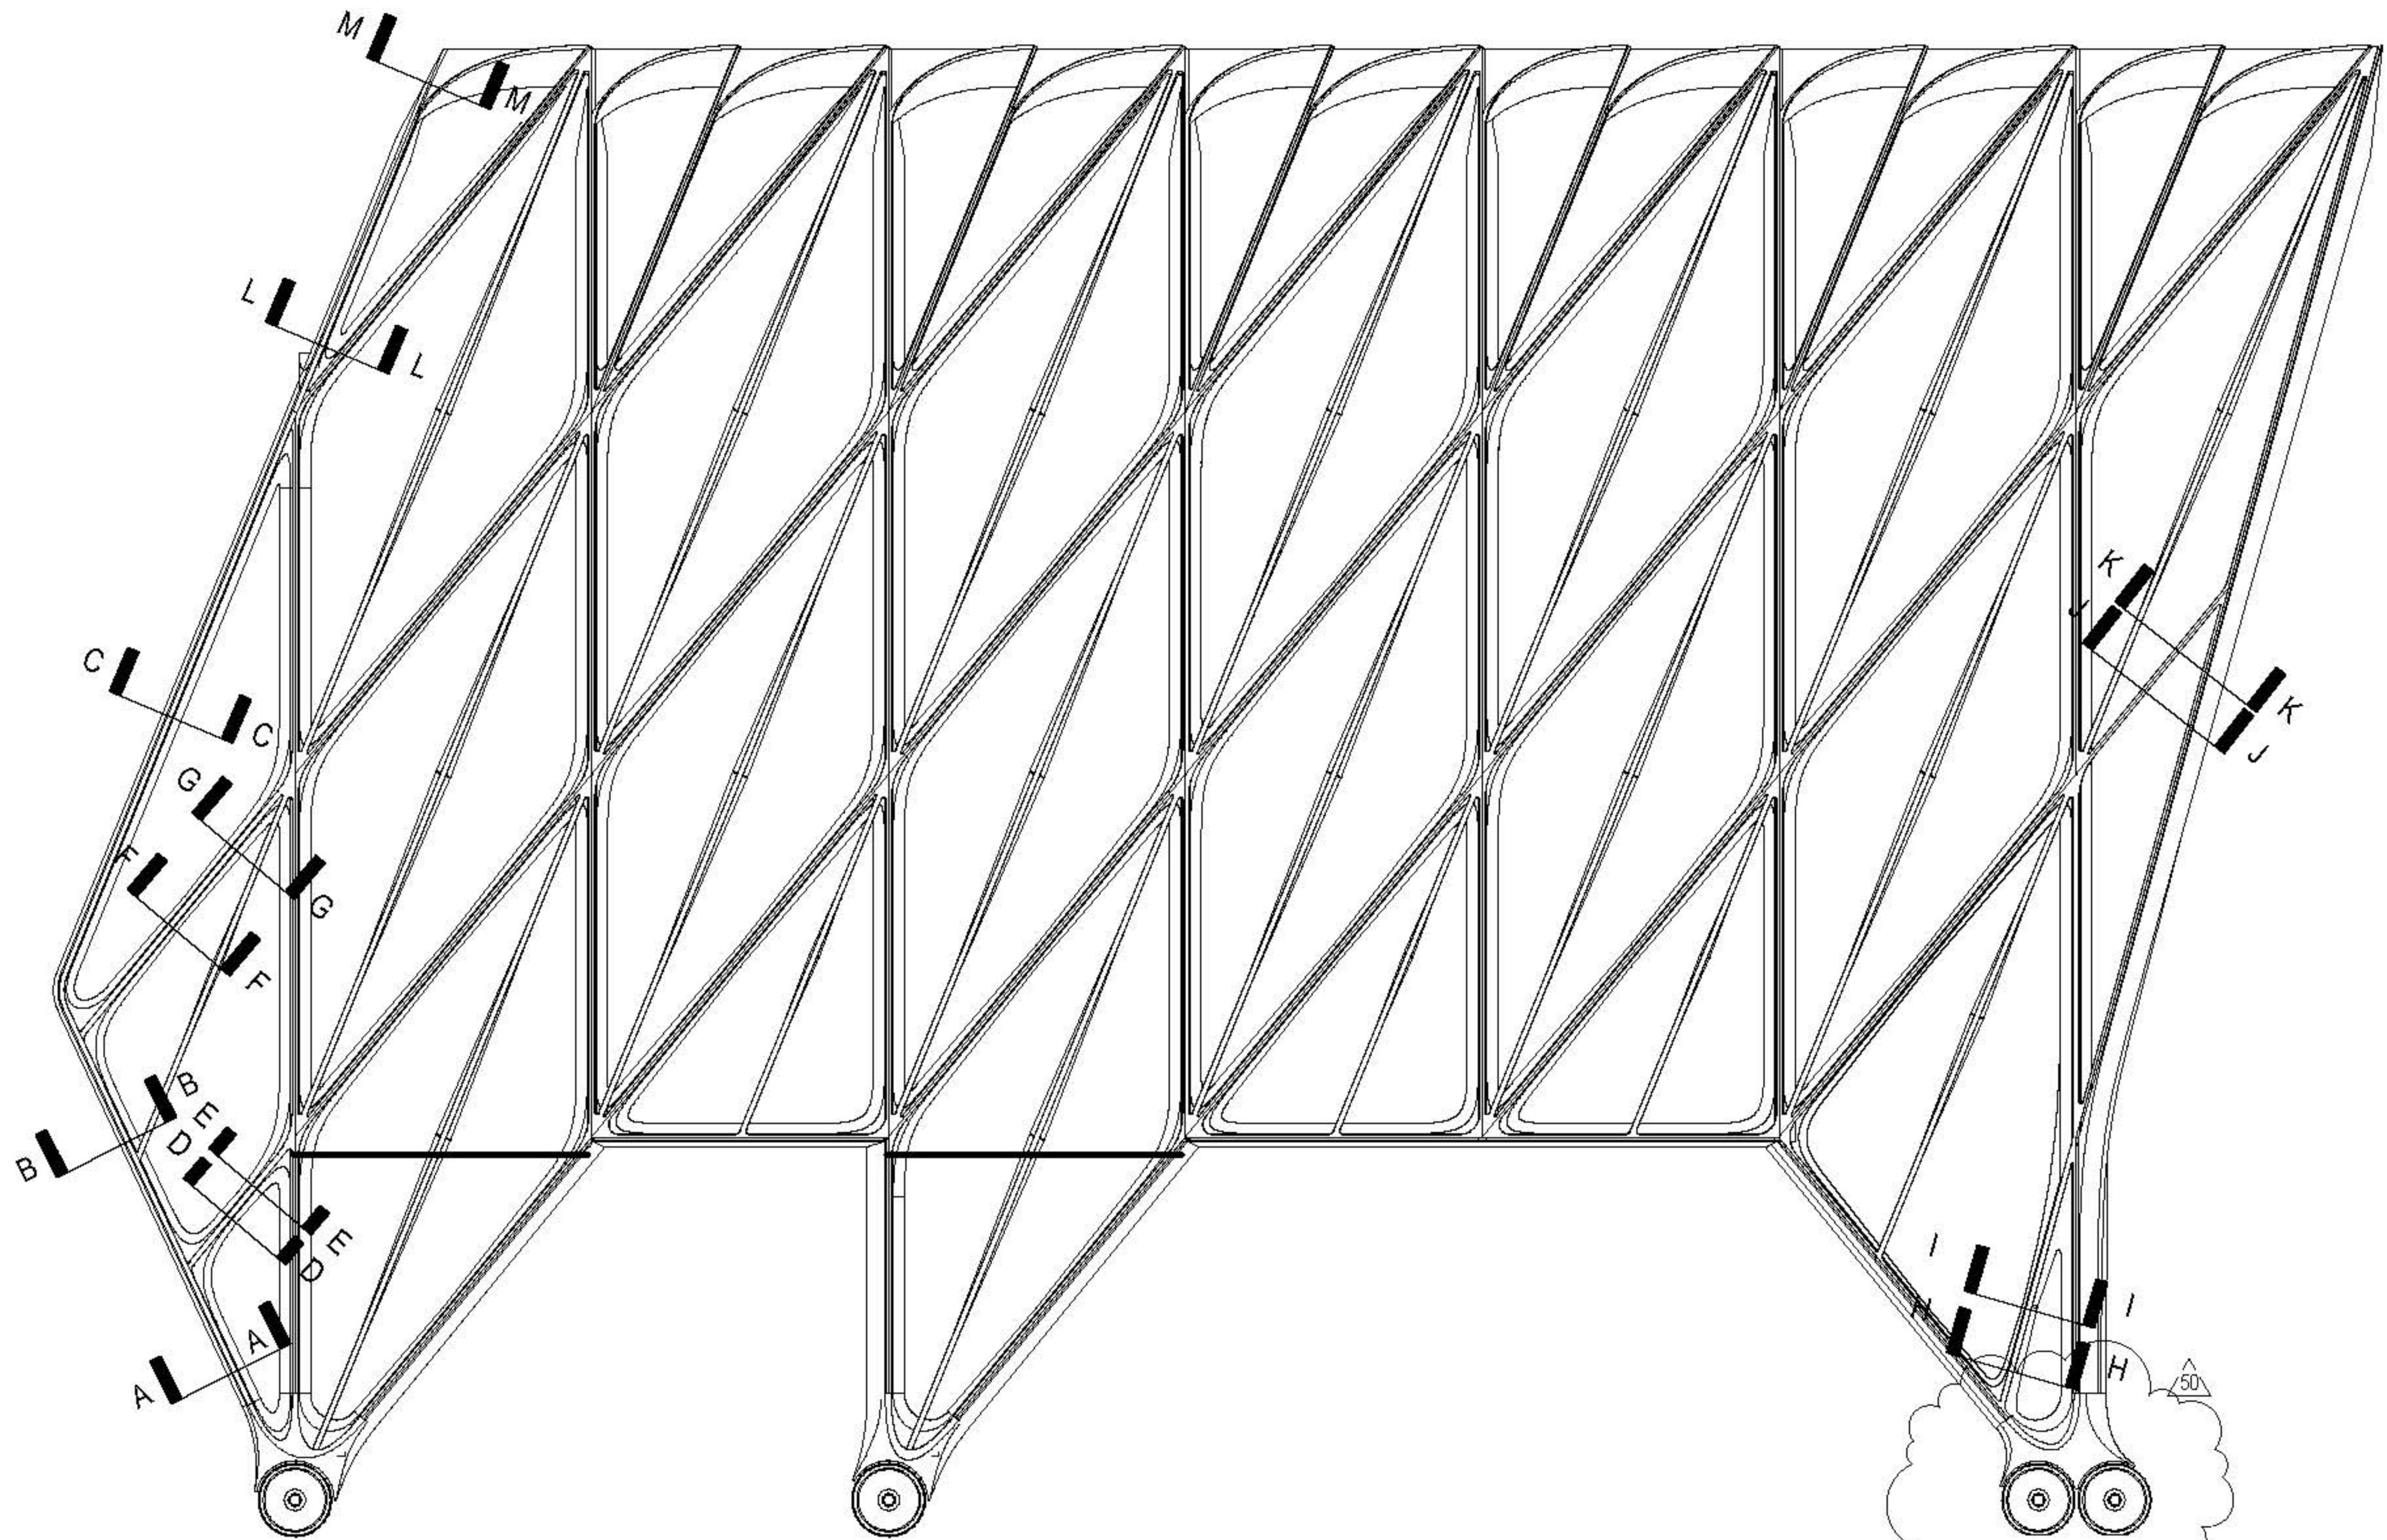


1 SOUTH ELEVATION
 3/32" = 1'-0"

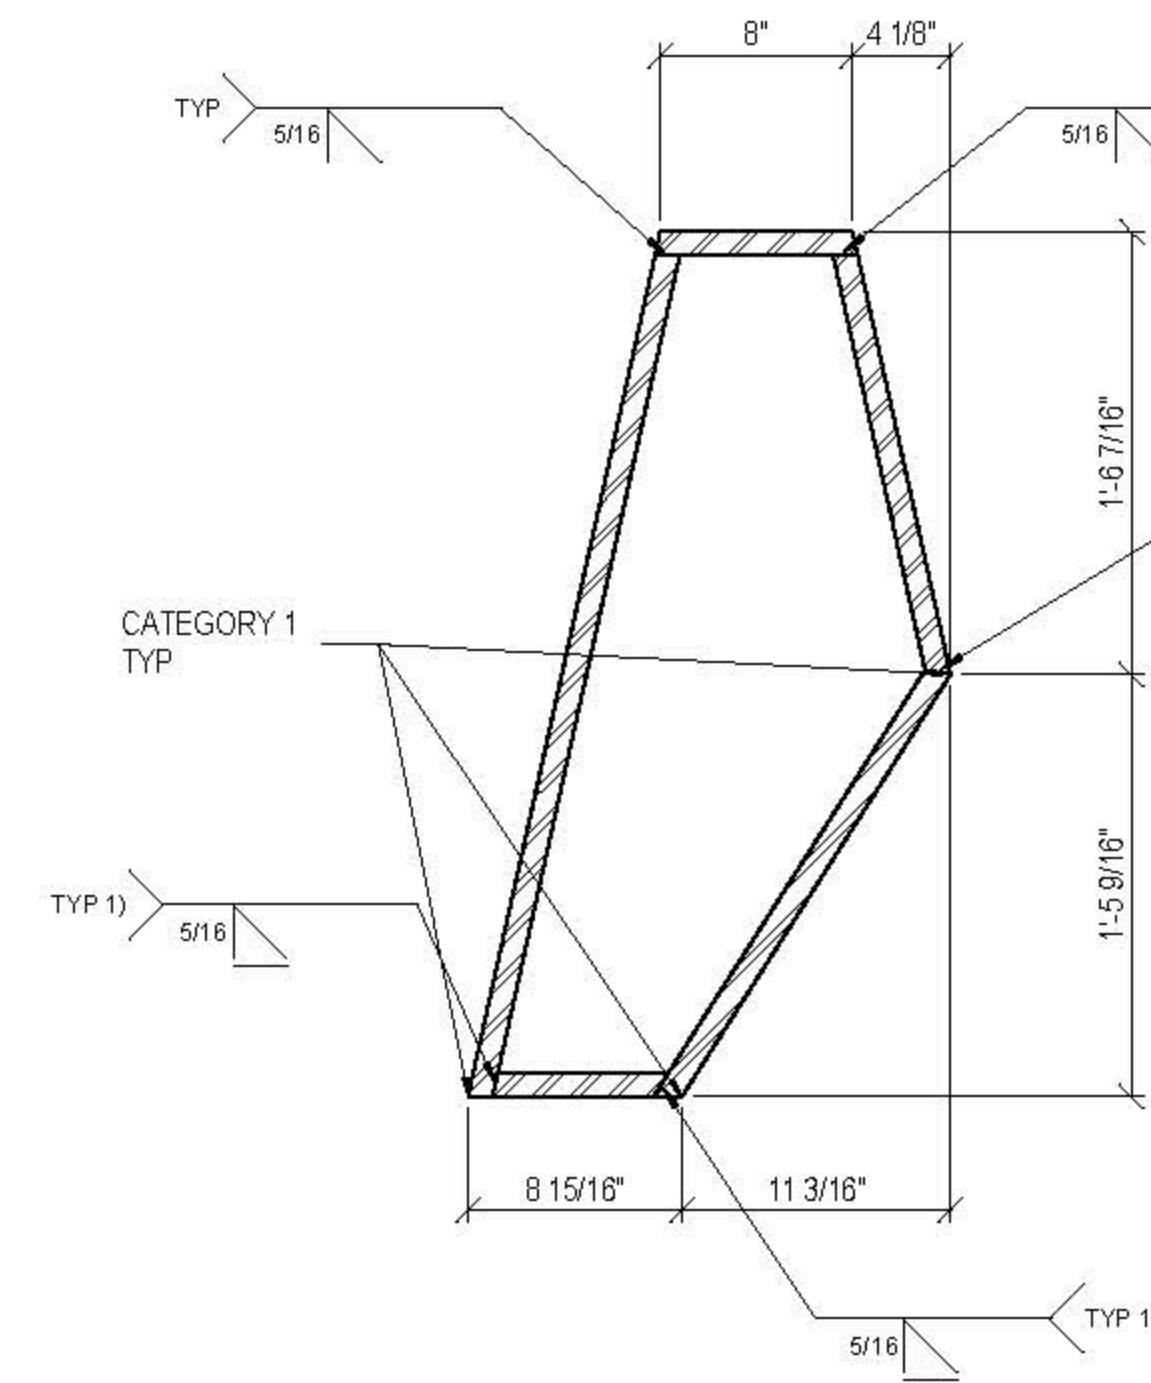

2 SECTION A-A
 1 1/2" = 1'-0"

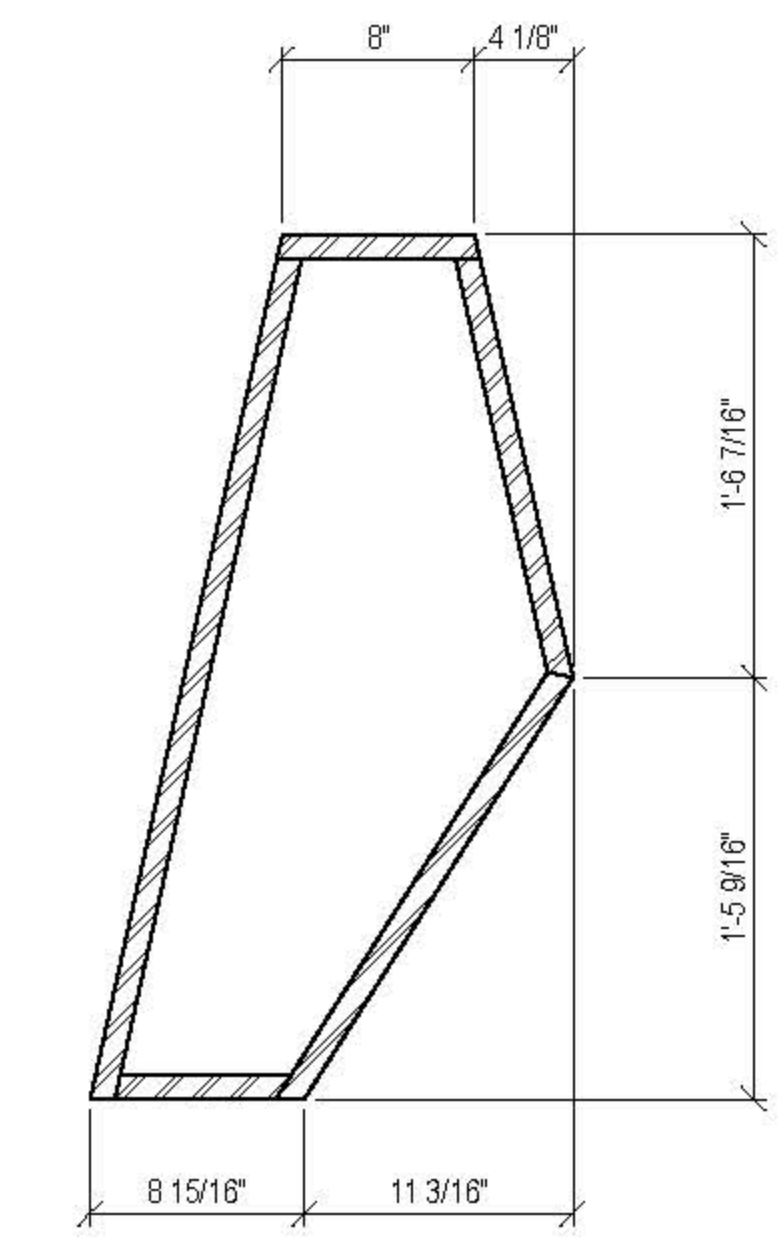


3 SECTION B-B
 1 1/2" = 1'-0"

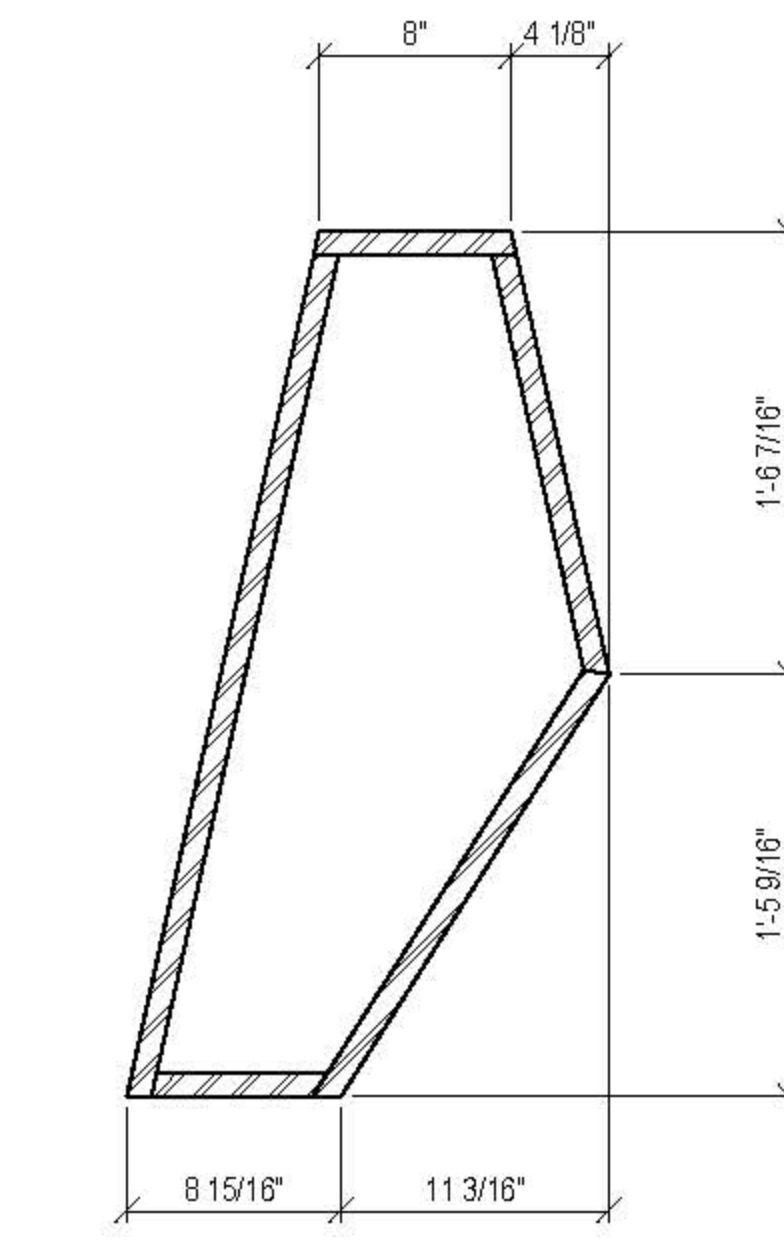


4 SECTION C-C
 1 1/2" = 1'-0"

CATEGORY 1 CORNERS: ALL CORNERS MARKED CATEGORY 1 TO HAVE A SHARP CONTINUOUS EDGE WITH STRAIGHTNESS TO WITHIN +/- 1/16". ALL CORNERS MAY HAVE A 0.00" RADIUS


1) EXPOSED EDGE WITH CONTINUOUS AND CONSISTENT FINISH REQUIRED, EVEN ACROSS SPLICES FOR NODE WELD DETAILS SEE DRAWING S-755

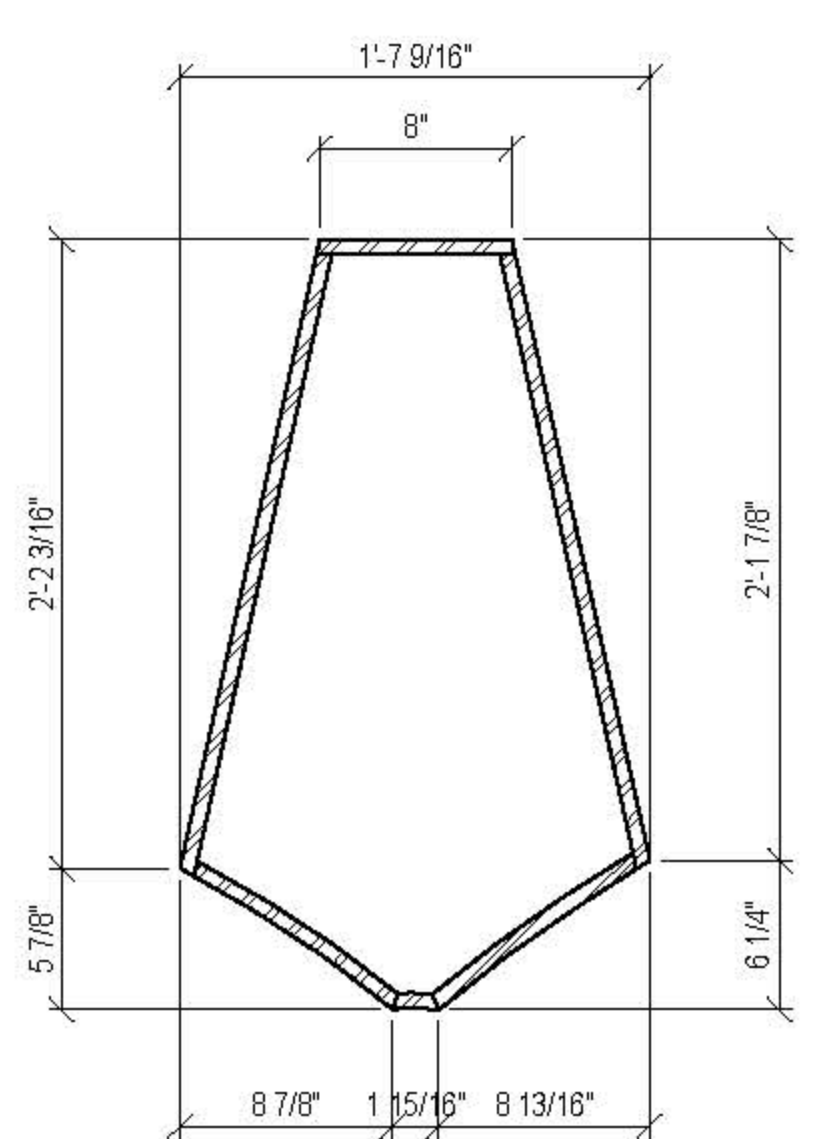


5 SECTION D-D
 1 1/2" = 1'-0"

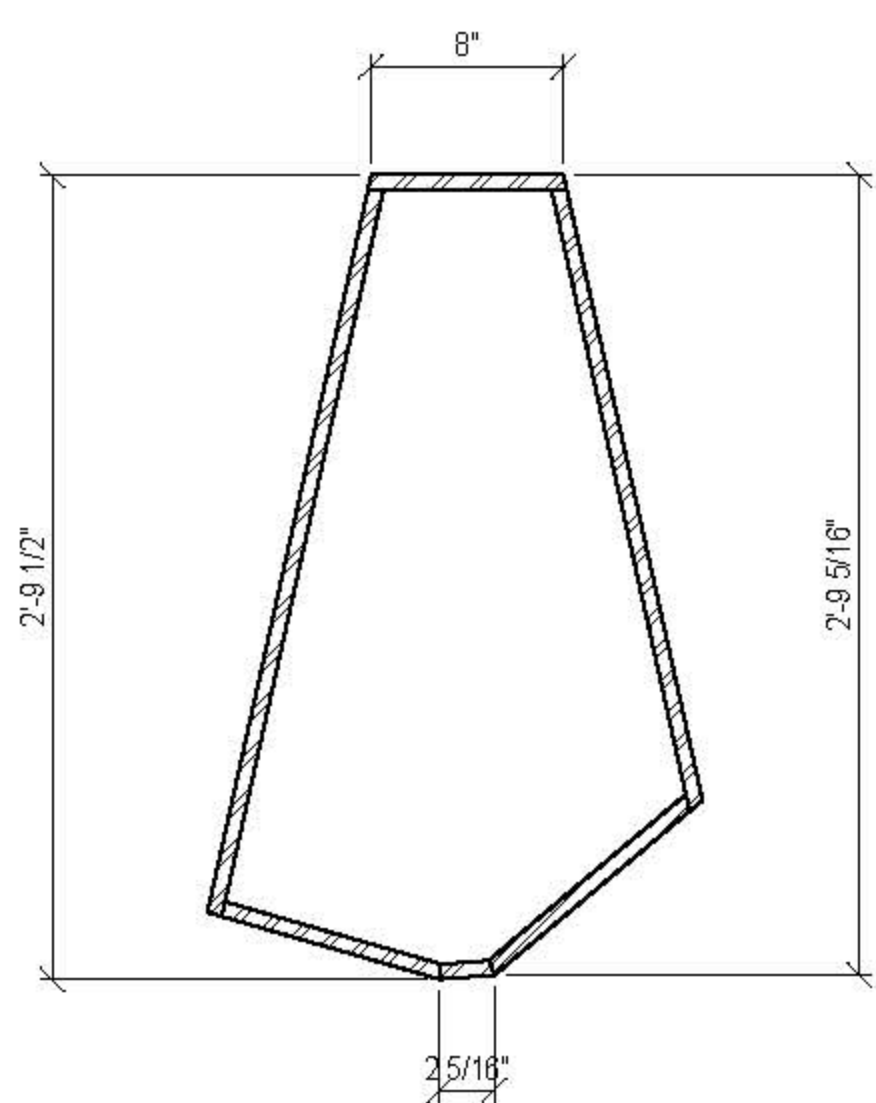


6 SECTION E-E
 1 1/2" = 1'-0"

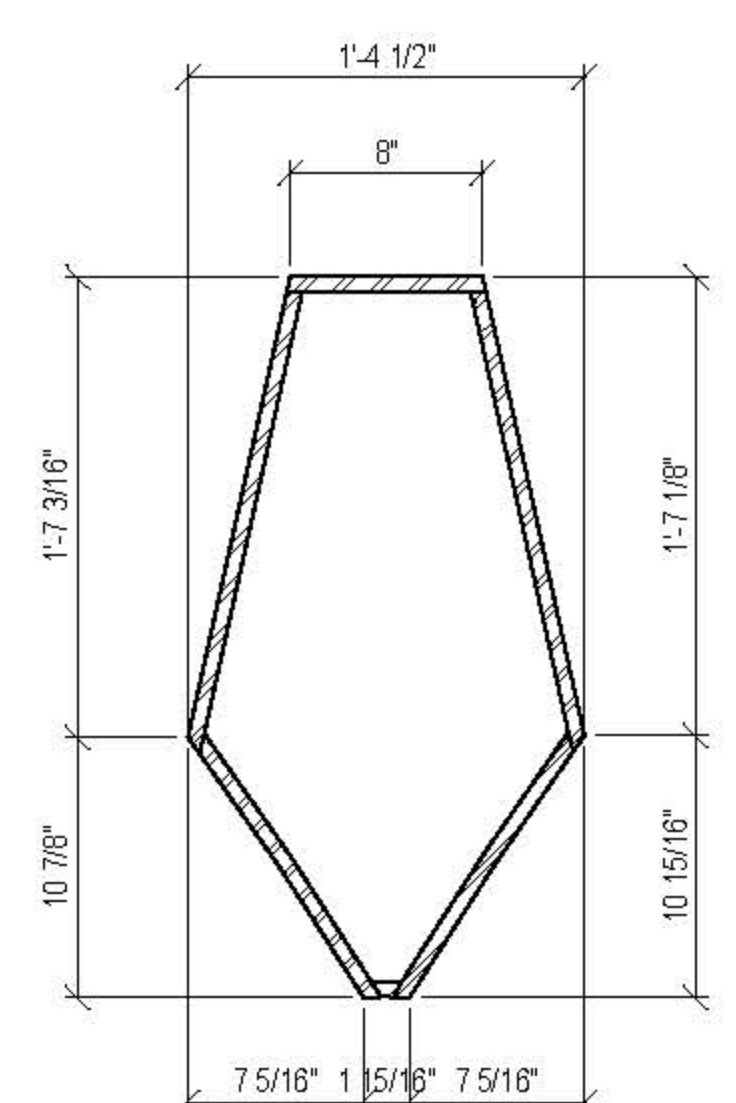


7 SECTION F-F
 1 1/2" = 1'-0"

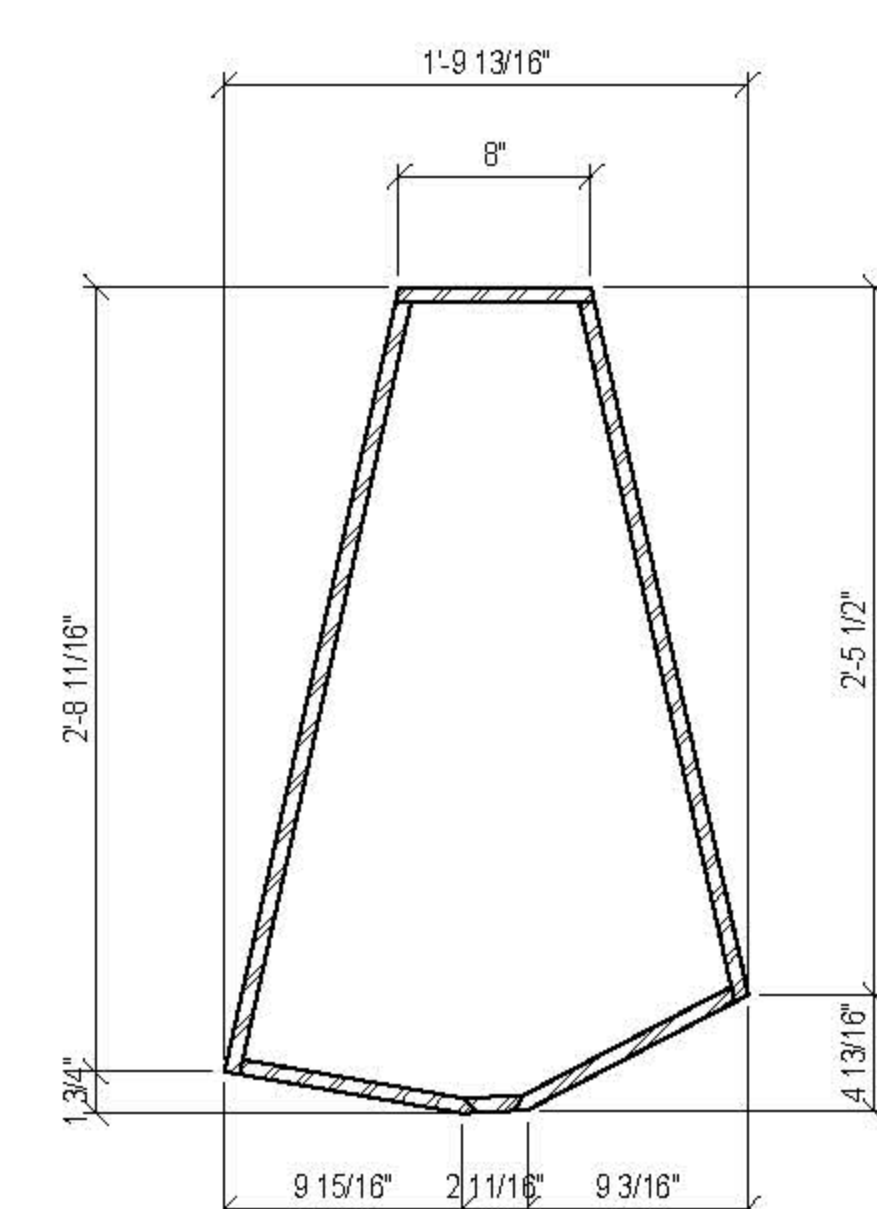


8 SECTION G-G
 1 1/2" = 1'-0"

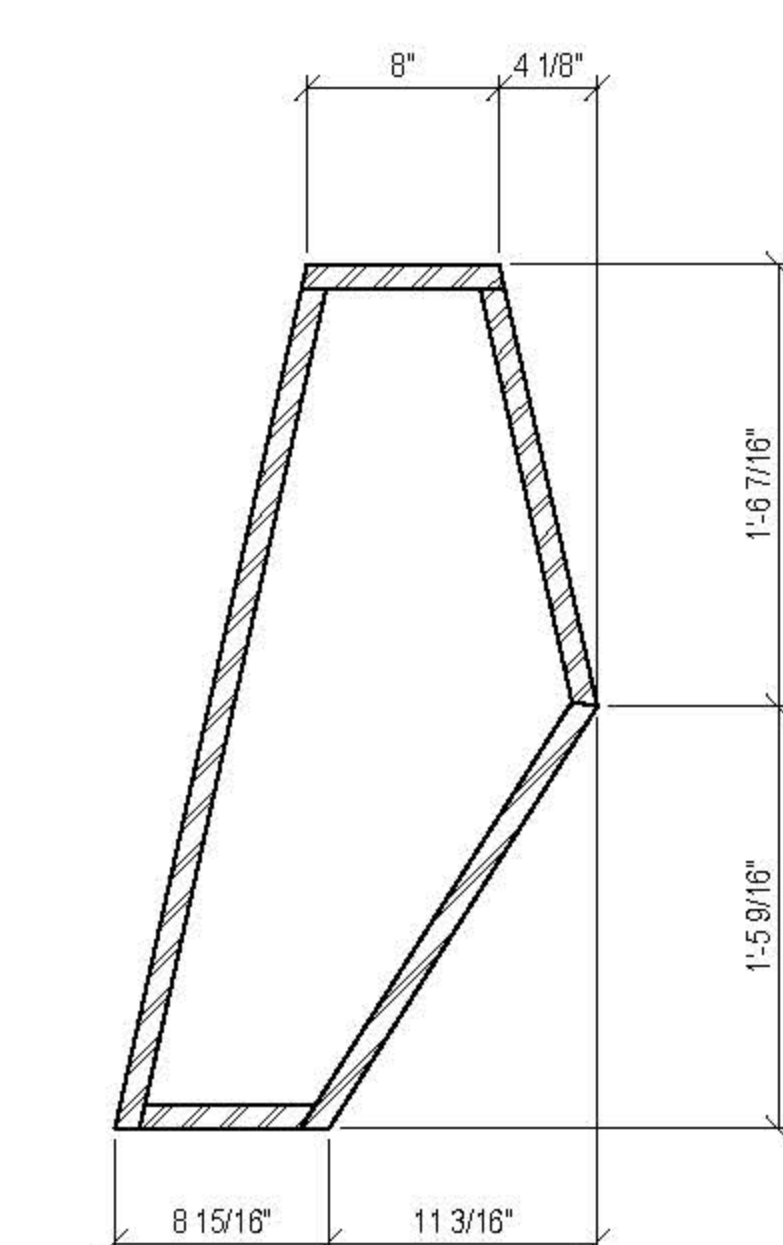


14 SECTION L-L
 1 1/2" = 1'-0"

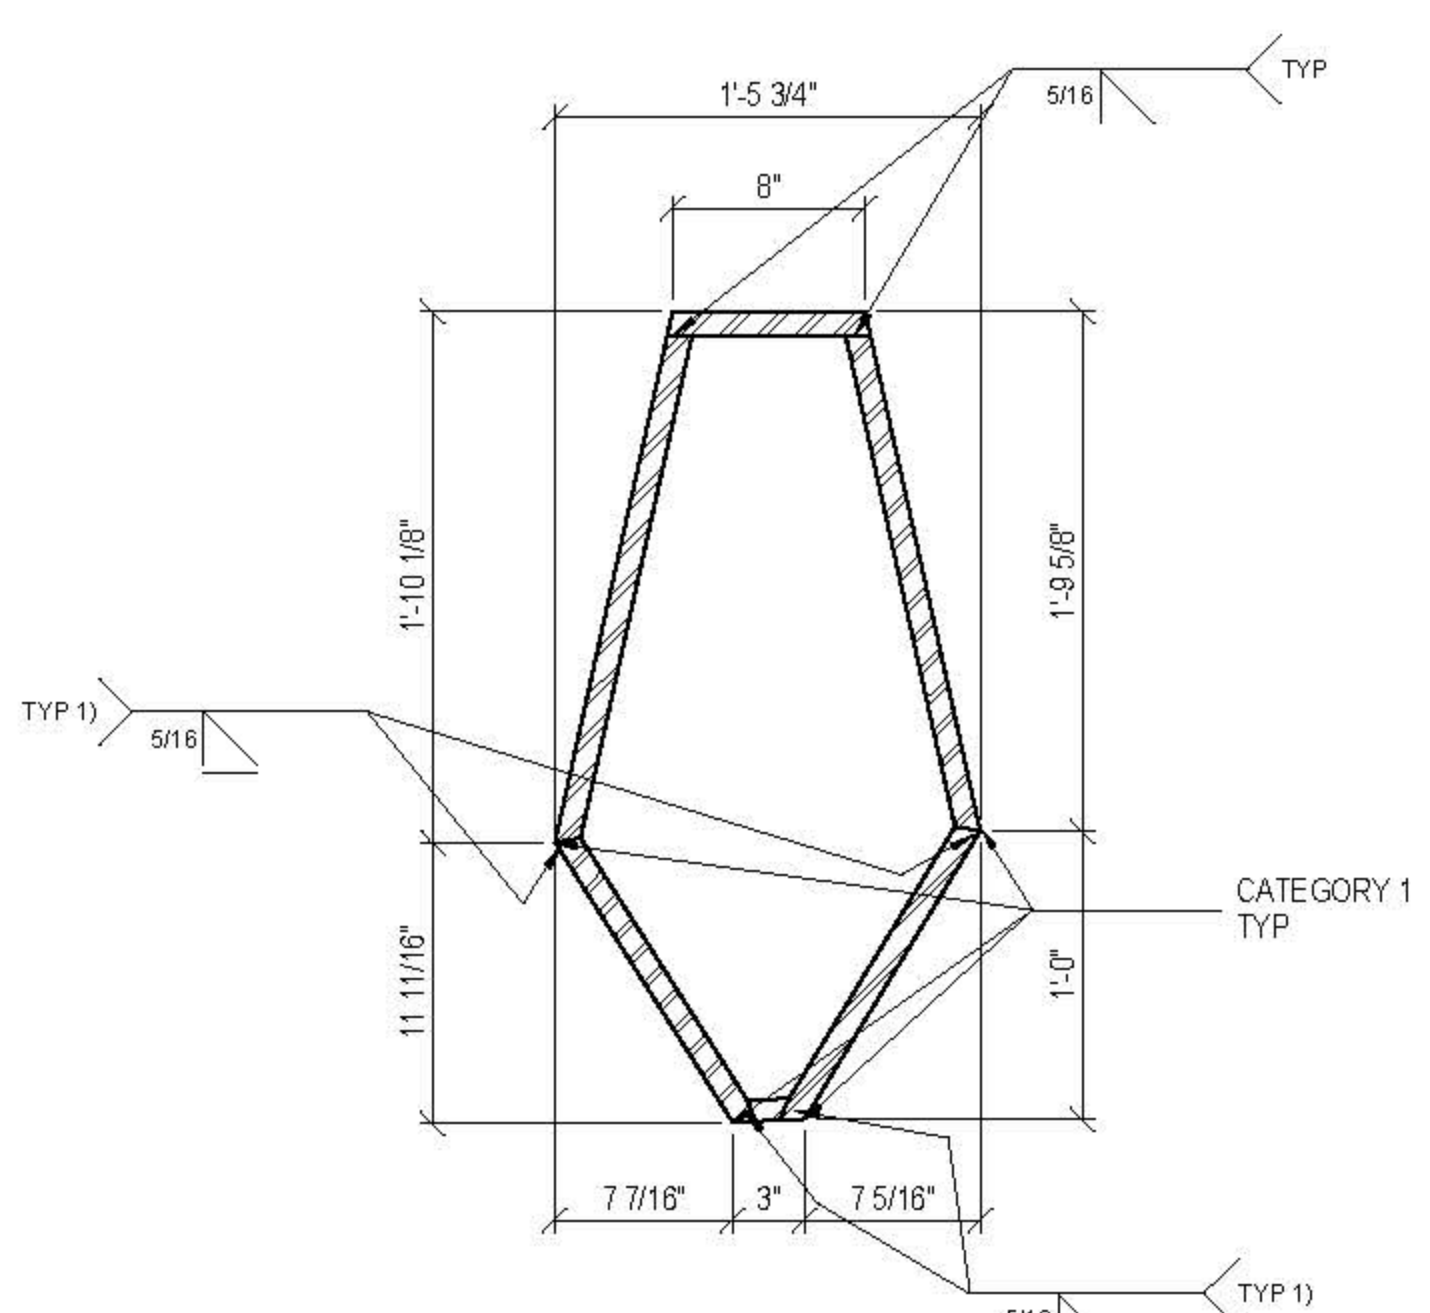


9 SECTION H-H
 1 1/2" = 1'-0"

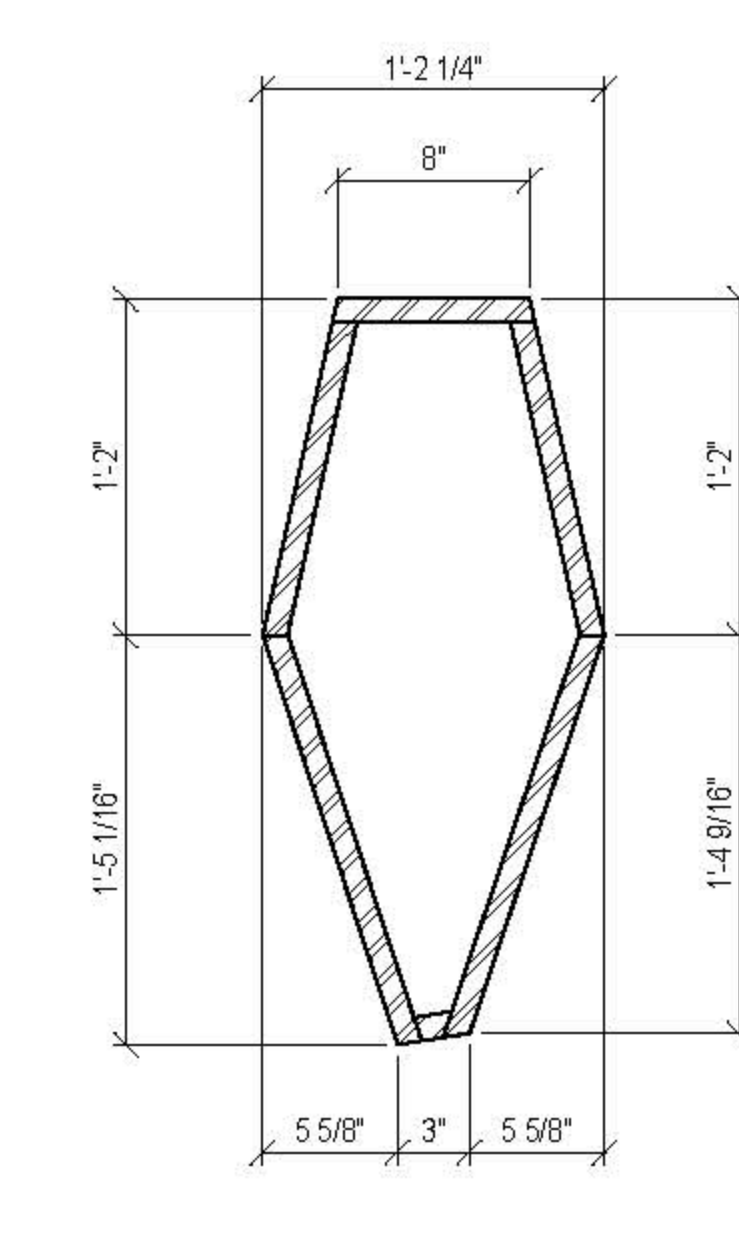


10 SECTION I-I
 1 1/2" = 1'-0"

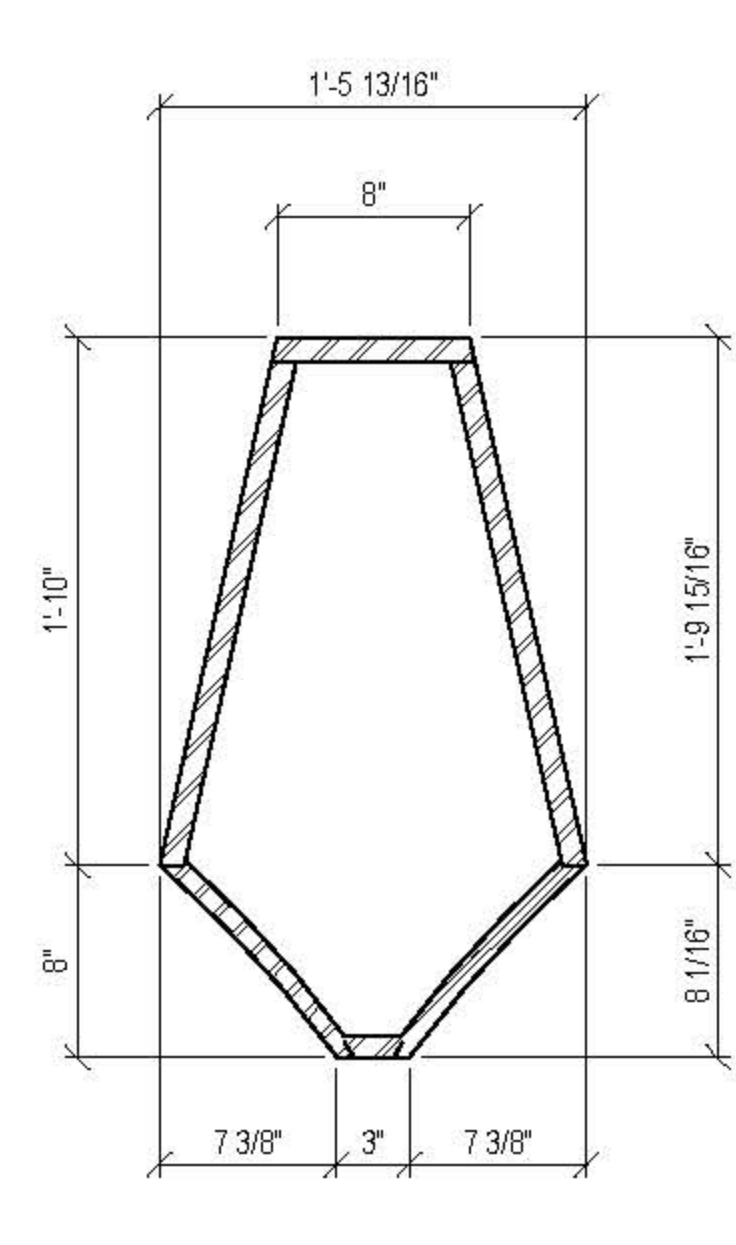

11 SECTION J-J
 1 1/2" = 1'-0"

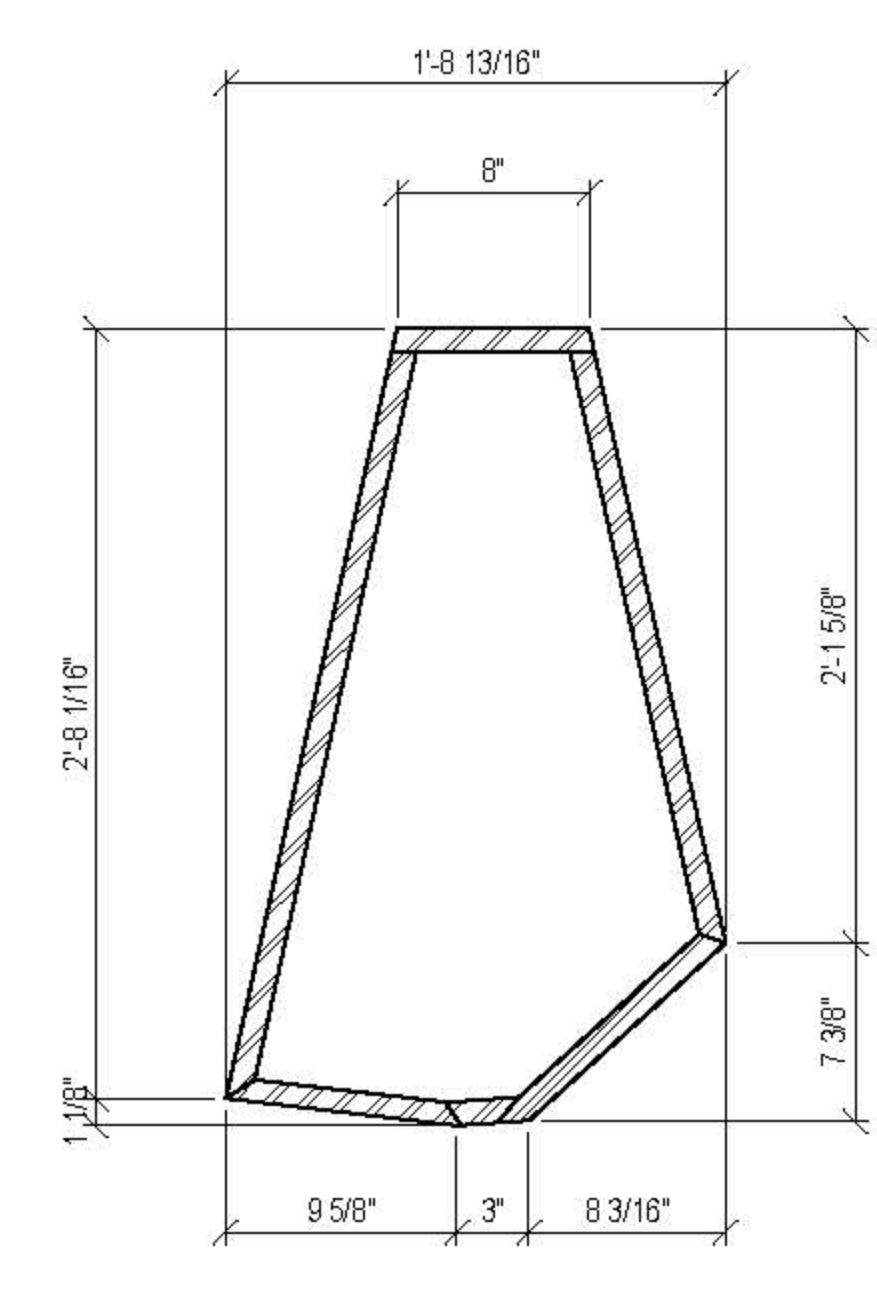


12 SECTION K-K
 1 1/2" = 1'-0"

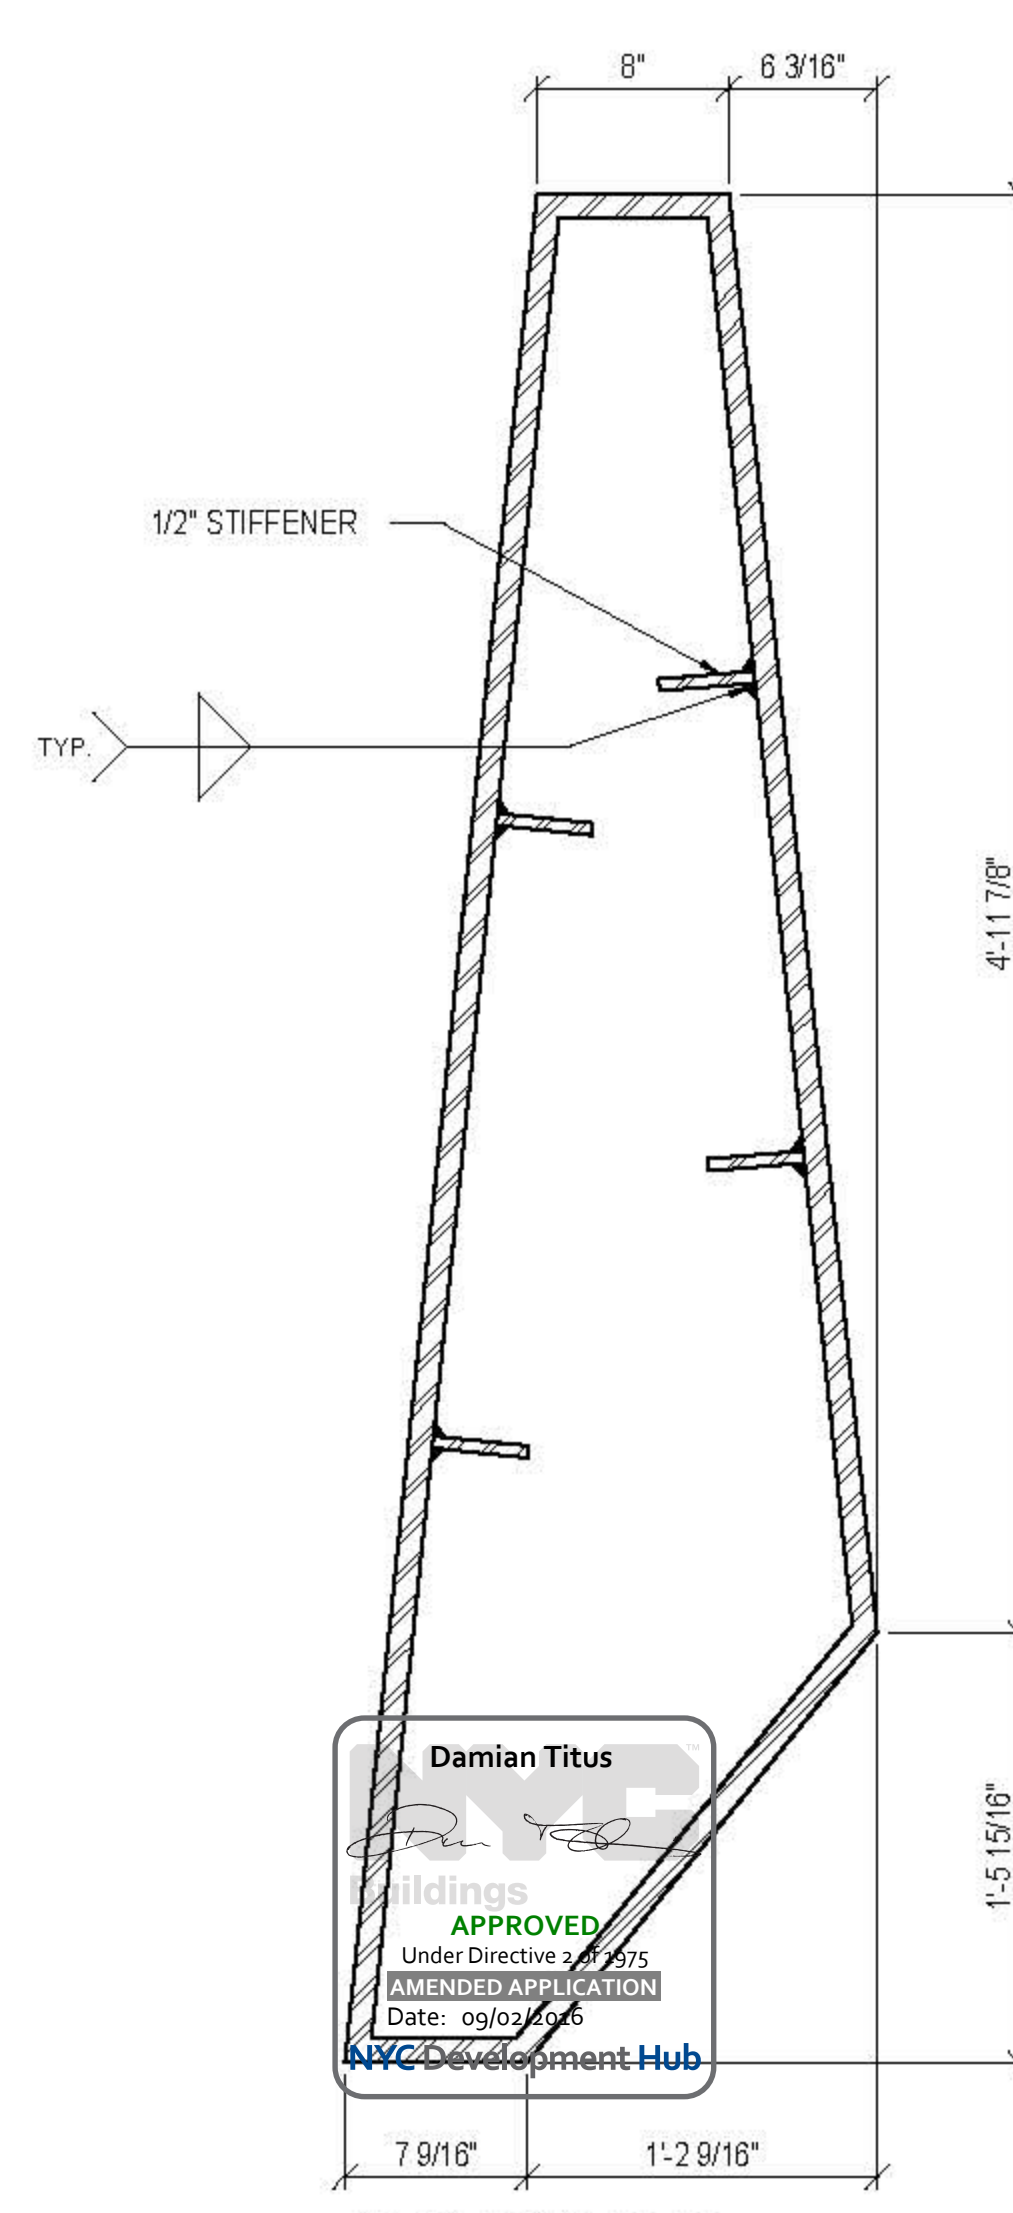

13 SECTION M-M
 1 1/2" = 1'-0"

ALL ATYPICAL SECTIONS SIMILAR TO O.N.
 ALL WELDS FOR ATYPICAL ELEMENTS GROUND FLUSH/SMOOTH TO O.N.

PENDING COORDINATION DURING DESIGN ASSIST.

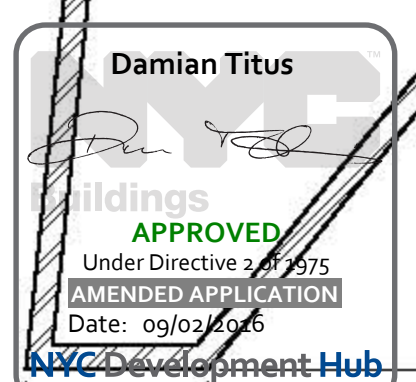

CULTURE SHED

545 West 30th Street
New York, New York 10001

OWNER
CULTURE SHED INC.

ARCHITECTS
Oller Scalfaro + Renfro Architects, P.C.
601 West 30th Street #815
New York, New York 10001
T: 212.260.7971

rockwellgroup
5 Union St. West, 6th Fl.
New York, New York 10003
T: 212.463.0334
F: 212.463.0335

STRUCTURAL ENGINEER
Thornton Tomasetti
51 Madison Avenue
New York, New York 10010
T: 917.661.7800
F: 917.661.7811

MEP ENGINEER
Jans Baum & Bolles
50 Pine Street
New York, New York 10005
T: 212.530.9300
F: 212.266.6944

FAÇADE CONSULTANT
Thornton Tomasetti
51 Madison Avenue
New York, New York 10010
T: 917.661.7800
F: 917.661.7811

KINETICS ENGINEER
Hardess & Hanover
1501 Broadway
New York, New York 10036
T: 212.944.1150
F: 212.391.0297

LIGHTING DESIGNER
Tilston Design Associates
40 North Street #1650
New York, New York 10013
T: 212.675.7760

THEATRE PLANNING & DESIGN
Fisher Dodge Associates
22 West 15th Street
New York, New York 10011
T: 212.691.3000

LIFE SAFETY
Code Consultants, Inc.
215 West 43rd St, 15th Fl.
New York, New York 10018
T: 212.216.9596

ENERGY MODEL/LEED
Vindian
50 Washington Street
Norwalk, CT 06854
T: 203.299.1411

ACOUSTIC/AUDIO-VISUAL
Avalon
50 North Main Street
South Norwalk, CT 06854
T: 347.210.5540

VERTICAL TRANSPORTATION
Van Dusen & Associates
5 Regent Street, Suite 524
Lakewood, NJ 07038
T: 973.994.9220

SPECIFICATIONS
Construction Specifications Inc.
PO Box 489
27 Turrent Road
Morganville, NJ 07751
T: 732.970.0700
F: 732.970.0700


SECURITY
Duchella Venter & Santoro
1100 Sherman Avenue
Hartford, CT 06114
T: 203.286.6490

WATERPROOFING
James R. Gahfort AIA Consulting Architects PC
104 West 27th Street
New York, NY 10001
T: 212.736.3344

FAÇADE MAINTENANCE
Frank Engineering PLLC
156 West Street
New York, NY 10005
T: 212.696.3000

BRANDING GRAPHICS
2nd Global Design Consultancy
180 Varck Street 15th Floor
New York, NY 10014
T: 212.647.1170

KEY PLAN

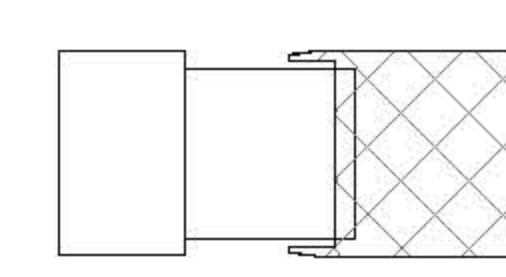

ISSUE PRINTING DATE

ISSUE	PRINTING	DATE	
03	60	DOB AMENDMENT 7	03/19/2016
04	30	DOB AMENDMENT 6	04/02/2016
21		CONSTRUCTION SET	10/08/2015
10	4	100% CONSTRUCTION DOCUMENTS	03/18/2015
9		90% CONSTRUCTION DOCUMENTS	02/16/2015
6		PRELIMINARY JOB SUBMISSION	12/10/2014
1		ADVANCED PROCUREMENT BID SET	06/16/2014

STAMP



DRAWN BY
Autmy

CHECKED BY
Chris

PROJECT NUMBER
N11318.00


TITLE
DEPLOYED SHED NORTH/SOUTH WALL-
TERTIARY ELEMENTS

DRAWING NO.
S-758.01


B.SCAN NO.
S-758.01

95 of 123

GEOMETRY, DIMENSIONS AND SURFACE CONTOURING, BLENDING AND INTERSECTION OF SECTIONS ILLUSTRATED IN THE STRUCTURAL DRAWINGS ARE PROVIDED FOR REFERENCE AND GENERATION OF STRUCTURAL ARRANGEMENT AND DETAILS ONLY. THE 3D MODEL ISSUED BY THE ARCHITECT DETERMINES THE EXTERIOR SURFACE AND SHALL BE ADHERED TO FOR THE FINAL GEOMETRY. FOR DETAILS OF SECONDARY STEEL, INCLUDING STRUCTURAL CLADDING REFER TO ARCHITECTURE DRAWINGS. IT IS THE RESPONSIBILITY OF THE CONTRACTOR TO IDENTIFY ANY DISCREPANCIES OR AMBIGUITIES FOR DISCUSSION, RESOLUTION AND DIRECTION FROM THE ARCHITECT AND SER.

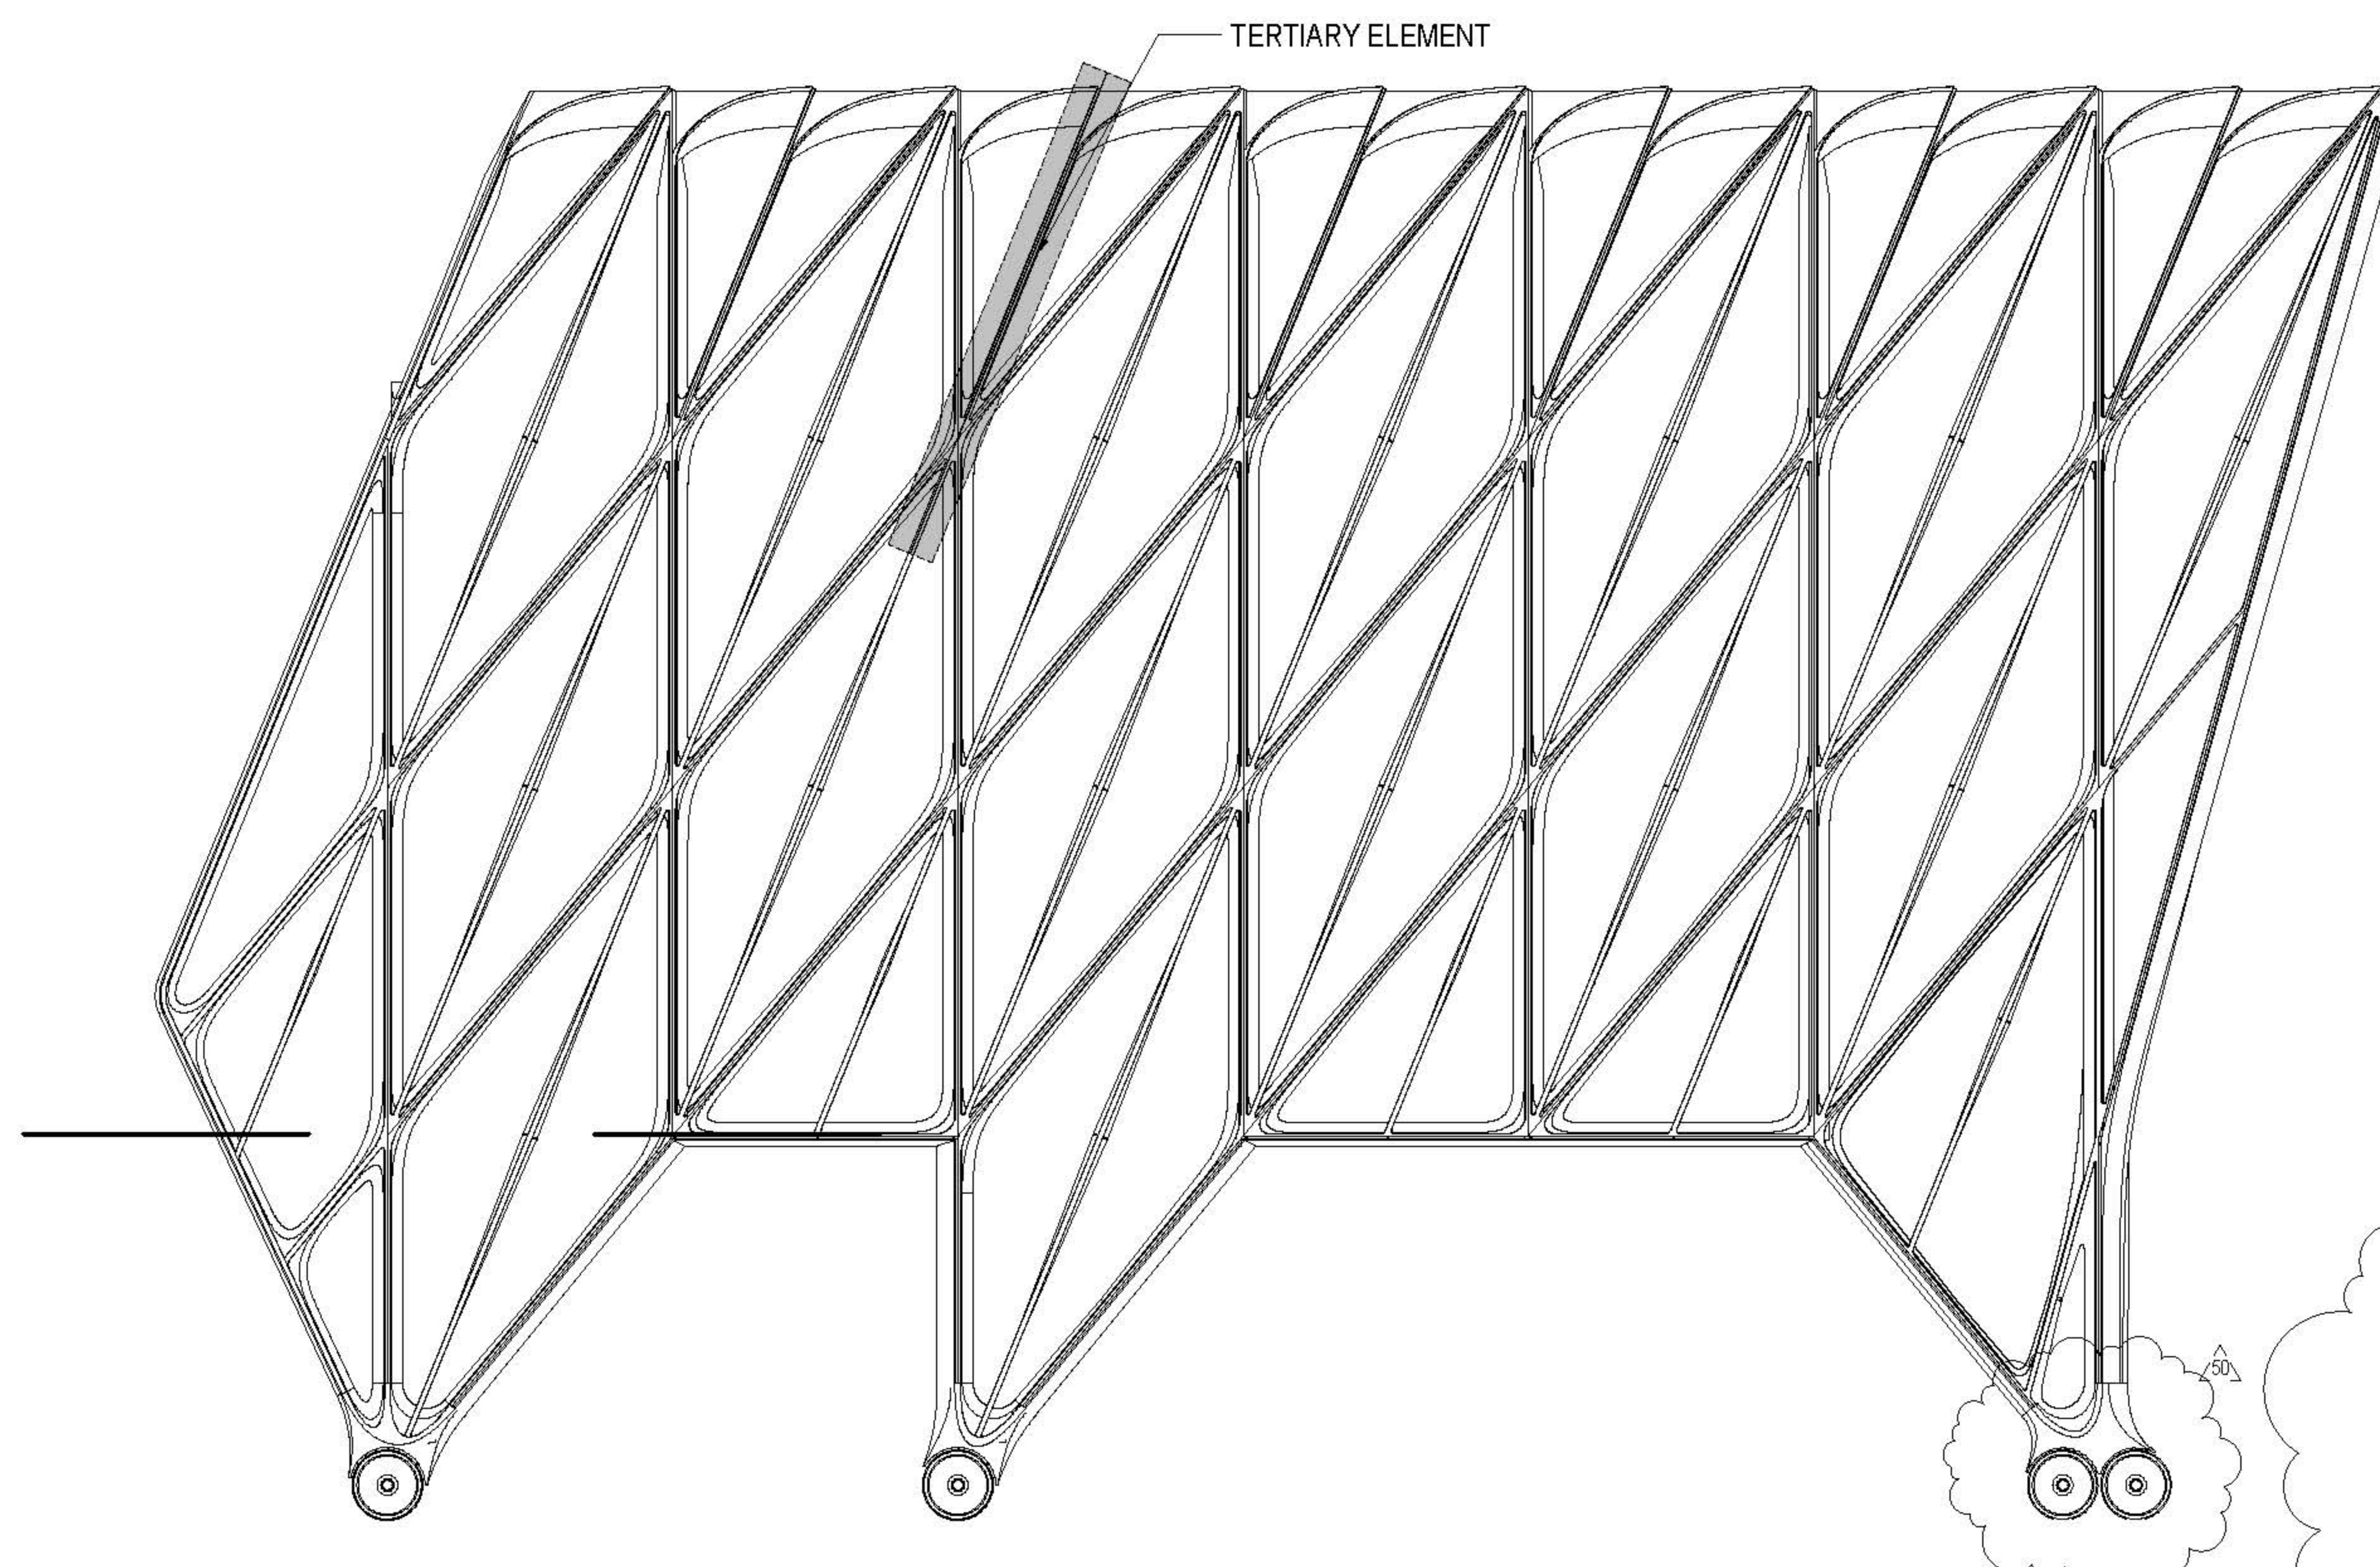


1 SOUTH ELEVATION2
3/32" = 1'-0"

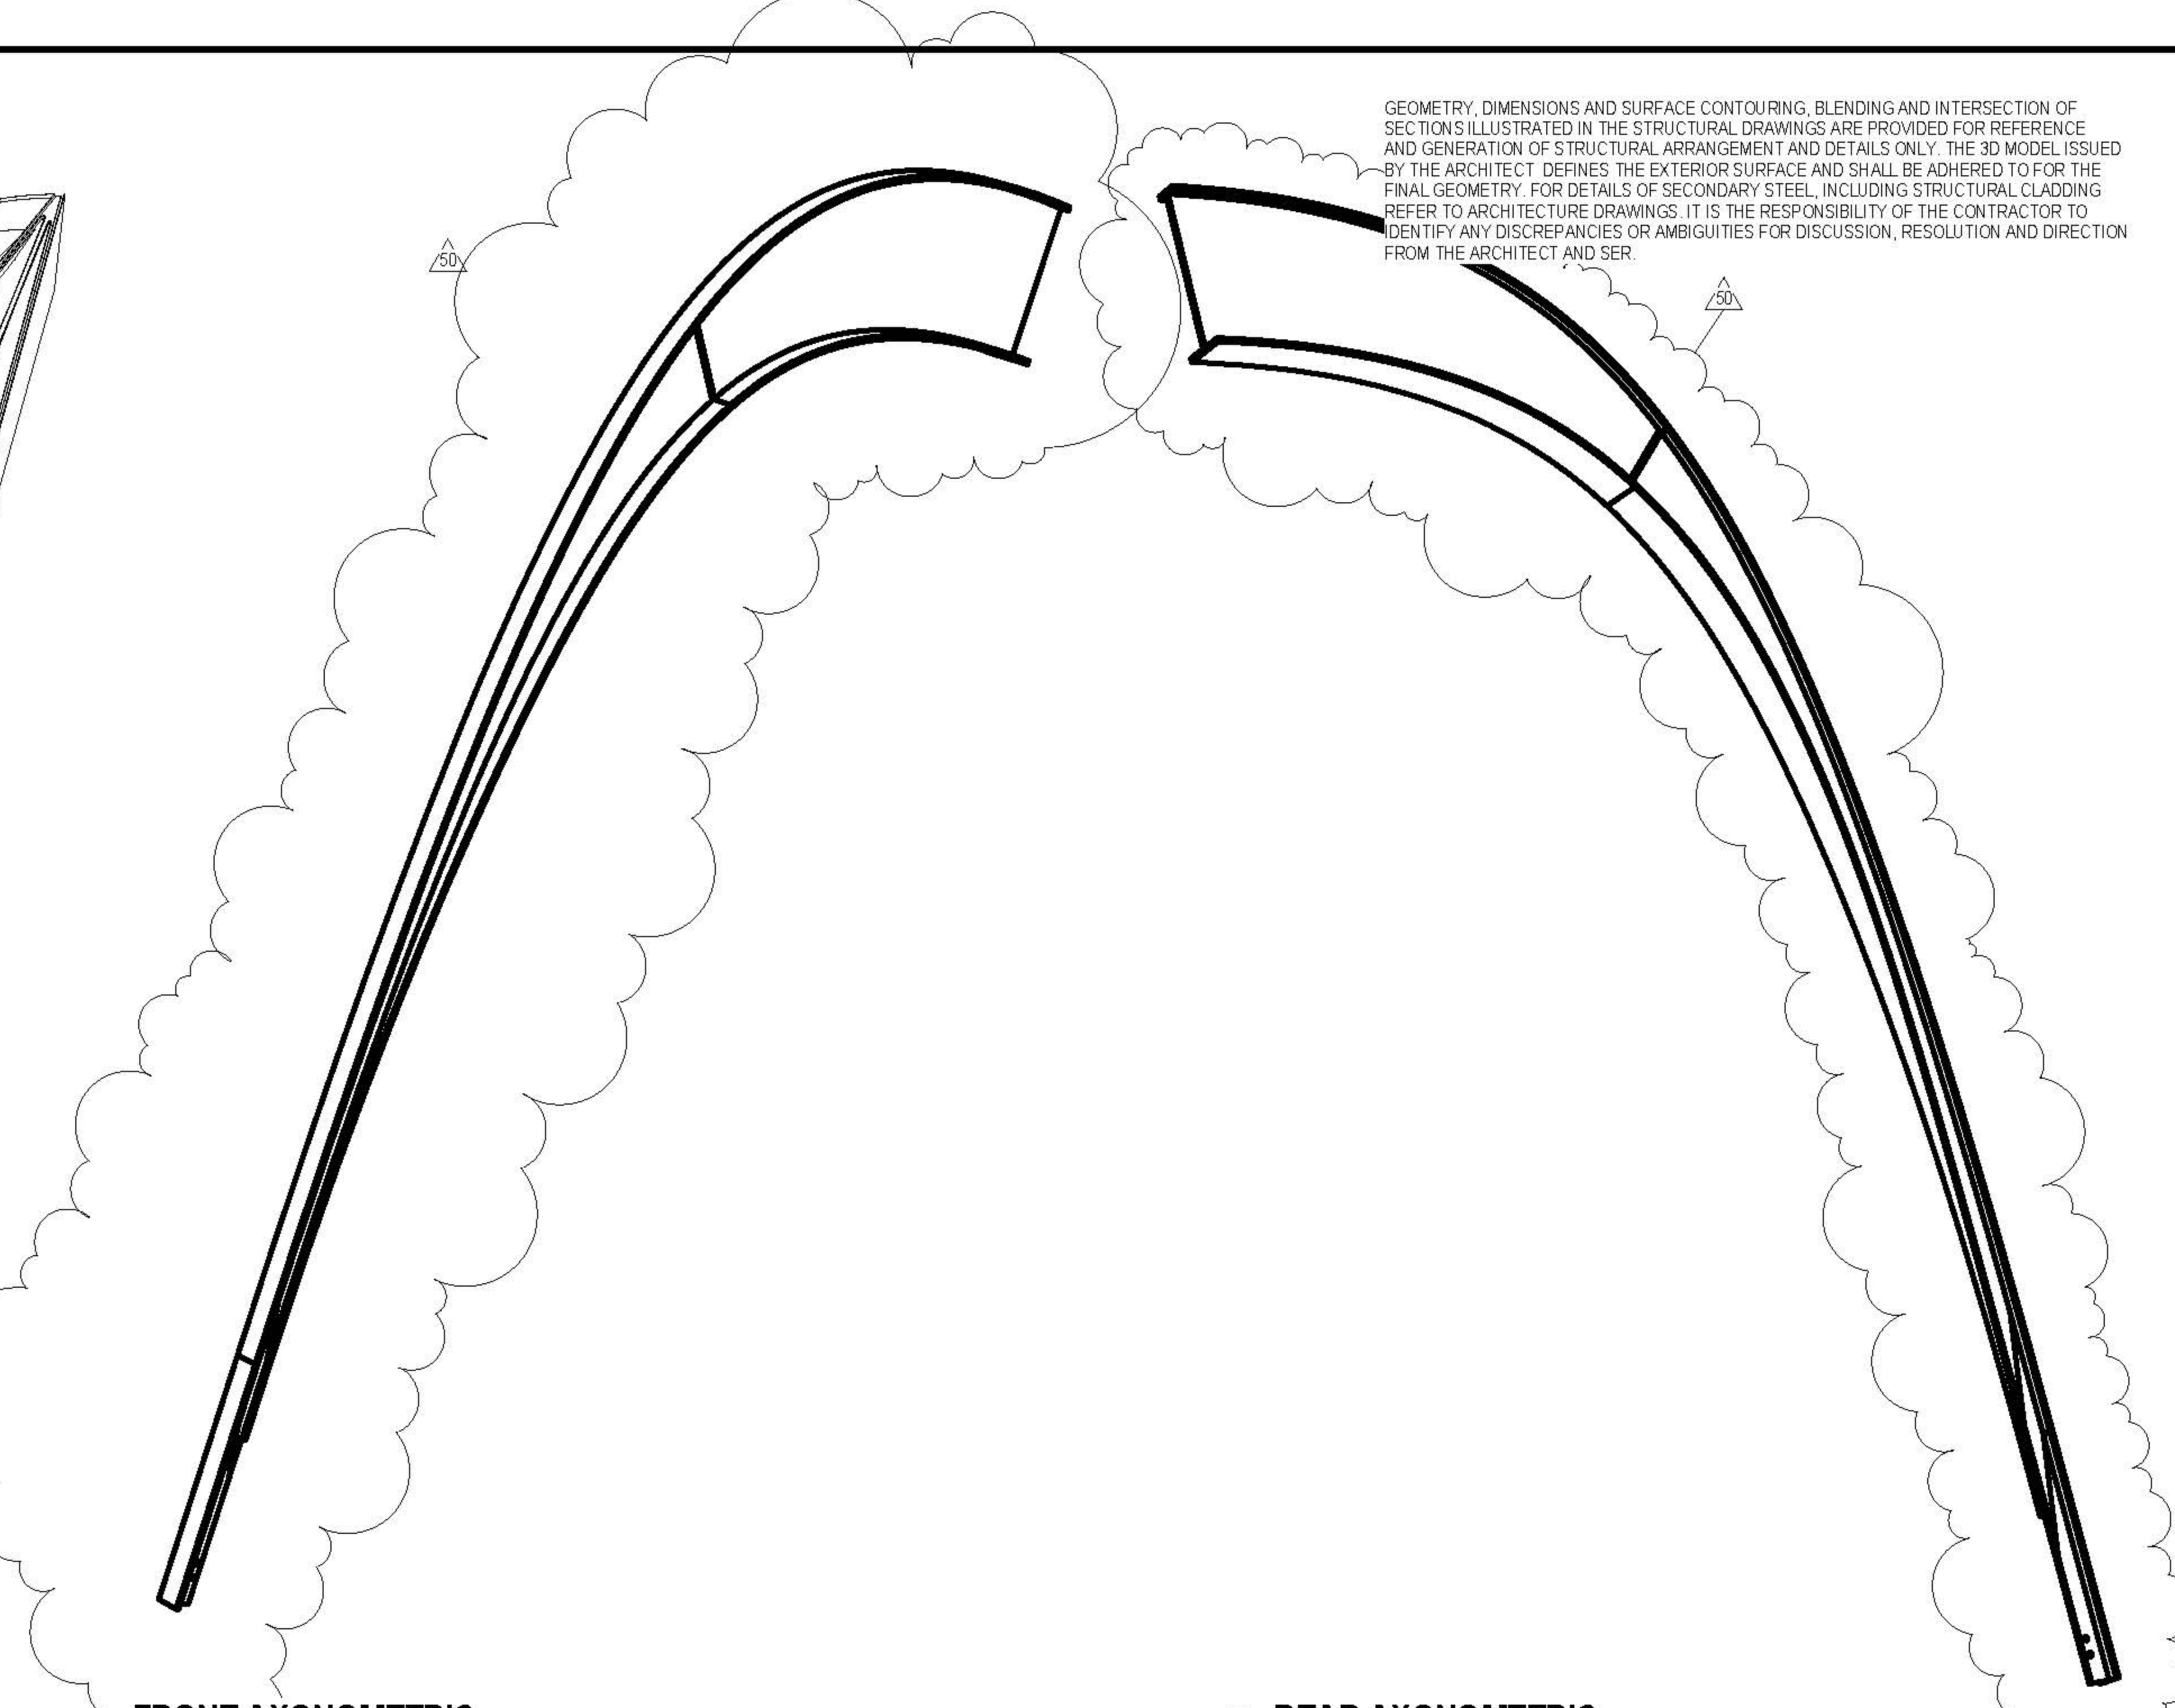


2 FRONT AXONOMETRIC
1/2" = 1'-0"


3 REAR AXONOMETRIC
1/2" = 1'-0"

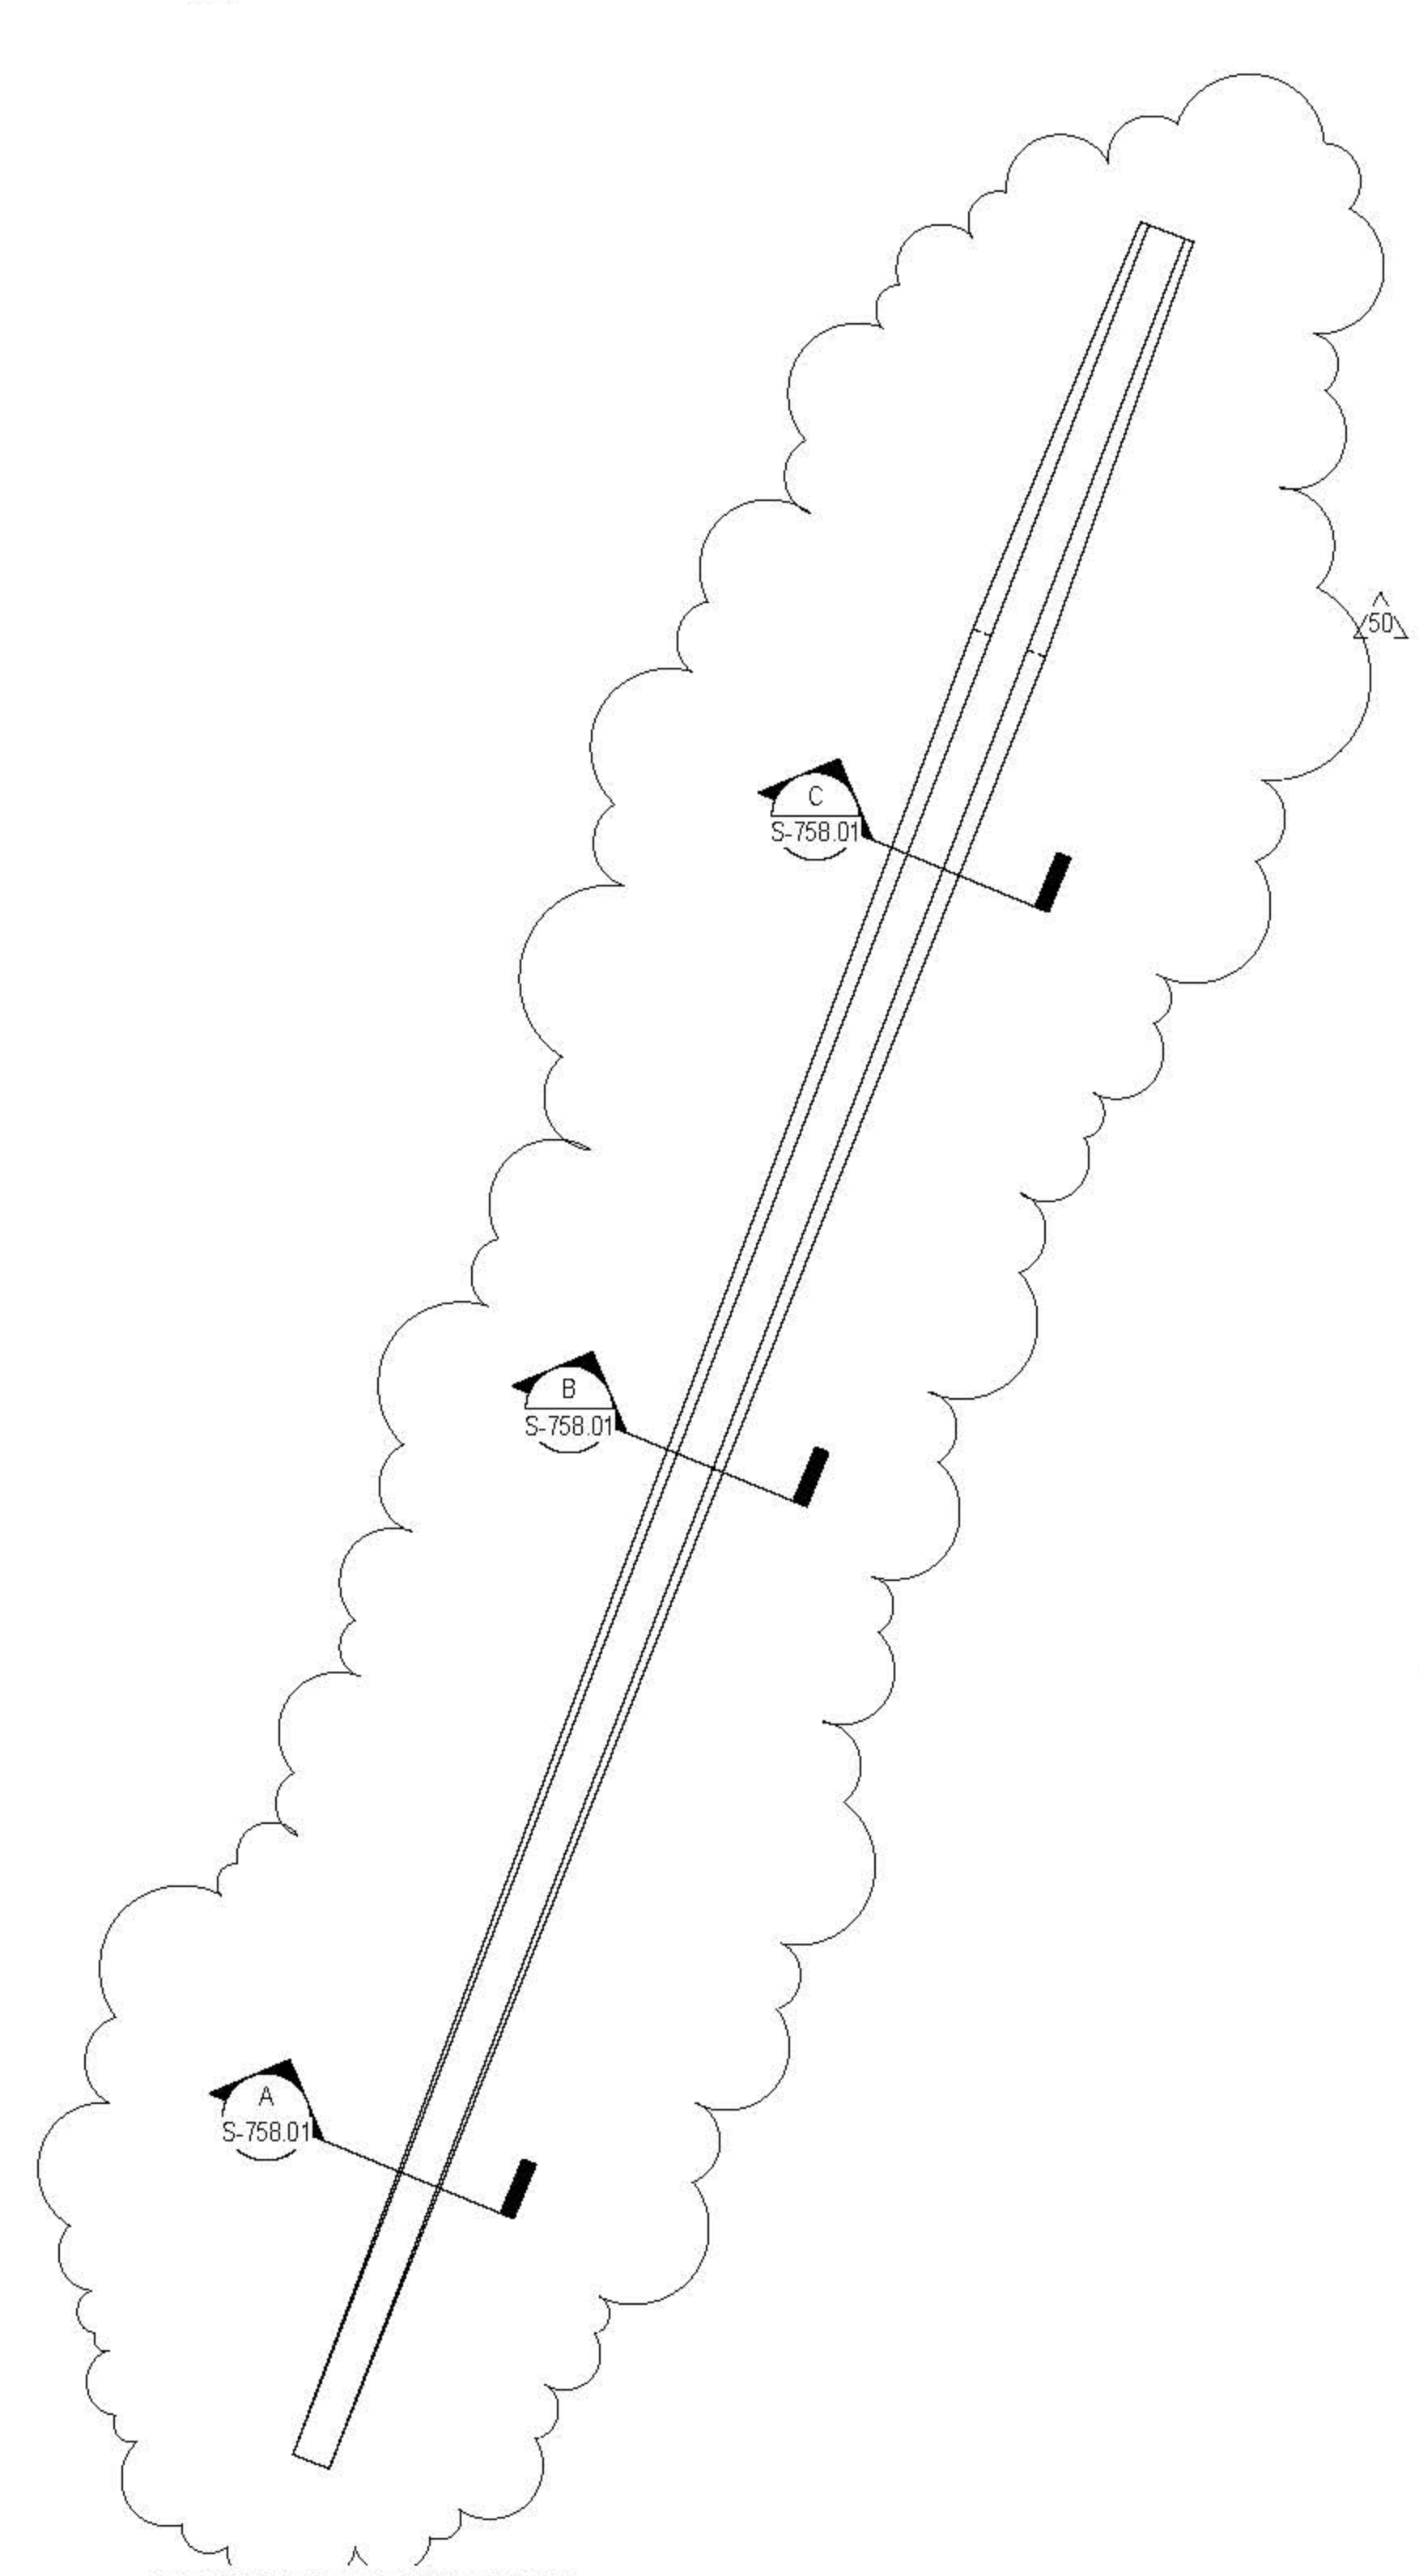


4 FRONT ELEVATION
1/2" = 1'-0"

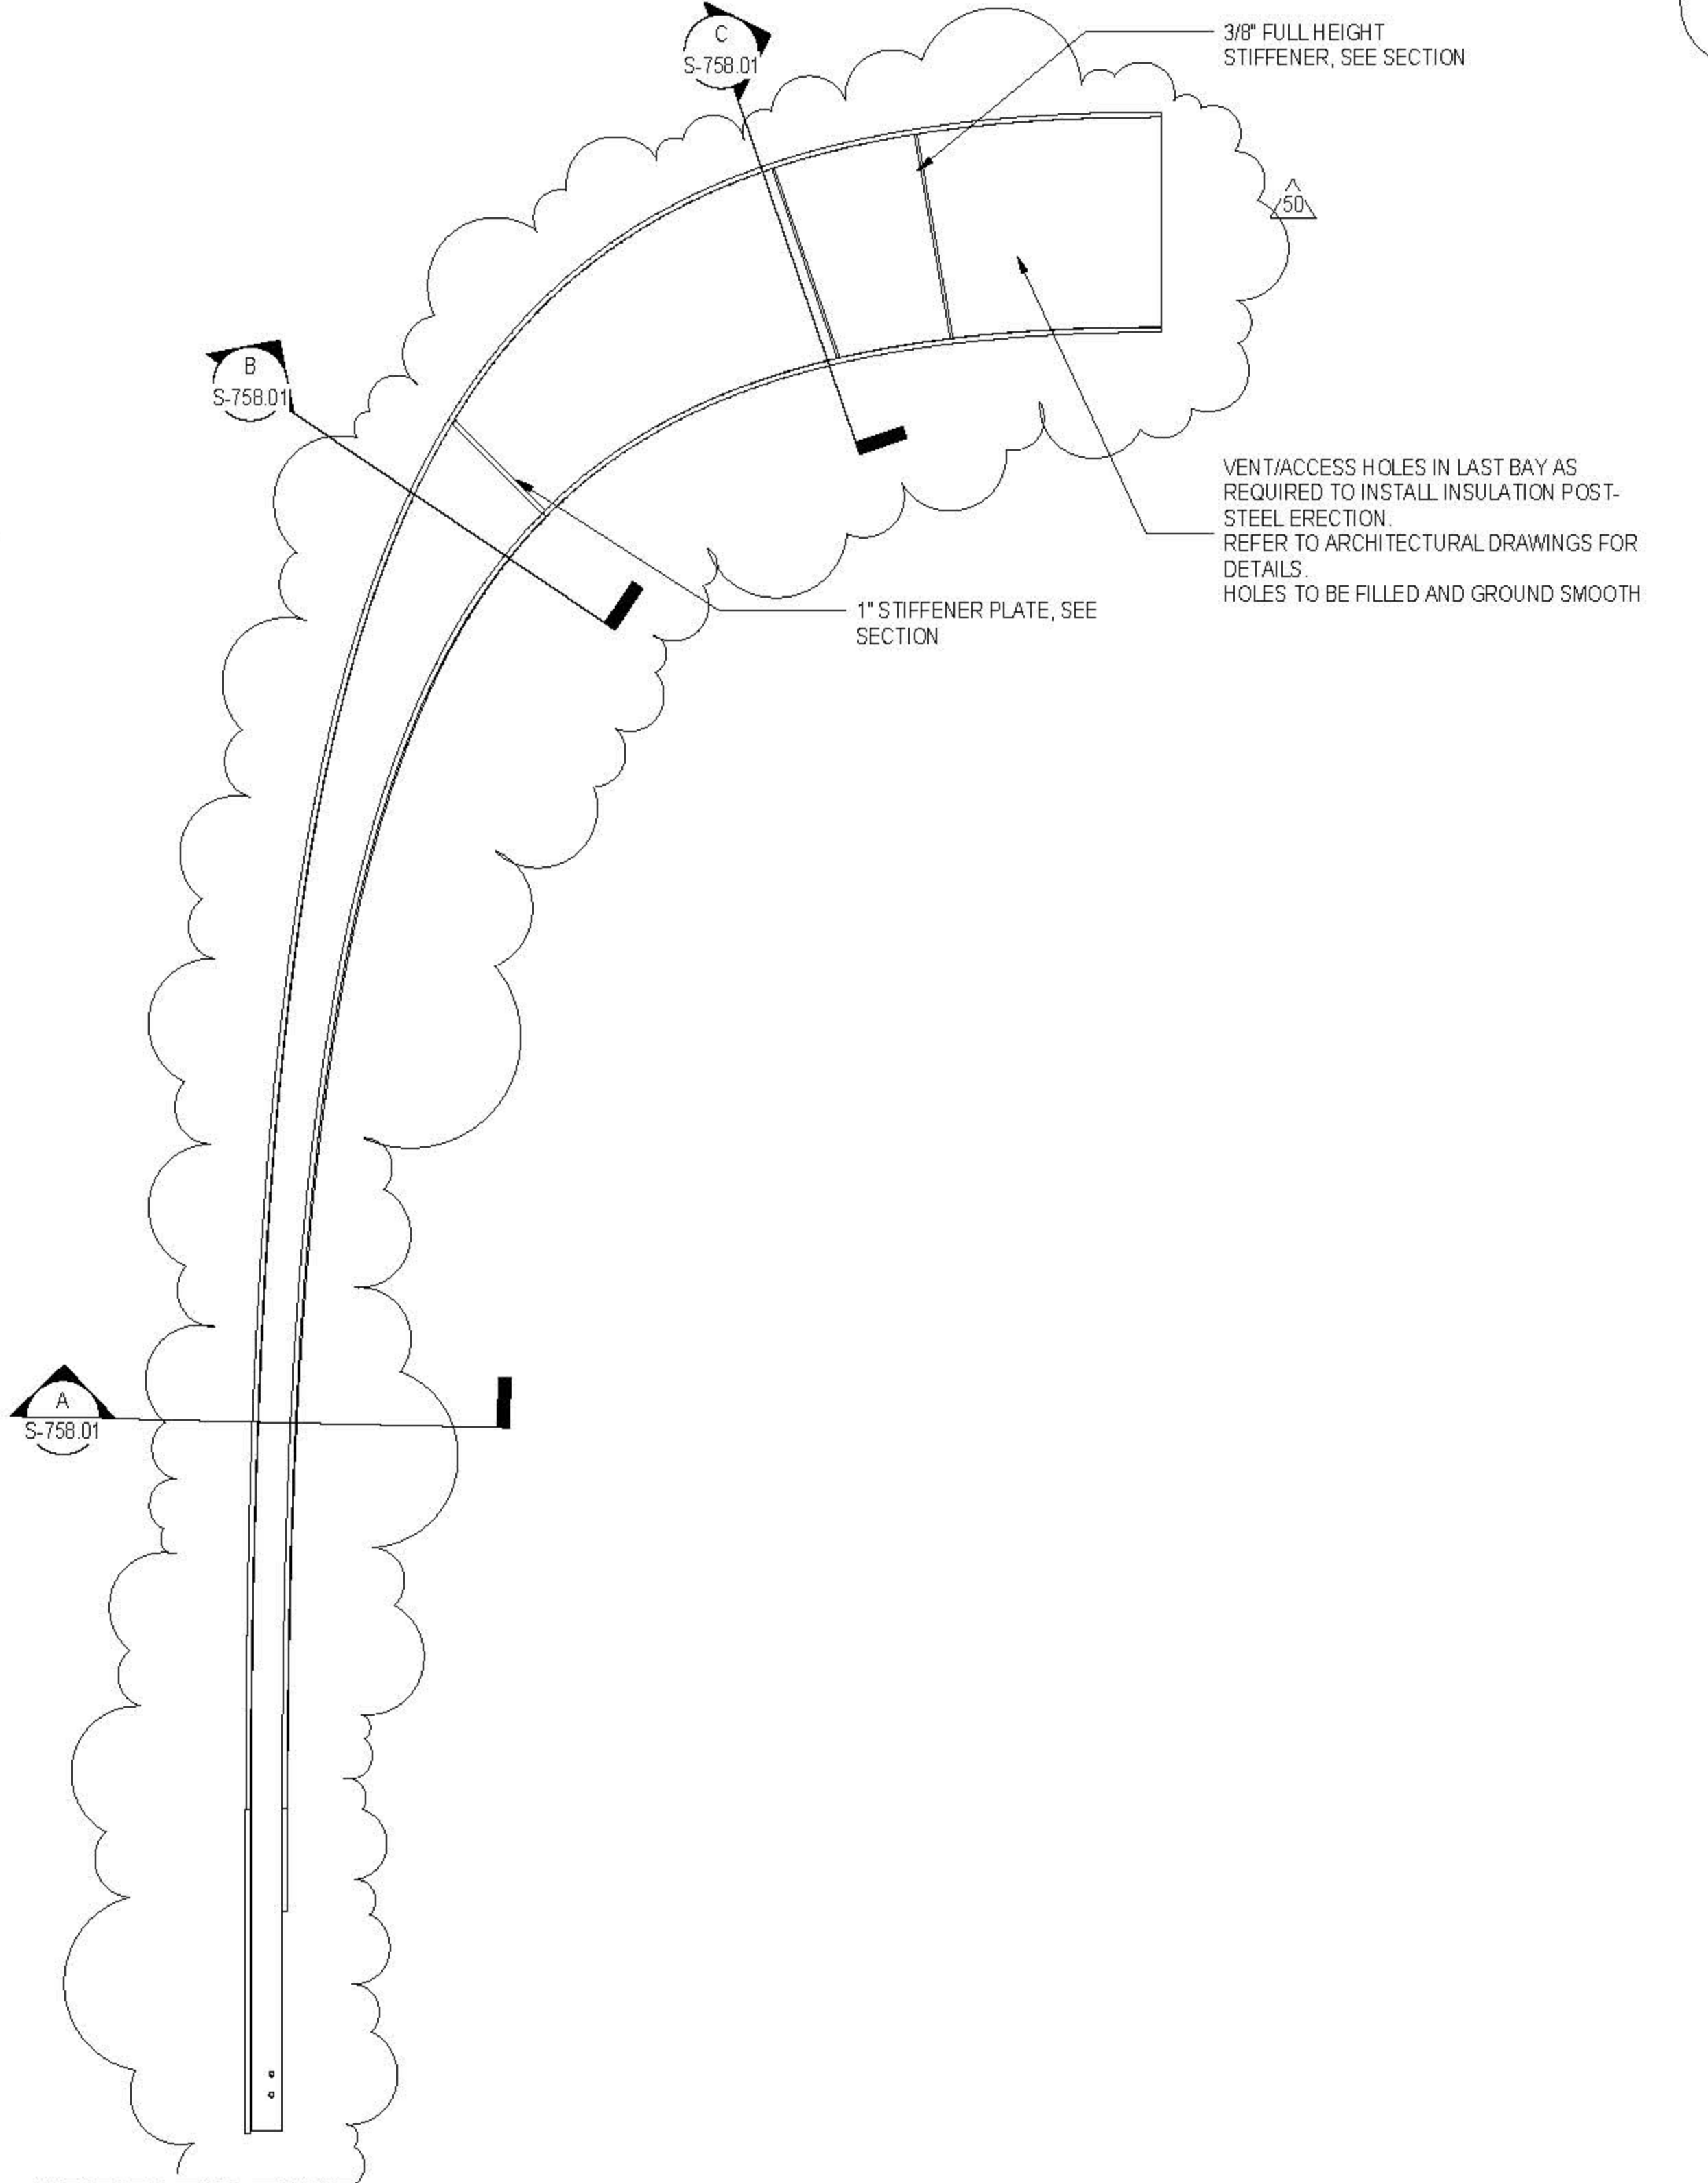


5 SIDE ELEVATION
1/2" = 1'-0"

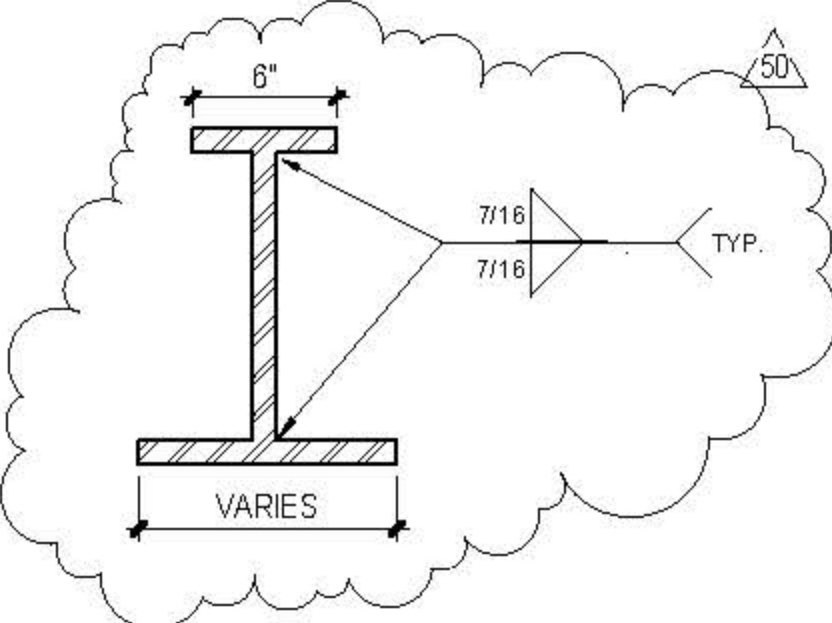

A SECTION AA
1 1/2" = 1'-0"

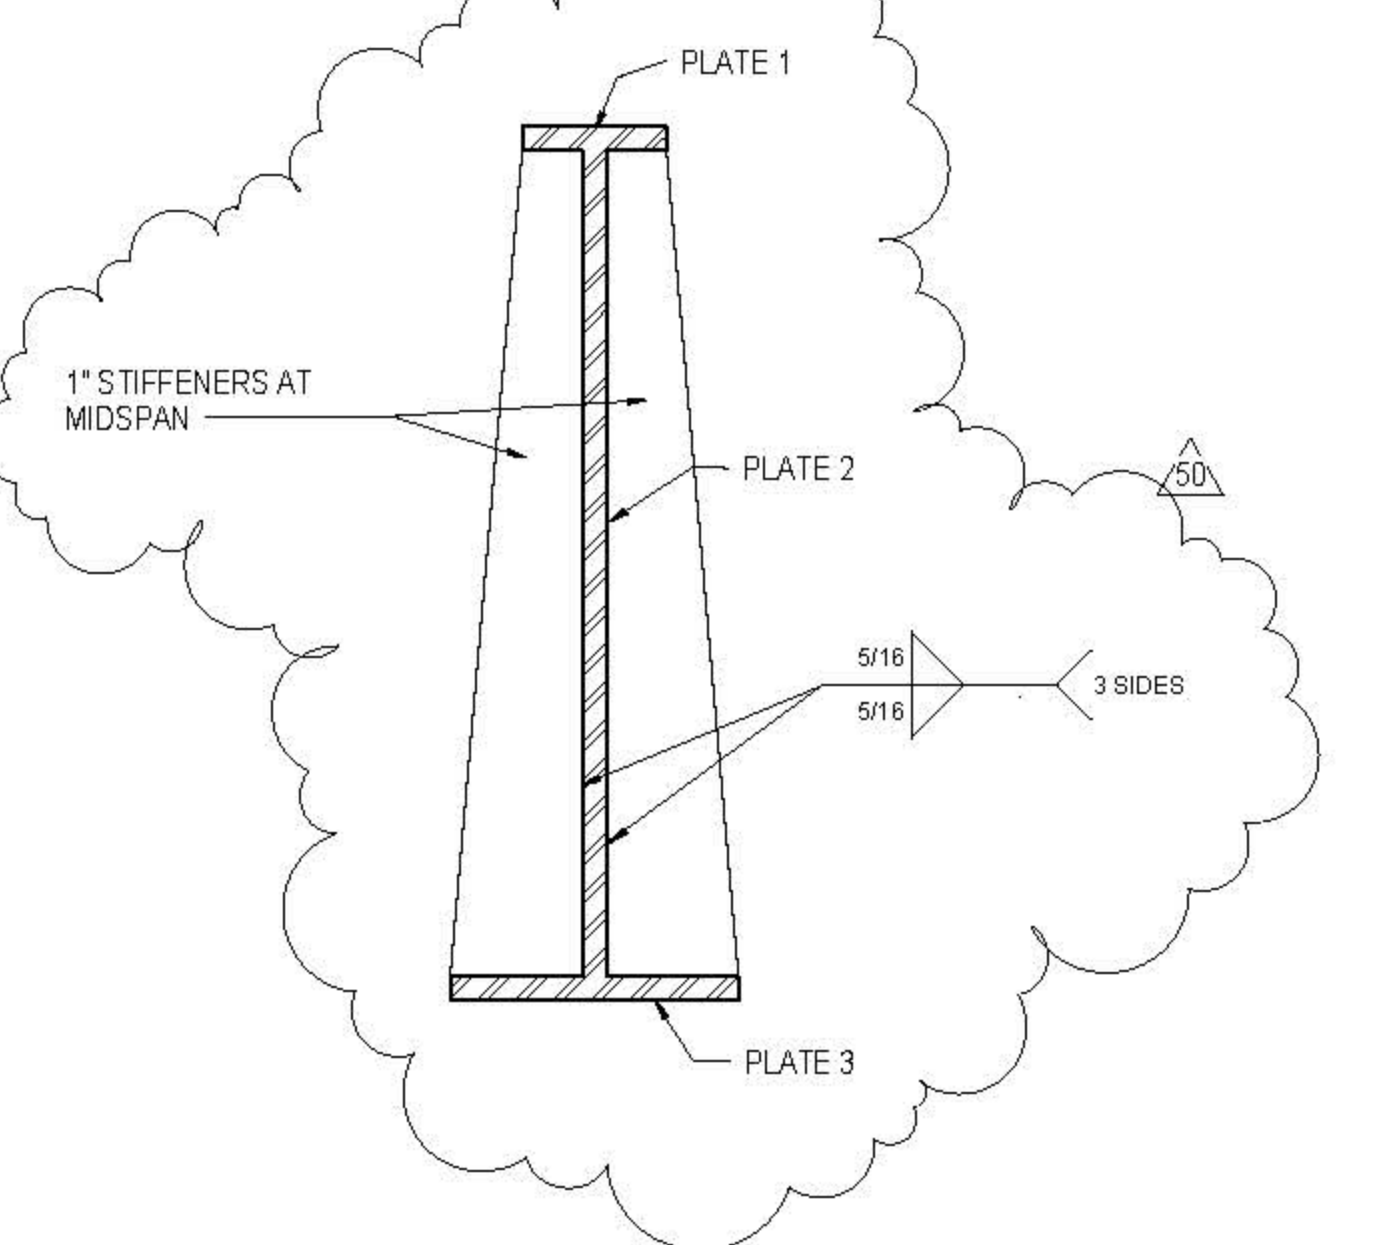

B SECTION BB
1 1/2" = 1'-0"

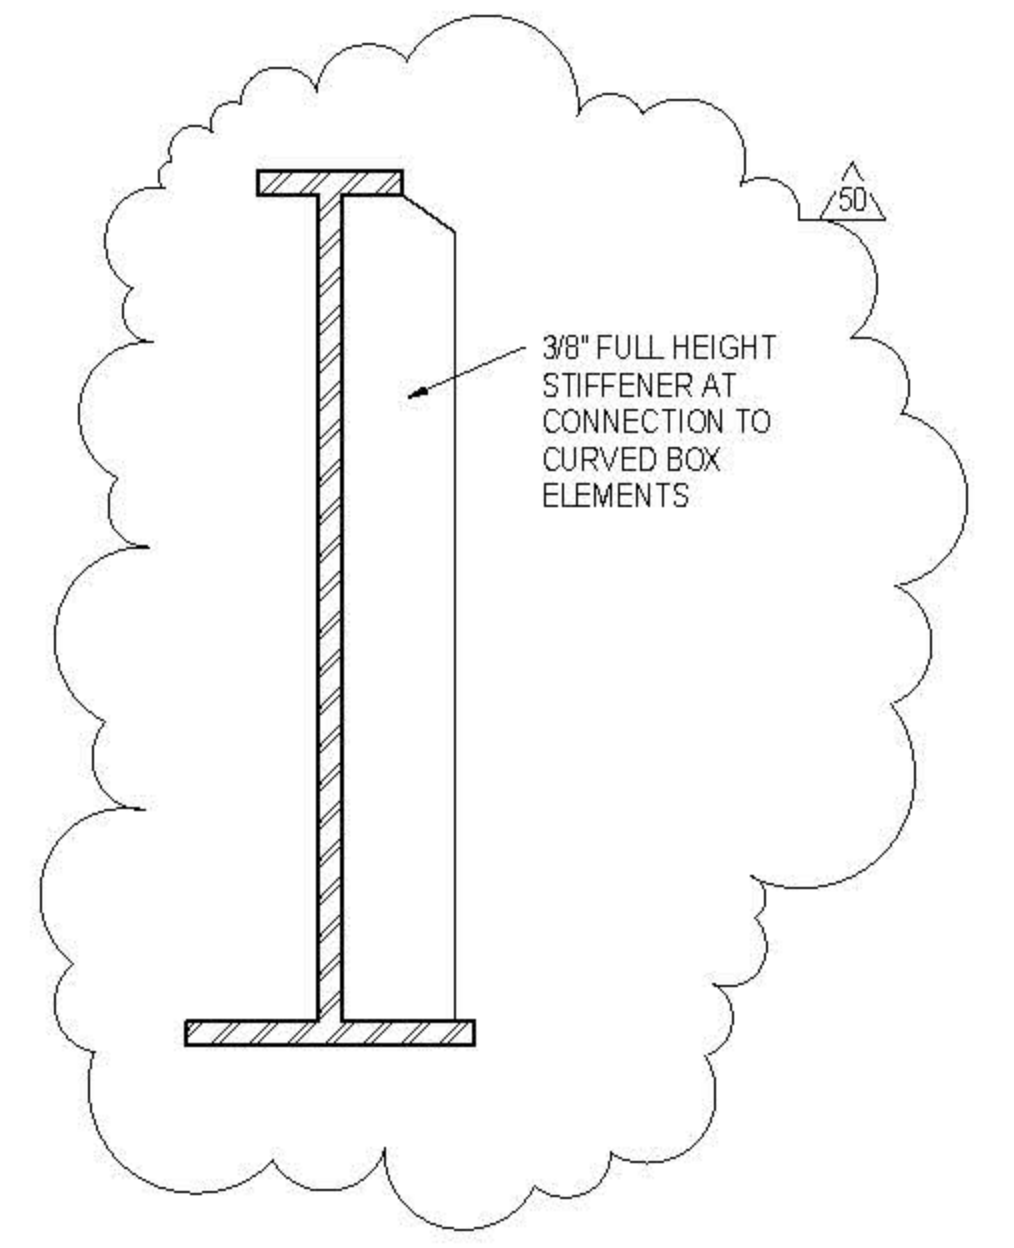


C SECTION CC
1 1/2" = 1'-0"

CATEGORY I CORNERS: ALL CORNERS MARKED CATEGORY I TO HAVE A SHARP CONTINUOUS EDGE WITH STRAIGHTNESS TO WITHIN +/- .116"
ALL CORNERS MAY HAVE A 0.08" RADIUS

1) EXPOSED EDGE WITH CONTINUOUS AND CONSISTENT FINISH REQUIRED, EVEN ACROSS SPLICES FOR NODE WELD DETAILS SEE DRAWING S-755

PENDING COORDINATION DURING DESIGN ASSIST.

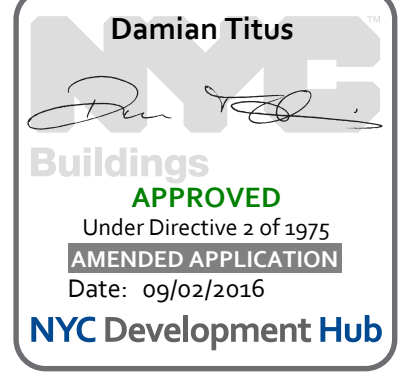

CULTURE SHED
545 West 30th Street
New York, New York 10001
OWNER: CULTURE SHED INC.

GEOMETRY, DIMENSIONS AND SURFACE CONTOURING, BLENDING AND INTERSECTION OF SECTIONS ILLUSTRATED IN THE STRUCTURAL DRAWINGS ARE PROVIDED FOR REFERENCE AND GENERATION OF STRUCTURAL ARRANGEMENT AND DETAILS ONLY. THE 3D MODEL ISSUED BY THE ARCHITECT DEFINES THE EXTERIOR SURFACE AND SHALL BE ADHERED TO FOR THE FINAL GEOMETRY. FOR DETAILS OF SECONDARY STEEL, INCLUDING STRUCTURAL CLADDING REFER TO ARCHITECTURE DRAWINGS. IT IS THE RESPONSIBILITY OF THE CONTRACTOR TO IDENTIFY ANY DISCREPANCIES OR AMBIGUITIES FOR DISCUSSION, RESOLUTION AND DIRECTION FROM THE ARCHITECT AND SER.

ARCHITECTS
Oller Scalfaro + Renfro Architects, DPC
601 West 26 Street #815
New York, New York 10001
T: 212.260.7971

rockwellgroup
6 Union St. West, 6th Fl.
New York, New York 10003
T: 212.463.0334
F: 212.463.0335

STRUCTURAL ENGINEER
Thornton Tomasetti
51 Madison Avenue
New York, New York 10010
T: 917.661.7800
F: 917.661.7801

MEP ENGINEER
Jawa Baum & Bolles
60 Pine Street
New York, New York 10005
T: 212.530.9300
F: 212.265.6944

FACADE CONSULTANT
Thornton Tomasetti
51 Madison Avenue
New York, New York 10010
T: 917.661.7800
F: 917.661.7801

KINETICS ENGINEER
Hardsley & Hannon
1501 Broadway
New York, New York 10036
T: 212.944.1150
F: 212.391.0297

LIGHTING DESIGNER
Tilston Design Associates
40 North Street #160
New York, New York 10013
T: 212.675.7760

THEATRE PLANNING & DESIGN
Fisher Dodge Associates
22 West 15th Street
New York, New York 10011
T: 212.691.3000

LIFE SAFETY
Code Consultants, Inc.
215 West 43rd St, 15th Fl.
New York, New York 10018
T: 212.216.9596

ENERGY MODEL/LEED
Vindian
60 Washington Street
Norwalk, CT 06854
T: 203.298.1411

ACOUSTIC/AUDIO-VISUAL
Acoustic
93 North Main Street
South Norwalk, CT 06854
T: 347.210.5540

VERTICAL TRANSPORTATION
Van Duusen & Associates
5 Regent Street, Suite 524
Lakewood, NJ 07038
T: 973.994.9220

SPECIFICATIONS
Construction Specifications Inc.
PO Box 489
227 Emmet Road
Morganville, NJ 07751
T: 732.970.0700
F: 732.970.0700


SECURITY
Duchella Venter & Santoro
1020 Sherman Avenue
Hartford, CT 06114
T: 203.286.6490

WATERPROOFING
James R. Galtfort AIA Consulting Architects PC
104 West 27th Street
New York, NY 10001
T: 212.736.3344

FACADE MAINTENANCE
Frank Engineering PLLC
166 Ave. Street
New York, NY 10005
T: 212.698.3000

BRANDING/GRAPHICS
2nd Global Design Consultancy
180 Varck Street 15th Floor
New York, NY 10014
T: 212.647.1170

KEY PLAN

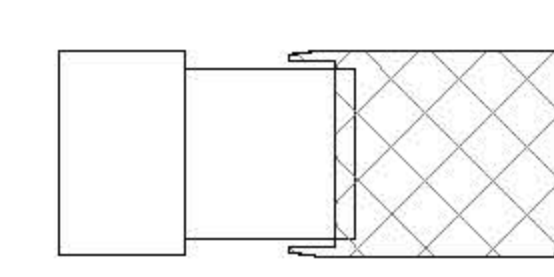

ISSUE	PRINTING	DATE	
03	60	DOB AMENDMENT 7	08.29.2016
04	30	DOB AMENDMENT 6	04.02.2016
21		CONSTRUCTION SET	10.08.2015
10	4	100% CONSTRUCTION DOCUMENTS	03.18.2015
9		90% CONSTRUCTION DOCUMENTS	02.16.2015
6		PRELIMINARY JOB SUBMISSION	12.16.2014
1		ADVANCED PROCUREMENT BID SET	06.16.2014

STAMP



DRAWN BY
Autmy


CHECKED BY
Chrismy

PROJECT NUMBER
N11318.00


TITLE
DETAILS, DEPLOYED SHED NORTH/SOUTH WALL - CURVED SECTIONS

DRAWING NO.
S-760.01


B-SCAN NO.
S-760.01

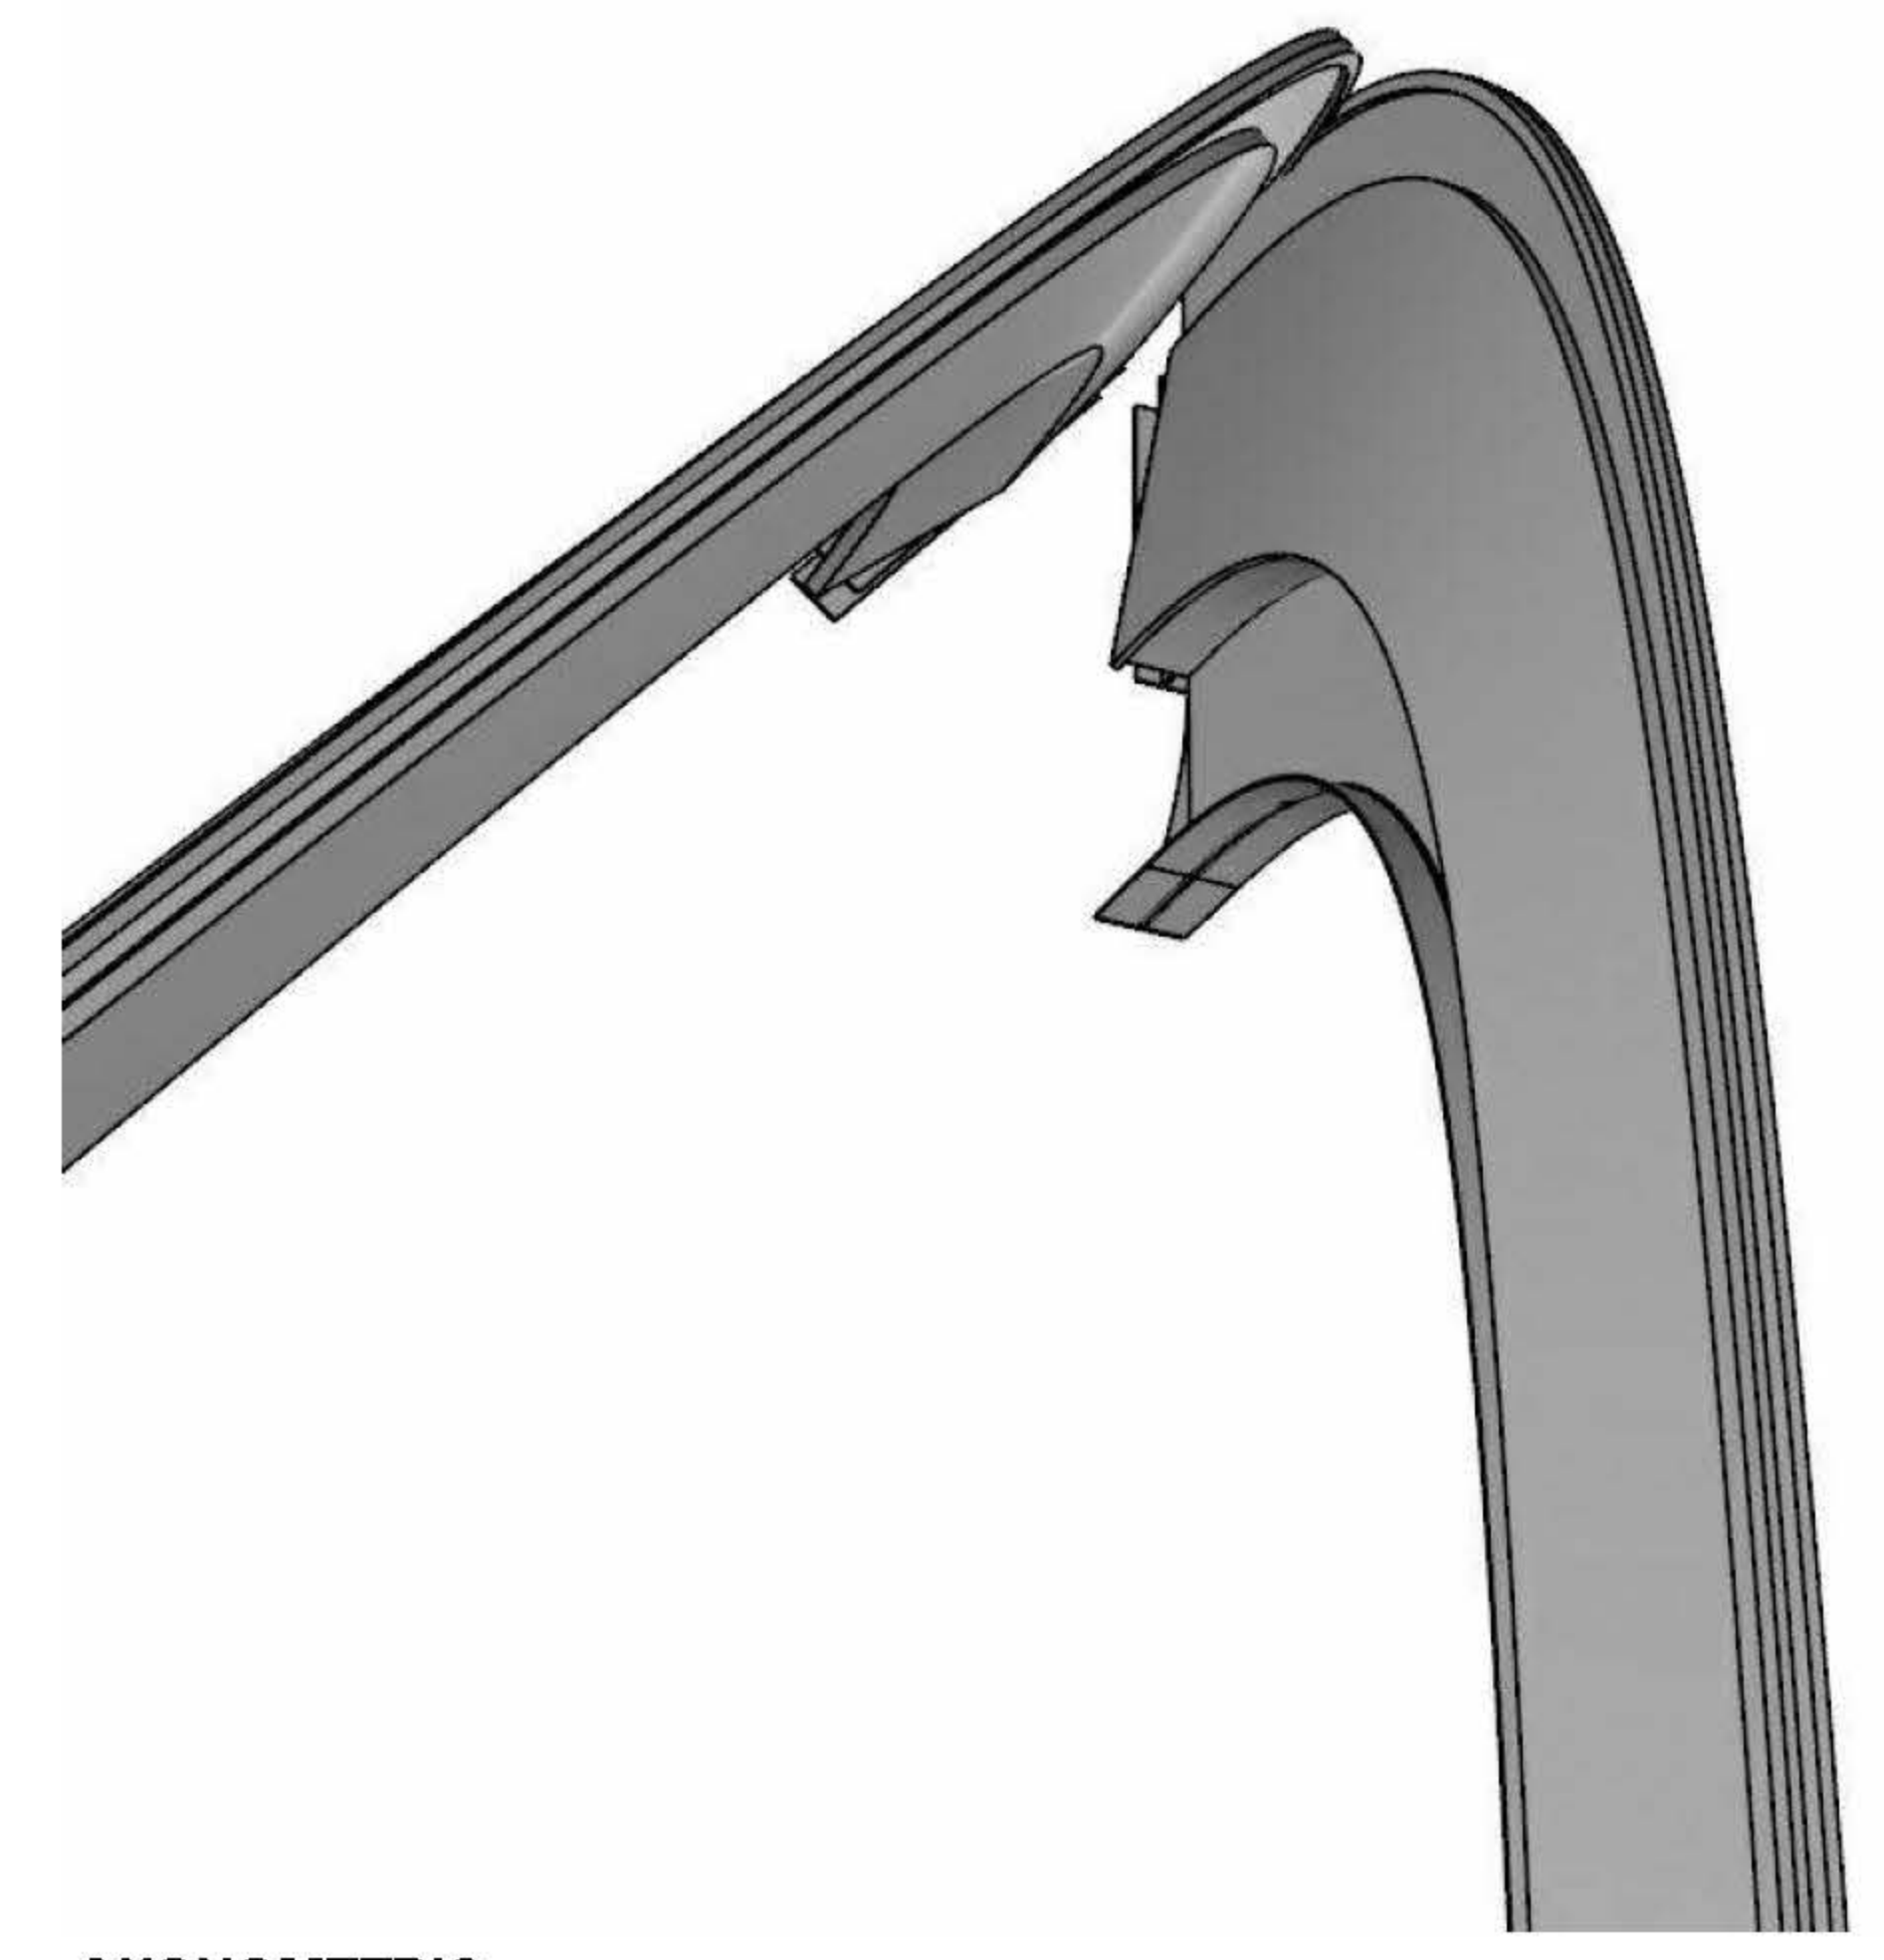


2 AXONOMETRIC
1 1/2" = 1'-0"

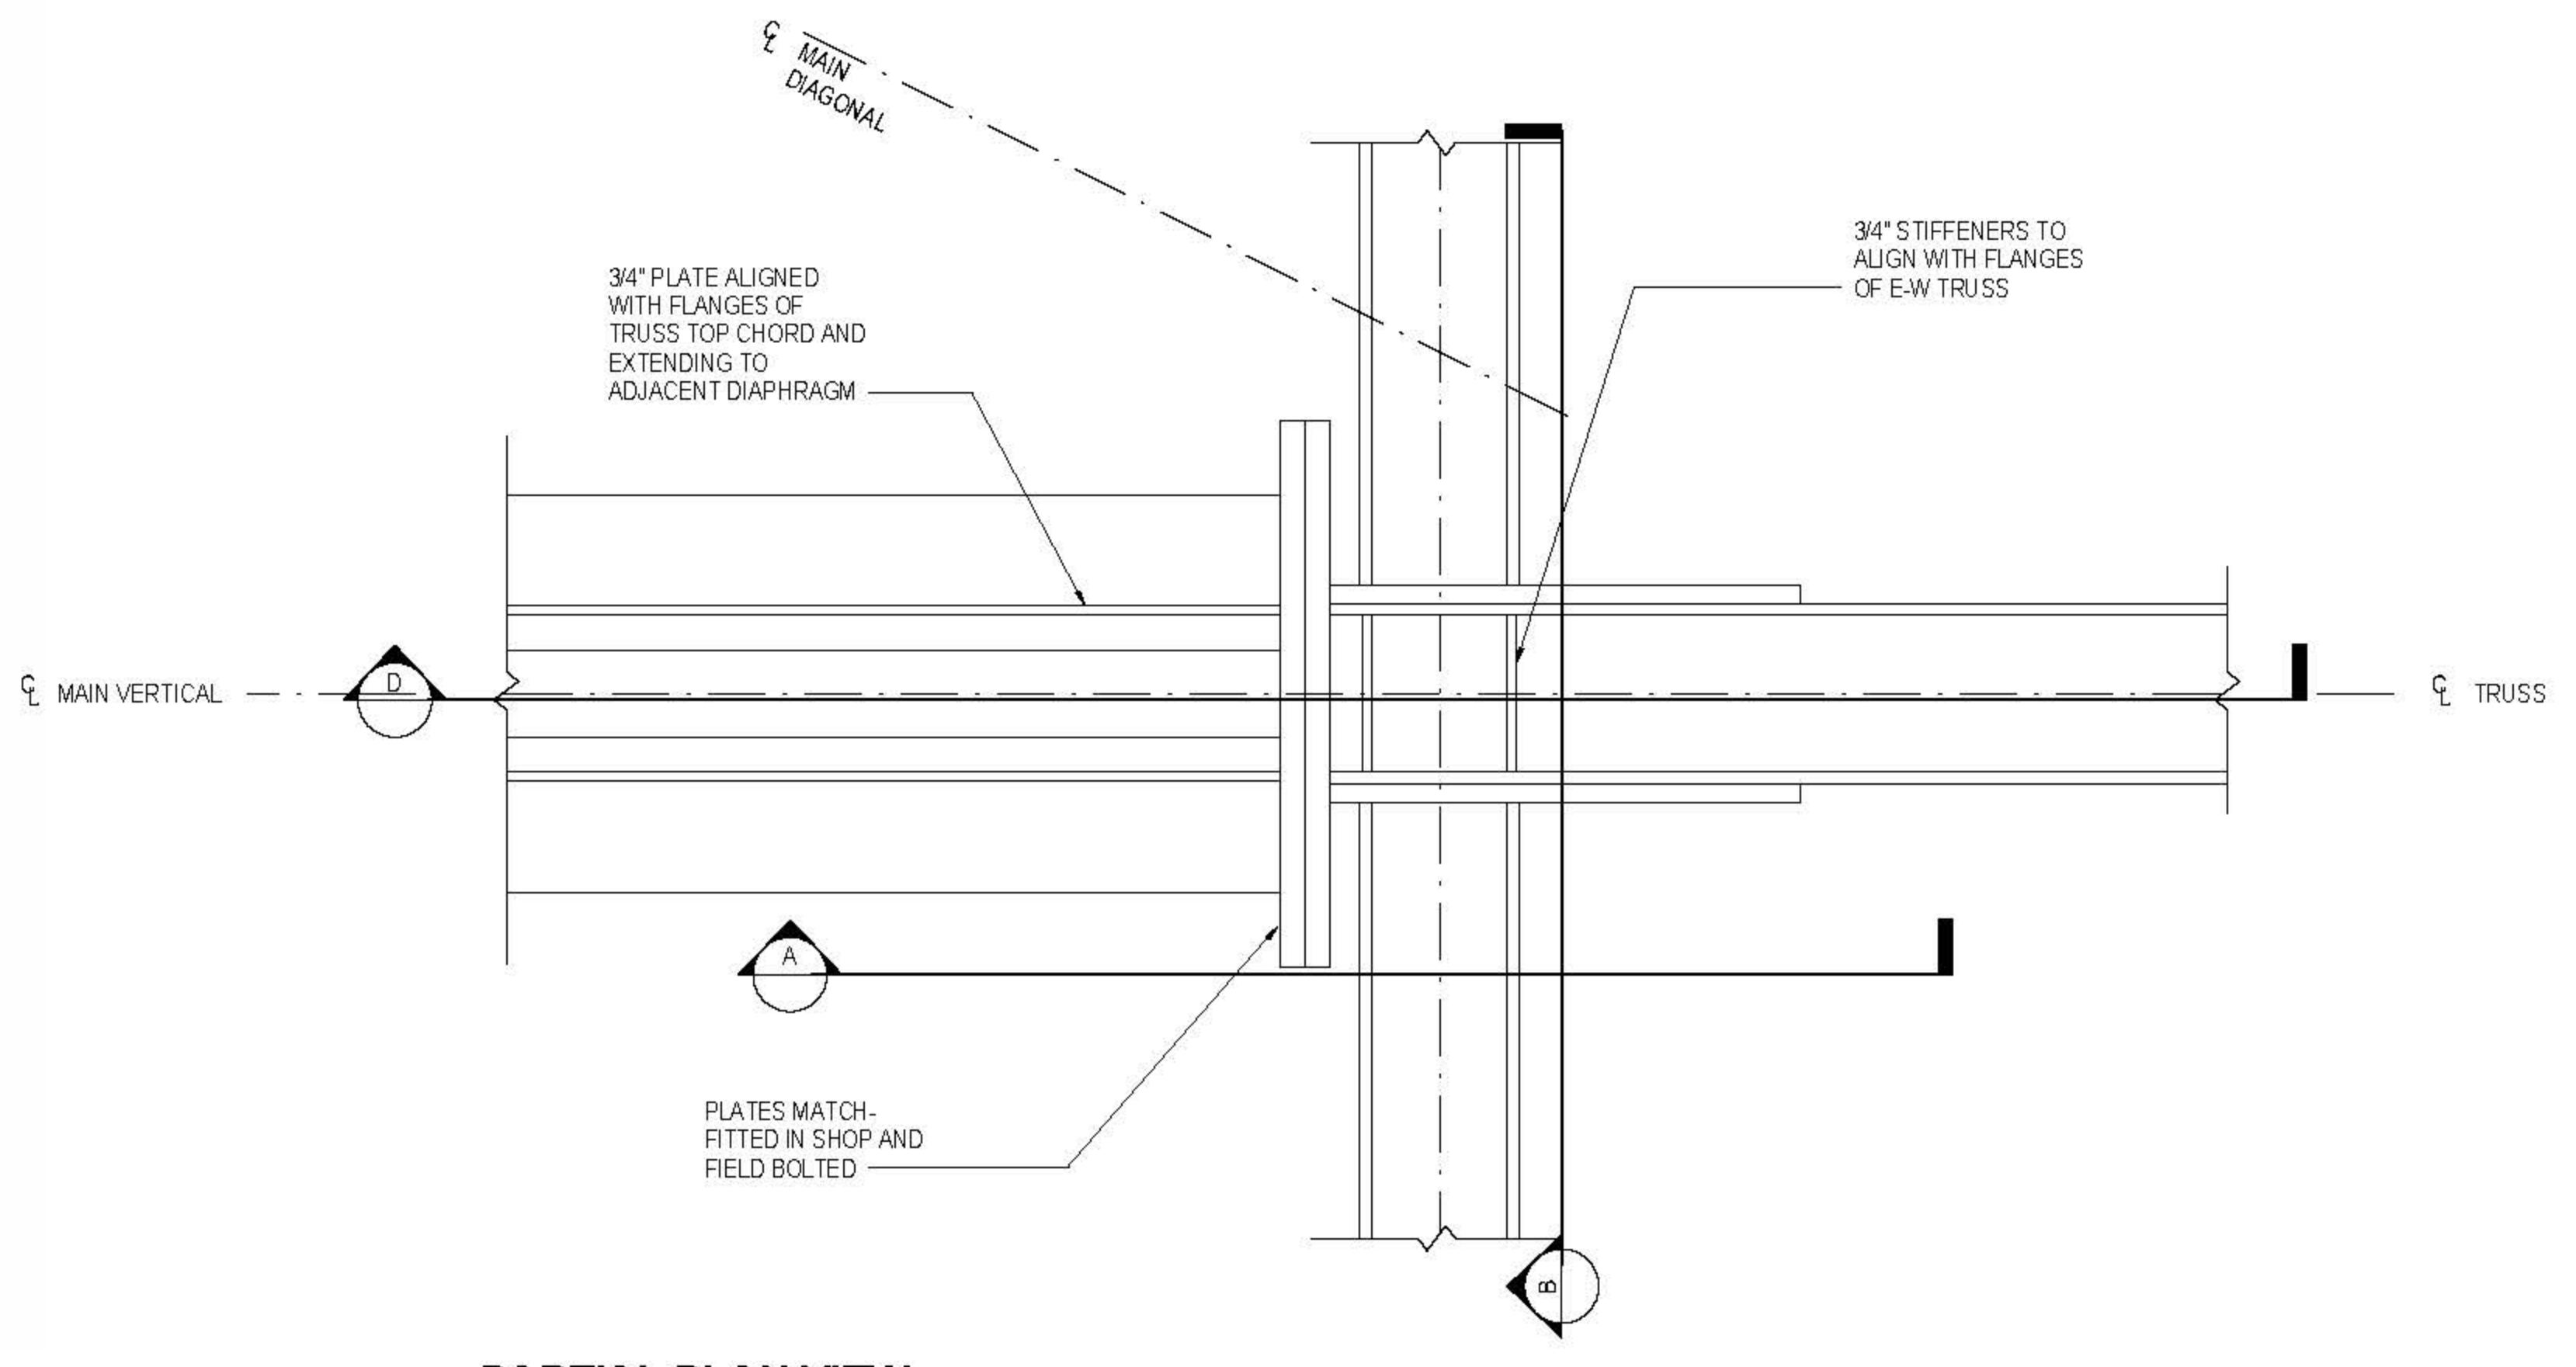


3 PARTIAL PLAN VIEW
1" = 1'-0"

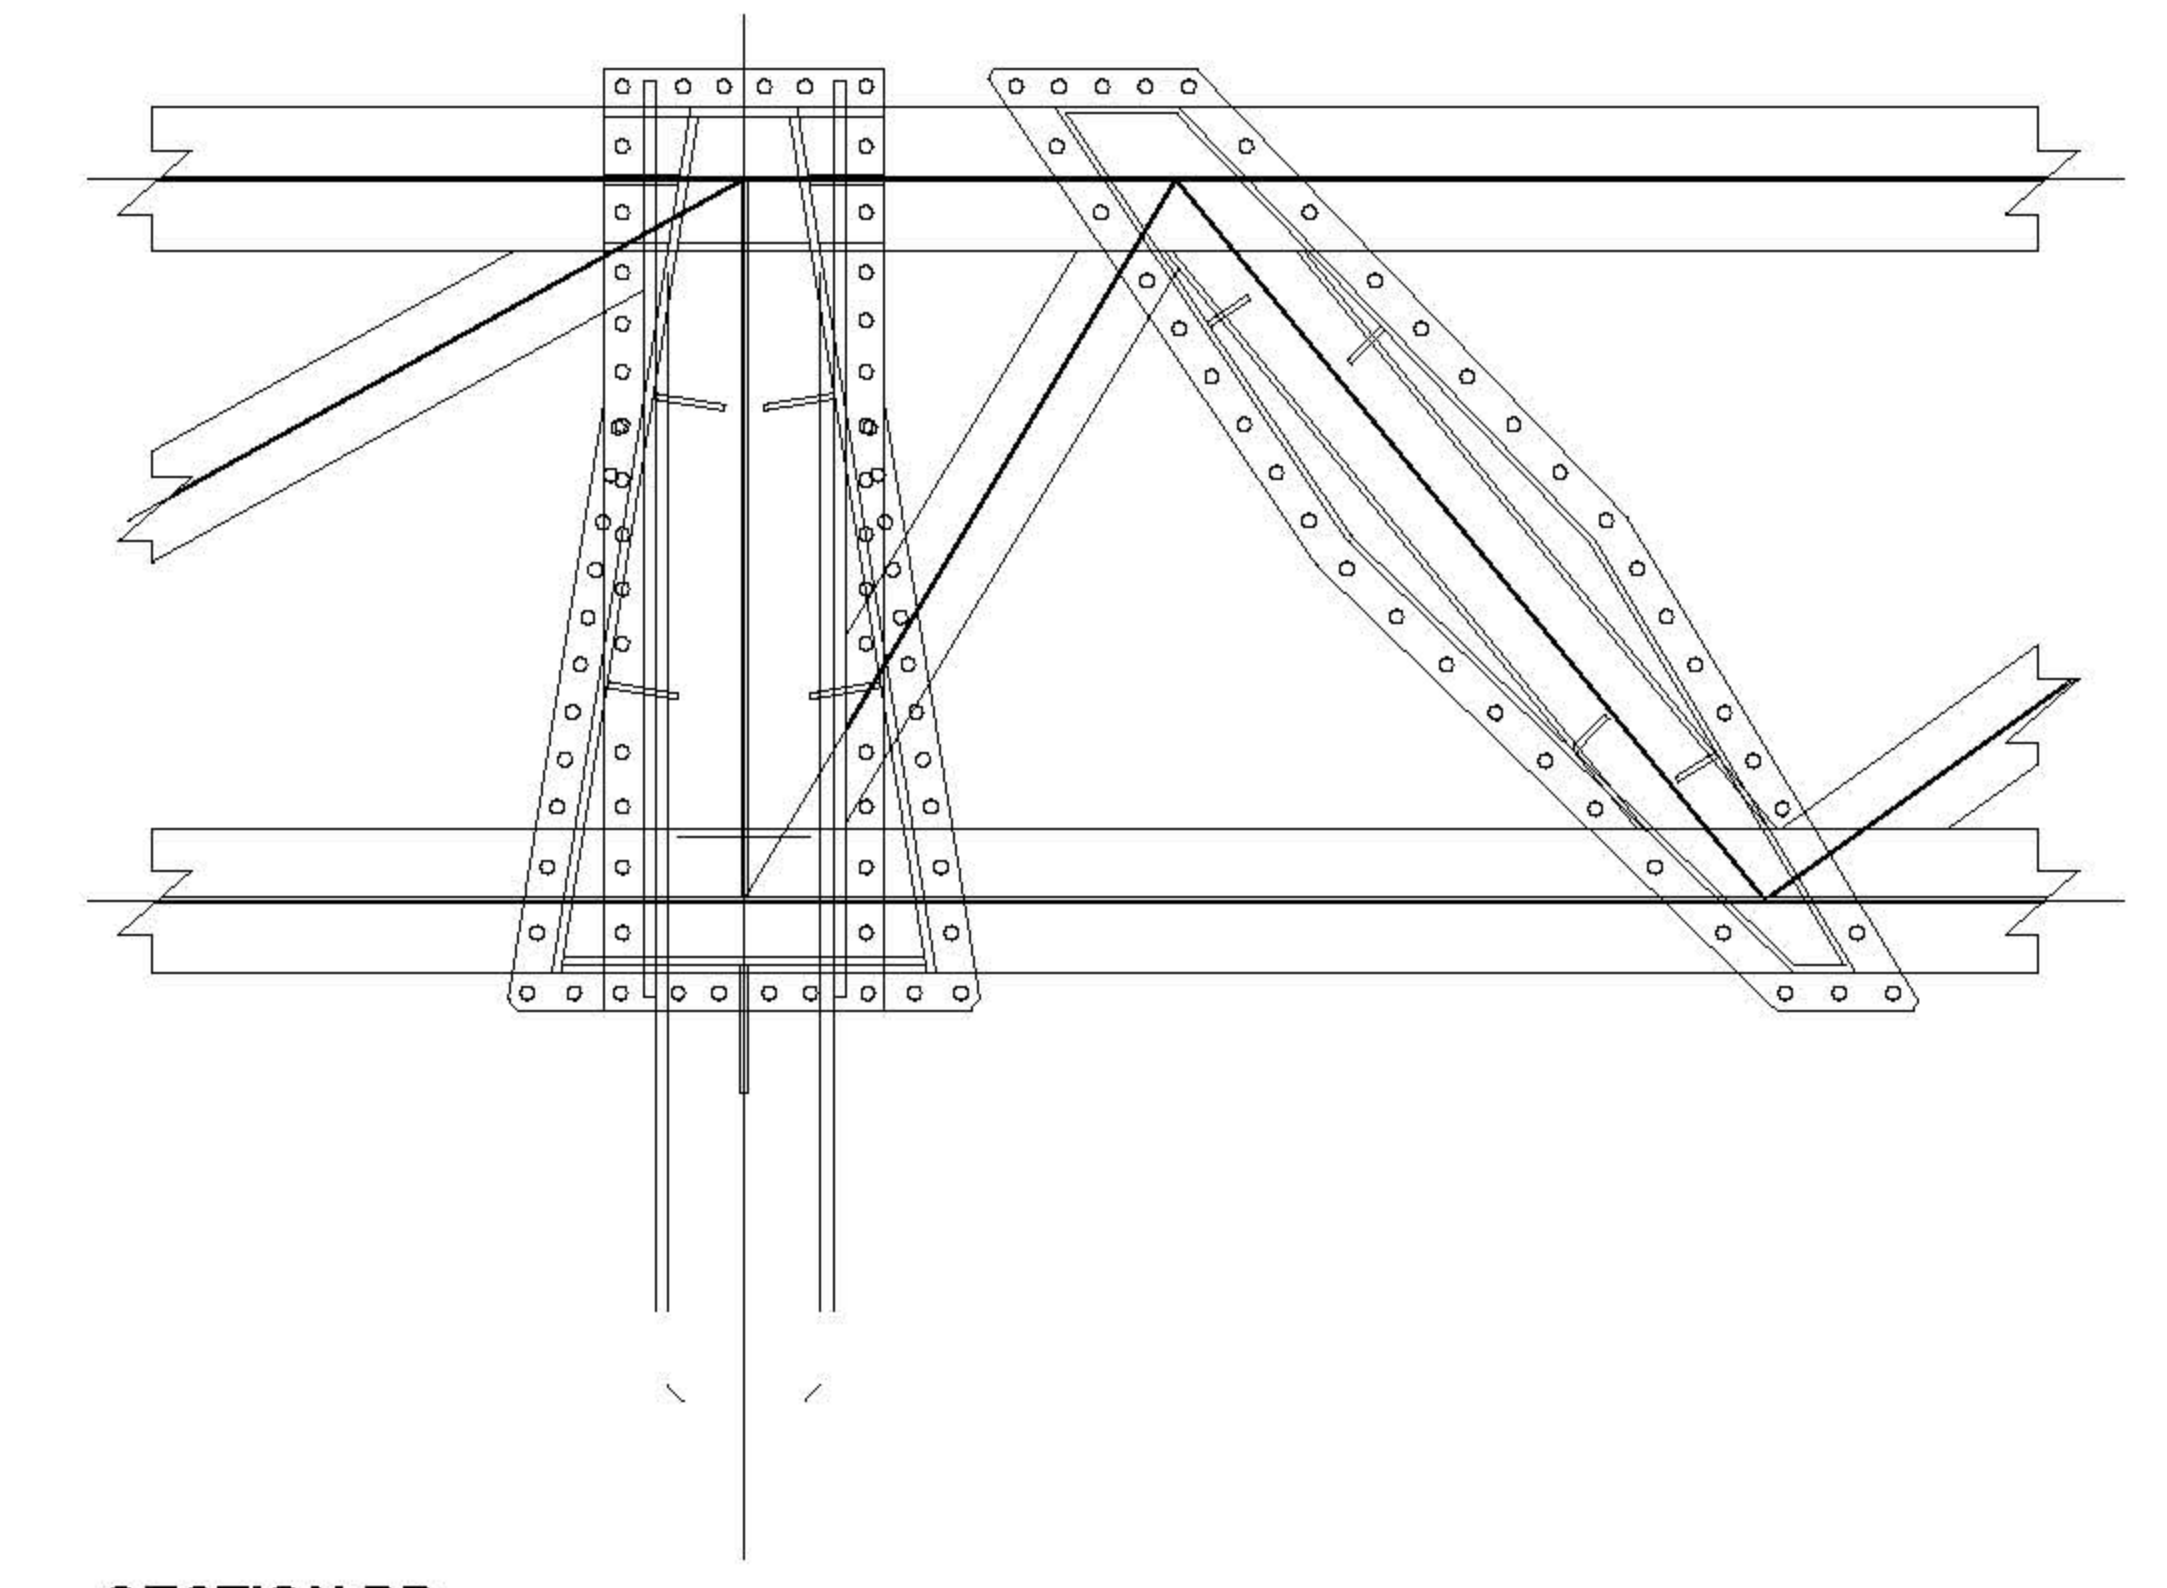

5 SECTION BB
3/4" = 1'-0"

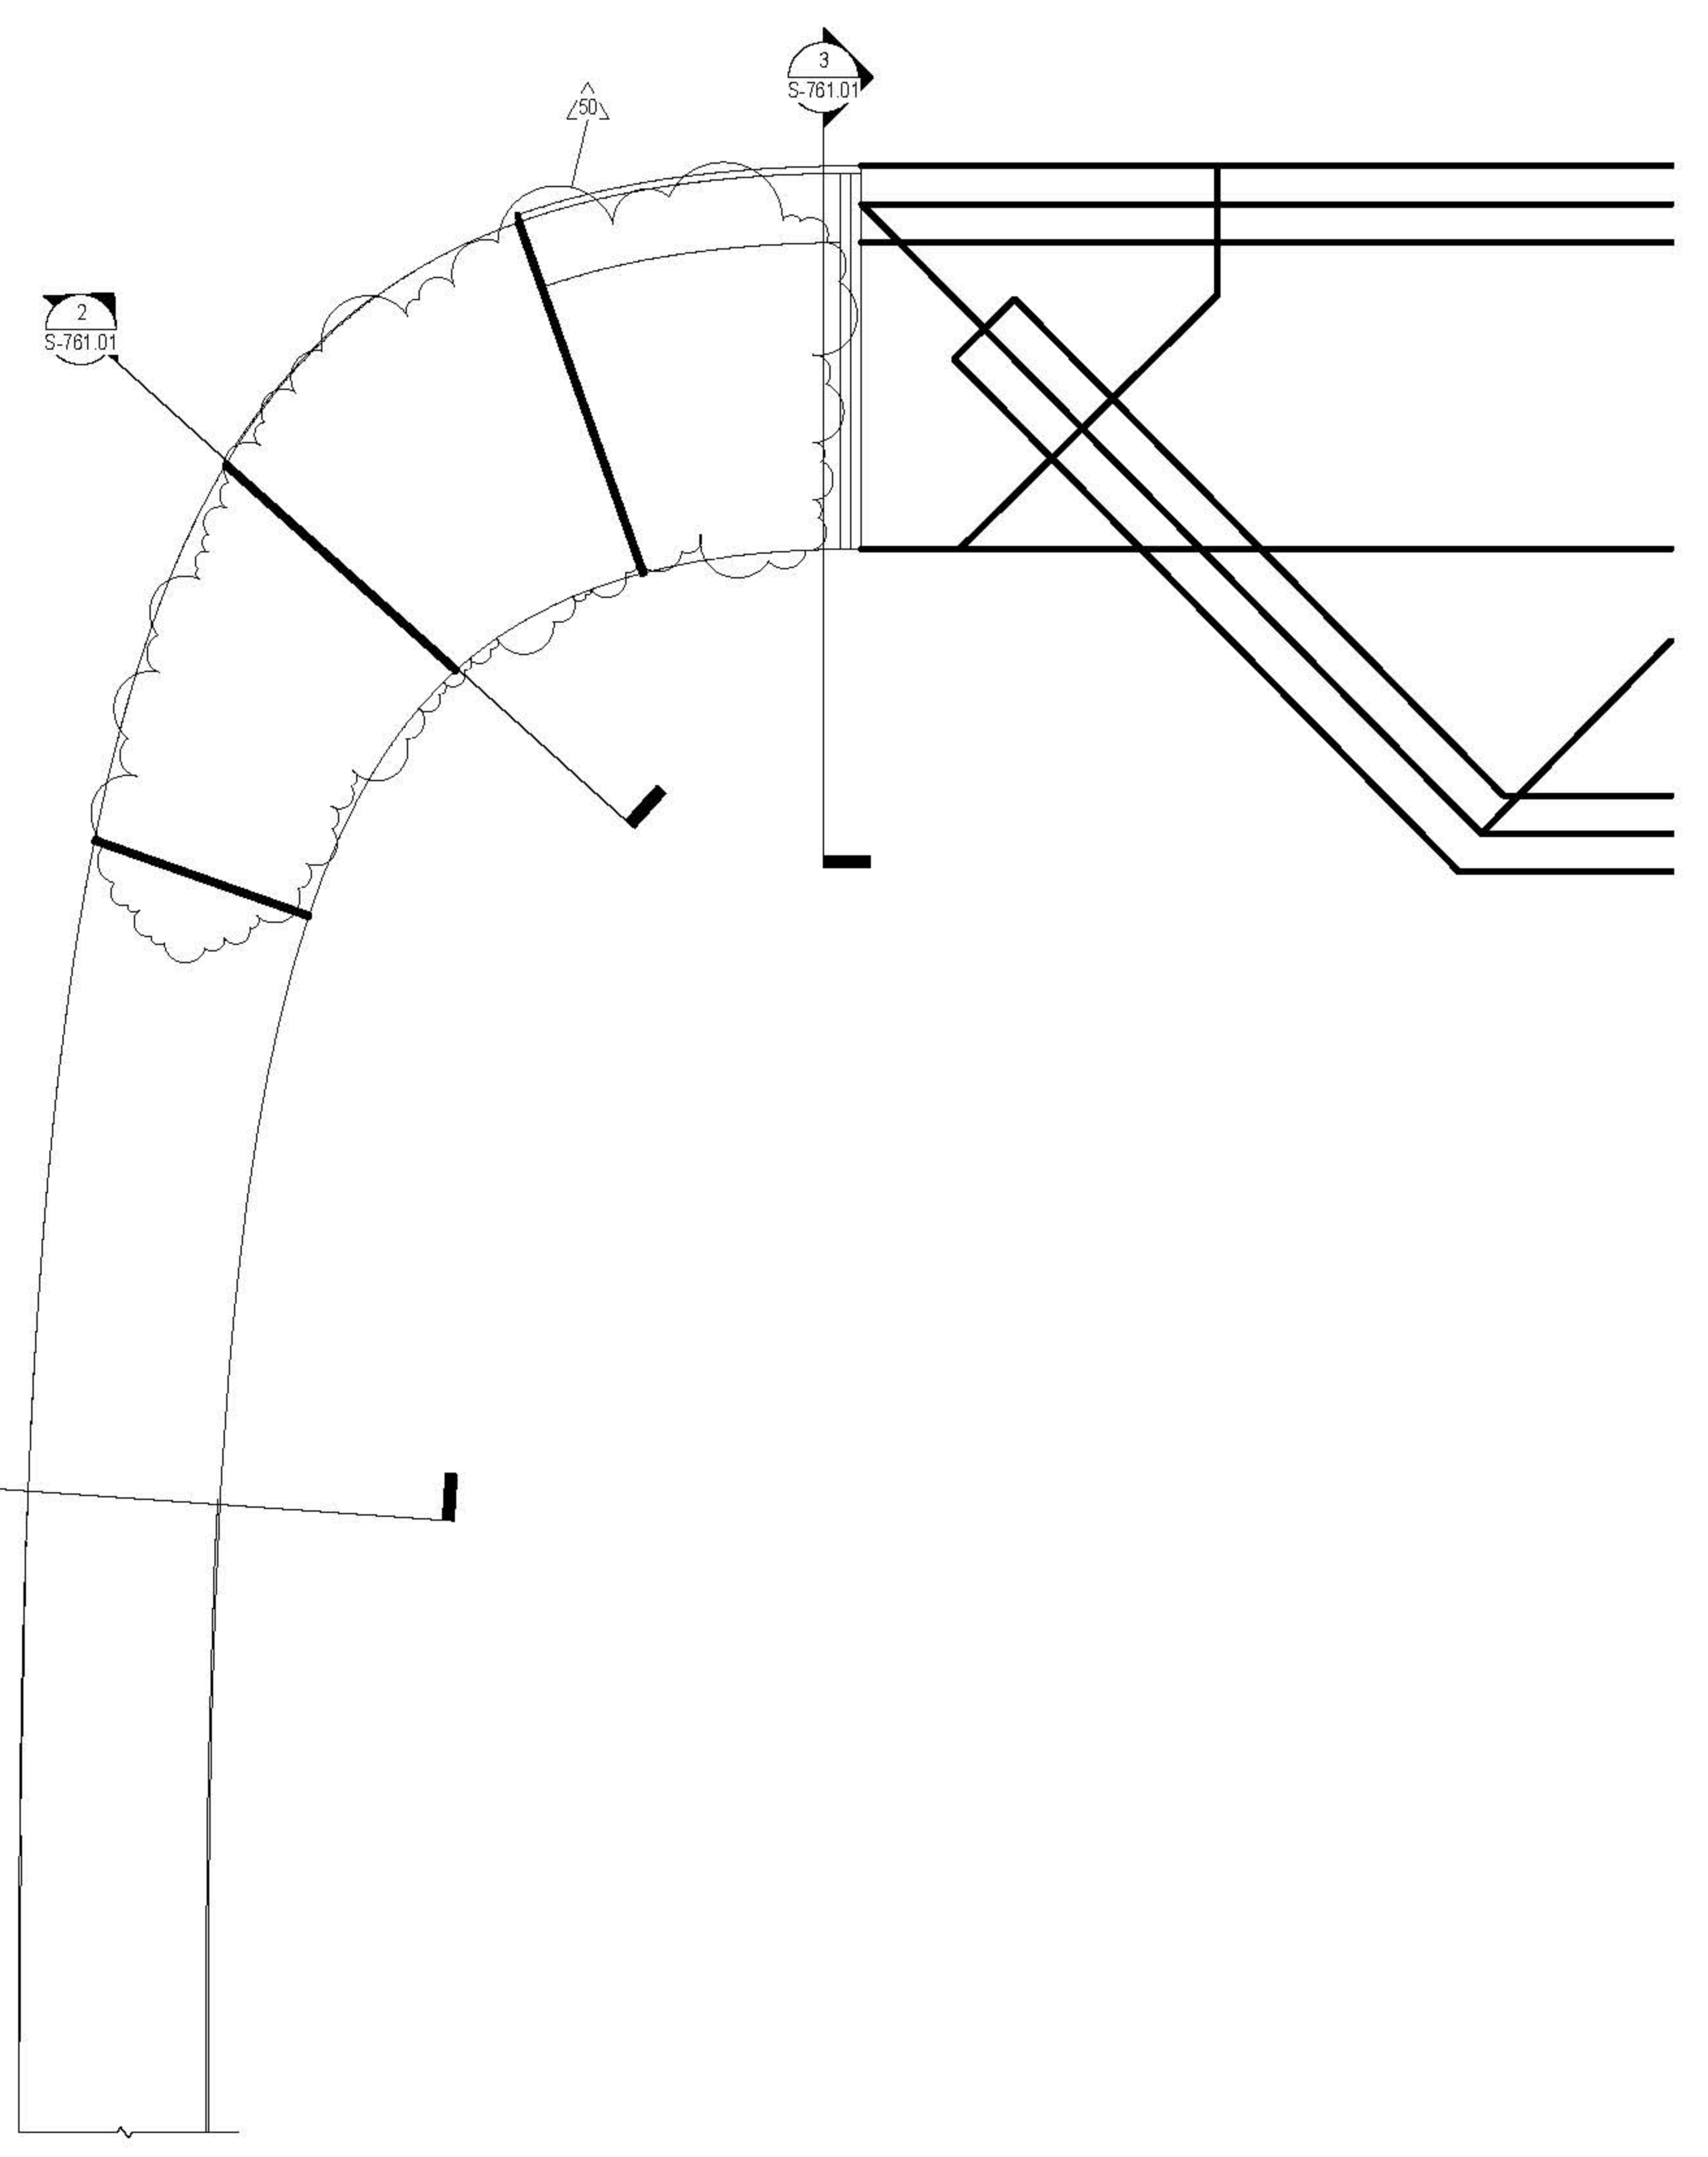


1 PARTIAL ELEVATION (LOOKING WEST) A-A
1/2" = 1'-0"

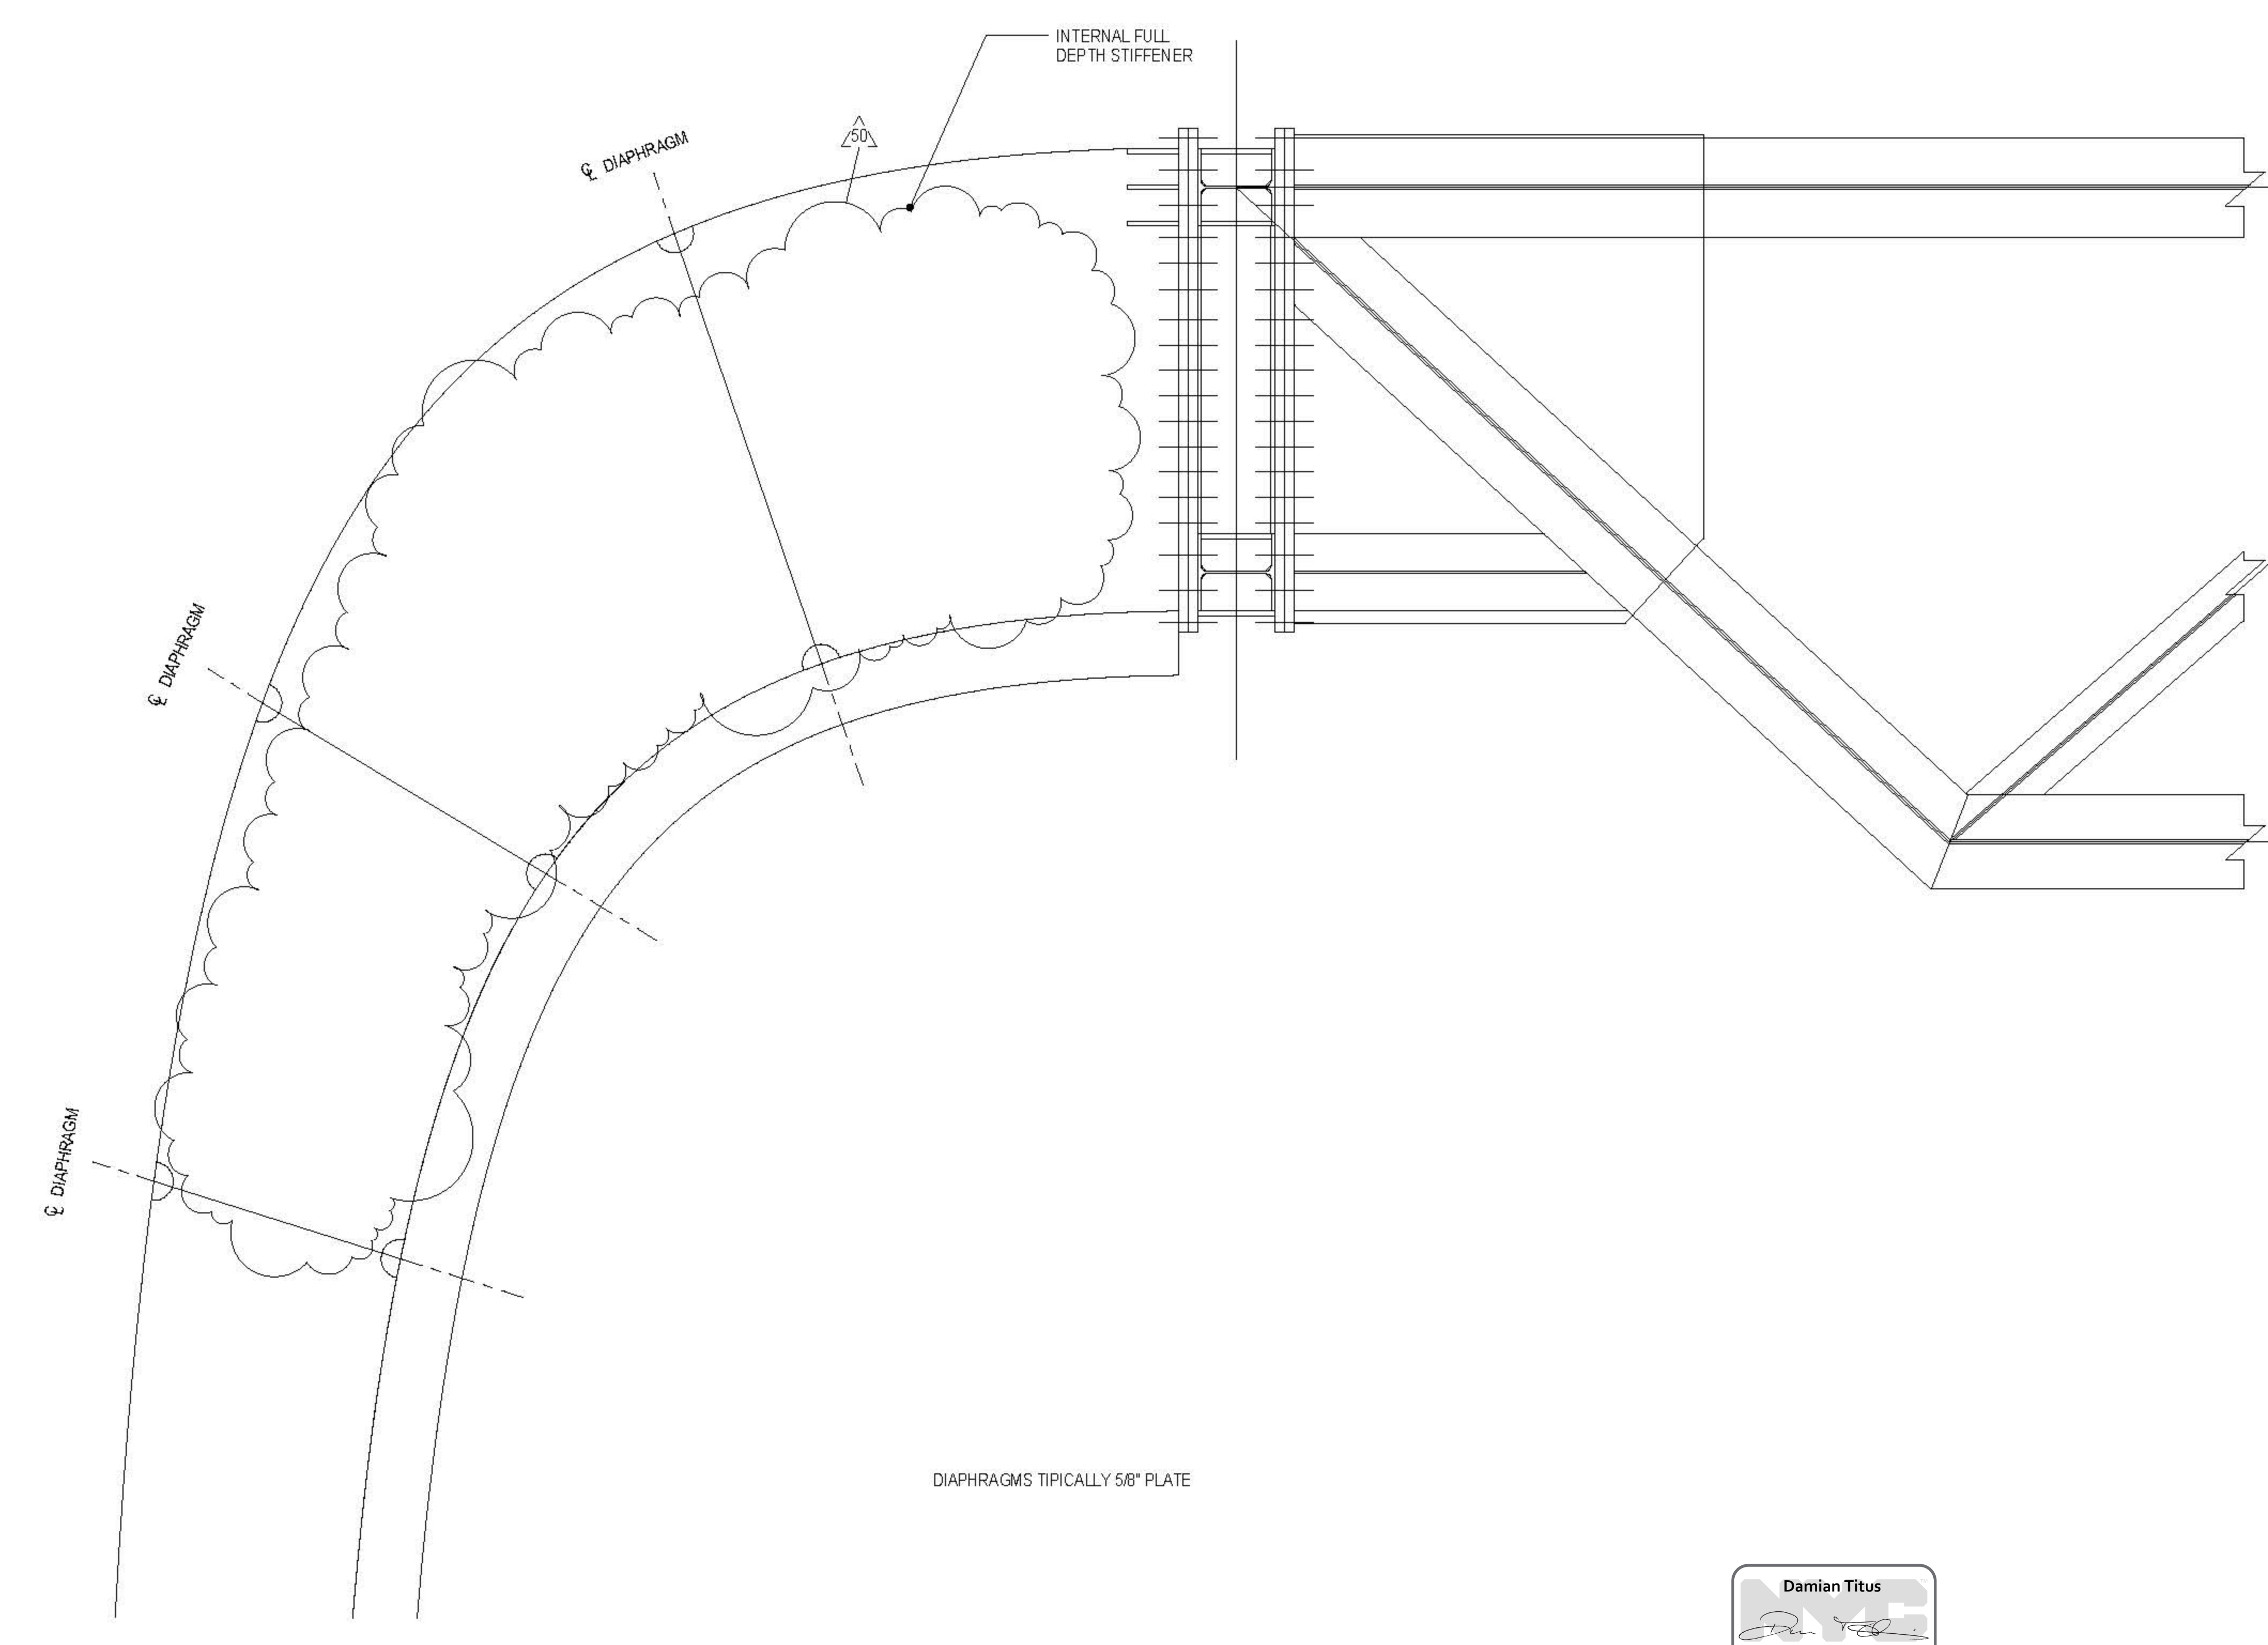

4 SECTION DD
3/4" = 1'-0"

DIAPHRAGMS TYPICALLY 5/8" PLATE

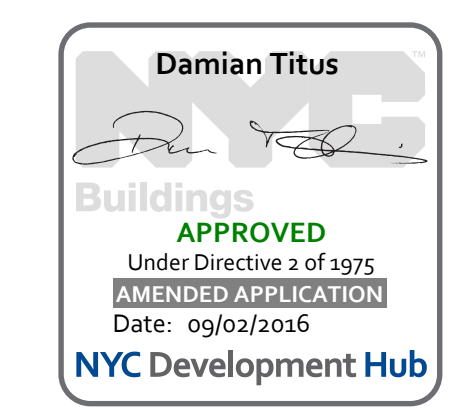

GEOMETRY, DIMENSIONS AND SURFACE CONTOURING, BLENDING AND INTERSECTION OF SECTIONS ILLUSTRATED IN THE STRUCTURAL DRAWINGS ARE PROVIDED FOR REFERENCE AND GENERATION OF STRUCTURAL ARRANGEMENT AND DETAILS ONLY. THE 3D MODEL ISSUED BY THE ARCHITECT DEFINES THE EXTERIOR SURFACE AND SHALL BE ADHERED TO FOR THE FINAL GEOMETRY. FOR DETAILS OF SECONDARY STEEL, INCLUDING STRUCTURAL CLADDING REFER TO ARCHITECTURE DRAWINGS. IT IS THE RESPONSIBILITY OF THE CONTRACTOR TO IDENTIFY ANY DISCREPANCIES OR AMBIGUITIES FOR DISCUSSION, RESOLUTION AND DIRECTION FROM THE ARCHITECT AND SER.

CULTURE SHED
545 West 30th Street
New York, New York 10001

OWNER
CULTURE SHED INC.

ARCHITECTS
Oiler Scalfaro + Renfro Architects, DPC
601 West 26 Street #815
New York, New York 10001
T: 212.260.7971

rockwellgroup
5 Union St. West, 6th Flr
New York, New York 10003
T: 212.463.0334
F: 212.463.0335

STRUCTURAL ENGINEER
Thornton Tomasetti
51 Madison Avenue
New York, New York 10010
T: 917.661.7800
F: 917.661.7801

MEP ENGINEER
Jans Baum & Bolles
50 Park Street
New York, New York 10005
T: 212.530.9300
F: 212.266.6964

FACADE CONSULTANT
Thornton Tomasetti
51 Madison Avenue
New York, New York 10010
T: 917.661.7800
F: 917.661.7801

KINETICS ENGINEER
Hadesky & Hanover
1501 Broadway
New York, New York 10036
T: 212.944.1150
F: 212.391.0297

LIGHTING DESIGNER
Tilston Design Associates
40 North Street #1650
New York, New York 10013
T: 212.675.7760

THEATRE PLANNING & DESIGN
Fisher Dodge Associates
22 West 15th Street
New York, New York 10011
T: 212.691.3000

LIFE SAFETY
Code Consultants, Inc.
215 West 40th St, 15th Flr
New York, New York 10018
T: 212.216.9596

ENERGY MODEL/LEED
Vindian
50 Washington Street
Norwalk, CT 06854
T: 203.298.1411

ACOUSTIC/AUDIO-VISUAL
Avalon
50 North Main Street
South Norwalk, CT 06854
T: 347.210.5540

VERTICAL TRANSPORTATION
Van Duusen & Associates
5 Regent Street, Suite 524
Livingston, NJ 07039
T: 973.994.9220


SPECIFICATIONS
Construction Specifications Inc.
PO Box 489
227 Tenthon Road
Morganville, NJ 07751
T: 732.970.0700
F: 732.970.0700

SECURITY
Duchella Venter & Santoro
1020 Sherman Avenue
Hartford, CT 06114
T: 203.286.6490


WATERPROOFING
James R. Gahfort AIA Consulting Architects PC
104 West 27th Street
New York, NY 10001
T: 212.736.3344

FACADE MAINTENANCE
Erick Engineering PLLC
106 Ave. Street
New York, NY 10005
T: 212.696.3000


BRANDING GRAPHICS
2nd Global Design Consultancy
180 Varck Street 15th Floor
New York, NY 10014
T: 212.647.1170

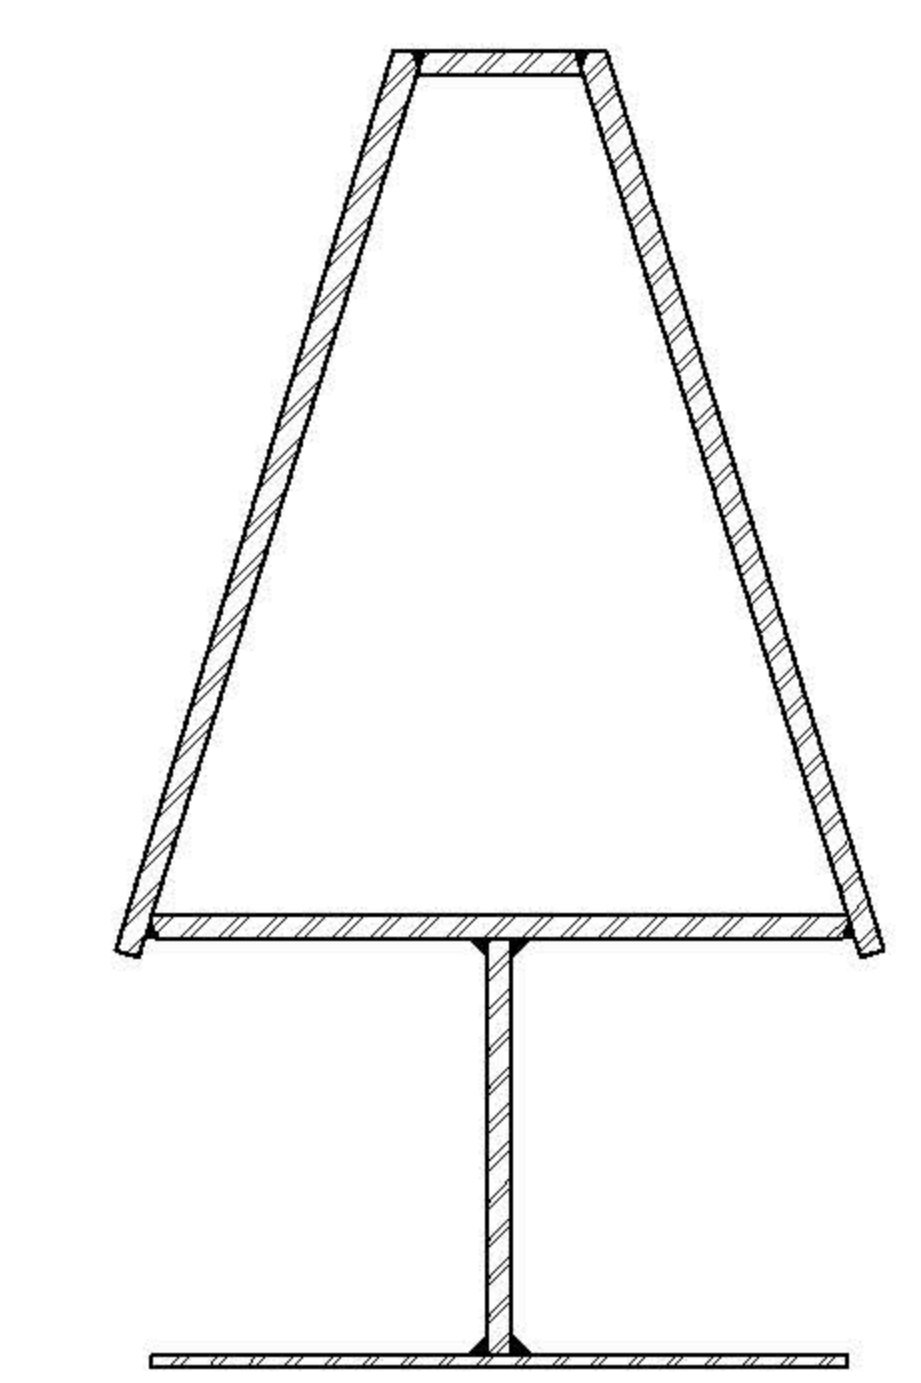

1 TYPICAL VERTICAL SECTION
1 1/2" = 1'-0"

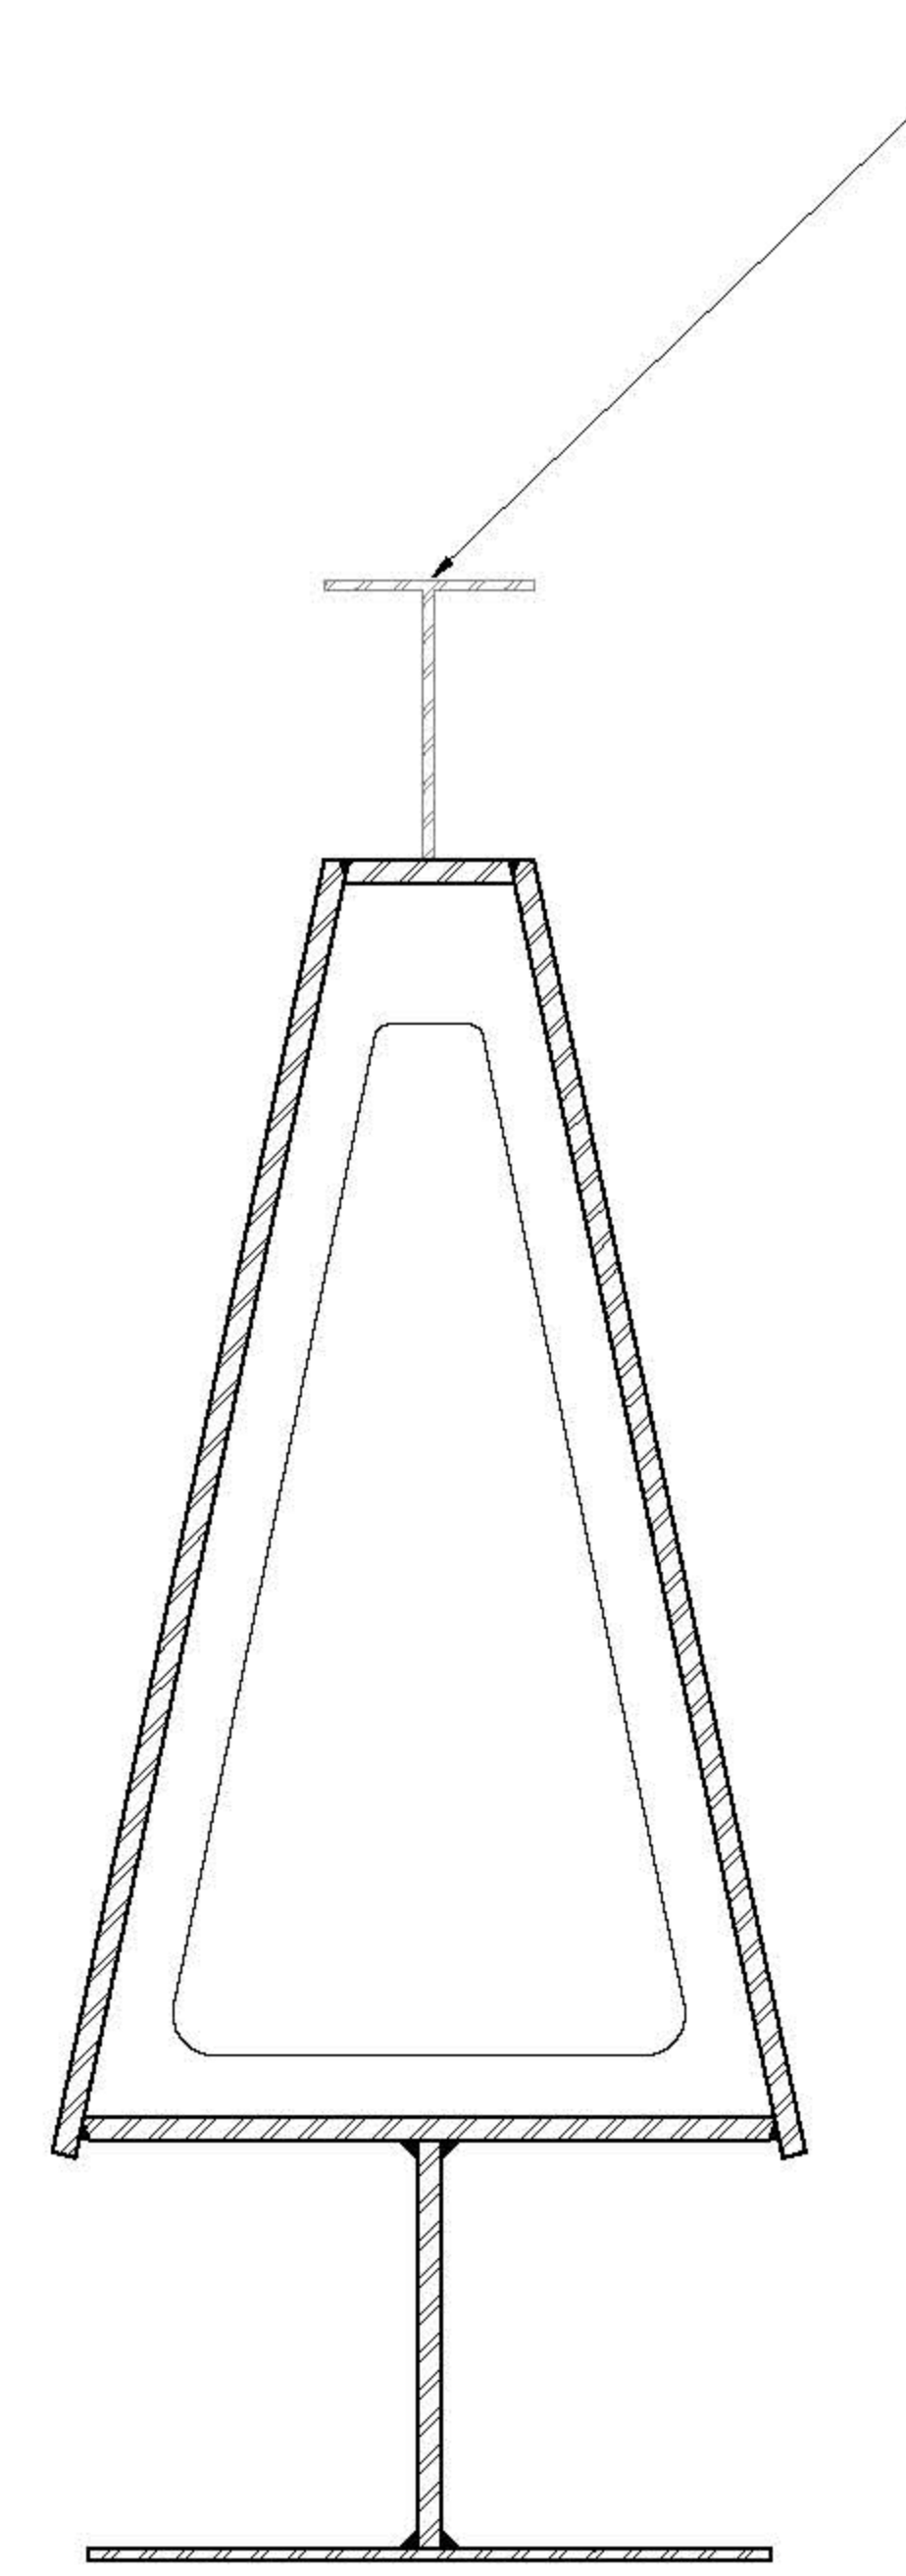


2 TYPICAL SECTION AT DIAPHRAGM
1 1/2" = 1'-0"

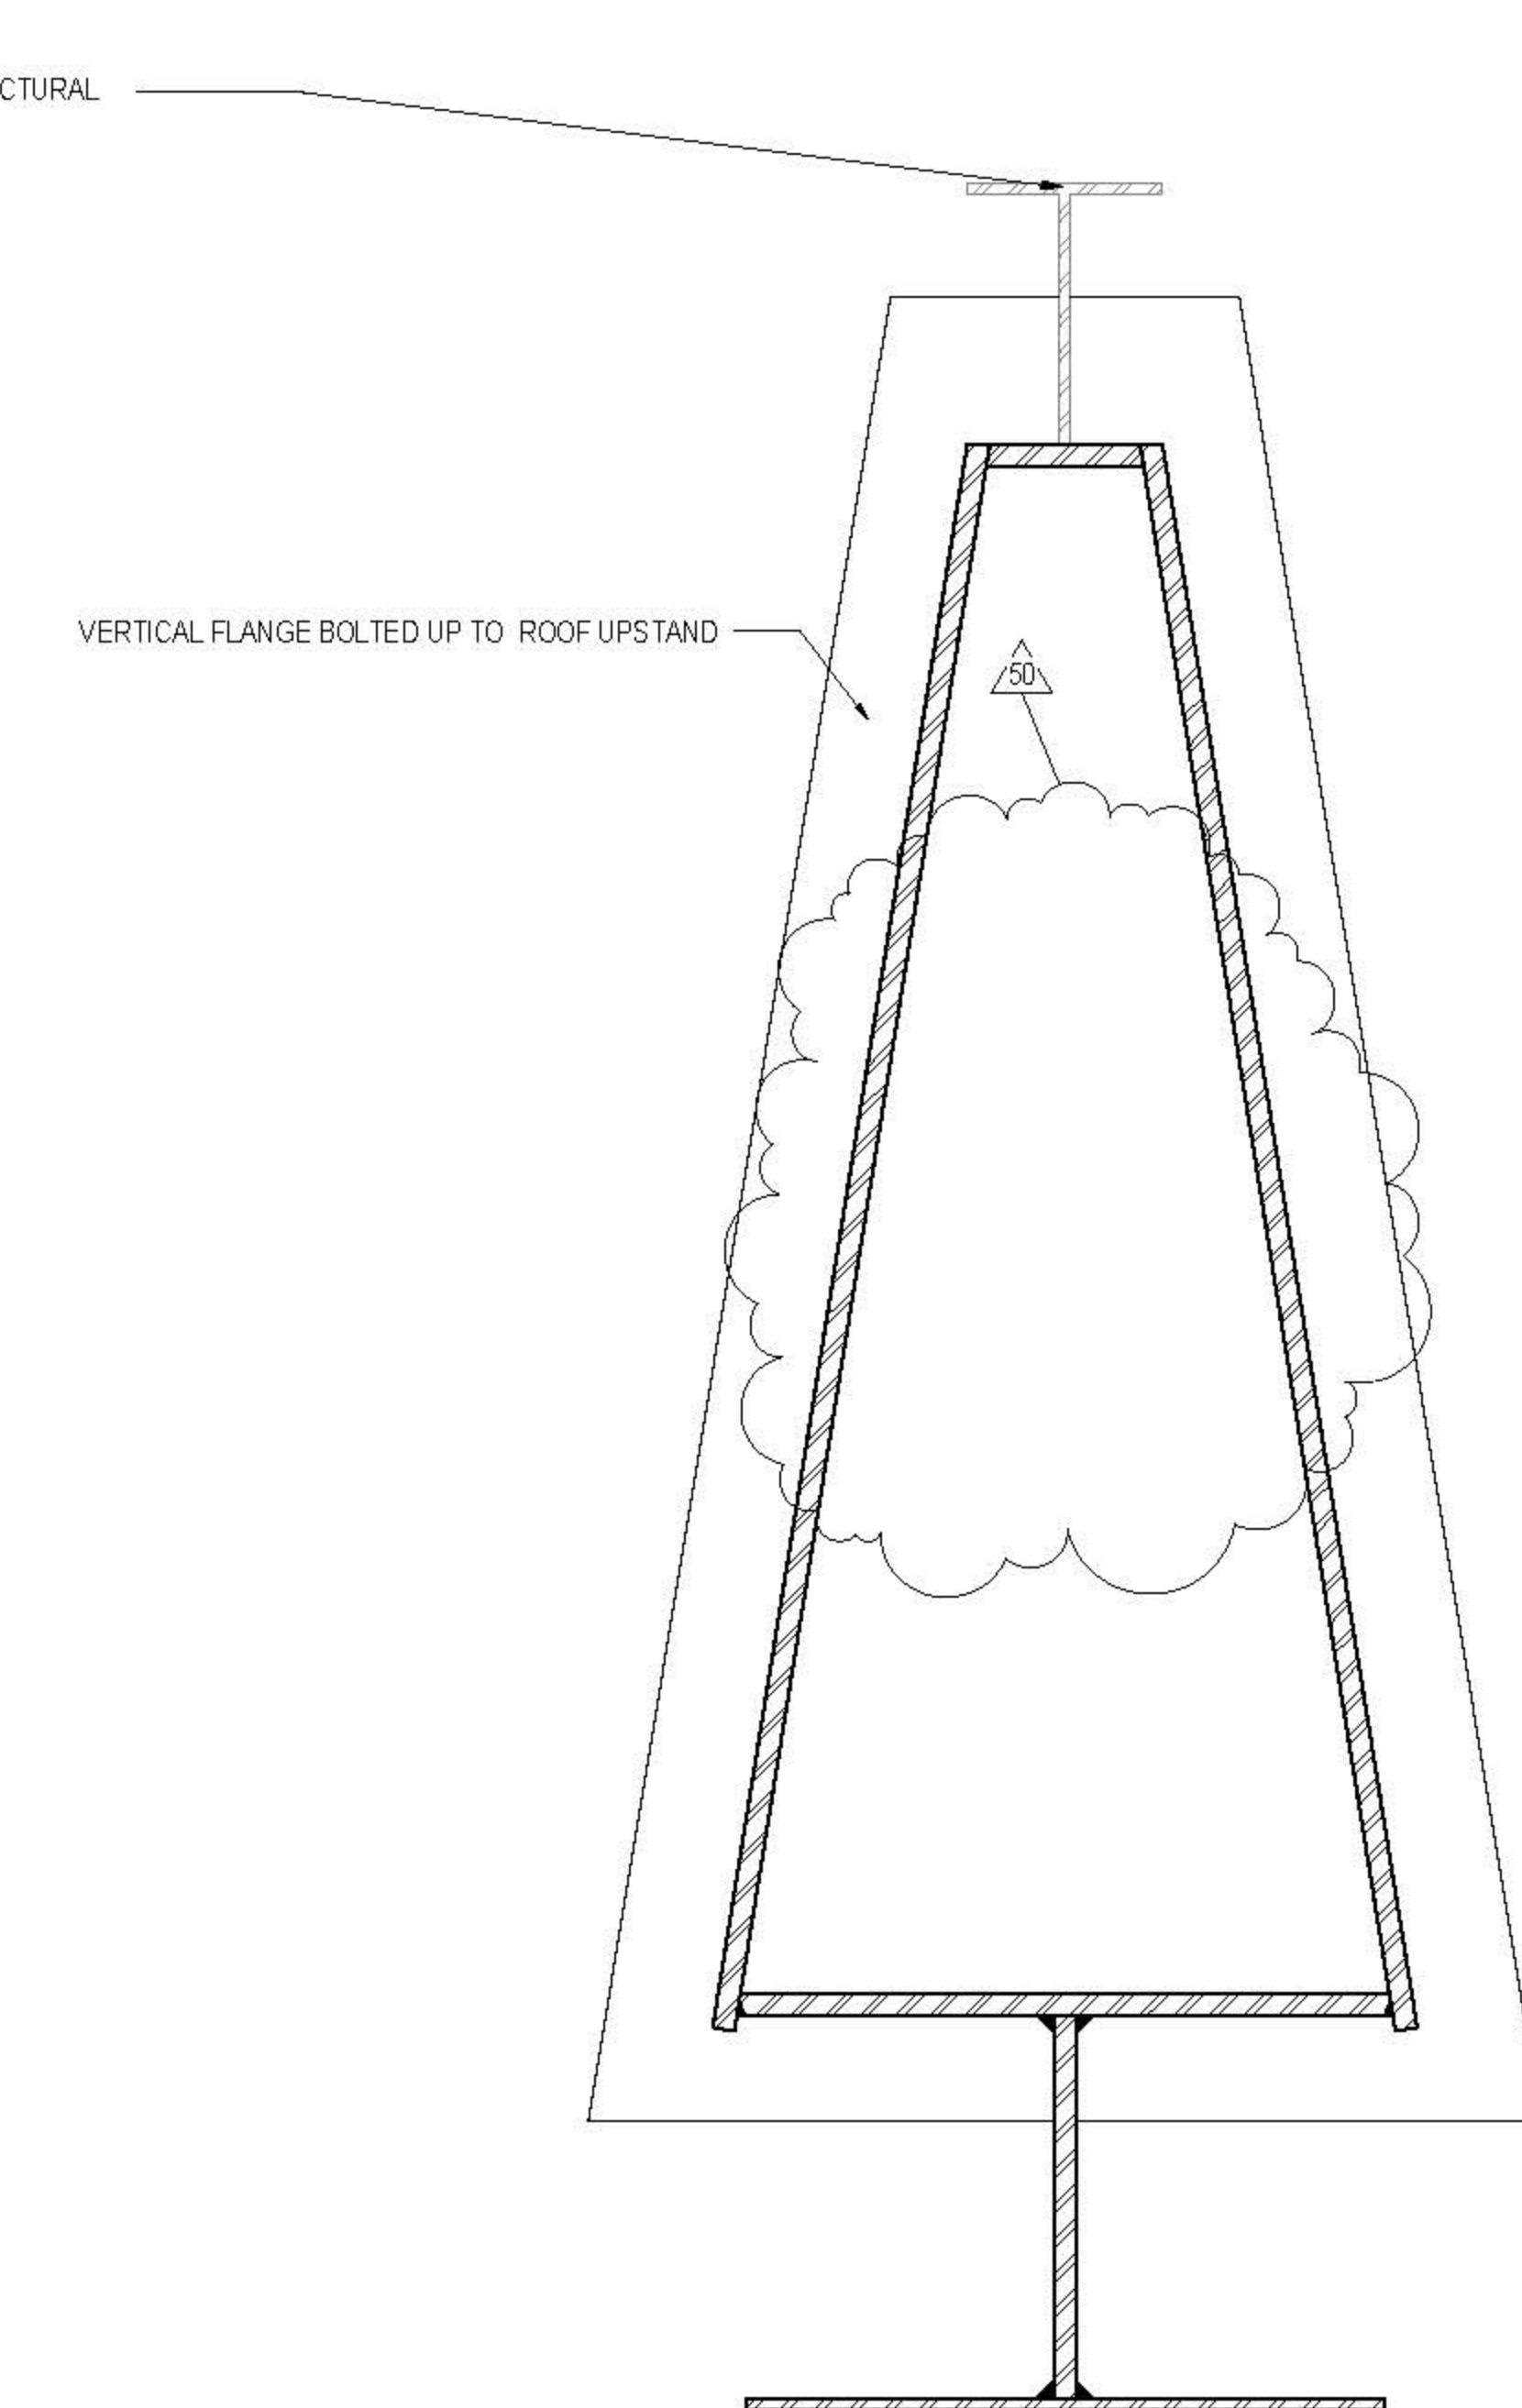

3 SECTION 3
1 1/2" = 1'-0"

SECONDARY STEEL TO SUPPORT ROOF CLADDING. REFER TO ARCHITECTURAL DRAWINGS/3D MODEL FOR DETAILS

VERTICAL FLANGE BOLTED UP TO ROOF UPSTAND

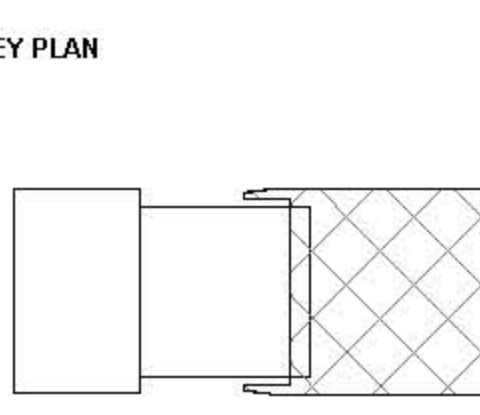

ISSUE	PRINTING	DATE	
63	60	DOB AMENDMENT 7	03.19.2016
44	39	DOB AMENDMENT 6	04.02.2016
21		CONSTRUCTION SET	10.08.2015
10	4	100% CONSTRUCTION DOCUMENTS	03.18.2015
9		90% CONSTRUCTION DOCUMENTS	02.16.2015
6		PRELIMINARY CDR SUBMISSION	12.16.2014
1		ADVANCED PROCUREMENT BID SET	06.16.2014




DRAWN BY: *Audrey* CHECKED BY: *Chris*

PROJECT NUMBER: N1318.00

TITLE: DETAILS, DEPLOYED SHED NORTH/SOUTH WALLS - CURVED SECTION DETAILS

DRAWING NO.: S-761.01

B.SCAN NO.: S-761.01

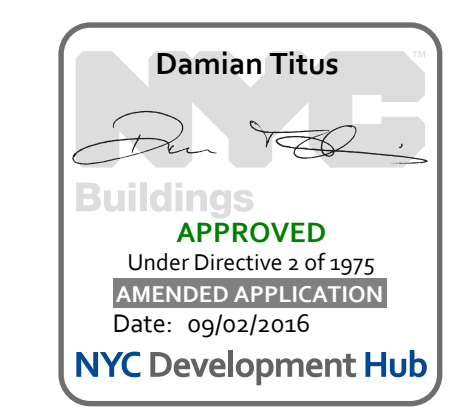

PENDING COORDINATION DURING DESIGN ASSIST.

CULTURE SHED
 545 West 30th Street
 New York, New York 10001
 OWNER
 CULTURE SHED INC.

ARCHITECTS
 Oller Scifano + Renfro Architects, DPC
 601 West 26 Street #815
 New York, New York 10001
 T: 212.260.7971

rockwellgroup
 5 Union St. West, 6th Fl.
 New York, New York 10003
 T: 212.463.0334
 F: 212.463.0335

STRUCTURAL ENGINEER
 Thornton Tomasetti
 51 Madison Avenue
 New York, New York 10010
 T: 917.661.7800
 F: 917.661.7801

MEP ENGINEER
 Jans Baum & Bolles
 50 Pine Street
 New York, New York 10005
 T: 212.530.9300
 F: 212.266.6944

FACADE CONSULTANT
 Thornton Tomasetti
 51 Madison Avenue
 New York, New York 10010
 T: 917.661.7800
 F: 917.661.7801

KINETICS ENGINEER
 Hardsy & Hanover
 1501 Broadway
 New York, New York 10036
 T: 212.944.1150
 F: 212.399.0297

LIGHTING DESIGNER
 Tibotone Design Associates
 40 Worth Street #1650
 New York, New York 10013
 T: 212.675.7760

THEATRE PLANNING & DESIGN
 Fisher Dodge Associates
 22 West 15th Street
 New York, New York 10011
 T: 212.691.3000

LIFE SAFETY
 Code Consultants, Inc.
 215 West 40th St, 15th Fl.
 New York, New York 10018
 T: 212.216.9596

ENERGY MODEL/LEED
 Vidman
 50 Washington Street
 Norwalk, CT 06854
 T: 203.298.1411

ACOUSTIC/AUDIO-VISUAL
 Auraltek
 50 North Main Street
 South Norwalk, CT 06854
 T: 347.210.5540

VERTICAL TRANSPORTATION
 Van Dusen & Associates
 5 Regent Street, Suite 524
 Livingston, NJ 07039
 T: 973.994.9220

SPECIFICATIONS
 Construction Specifications Inc.
 PO Box 489
 22 Tannett Road
 Morganville, NJ 07751
 T: 732.970.0700
 F: 732.970.0700


SECURITY
 Duchella Venter & Santoro
 1100 Sherman Avenue
 Hamden, CT 06514
 T: 203.286.6490

WATERPROOFING
 James R. Galtfort AIA Consulting Architects PC
 104 West 27th Street
 New York, NY 10001
 T: 212.736.3344

FACADE MAINTENANCE
 Erik Engineering PLLC
 186 Ave. Street
 New York, NY 10005
 T: 212.696.3000


BRANDING GRAPHICS
 2nd Global Design Consultancy
 180 York Street 15th Floor
 New York, NY 10014
 T: 212.647.1170

GEOMETRY, DIMENSIONS AND SURFACE CONTOURING, BLENDING AND INTERSECTION OF SECTIONS ILLUSTRATED IN THE STRUCTURAL DRAWINGS ARE PROVIDED FOR REFERENCE AND GENERATION OF STRUCTURAL ARRANGEMENT AND DETAILS ONLY. THE 3D MODEL ISSUED BY THE ARCHITECT DEFINES THE EXTERIOR SURFACE AND SHALL BE ADHERED TO FOR THE FINAL GEOMETRY. FOR DETAILS OF SECONDARY STEEL, INCLUDING STRUCTURAL CLADDING REFER TO ARCHITECTURE DRAWINGS. IT IS THE RESPONSIBILITY OF THE CONTRACTOR TO IDENTIFY ANY DISCREPANCIES OR AMBIGUITIES FOR DISCUSSION, RESOLUTION AND DIRECTION FROM THE ARCHITECT AND SER.

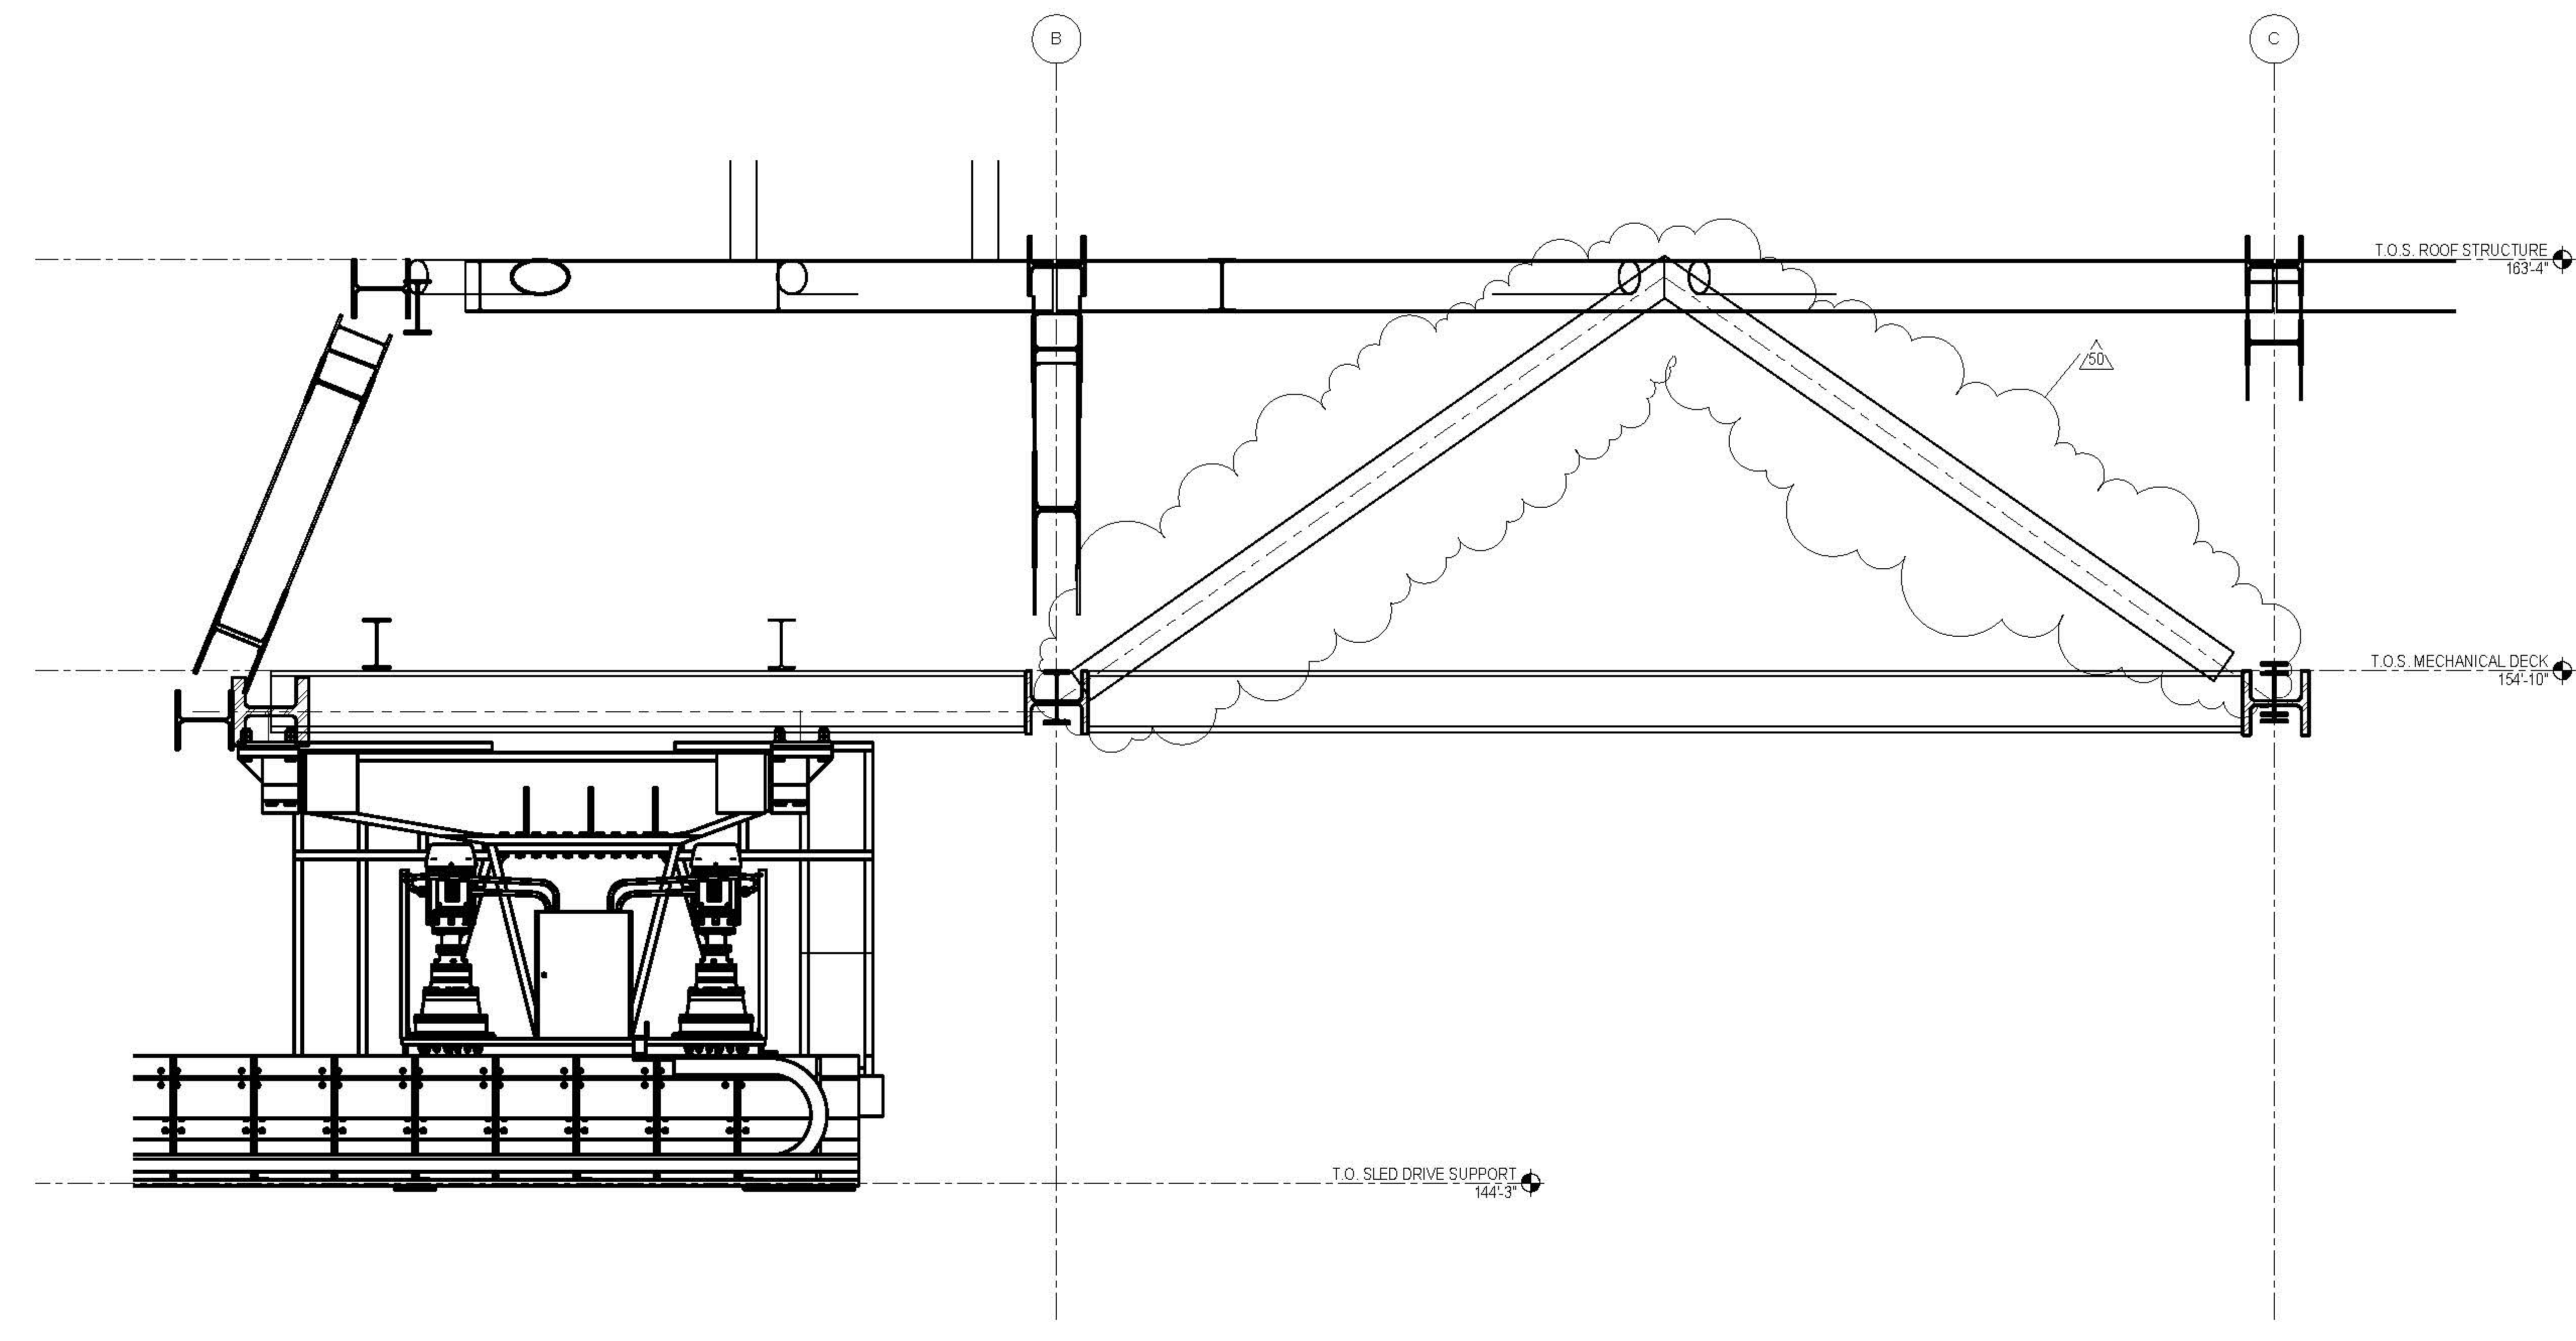

1 SHED DRIVE CONNECTION
 1/2" = 1'-0"

KEY PLAN

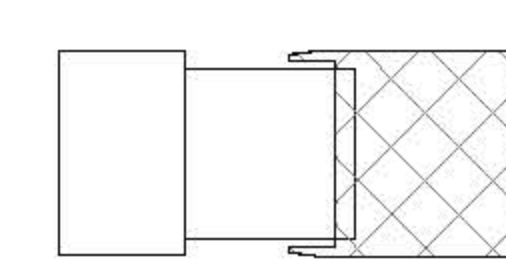

ISSUE **PRINTING** **DATE**

ISSUE	PRINTING	DATE	
63	60	DOB AMENDMENT 7	03.19.2016
44	30	DOB AMENDMENT 6	04.02.2016
21		CONSTRUCTION SET	10.08.2015
10	4	100% CONSTRUCTION DOCUMENTS	03.18.2015
9		90% CONSTRUCTION DOCUMENTS	02.16.2015
6		PRELIMINARY JOB SUBMISSION	12.10.2014
1		ADVANCED PROCUREMENT BID SET	06.16.2014



DRAWN BY
 Author


CHECKED BY
 Chris

PROJECT NUMBER
 N11318.00

TITLE
 DETAILS, DEPLOYED SHED DRIVE CONNECTION

DRAWING NO.
 S-764.01

B.SCAN NO.
S-764.01

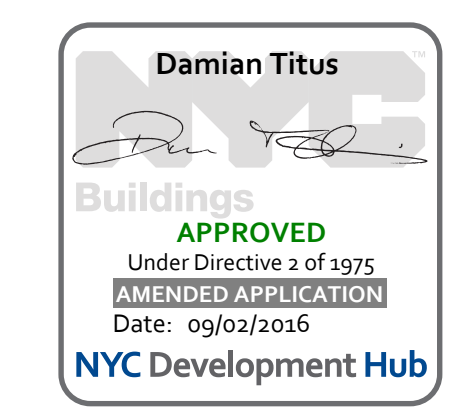

PENDING COORDINATION DURING DESIGN ASSIST.

CULTURE SHED
545 West 30th Street
New York, New York 10001

OWNER
CULTURE SHED INC

ARCHITECTS
Diller Scofidio + Renfro Architects, PC
601 West 38 Street #1515
New York, New York 10001
T: 212.360.7871

STRUCTURAL ENGINEER
Thornton Tomasetti
51 Madison Avenue
New York, New York 10010
T: 917.861.7800
F: 917.861.7801

MEP ENGINEER
Jawa Baum & Bolles
80 Pine Street
New York, New York 10005
T: 212.230.0900
F: 212.230.0904

FACADE CONSULTANT
Thornton Tomasetti
51 Madison Avenue
New York, New York 10010
T: 917.861.7800
F: 917.861.7801

KINETICS ENGINEER
Hartley & Heston
1001 Broadway
New York, New York 10036
T: 212.844.1150
F: 212.267.0297

LIGHTING DESIGNER
Tilcon Design Associates
43 West Street #1902
New York, New York 10013
T: 212.675.7700

THEATRE PLANNING & DESIGN
Palmer Dodge Associates
22 West 18th Street
New York, New York 10011
T: 212.851.3000

LIFE SAFETY
Code Consultants, Inc.
215 West 42nd St, 10th Fl
New York, New York 10018
T: 212.216.8586

ENERGY MODELLED
Virtisan
93 Washington Street
Norwalk, CT 06854
T: 203.295.1411

ACoustics/AUDIO-VISUAL
Alvares
93 North Main Street
South Norwalk, CT 06854
T: 947.210.5540

VERTICAL TRANSPORTATION
Van Dusen & Associates
5 Regent Street, Suite 504
Lynchburg, NJ 07039
T: 973.984.8220



SPECIFICATIONS
Construction Specifications Inc.
PO Box 488
22 Tenney Road
Morgantown, NJ 07951
T: 732.870.0700
F: 732.870.0700

SECURITY
Ducibelle Venter & Santoro
1020 Sherman Avenue
Hartford, CT 06114
T: 203.288.9490

WATERPROOFING
James R. Gairford AIA Consulting Architects PC
154 West 27th Street
New York, NY 10001
T: 212.736.3344

FACADE MAINTENANCE
Smith Engineering PLLC
100 Arden Street
New York, NY 10006
T: 212.696.3000



BRANDING/GRAPHICS
204 Global Design Consultancy
180 Vespa Street, 15th Floor
New York, NY 10014
T: 212.647.1170

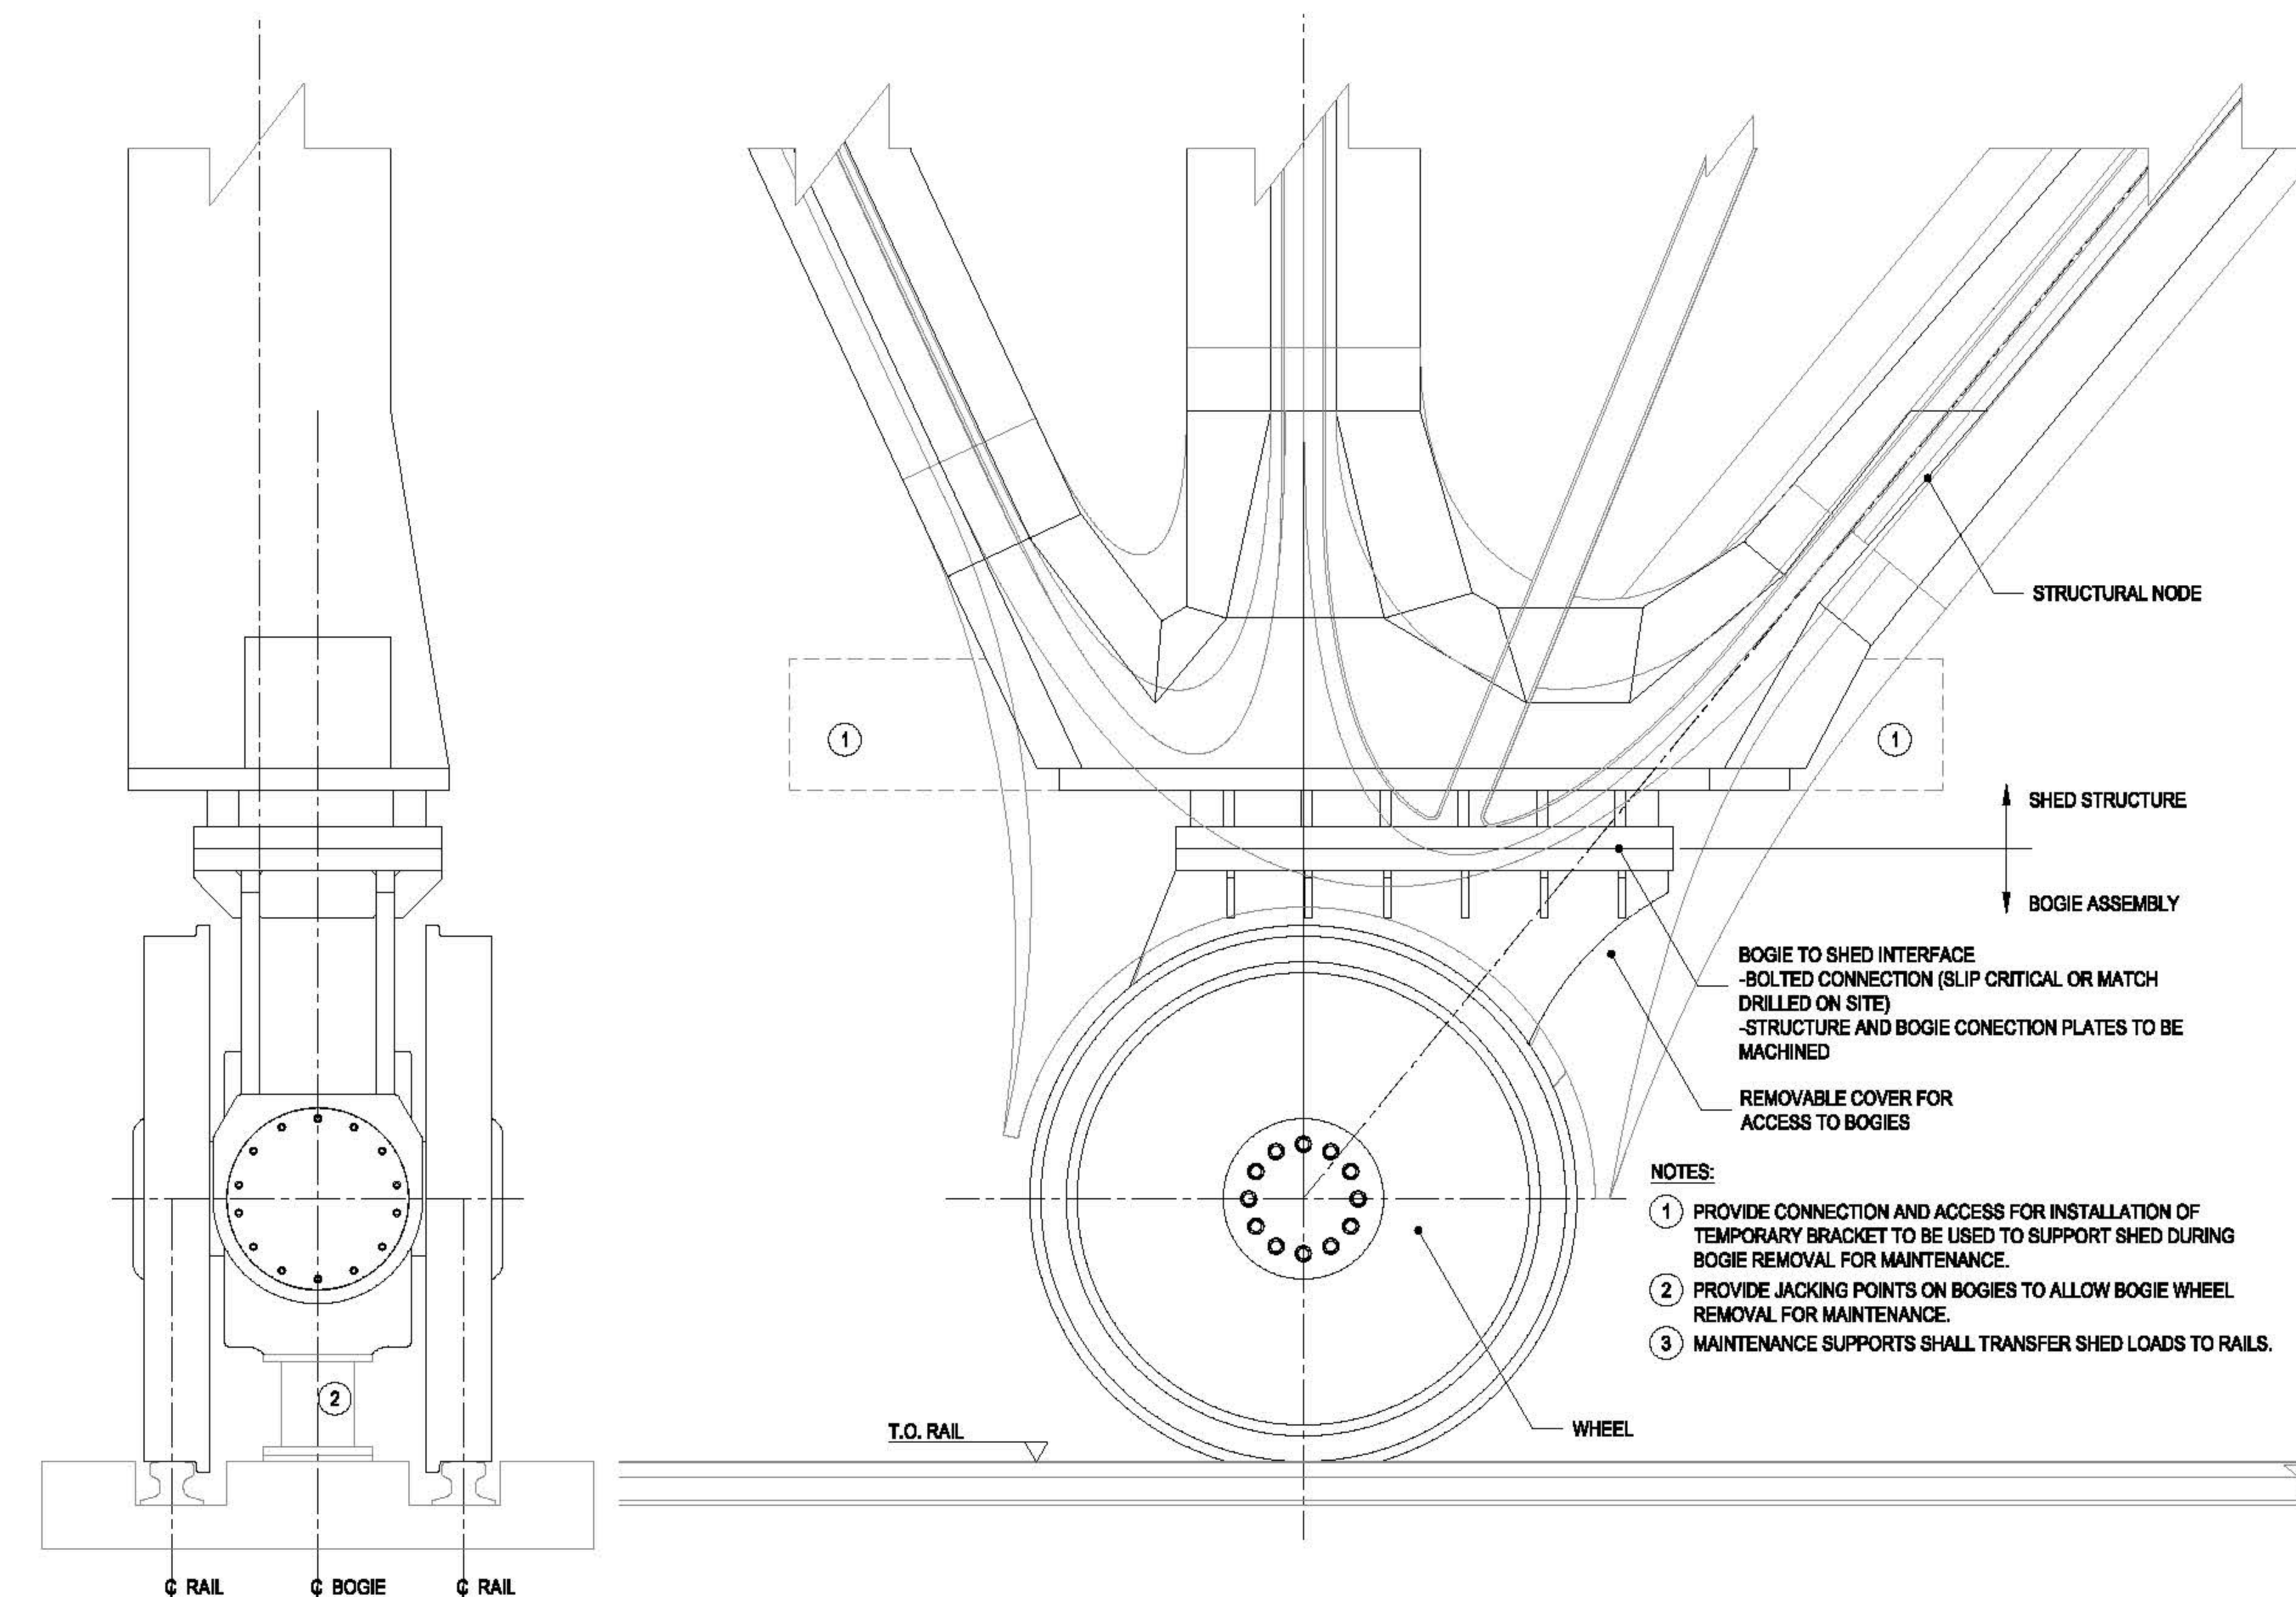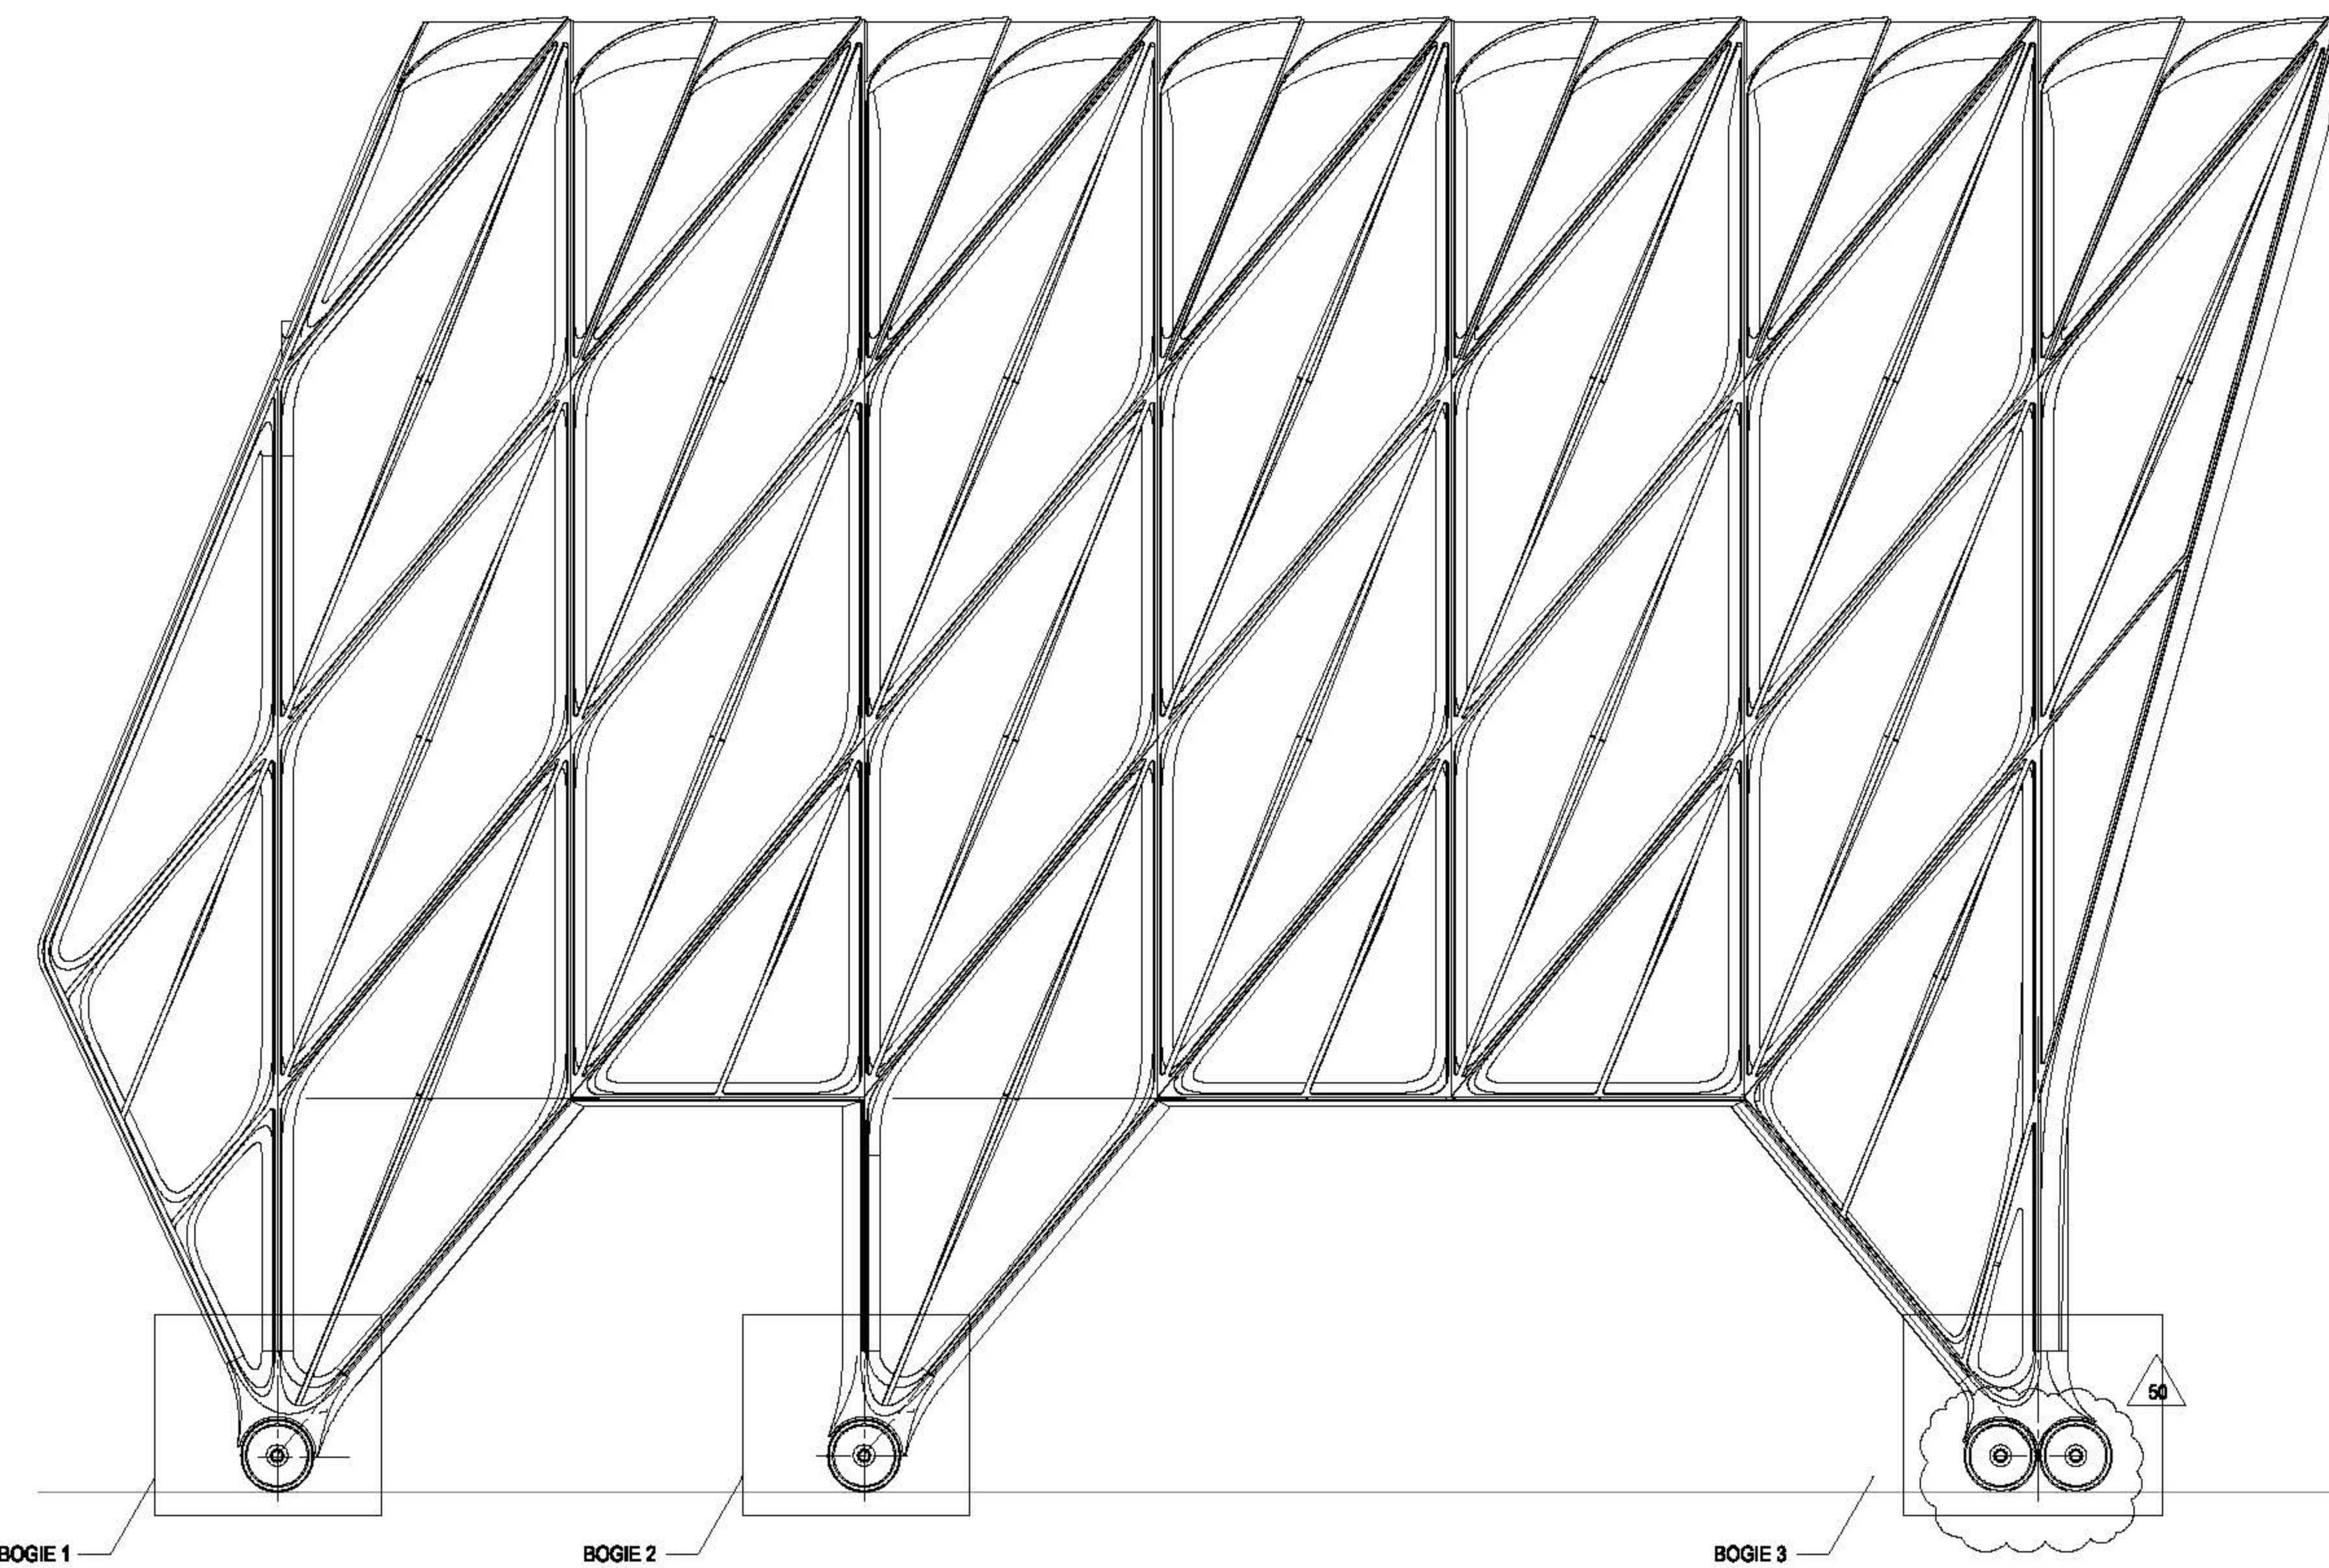

- STRUCTURAL NODE
SHED STRUCTURE
BOGIE ASSEMBLY
- BOGIE TO SHED INTERFACE
- BOLTED CONNECTION (SLIP CRITICAL OR MATCH DRILLED ON SITE)
- STRUCTURE AND BOGIE CONNECTION PLATES TO BE MACHINED
- REMOVABLE COVER FOR ACCESS TO BOGIES
- NOTES:
① PROVIDE CONNECTION AND ACCESS FOR INSTALLATION OF TEMPORARY BRACKET TO BE USED TO SUPPORT SHED DURING BOGIE REMOVAL FOR MAINTENANCE.
② PROVIDE JACKING POINTS ON BOGIES TO ALLOW BOGIE WHEEL REMOVAL FOR MAINTENANCE.
③ MAINTENANCE SUPPORTS SHALL TRANSFER SHED LOADS TO RAILS.

1 SOUTH ELEVATION
3/8" = 1'-0"

2 BOGIE 1
3/4" = 1'-0"

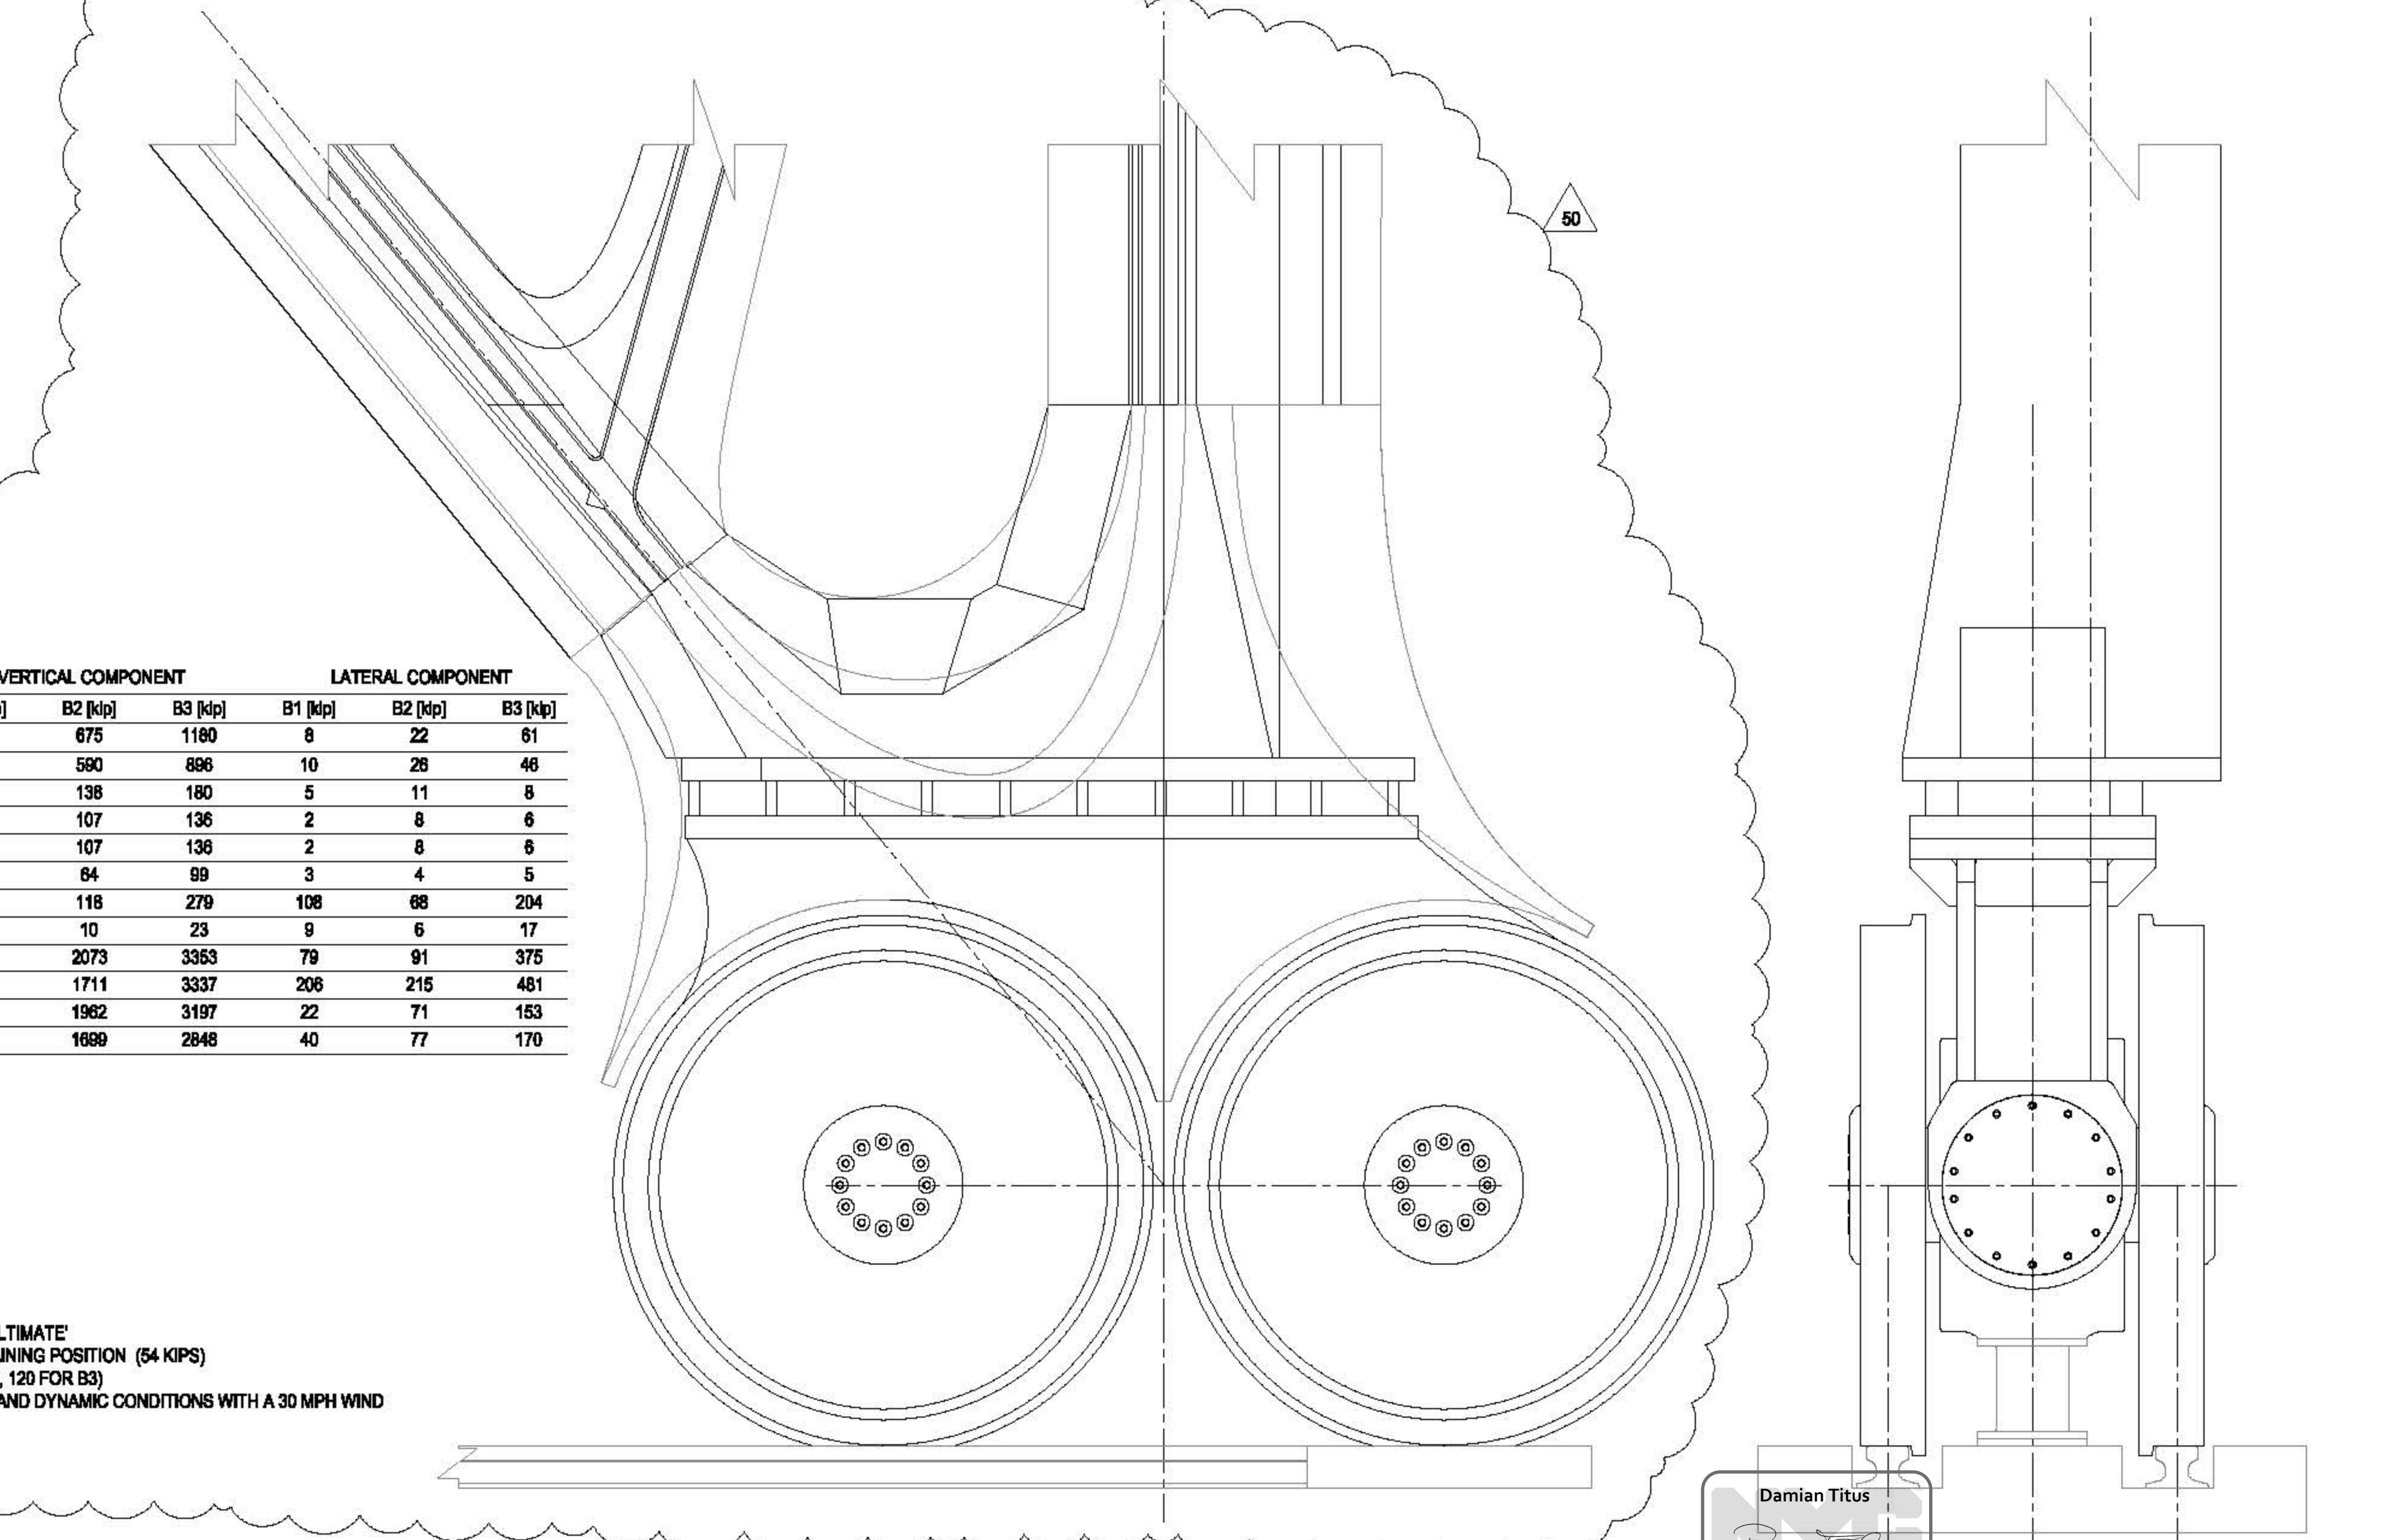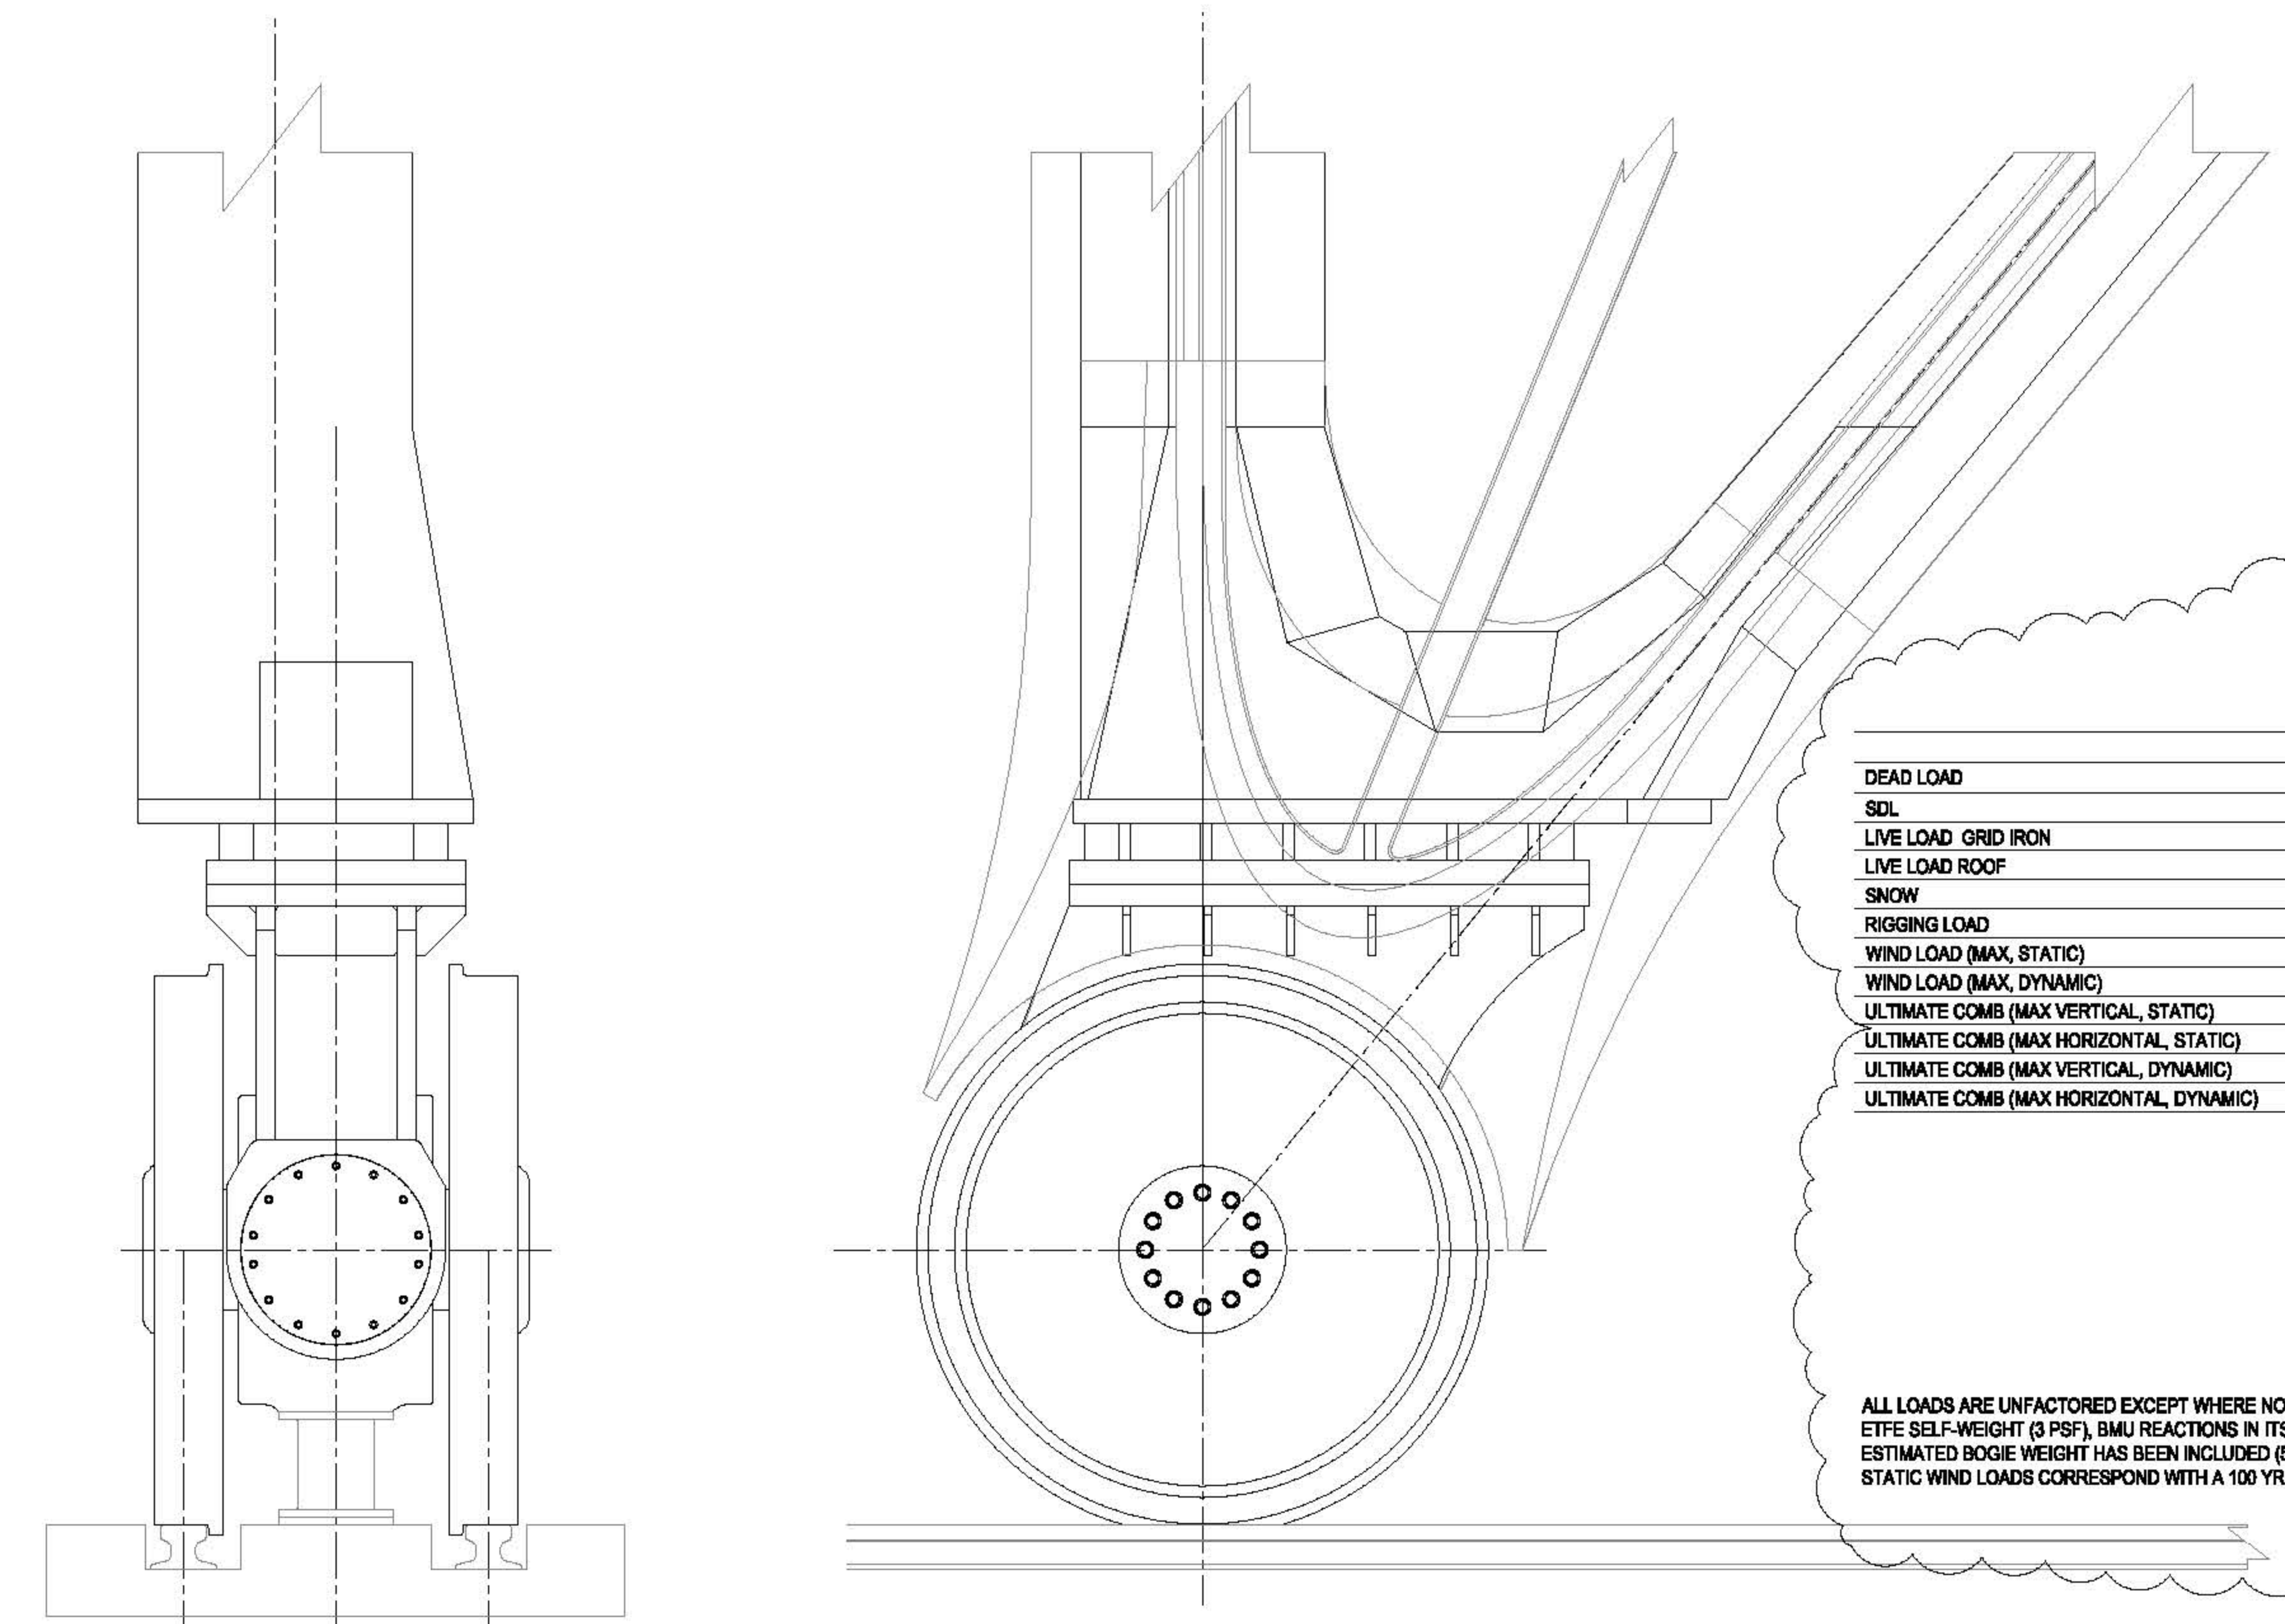


	VERTICAL COMPONENT			LATERAL COMPONENT		
	B1 [k]	B2 [k]	B3 [k]	B1 [k]	B2 [k]	B3 [k]
DEAD LOAD	297	675	1180	8	22	61
SDL	230	560	886	10	26	46
LIVE LOAD GRID IRON	50	138	180	5	11	8
LIVE LOAD ROOF	37	107	136	2	6	6
SNOW	37	107	136	2	6	6
RIGGING LOAD	32	64	89	3	4	5
WIND LOAD (MAX. STATIC)	67	118	279	108	68	204
WIND LOAD (MAX. DYNAMIC)	8	10	23	9	6	17
ULTIMATE COMB (MAX VERTICAL, STATIC)	658	2073	3353	79	91	375
ULTIMATE COMB (MAX HORIZONTAL, STATIC)	688	1711	3337	206	215	461
ULTIMATE COMB (MAX VERTICAL, DYNAMIC)	606	1962	3197	22	71	153
ULTIMATE COMB (MAX HORIZONTAL, DYNAMIC)	688	1688	2848	40	77	170

ALL LOADS ARE UNFACTORED EXCEPT WHERE NOTED 'ULTIMATE'
ETFE SELF-WEIGHT (3 PSF), BMU REACTIONS IN ITS REMAINING POSITION (54 KIPS)
ESTIMATED BOGIE WEIGHT HAS BEEN INCLUDED (88 KIPS, 120 FOR 33)
STATIC WIND LOADS CORRESPOND WITH A 100 YR WIND AND DYNAMIC CONDITIONS WITH A 30 MPH WIND

3 BOGIE 2
3/4" = 1'-0"

4 BOGIE 3
3/4" = 1'-0"

KEY PLAN

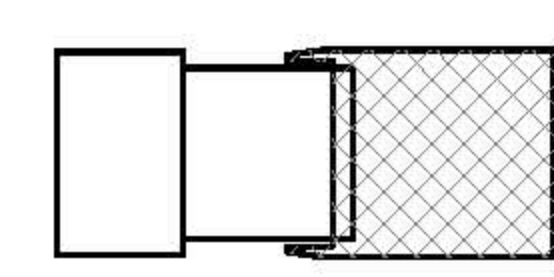

ISSUE PRINTING DATE

REV	DESCRIPTION	DATE
01	DOB AMENDMENT 7	08.19.2018
10	100% CONSTRUCTION DOCUMENTS	03.18.2019
9	90% CONSTRUCTION DOCUMENTS	02.18.2019
8	PRELIMINARY DESIGN SUBMISSION	12.10.2014
1	ADVANCED PROCUREMENT BID SET	08.18.2014

FOR BIDDING ONLY
NOT FOR CONSTRUCTION
STAMP



DRAWN BY: MGC
CHECKED BY: SL
PROJECT NUMBER: N11318.00

TITLE: SHED TO BOGIE CONNECTIONS

DRAWING NO.: S-765.01

D-SCAN NO.: S-765.01

100 of 120

PENDING COORDINATION DURING DESIGN ASSIST

CULTURE SHED
545 West 30th Street
New York, New York 10001

OWNER
CULTURE SHED INC

ARCHITECTS
Diller Scofidio + Renfro Architects, DPC
601 West 28 Street #815
New York, New York 10001
T: 212.360.7871

STRUCTURAL ENGINEER
Thornton Tomasetti
51 Madison Avenue
New York, New York 10010
T: 917.861.7800
F: 917.861.7801

MEP ENGINEER
Jawa Baum & Bolles
50 Park Street
New York, New York 10005
T: 212.250.0000
F: 212.250.0594

FACADE CONSULTANT
Thornton Tomasetti
51 Madison Avenue
New York, New York 10010
T: 917.861.7800
F: 917.861.7801

KINETICS ENGINEER
Hardisty & Heston
1001 Broadway
New York, New York 10036
T: 212.844.1150
F: 212.267.0297

LIGHTING DESIGNER
Tilcon Design Associates
40 West Street #902
New York, New York 10013
T: 212.676.7790

THEATRE PLANNING & DESIGN
Fisher Dodge Associates
22 West 16th Street
New York, New York 10011
T: 212.851.3000

LIFE SAFETY
Code Consultants, Inc.
215 West 40th St, 10th Fl
New York, New York 10018
T: 212.216.8586

ENERGY MODELEED
Virtman
50 Washington Street
Norwalk, CT 06854
T: 203.295.1411

ACOUSTICAL/AUDIO-VISUAL
Alumville
93 North Main Street
South Norwalk, CT 06854
T: 947.210.5540

VERTICAL TRANSPORTATION
Van Dusen & Associates
5 Regent Street, Suite 504
Lynchburg, NJ 07039
T: 973.994.8220

SPECIFICATIONS
Construction Specifications Inc.
PO Box 488
22 Tenney Road
Morristown, NJ 07951
T: 732.870.0700
F: 732.870.0700


SECURITY
Ducibelle Venter & Santoro
1020 Sherman Avenue
Hartford, CT 06114
T: 203.288.8490

WATERPROOFING
James R. Gairford AIA Consulting Architects PC
104 West 27th Street
New York, NY 10001
T: 212.736.3344

FACADE MAINTENANCE
Smith Engineering PLLC
160 Avenue
New York, NY 10006
T: 212.696.3000

BRANDING/GRAPHICS
204 Global Design Consultancy
180 West Street, 15th Floor
New York, NY 10014
T: 212.647.1170

KEY PLAN

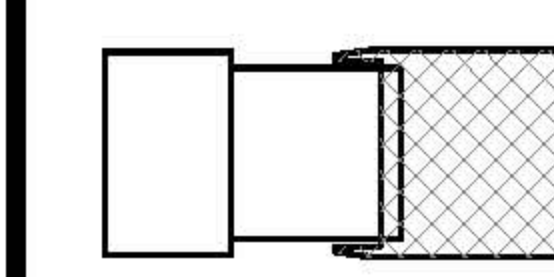

ISSUE PRINTING DATE

81	50	DOB AMENDMENT 7	08/18/2016
10		100% CONSTRUCTION DOCUMENTS	03/18/2015
9		90% CONSTRUCTION DOCUMENTS	02/18/2015
8		PRELIMINARY OBS SUBMISSION	12/18/2014
1		ADVANCED PROCUREMENT BID SET	08/18/2014

FOR BIDDING ONLY
NOT FOR CONSTRUCTION
STAMP



DRAWN BY
MG

CHECKED BY
SL


PROJECT NUMBER
N11818.00

TITLE
SHED TO BOGIE DETAILS


DRAWING NO.
S-766.01

8-6CAN NO.
S-766.01


101 of 123

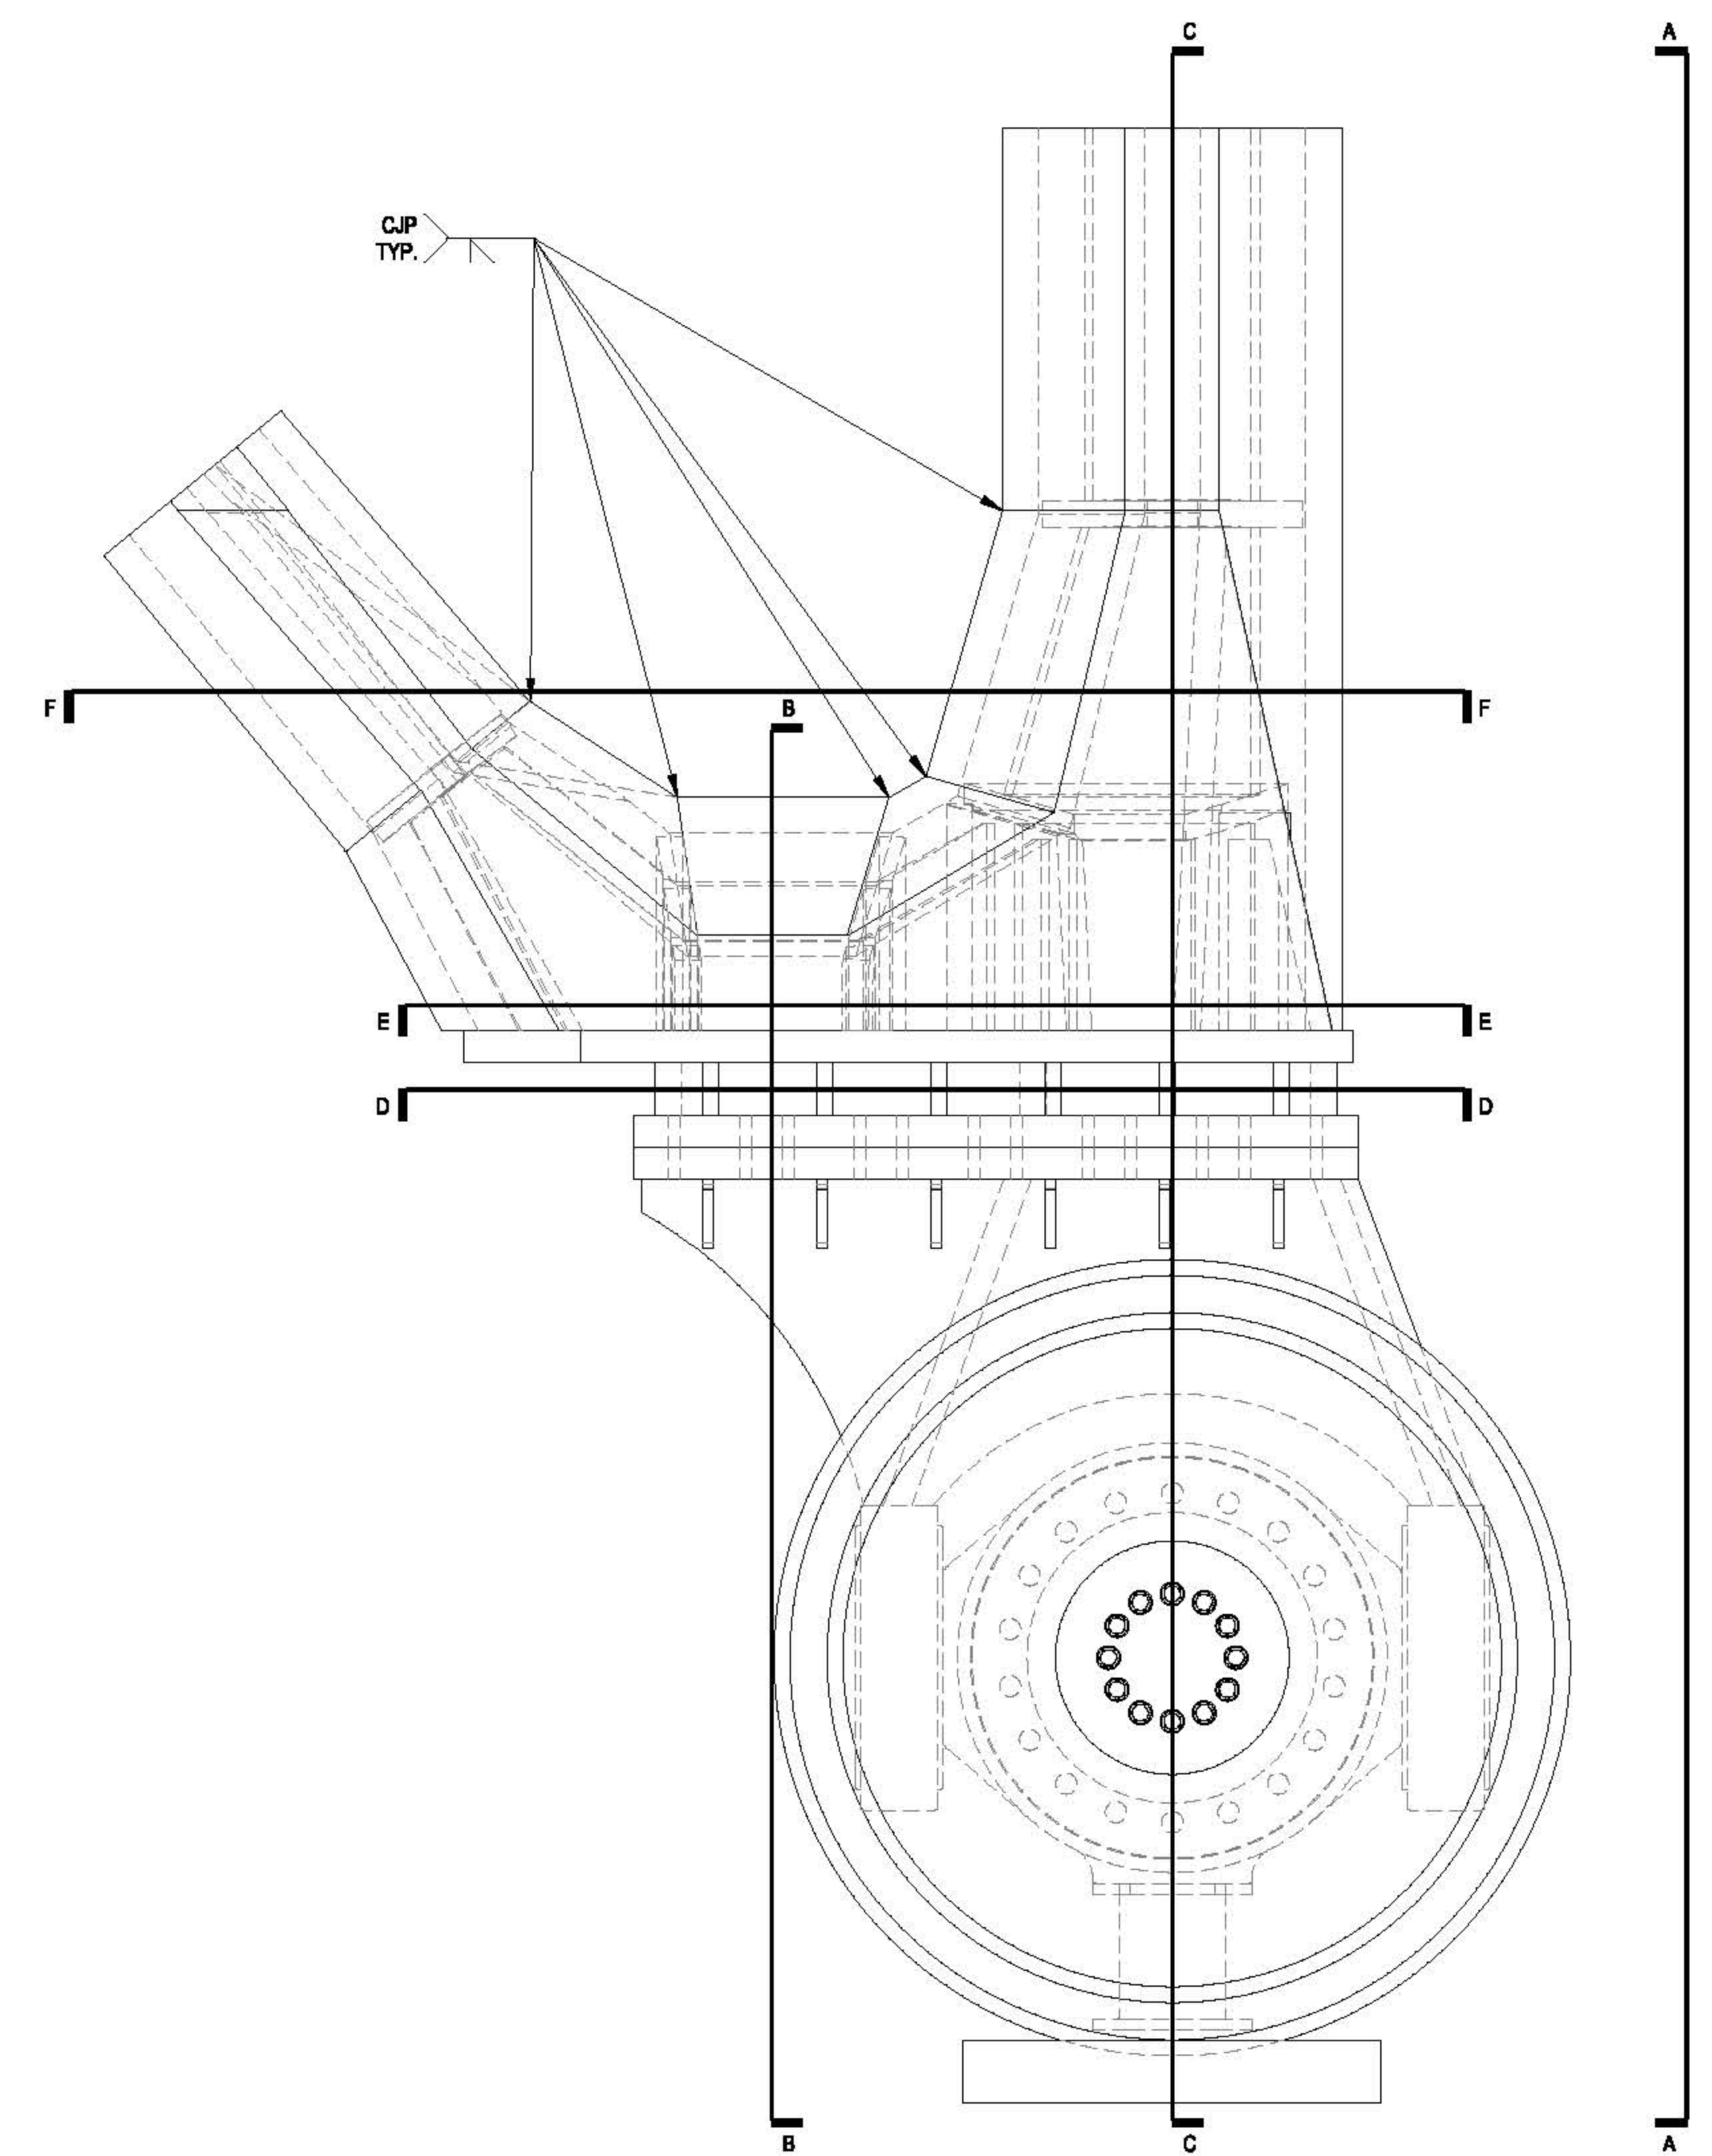


1 SOUTH ELEVATION
1" = 1'-0"

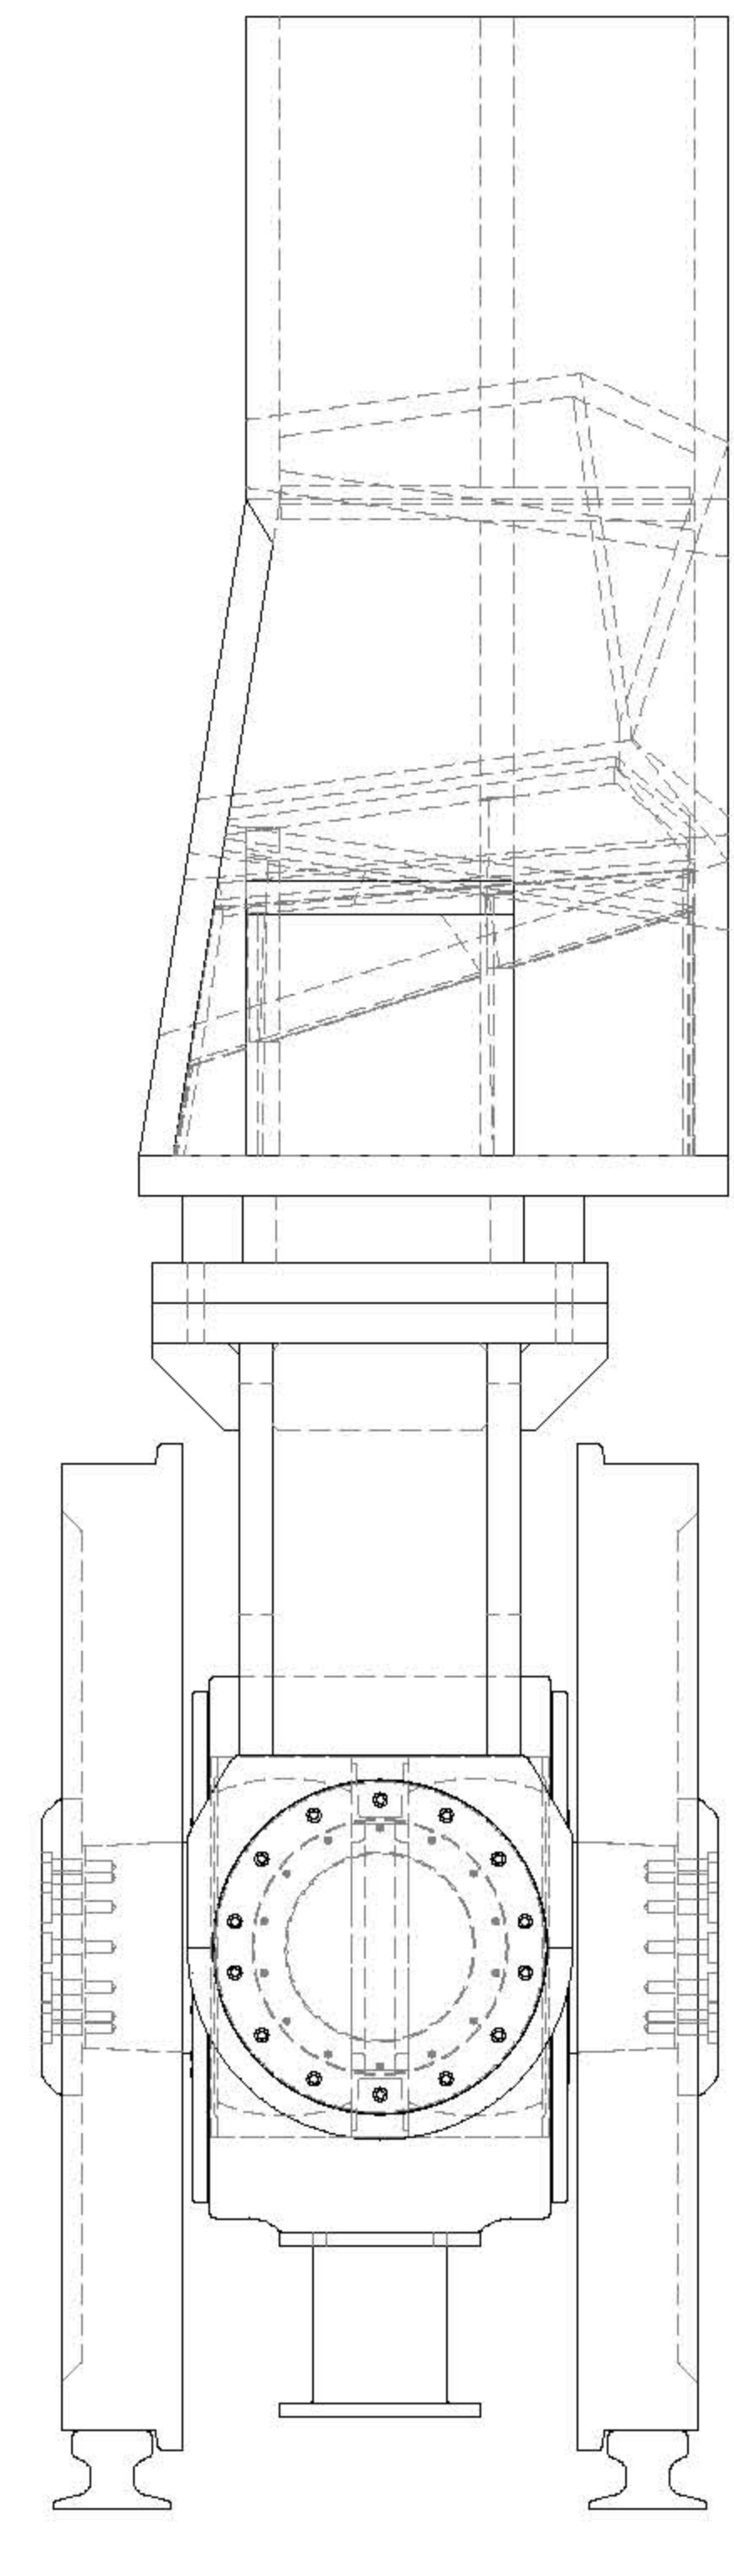

2 VIEW A-A
1" = 1'-0"

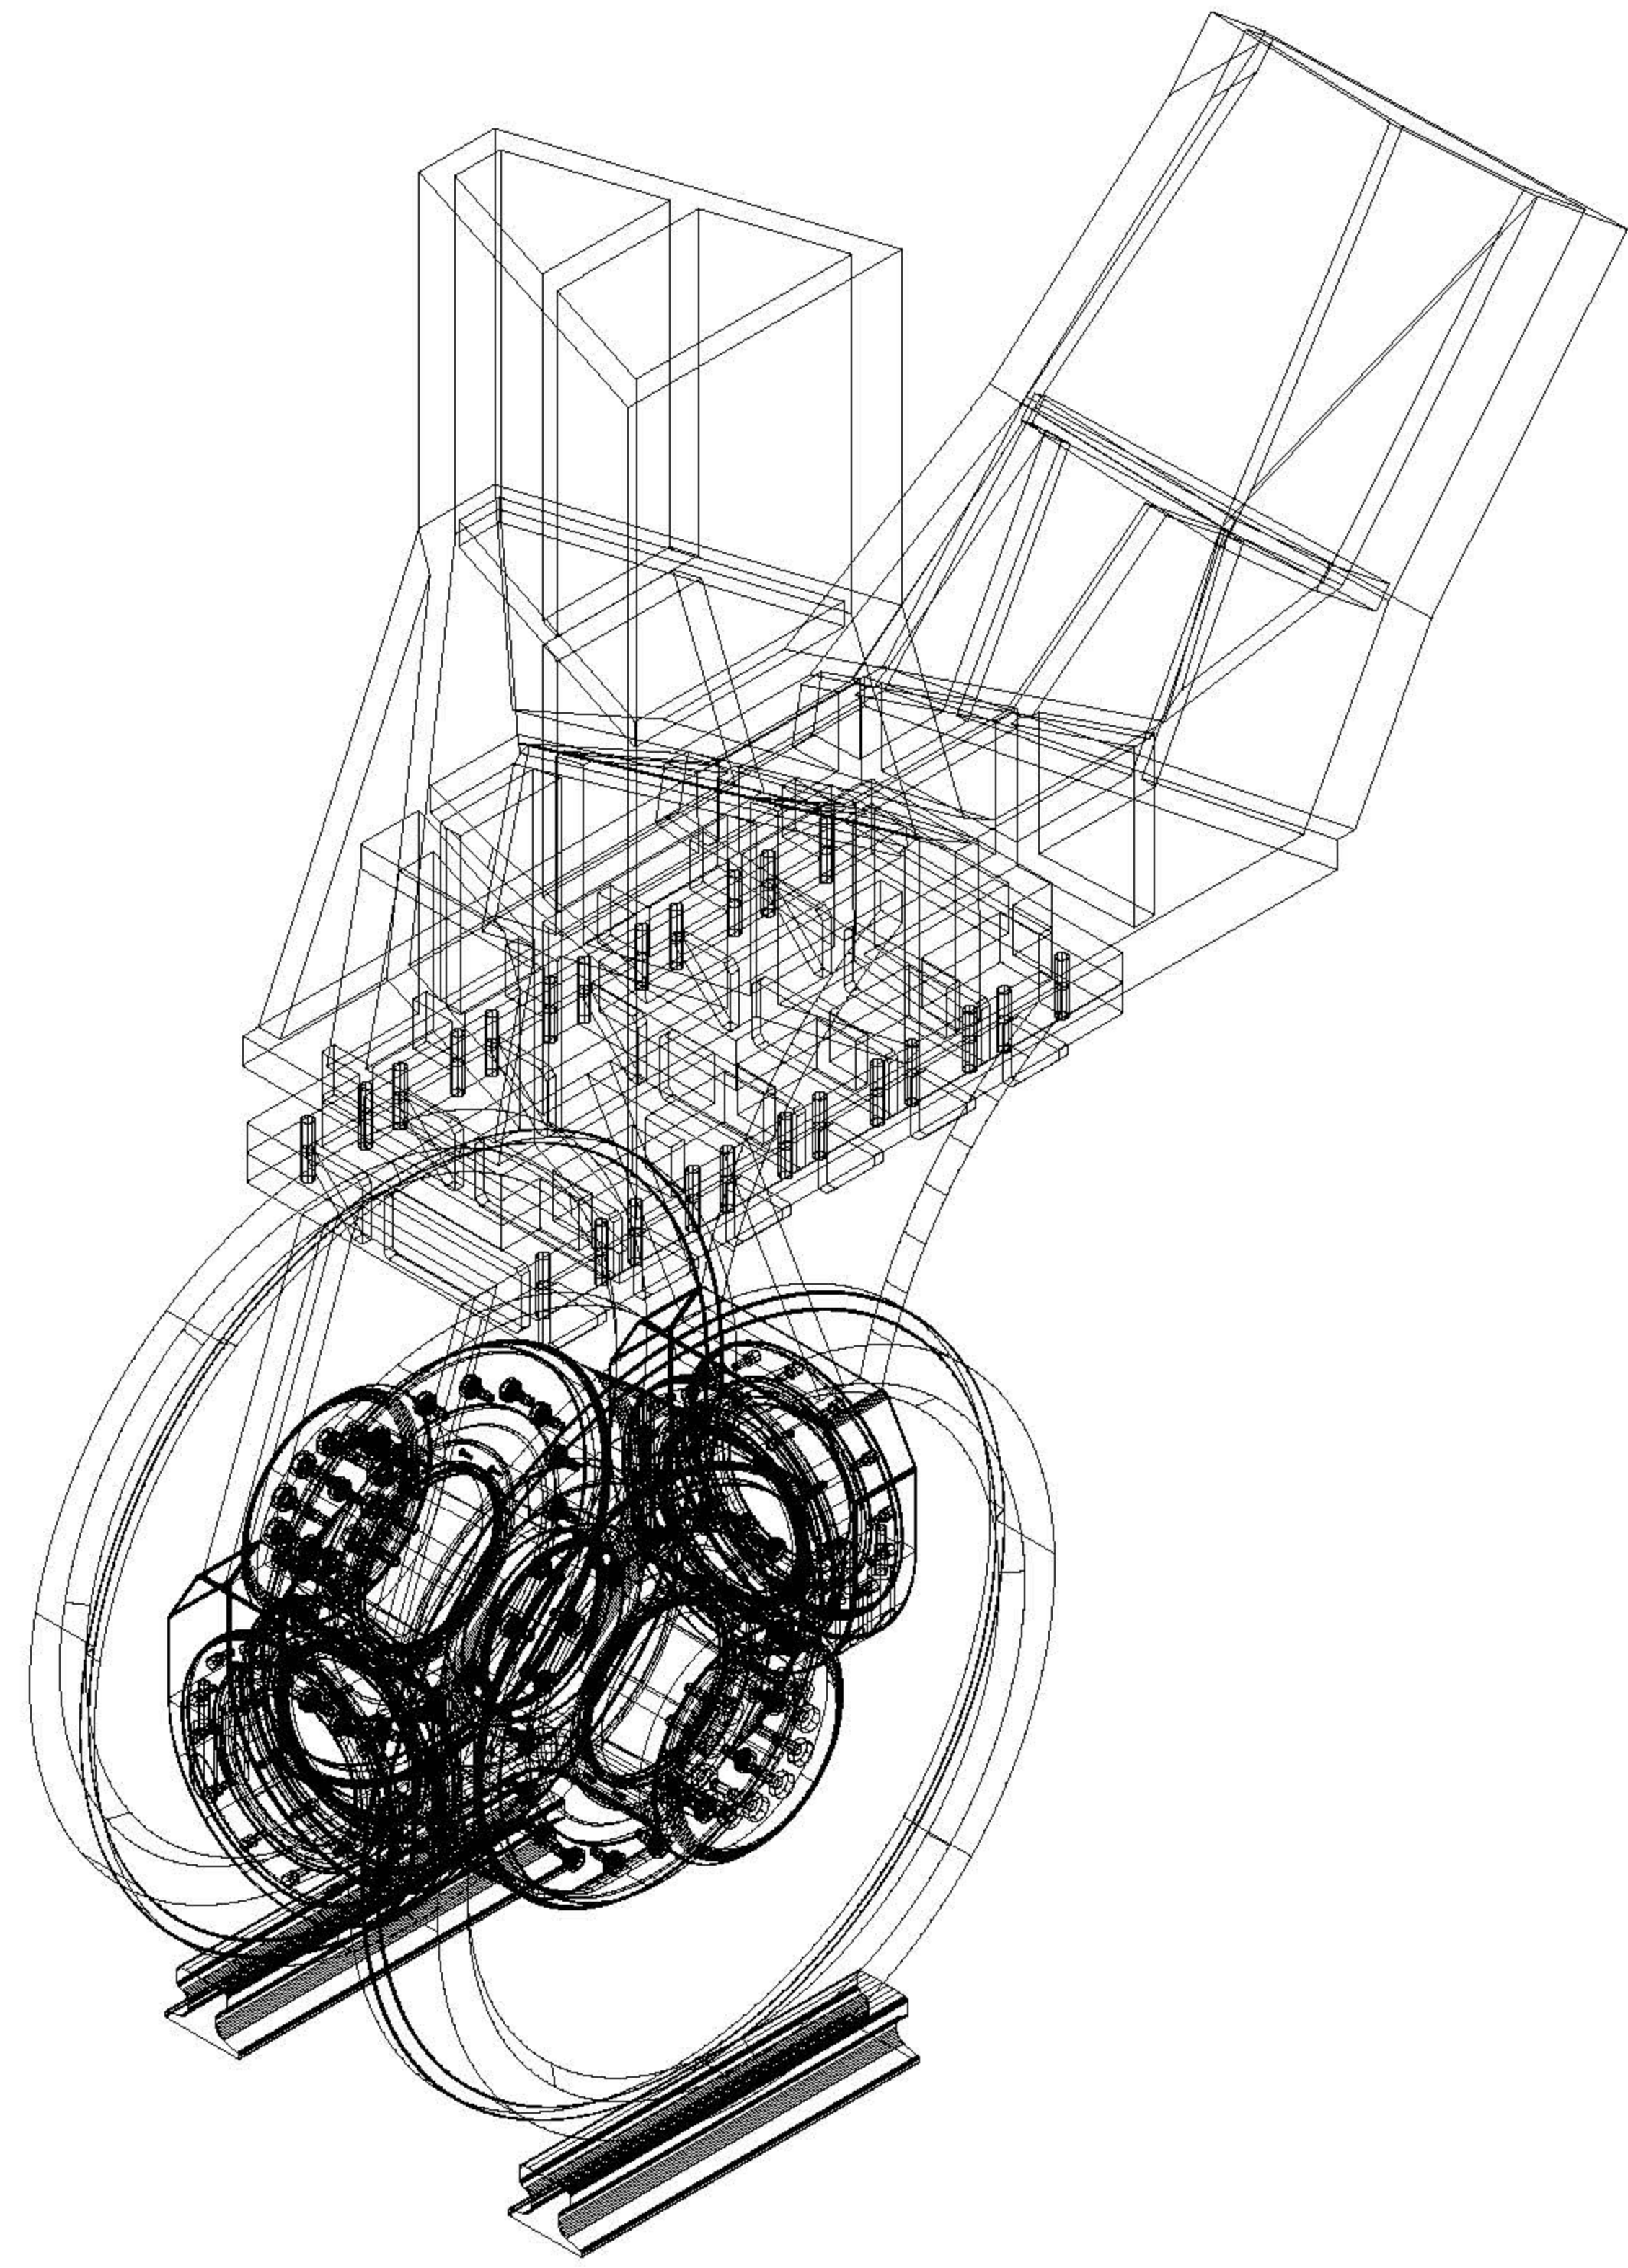


3 AXONOMETRIC

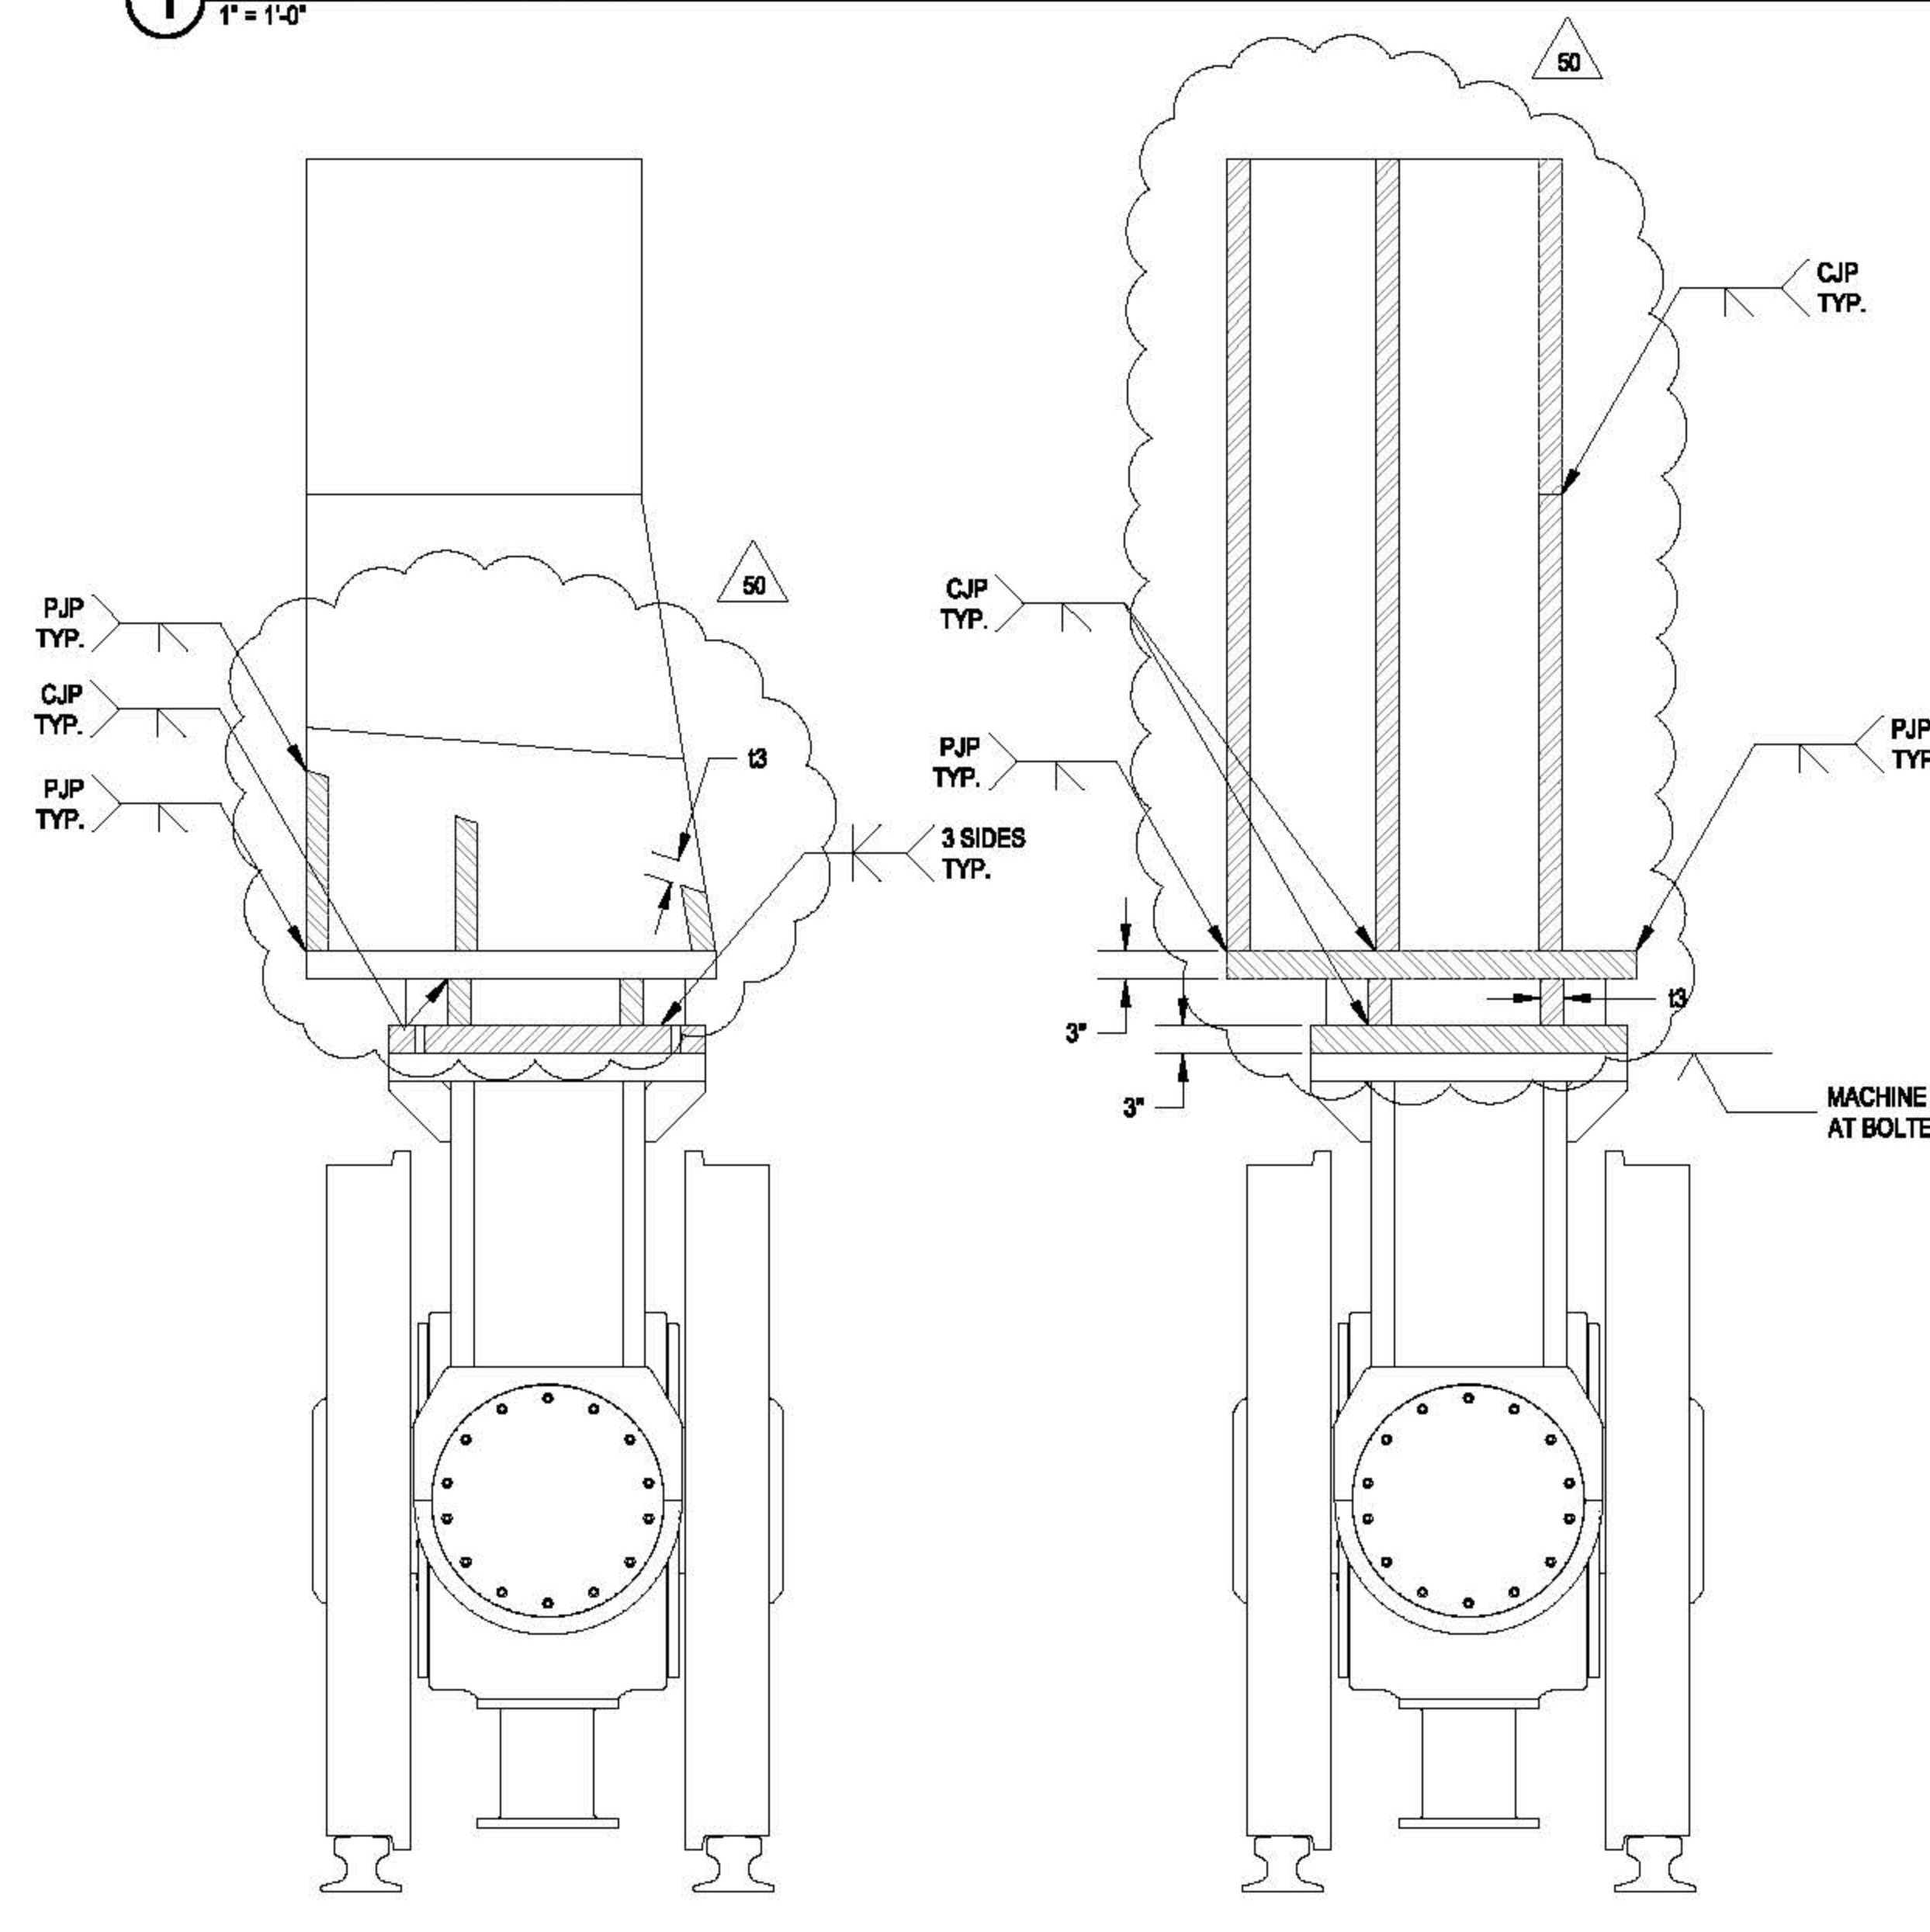


3 SECTION B-B
3/4" = 1'-0"


4 SECTION C-C
3/4" = 1'-0"

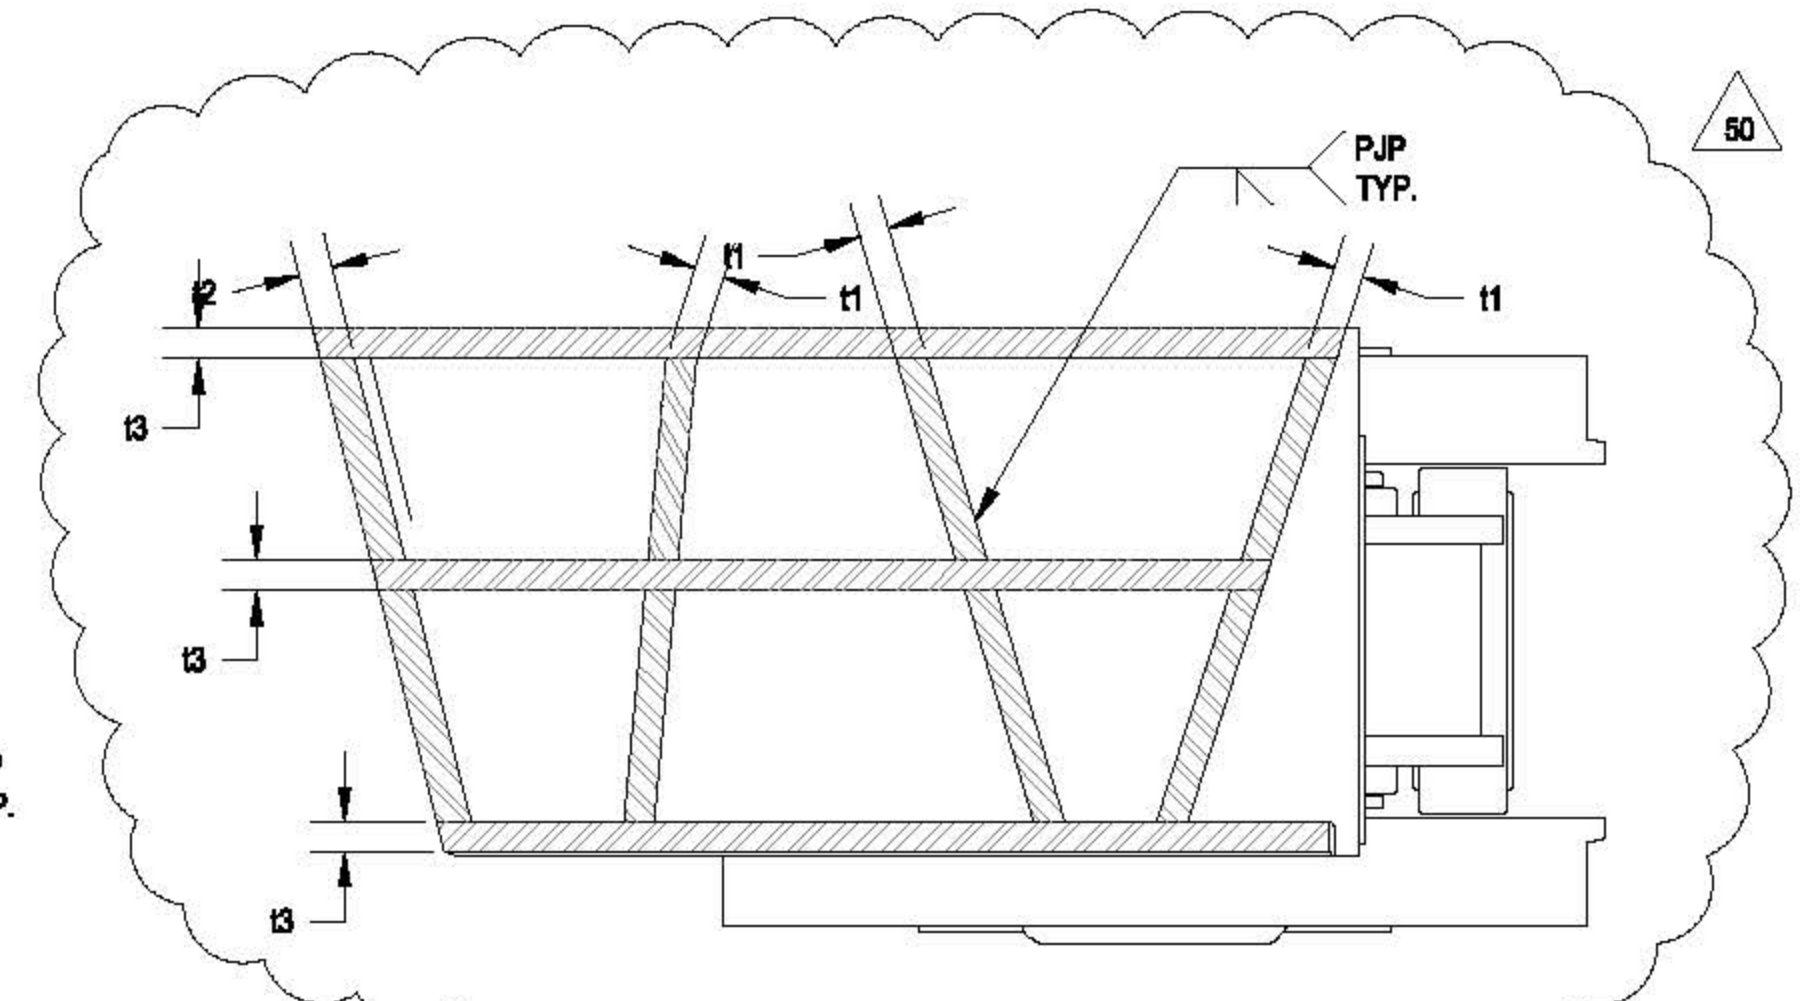

5 SECTION E-E
3/4" = 1'-0"

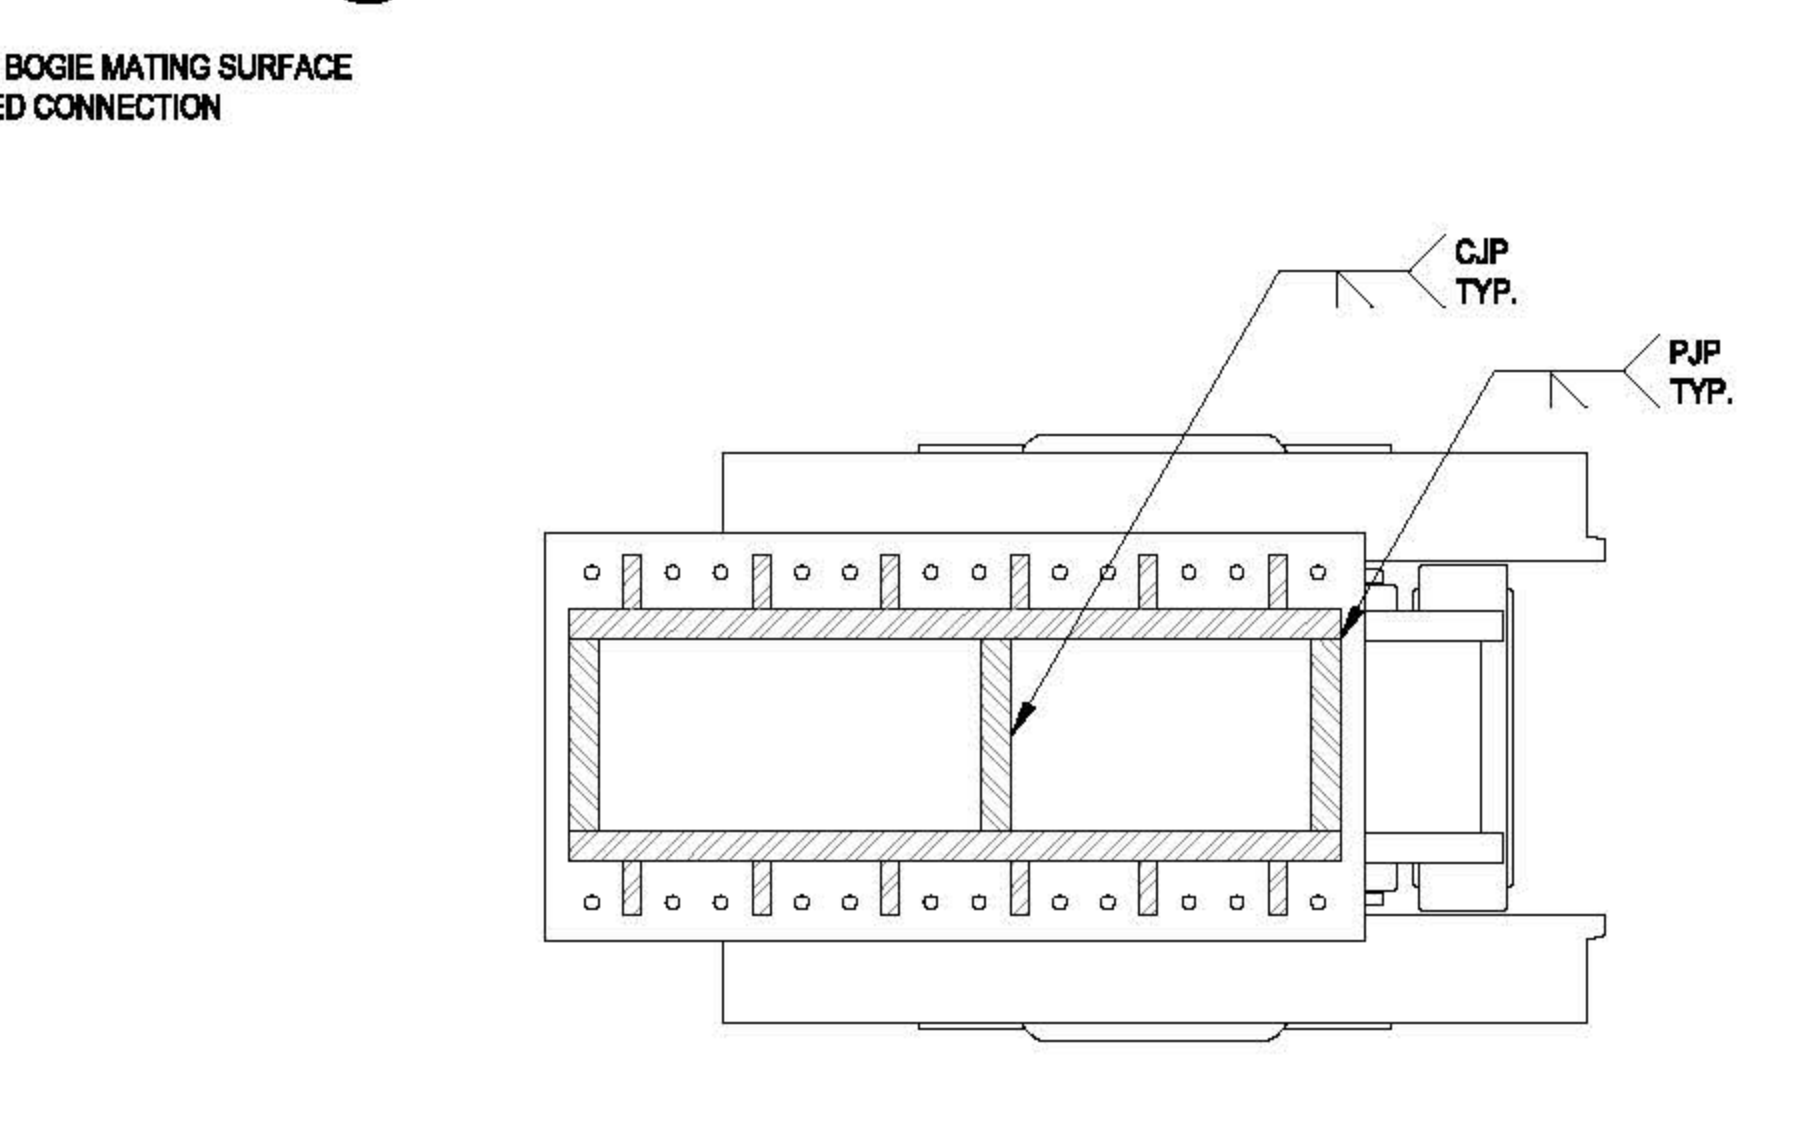


6 SECTION D-D
3/4" = 1'-0"

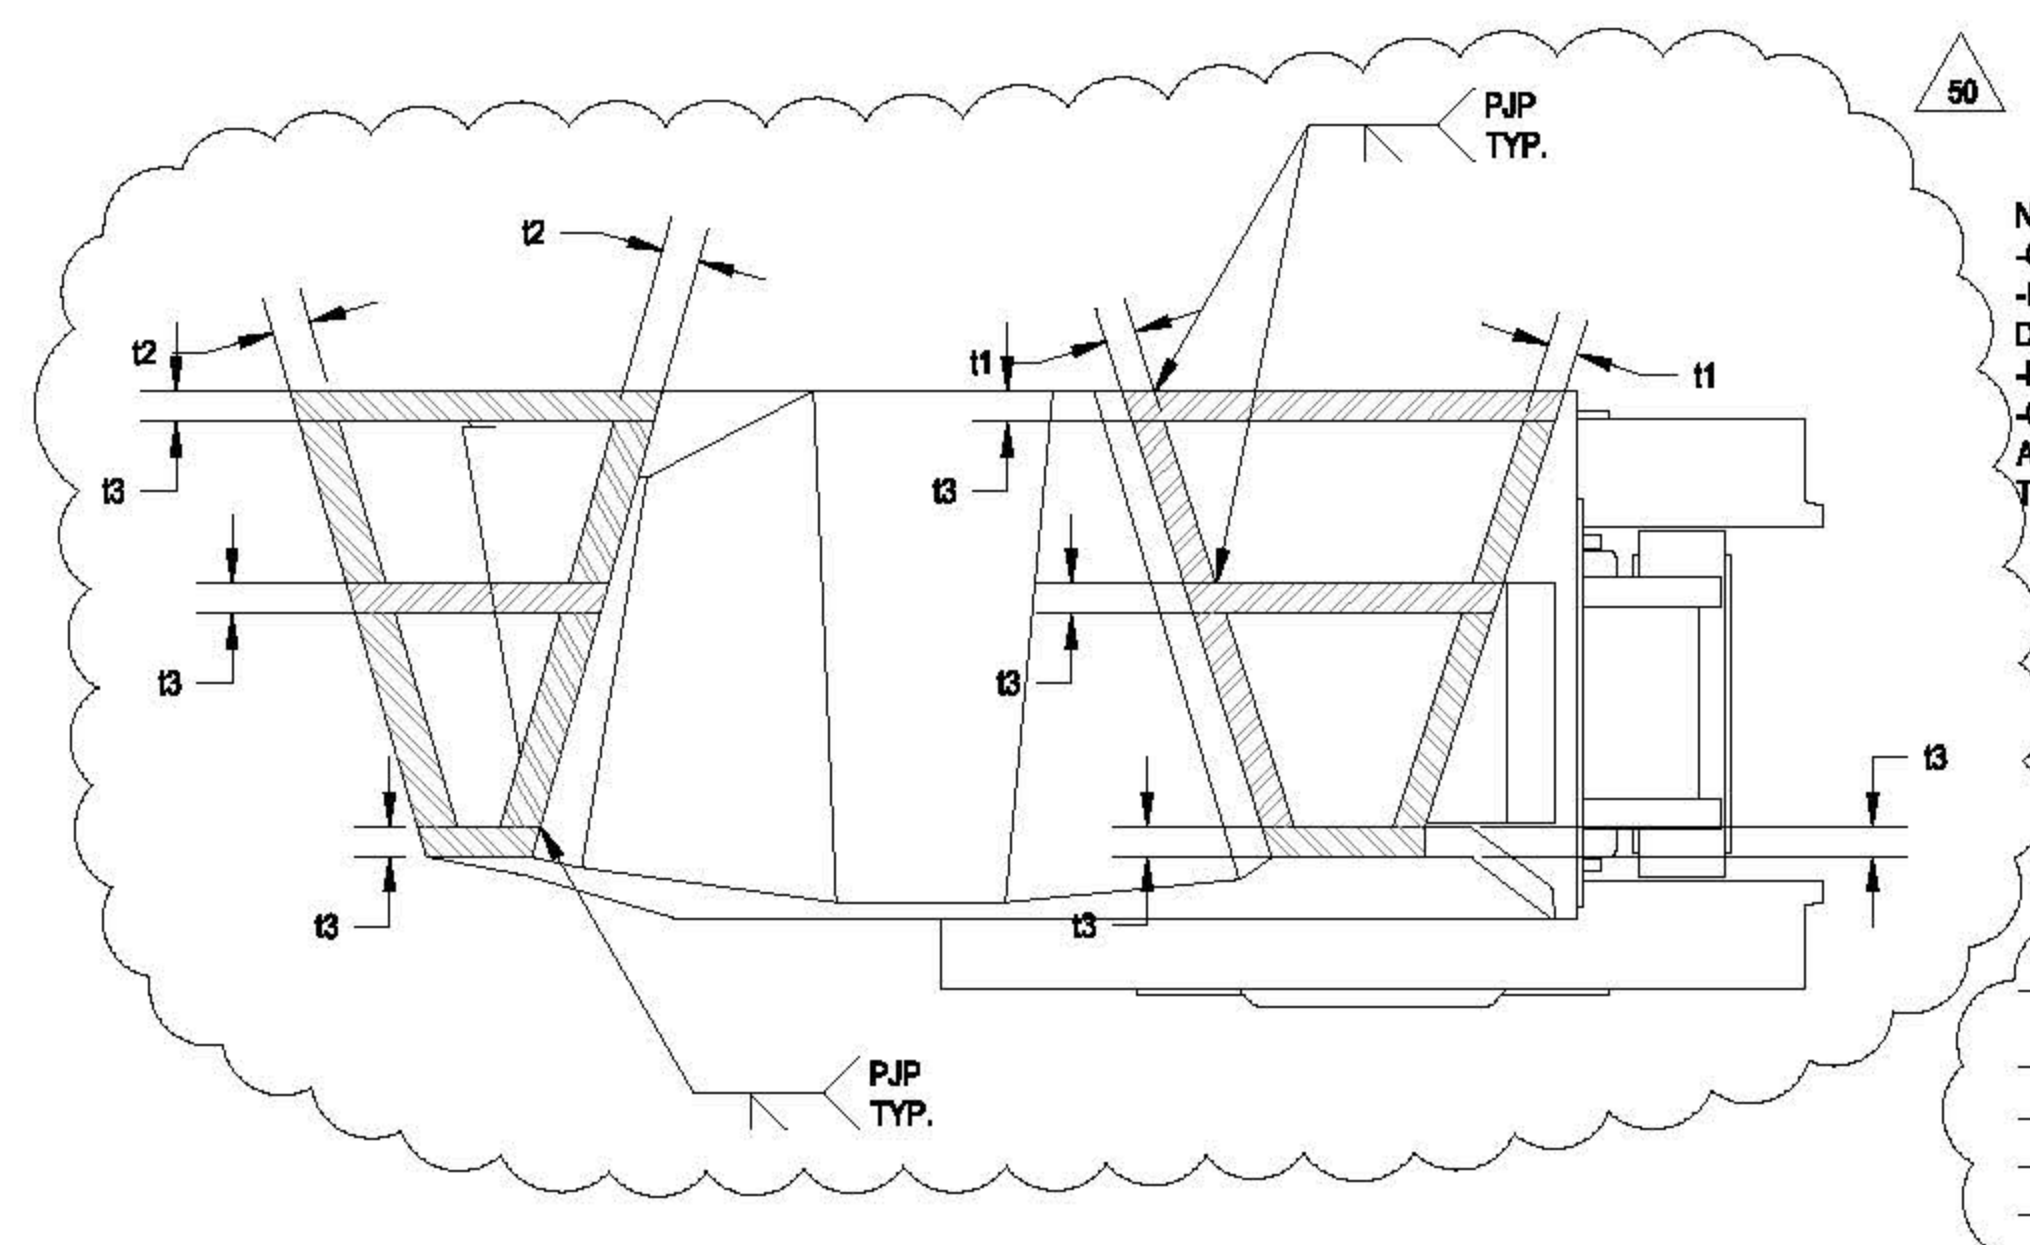


7 SECTION F-F
3/4" = 1'-0"

NOTES:
-GEOMETRY IS BASED ON WELDED CONSTRUCTION FROM FLAT PLATES
-INTERNAL PLATE CONFIGURATION AND WELD SEQUENCE TO BE DEVELOPED DURING DESIGN ASSIST PHASE
-PLATE THICKNESS IS 2 INCH UNLESS NOTED
-CASTINGS MAY BE PROPOSED AS AN ALTERNATE, SUBJECT TO AGREEMENT WITH THE ARCHITECT AND SER. REFER TO SPECIFICATION AND ARCHITECTURAL DRAWINGS FOR THE INTERFACE BETWEEN THE CASTING AND STEELWORK (I.E. THE REVEAL).


THICKNESS	11 [in]	12 [in]	13 [in]
BOGIE B1	3/4	3/8	1 1/2
BOGIE B2	3/4	1 1/4	1 1/2
BOGIE B3	2 1/2	1	2 1/2

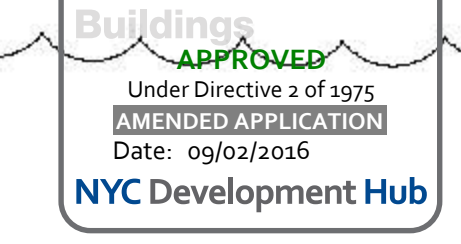


GEOMETRY, DIMENSIONS AND SURFACE CONTOURING, BLENDING AND INTERSECTION OF SECTIONS ILLUSTRATED IN THE STRUCTURAL DRAWINGS ARE PROVIDED FOR REFERENCE AND GENERATION OF STRUCTURAL ARRANGEMENT AND DETAILS ONLY. THE 3D MODEL ISSUED BY THE ARCHITECT DEFINES THE EXTERIOR SURFACE AND SHALL BE ADHERED TO FOR THE FINAL GEOMETRY. FOR DETAILS OF SECONDARY STEEL, INCLUDING STRUCTURAL CLADDING REFER TO ARCHITECTURE DRAWINGS. IT IS THE RESPONSIBILITY OF THE CONTRACTOR TO IDENTIFY ANY DISCREPANCIES OR AMBIGUITIES FOR DISCUSSION, RESOLUTION AND DIRECTION FROM THE ARCHITECT AND SER.

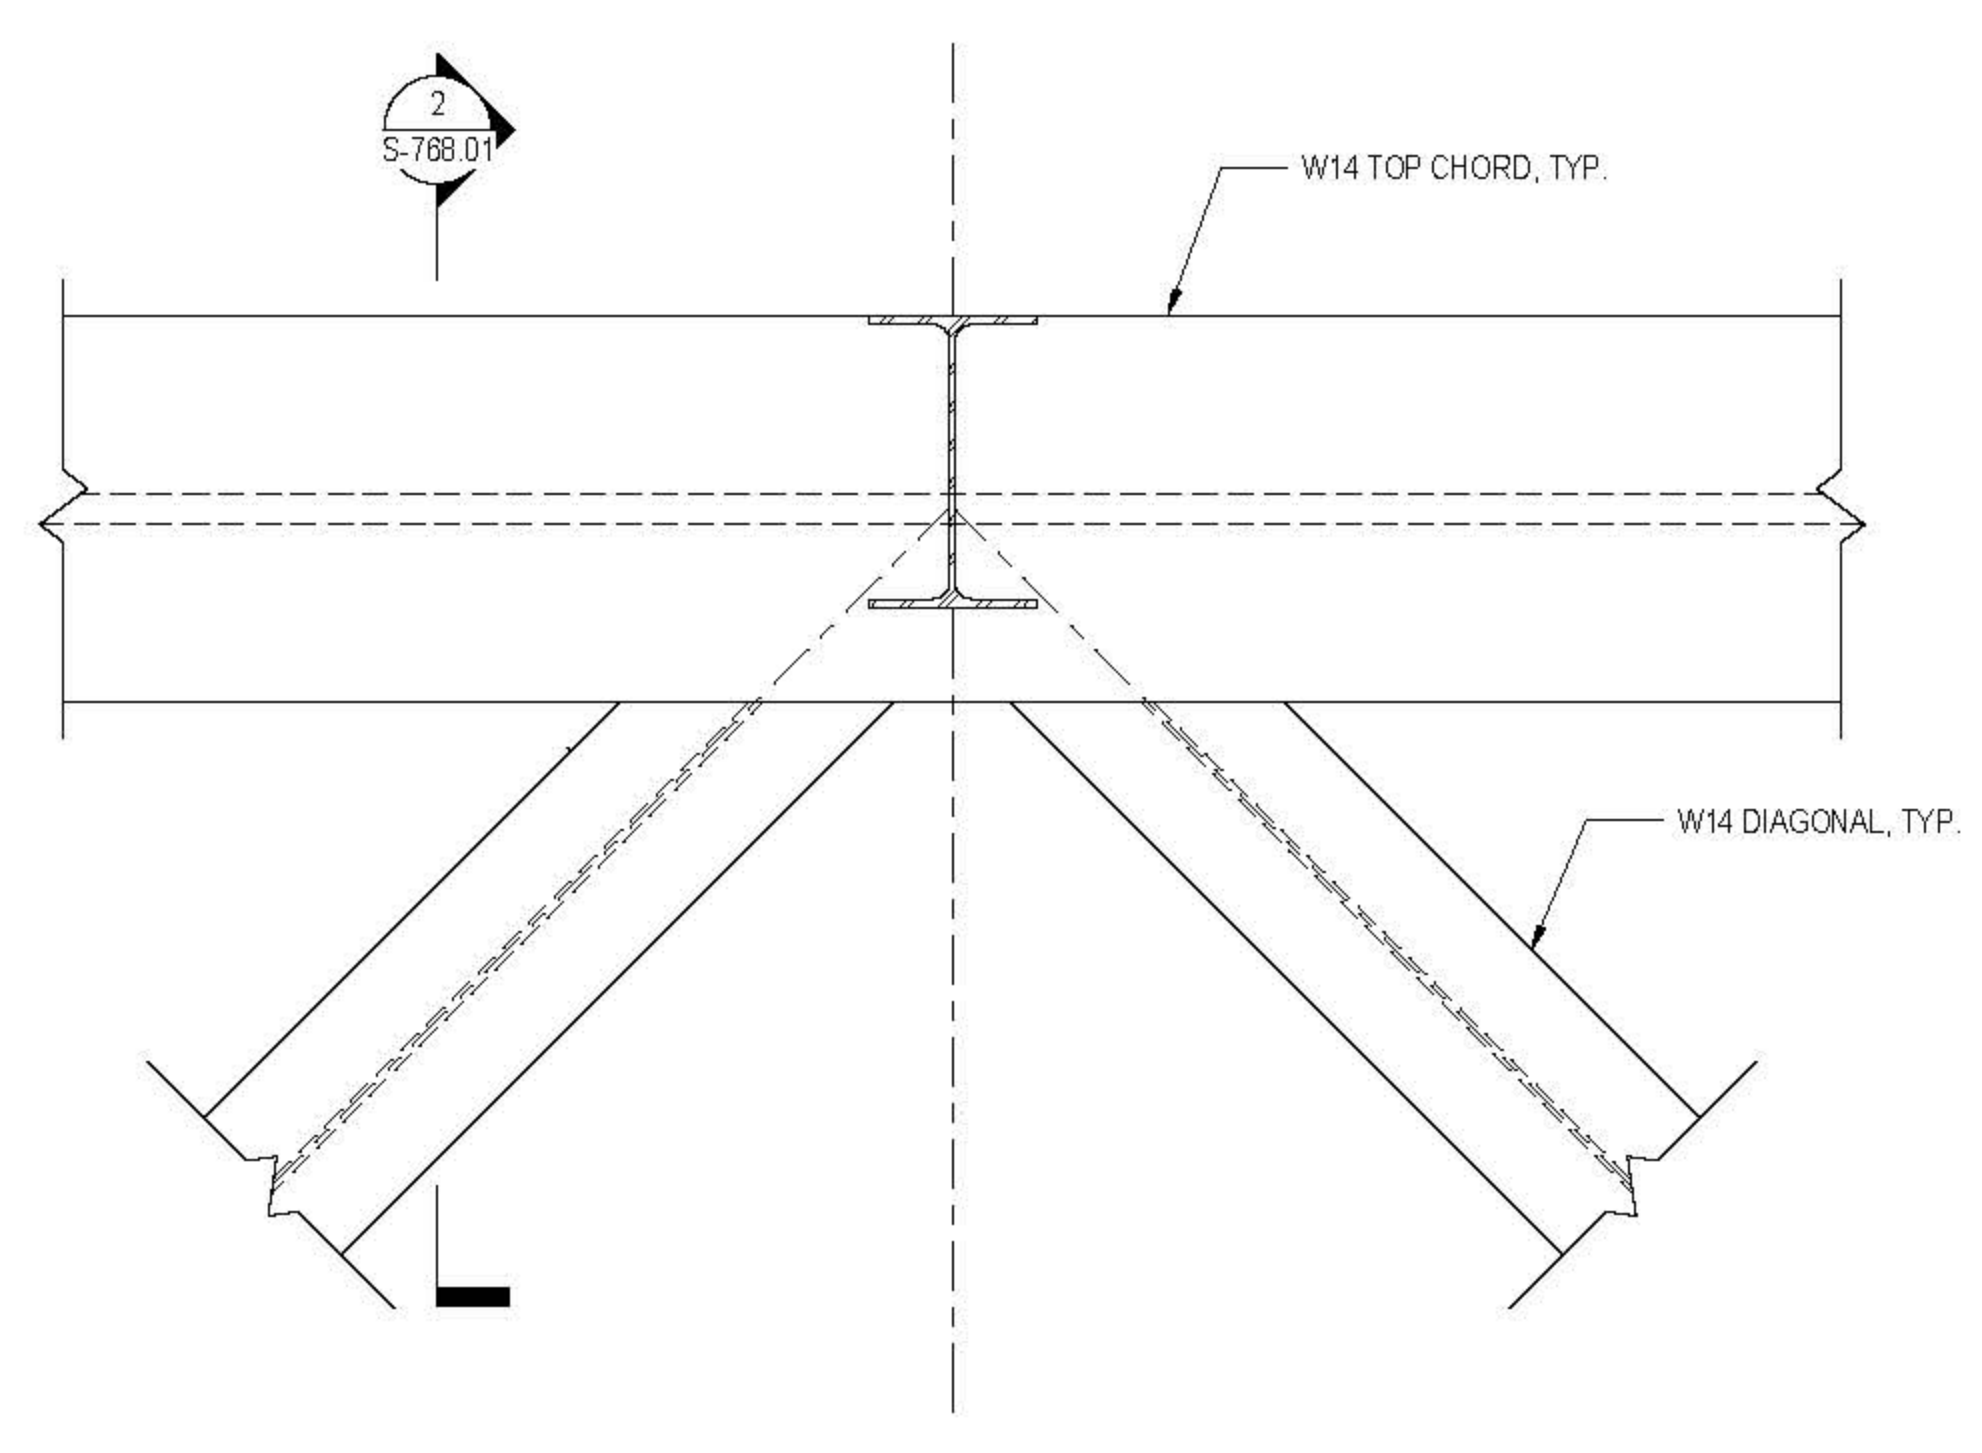


1 TYPICAL TRUSS CONNECTION AT TOP CHORD
 1/16" = 1'-0"

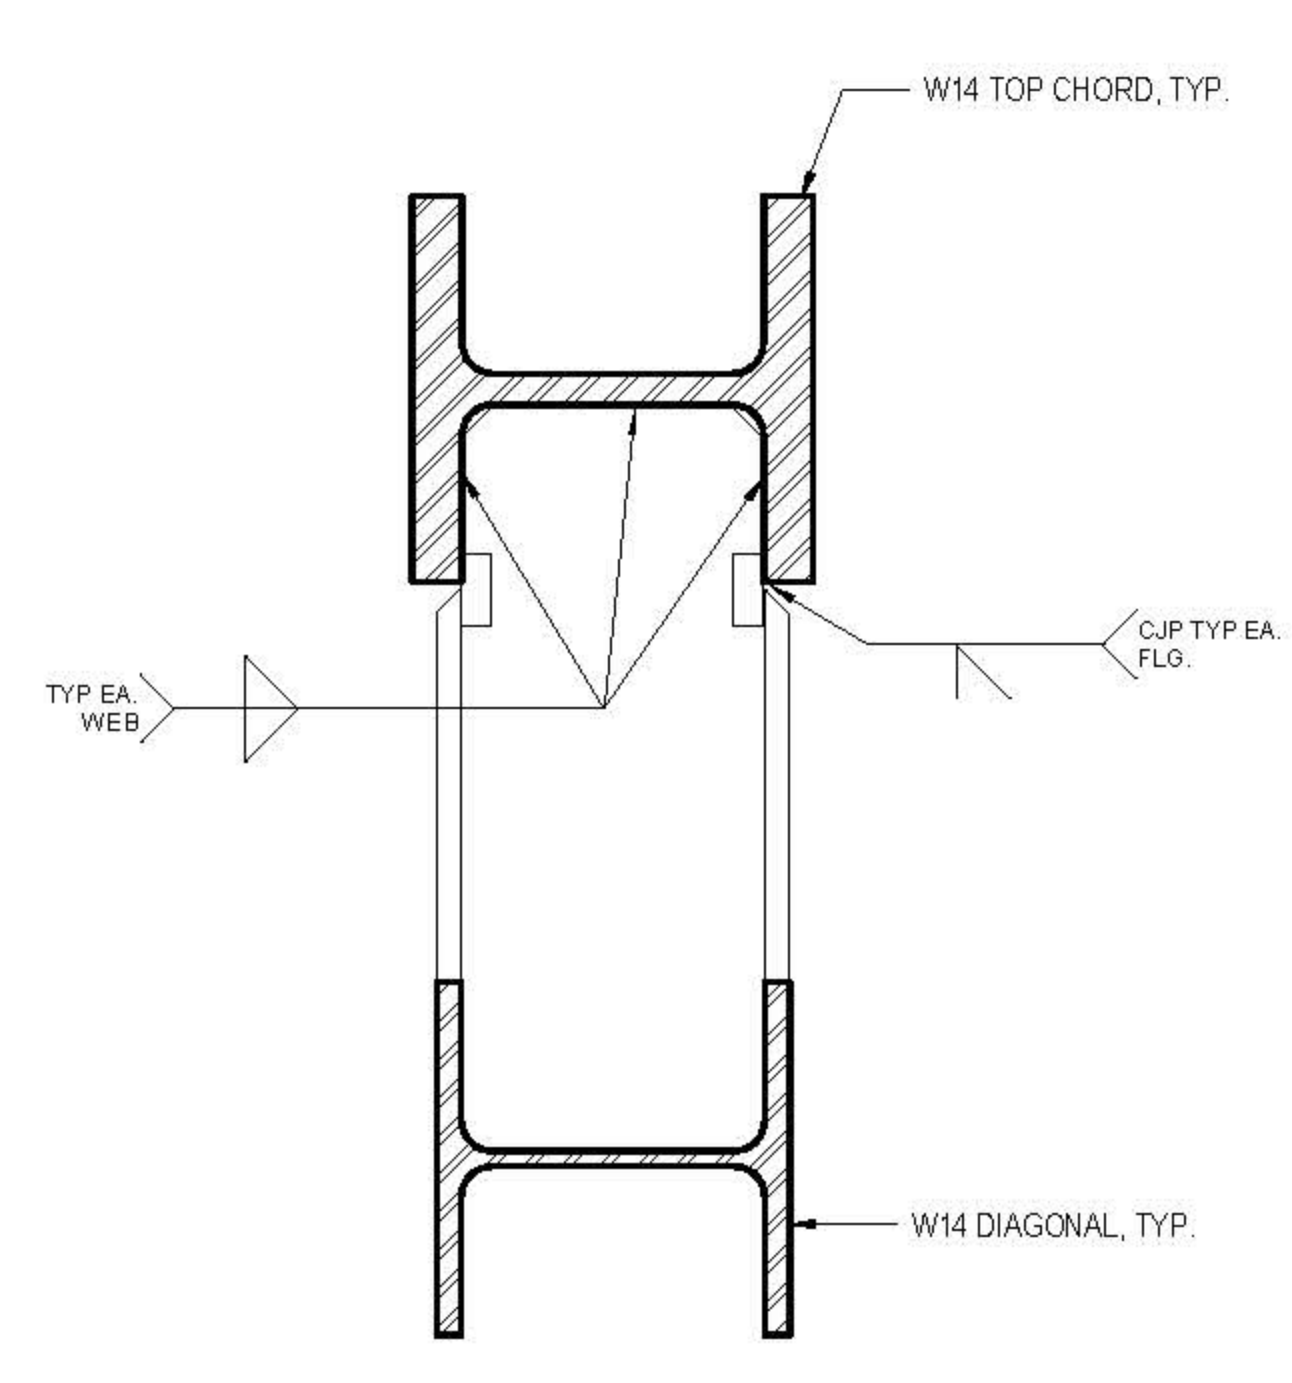


2 TYPICAL TRUSS DIAGONAL CONNECTION
 1/16" = 1'-0"

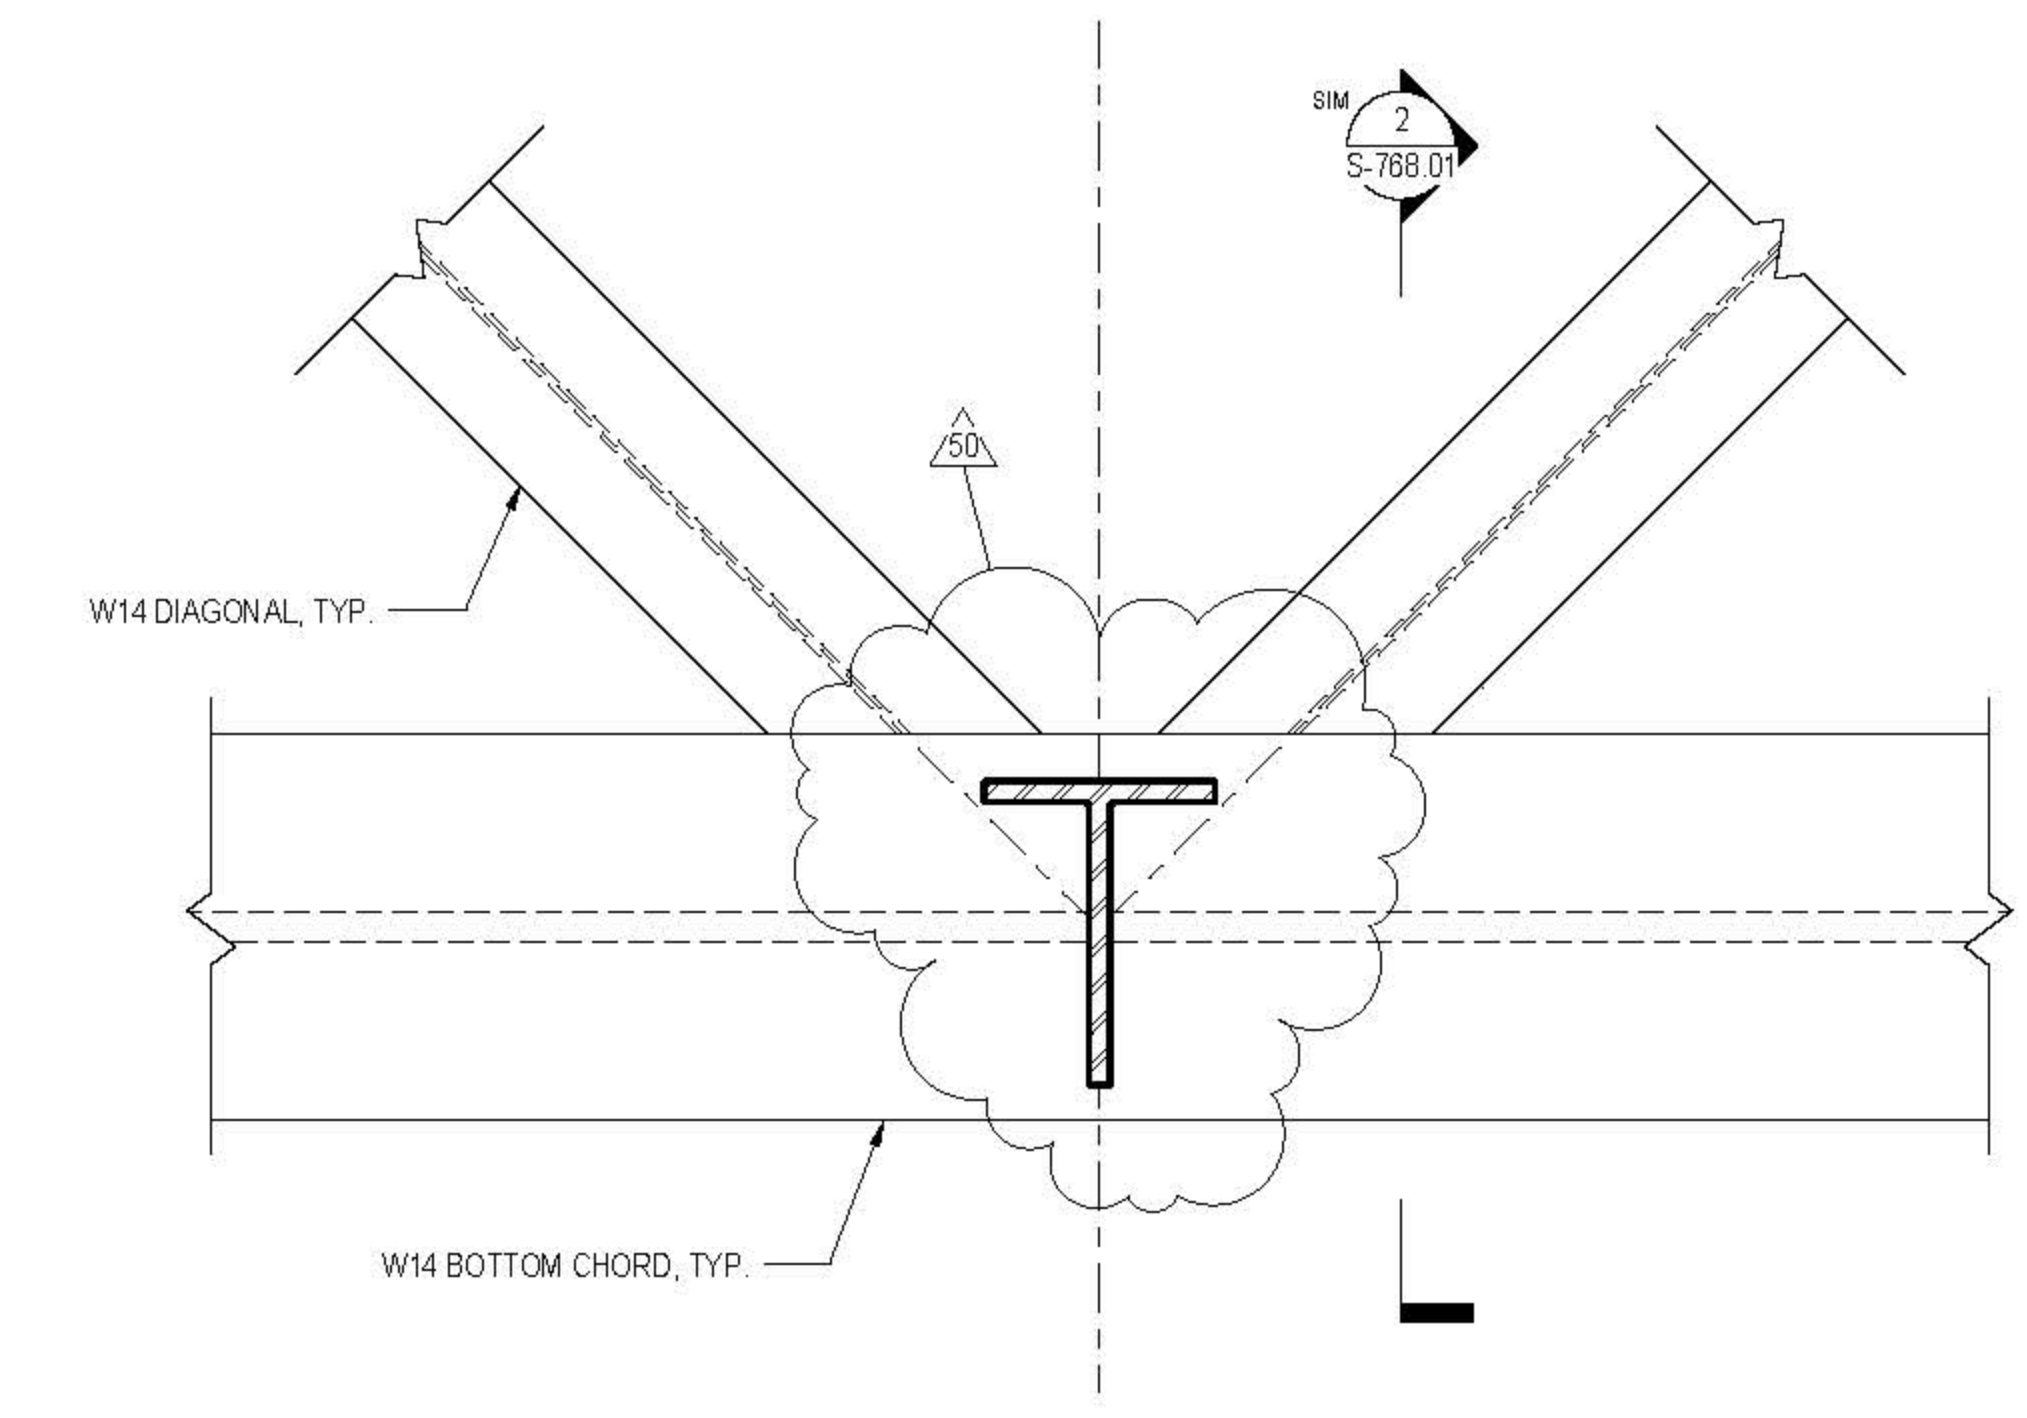

3 TYPICAL TRUSS CONNECTION AT BOTTOM CHORD
 1/16" = 1'-0"

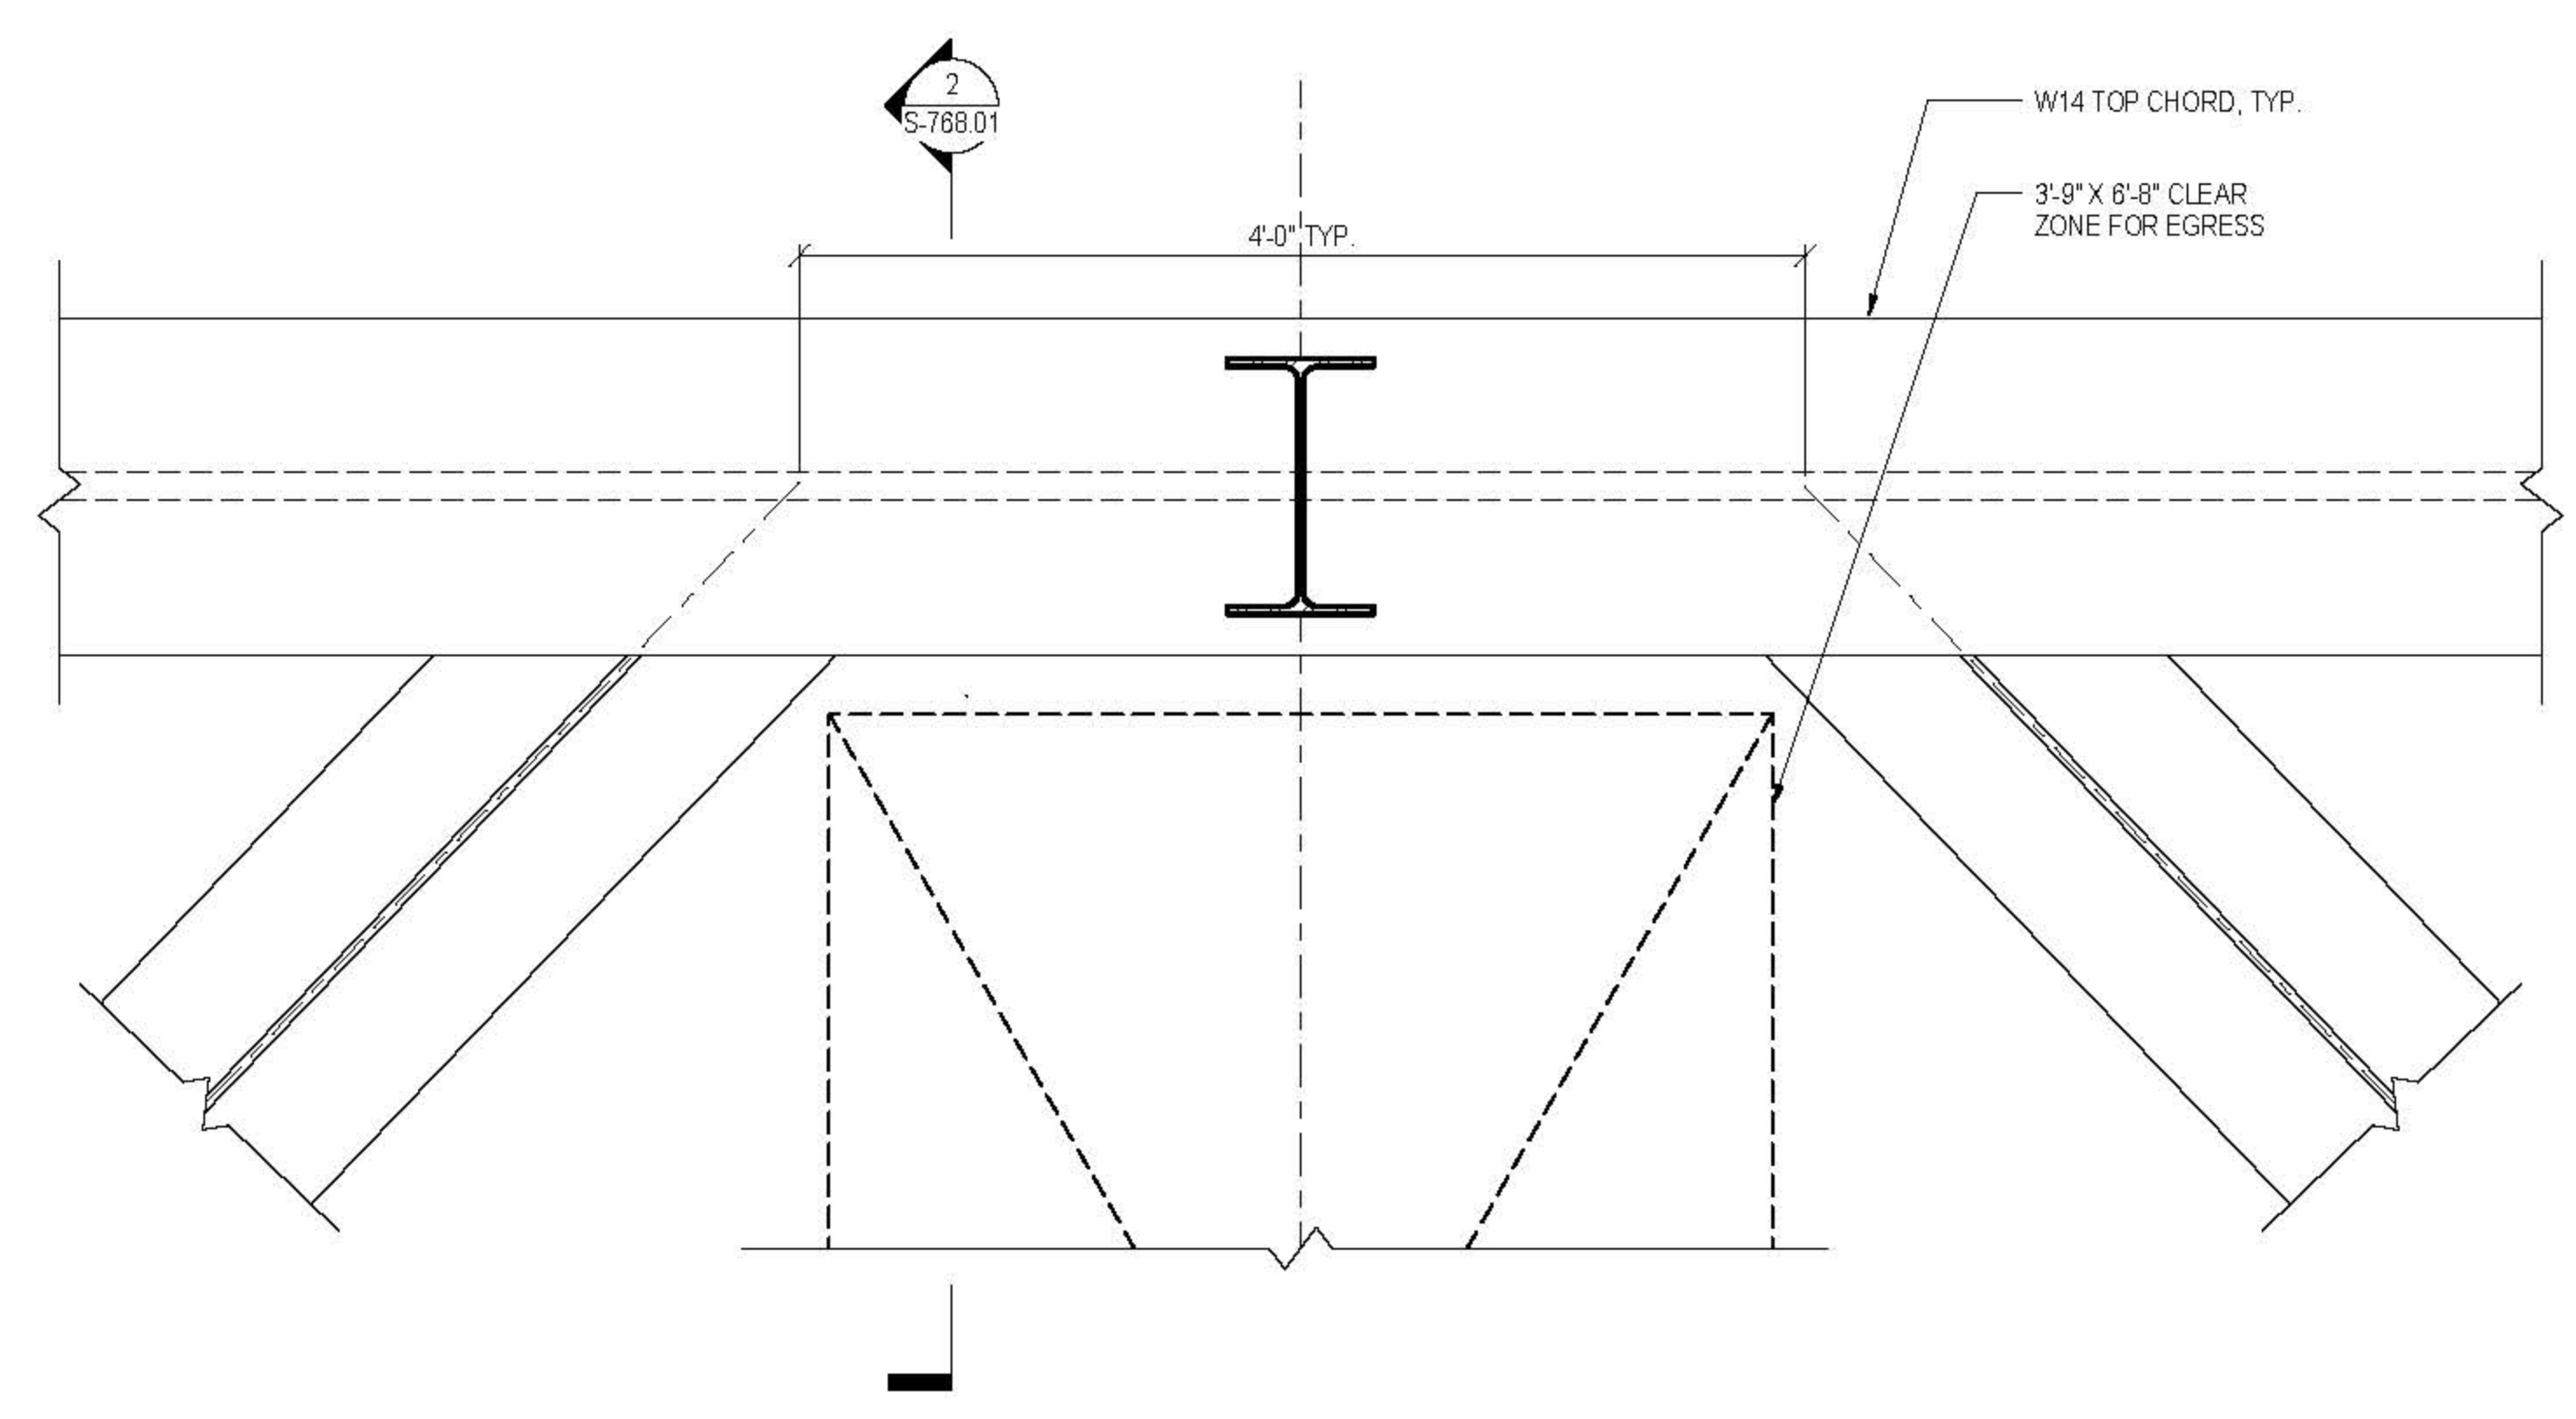


4 TYPICAL TRUSS CONNECTION AT WALKWAY
 1/16" = 1'-0"

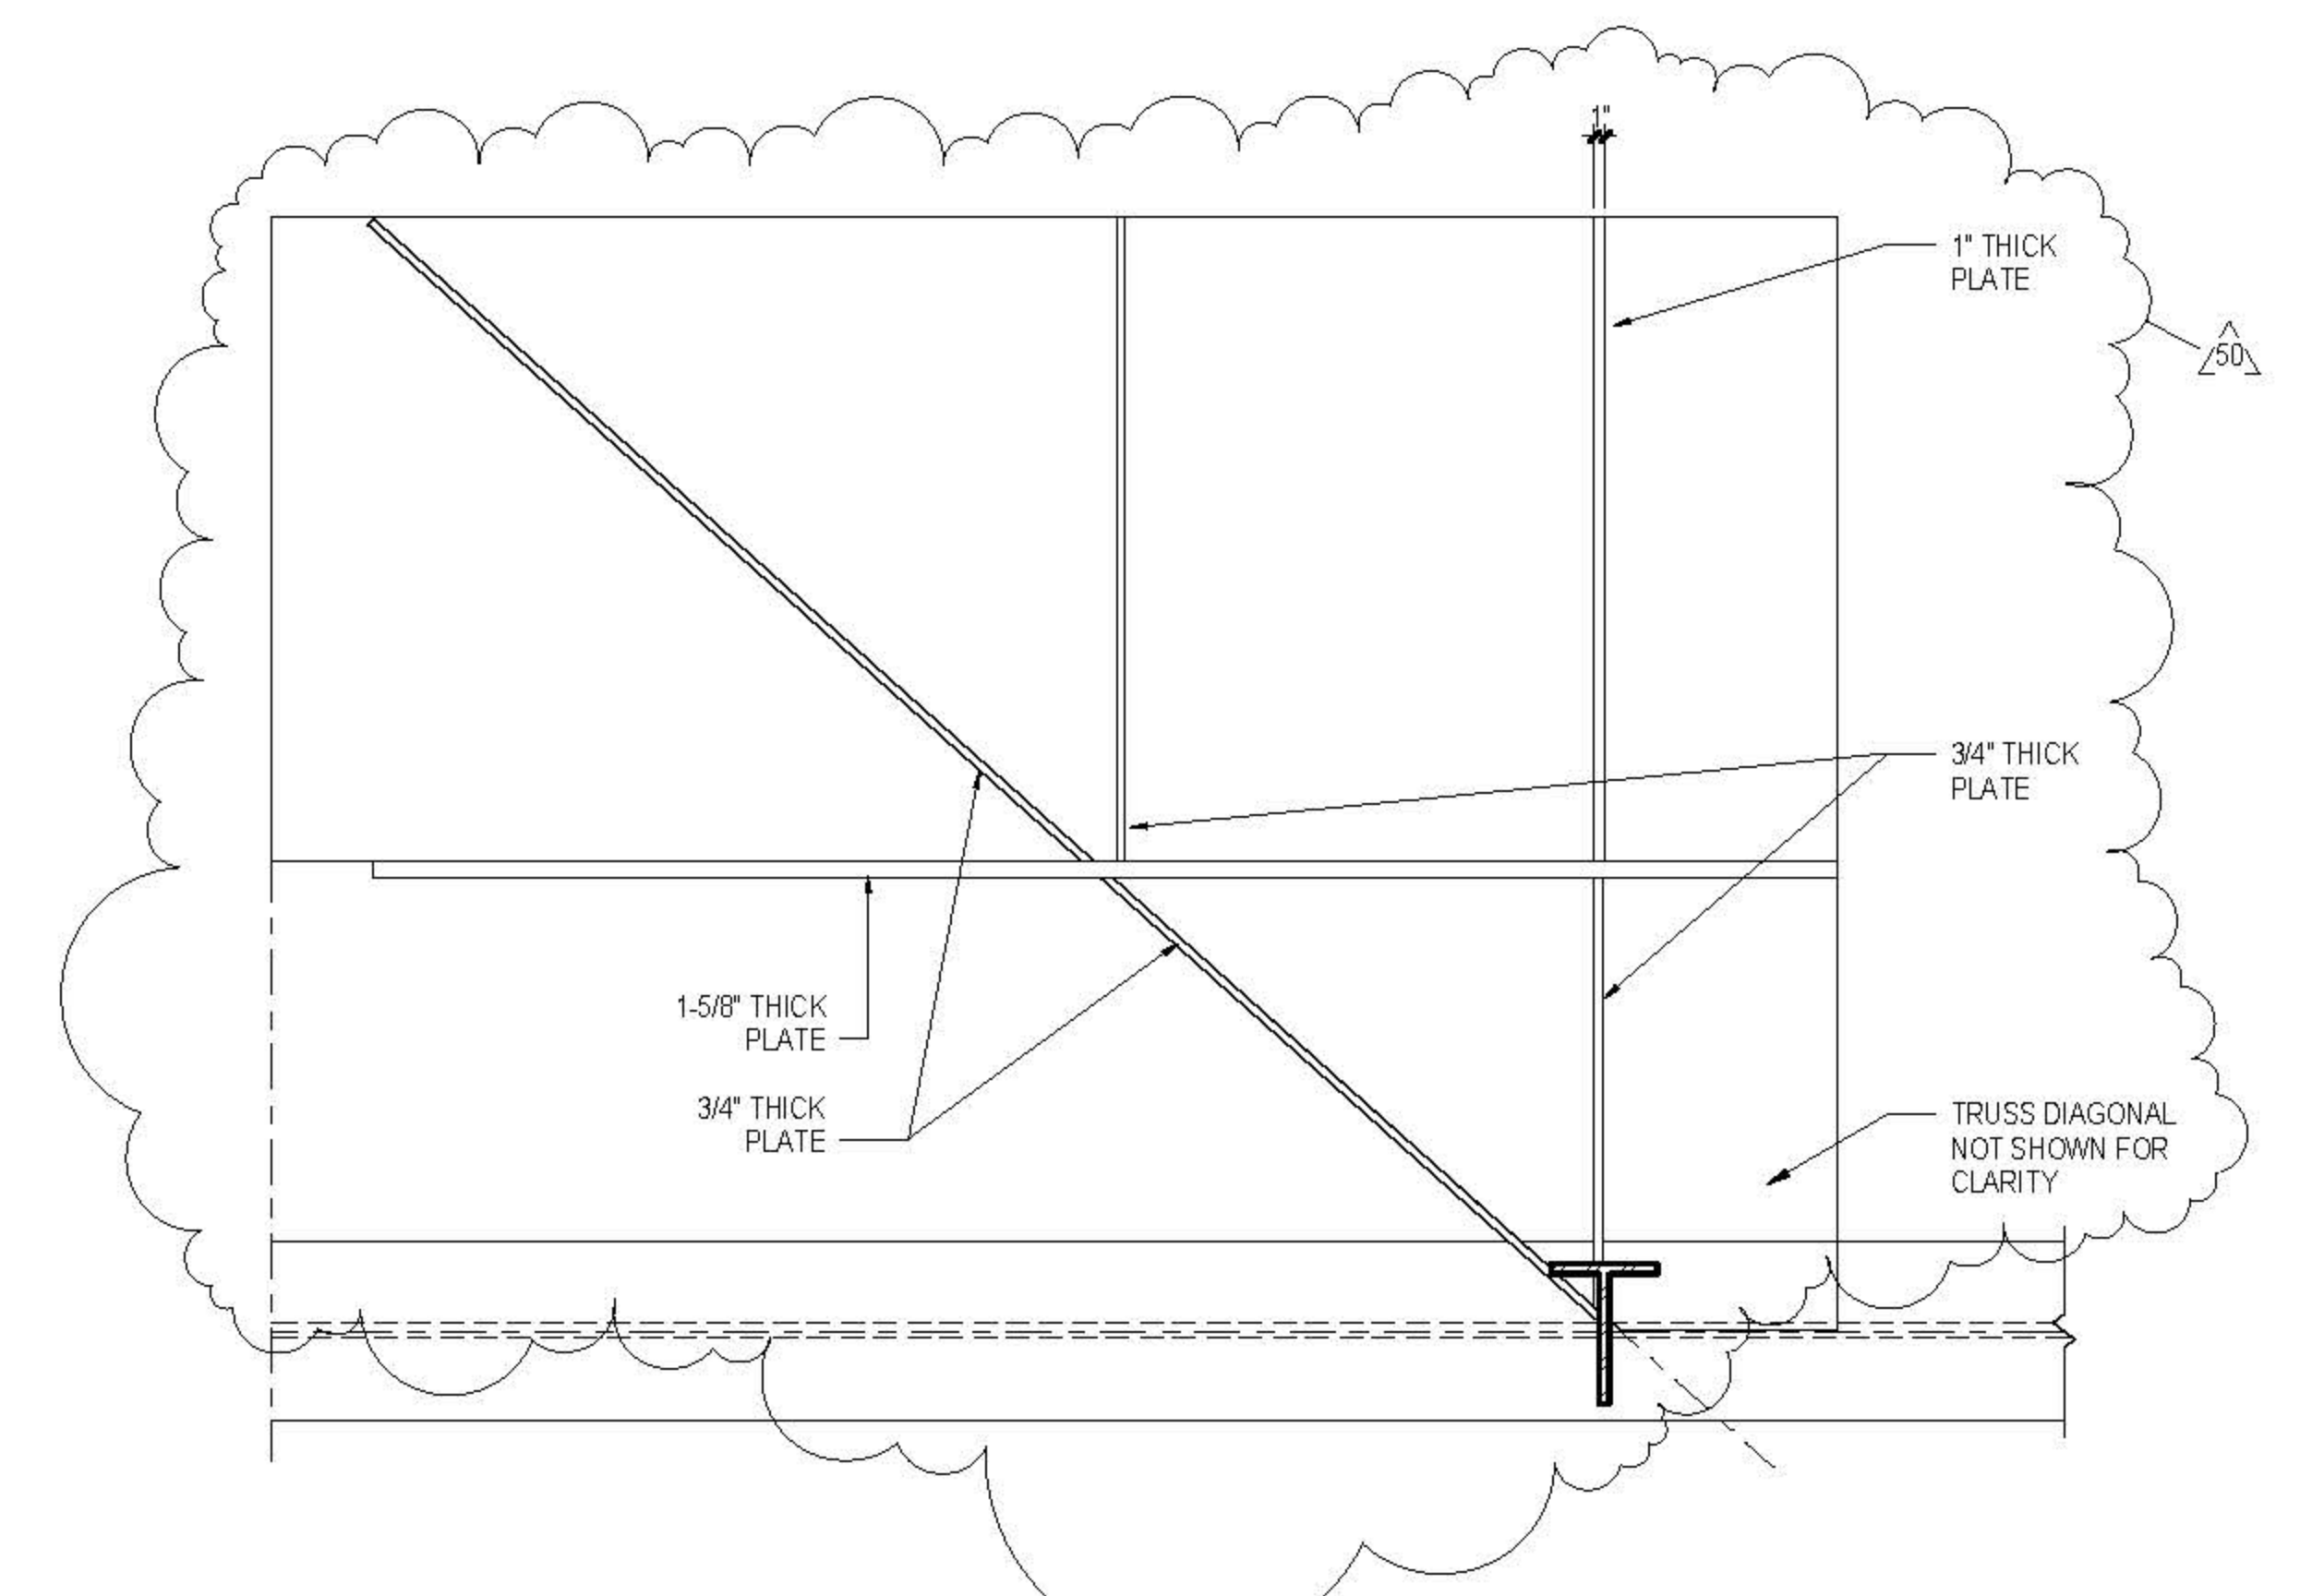

5 TYPICAL BOTTOM CHORD END CONNECTION
 3/4\"/>

KEY PLAN

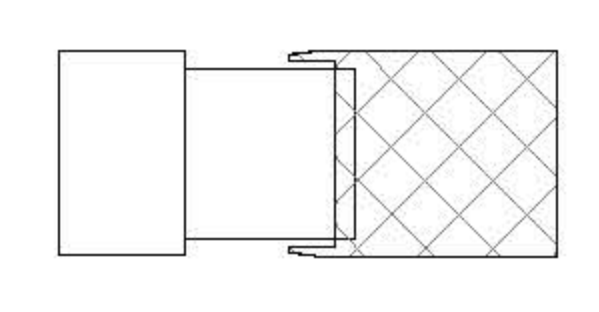

ISSUE Δ PRINTING DATE

ISSUE	PRINTING	DATE	
63	60	DOB AMENDMENT 7	08.19.2016
44	30	DOB AMENDMENT 6	04.09.2016
21		CONSTRUCTION SET	10.09.2015
10	4	100% CONSTRUCTION DOCUMENTS	03.18.2015
9		90% CONSTRUCTION DOCUMENTS	02.16.2015
6		PRELIMINARY CDS SUBMISSION	12.16.2014
1		ADVANCED PROCUREMENT BID SET	06.16.2014


STAMP


DRAWN BY: *Autum* CHECKED BY: *Chris*
 PROJECT NUMBER: N11318.00

TITLE: DETAILS, DEPLOYED SHED NORTH/SOUTH WALLS - N-S TRUSSES

DRAWING NO.: S-768.01

B-SCAN NO.: S-768.01

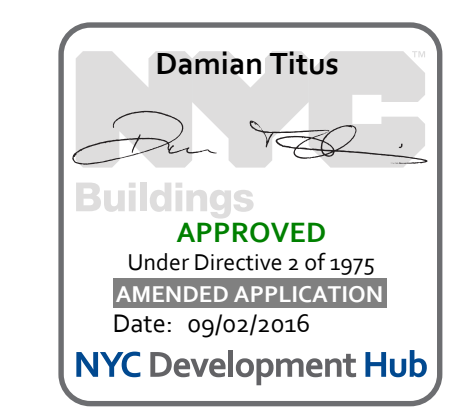

PENDING COORDINATION DURING DESIGN ASSIST.

GEOMETRY, DIMENSIONS AND SURFACE CONTOURING, BLENDING AND INTERSECTION OF SECTIONS ILLUSTRATED IN THE STRUCTURAL DRAWINGS ARE PROVIDED FOR REFERENCE AND GENERATION OF STRUCTURAL ARRANGEMENT AND DETAILS ONLY. THE 3D MODEL ISSUED BY THE ARCHITECT DEFINES THE EXTERIOR SURFACE AND SHALL BE ADHERED TO FOR THE FINAL GEOMETRY. FOR DETAILS OF SECONDARY STEEL, INCLUDING STRUCTURAL CLADDING REFER TO ARCHITECTURE DRAWINGS. IT IS THE RESPONSIBILITY OF THE CONTRACTOR TO IDENTIFY ANY DISCREPANCIES OR AMBIGUITIES FOR DISCUSSION, RESOLUTION AND DIRECTION FROM THE ARCHITECT AND SER.

ARCHITECTS
Oiler Scudato + Renfro Architects, DPC
601 West 26 Street #815
New York, New York 10001
T: 212.263.7971

rockwellgroup
5 Union St. West, 6th Fl.
New York, New York 10003
T: 212.463.0334
F: 212.463.0335

STRUCTURAL ENGINEER
Thornton Tomasetti
51 Madison Avenue
New York, New York 10010
T: 917.861.7800
F: 917.861.7801

MEP ENGINEER
Jara Baum & Bolles
63 Park Street
New York, New York 10005
T: 212.530.9300
F: 212.266.6944

FAÇADE CONSULTANT
Thornton Tomasetti
51 Madison Avenue
New York, New York 10010
T: 917.861.7800
F: 917.861.7801

KINETICS ENGINEER
Hardisty & Hanover
1501 Broadway
New York, New York 10036
T: 212.944.1150
F: 212.391.0337

LIGHTING DESIGNER
Tilston Design Associates
40 North Street #1650
New York, New York 10013
T: 212.675.7760

THEATRE PLANNING & DESIGN
Fisher Dodge Associates
22 West 15th Street
New York, New York 10011
T: 212.691.3000

LIFE SAFETY
Code Consultants, Inc.
215 West 43rd St, 15th Fl.
New York, New York 10018
T: 212.216.9596

ENERGY MODEL/LEED
Vindian
63 Washington Street
Norwalk, CT 06854
T: 203.298.1411

ACOUSTIC/AUDIO-VISUAL
Avalon
50 North Main Street
South Norwalk, CT 06854
T: 347.210.5540

VERTICAL TRANSPORTATION
Van Duusen & Associates
5 Regent Street, Suite 524
Lakewood, NJ 07038
T: 973.994.9220

SPECIFICATIONS
Construction Specifications Inc.
PO Box 489
227 Tenthon Road
Morganville, NJ 07751
T: 732.970.0700
F: 732.970.0750


SECURITY
Duchella Venter & Santoro
1100 Sherman Avenue
Hartford, CT 06114
T: 203.286.6490

WATERPROOFING
James R. Gahfort AIA Consulting Architects PC
104 West 27th Street
New York, NY 10001
T: 212.736.3344

FAÇADE MAINTENANCE
Erick Engineering PLLC
166 Ave. Street
New York, NY 10005
T: 212.698.3000

BRANDING GRAPHICS
2nd Global Design Consultancy
180 Varck Street 15th Floor
New York, NY 10014
T: 212.647.1170

KEY PLAN

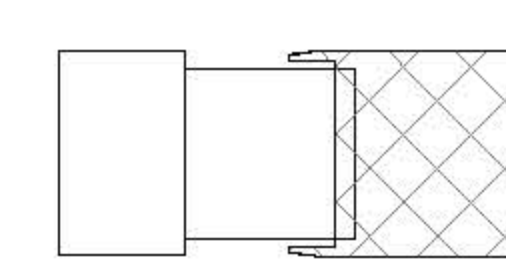

ISSUE PRINTING DATE

ISSUE	PRINTING	DATE
01	01	08/19/2016
02	02	08/23/2016
03	03	08/23/2016
04	04	08/23/2016
100	100	08/23/2016





DRAWN BY Audrey
CHECKED BY Damian Titus
PROJECT NUMBER N11318.00

TITLE
DETAILS DEPLOYED SHED EAST WALL I

DRAWING NO.
8-770.01





B-SCAN NO.
S-770.01

103 of 123

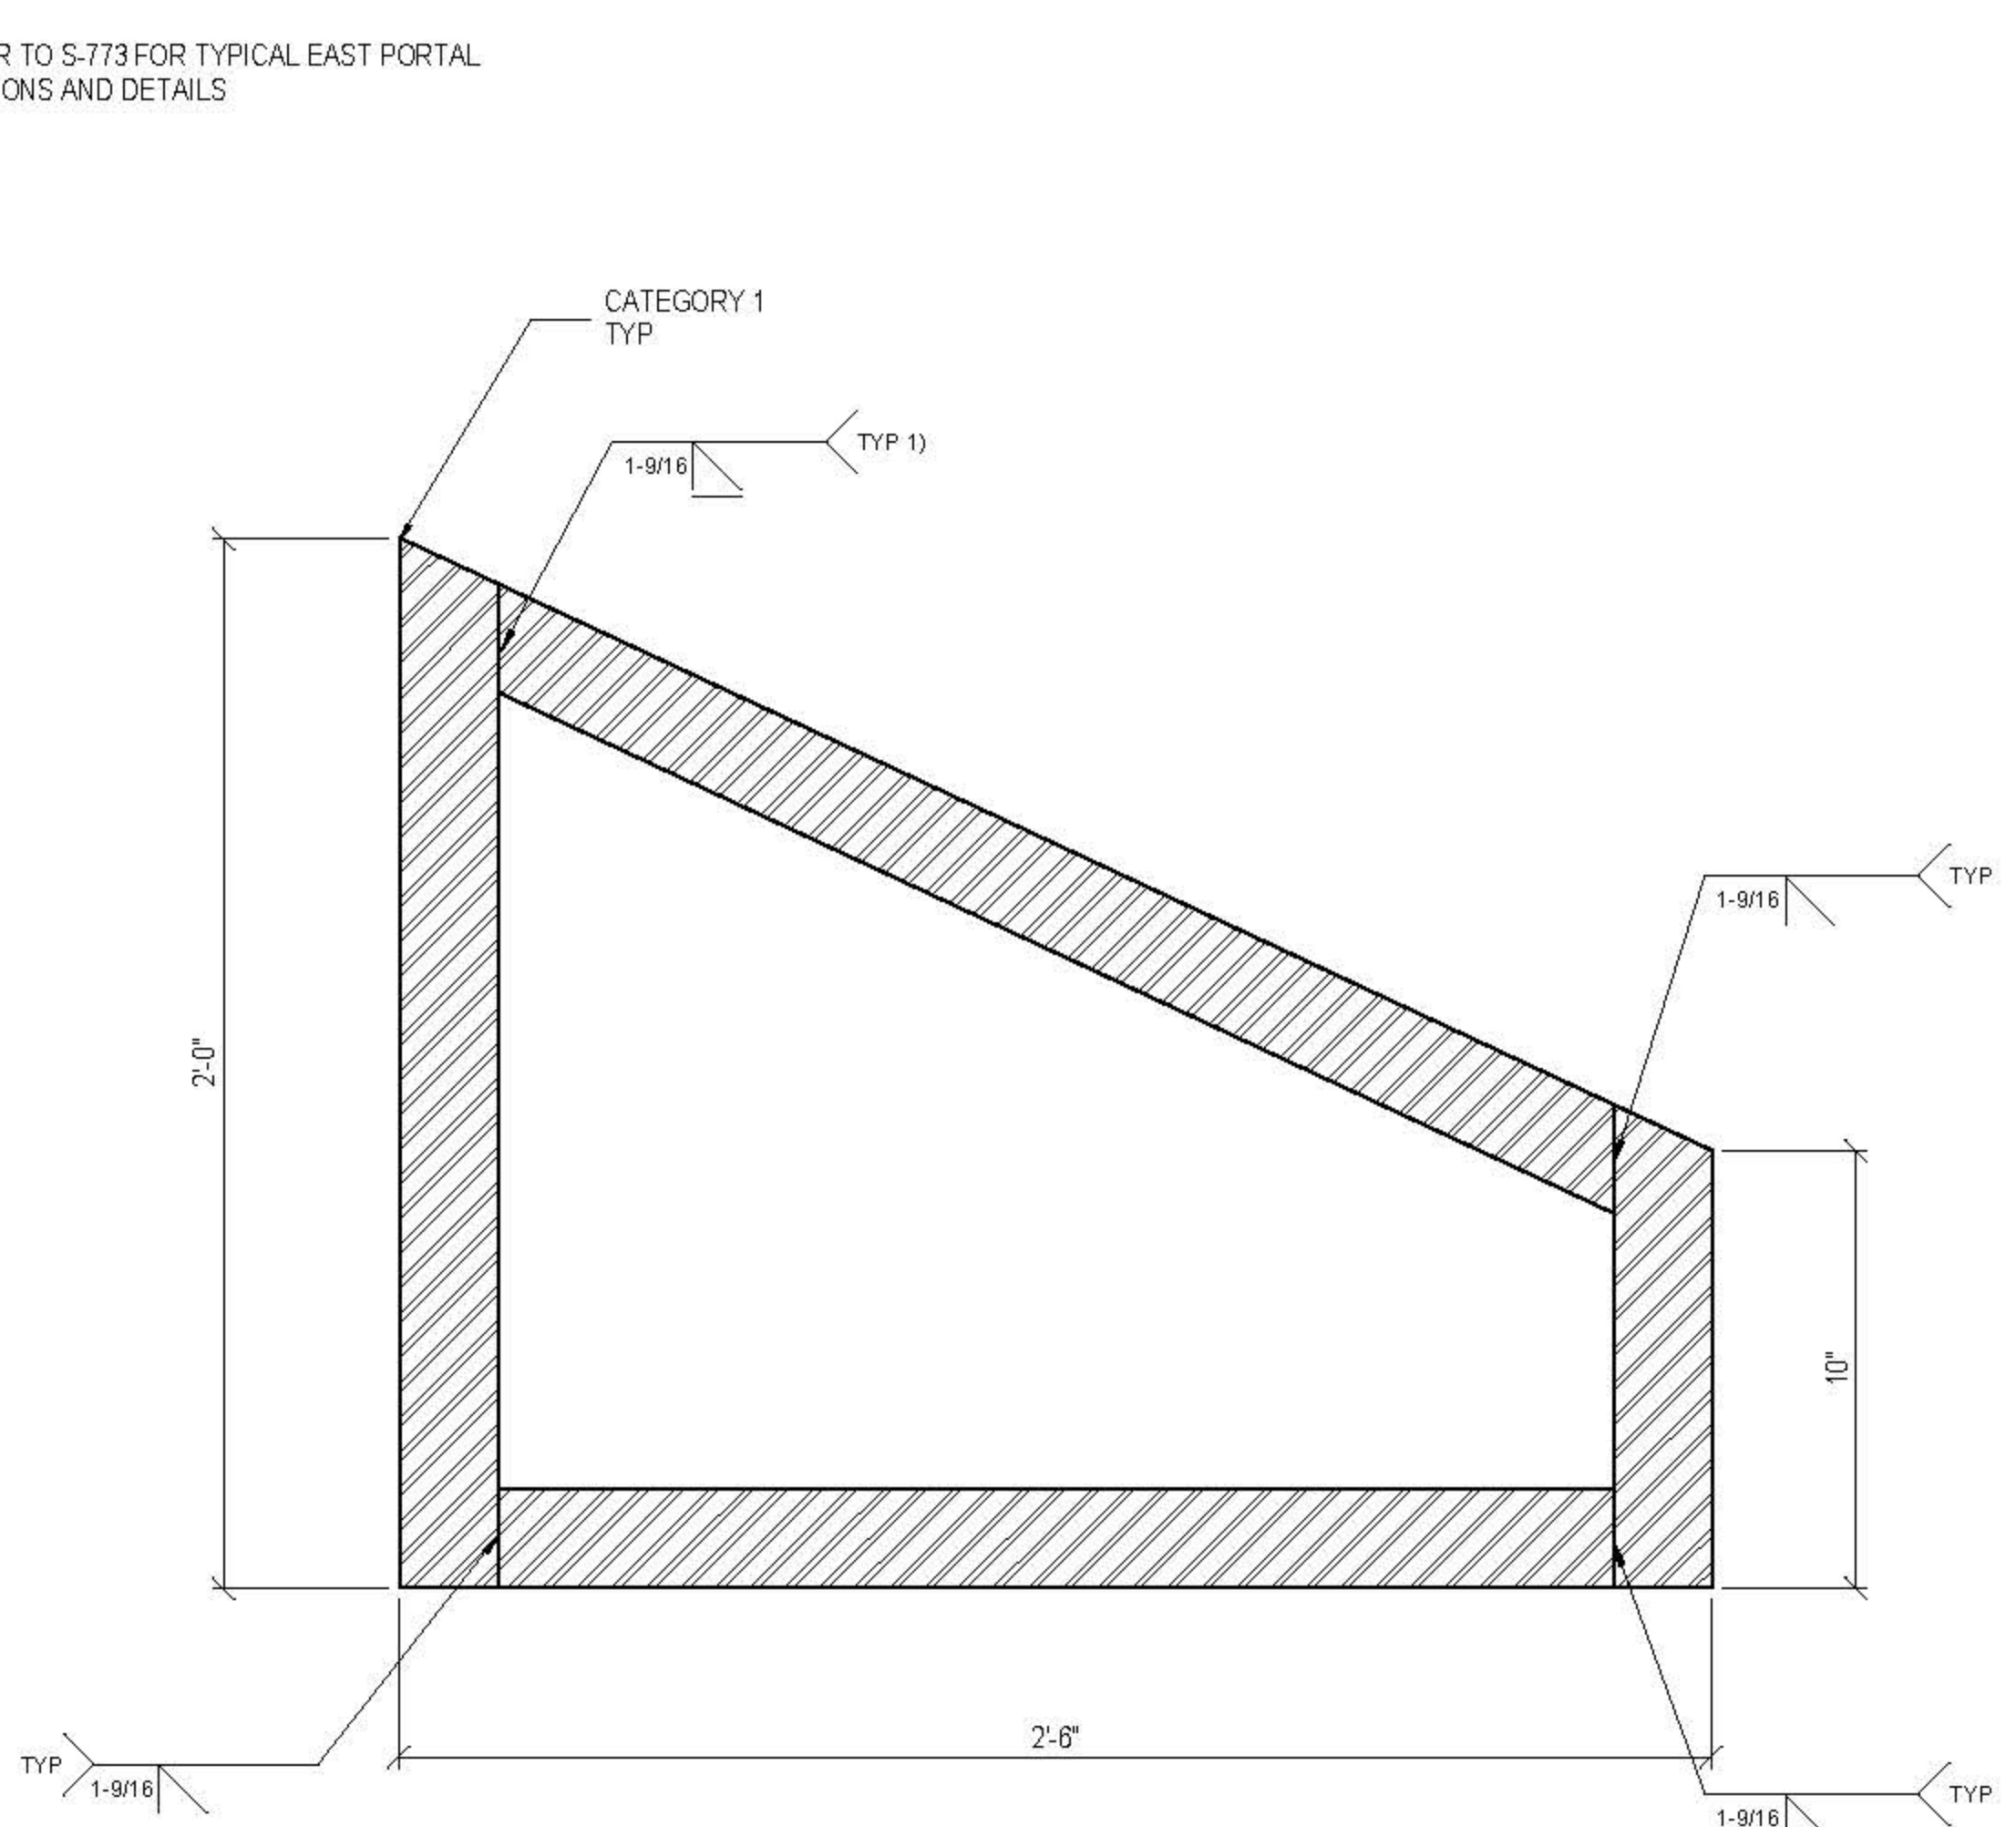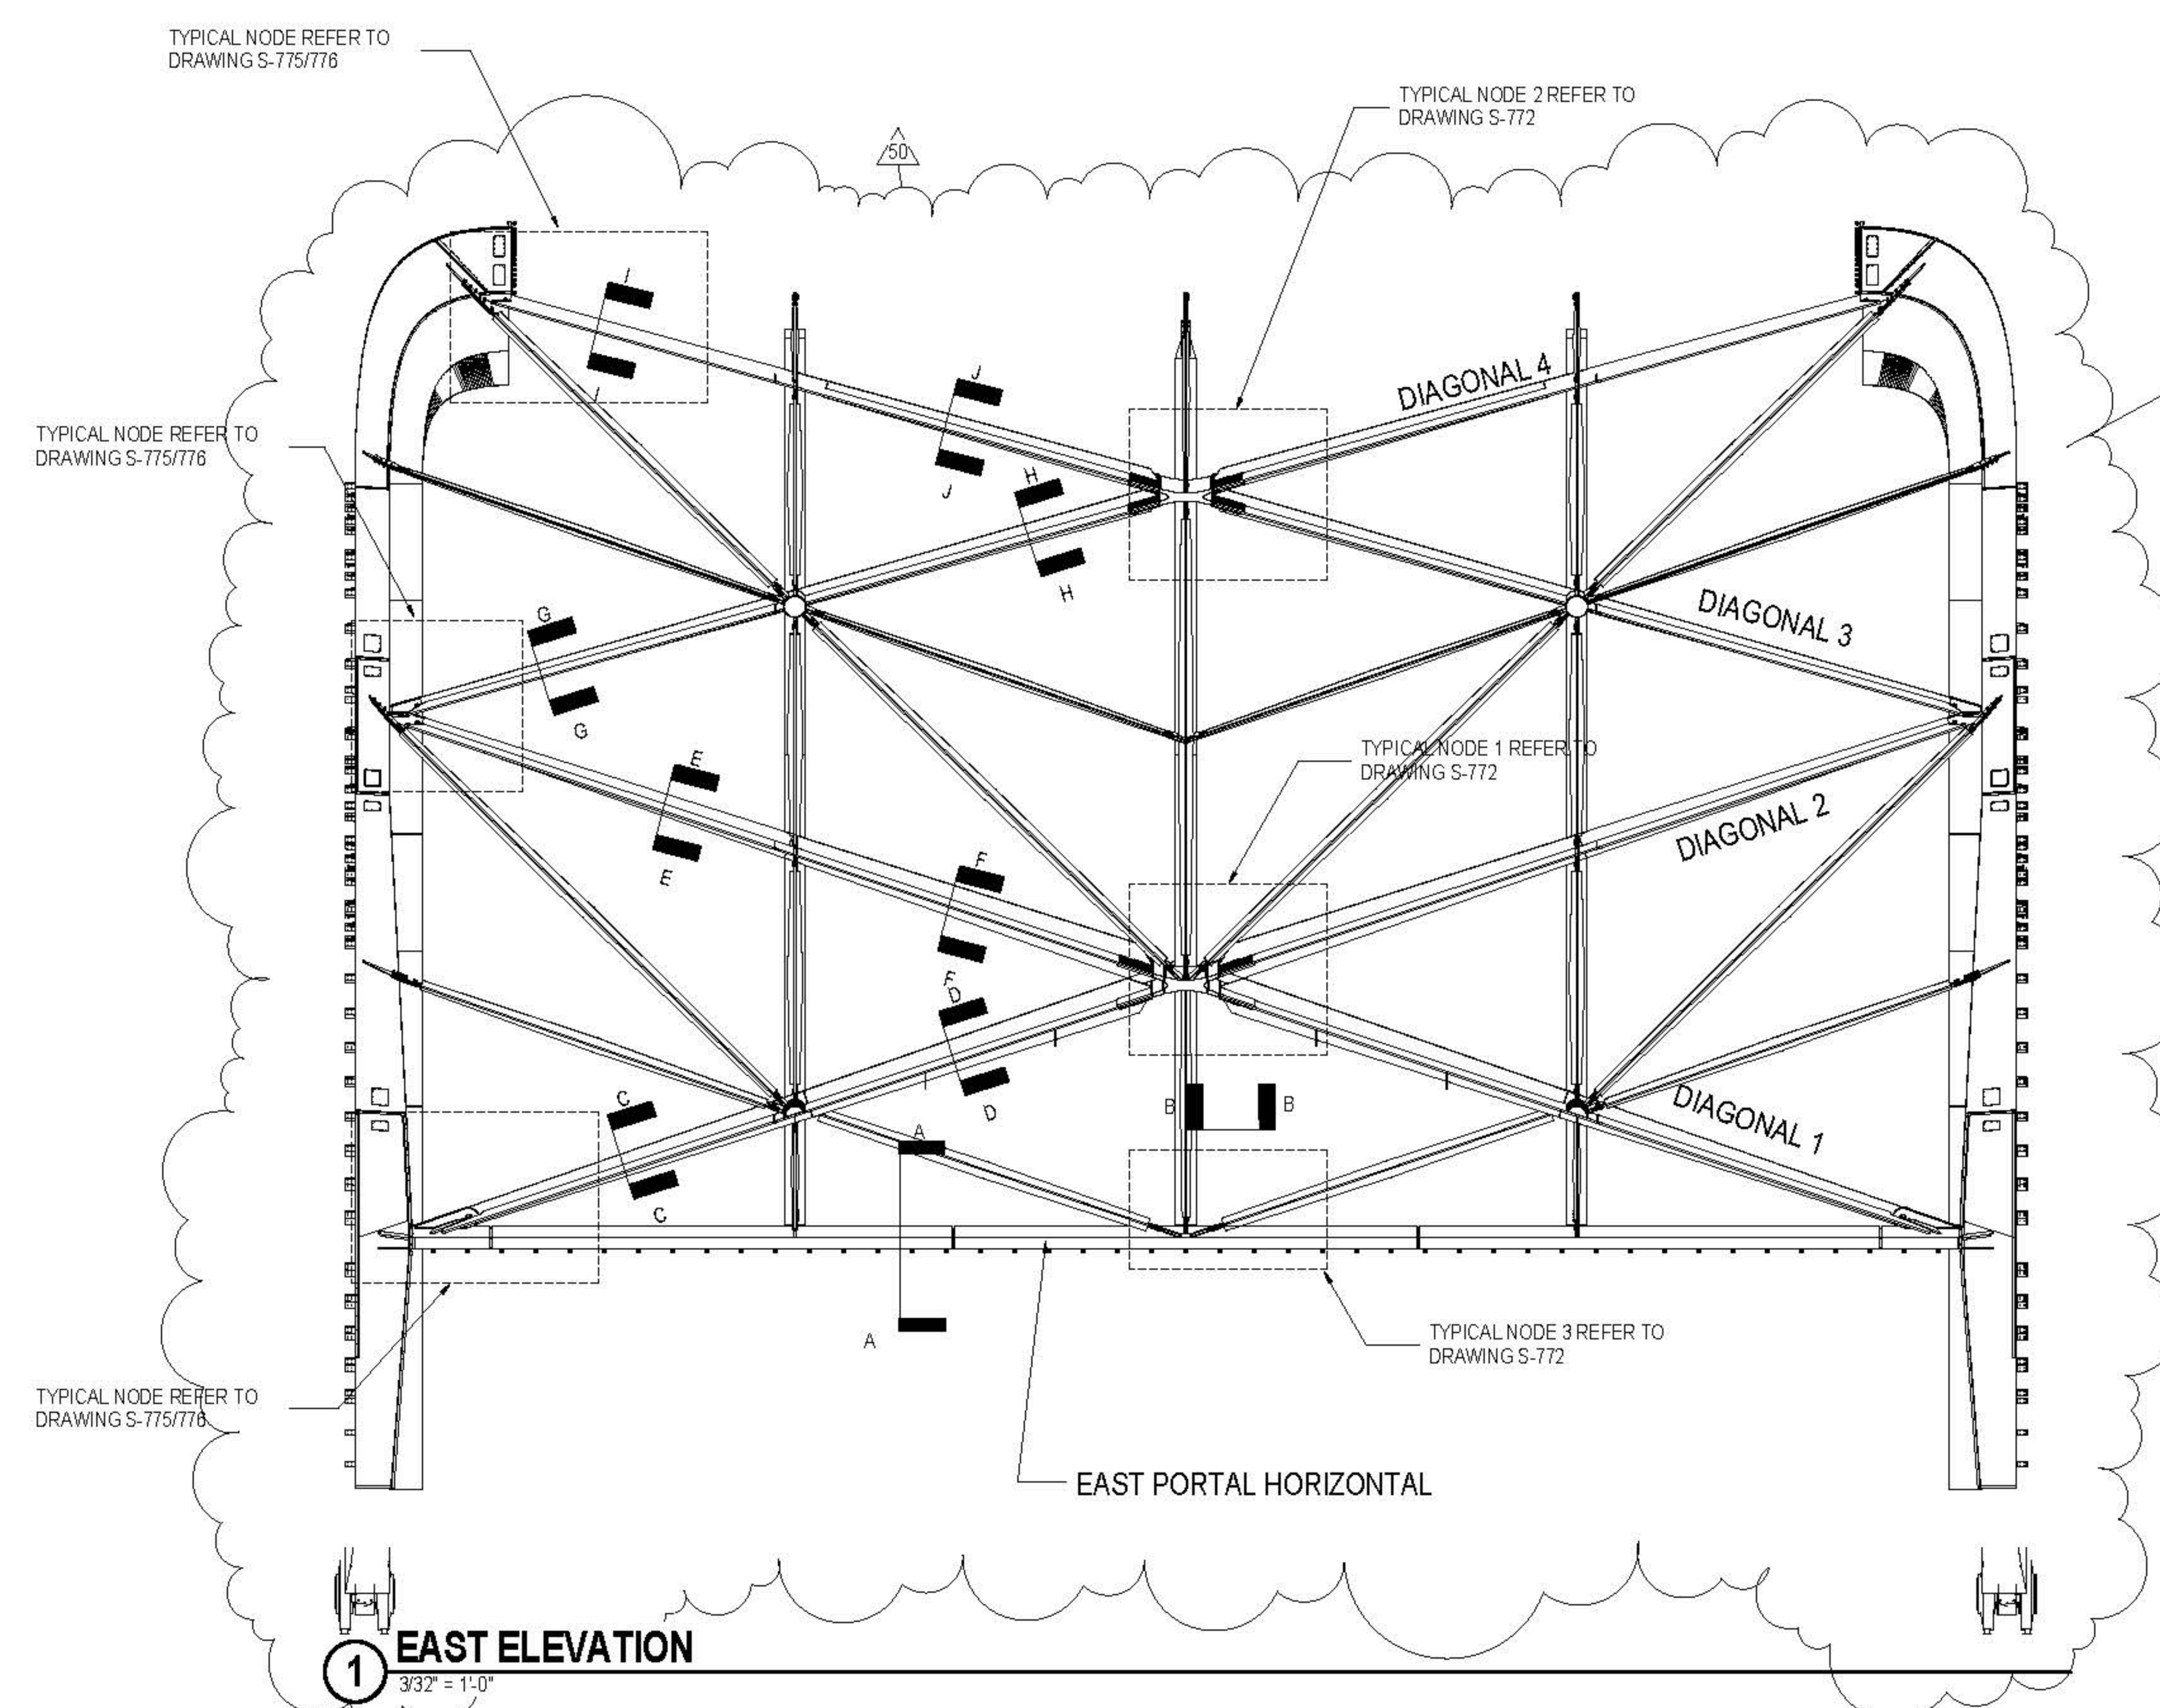

ELEMENT	PLATE THICKNESS
EAST PORTAL HORIZONTAL	2 1/4"
DIAGONAL 1	2"
DIAGONAL 2	2"
DIAGONAL 3	2"
DIAGONAL 4	2"

6 EAST WALL PLATE THICKNESSES

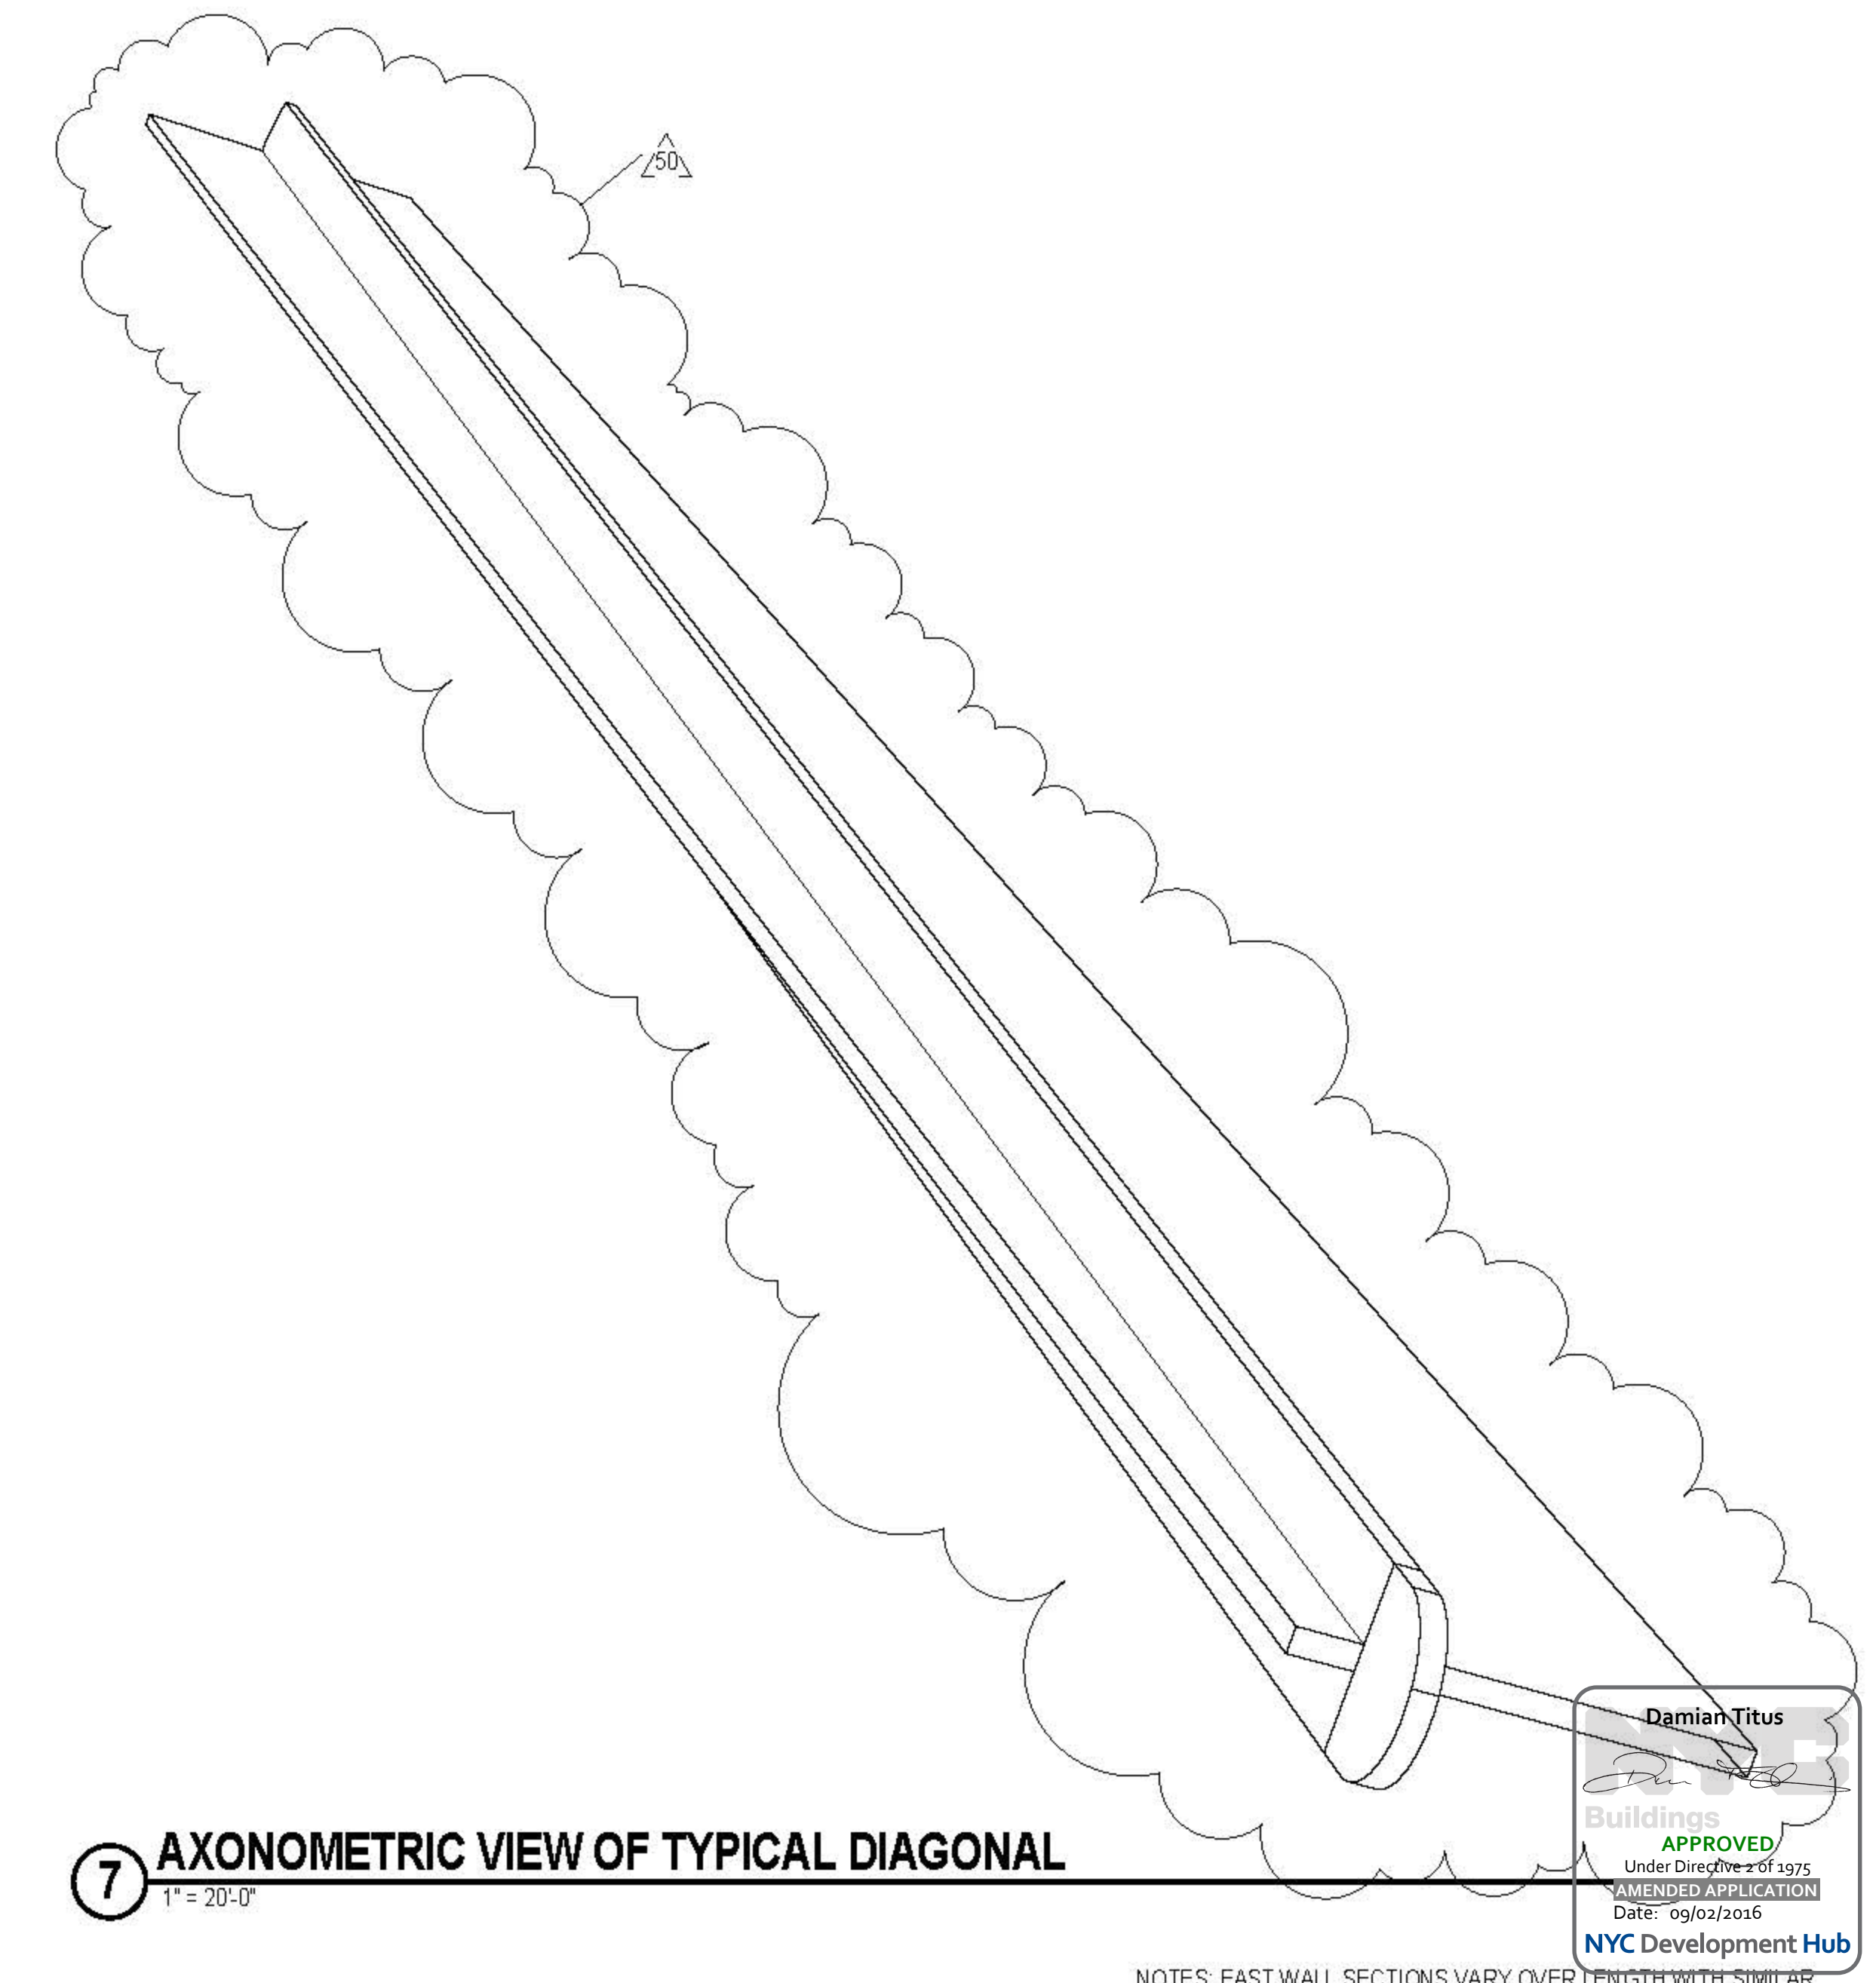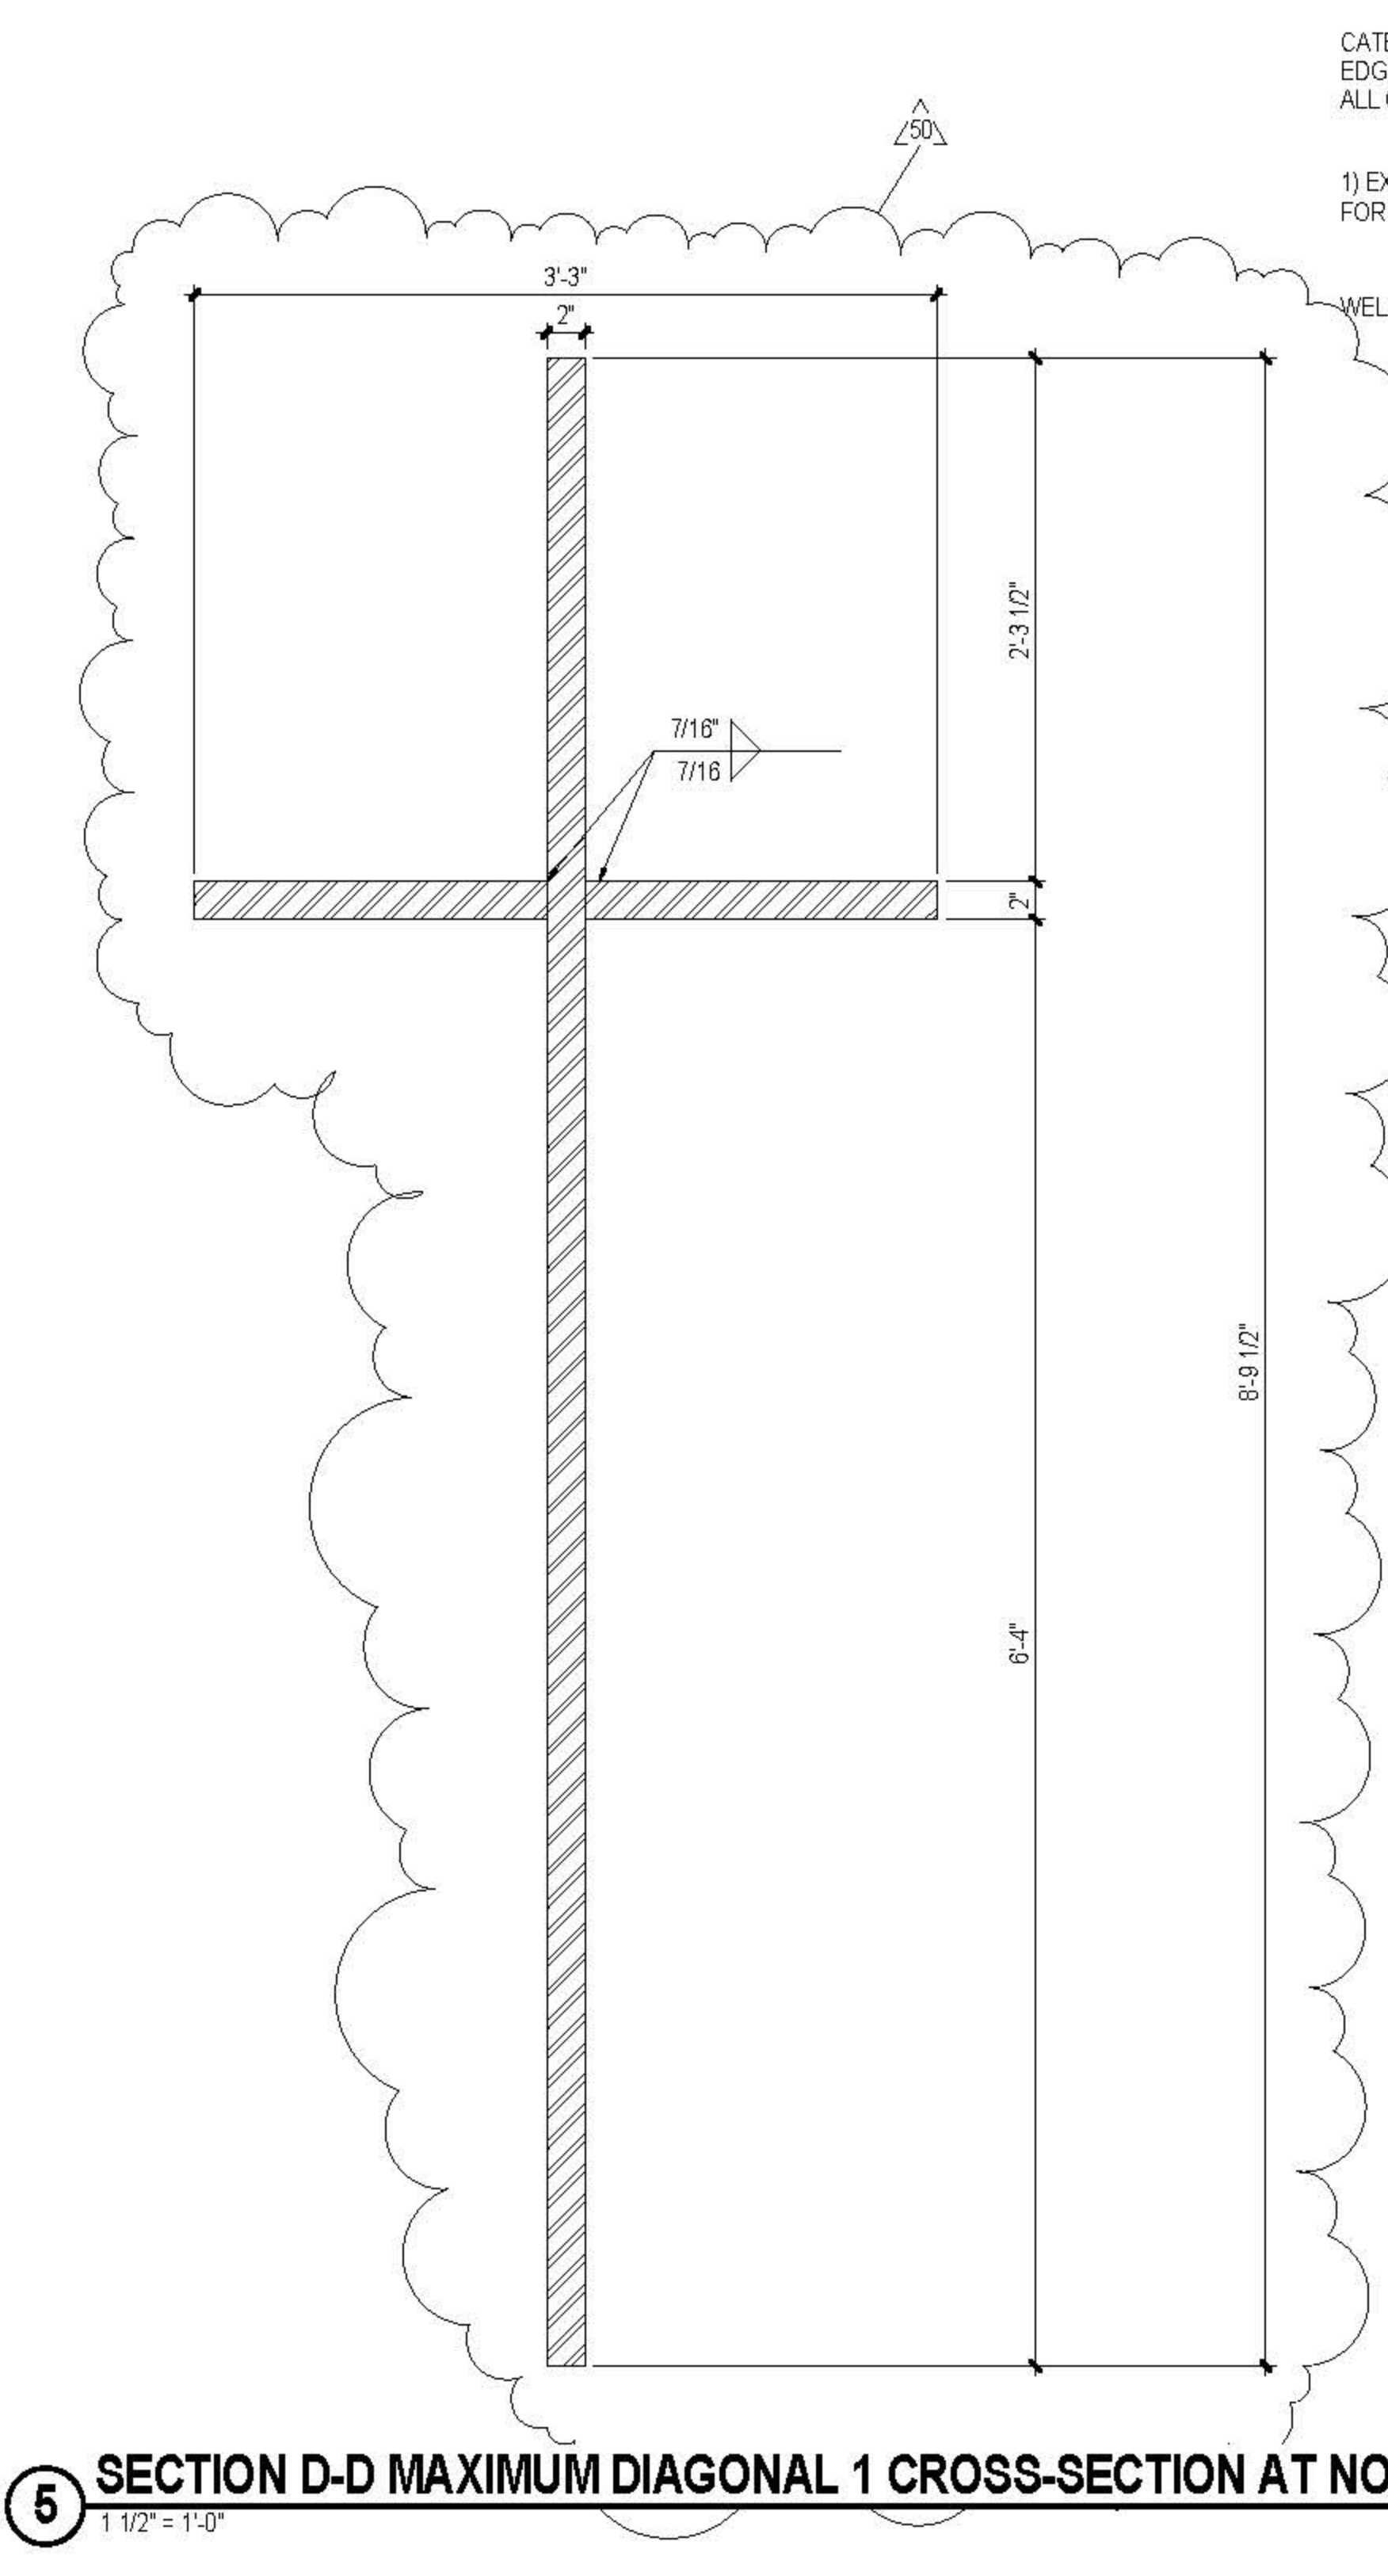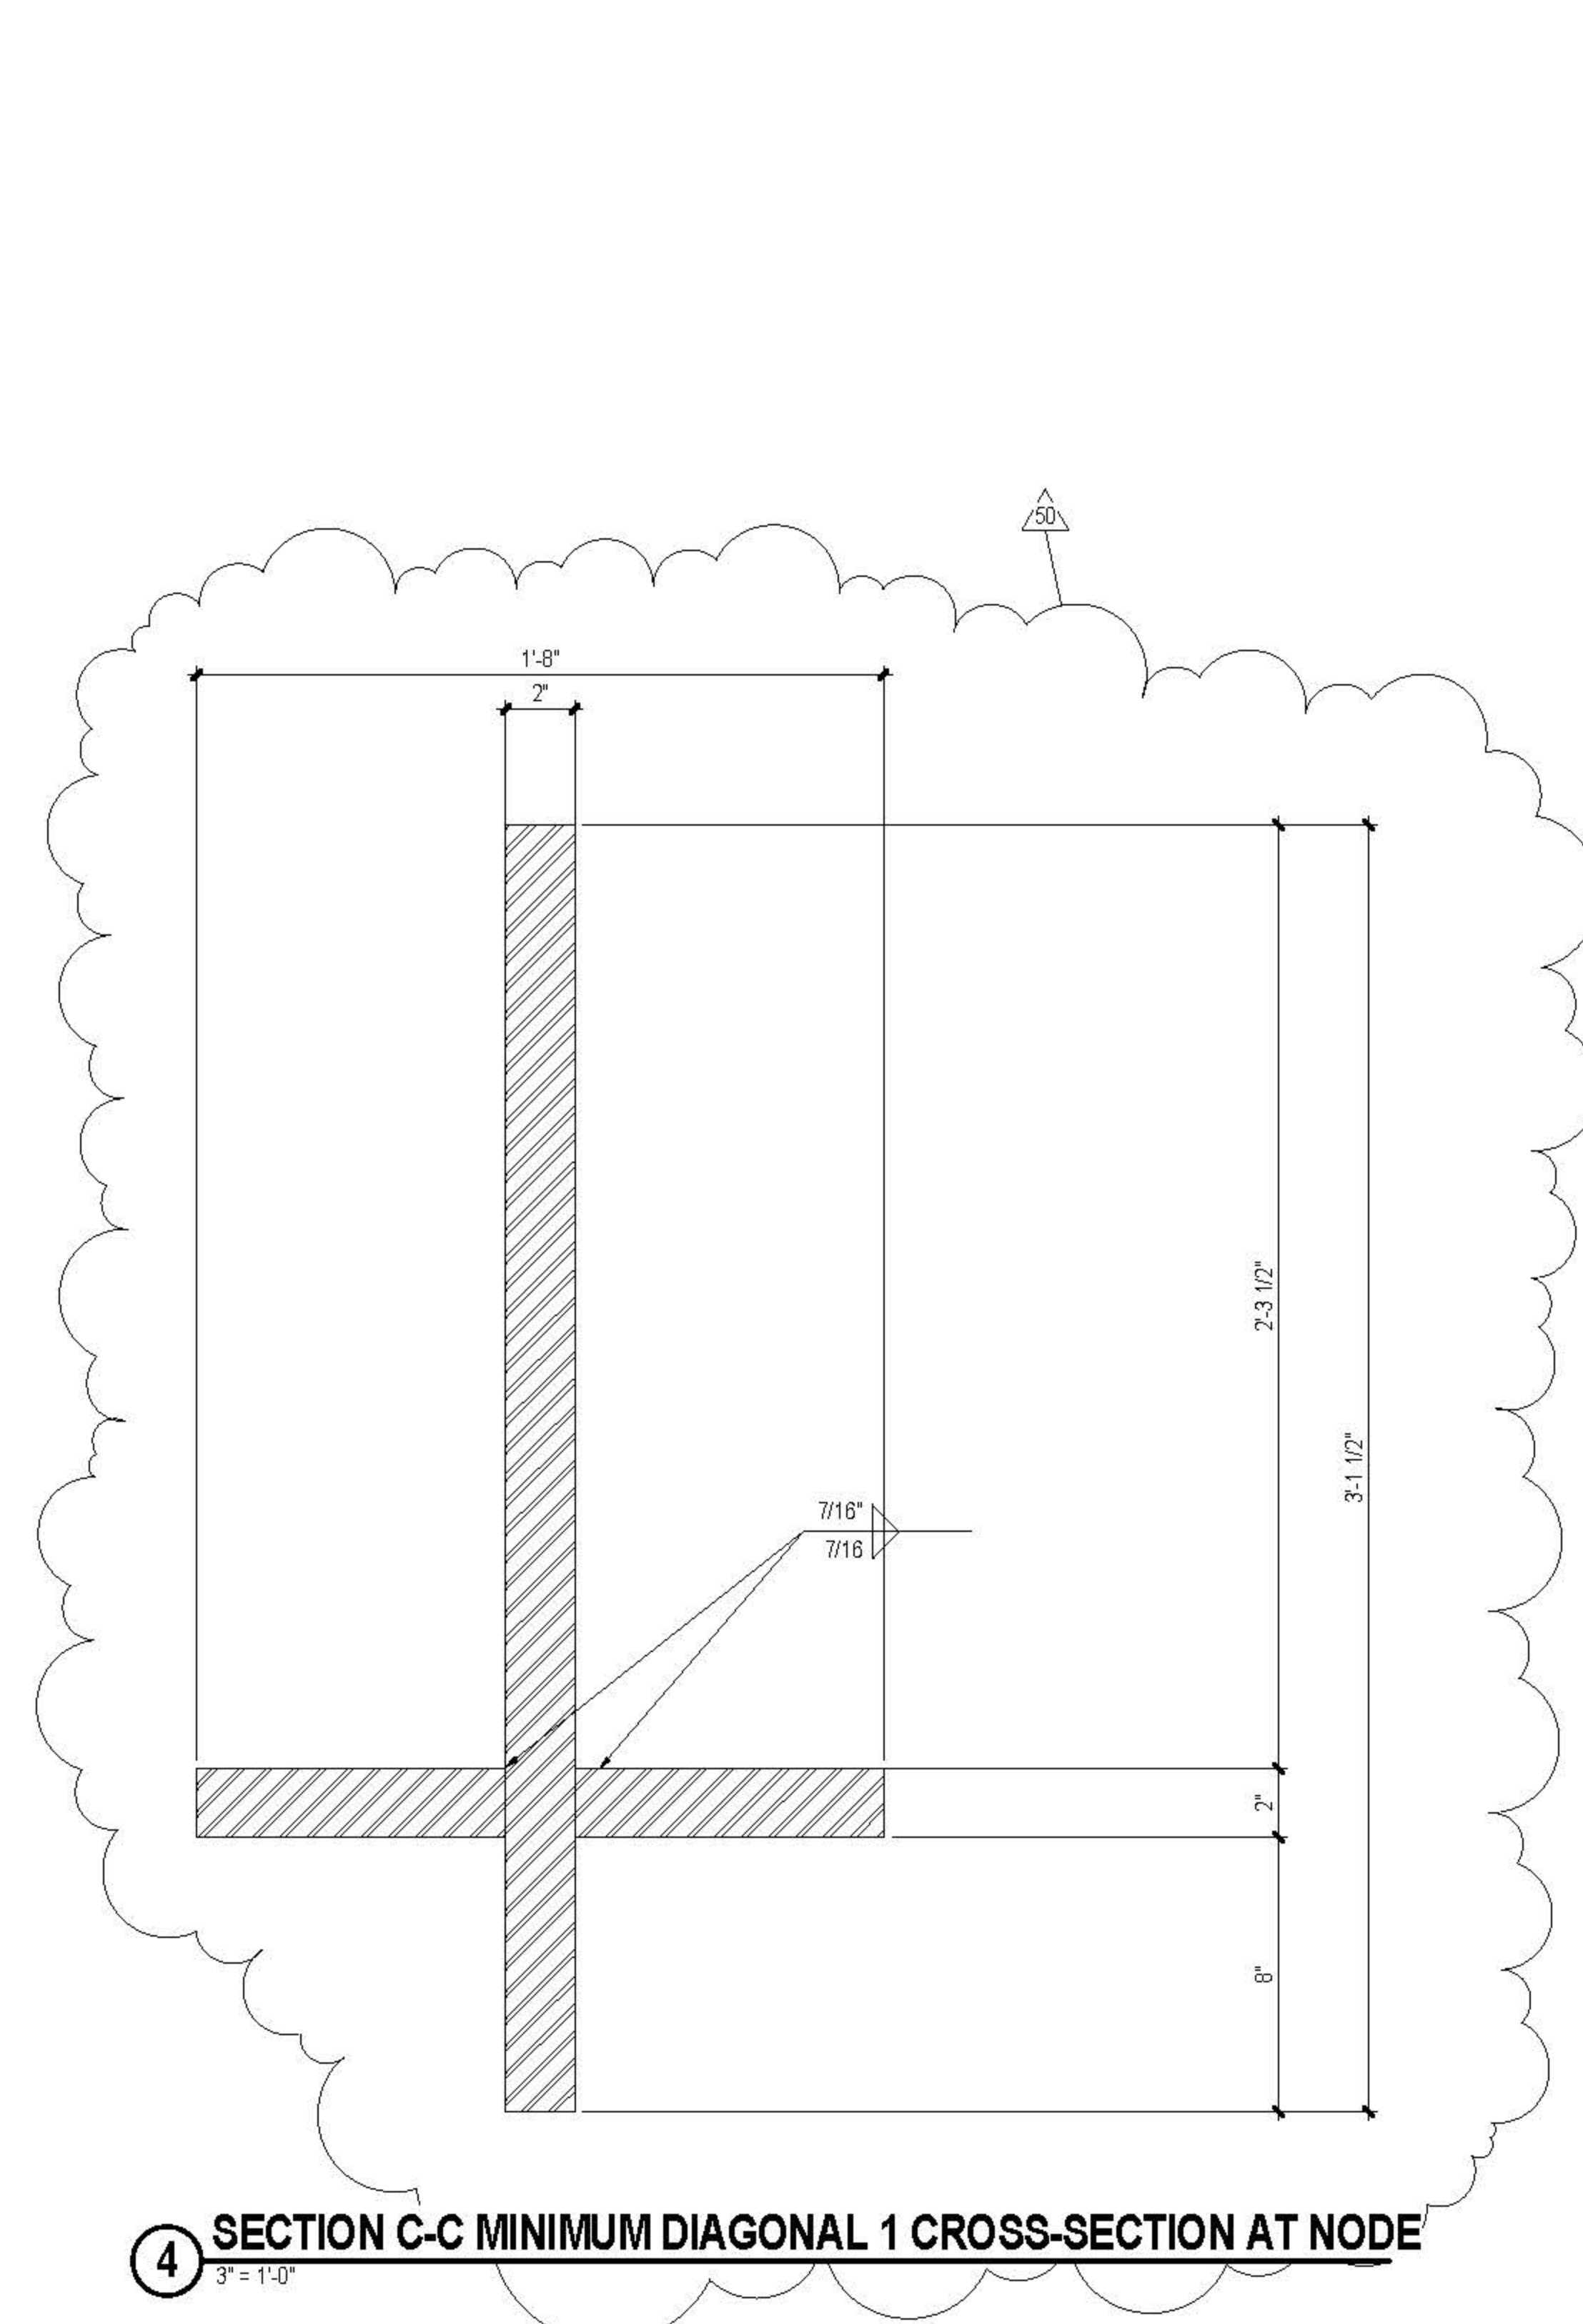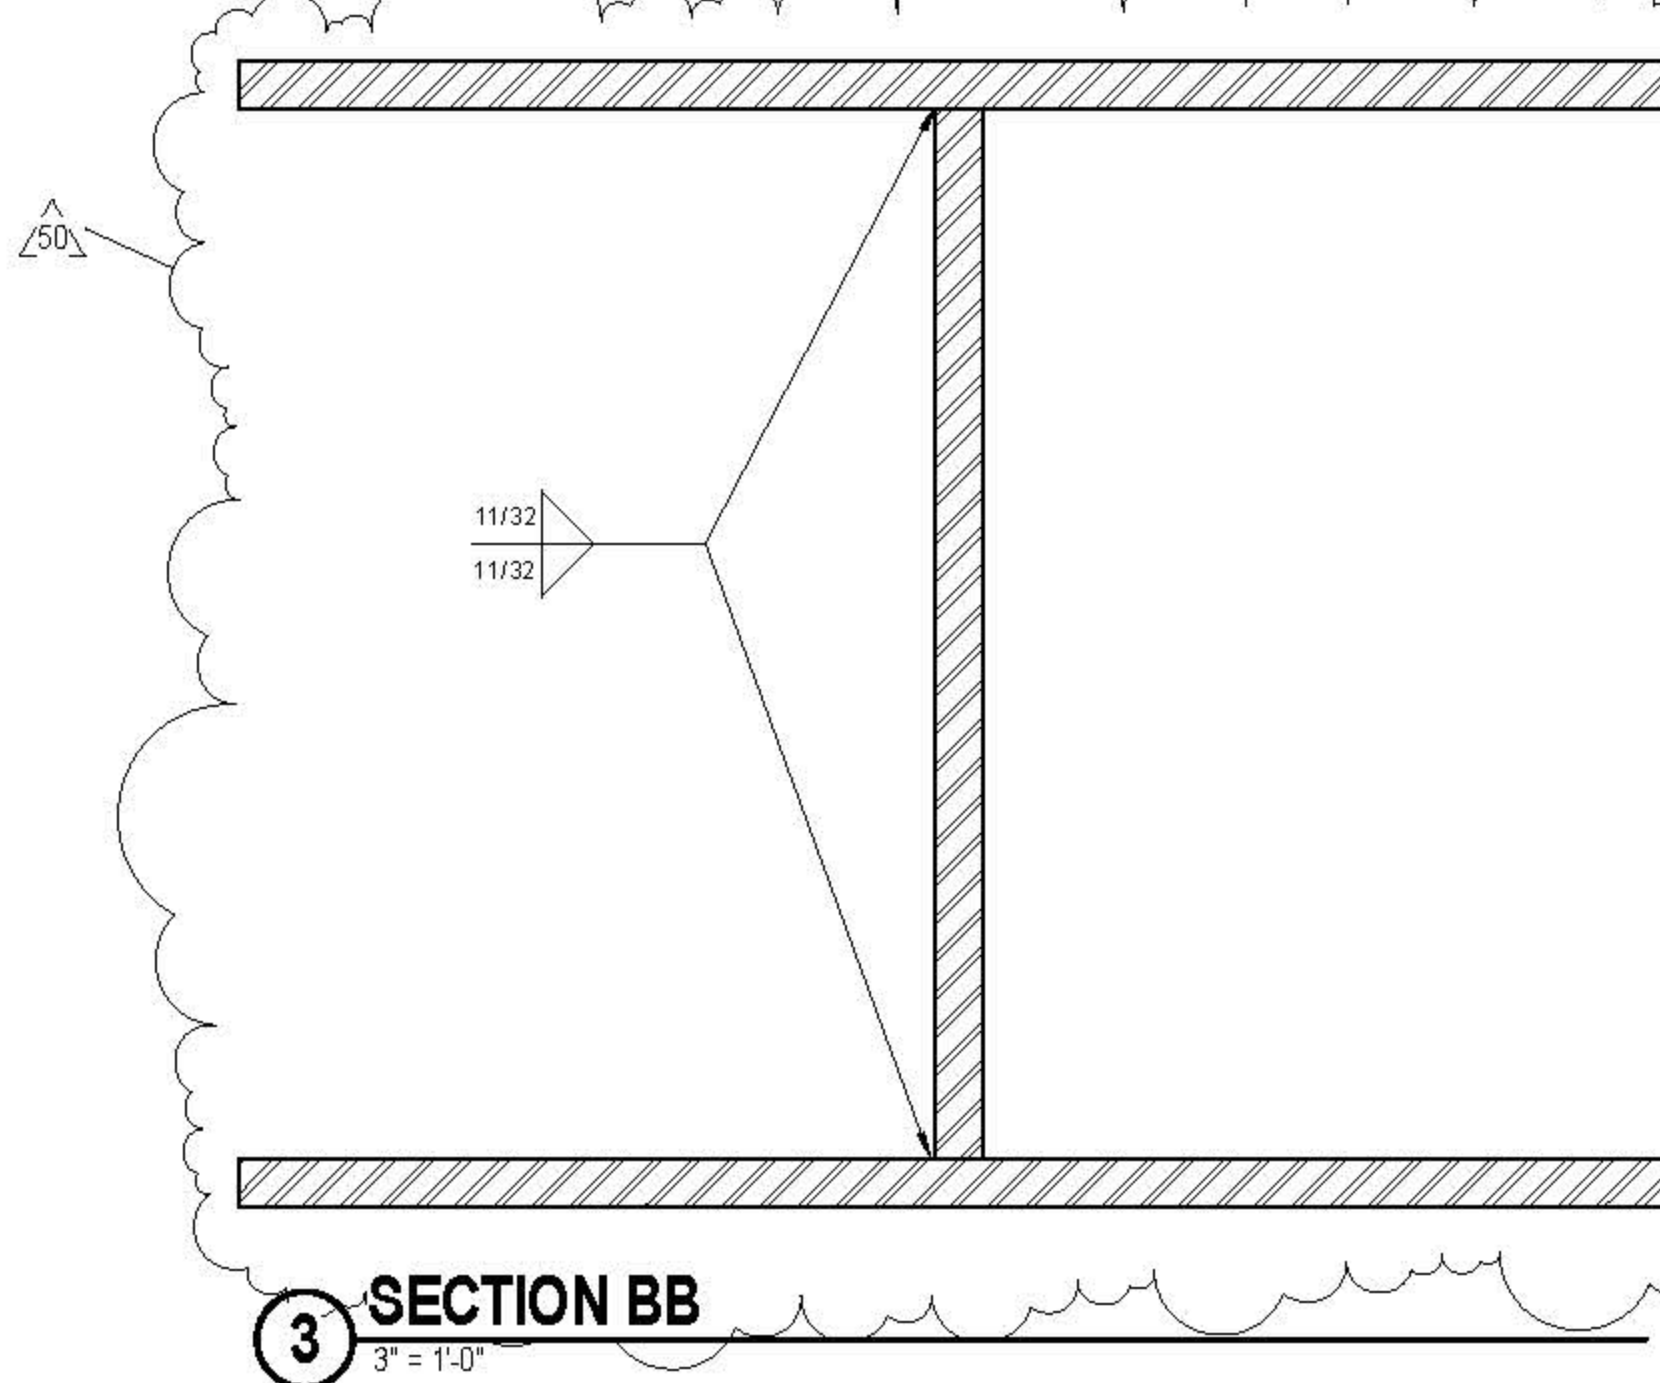

4 SECTION C-C MINIMUM DIAGONAL 1 CROSS-SECTION AT NODE
3" = 1'-0"

5 SECTION D-D MAXIMUM DIAGONAL 1 CROSS-SECTION AT NODE
1 1/2" = 1'-0"

7 AXONOMETRIC VIEW OF TYPICAL DIAGONAL
1" = 20'-0"

NOTES: EAST WALL SECTIONS VARY OVER LENGTH WITH SIMILAR COMPLEXITY TO DIAGONALS ON NORTH AND SOUTH WALL. REFER TO S-750.

ALL EAST WALL SECTIONS SIMILAR U.O.N.
ALLOW FOR INTERNAL DIAPHRAGMS AT B/C/C TYPICALLY

PENDING COORDINATION DURING DESIGN ASSIST.

CULTURE SHED
545 West 30th Street
New York, New York 10001

OWNER
CULTURE SHED INC.

ARCHITECTS
Oller Sclafano + Renfro Architects, DPC
601 West 26 Street #815
New York, New York 10001
T: 212.260.7971

rockwellgroup
5 Union St. West, 6th Fl.
New York, New York 10003
T: 212.463.0334
F: 212.463.0335

STRUCTURAL ENGINEER
Thornton Tomasetti
51 Madison Avenue
New York, New York 10010
T: 917.981.7800
F: 917.981.7801

MEP ENGINEER
Jans Baum & Bolles
50 Pine Street
New York, New York 10005
T: 212.530.9300
F: 212.266.6944

FACADE CONSULTANT
Thornton Tomasetti
51 Madison Avenue
New York, New York 10010
T: 917.981.7800
F: 917.981.7801

KINETICS ENGINEER
Hardisty & Hanover
1501 Broadway
New York, New York 10036
T: 212.944.1150
F: 212.391.0297

LIGHTING DESIGNER
Tilston Design Associates
40 North Street #1650
New York, New York 10013
T: 212.675.7760

THEATRE PLANNING & DESIGN
Fisher Dodge Associates
22 West 15th Street
New York, New York 10011
T: 212.691.3000

LIFE SAFETY
Code Consultants, Inc.
215 West 43rd St, 15th Fl.
New York, New York 10018
T: 212.216.9596

ENERGY MODEL/LEED
Vindian
50 Washington Street
Norwalk, CT 06854
T: 203.298.1411

ACOUSTIC/AUDIO-VISUAL
Avalonik
50 North Main Street
South Norwalk, CT 06854
T: 347.210.5540

VERTICAL TRANSPORTATION
Van Duusen & Associates
5 Regent Street, Suite 524
Livingston, NJ 07039
T: 973.994.9220

SPECIFICATIONS
Construction Specifications Inc.
PO Box 489
227 Emmet Road
Morganville, NJ 07751
T: 732.970.0700
F: 732.970.0750


SECURITY
Duchella Venter & Santoro
1100 Sherman Avenue
Hartford, CT 06114
T: 203.286.6490

WATERPROOFING
James R. Gahfort AIA Consulting Architects PC
104 West 27th Street
New York, NY 10001
T: 212.736.3344

FACADE MAINTENANCE
Eink Engineering PLLC
150 Area Street
New York, NY 10005
T: 212.698.3000

BRANDING GRAPHICS
2nd Global Design Consultancy
180 Varck Street 15th Floor
New York, NY 10014
T: 212.647.1170

KEY PLAN

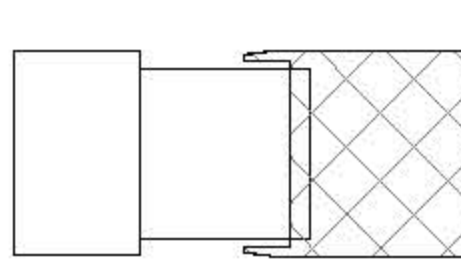

ISSUE PRINTING DATE

ISSUE	PRINTING	DATE
01	01	08/19/2016
02	02	08/23/2016
03	03	08/23/2016
04	04	08/23/2016
100	100	08/23/2016

STAMP



DRAWN BY: **Autum** CHECKED BY: **Chris**

PROJECT NUMBER: **N11318.00**


TITLE: **DETAILS DEPLOYED SHED EAST WALL E**

DRAWING NO.: **8-771.01**


B-SCAN NO.: **S-771.01**

104 of 123


GEOMETRY, DIMENSIONS AND SURFACE CONTOURING, BLENDING AND INTERSECTION OF SECTIONS ILLUSTRATED IN THE STRUCTURAL DRAWINGS ARE PROVIDED FOR REFERENCE AND GENERATION OF STRUCTURAL ARRANGEMENT AND DETAILS ONLY. THE 3D MODEL ISSUED BY THE ARCHITECT DEFINES THE EXTERIOR SURFACE AND SHALL BE ADHERED TO FOR THE FINAL GEOMETRY. FOR DETAILS OF SECONDARY STEEL, INCLUDING STRUCTURAL CLADDING REFER TO ARCHITECTURE DRAWINGS. IT IS THE RESPONSIBILITY OF THE CONTRACTOR TO IDENTIFY ANY DISCREPANCIES OR AMBIGUITIES FOR DISCUSSION, RESOLUTION AND DIRECTION FROM THE ARCHITECT AND SER.

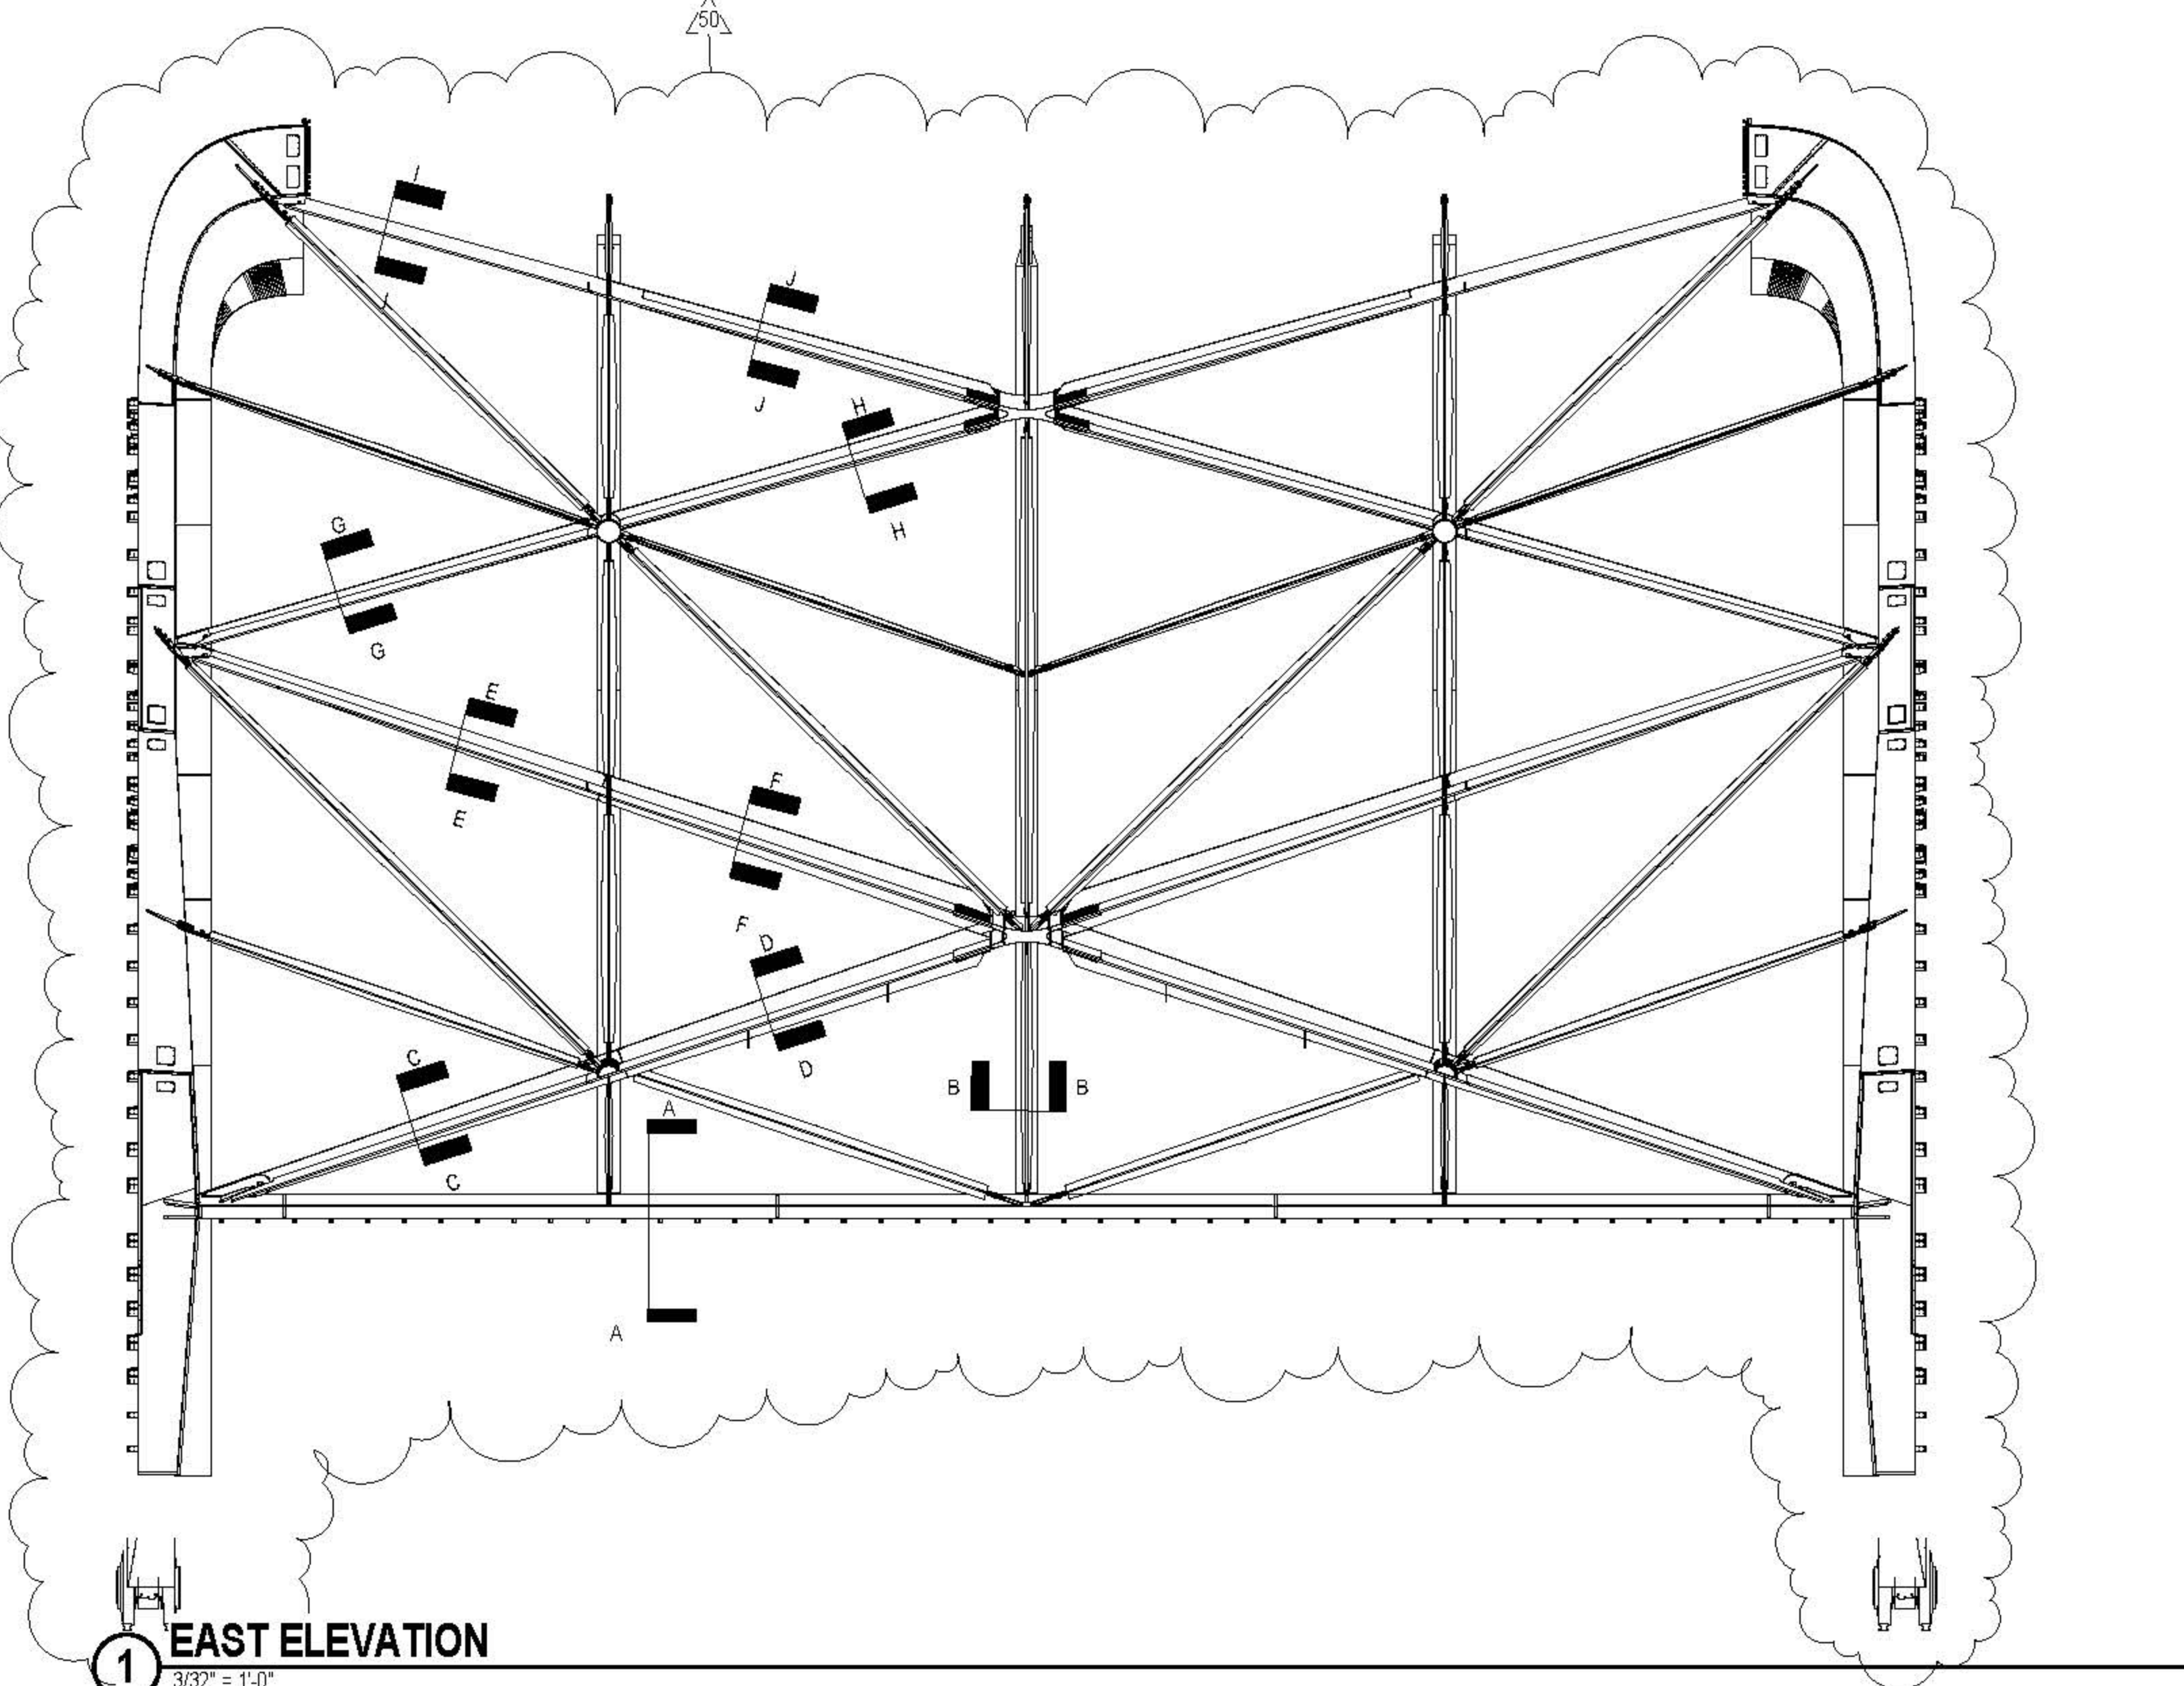


1 EAST ELEVATION
3/32" = 1'-0"

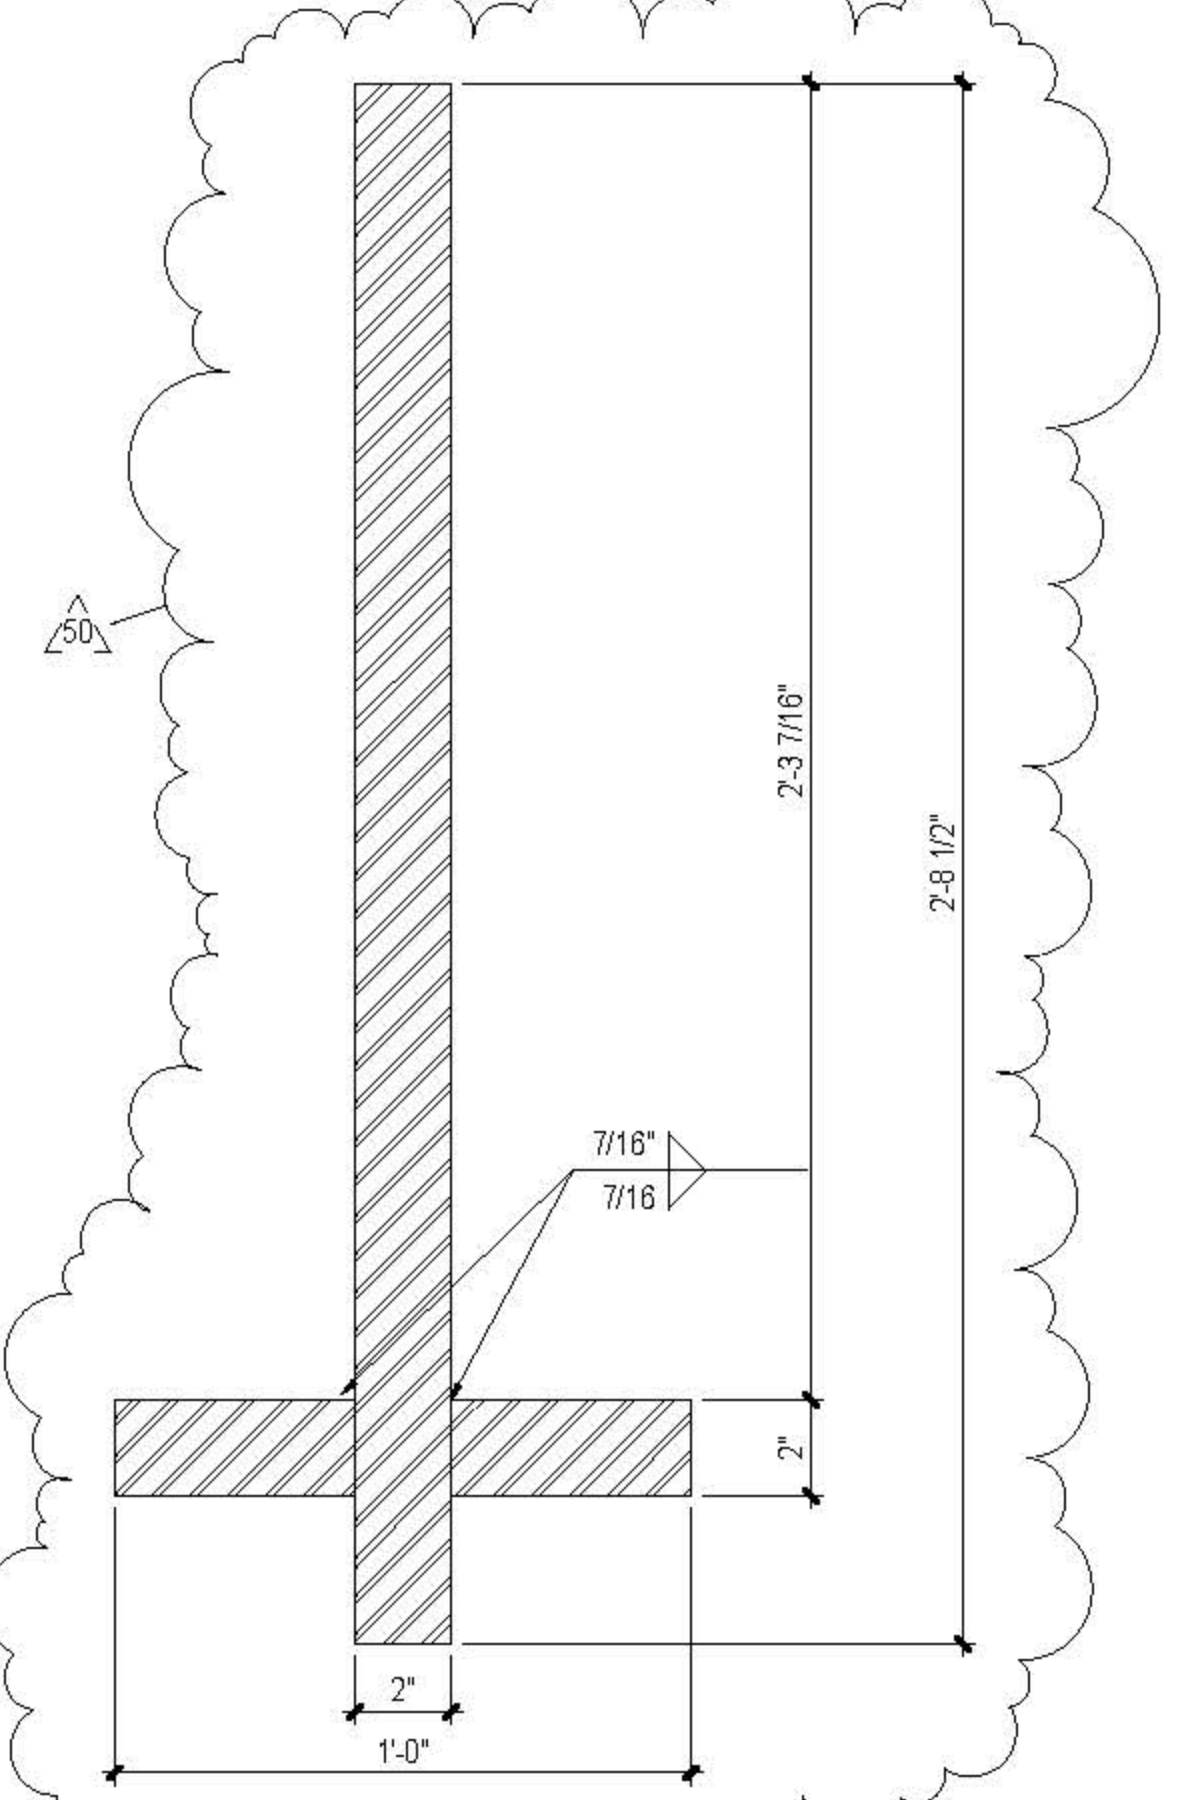


6 SECTION I-I MINIMUM DIAGONAL 4 CROSS-SECTION AT PIN
3" = 1'-0"

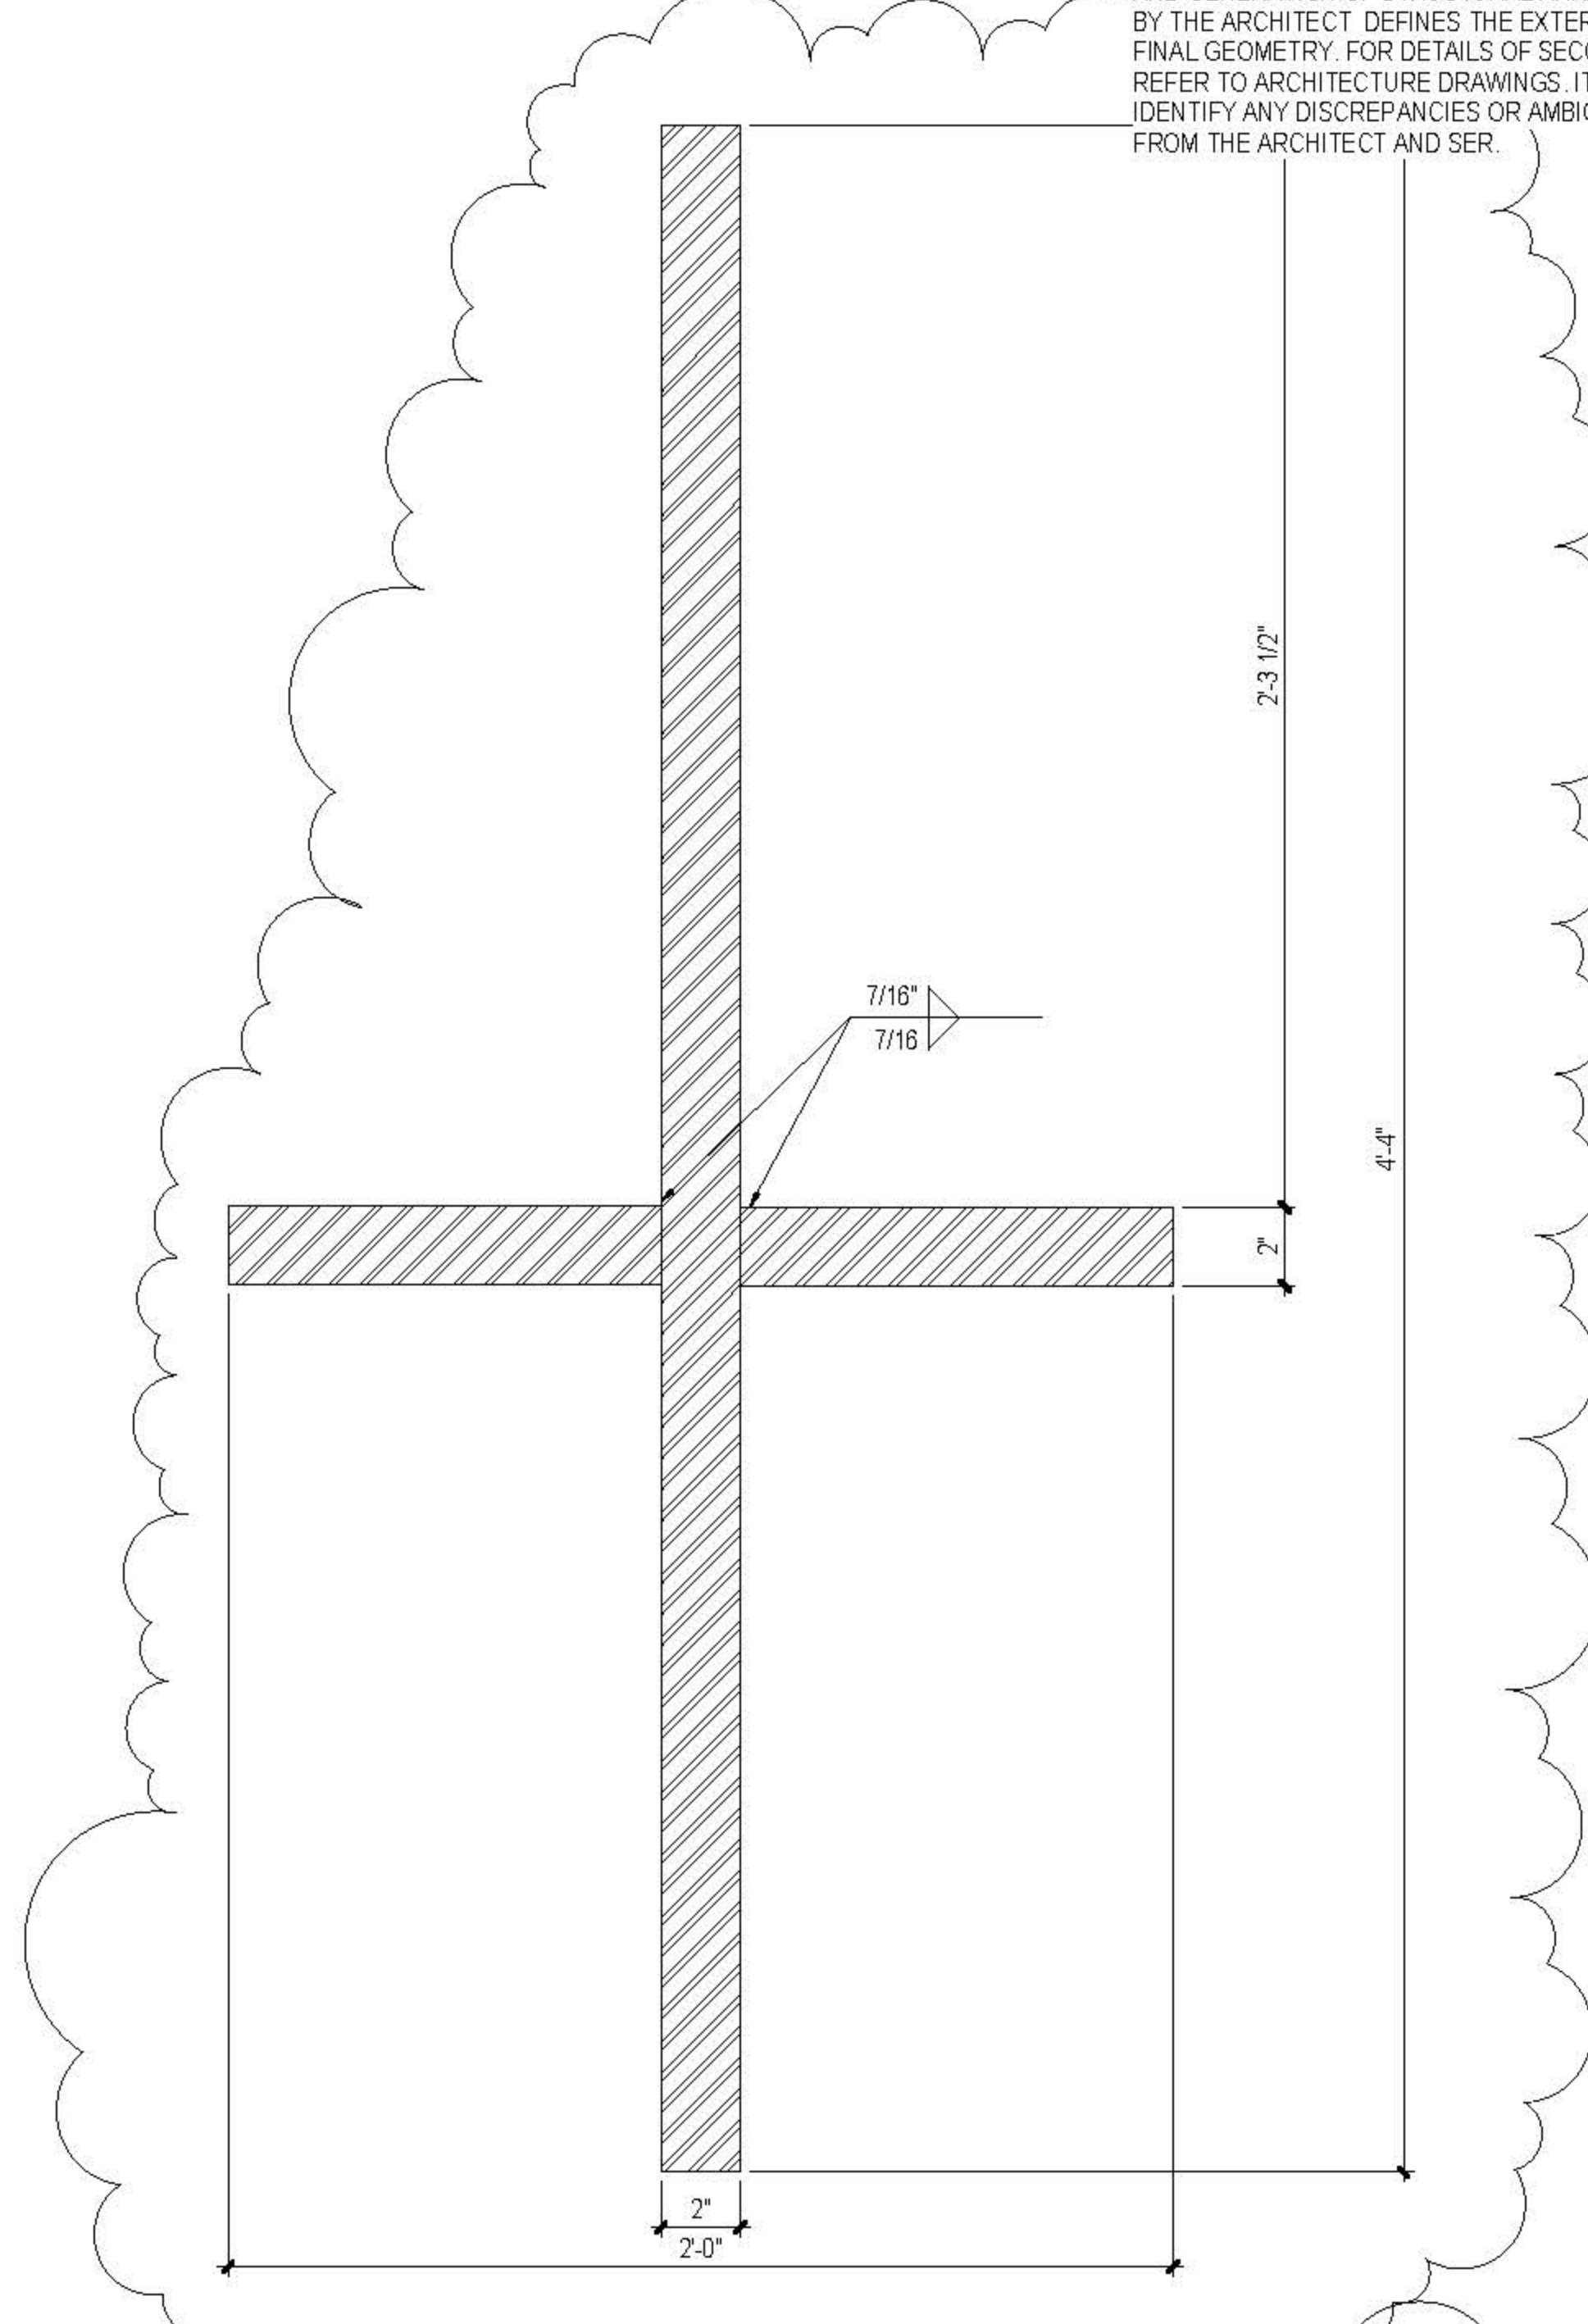


7 SECTION J-J MAXIMUM DIAGONAL 4 CROSS-SECTION AT NODE
3" = 1'-0"

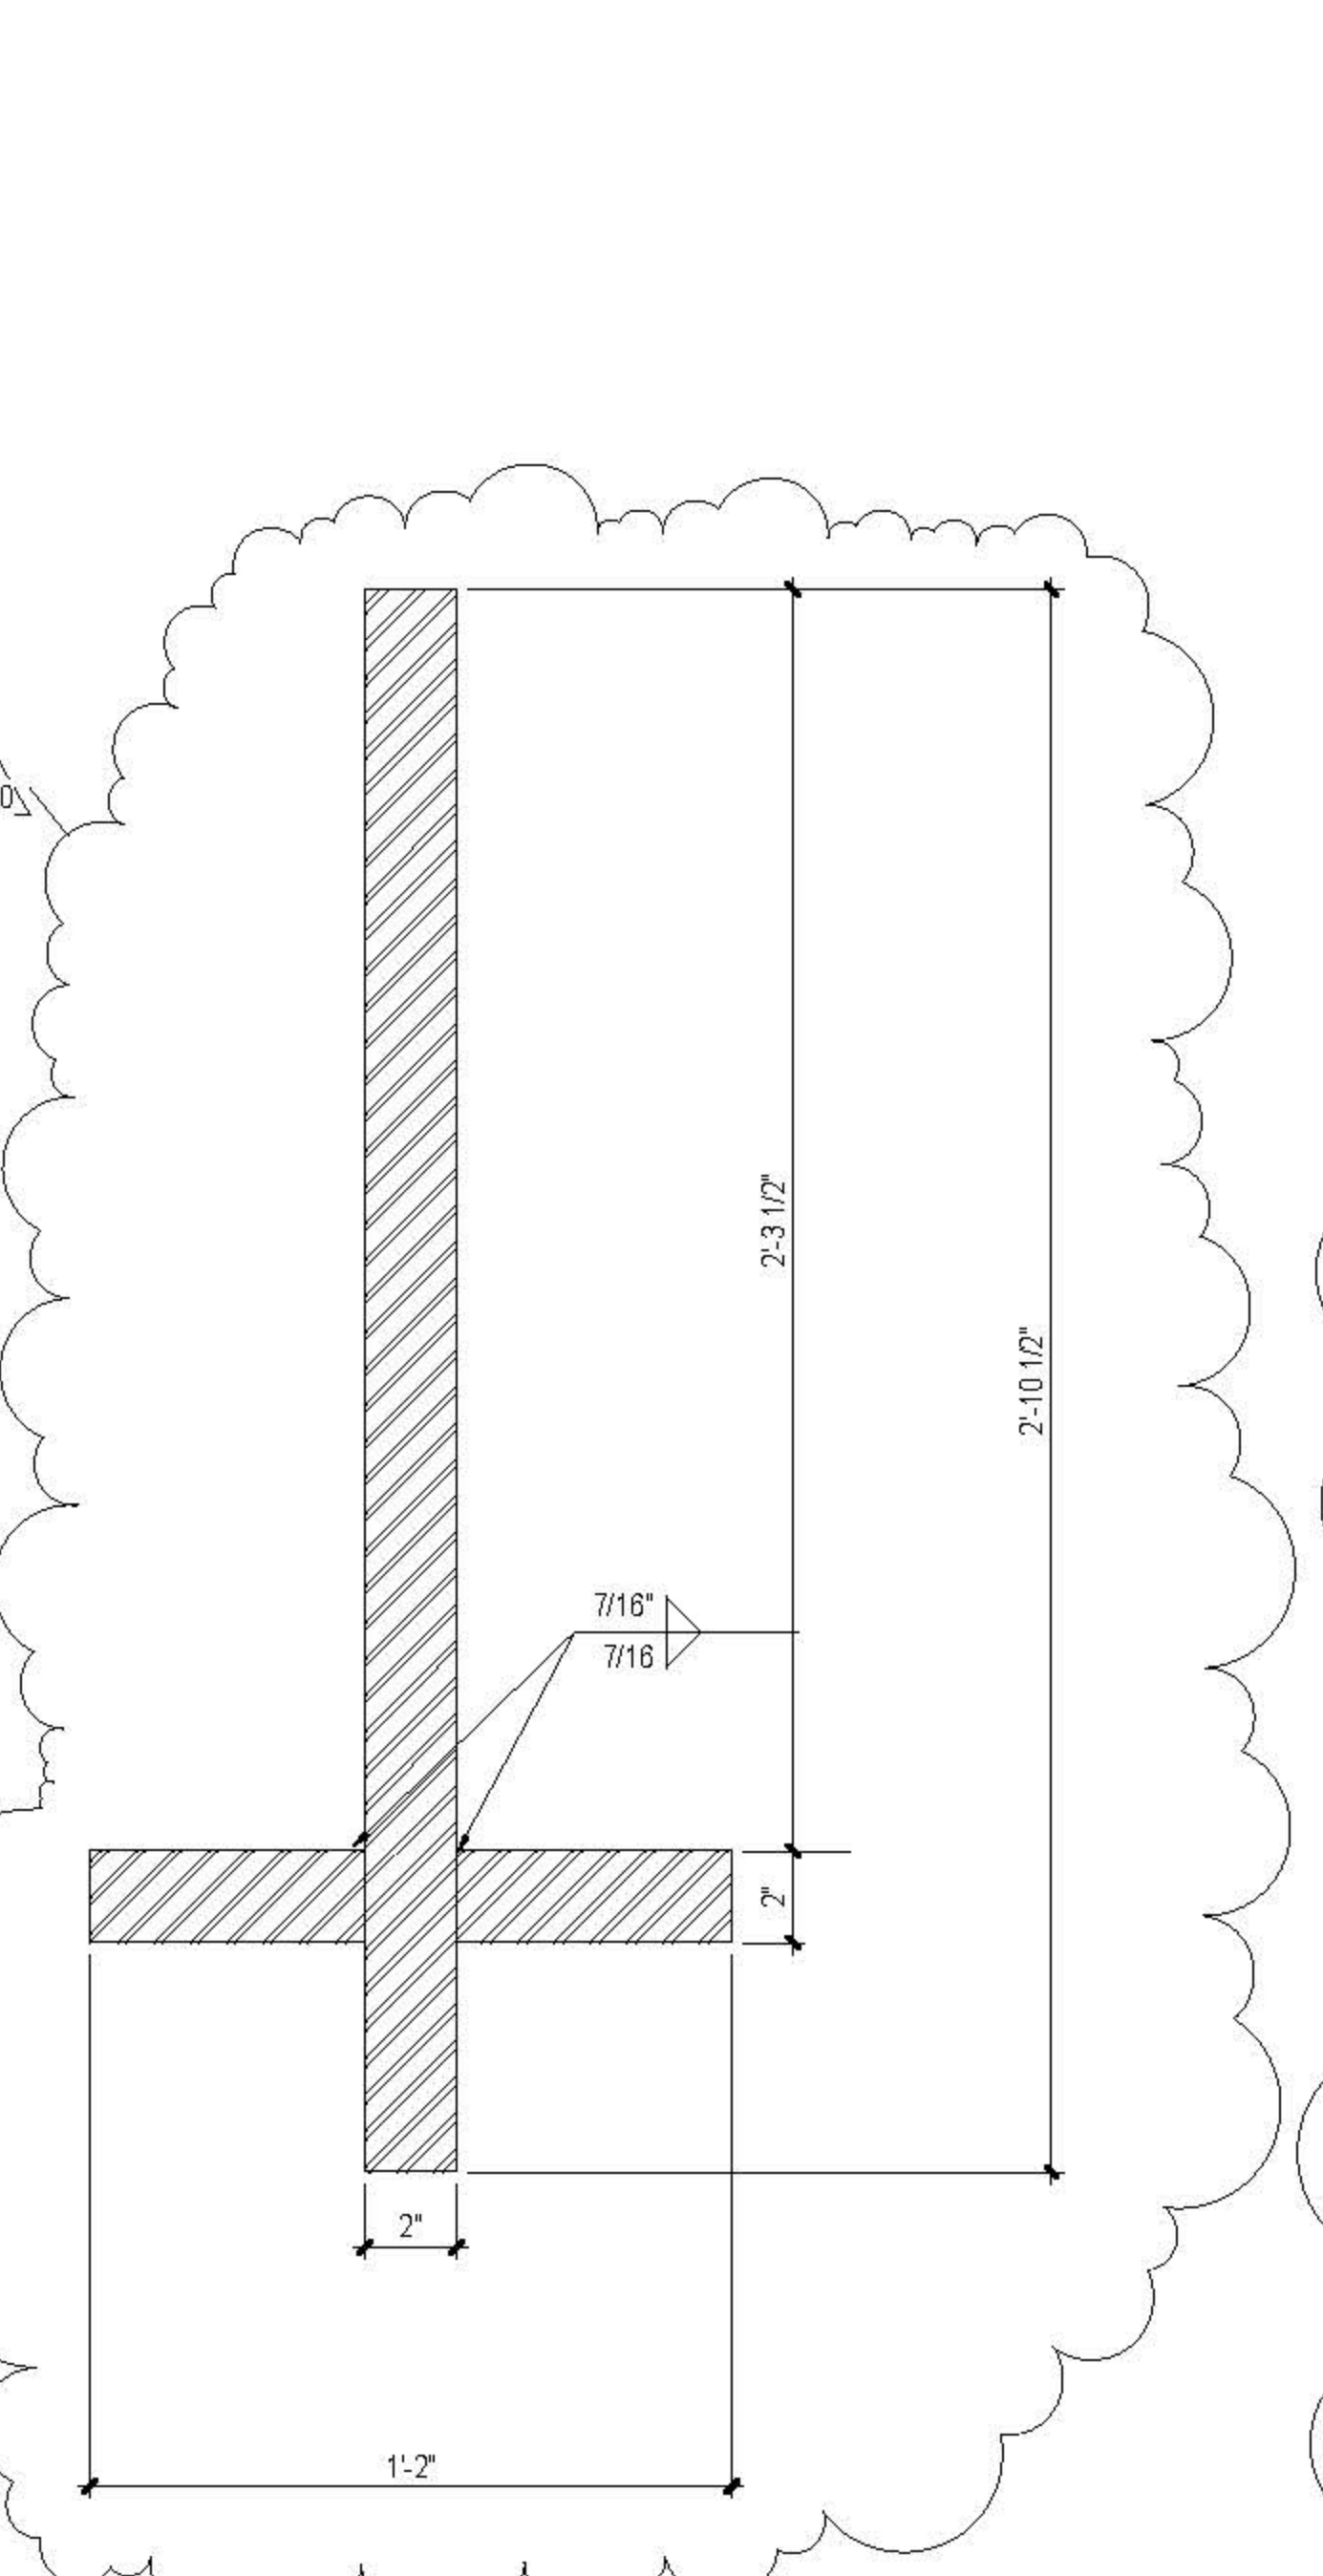


2 SECTION E-E MINIMUM DIAGONAL 2 CROSS-SECTION AT PIN
3" = 1'-0"

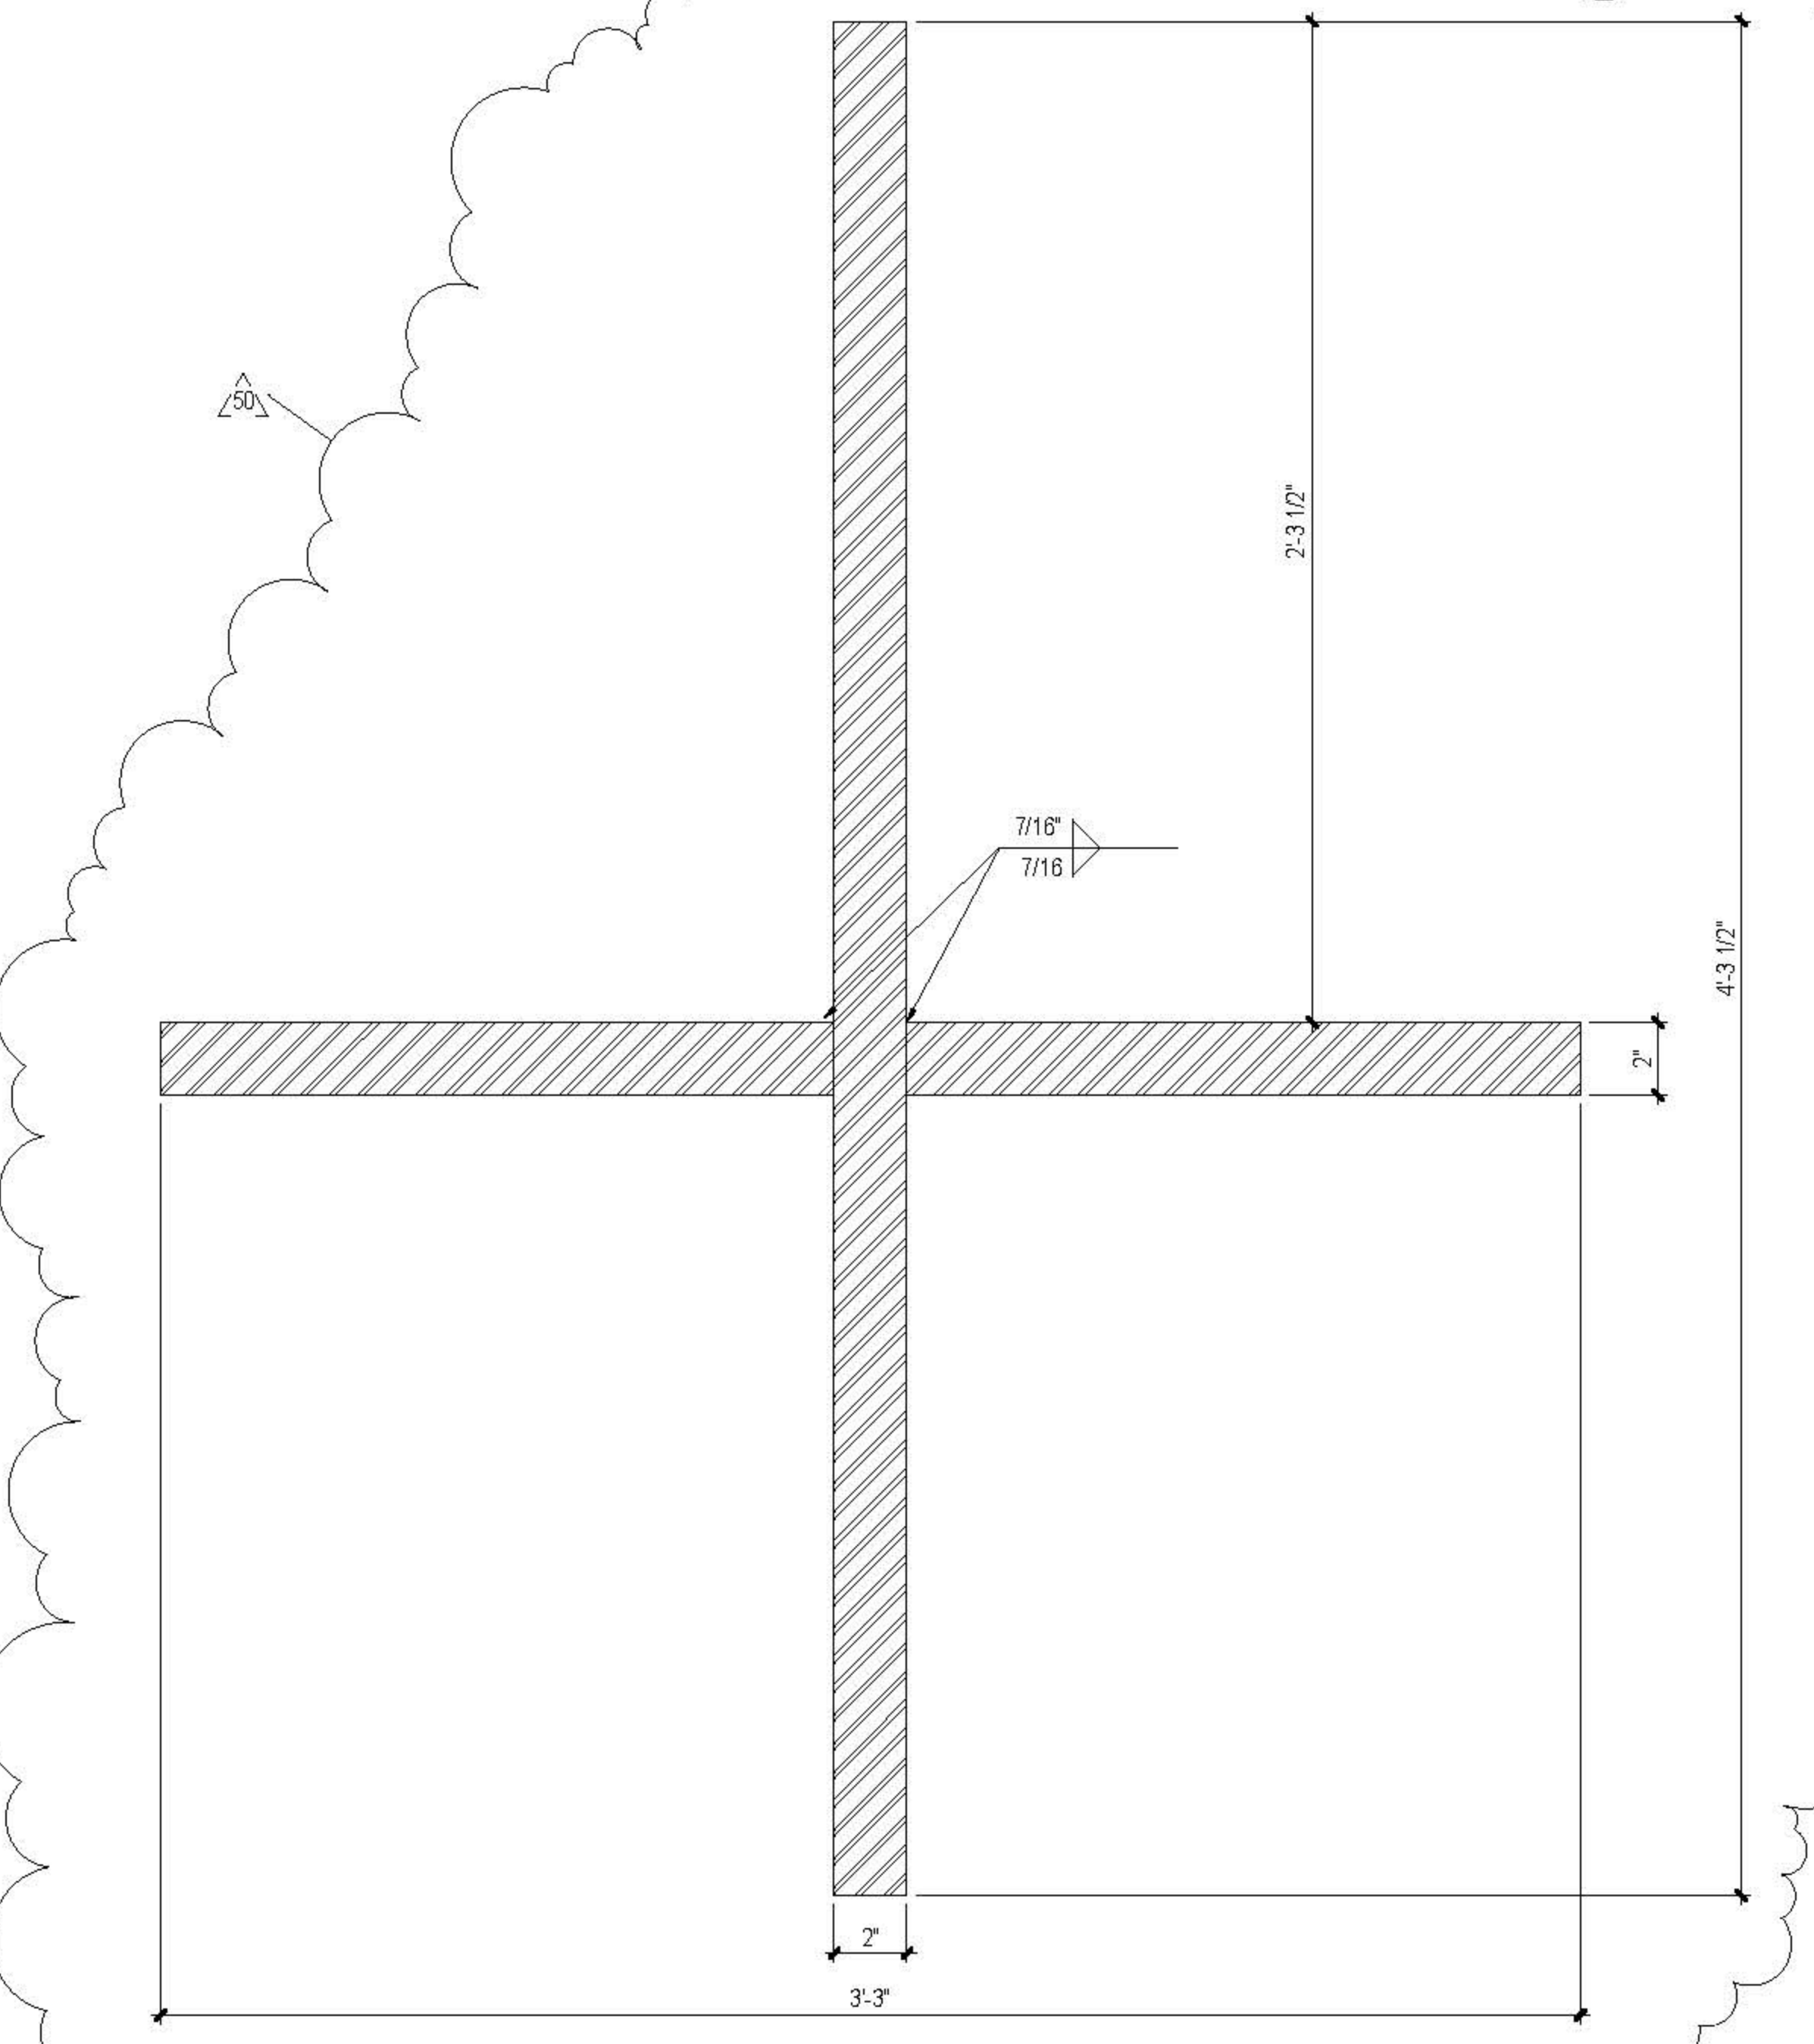

3 SECTION F-F MAXIMUM DIAGONAL 2 CROSS-SECTION AT NODE
3" = 1'-0"

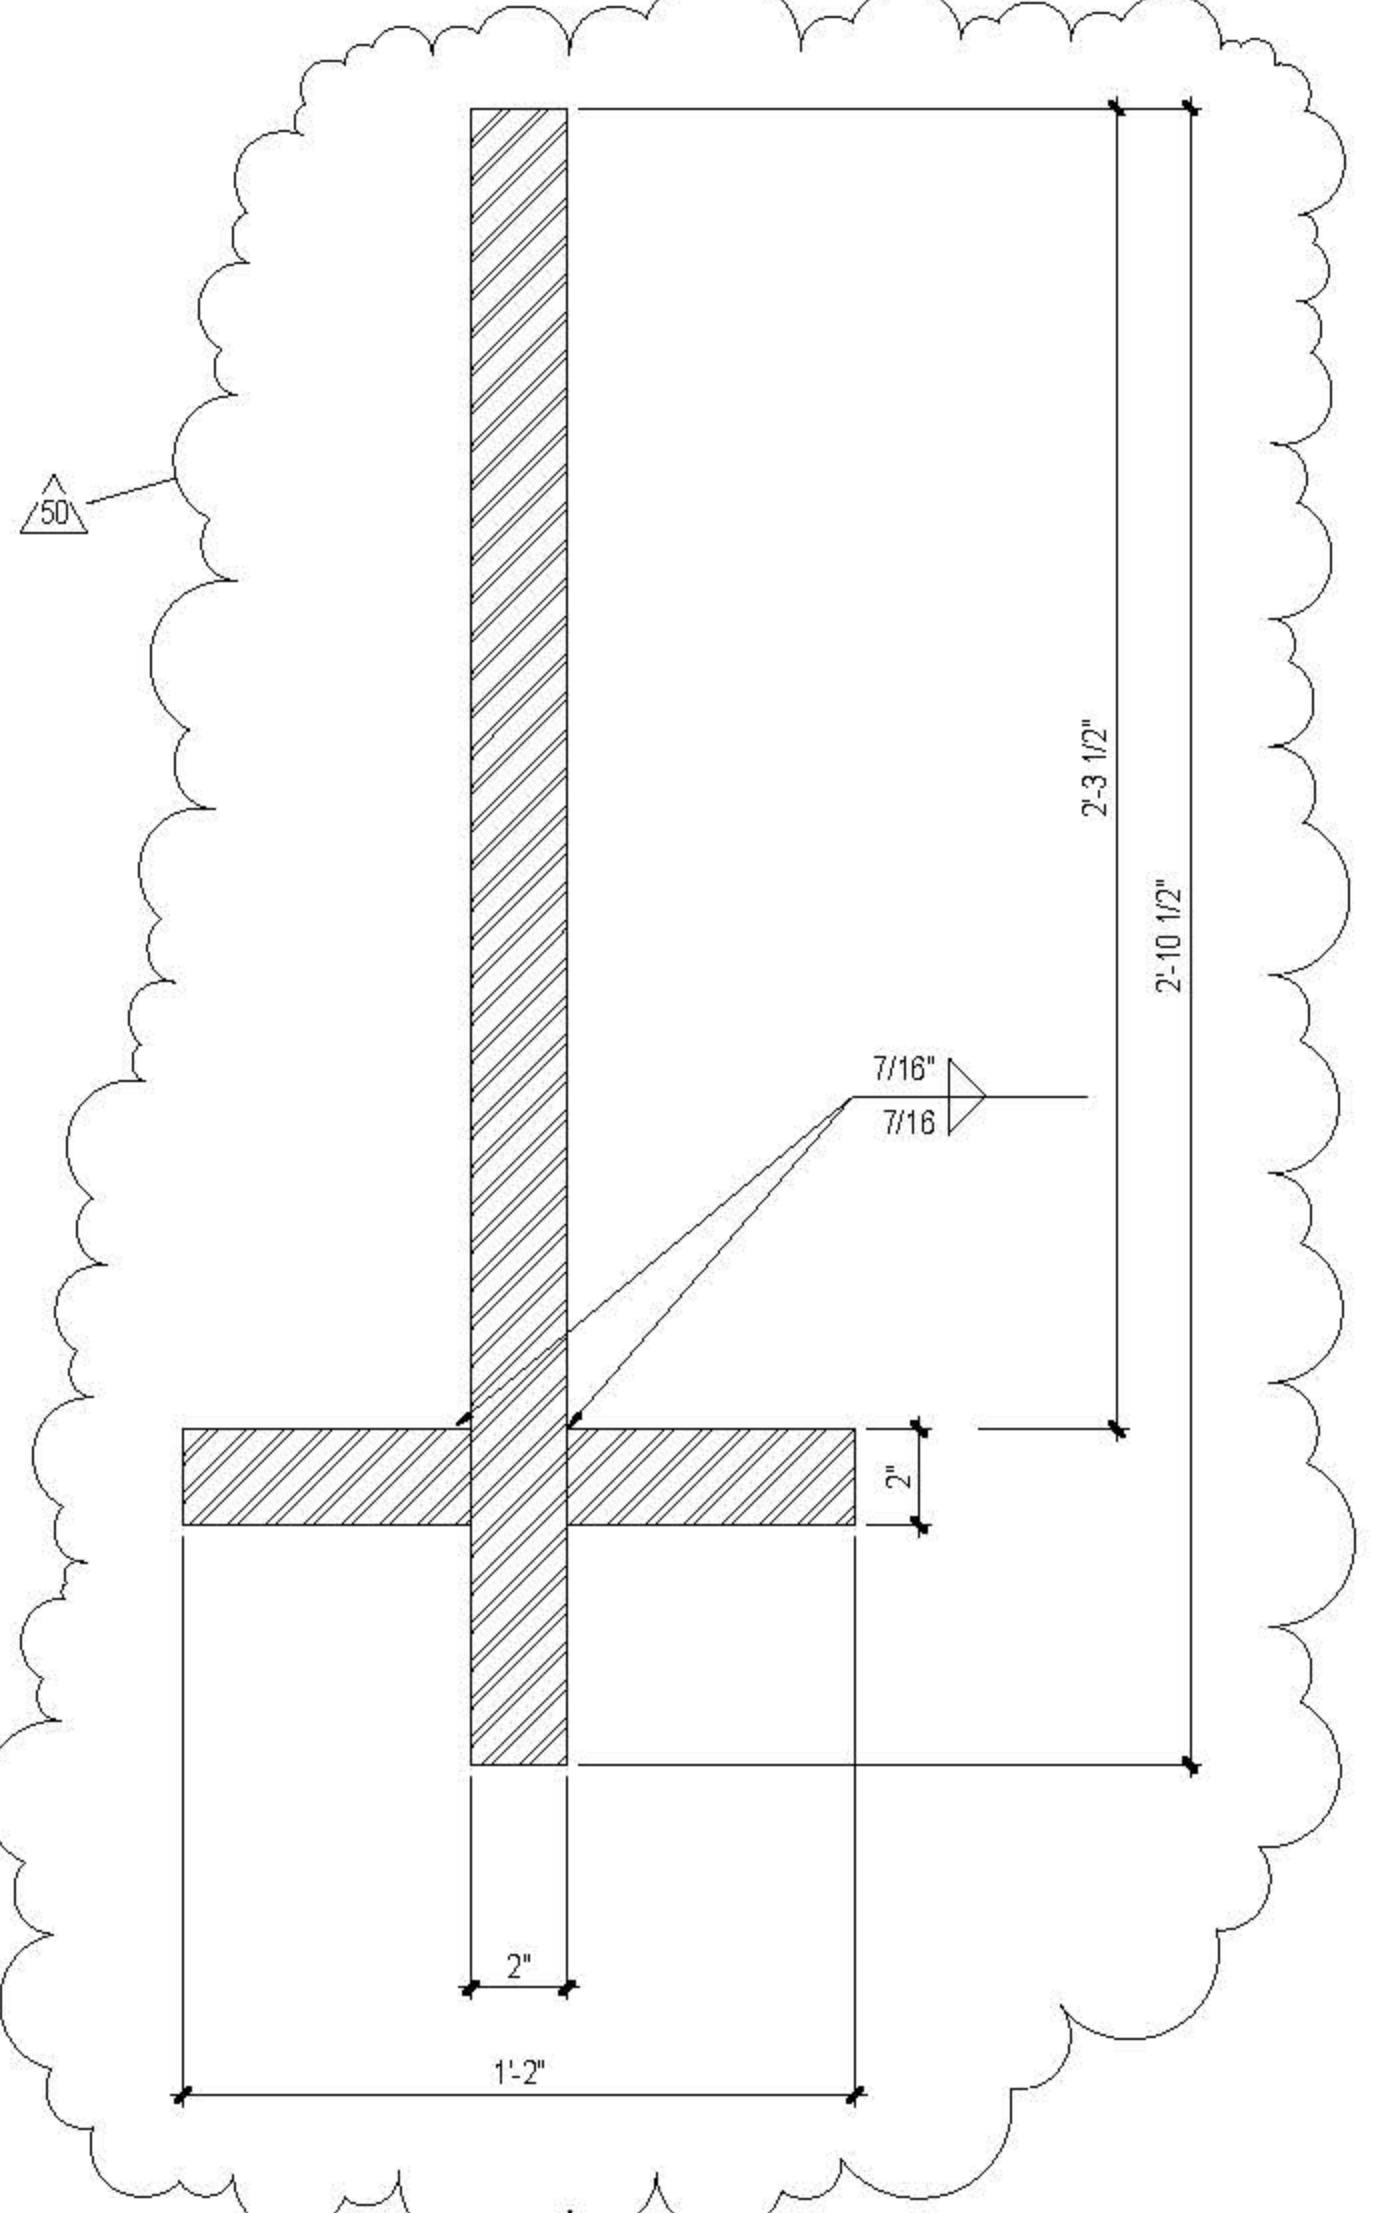

4 SECTION G-G MINIMUM DIAGONAL 3 CROSS-SECTION AT PIN
3" = 1'-0"

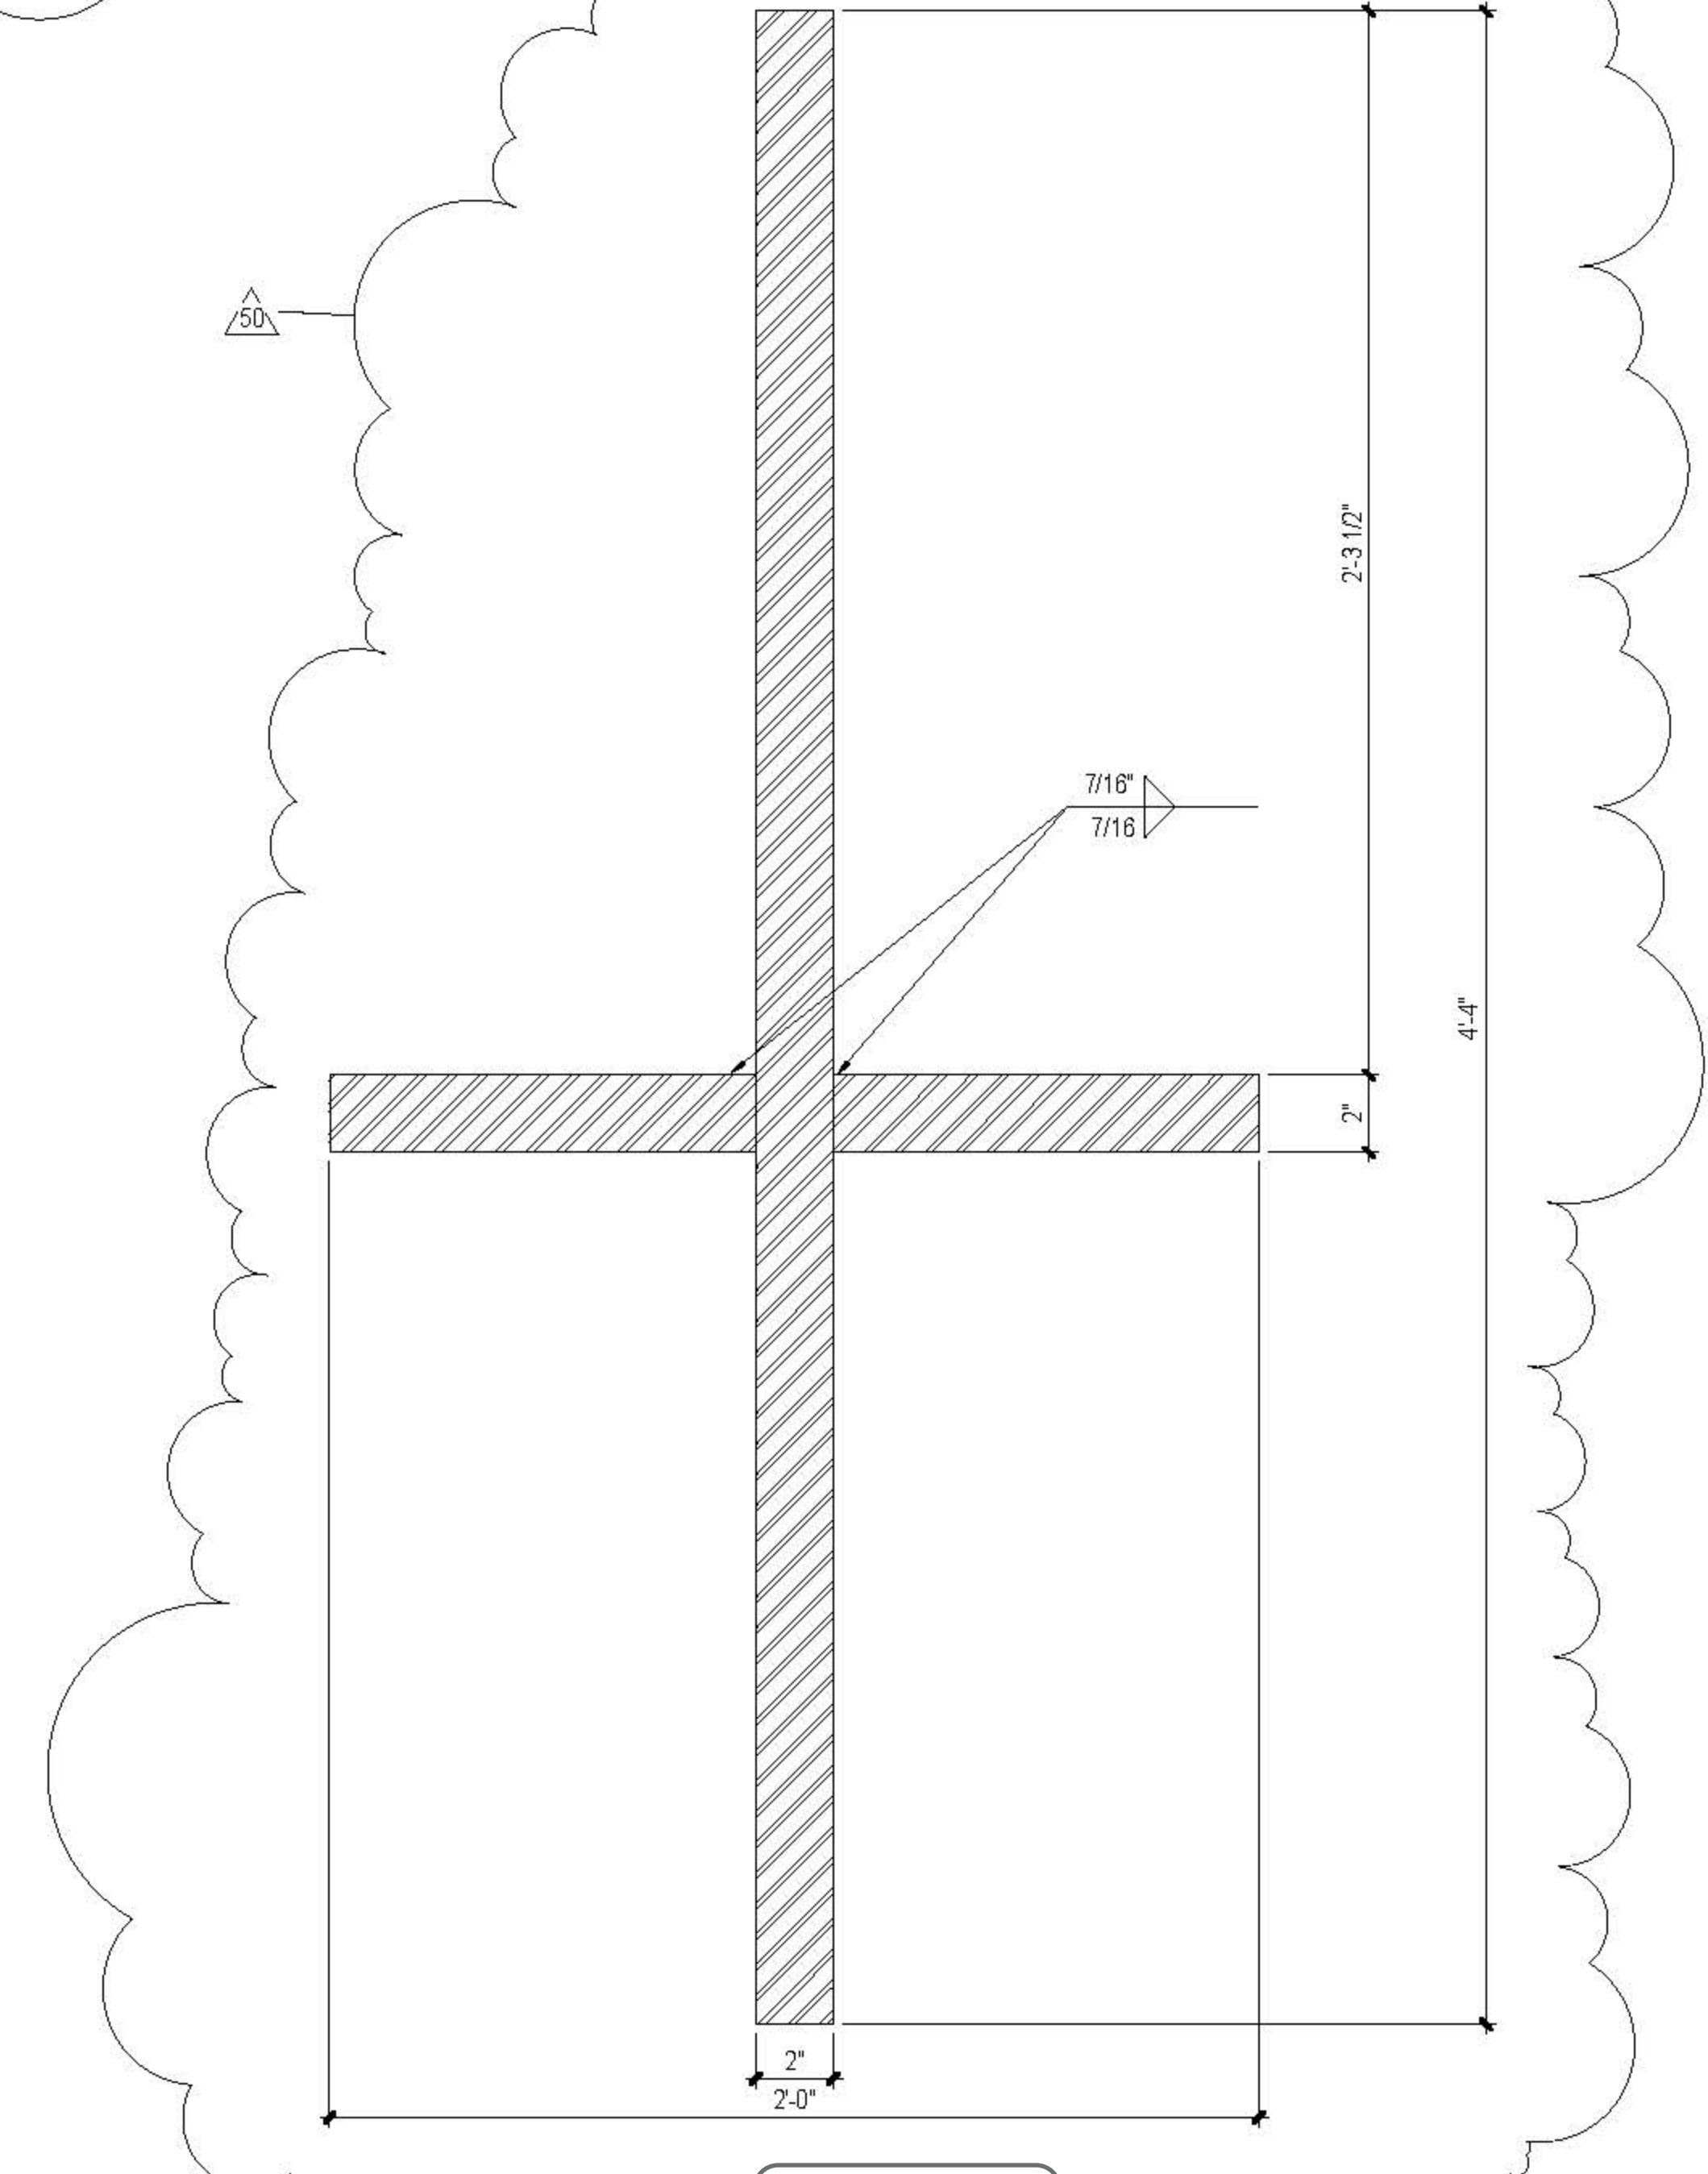

5 SECTION H-H MAXIMUM DIAGONAL 3 CROSS-SECTION AT NODE
3" = 1'-0"

CATEGORY I CORNERS: ALL CORNERS MARKED CATEGORY I TO HAVE A SHARP CONTINUOUS EDGE WITH STRAIGHTNESS TO WITHIN +/- 1/16". ALL CORNERS MAY HAVE A 0.08" RADIUS.

1) EXPOSED EDGE WITH CONTINUOUS AND CONSISTENT FINISH REQUIRED, EVEN ACROSS SPLICES FOR NODE WELD DETAILS SEE DRAWING S-755

NOTES: EAST WALL SECTIONS VARY OVER LENGTH WITH SIMILAR COMPLEXITY TO DIAGONALS ON NORTH AND SOUTH WALL. REFER TO S-750.








ALL EAST WALL SECTIONS SIMILAR U.O.N. ALLOW FOR INTERNAL DIAPHRAGMS AT 8" C/C TYPICALLY REFER TO S-770 FOR PLATE THICKNESSES



PENDING COORDINATION DURING DESIGN ASSIST.

GEOMETRY, DIMENSIONS AND SURFACE CONTOURING, BLENDING AND INTERSECTION OF SECTIONS ILLUSTRATED IN THE STRUCTURAL DRAWINGS ARE PROVIDED FOR REFERENCE AND GENERATION OF STRUCTURAL ARRANGEMENT AND DETAILS ONLY. THE 3D MODEL ISSUED BY THE ARCHITECT DEFINES THE EXTERIOR SURFACE AND SHALL BE ADHERED TO FOR THE FINAL GEOMETRY. FOR DETAILS OF SECONDARY STEEL, INCLUDING STRUCTURAL CLADDING REFER TO ARCHITECTURE DRAWINGS. IT IS THE RESPONSIBILITY OF THE CONTRACTOR TO IDENTIFY ANY DISCREPANCIES OR AMBIGUITIES FOR DISCUSSION, RESOLUTION AND DIRECTION FROM THE ARCHITECT AND SER.


THE GEOMETRY CREATED BY THE INTERSECTING ELEMENTS SHALL BE IN ACCORDANCE WITH THE 3D MODEL. THE LEVEL OF QUALITY IS TO BE SIMILAR TO THE COMMISSIONED MOCK-UP FOR THE TYPICAL NODE. THE GENERAL CONCEPT IS THAT EDGES FLOW SMOOTHLY AND CONTINUOUSLY BETWEEN THE EDGE OF THE ELEMENT TO THE CORRESPONDING EDGE OF THE ADJACENT ELEMENT AND THE INTERLYING SURFACES BETWEEN THESE EDGES ARE BLENDED AND CONTOURED TO DEFINE A SMOOTH, UNINTERRUPTED TRANSITION.

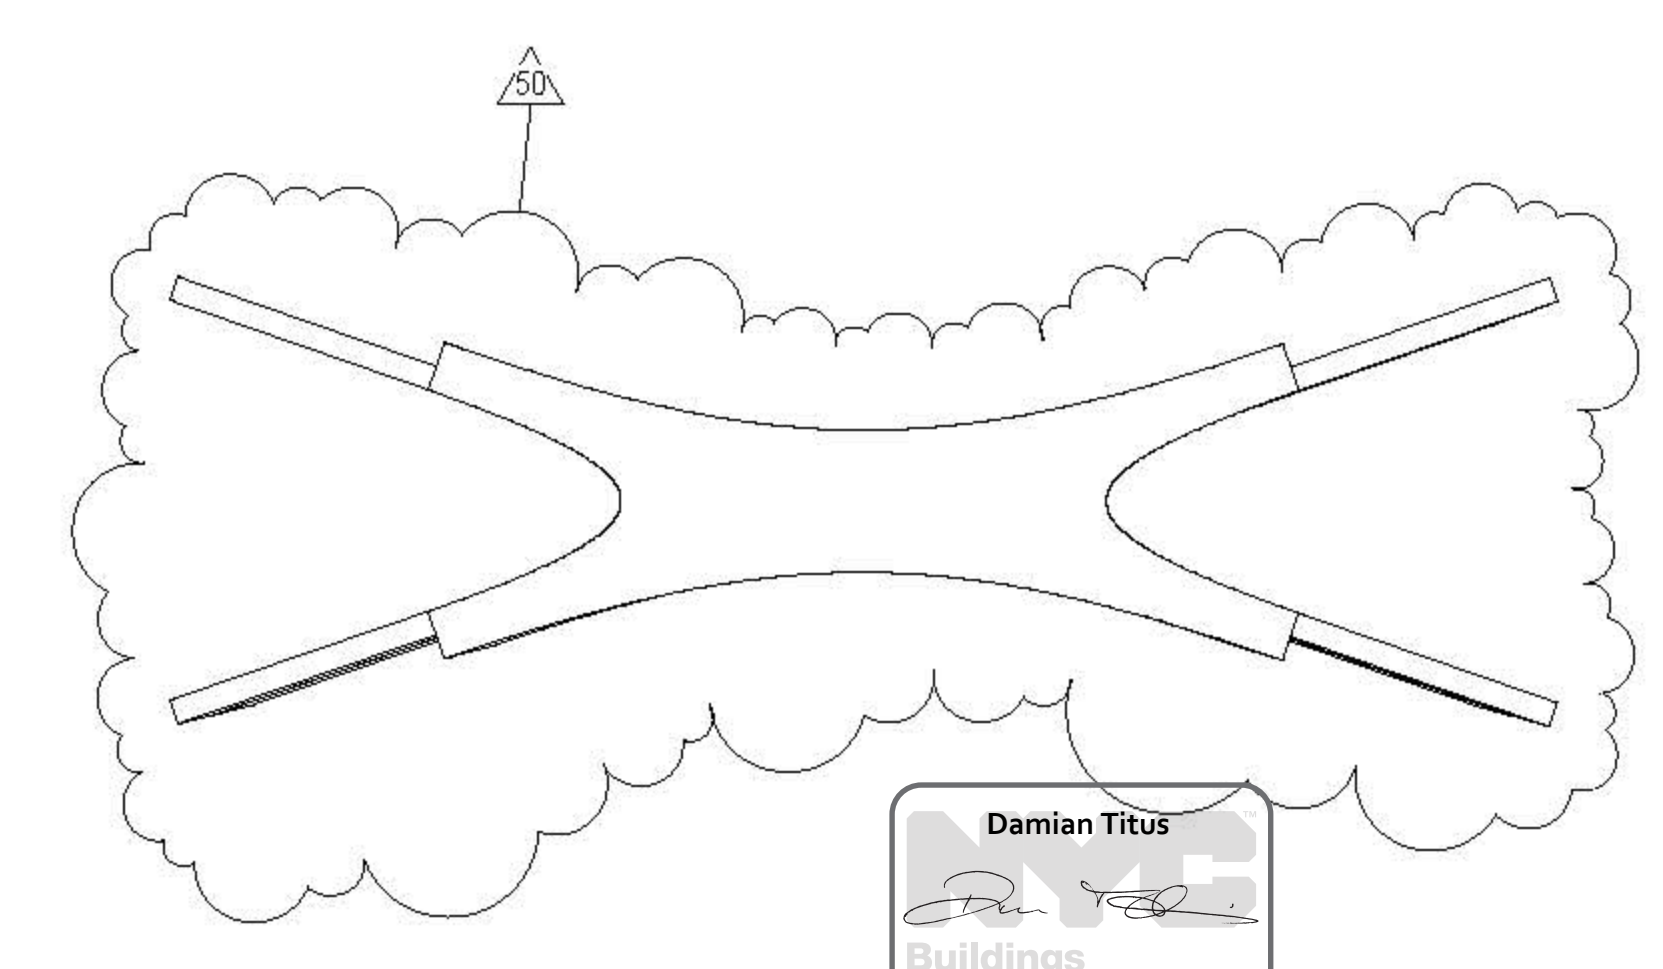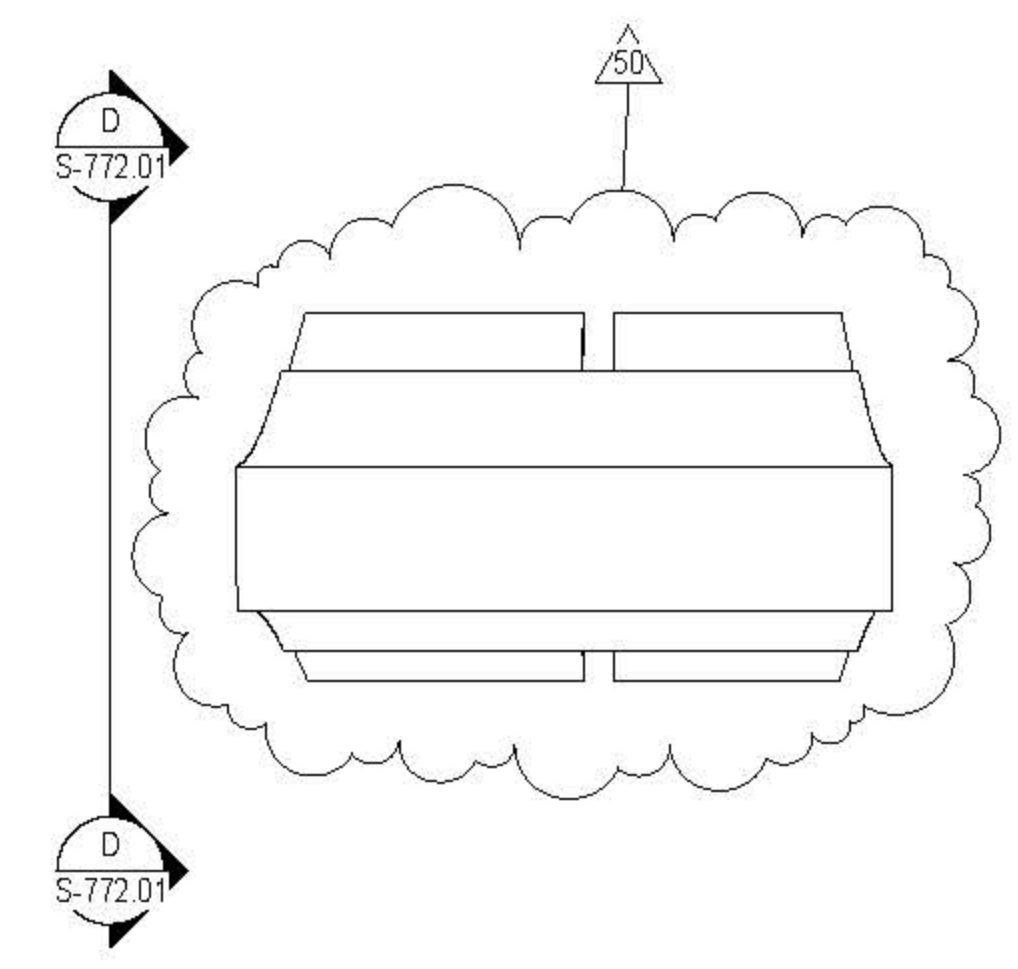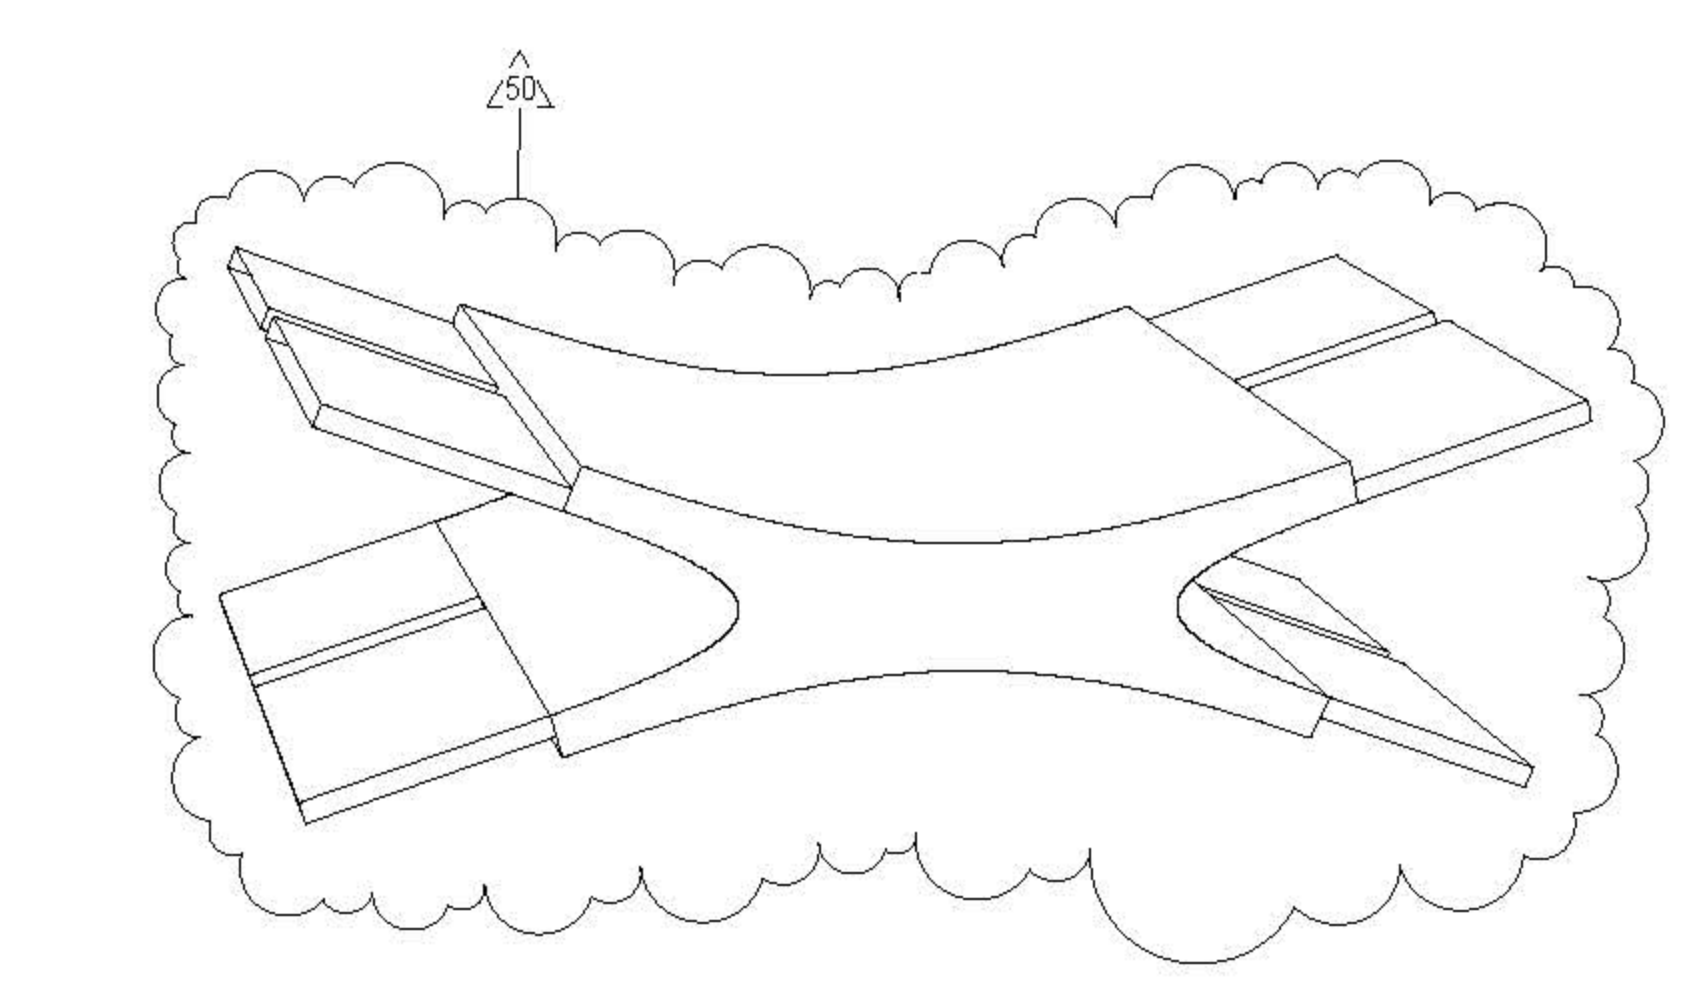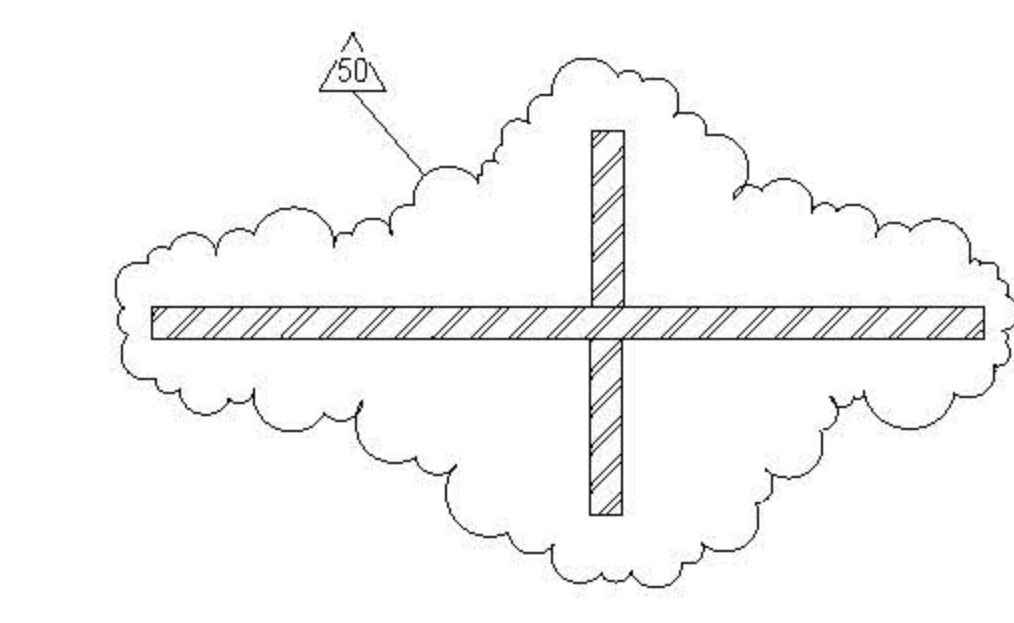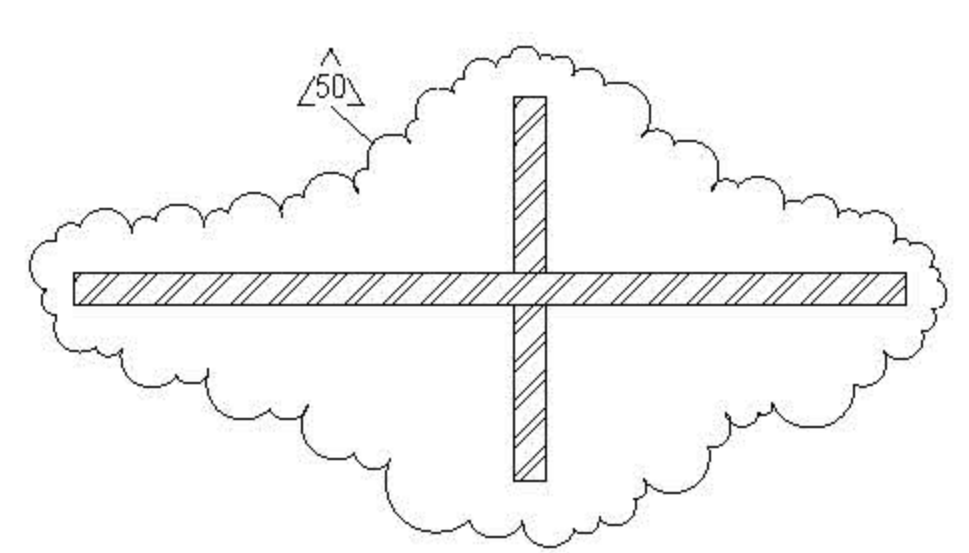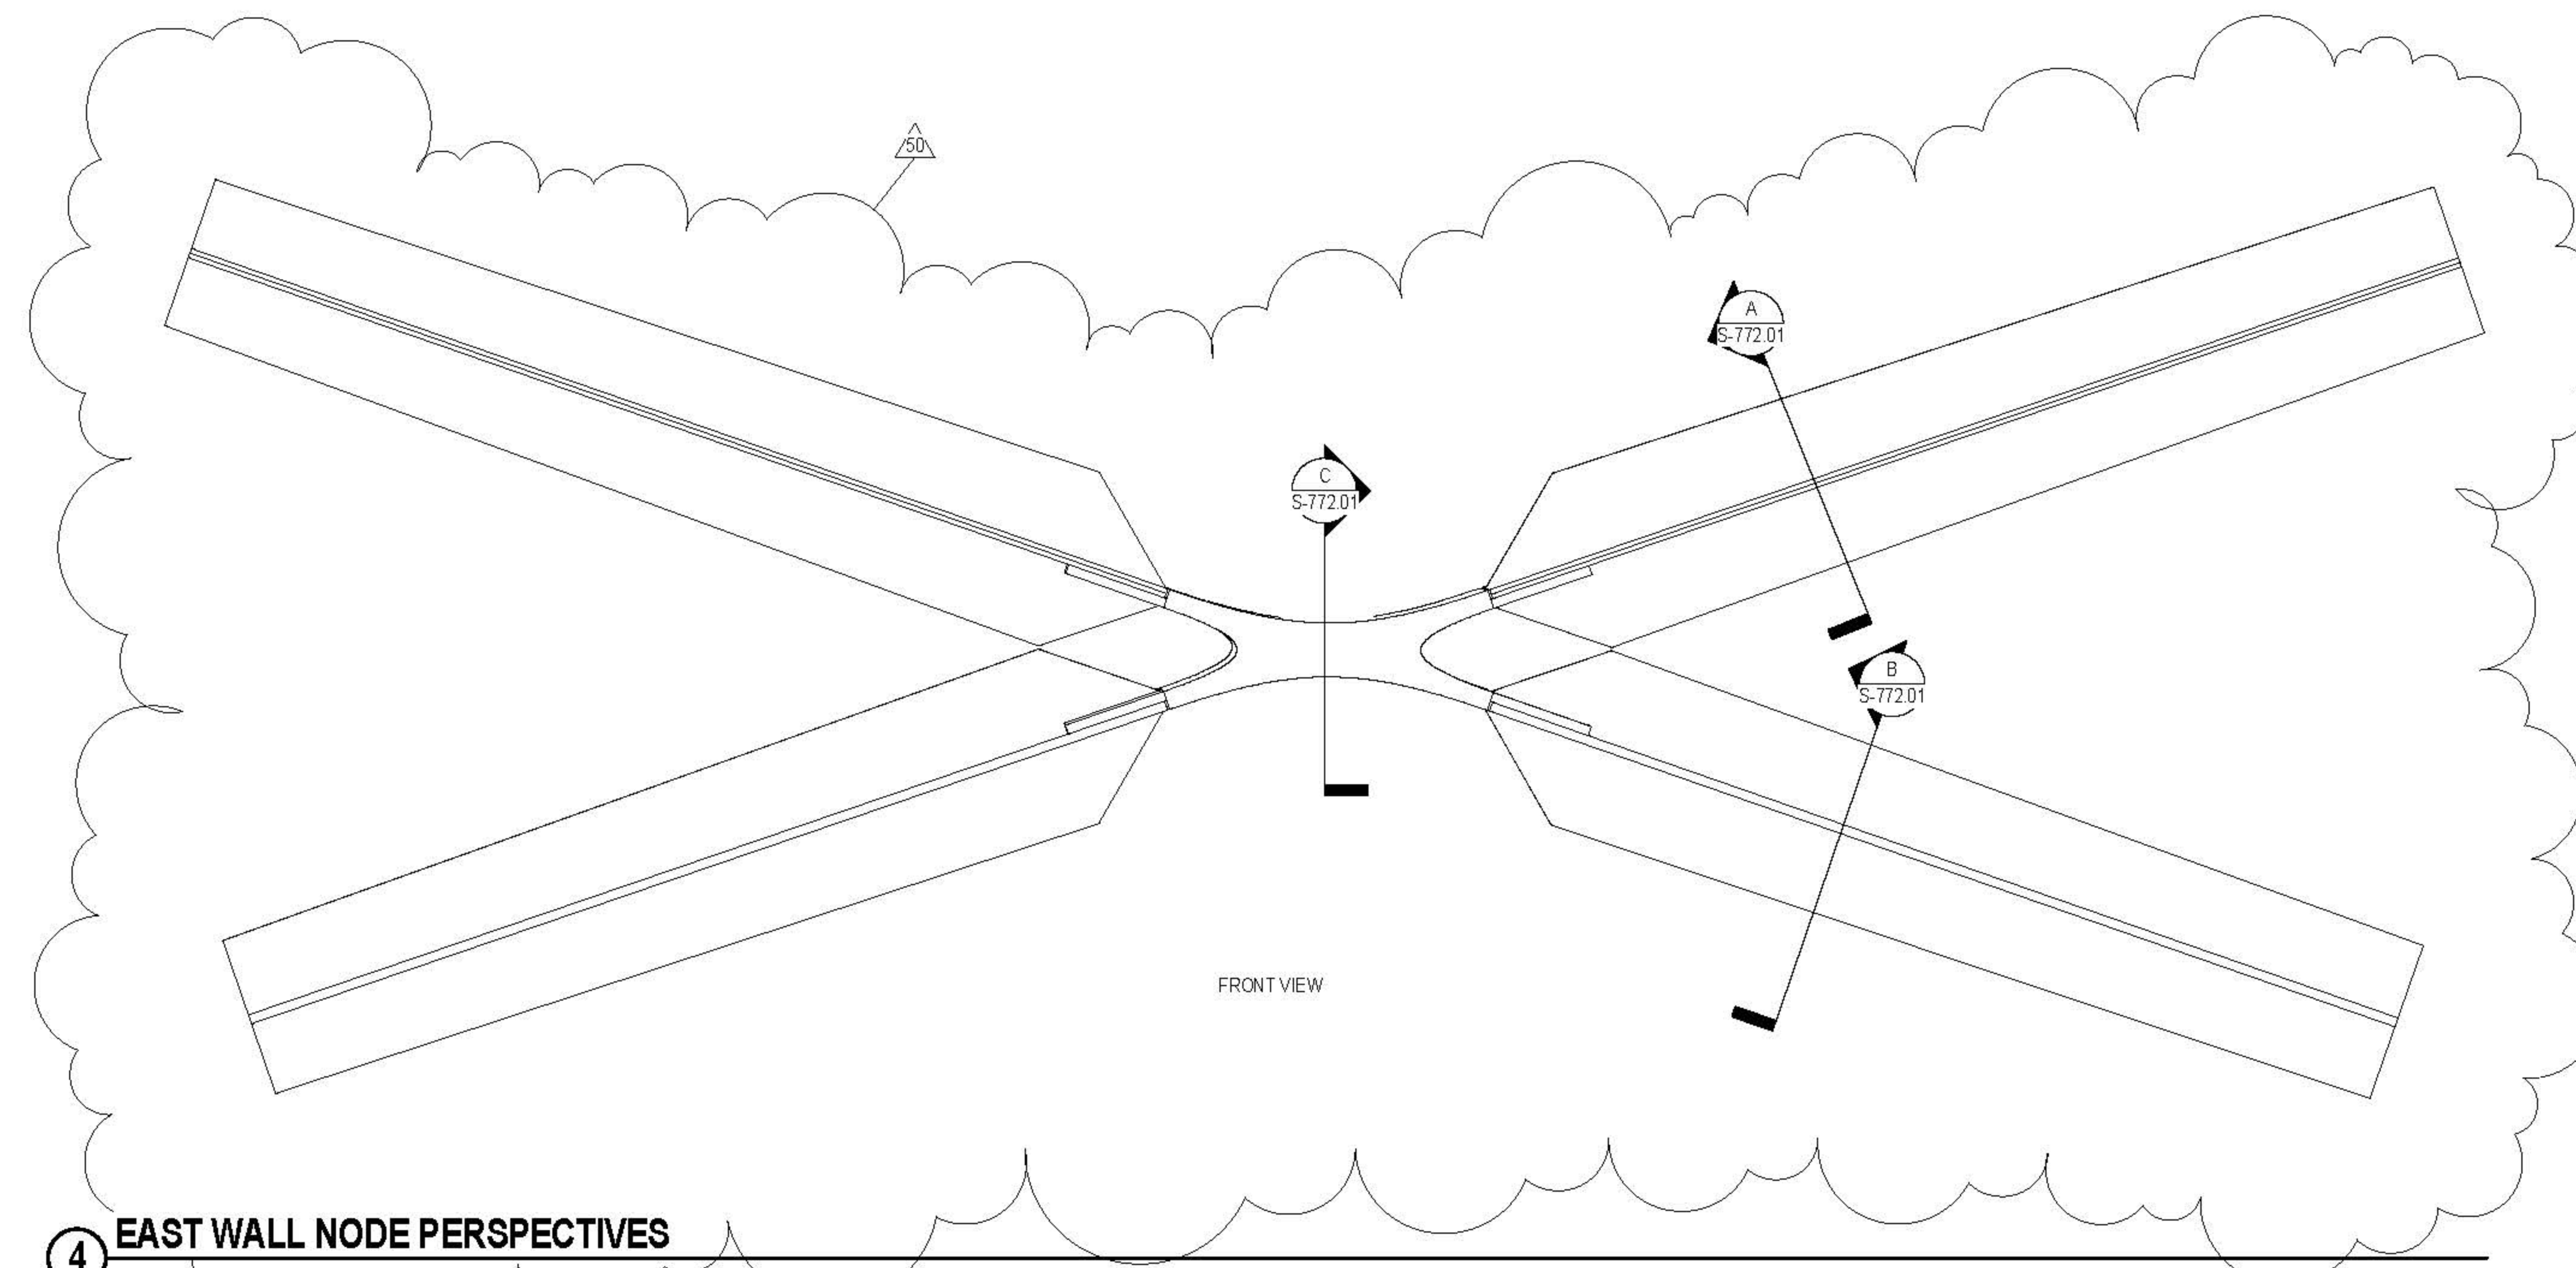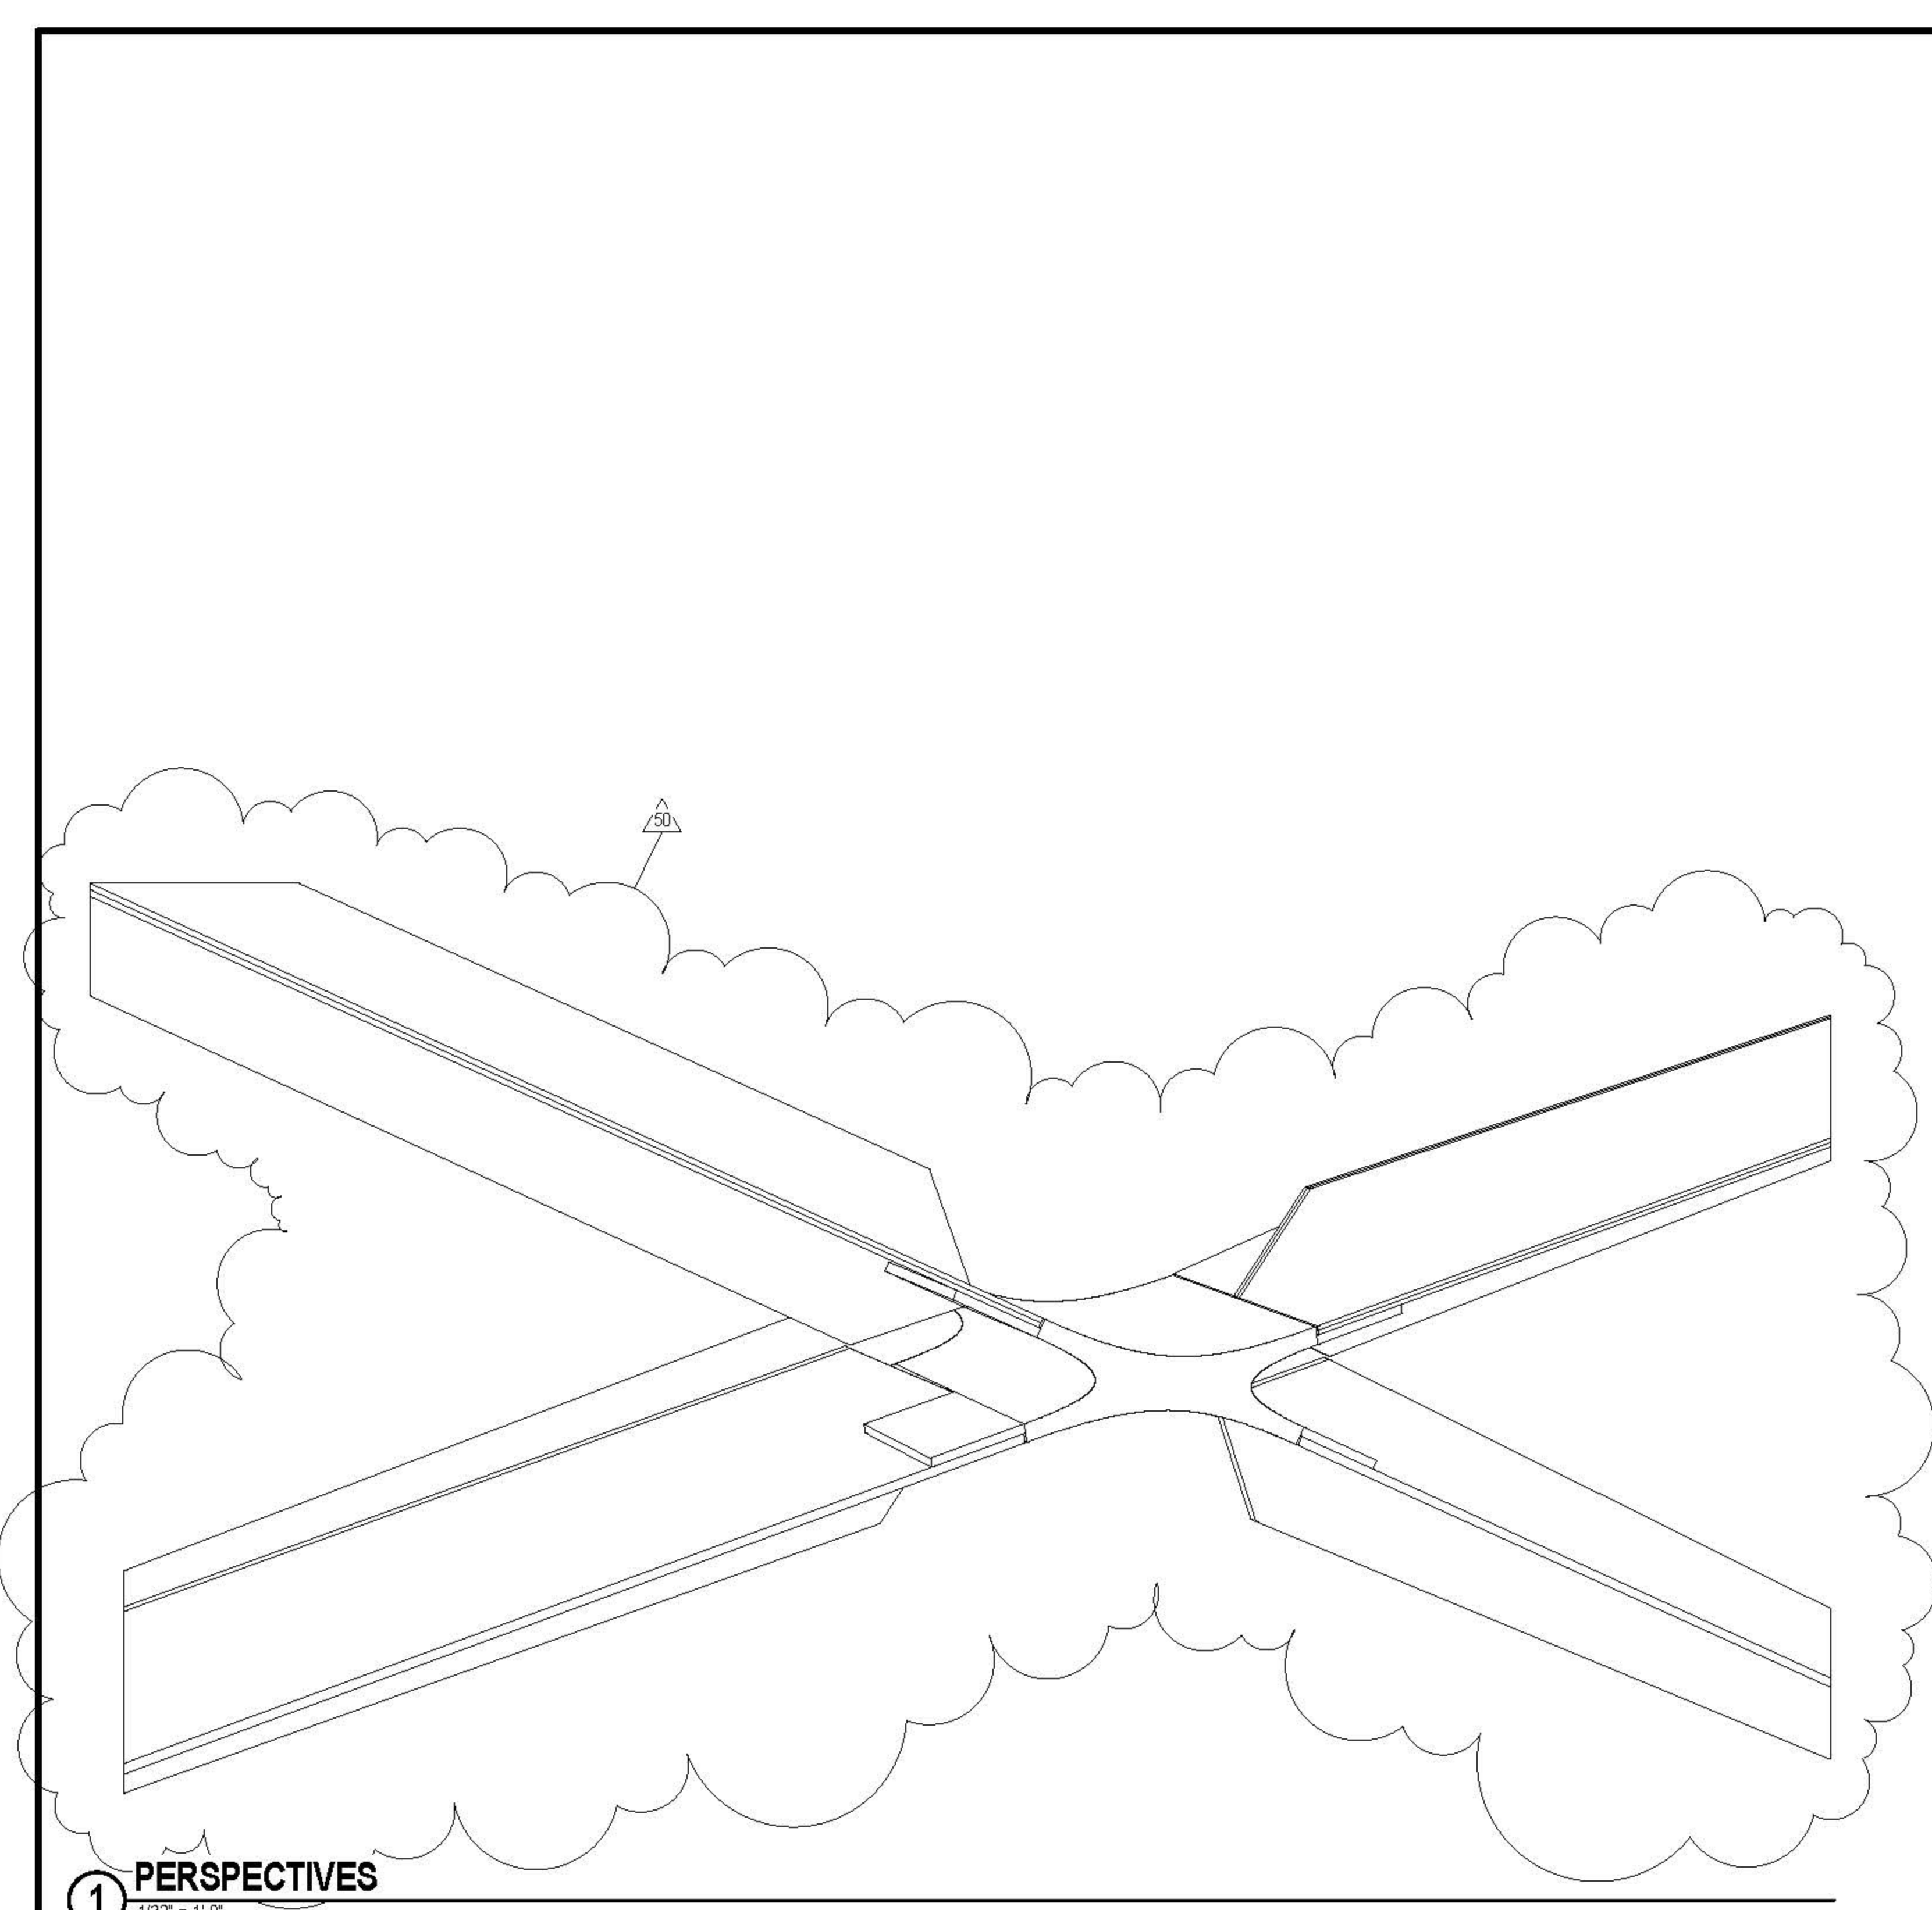

NOTE 1: INSPECT PLATE FOR PRE-EXISTING LAMINATIONS PER ASTM A578 (UT)
NOTE 2: USE LOW HYDROGEN ELECTRODE. WELD THICKER PLATES FIRST TO REDUCE RESTRAINT AND USE PEENING

Damian Titus
Building APPROVED
Under Directive 1 of 1995
NYC Development Hub

KEY PLAN

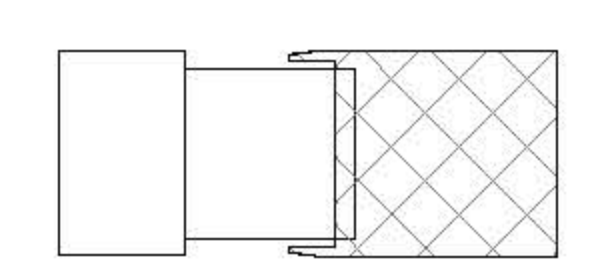

ISSUE	PRINTING	DATE	
63	60	DOB AMENDMENT 7	03.19.2016
44	30	DOB AMENDMENT 6	04.02.2016
21		CONSTRUCTION SET	10.08.2015
10	4	100% CONSTRUCTION DOCUMENTS	03.18.2015
9		90% CONSTRUCTION DOCUMENTS	02.16.2015
6		PRELIMINARY CDR SUBMISSION	12.10.2014
1		ADVANCED PROCUREMENT BID SET	06.16.2014

STAMP



DRAWN BY
Autum

CHECKED BY
Chris

PROJECT NUMBER
N1318.00

TITLE
DETAILS, DEPLOYED SHED EAST WALL

DRAWING NO.
S-772.01

B-SCAN NO.
S-772.01

GEOMETRY, DIMENSIONS AND SURFACE CONTOURING, BLENDING AND INTERSECTION OF SECTIONS ILLUSTRATED IN THE STRUCTURAL DRAWINGS ARE PROVIDED FOR REFERENCE AND GENERATION OF STRUCTURAL ARRANGEMENT AND DETAILS ONLY. THE 3D MODEL ISSUED BY THE ARCHITECT DEFINES THE EXTERIOR SURFACE AND SHALL BE ADHERED TO FOR THE FINAL GEOMETRY. FOR DETAILS OF SECONDARY STEEL, INCLUDING STRUCTURAL CLADDING REFER TO ARCHITECTURE DRAWINGS. IT IS THE RESPONSIBILITY OF THE CONTRACTOR TO IDENTIFY ANY DISCREPANCIES OR AMBIGUITIES FOR DISCUSSION, RESOLUTION AND DIRECTION FROM THE ARCHITECT AND SER.

CULTURE SHED
545 West 30th Street
New York, New York 10001
OWNER: CULTURE SHED INC.

ARCHITECTS
Oller Scalfaro + Renfro Architects, PC
601 West 26 Street #815
New York, New York 10001
T: 212.260.7971

rockwellgroup
5 Union St. West, 6th Fl.
New York, New York 10003
T: 212.463.0334
F: 212.463.0335

STRUCTURAL ENGINEER
Thornton Tomasetti
51 Madison Avenue
New York, New York 10010
T: 917.661.7800
F: 917.661.7801

MEP ENGINEER
Jans Baum & Bolles
50 Park Street
New York, New York 10005
T: 212.530.9300
F: 212.260.6944

FACADE CONSULTANT
Thornton Tomasetti
51 Madison Avenue
New York, New York 10010
T: 917.661.7800
F: 917.661.7801

KINETICS ENGINEER
Hadesky & Hanover
1501 Broadway
New York, New York 10036
T: 212.944.1150
F: 212.391.0297

LIGHTING DESIGNER
Tilston Design Associates
40 North Street #1650
New York, New York 10013
T: 212.675.7760

THEATRE PLANNING & DESIGN
Fisher Dodge Associates
22 West 15th Street
New York, New York 10011
T: 212.691.3000

LIFE SAFETY
Code Consultants, Inc.
215 West 43rd St, 15th Fl.
New York, New York 10018
T: 212.216.9596

ENERGY MODEL/LEED
Vindian
50 Washington Street
Norwalk, CT 06854
T: 203.298.1411

ACOUSTIC/AUDIO-VISUAL
Avenille
50 North Main Street
South Norwalk, CT 06854
T: 347.210.5540

VERTICAL TRANSPORTATION
Van Duusen & Associates
5 Regent Street, Suite 524
Lakewood, NJ 07038
T: 973.994.9220

SPECIFICATIONS
Construction Specifications Inc.
PO Box 489
227 Trenchard Road
Morganville, NJ 07751
T: 732.970.0700
F: 732.970.0750


SECURITY
Duchella Venter & Santoro
1100 Sherman Avenue
Hartford, CT 06114
T: 203.286.6490

WATERPROOFING
James R. Gahfort AIA Consulting Architects PC
104 West 27th Street
New York, NY 10001
T: 212.736.3344

FACADE MAINTENANCE
Erick Engineering PLLC
162 Ave. Street
New York, NY 10005
T: 212.698.3000

BRANDING GRAPHICS
2nd Global Design Consultancy
180 Varck Street 15th Floor
New York, NY 10014
T: 212.647.1170

KEY PLAN

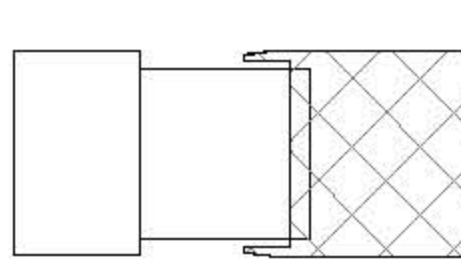

ISSUE PRINTING DATE

ISSUE	PRINTING	DATE
01	DOB AMENDMENT 7	03.19.2016
02	DOB AMENDMENT 6	04.09.2016
03	CONSTRUCTION SET	10.09.2015
04	100% CONSTRUCTION DOCUMENTS	03.18.2016
05	90% CONSTRUCTION DOCUMENTS	02.16.2016
06	PRELIMINARY DOB SUBMISSION	12.16.2014
07	ADVANCED PROCUREMENT BID SET	06.16.2014

STAMP



DRAWN BY
Autumn

CHECKED BY
Chris M

PROJECT NUMBER
N11318.00


TITLE
DETAILS, DEPLOYED SHED EAST PORTAL TYPICAL SECTIONS

DRAWING NO.
S-773.01


B.SCAN NO.
S-773.01

B.SCAN NO.
S-773.01


106 of 123

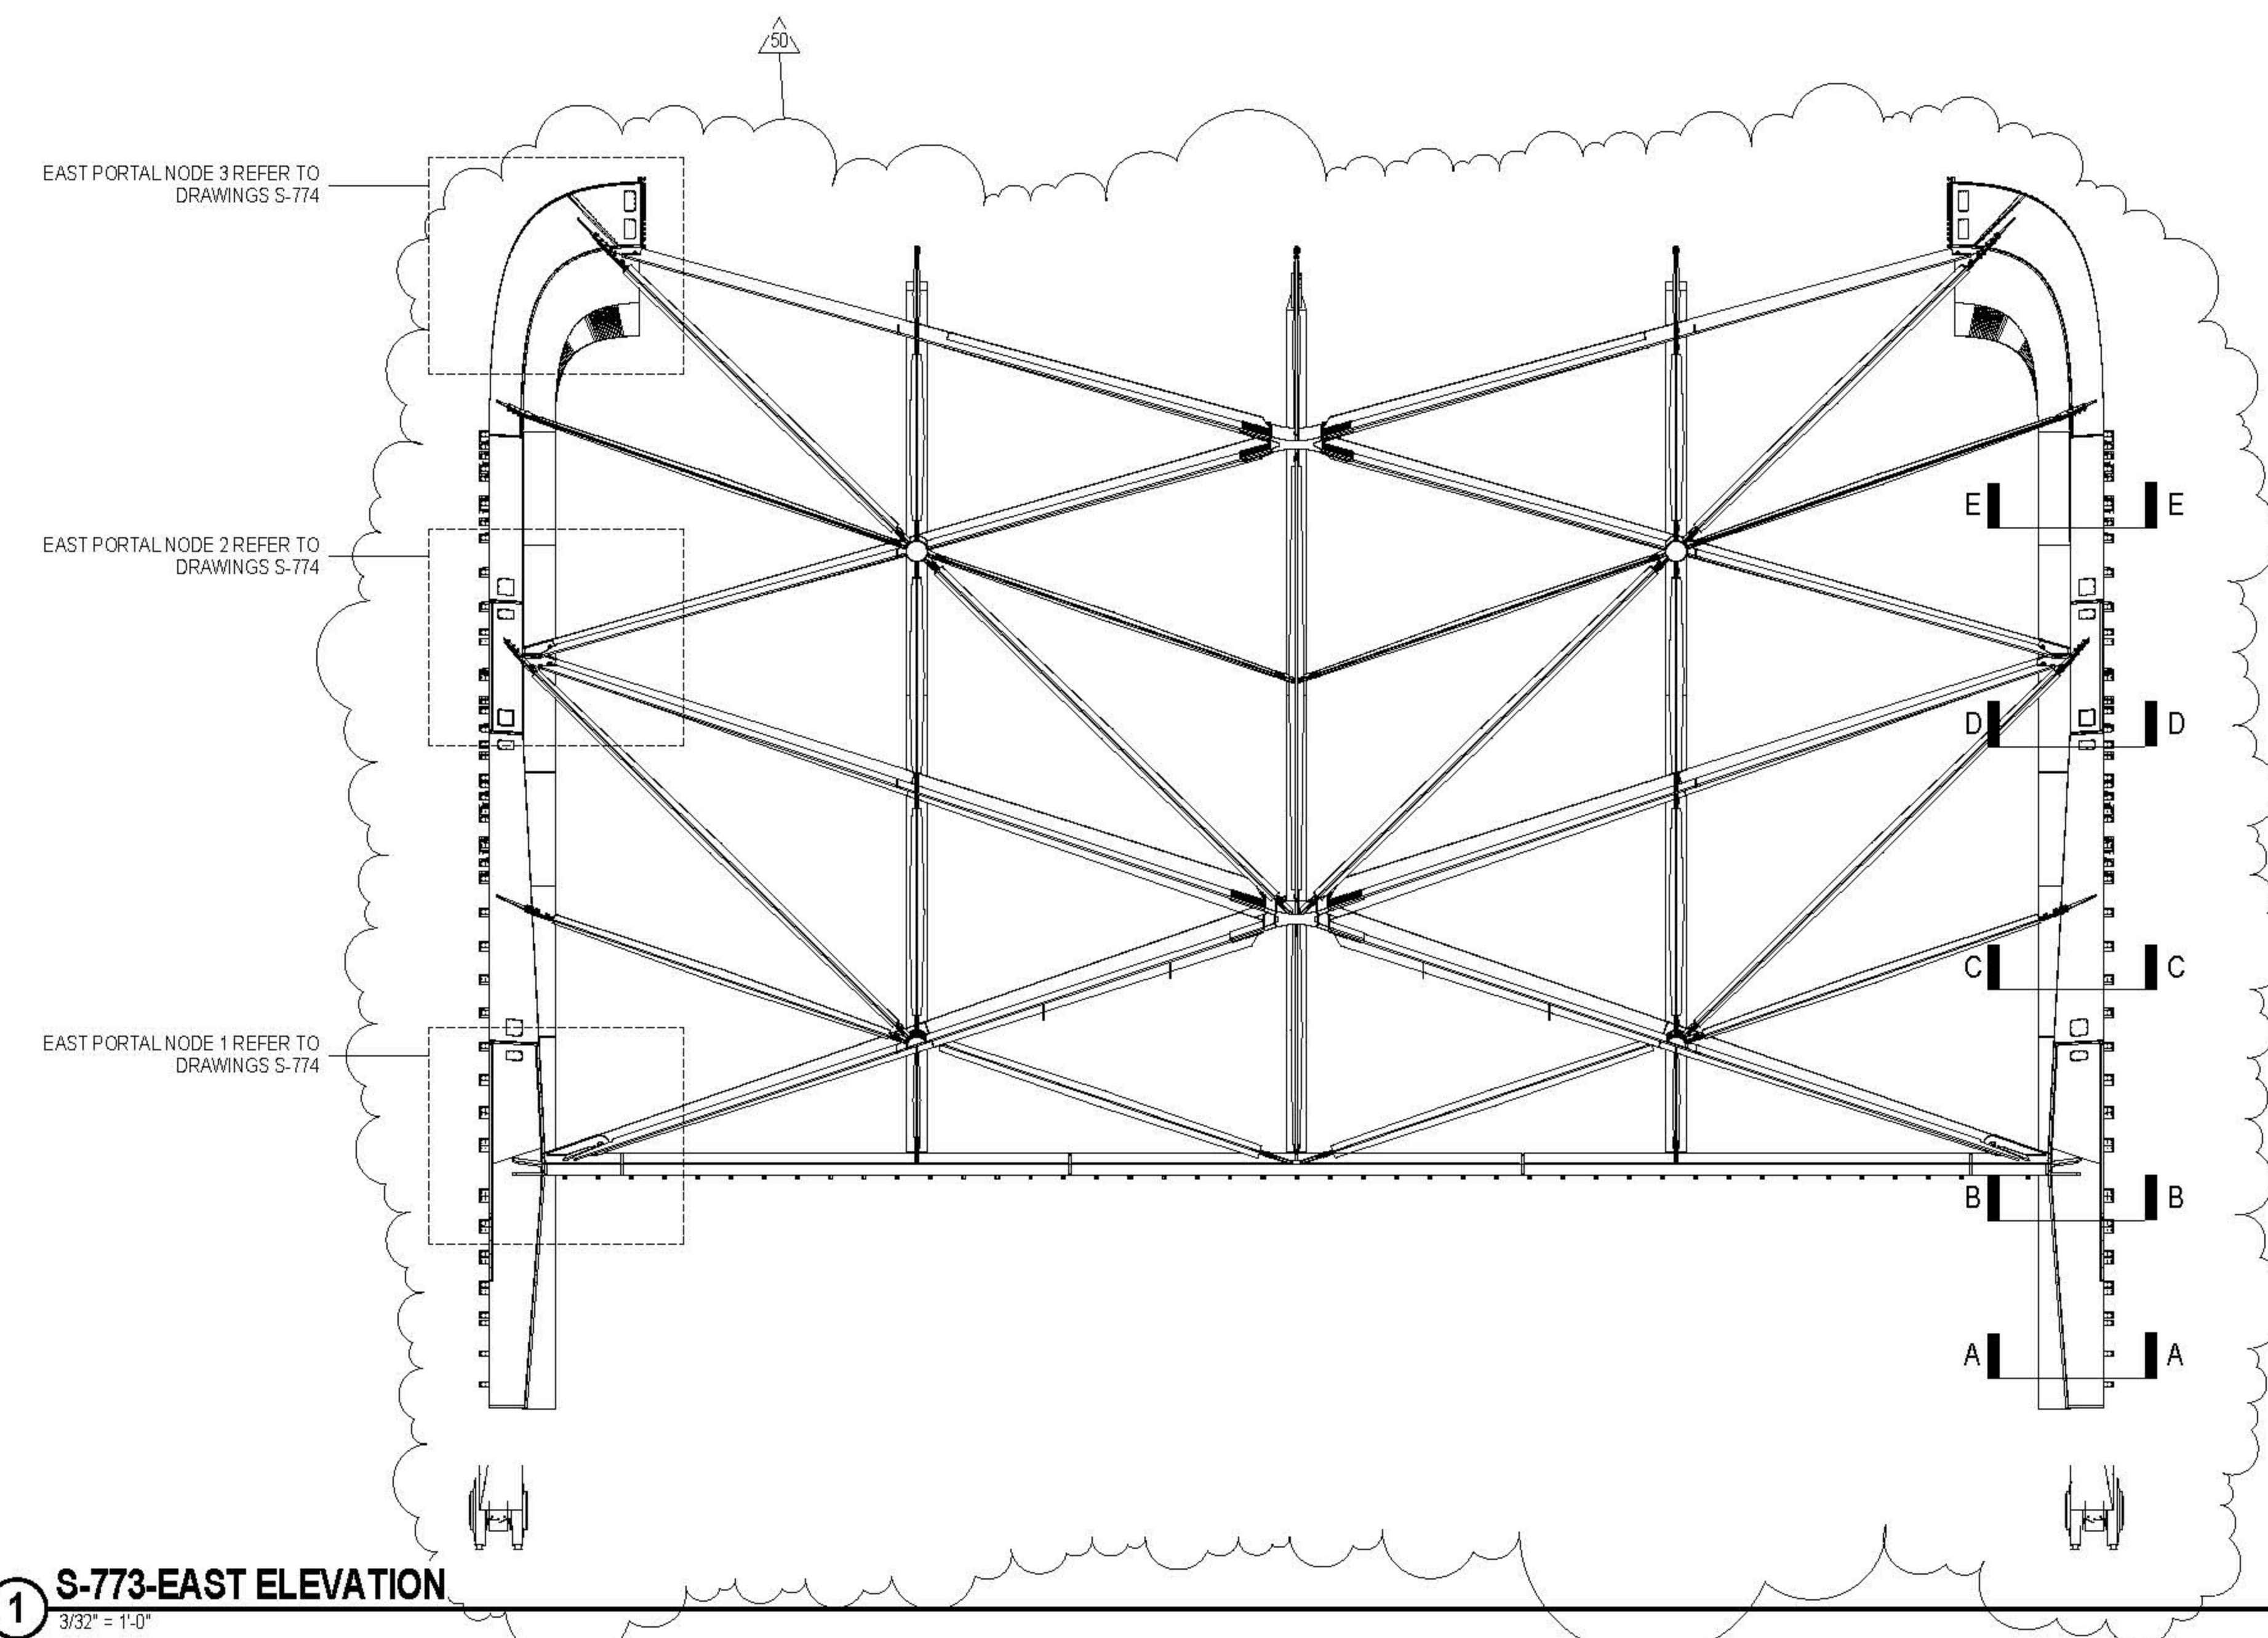


1 S-773-EAST ELEVATION
3/32" = 1'-0"

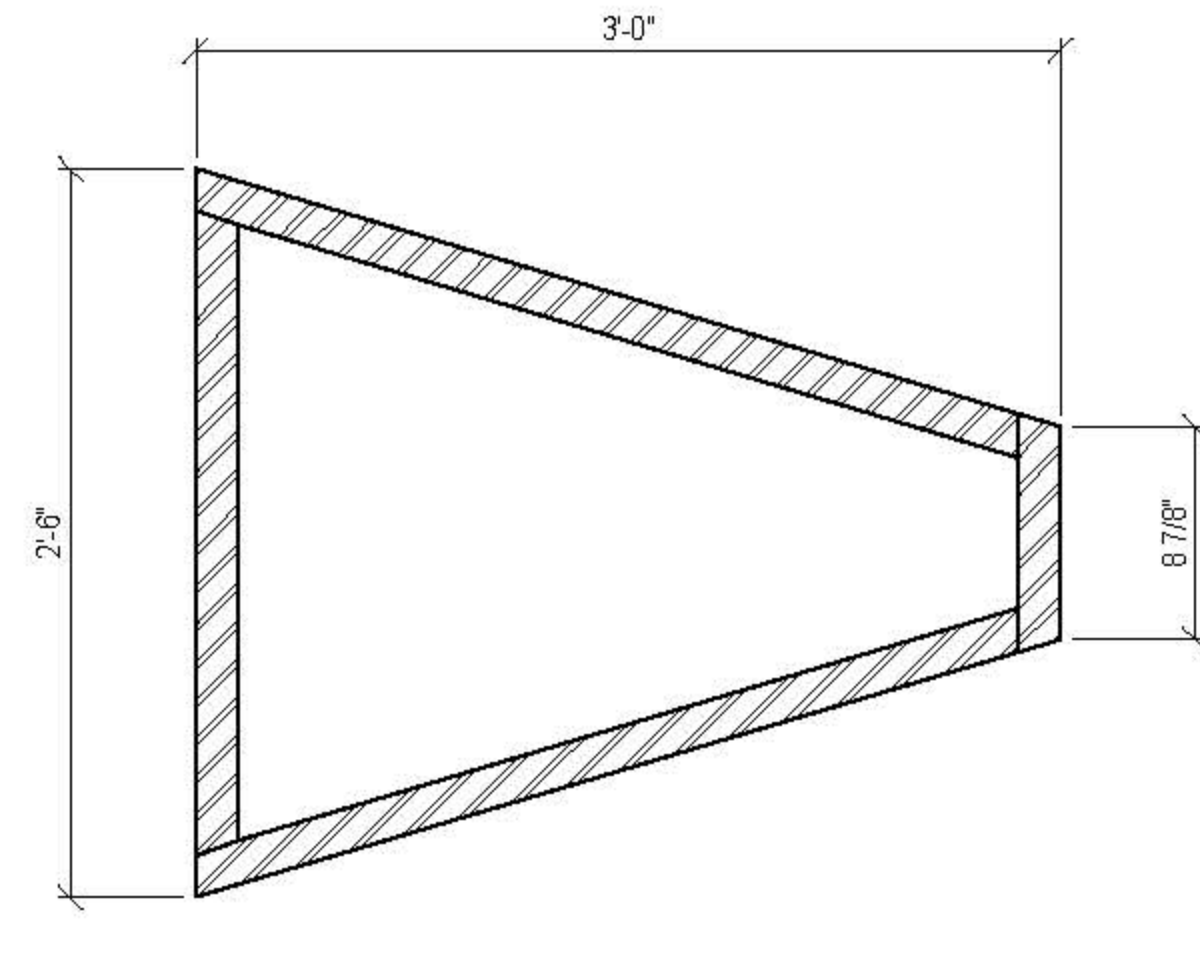


3 SECTION DD
1 1/2" = 1'-0"

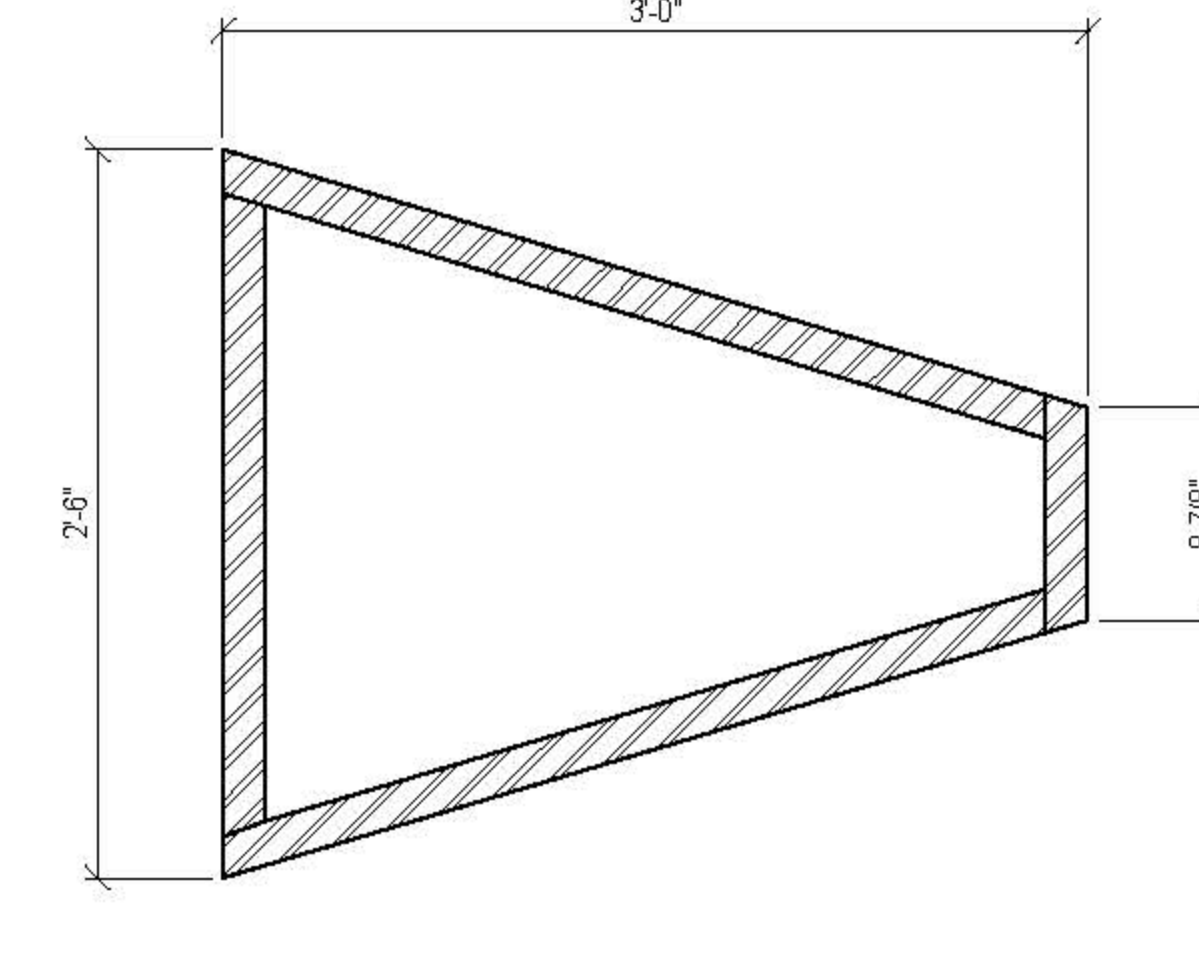


4 SECTION EE
1 1/2" = 1'-0"

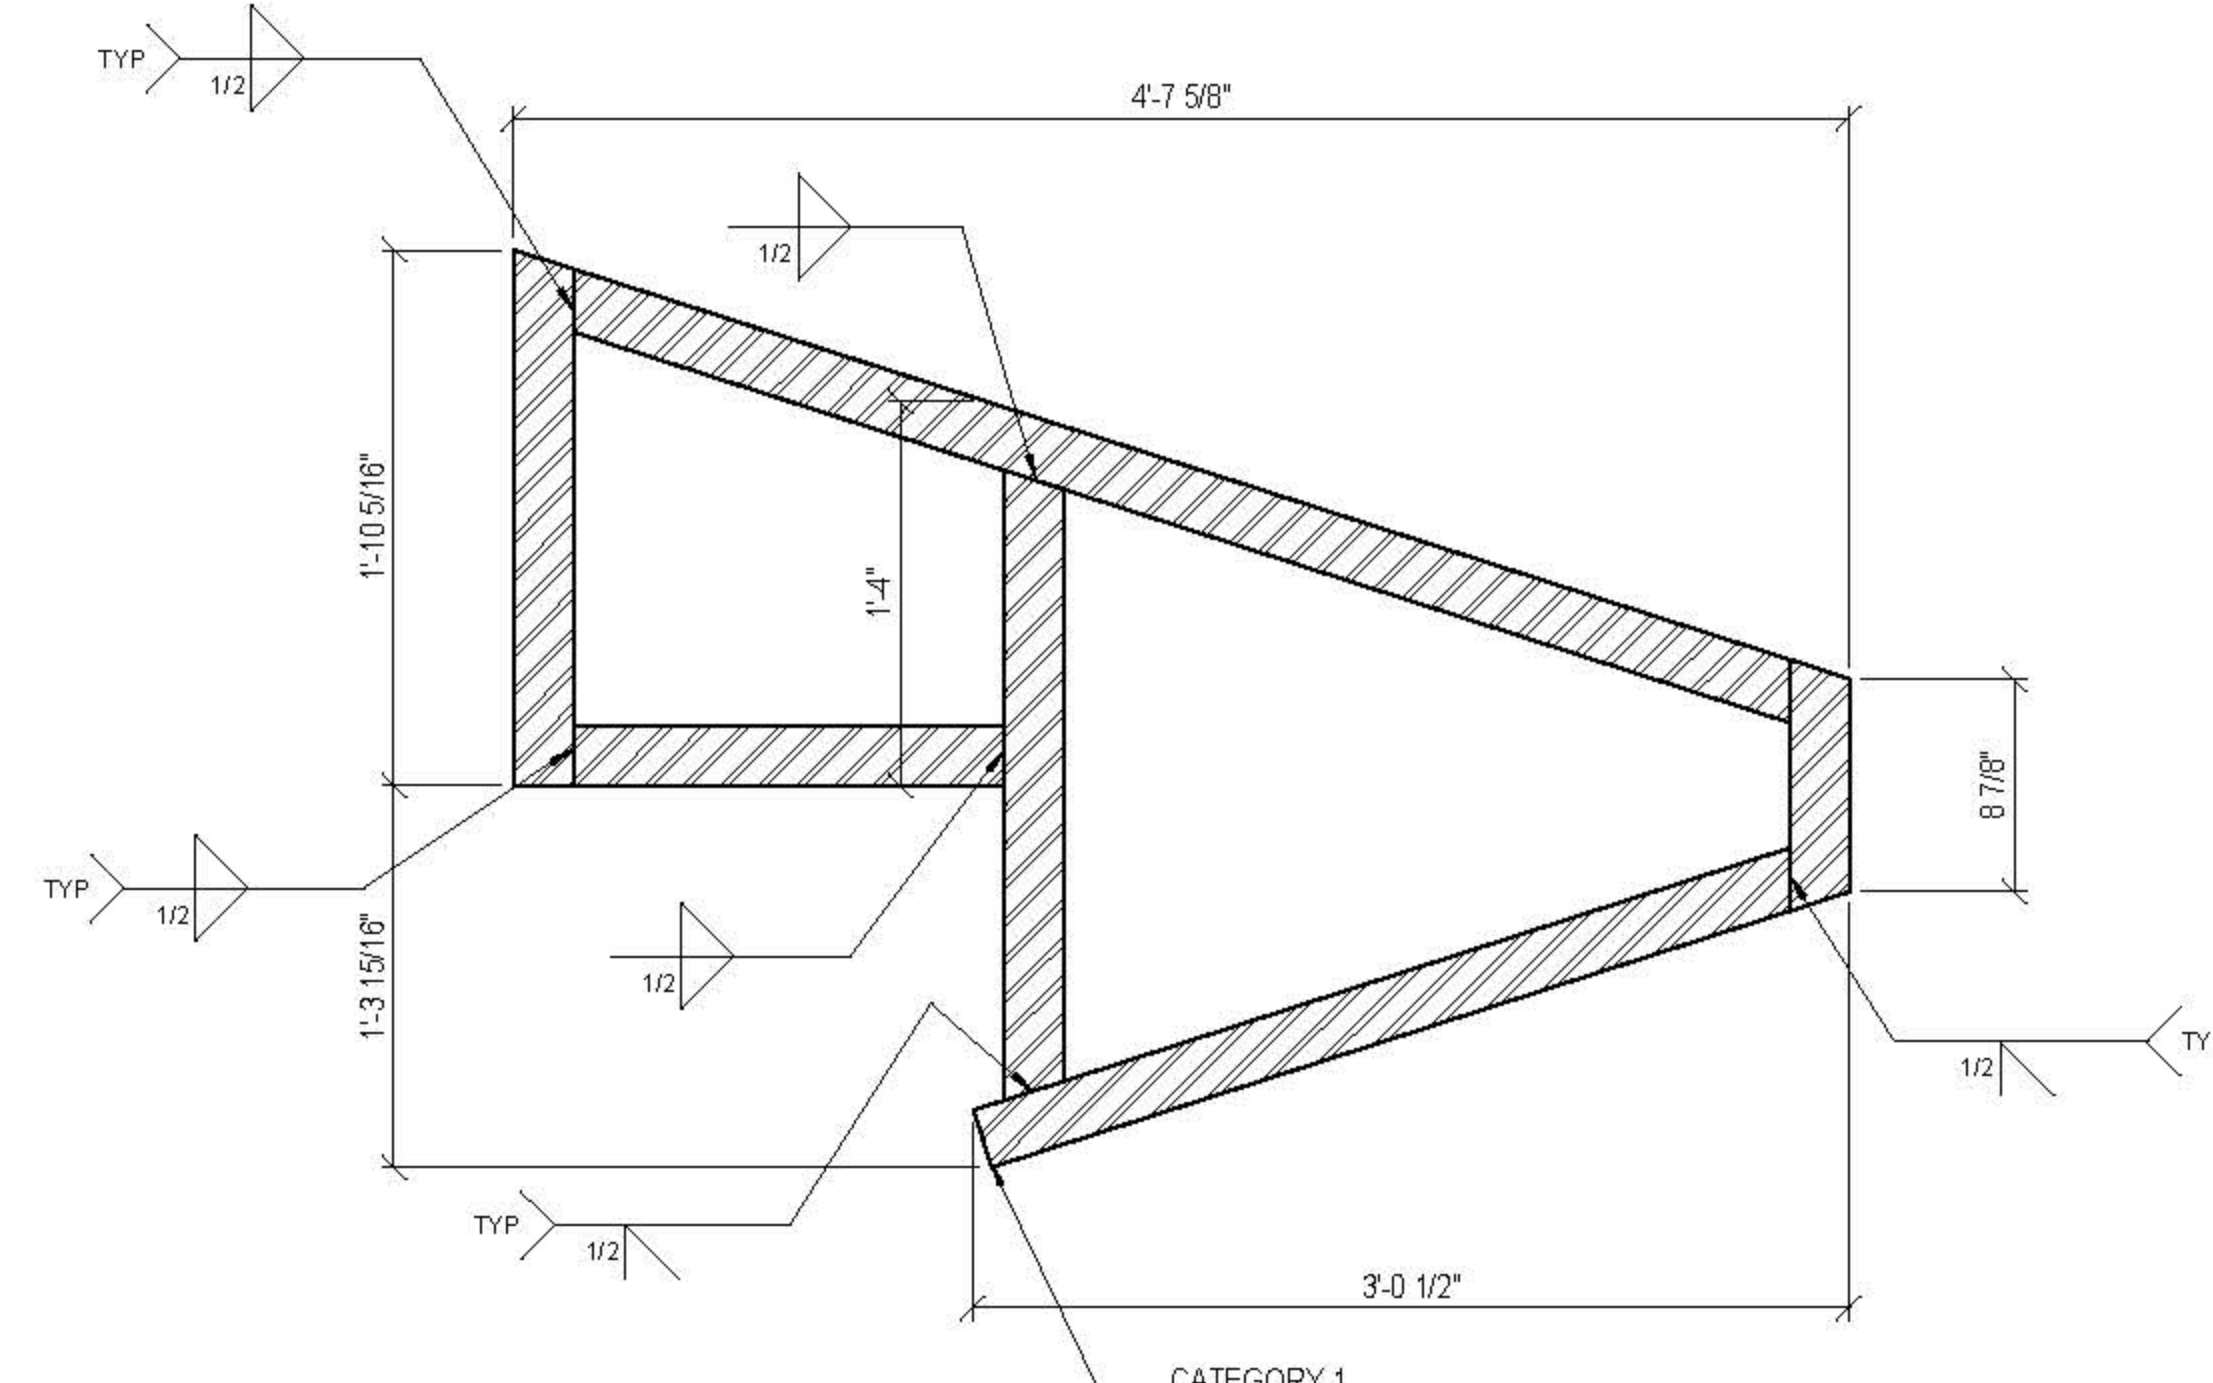

6 SECTION A-A
1 1/2" = 1'-0"

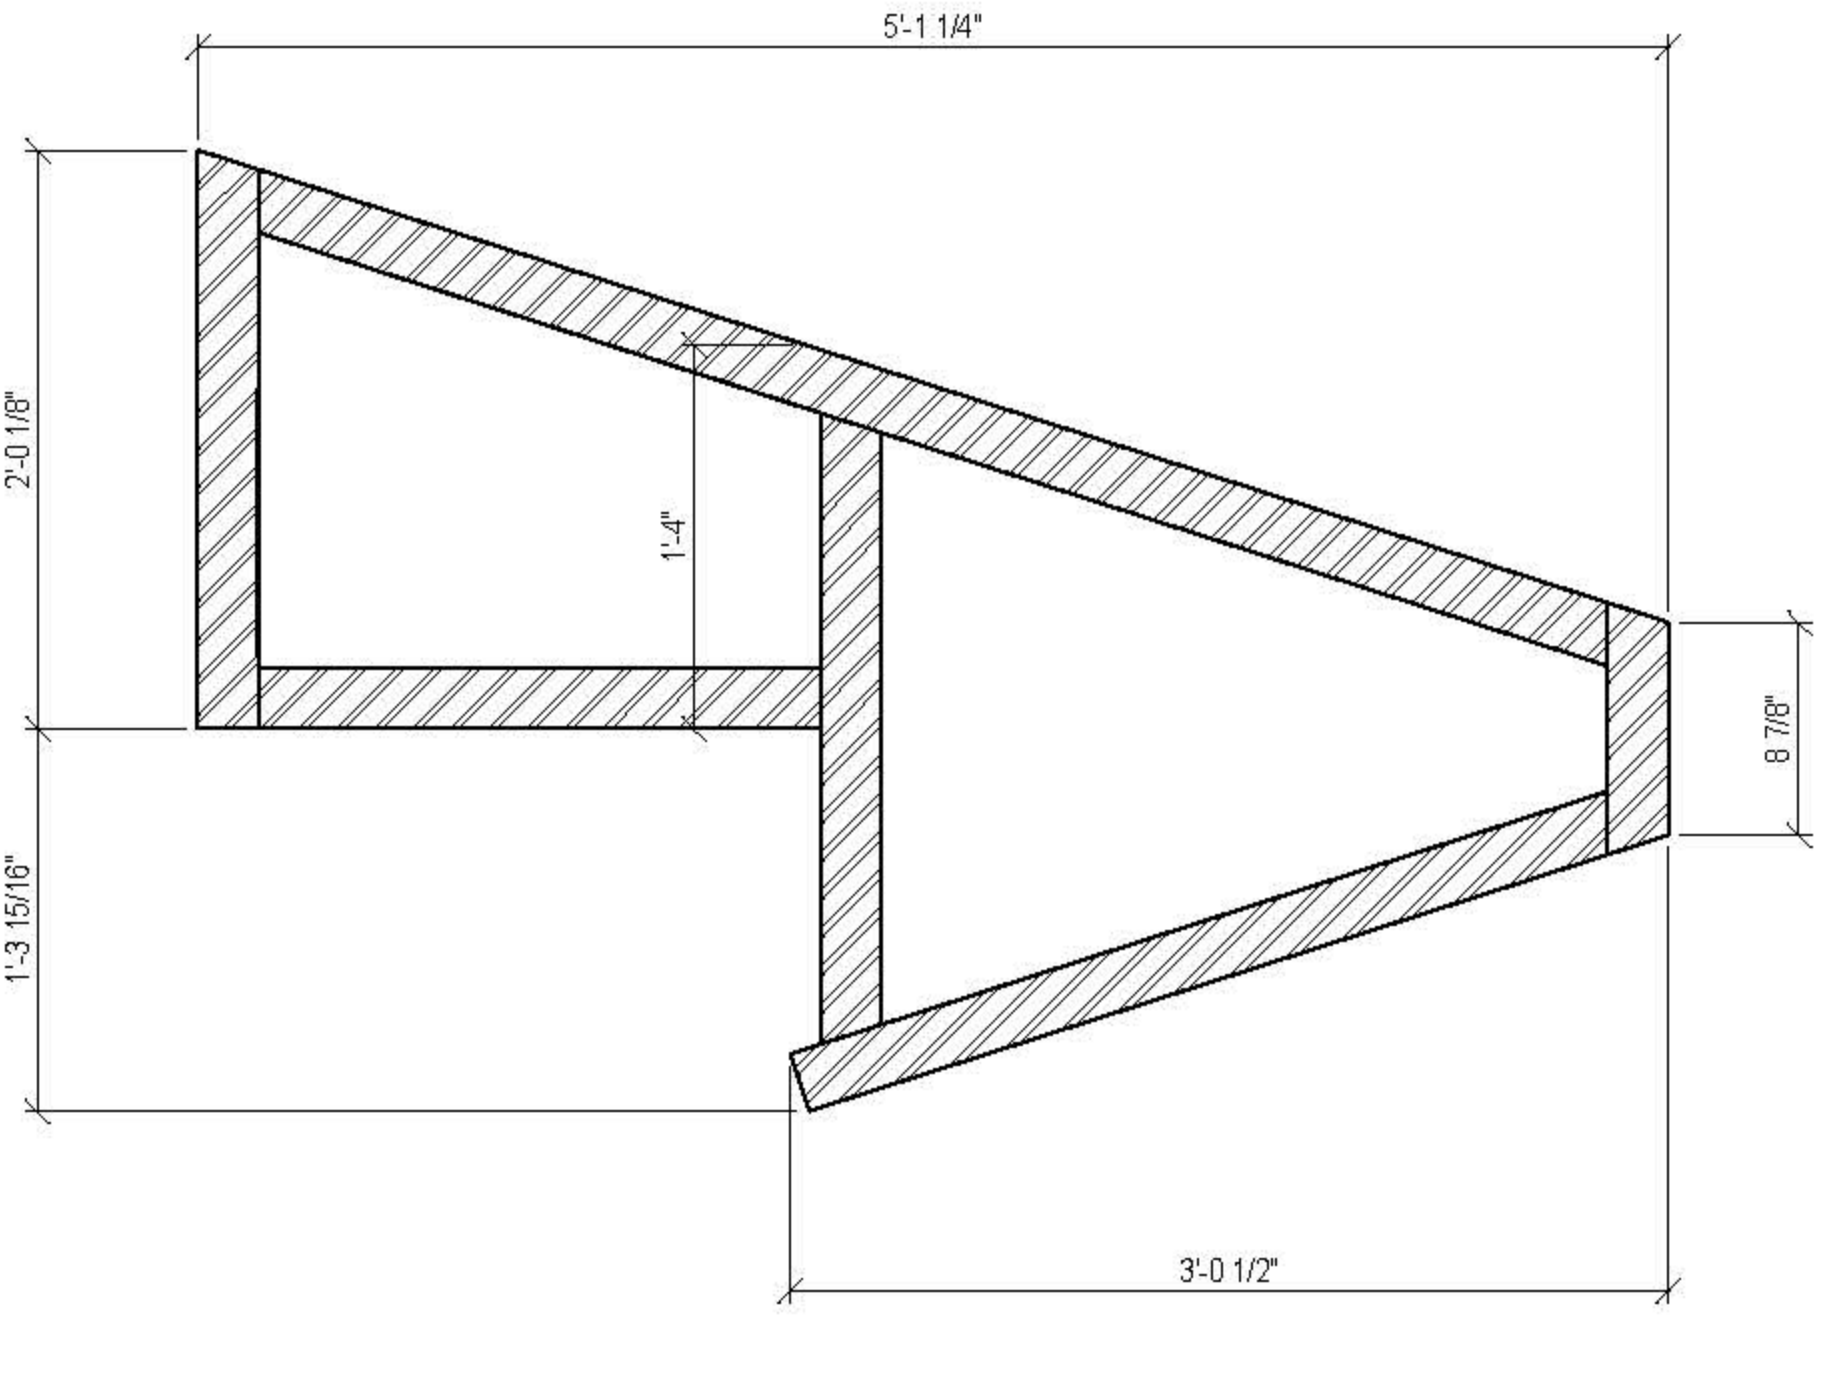

7 SECTION B-B
1 1/2" = 1'-0"

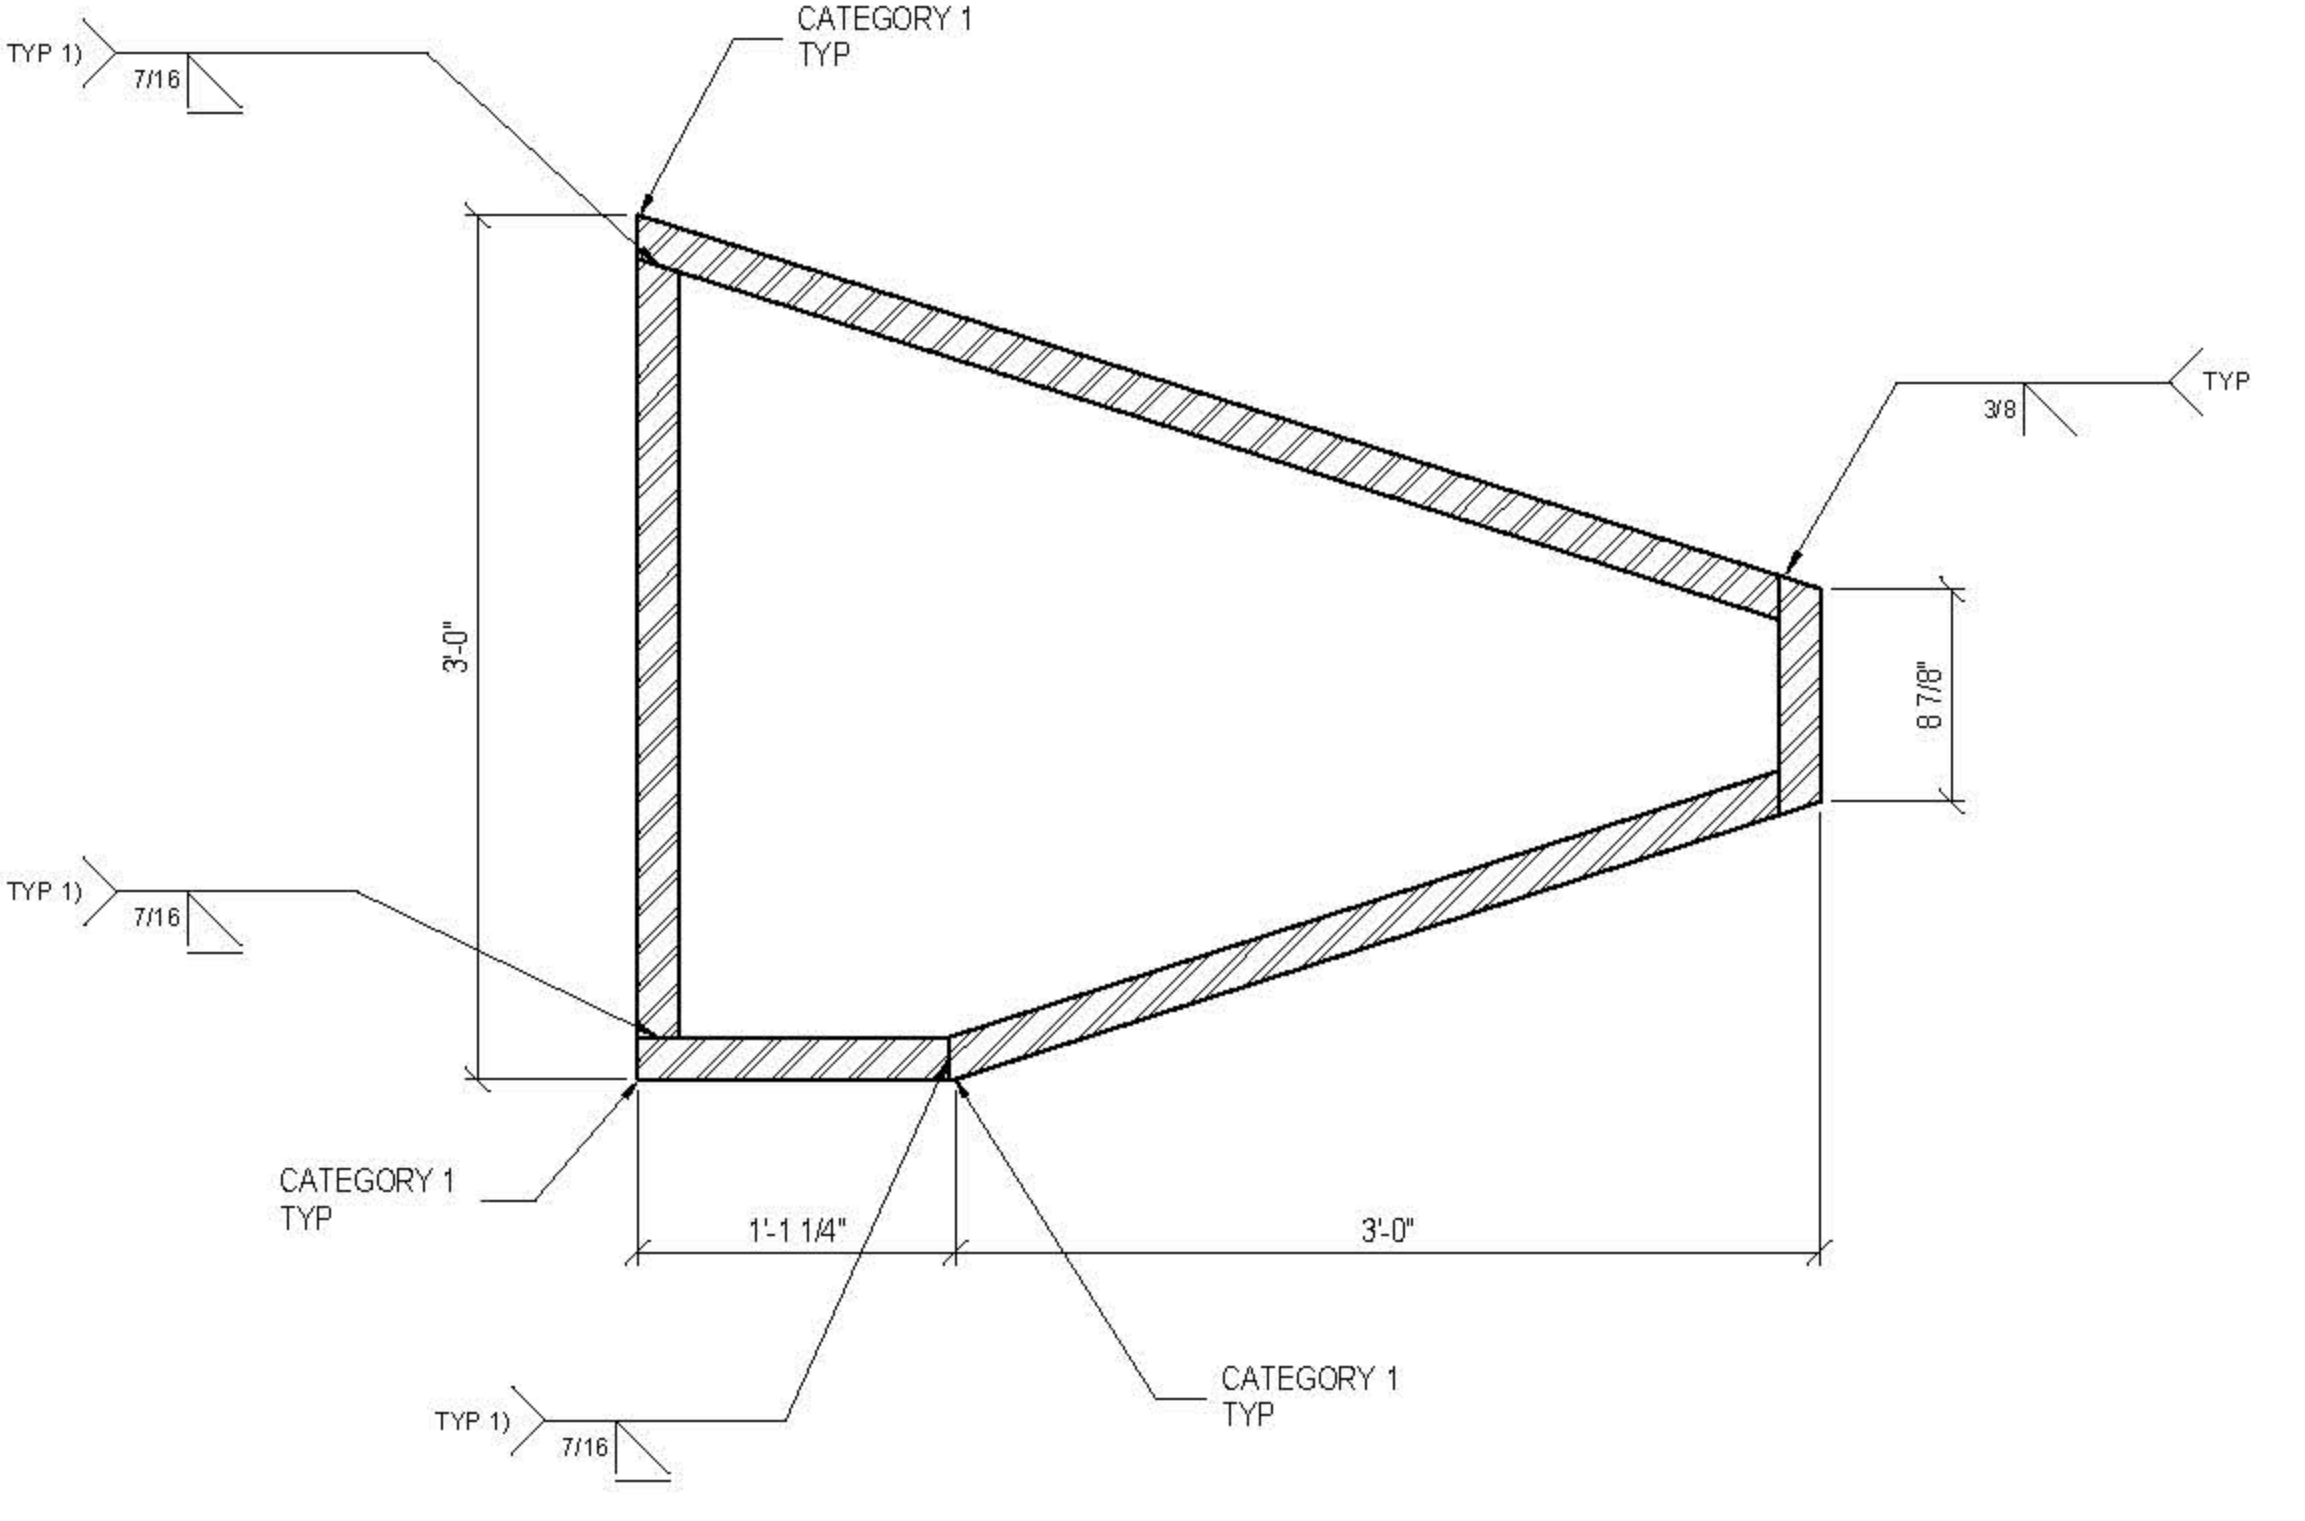

2 SECTION C-C
1 1/2" = 1'-0"

ALL PORTAL WALL SECTIONS SIMILAR U.O.N.

CATEGORY 1 CORNERS: ALL CORNERS MARKED CATEGORY 1 TO HAVE A SHARP CONTINUOUS EDGE WITH STRAIGHTNESS TO WITHIN +/- .1/16"
ALL CORNERS MAY HAVE A 0.08" RADIUS

1) EXPOSED EDGE WITH CONTINUOUS AND CONSISTENT FINISH REQUIRED, EVEN ACROSS SPICES FOR NODE WELD DETAILS SEE DRAWING S-755

REFER TO S-751 FOR PLATE THICKNESSES



PENDING COORDINATION DURING DESIGN ASSIST.

GEOMETRY, DIMENSIONS AND SURFACE CONTOURING, BLENDING AND INTERSECTION OF SECTIONS ILLUSTRATED IN THE STRUCTURAL DRAWINGS ARE PROVIDED FOR REFERENCE AND GENERATION OF STRUCTURAL ARRANGEMENT AND DETAILS ONLY. THE 3D MODEL ISSUED BY THE ARCHITECT DEFINES THE EXTERIOR SURFACE AND SHALL BE ADHERED TO FOR THE FINAL GEOMETRY. FOR DETAILS OF SECONDARY STEEL, INCLUDING STRUCTURAL CLADDING REFER TO ARCHITECTURE DRAWINGS. IT IS THE RESPONSIBILITY OF THE CONTRACTOR TO IDENTIFY ANY DISCREPANCIES OR AMBIGUITIES FOR DISCUSSION, RESOLUTION AND DIRECTION FROM THE ARCHITECT AND SER.

ARCHITECTS
Oller Scaffolds + Renfro Architects, DPC
601 West 30th Street #815
New York, New York 10001
T: 212.263.7971

STRUCTURAL ENGINEER
Thornton Tomasetti
51 Madison Avenue
New York, New York 10010
T: 917.991.7800
F: 917.991.7801

MEP ENGINEER
Janss Baum & Bolles
40 Park Street
New York, New York 10005
T: 212.530.9300
F: 212.263.6564

FACADE CONSULTANT
Thornton Tomasetti
51 Madison Avenue
New York, New York 10010
T: 917.991.7800
F: 917.991.7801

KINETICS ENGINEER
Hardisty & Hanover
1501 Broadway
New York, New York 10036
T: 212.944.1150
F: 212.399.0339

LIGHTING DESIGNER
Thibouton Design Associates
40 North Street #1650
New York, New York 10013
T: 212.675.7760

THEATRE PLANNING & DESIGN
Fisher Dodge Associates
22 West 15th Street
New York, New York 10011
T: 212.691.3000

LIFE SAFETY
Code Consultants, Inc.
215 West 40th St, 15th Flr
New York, New York 10018
T: 212.216.9596

ENERGY MODEL/LEED
Vindian
60 Washington Street
Norwalk, CT 06854
T: 203.298.1411

ACOUSTIC/AUDIO-VISUAL
Avenille
93 North Main Street
South Norwalk, CT 06854
T: 347.210.5540

VERTICAL TRANSPORTATION
Van Dusen & Associates
5 Regent Street, Suite 524
Larkington, NJ 07038
T: 973.994.9220

SPECIFICATIONS
Construction Specifications Inc.
PO Box 489
227 Tenth Road
Morganville, NJ 07751
T: 732.970.0700
F: 732.970.0700


SECURITY
Duchella Venter & Santoro
1020 Sherman Avenue
Hartford, CT 06114
T: 203.286.6490

WATERPROOFING
James R. Gahfort AIA Consulting Architects PC
104 West 77th Street
New York, NY 10001
T: 212.736.3344

FACADE MAINTENANCE
Frank Engineering PLLC
156 Ave. Street
New York, NY 10005
T: 212.698.3000

BRANDING GRAPHICS
2nd Global Design Consultancy
180 York Street 15th Floor
New York, NY 10014
T: 212.647.1170

KEY PLAN

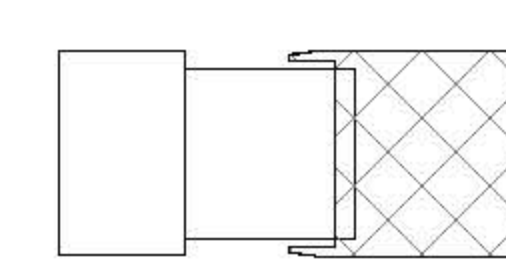

ISSUE

NO.	DESCRIPTION	DATE
63	60 DOB AMENDMENT 7	03.19.2016
44	30 DOB AMENDMENT 6	04.02.2016
21	CONSTRUCTION SET	10.09.2015
10	4 100% CONSTRUCTION DOCUMENTS	03.18.2015
9	90% CONSTRUCTION DOCUMENTS	02.16.2015
6	PRELIMINARY CDR SUBMISSION	12.16.2014
1	ADVANCED PROCUREMENT BID SET	06.16.2014

STAMP



DRAWN BY
Autum

CHEKED BY
Chris

PROJECT NUMBER
N1318.00

TITLE
DETAILS, DEPLOYED SHED - MECHANICAL DECK



DRAWING NO.
S-785.01

B.SCAN NO.
S-785.01


B.SCAN NO.
S-785.01

108 of 123


PENDING COORDINATION DURING DESIGN ASSIST.

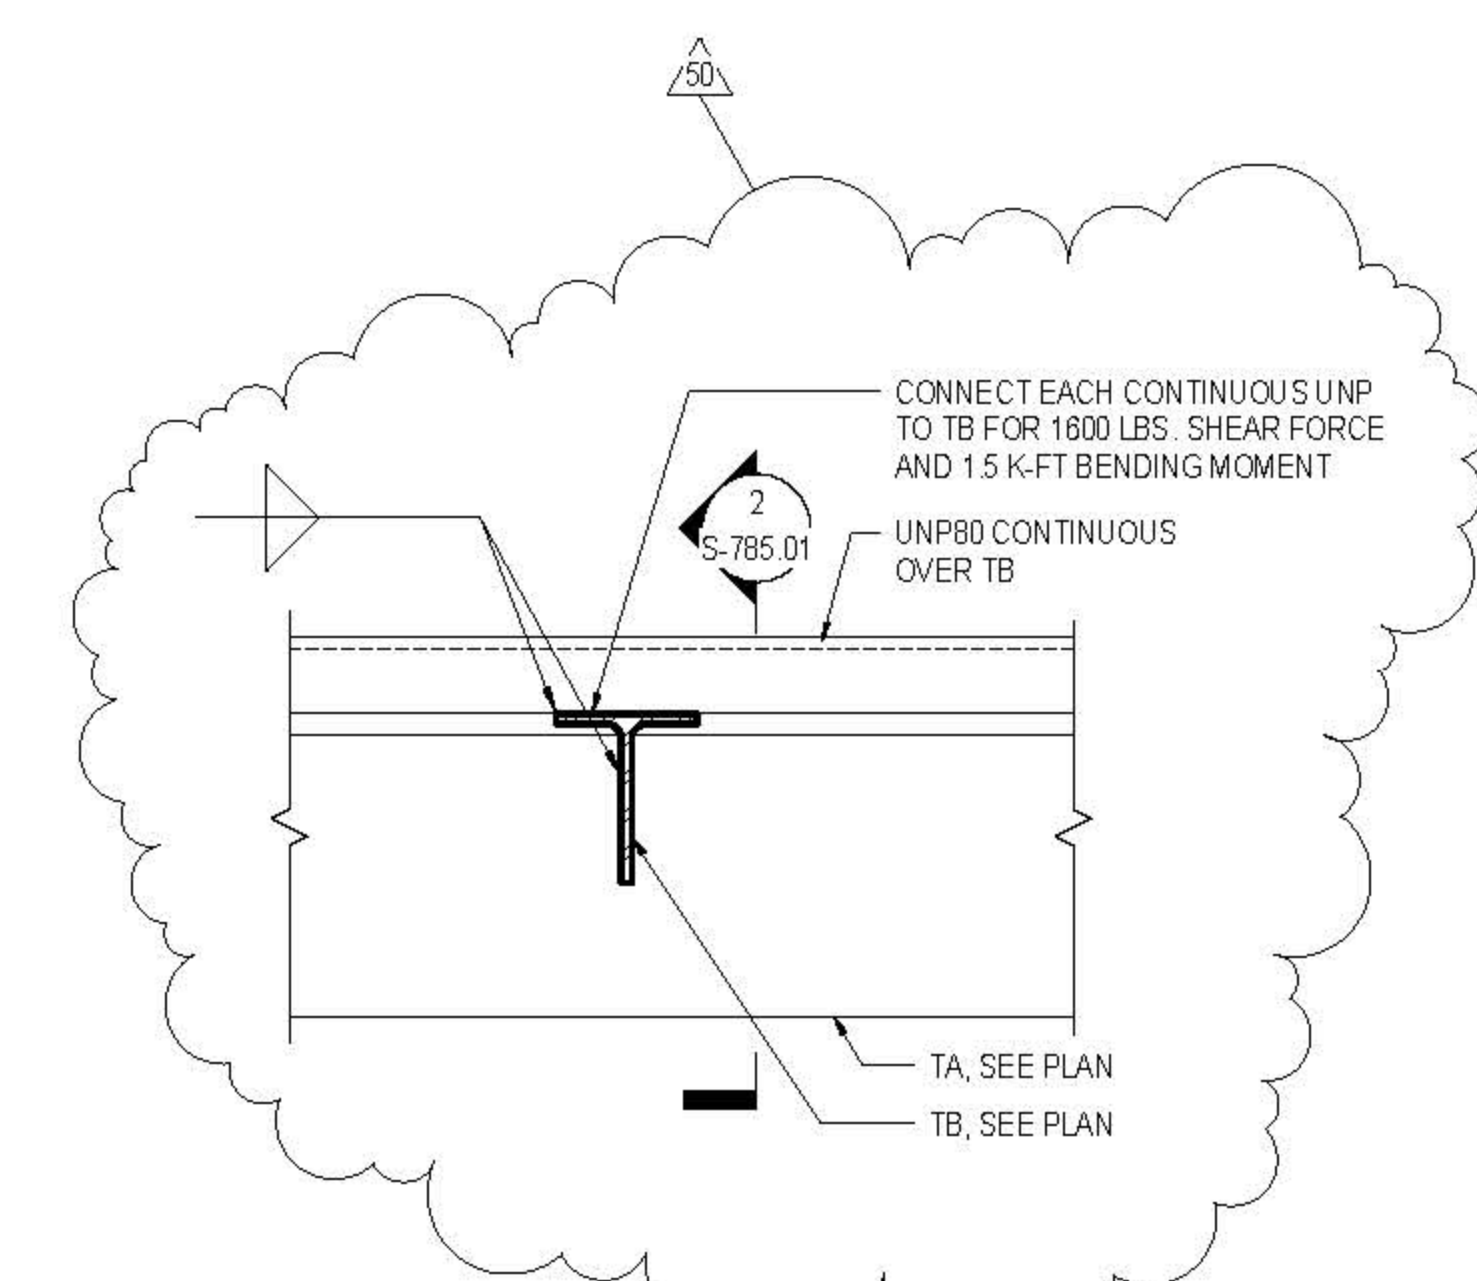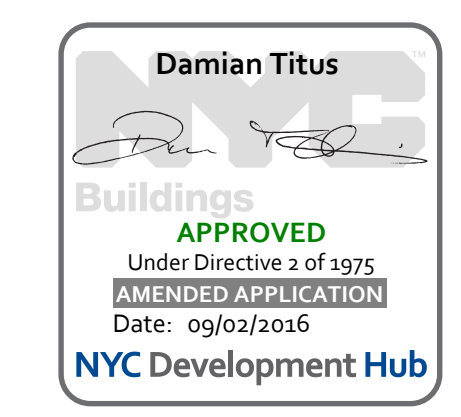


1 SECTION AT RIGGING GRID SUPPORTS
1 1/2" = 1'-0"

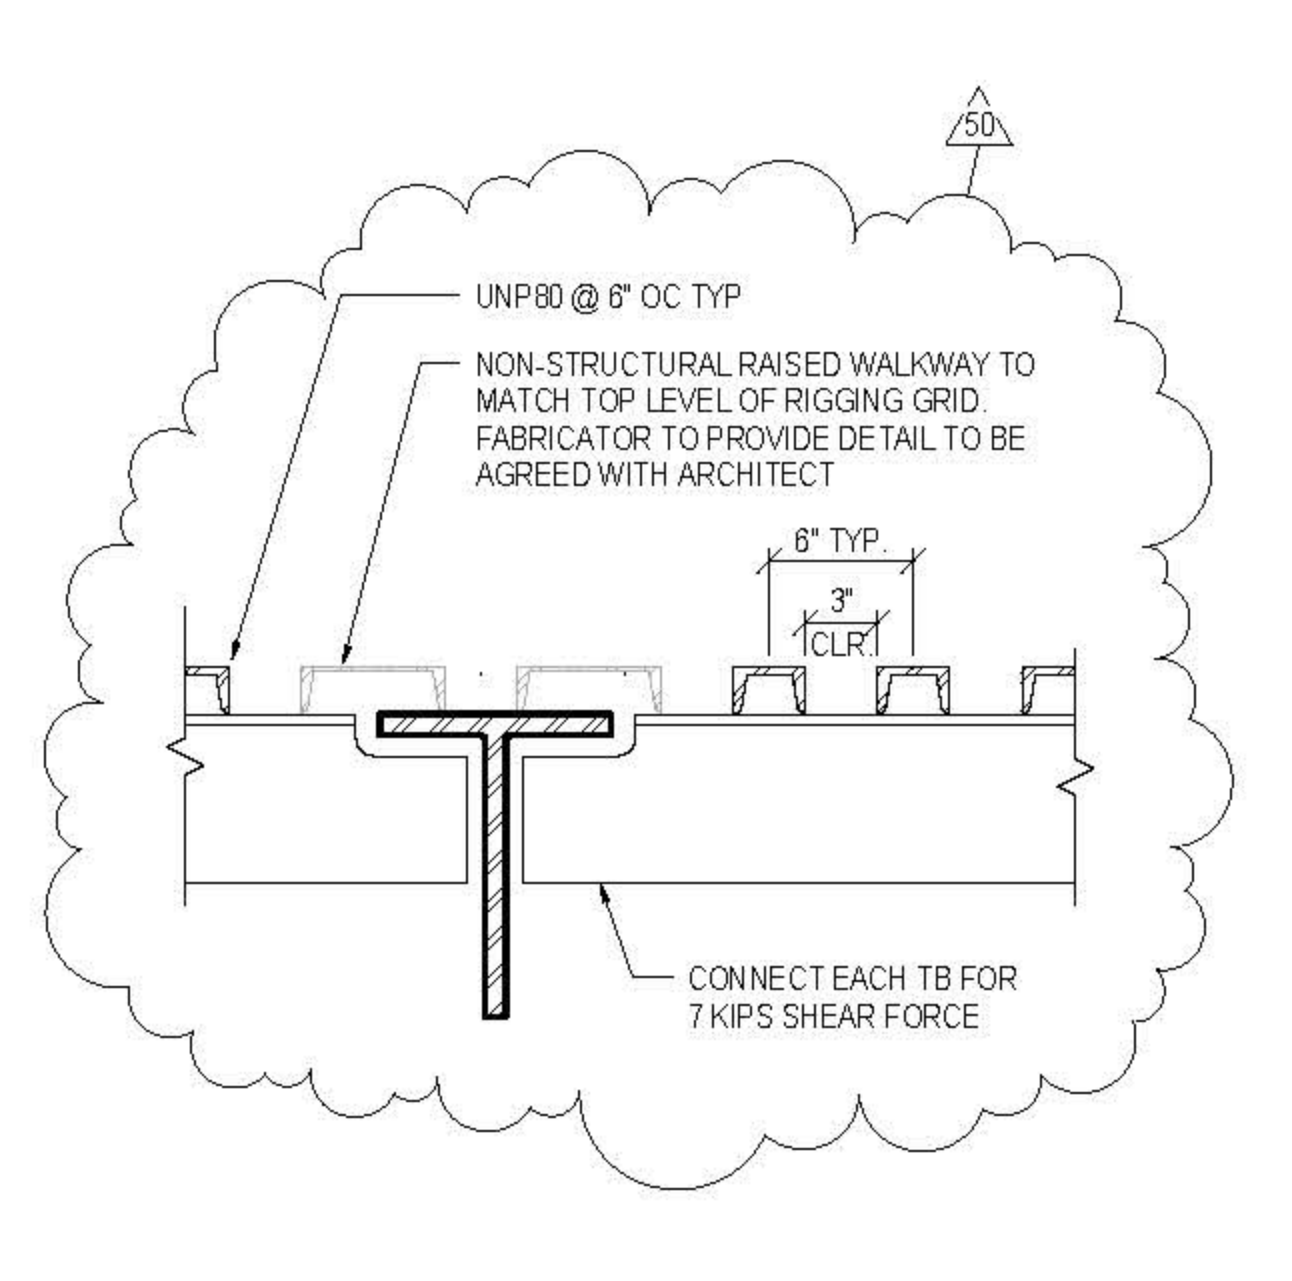


2 SECTION AT RIGGING GRID SUPPORTS
1 1/2" = 1'-0"

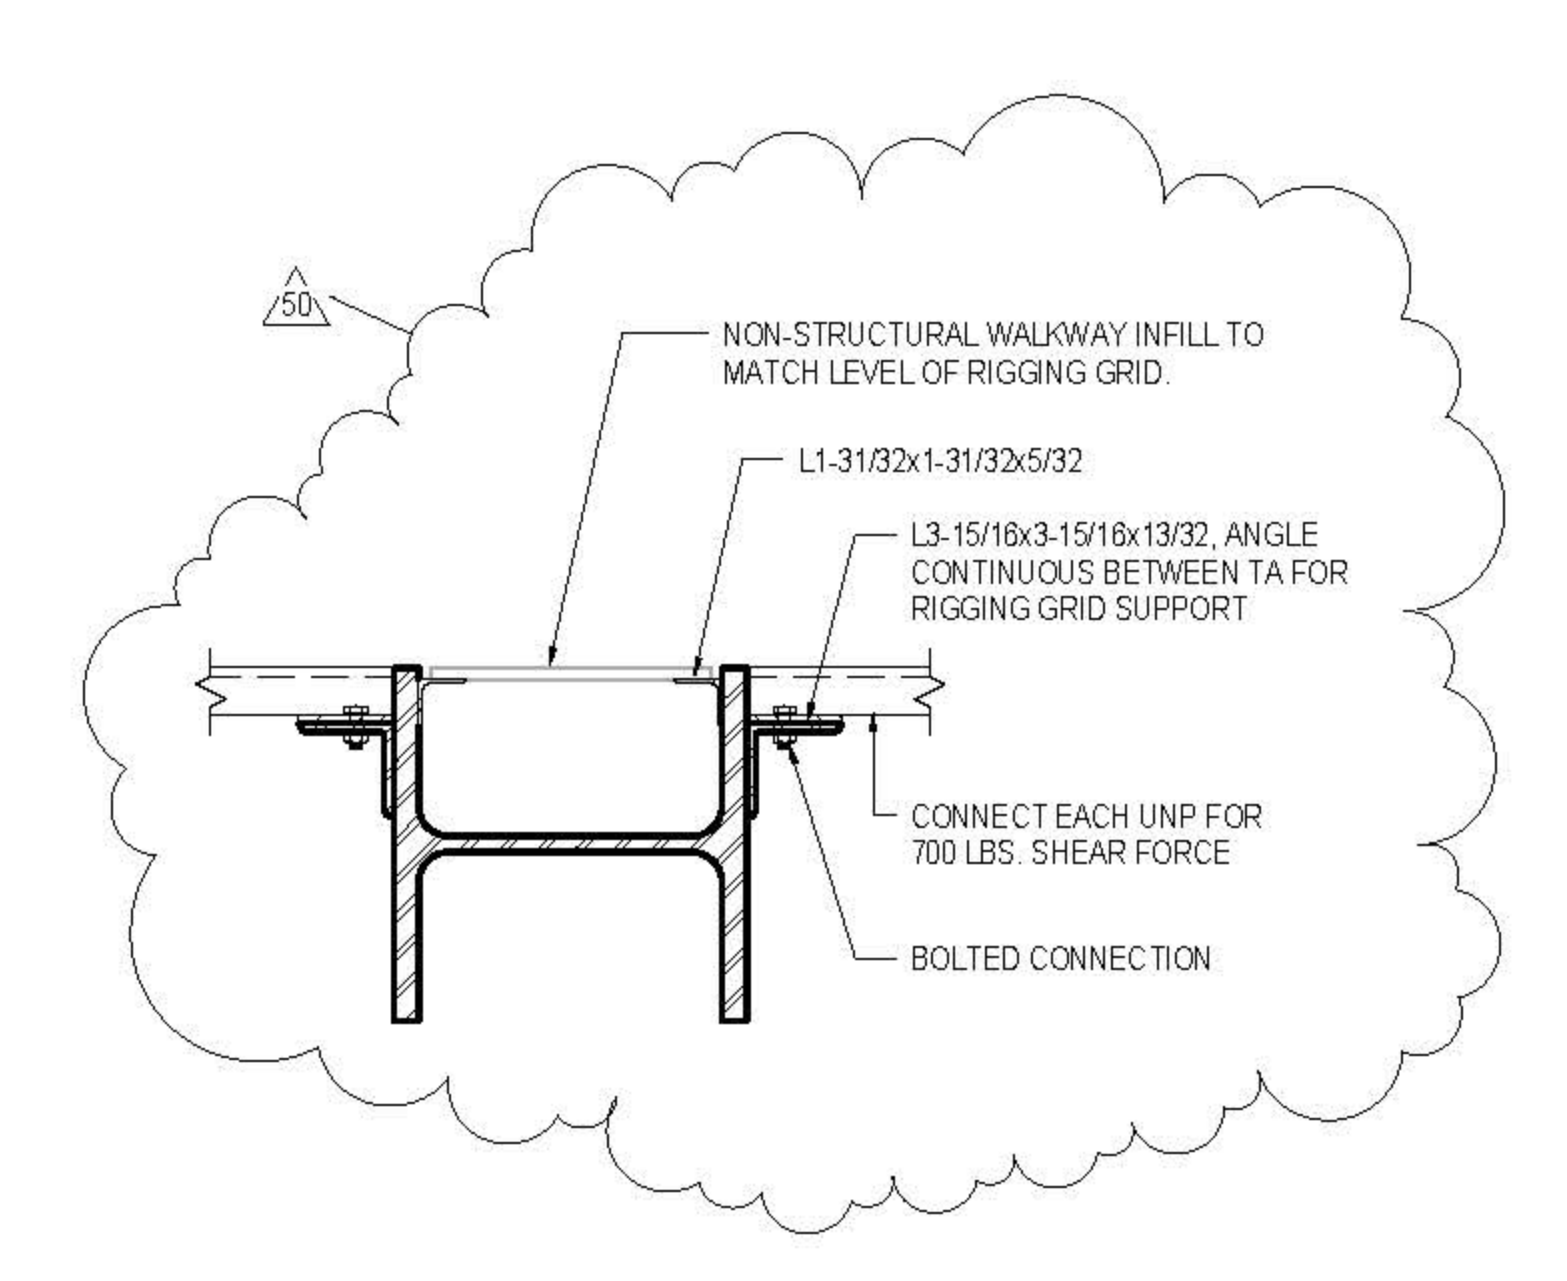


3 SECTION AT RIGGING GRID AND TRUSS
1 1/2" = 1'-0"

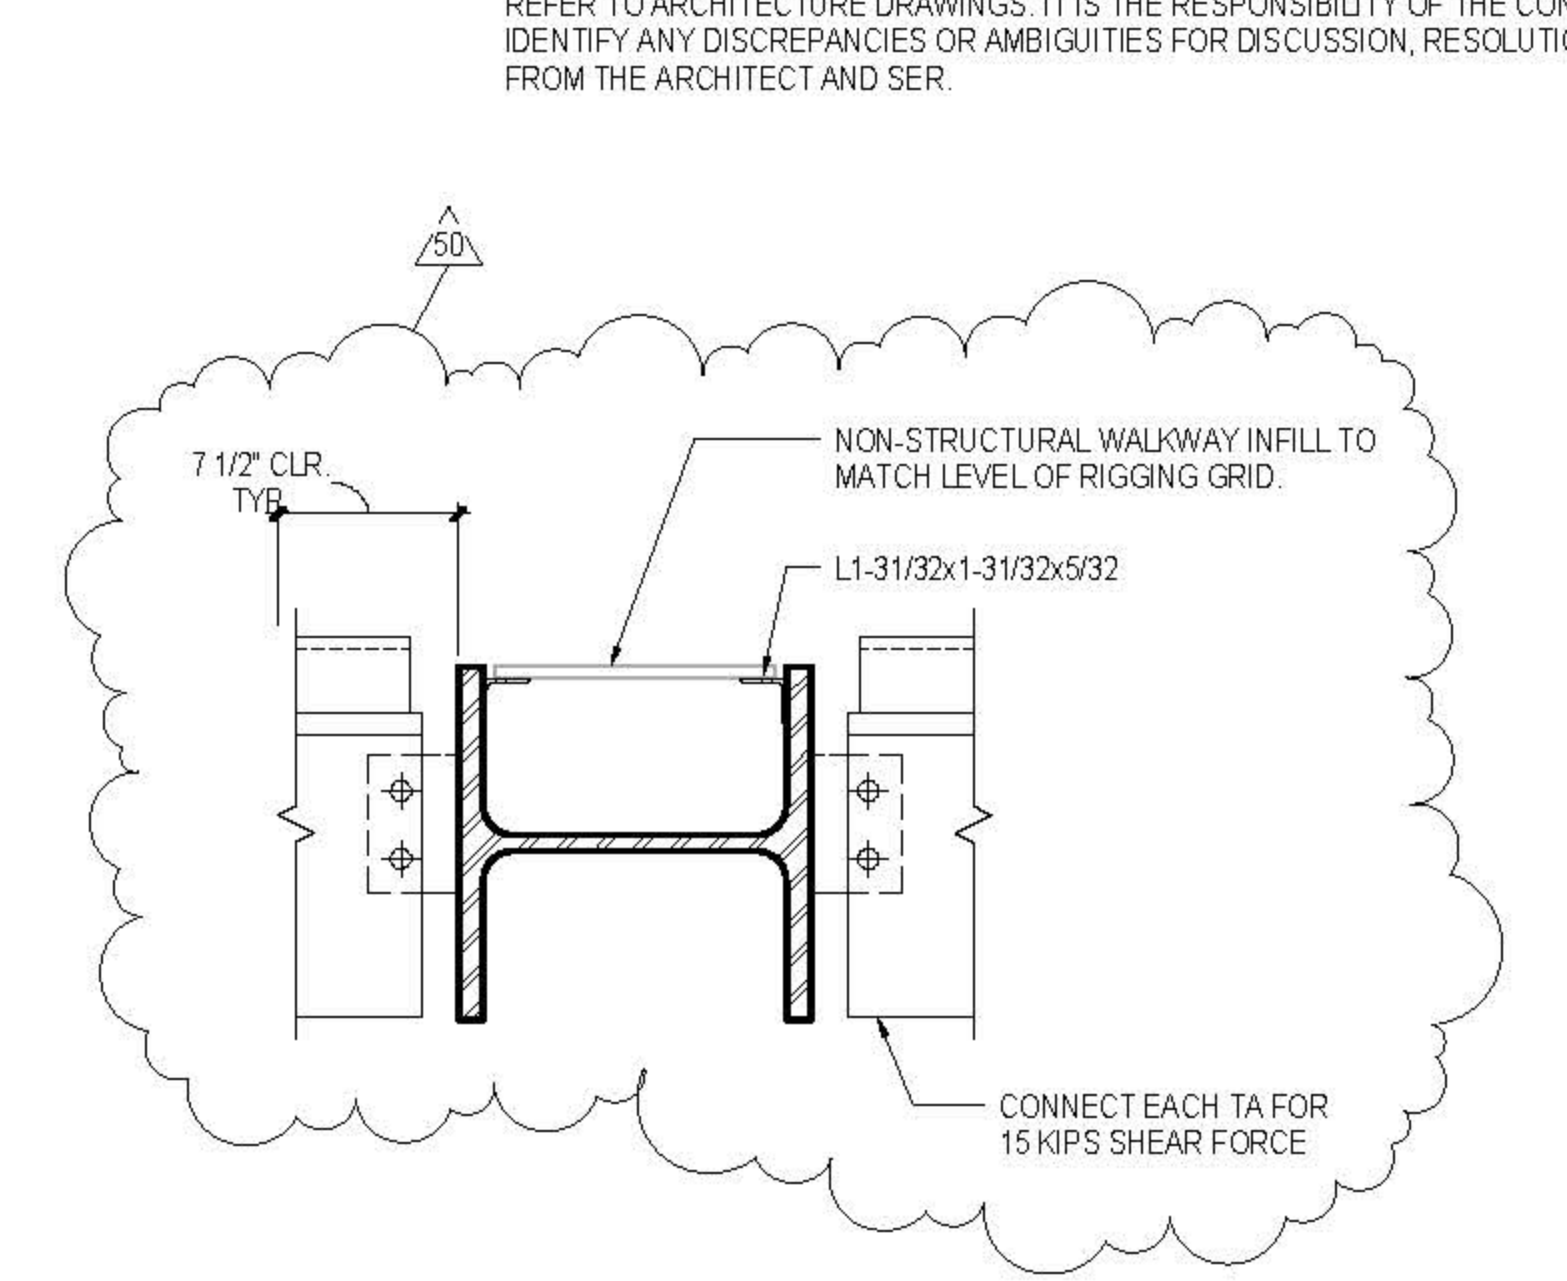


4 SECTION AT MECHANICAL DECK FRAMING AND TRUSS
1 1/2" = 1'-0"

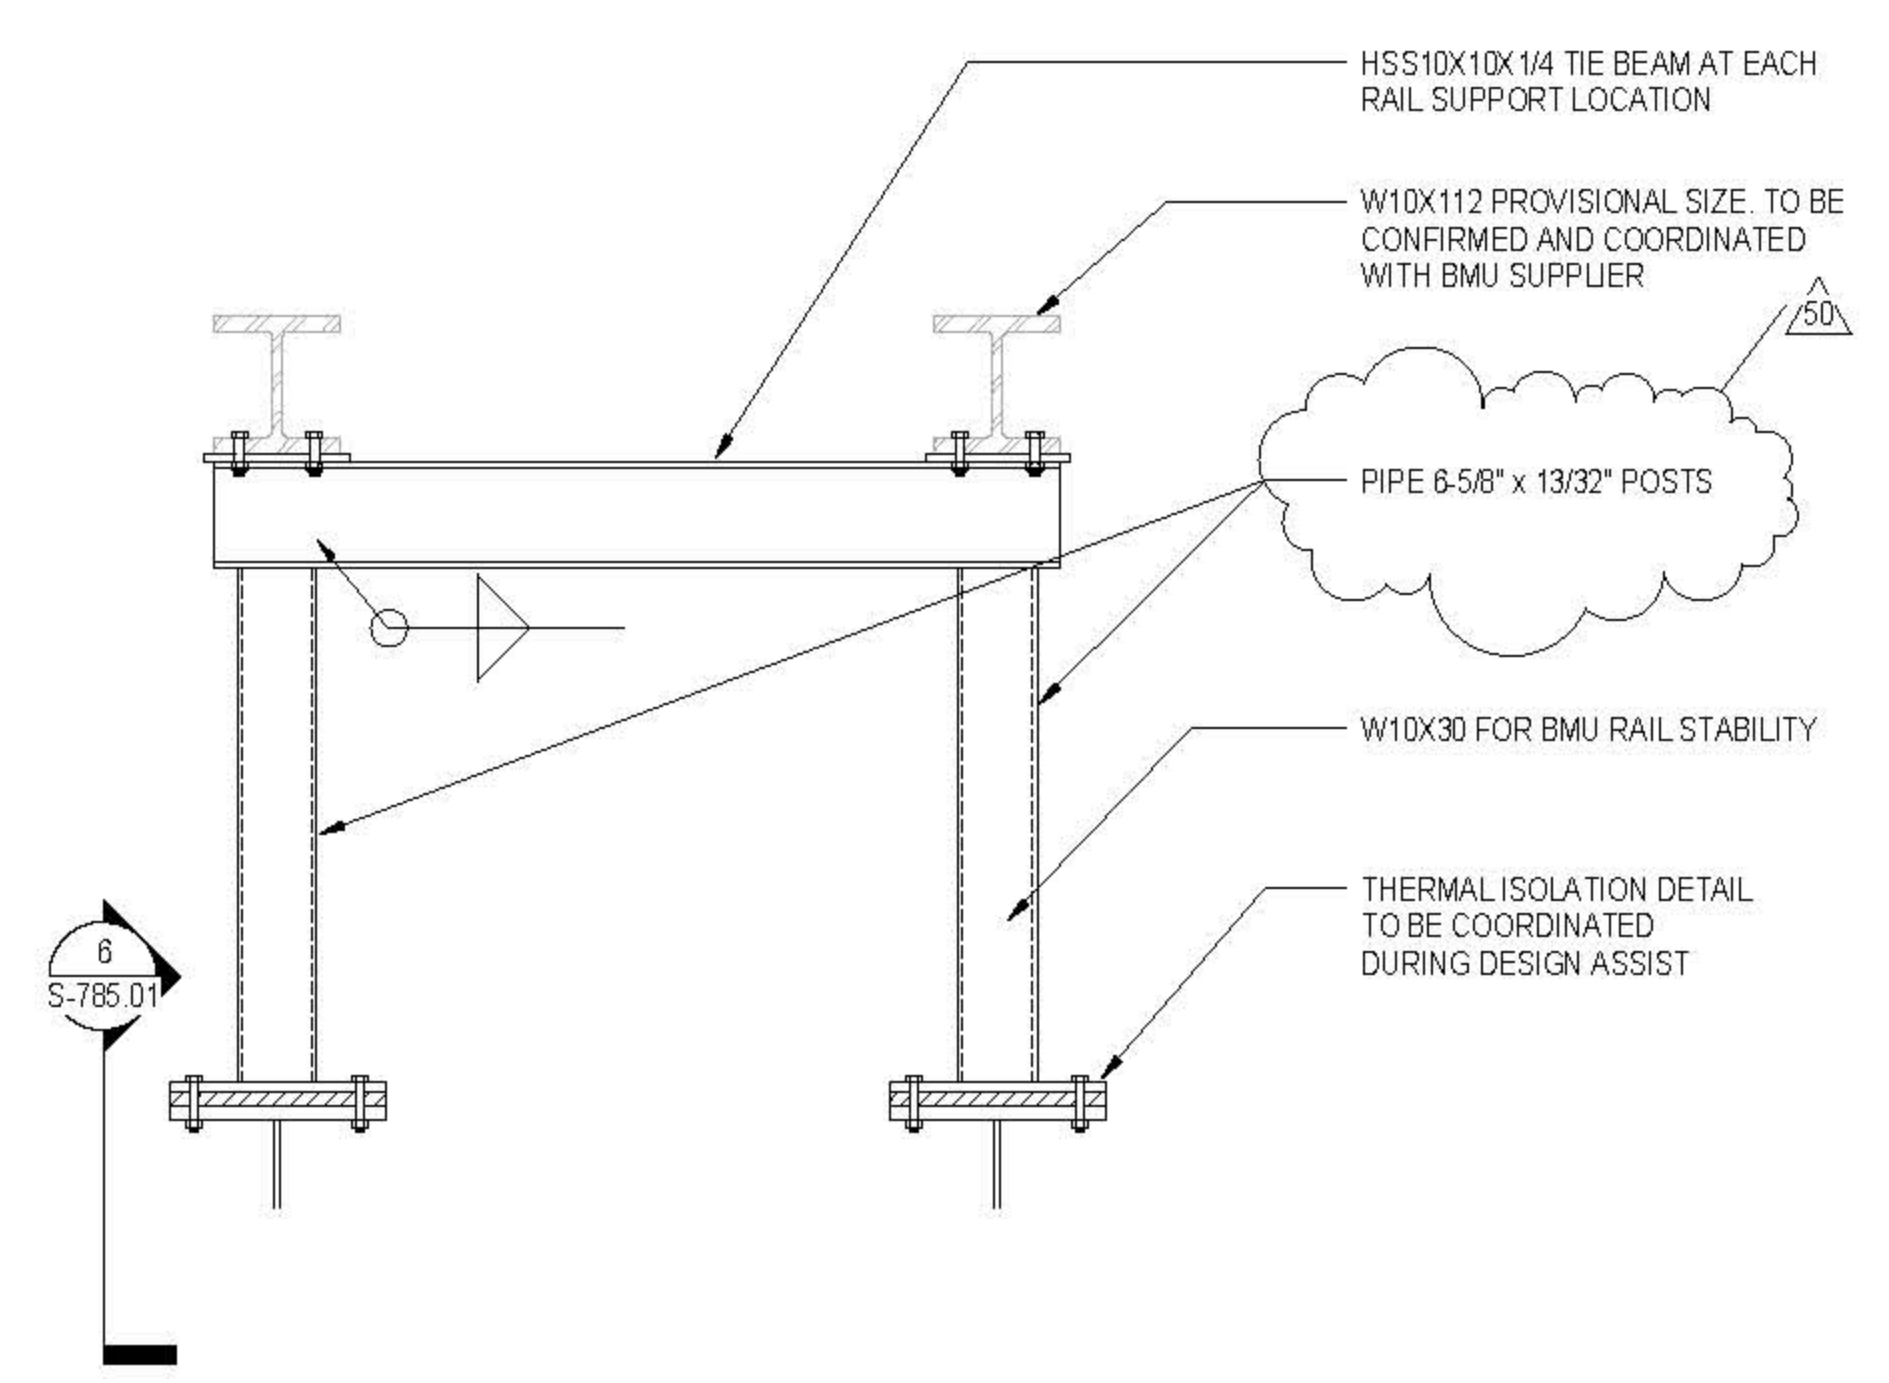


5 ROOF TRACK x TRUSS CONNECTION
3/4" = 1'-0"

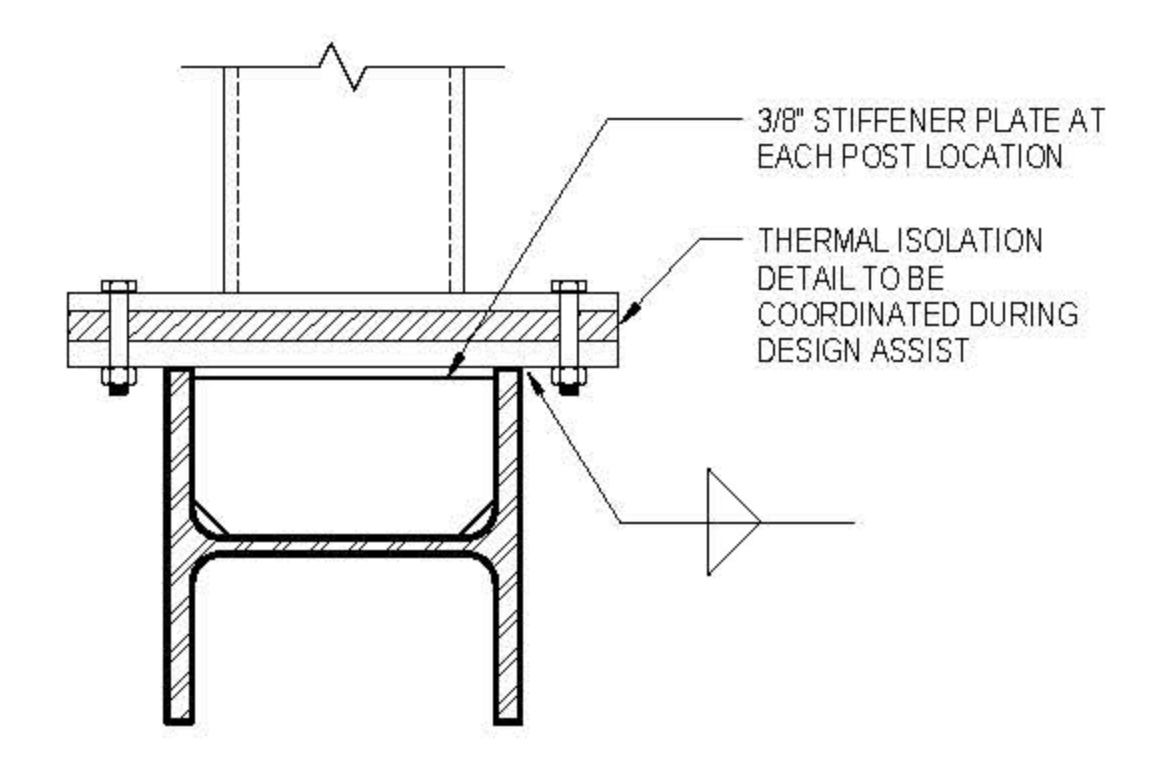

6 BMU POST THERMAL ISOLATION DETAIL
1 1/2" = 1'-0"

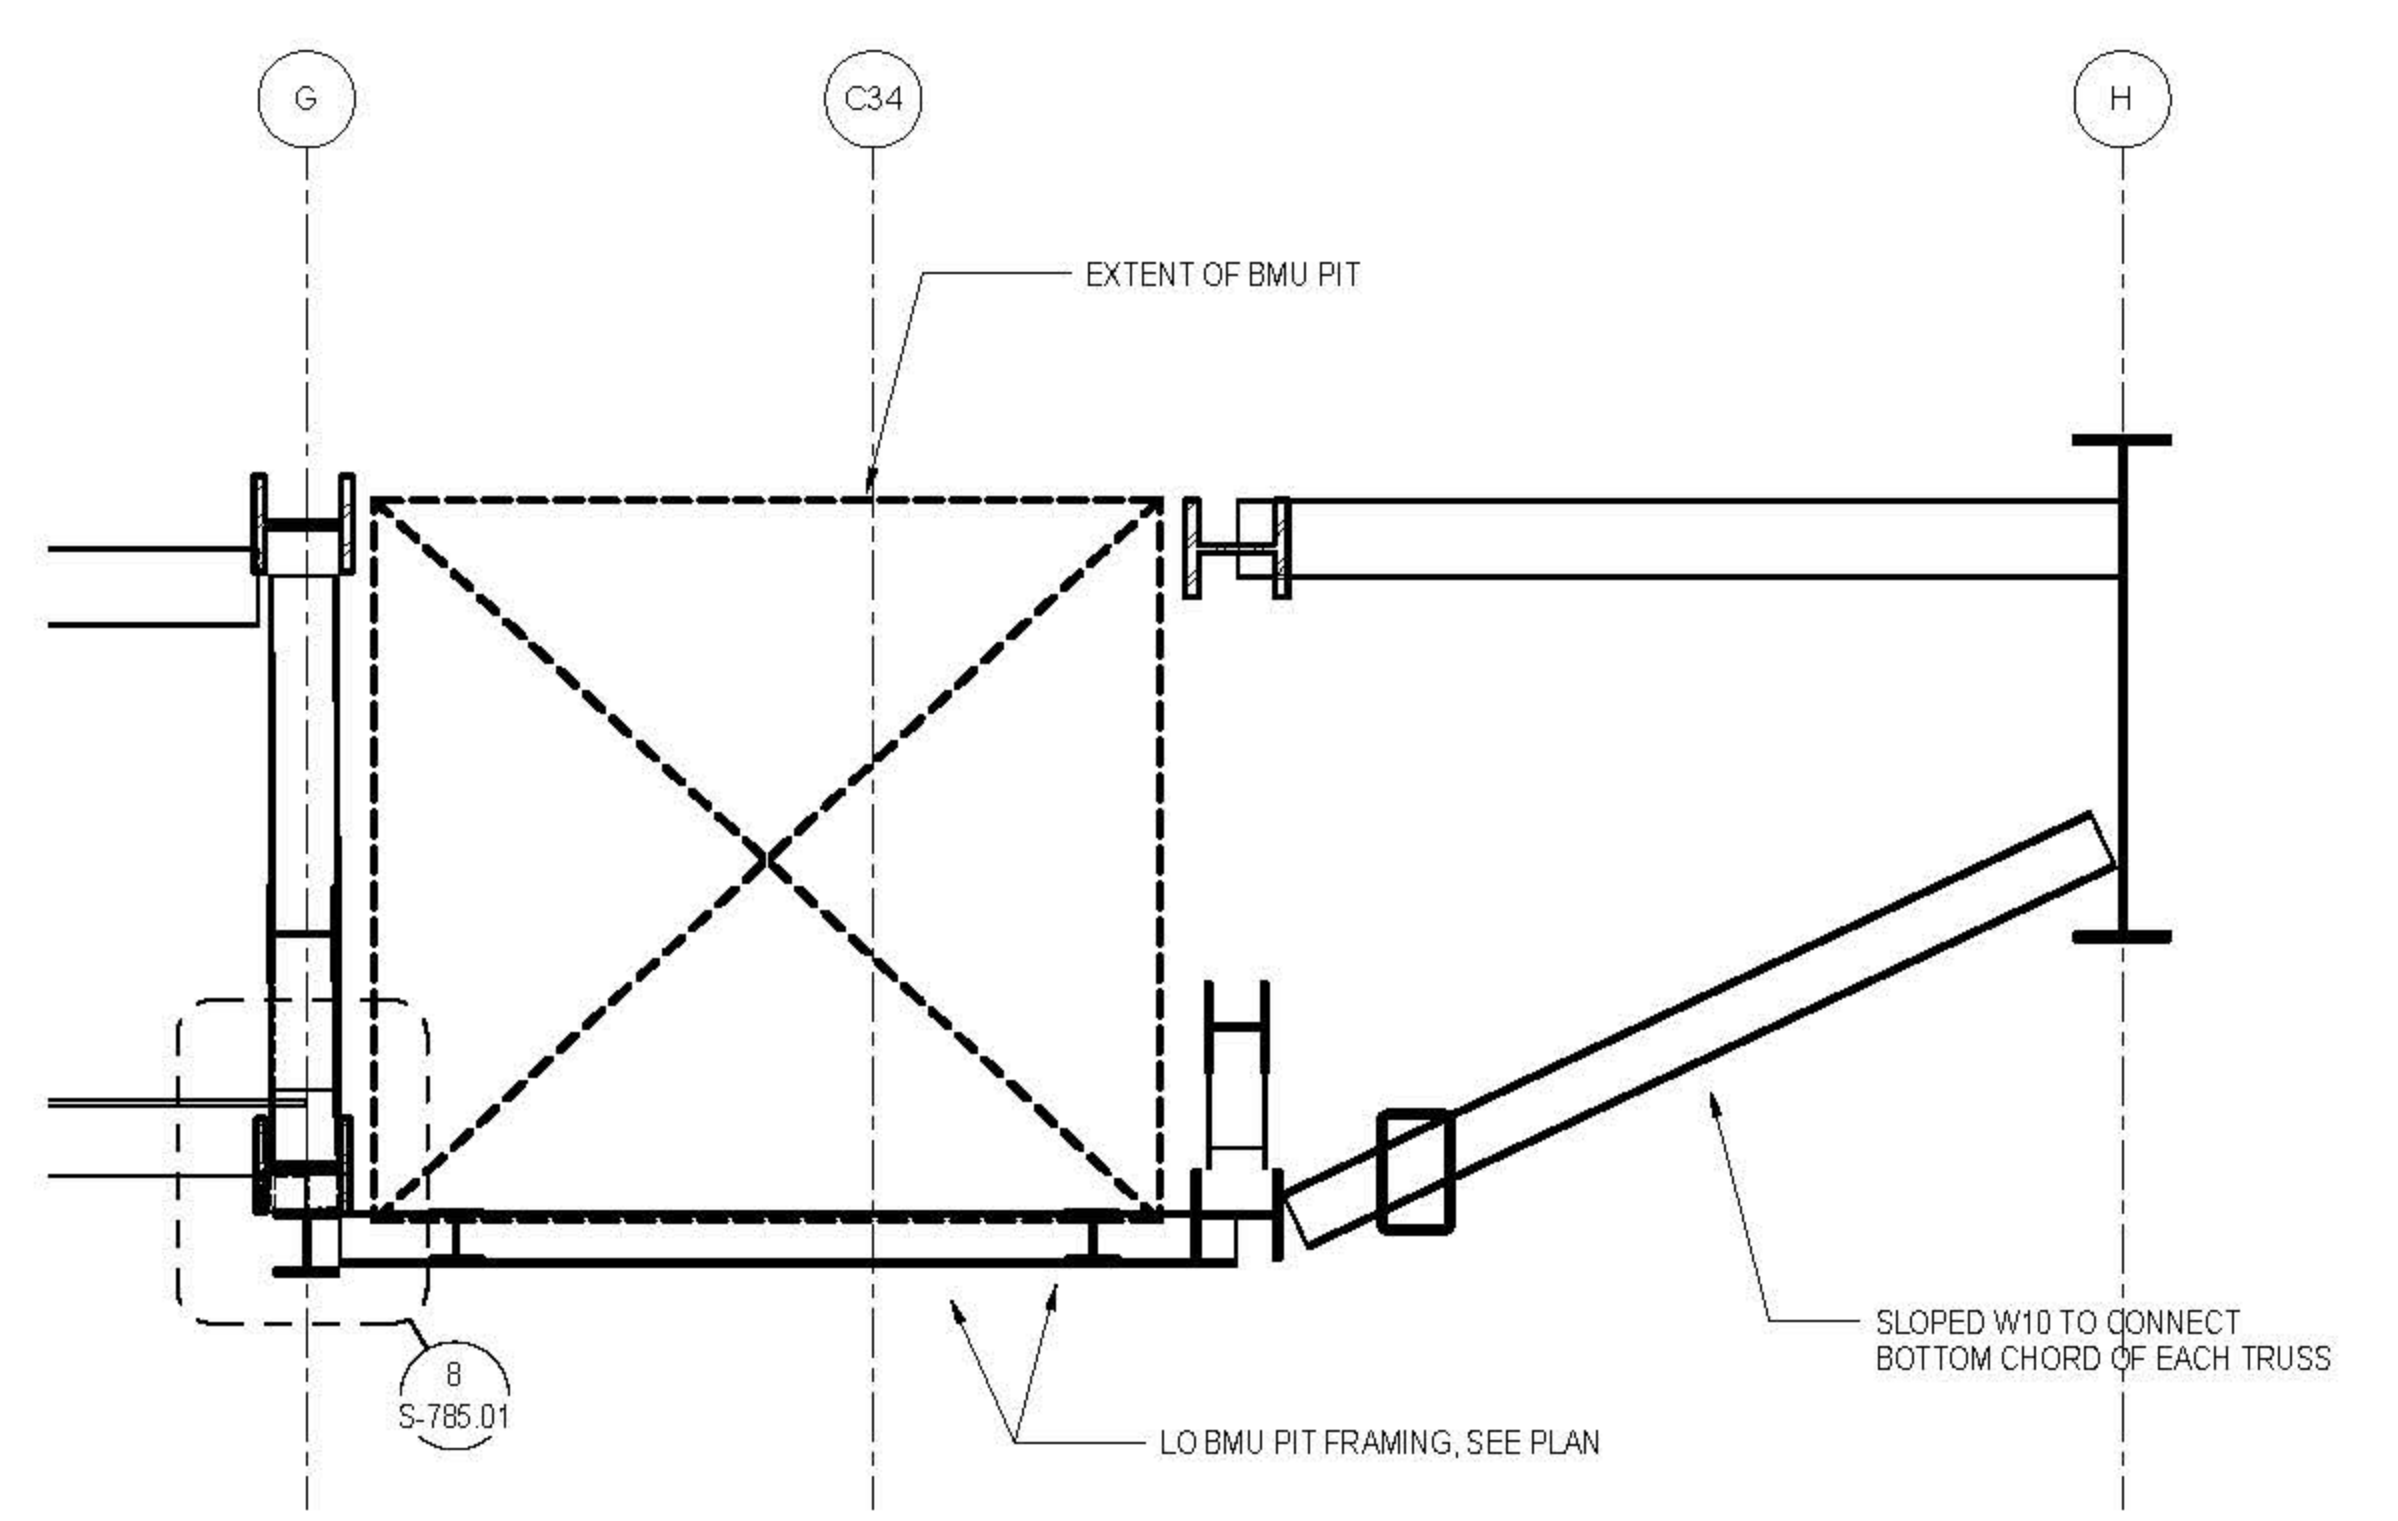

7 SECTION AT BMU PIT
3/8" = 1'-0"

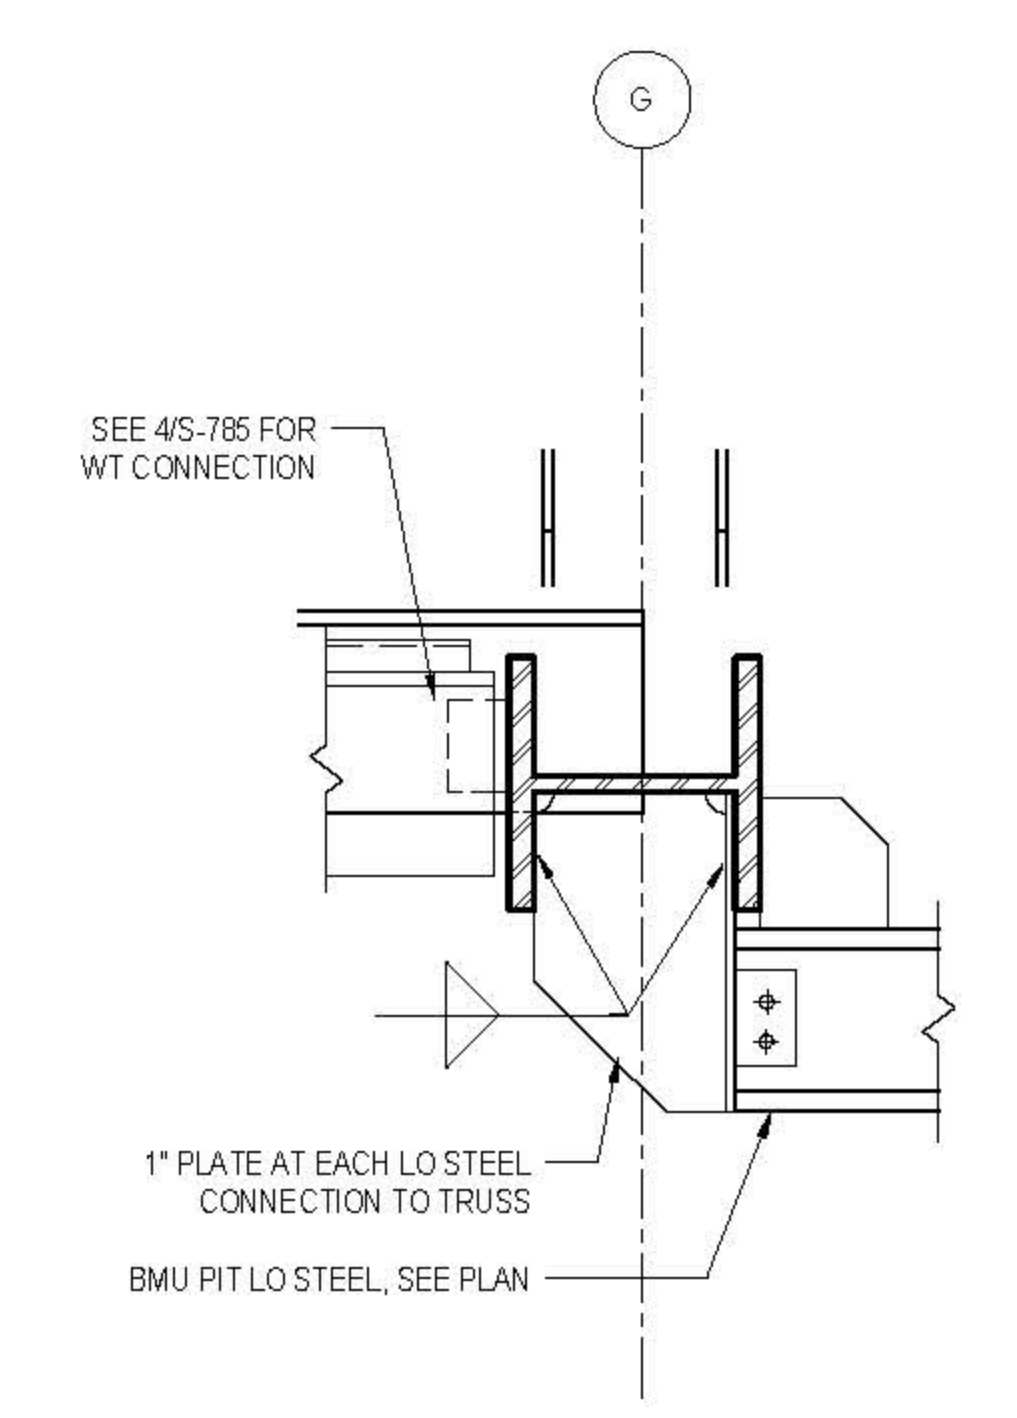

8 LO BMU FRAMING CONNECTION TO TRUSS
1" = 1'-0"

CULTURE SHED

545 West 30th Street
New York, New York 10001

OWNER
CULTURE SHED INC.

ARCHITECTS
Oller Scalfaro + Renfro Architects, DPC
601 West 30th Street #815
New York, New York 10001
T: 212.260.7971

rockwellgroup
5 Union St. West, 6th Fl.
New York, New York 10003
T: 212.463.0334
F: 212.463.0335

STRUCTURAL ENGINEER
Thornton Tomasetti
51 Madison Avenue
New York, New York 10010
T: 917.981.7800
F: 917.981.7801

MEP ENGINEER
Jans Baum & Bolles
60 Park Street
New York, New York 10005
T: 212.530.9300
F: 212.266.6944

FACADE CONSULTANT
Thornton Tomasetti
51 Madison Avenue
New York, New York 10010
T: 917.981.7800
F: 917.981.7801

KINETICS ENGINEER
Hudess & Hanover
1501 Broadway
New York, New York 10036
T: 212.944.1150
F: 212.391.0297

LIGHTING DESIGNER
Tilston Design Associates
40 North Street #160
New York, New York 10013
T: 212.675.7760

THEATRE PLANNING & DESIGN
Flaher Dachs Associates
22 West 15th Street
New York, New York 10011
T: 212.691.3000

LIFE SAFETY
Code Consultants, Inc.
215 West 43rd St, 15th Fl.
New York, New York 10018
T: 212.216.9596

ENERGY MODEL/LEED
Vindian
60 Washington Street
Norwalk, CT 06854
T: 203.298.1411

ACOUSTIC/AUDIO-VISUAL
Avenille
93 North Main Street
South Norwalk, CT 06854
T: 347.210.5540

VERTICAL TRANSPORTATION
Van Duinen & Associates
5 Regent Street, Suite 524
Lakewood, NJ 07038
T: 973.994.9220

SPECIFICATIONS
Construction Specifications Inc.
PO Box 489
22 Tannem Road
Morganville, NJ 07751
T: 732.970.0700
F: 732.970.0750


SECURITY
Duchella Venter & Santoro
1100 Sherman Avenue
Hartford, CT 06114
T: 203.286.6490

WATERPROOFING
James R. Gahfort AIA Consulting Architects PC
104 West 27th Street
New York, NY 10001
T: 212.736.3344


FACADE MAINTENANCE
Erick Engineering PLLC
162 Ave. Street
New York, NY 10005
T: 212.986.3000

BRANDING GRAPHICS
2nd Global Design Consultancy
180 Varck Street 15th Floor
New York, NY 10014
T: 212.647.1170


GEOMETRY, DIMENSIONS AND SURFACE CONTOURING, BLENDING AND INTERSECTION OF SECTION IS ILLUSTRATED IN THE STRUCTURAL DRAWINGS ARE PROVIDED FOR REFERENCE AND GENERATION OF STRUCTURAL ARRANGEMENT AND DETAILS ONLY. THE 3D MODEL ISSUED BY THE ARCHITECT DEFINES THE EXTERIOR SURFACE AND SHALL BE ADHERED TO FOR THE FINAL GEOMETRY. FOR DETAILS OF SECONDARY STEEL, INCLUDING STRUCTURAL CLADDING REFER TO ARCHITECTURE DRAWINGS. IT IS THE RESPONSIBILITY OF THE CONTRACTOR TO IDENTIFY ANY DISCREPANCIES OR AMBIGUITIES FOR DISCUSSION, RESOLUTION AND DIRECTION FROM THE ARCHITECT AND SER.

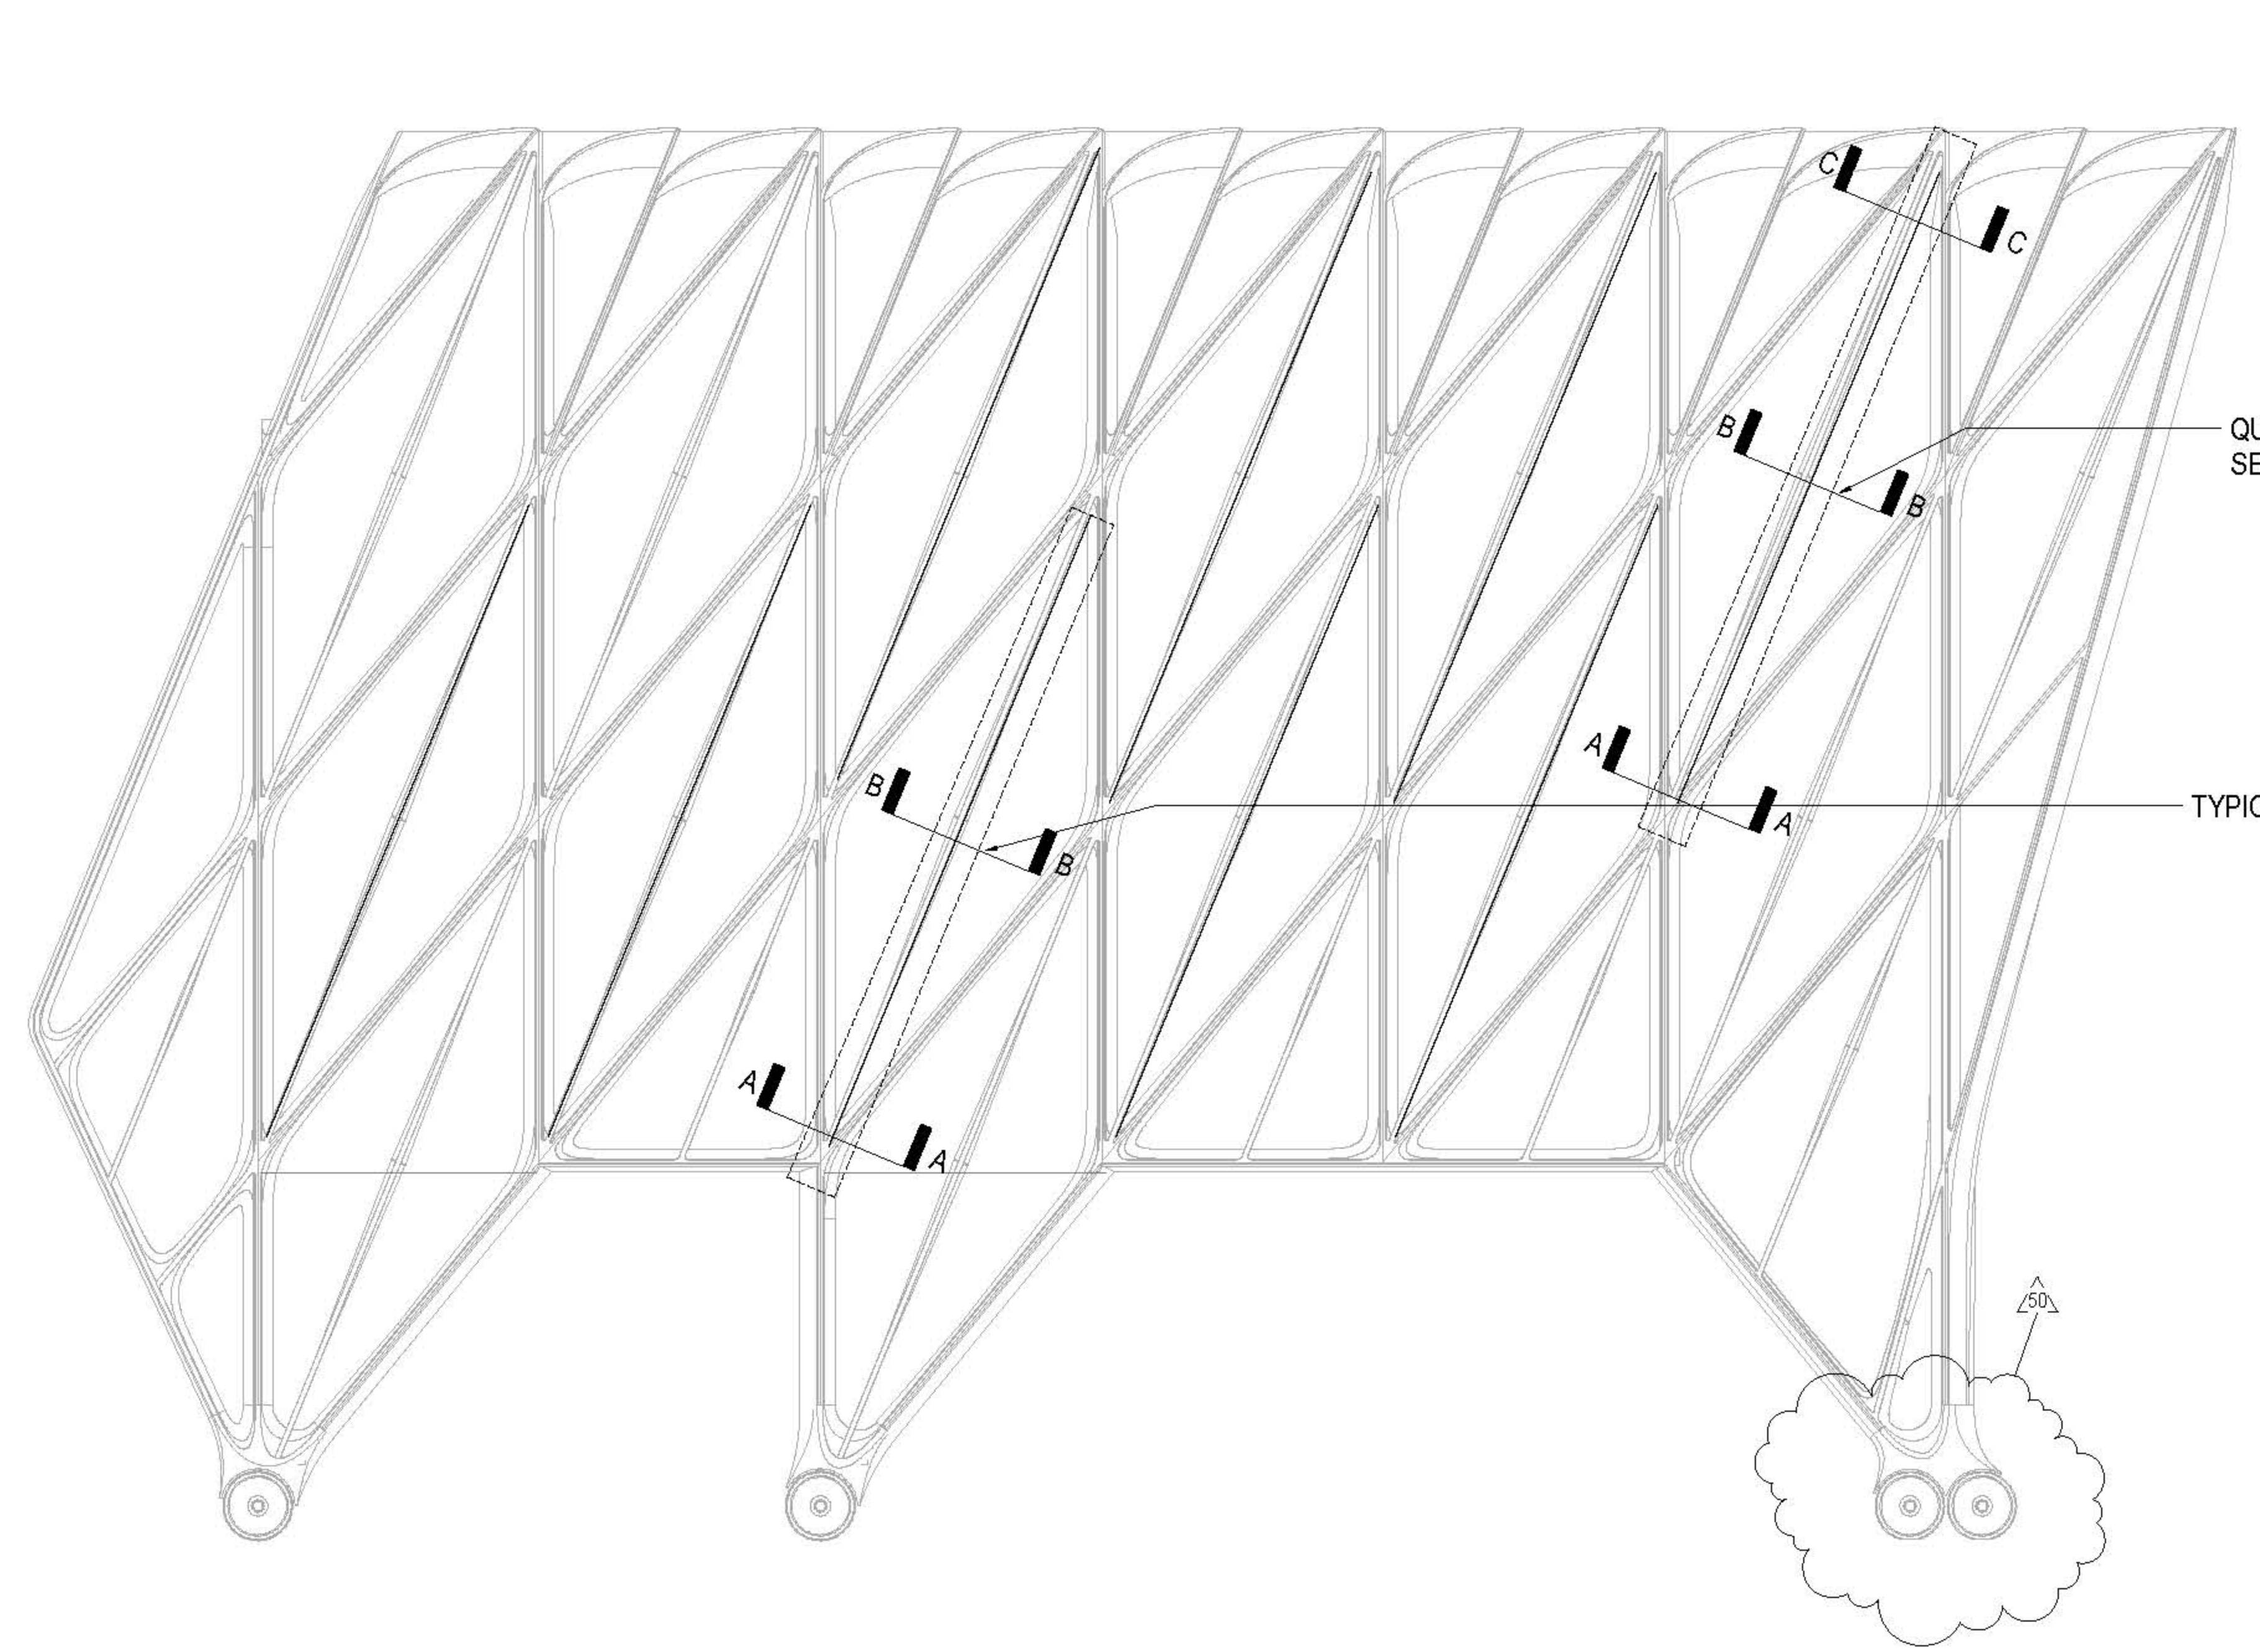


1 SOUTH ELEVATION
3/32" = 1'-0"

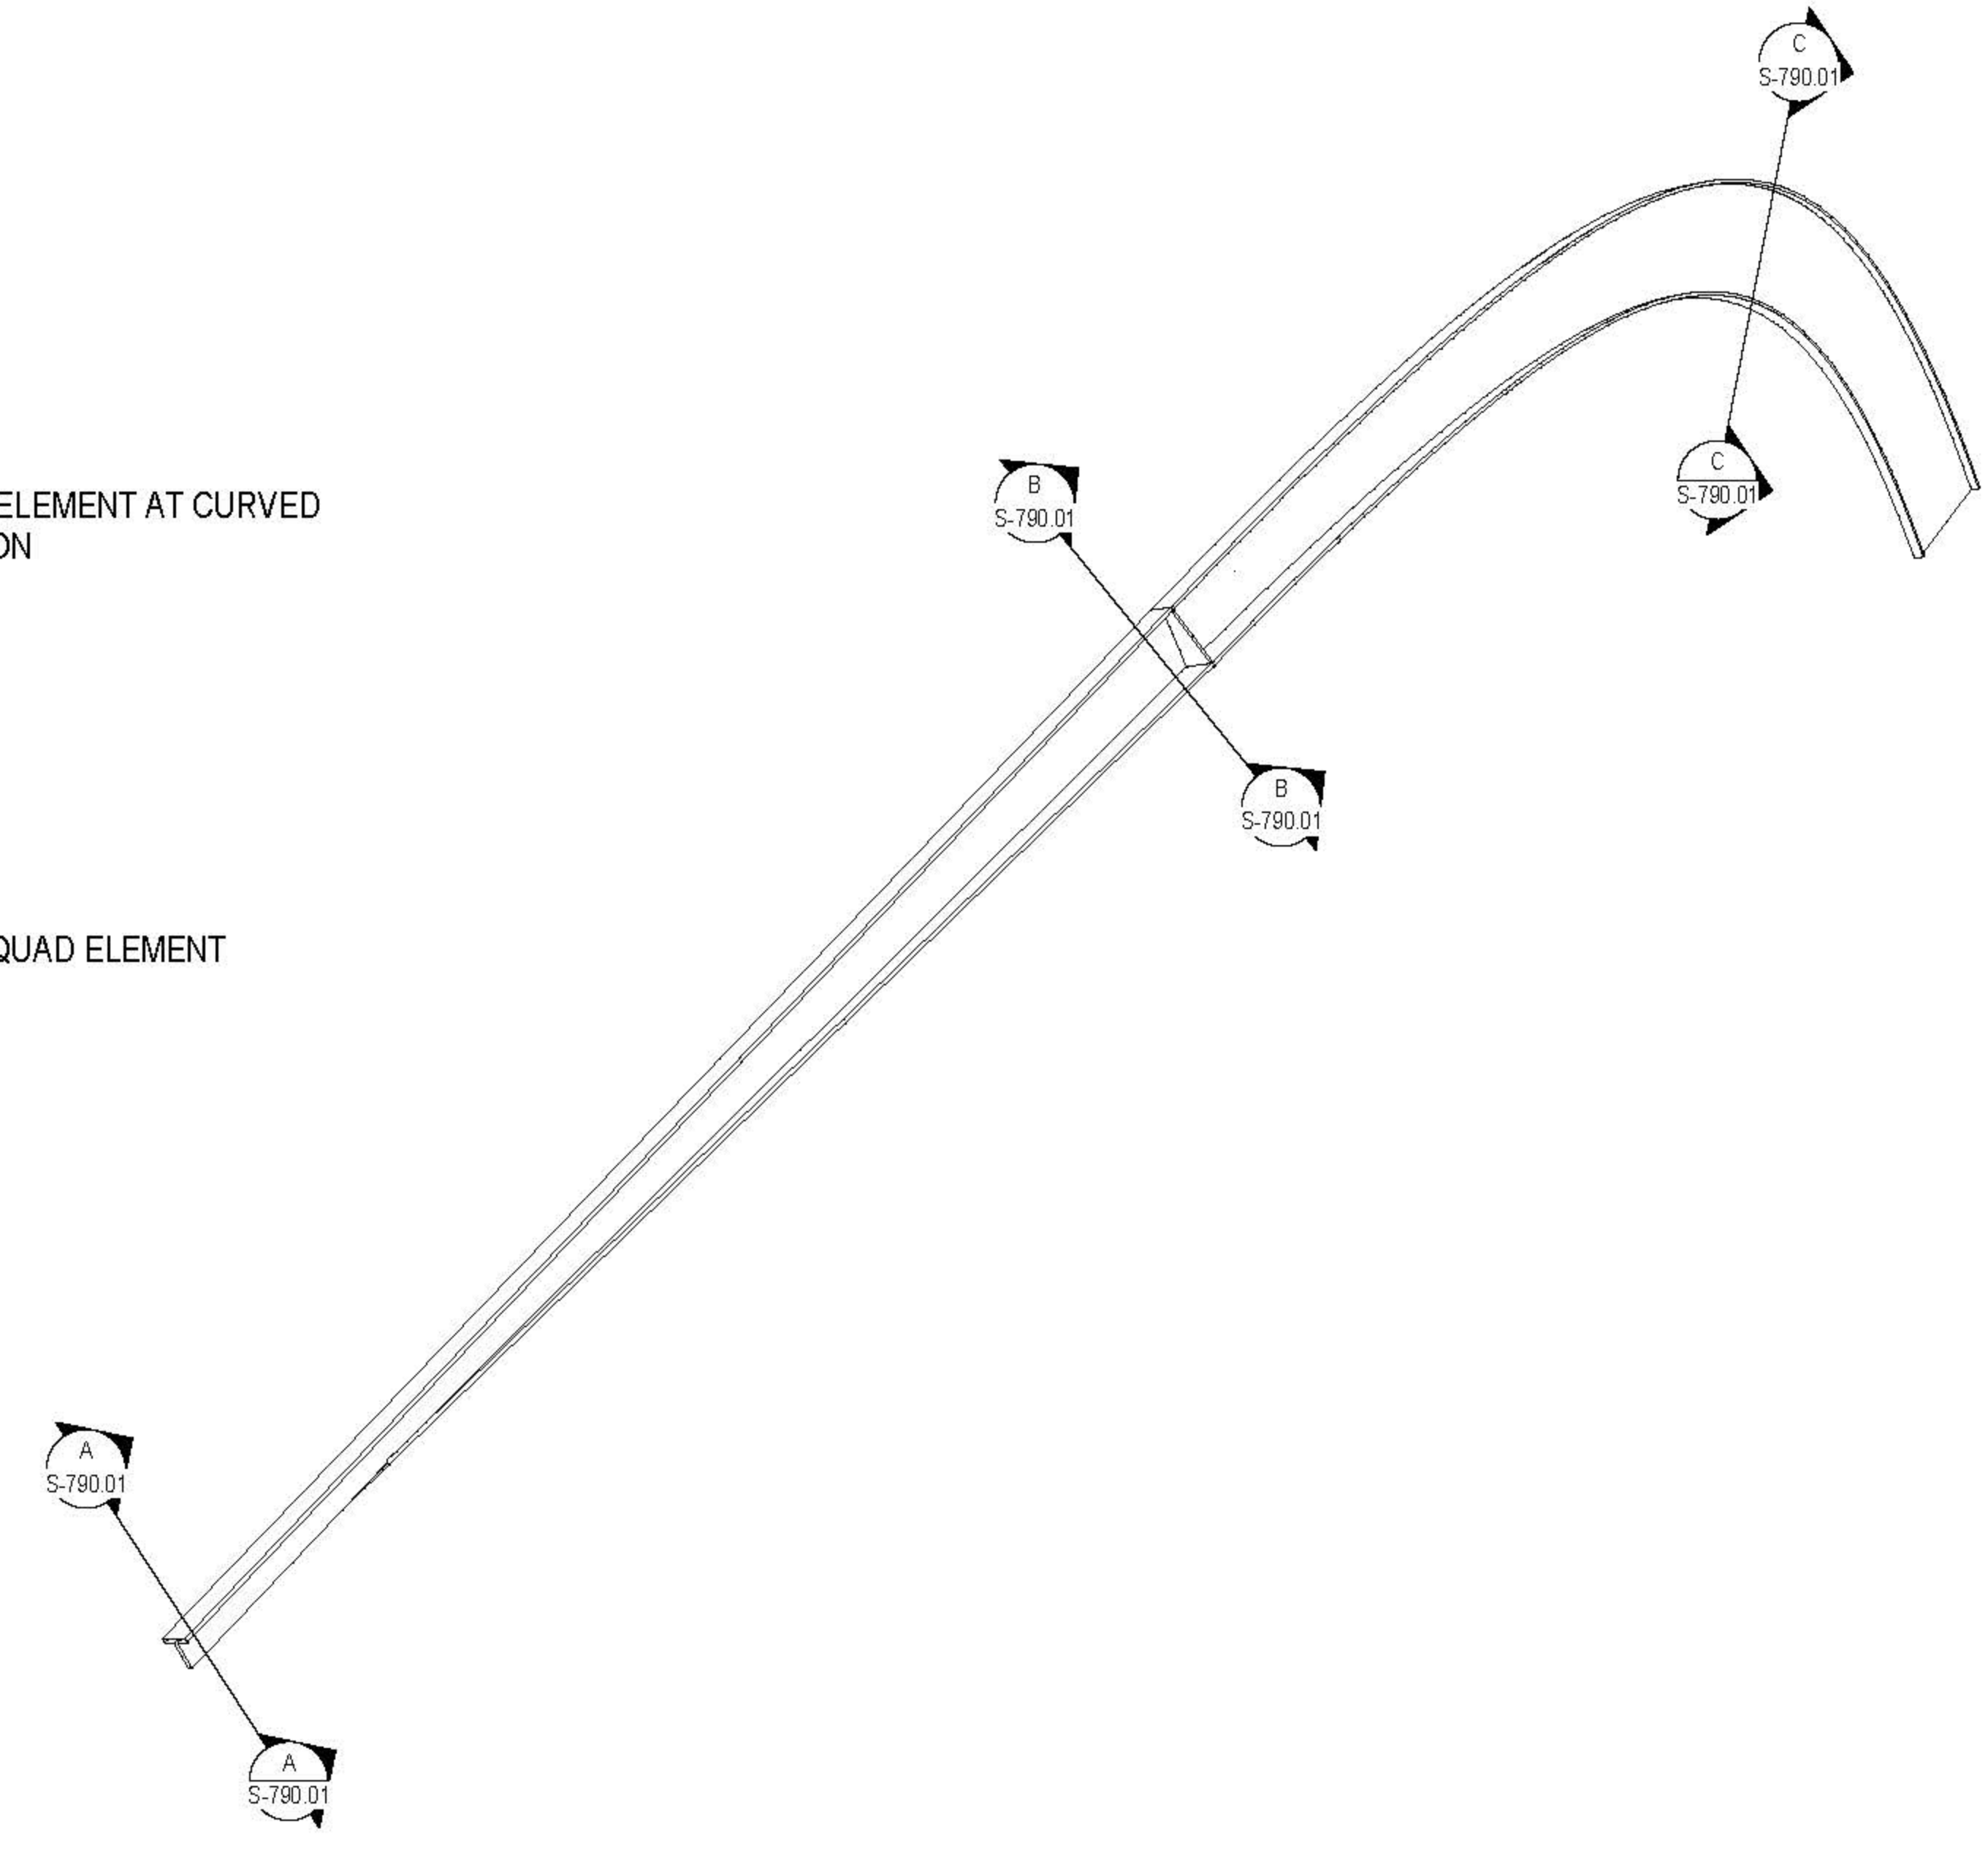


3 TYPICAL CURVED QUAD ELEMENT-AXONOMETRIC
1/2" = 1'-0"

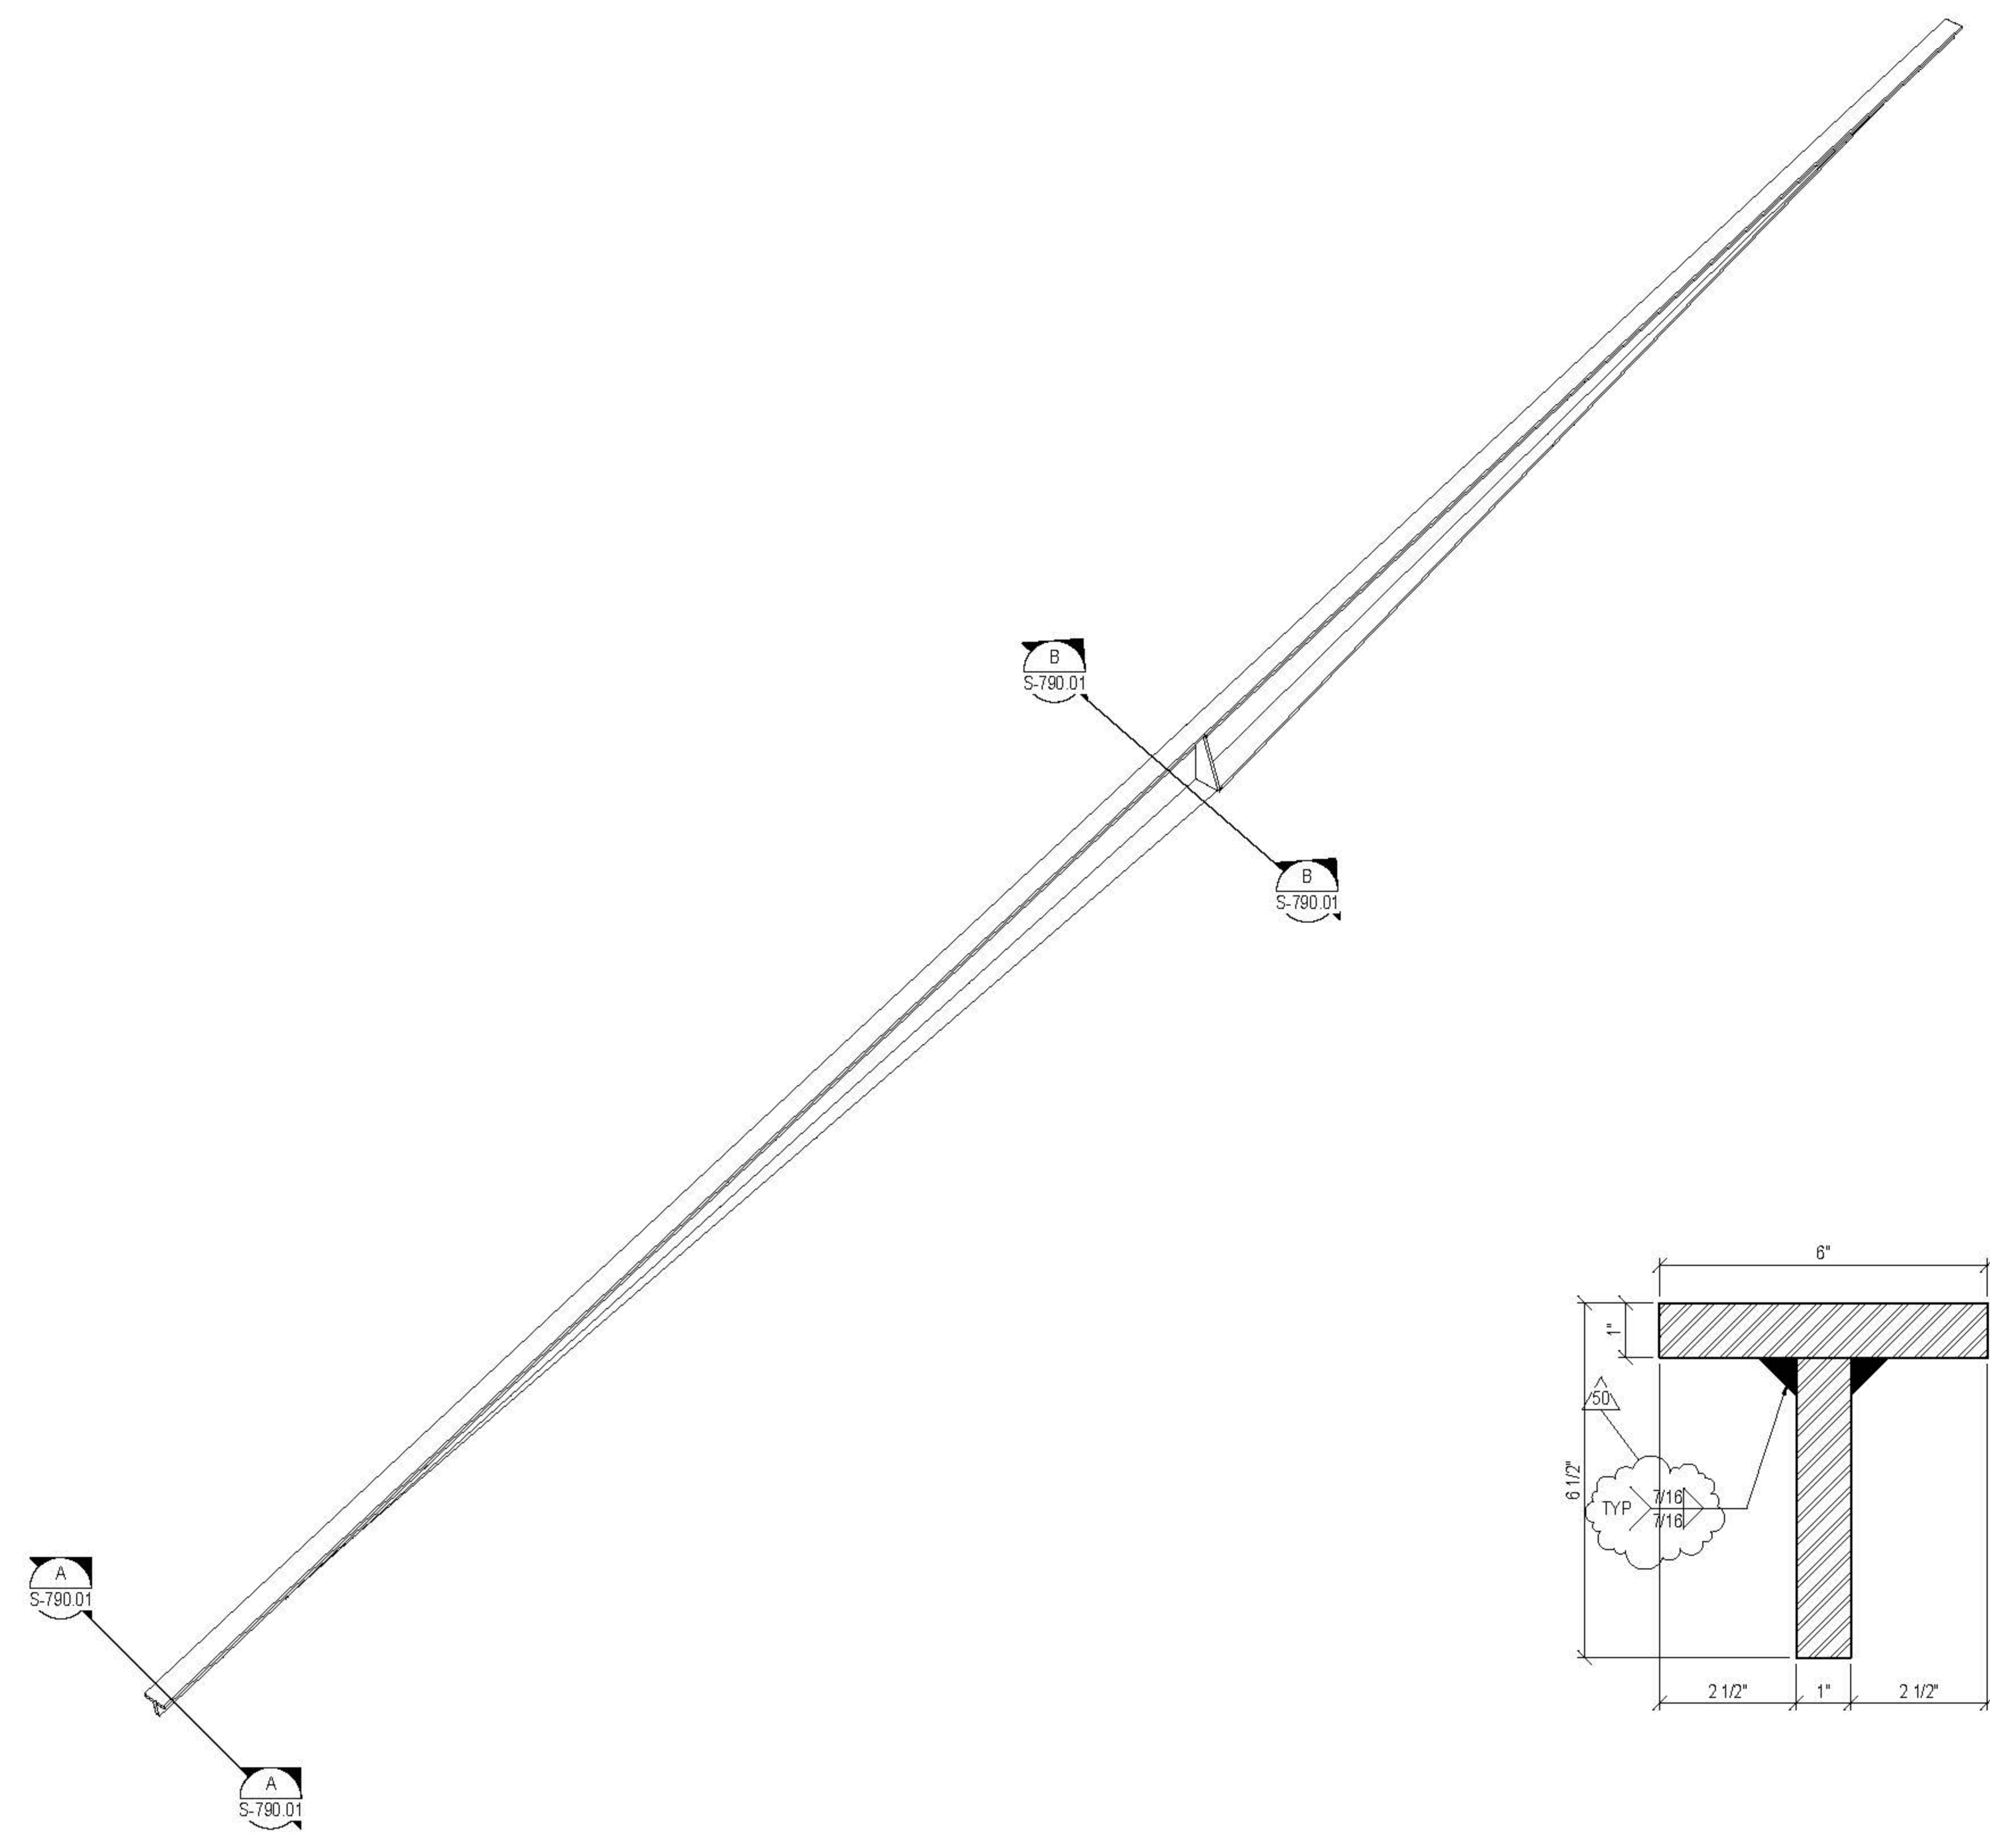


2 TYPICAL QUAD ELEMENT-AXONOMETRIC
1/2" = 1'-0"

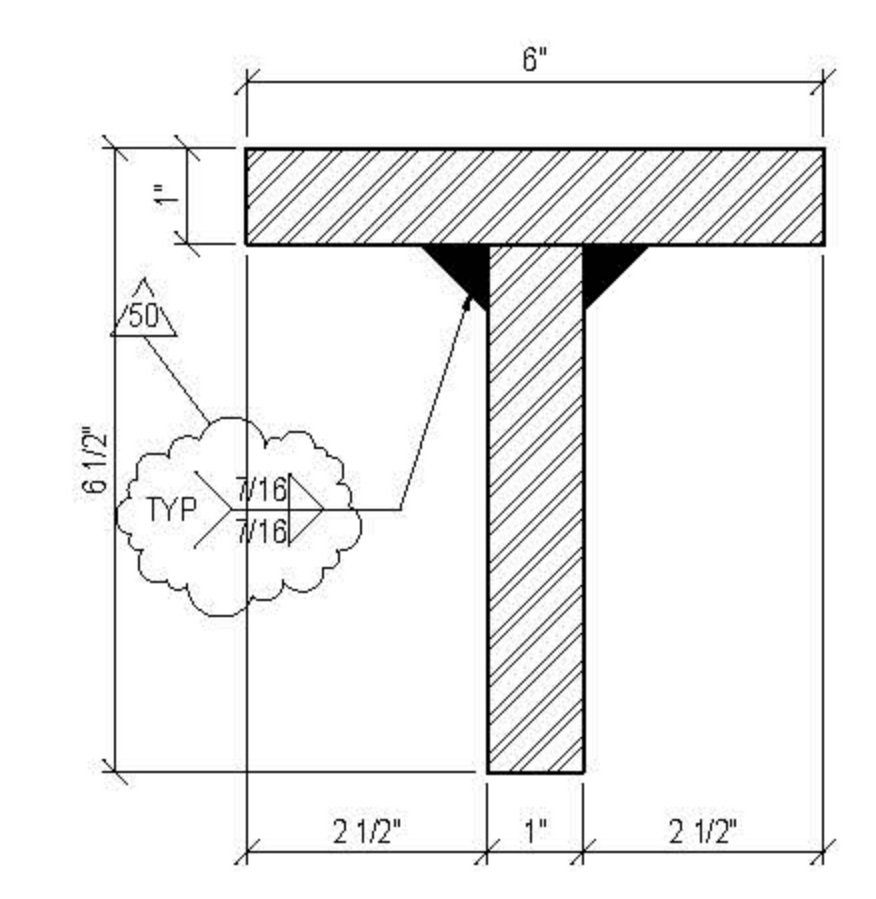

A SECTION A-A
0" = 1'-0"

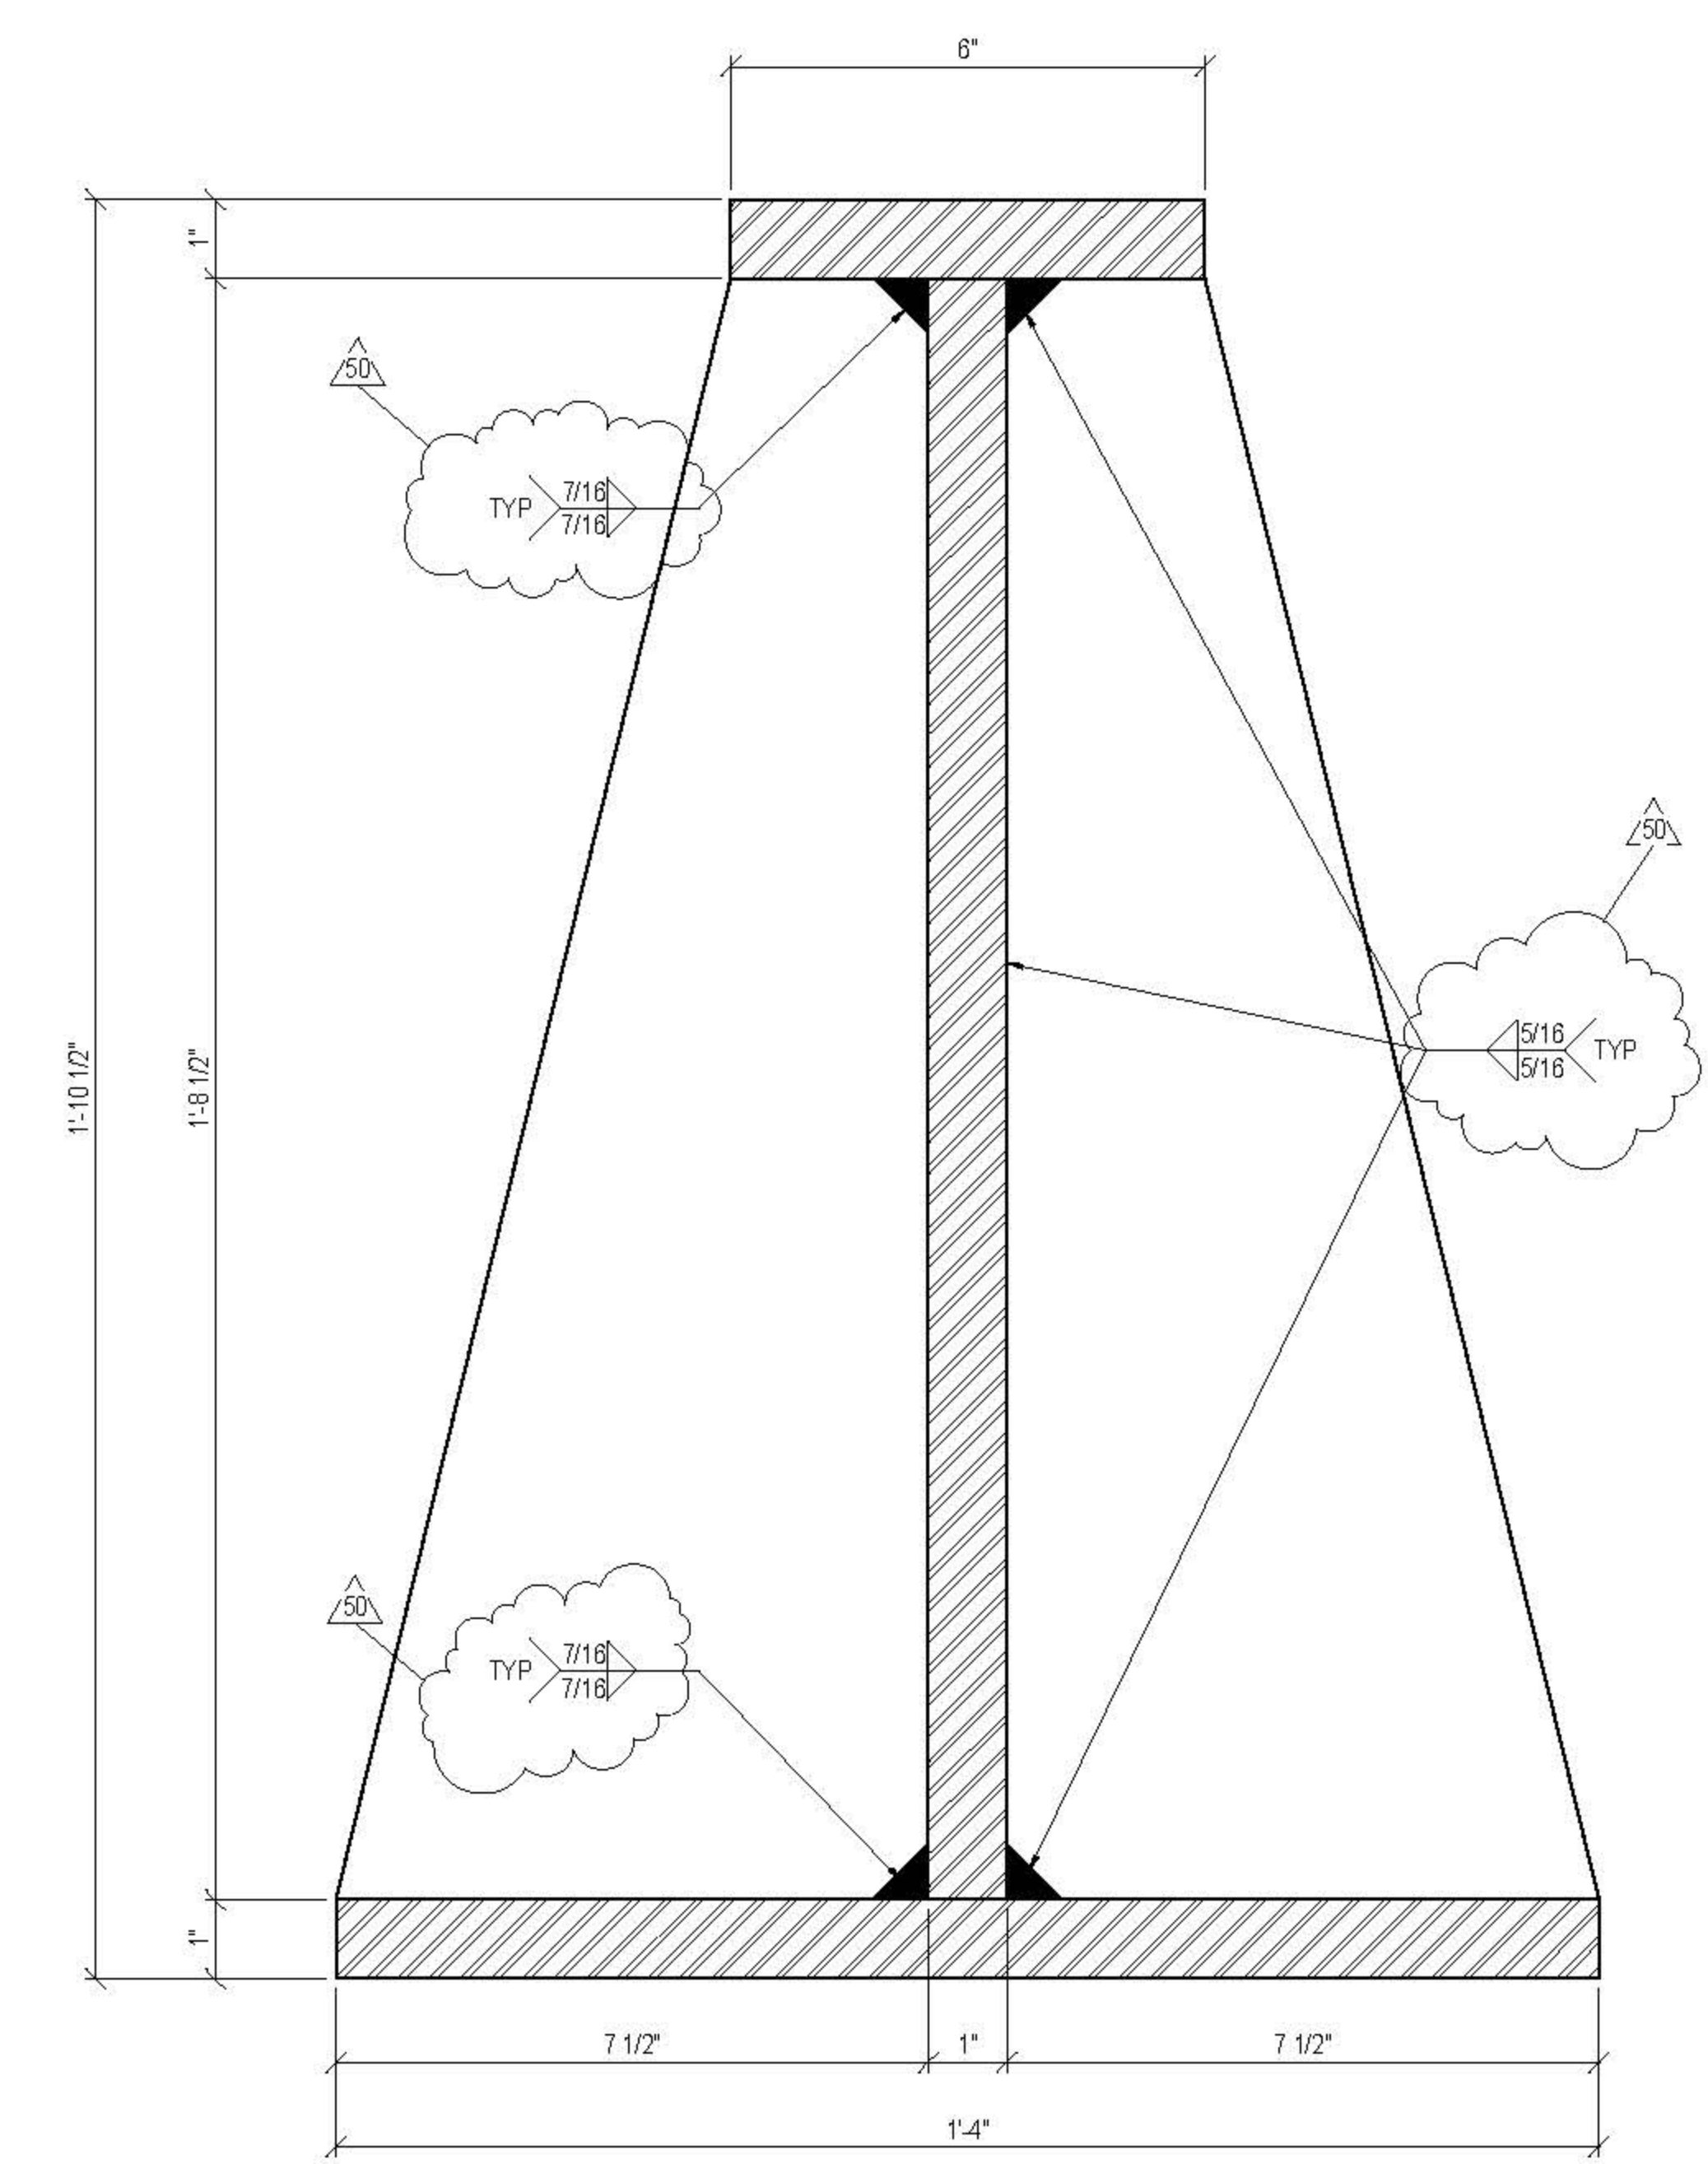


B SECTION B-B
0" = 1'-0"

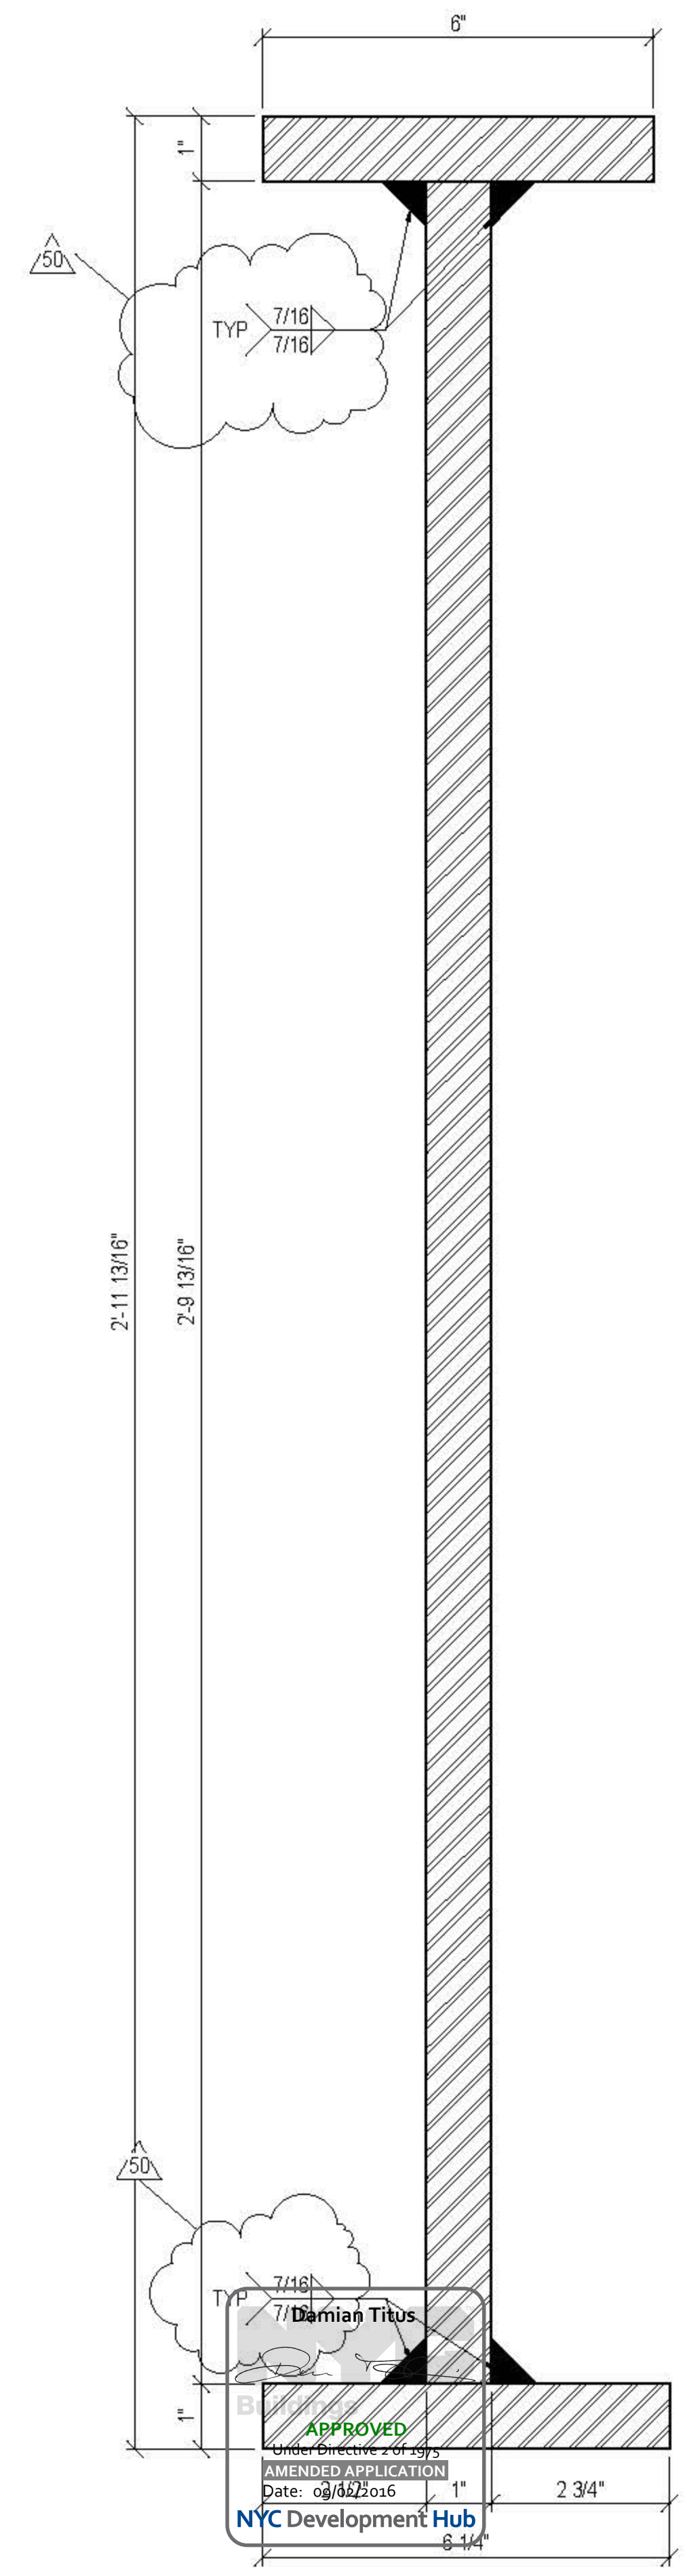

C SECTION C-C
0" = 1'-0"

KEY PLAN

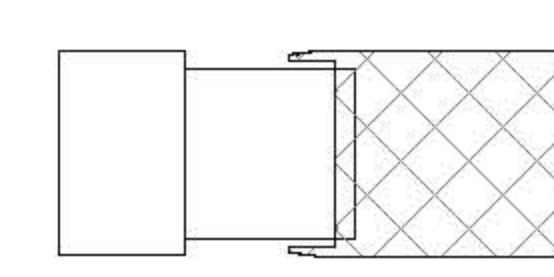

ISSUE PRINTING DATE

ISSUE	PRINTING	DATE	
03	60	DOB AMENDMENT 7	03.19.2016
04	30	DOB AMENDMENT 6	04.09.2016
21		CONSTRUCTION SET	10.08.2015
10	4	100% CONSTRUCTION DOCUMENTS	03.18.2015
9		90% CONSTRUCTION DOCUMENTS	02.16.2015
6		PRELIMINARY JOB SUBMISSION	12.10.2014
1		ADVANCED PROCUREMENT BID SET	06.16.2014



DRAWN BY: **Autmy** CHECKED BY: **Chris**

PROJECT NUMBER: **N1318.00**


TITLE: **DEPLOYED SHED NORTH/SOUTH WALL- QUAD MEMBERS**

DRAWING NO.: **S-790.01**

B.SCAN NO.: **S-790.01**

PENDING COORDINATION DURING DESIGN ASSIST.

KEY PLAN

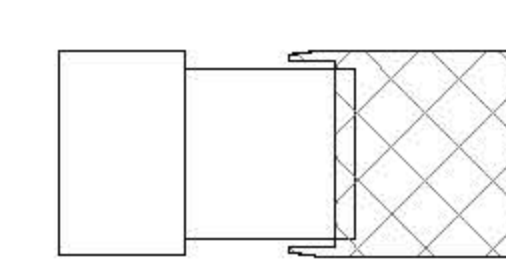

ISSUE PRINTING DATE

ISSUE	PRINTING	DATE
01	60	DOB AMENDMENT 7
02	30	DOB AMENDMENT 6
03	21	CONSTRUCTION SET
04	10	100% CONSTRUCTION DOCUMENTS
05	09	90% CONSTRUCTION DOCUMENTS
06	08	PRELIMINARY CDS SUBMISSION
07	01	ADVANCED PROCUREMENT BID SET

STAMP




DRAWN BY: **Autmy** CHECKED BY: **Chris**
PROJECT NUMBER: **N11318.00**

TITLE: **DEPLOYED SHED EAST WALL - QUAD MEMBER**


DRAWING NO.: **8-794.01**

B.SCAN NO.: **S-794.01**


GEOMETRY, DIMENSIONS AND SURFACE CONTOURING, BLENDING AND INTERSECTION OF SECTIONS ILLUSTRATED IN THE STRUCTURAL DRAWINGS ARE PROVIDED FOR REFERENCE AND GENERATION OF STRUCTURAL ARRANGEMENT AND DETAILS ONLY. THE 3D MODEL ISSUED BY THE ARCHITECT DEFINES THE EXTERIOR SURFACE AND SHALL BE ADHERED TO FOR THE FINAL GEOMETRY. FOR DETAILS OF SECONDARY STEEL, INCLUDING STRUCTURAL CLADDING REFER TO ARCHITECTURE DRAWINGS. IT IS THE RESPONSIBILITY OF THE CONTRACTOR TO IDENTIFY ANY DISCREPANCIES OR AMBIGUITIES FOR DISCUSSION, RESOLUTION AND DIRECTION FROM THE ARCHITECT AND SER.

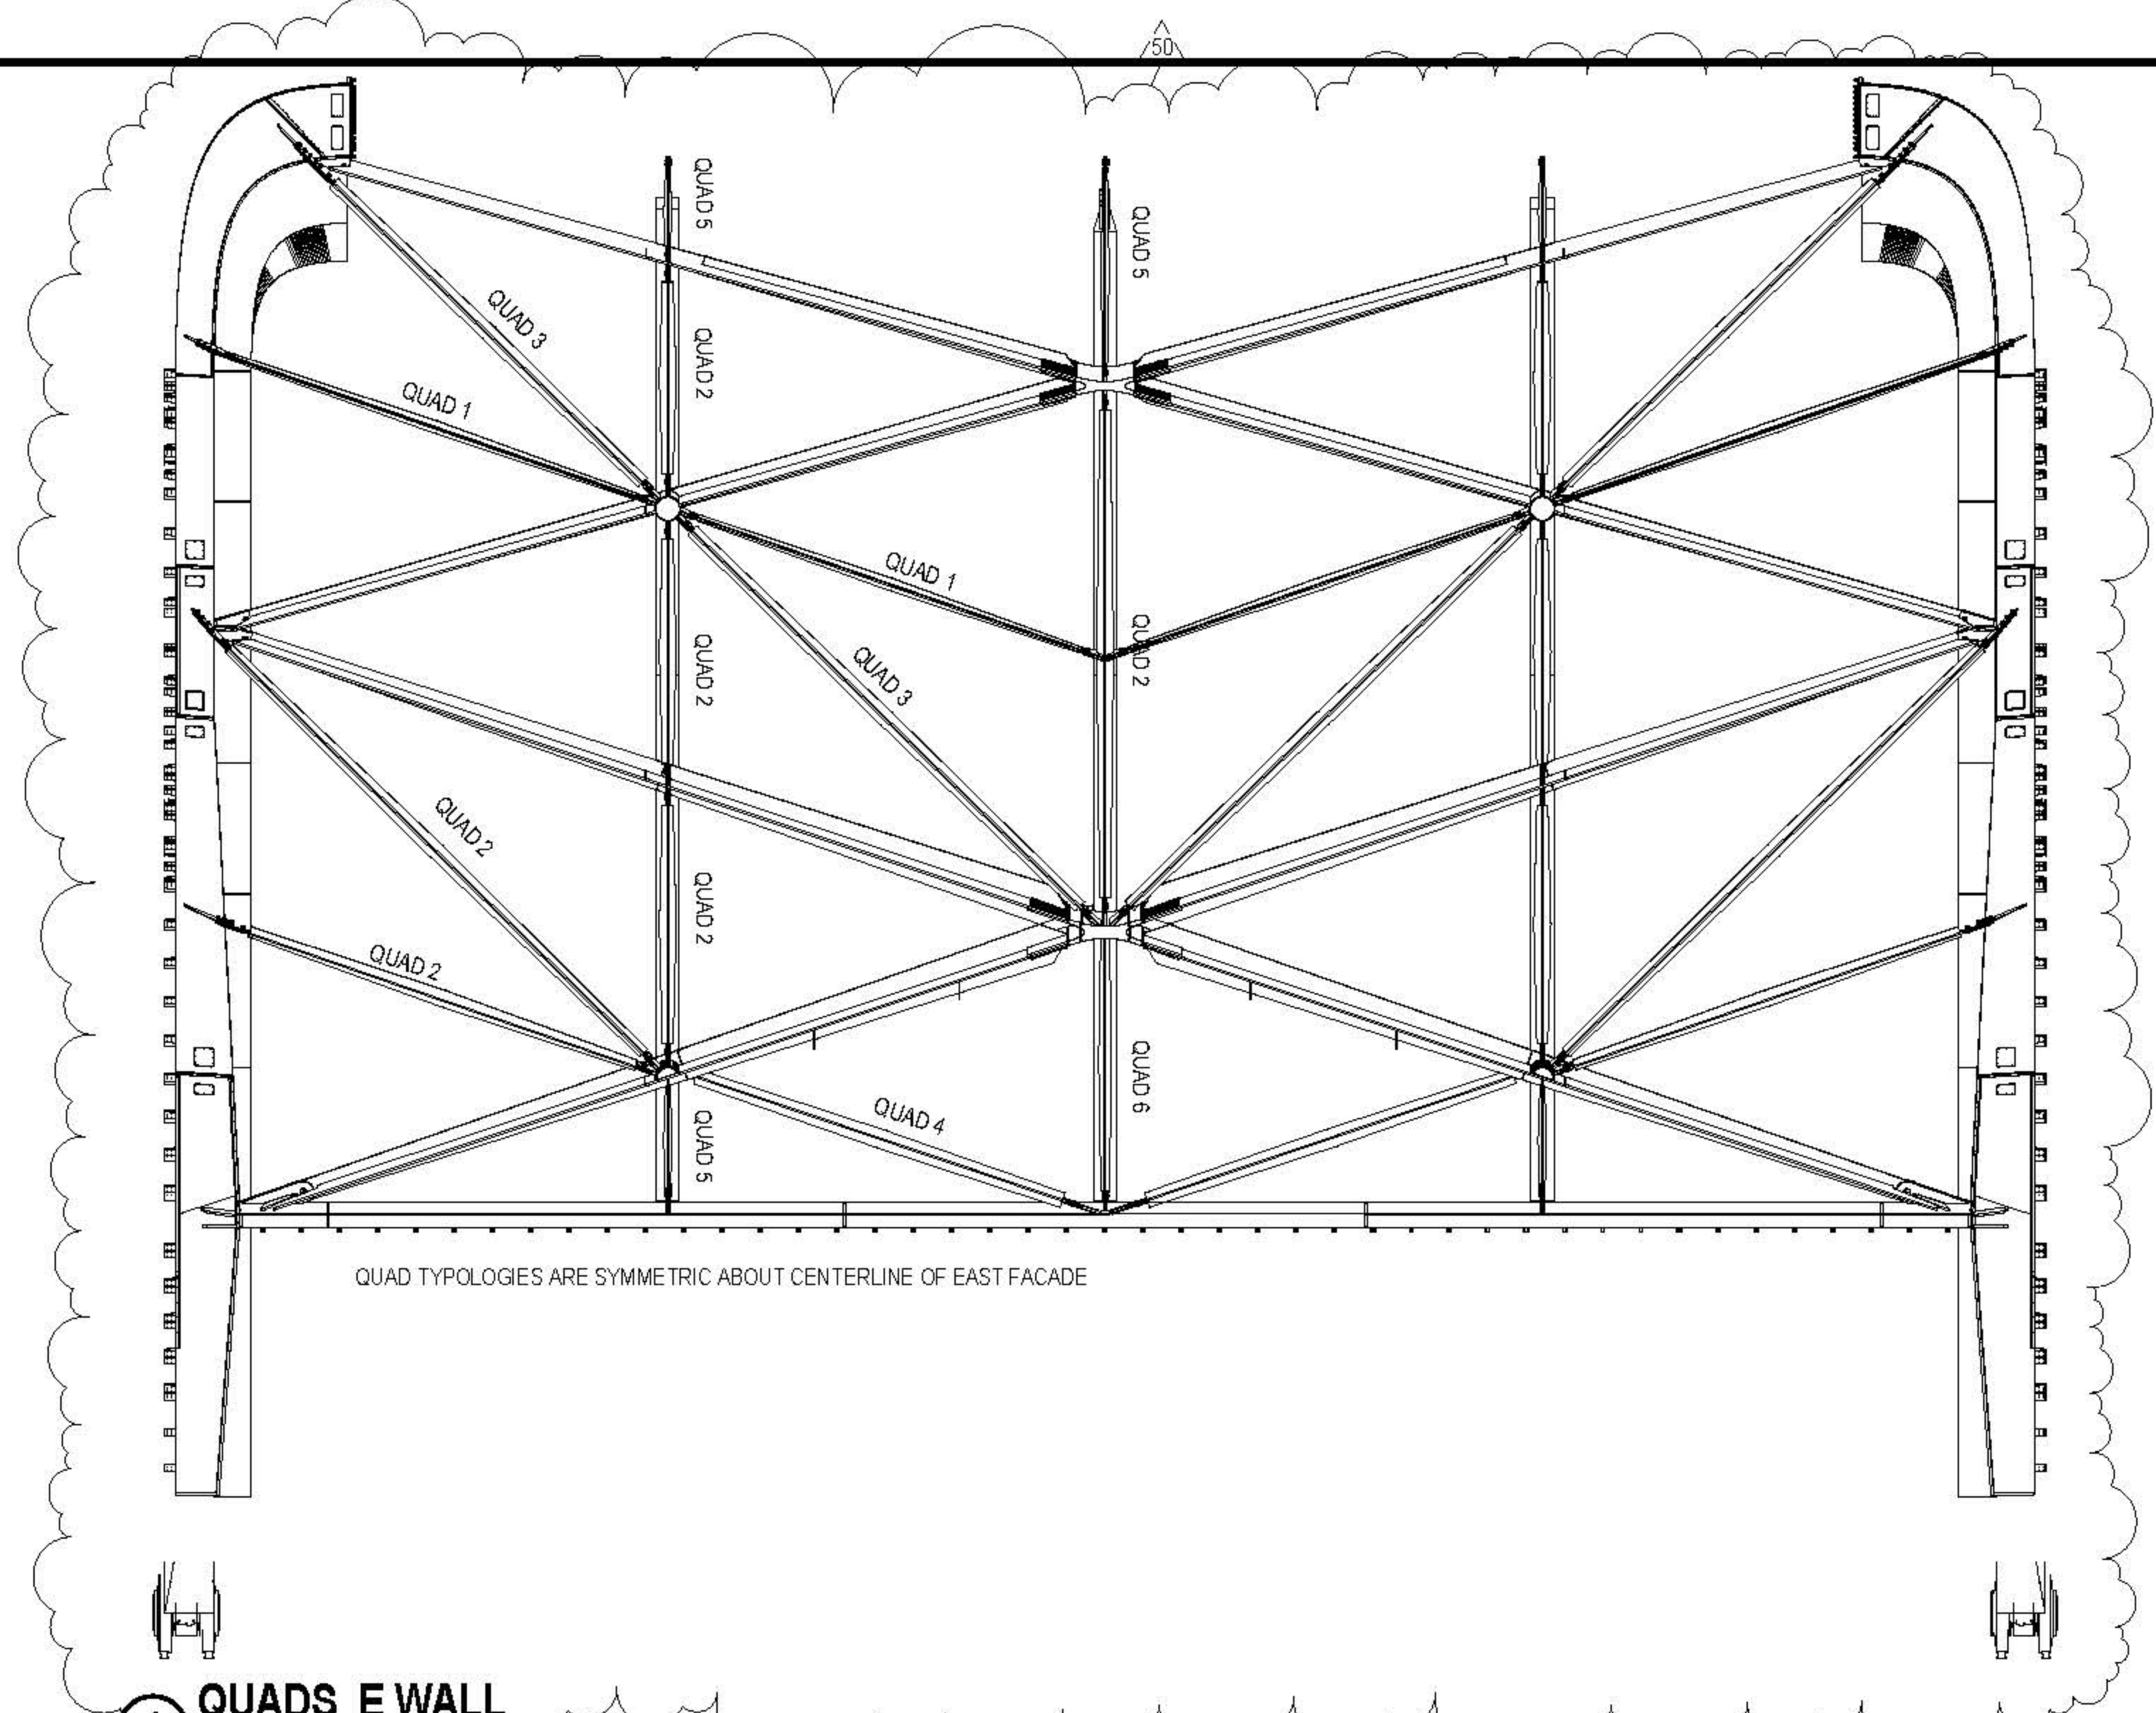


1. QUADS E WALL
3/32" = 1'-0"

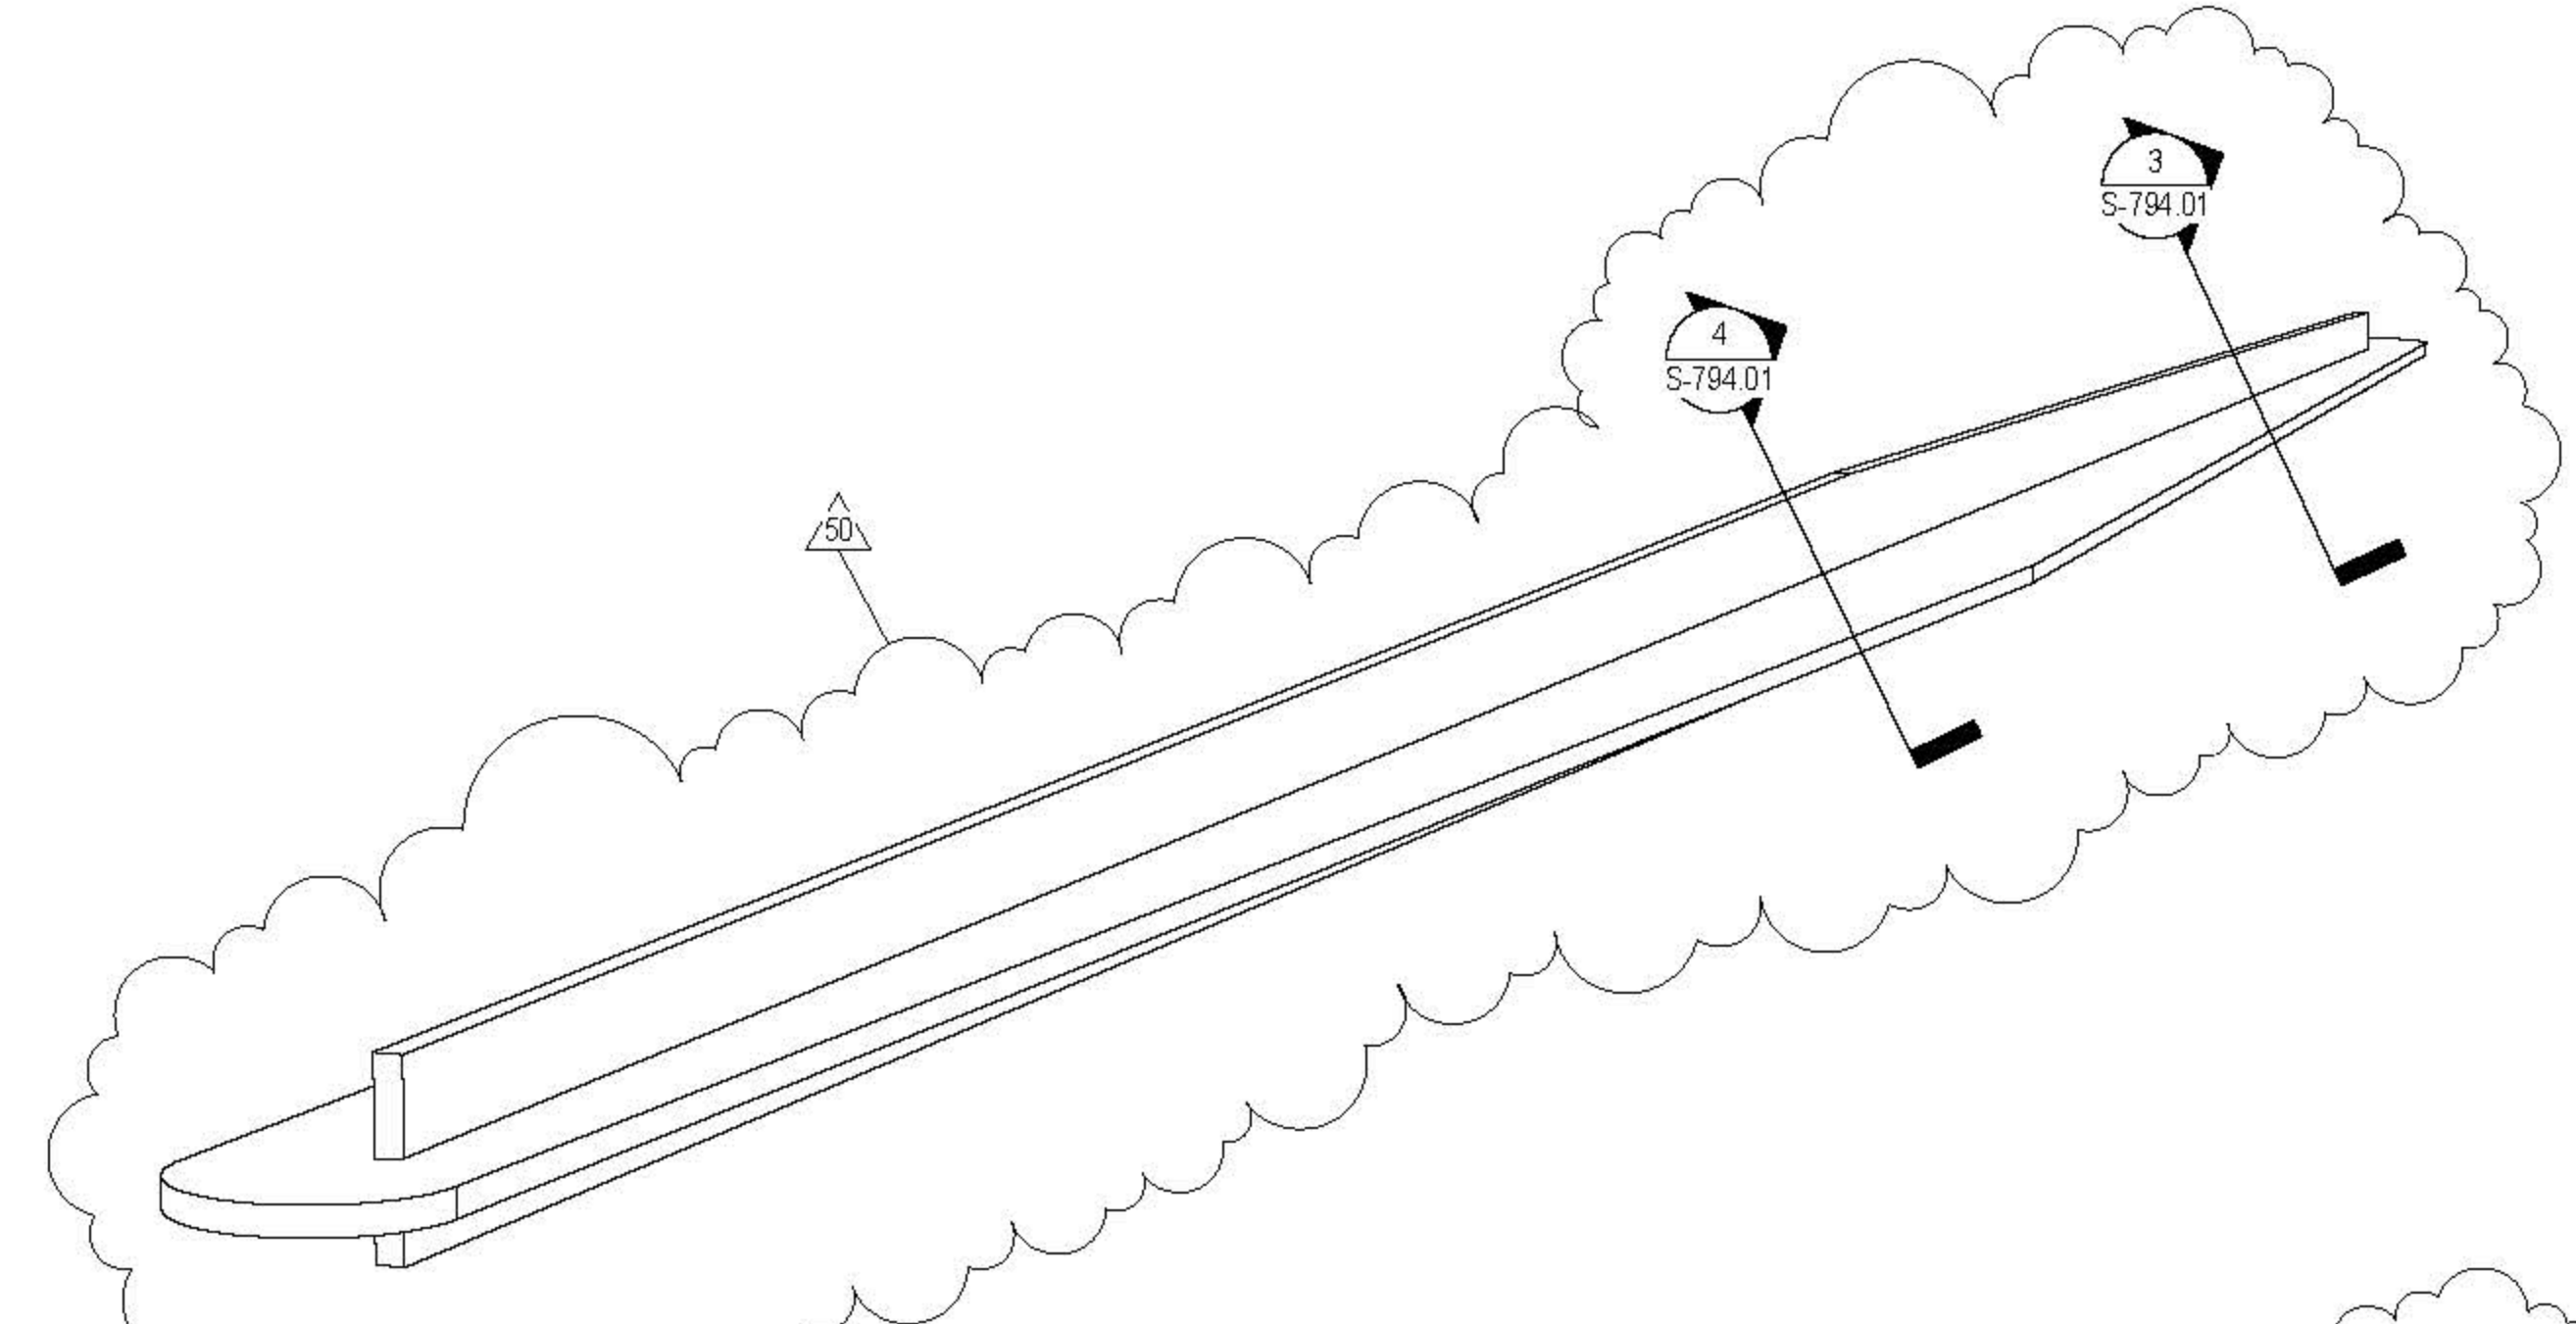


2. TYPICAL QUAD ELEMENT - AXONOMETRIC

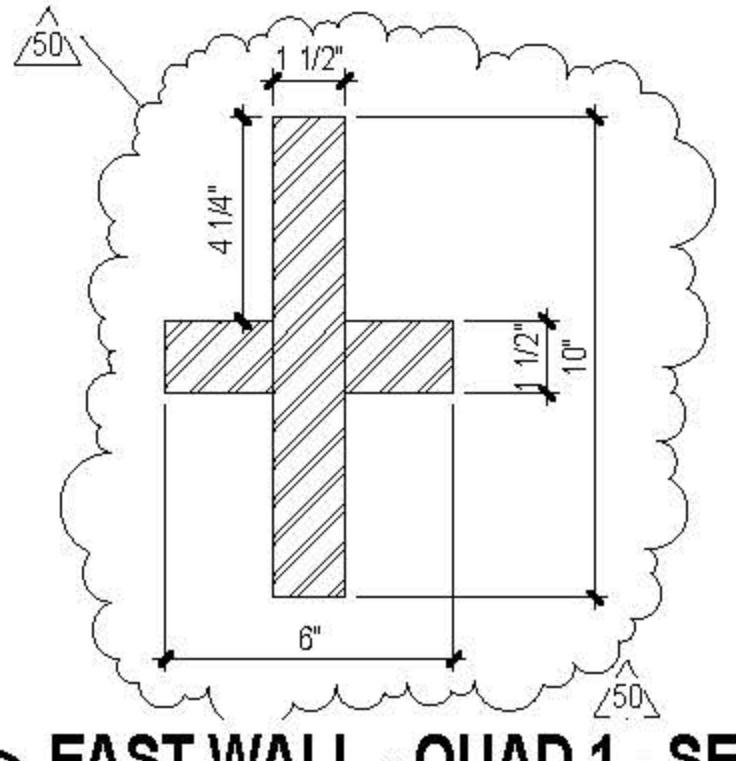


3. EAST WALL - QUAD 1 - SECTION AT JOINT
3/8" = 1'-0"

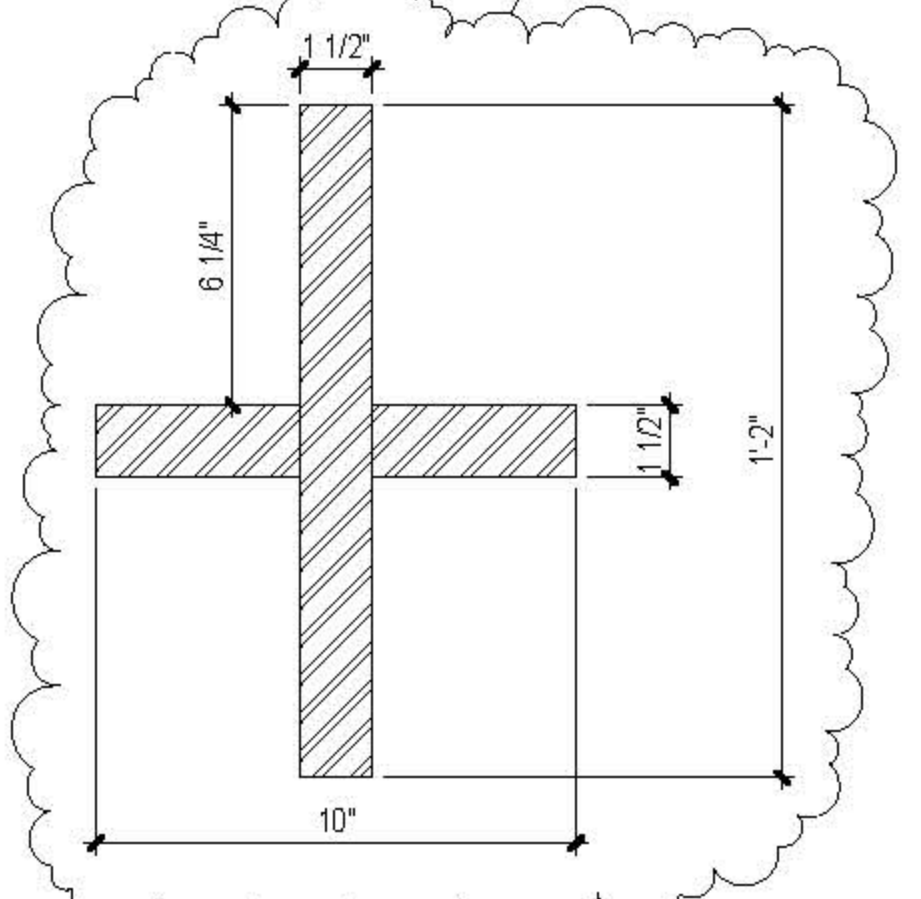


5. EAST WALL - QUAD 2 - SECTION AT JOINT
3/8" = 1'-0"

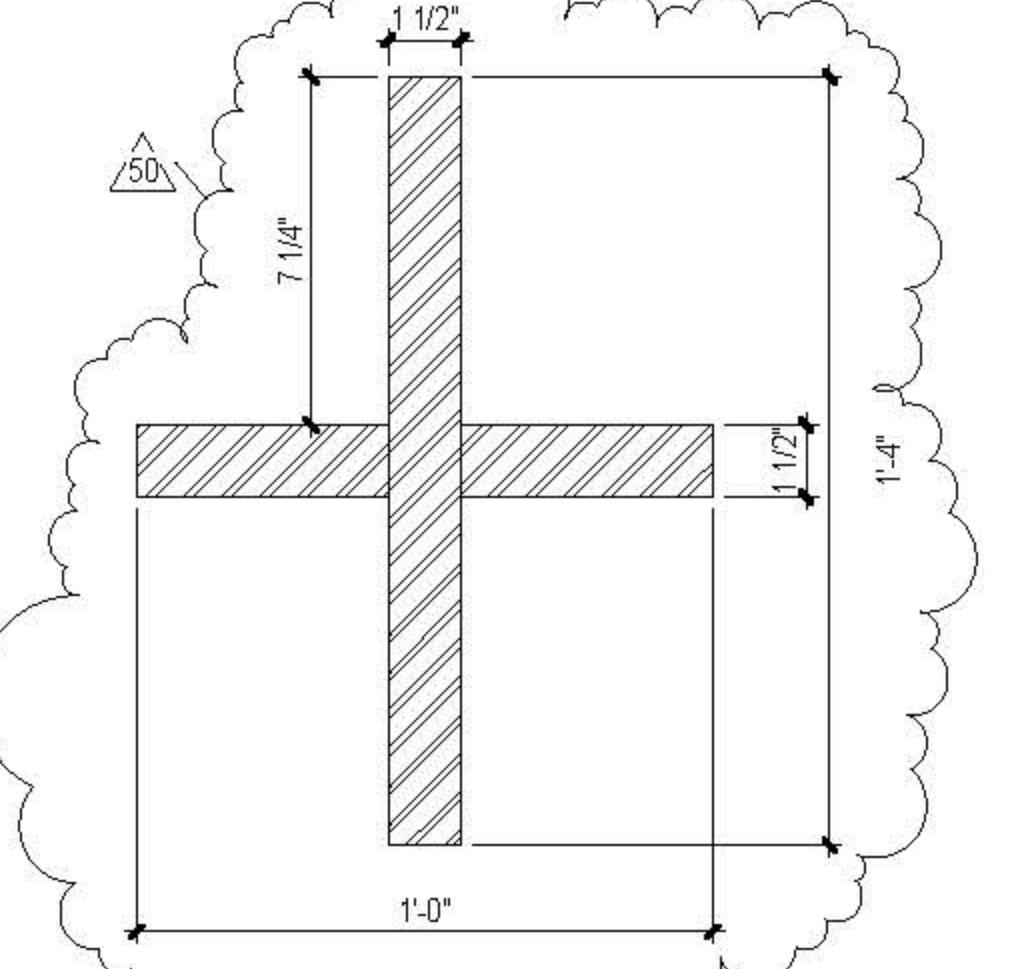


7. EAST WALL - QUAD 3 - SECTION AT JOINT
3/8" = 1'-0"

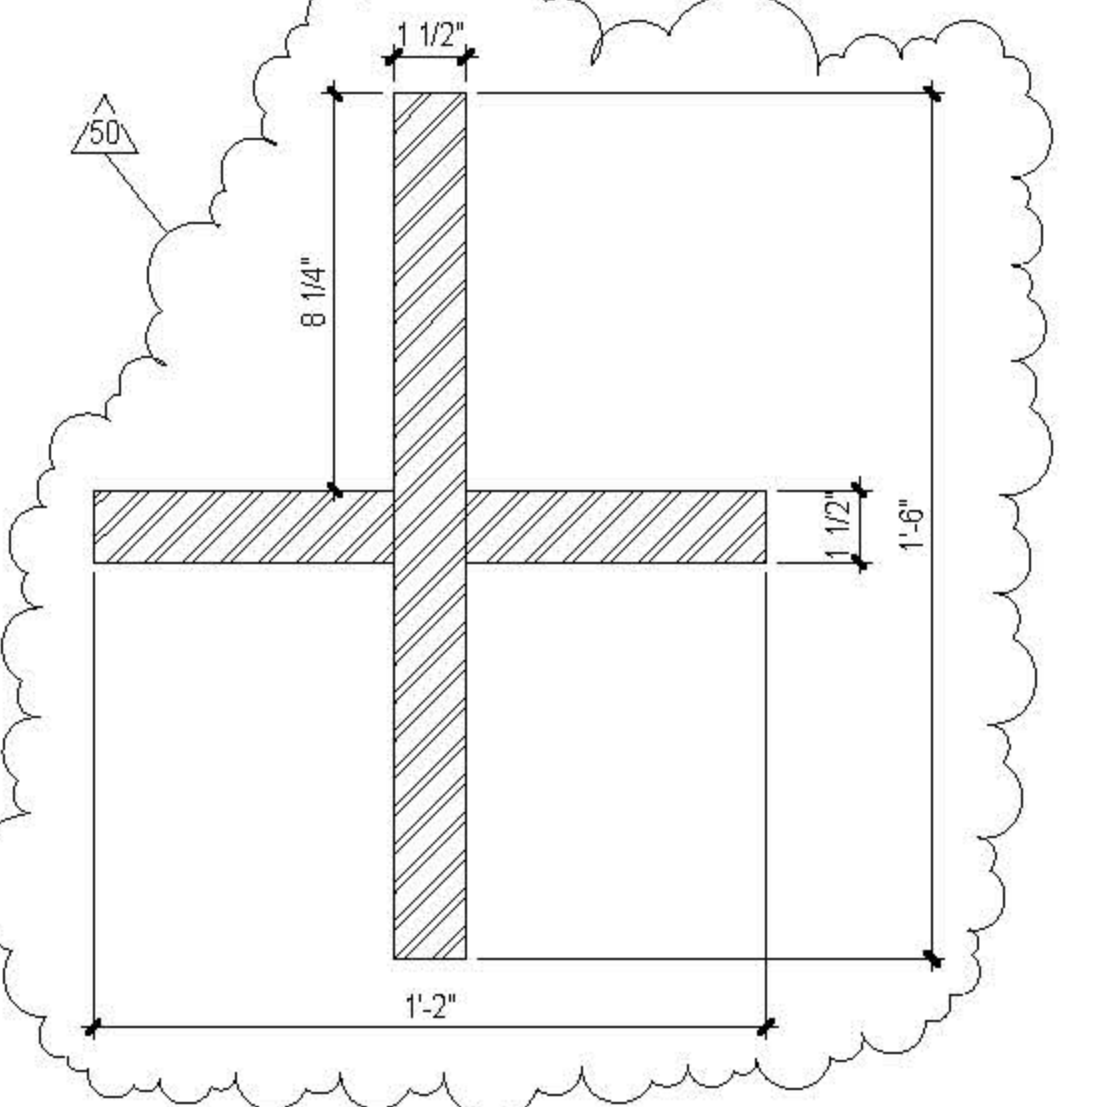


9. EAST WALL - QUAD 4 - SECTION AT JOINT
3/8" = 1'-0"

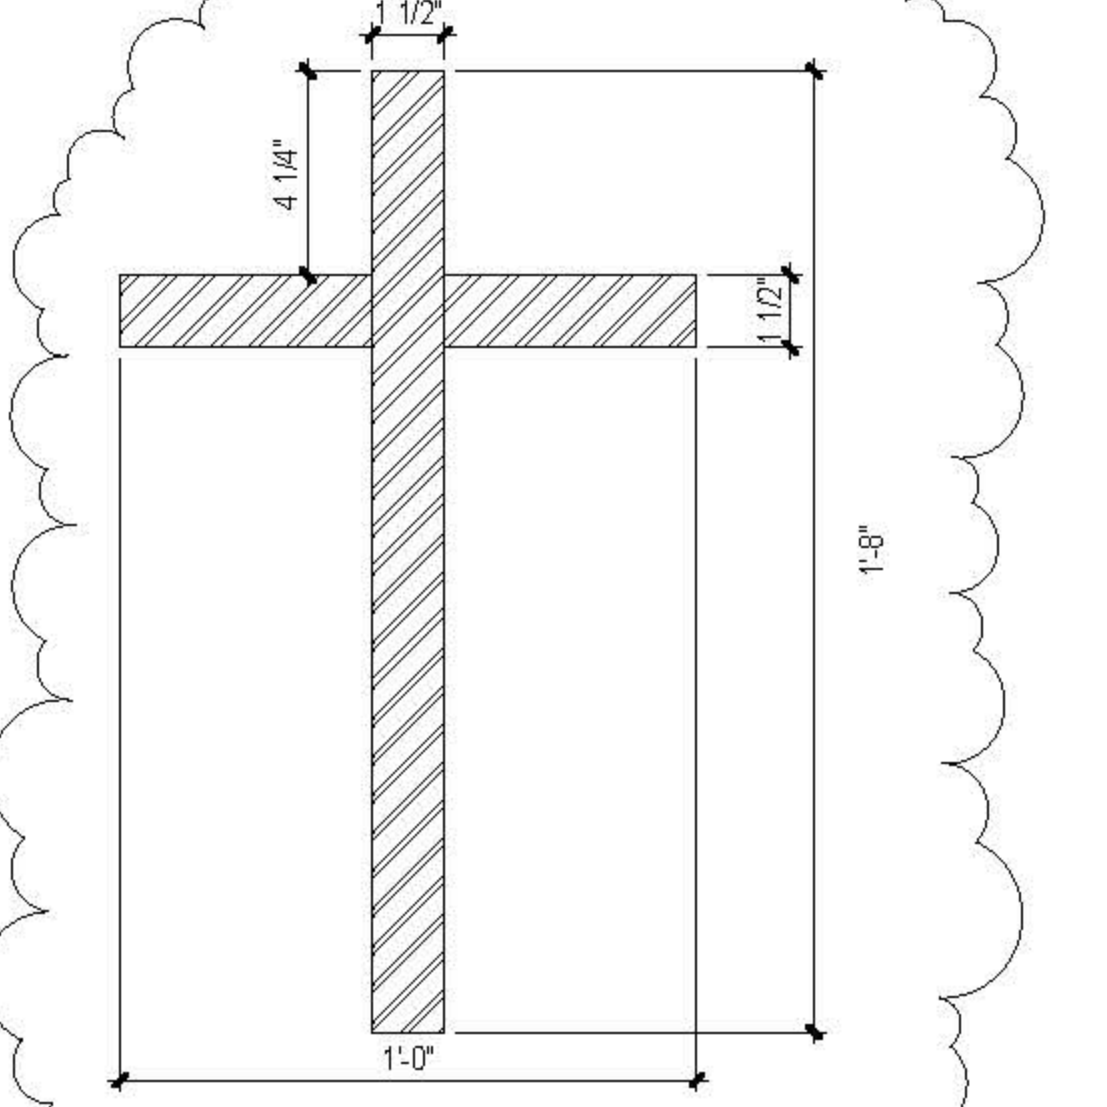


4. EAST WALL - QUAD 1 - MID-SECTION
3/8" = 1'-0"

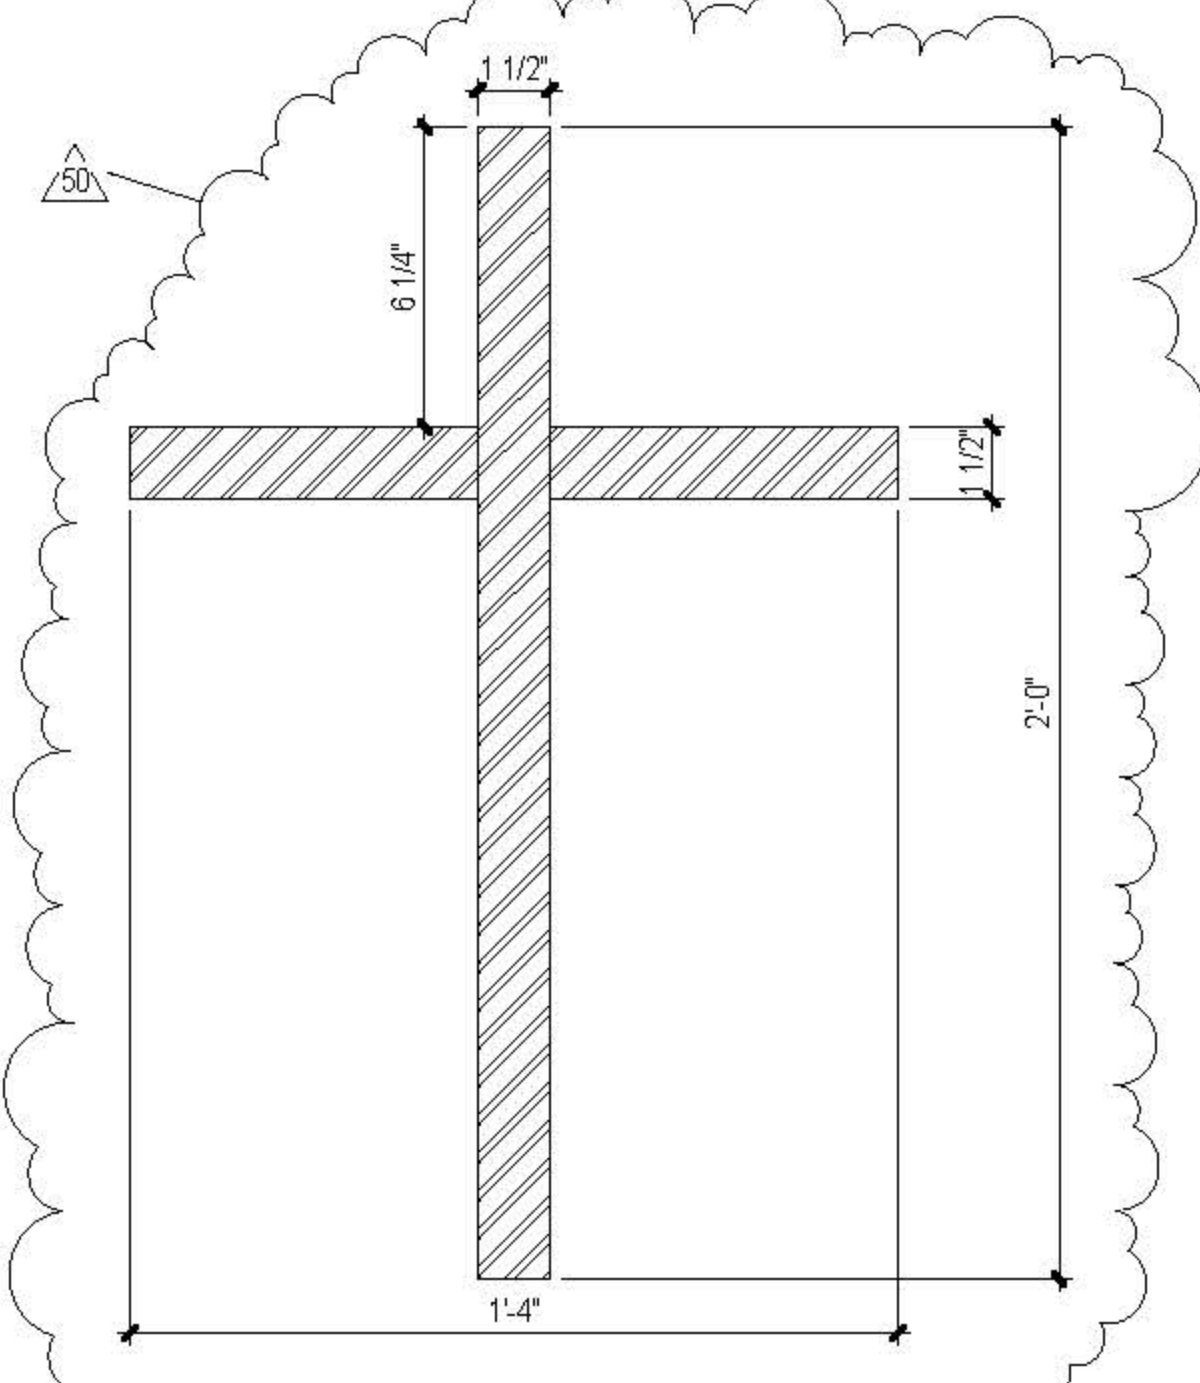


6. EAST WALL - QUAD 2 - MID-SECTION
3/8" = 1'-0"

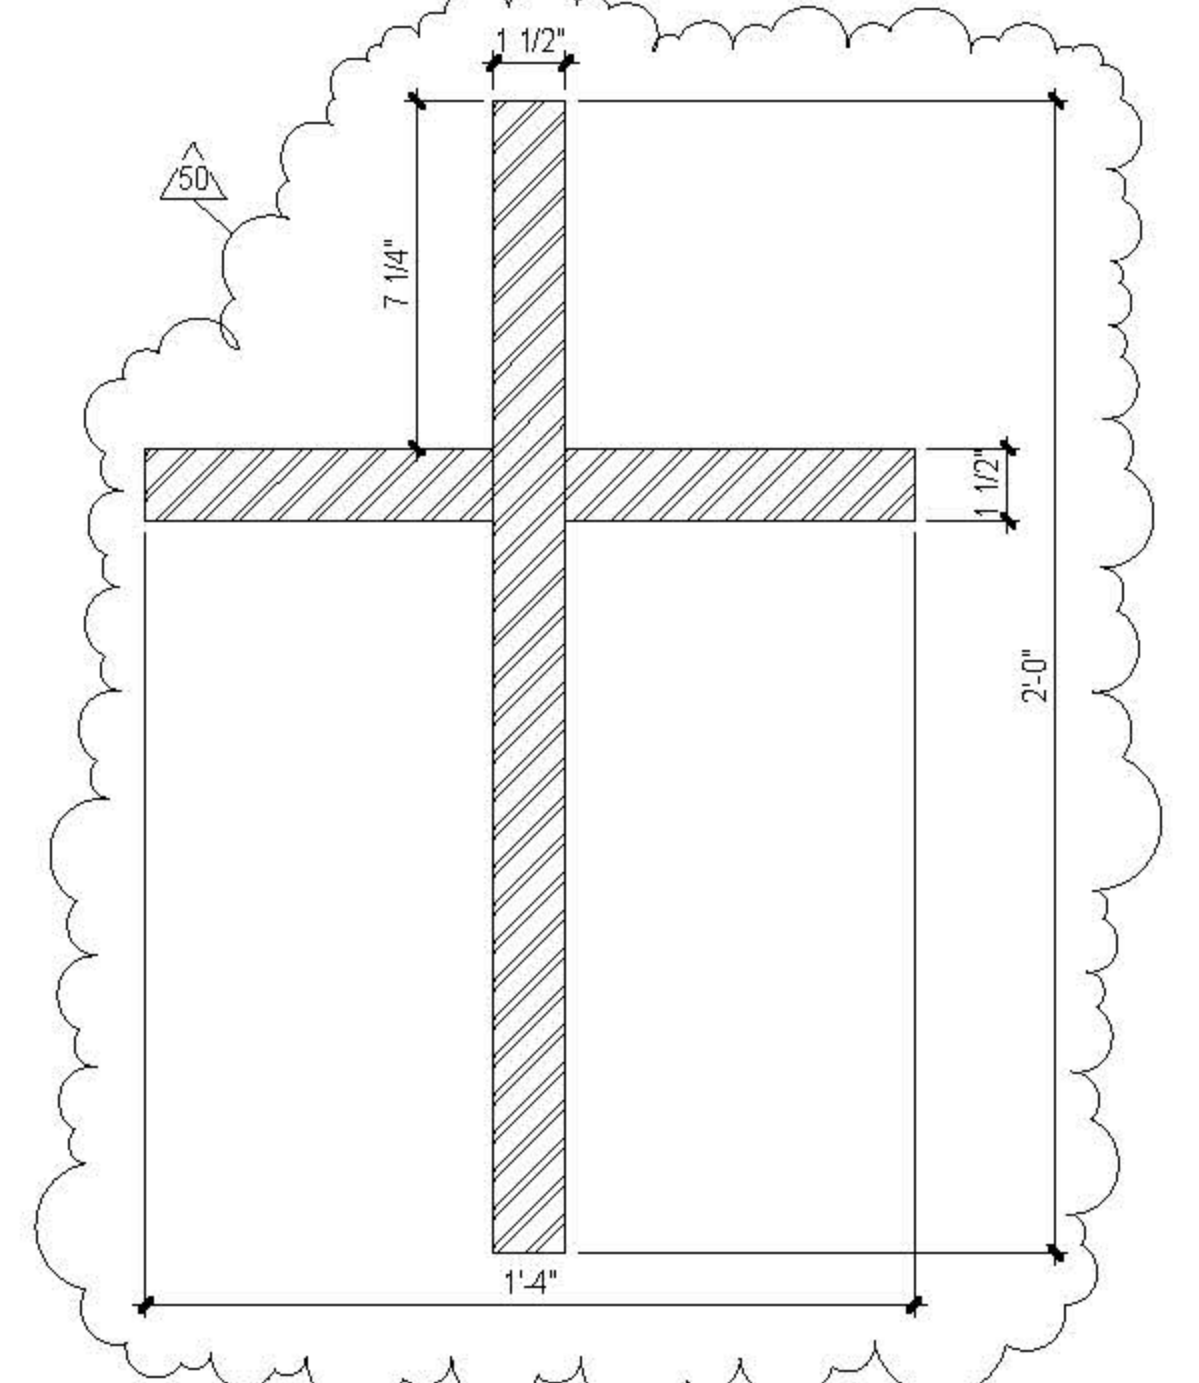


8. EAST WALL - QUAD 3 - MID-SECTION
3/8" = 1'-0"

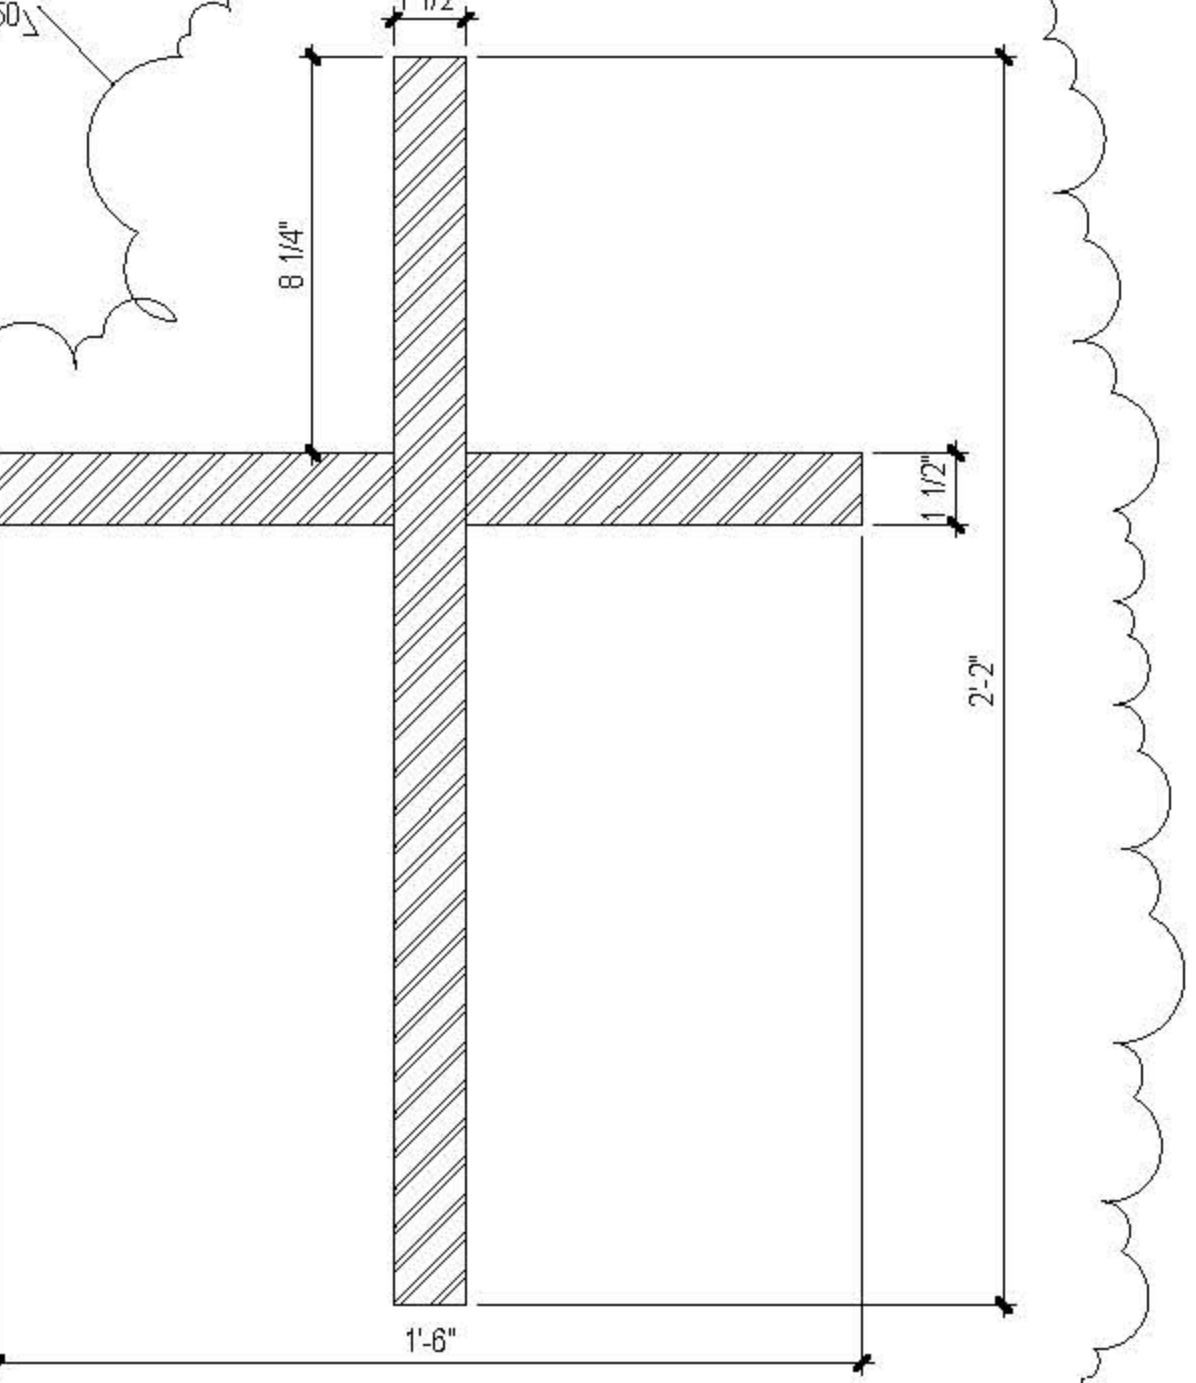


10. EAST WALL - QUAD 4 - MID-SECTION
3/8" = 1'-0"

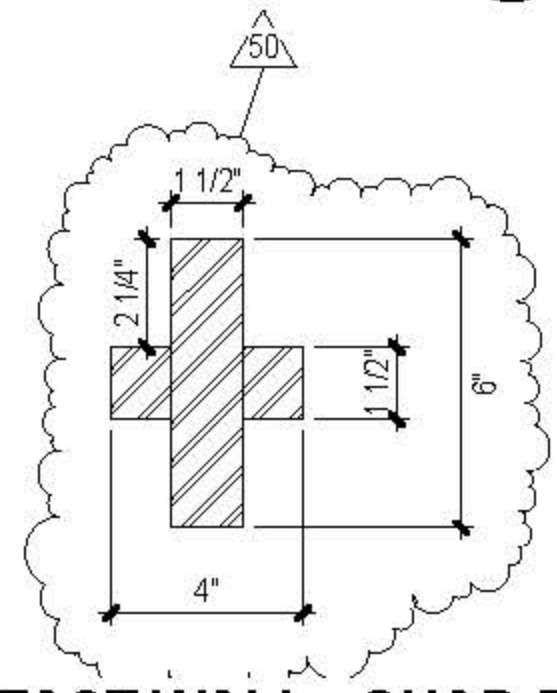


11. EAST WALL - QUAD 5 - SECTION AT JOINT
3/8" = 1'-0"

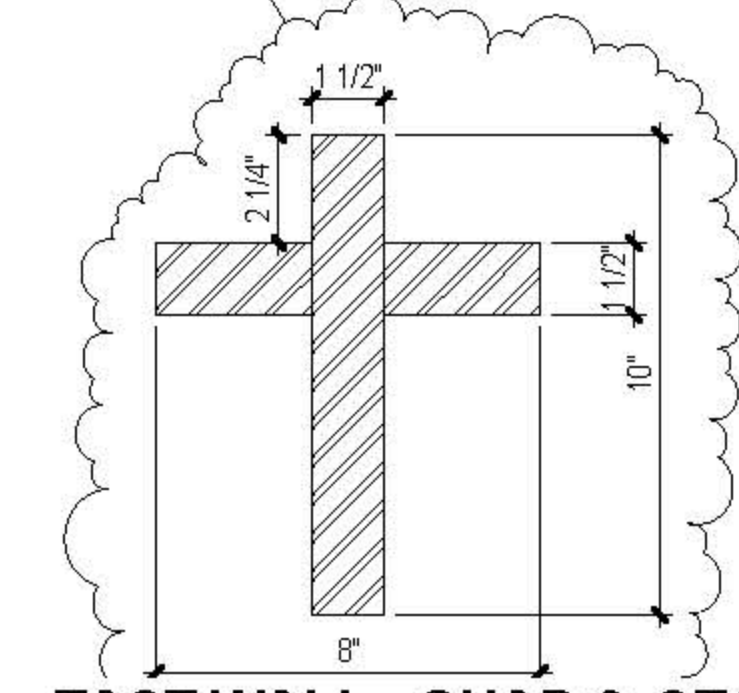

13. EAST WALL - QUAD 6 - SECTION AT JOINT
3/8" = 1'-0"

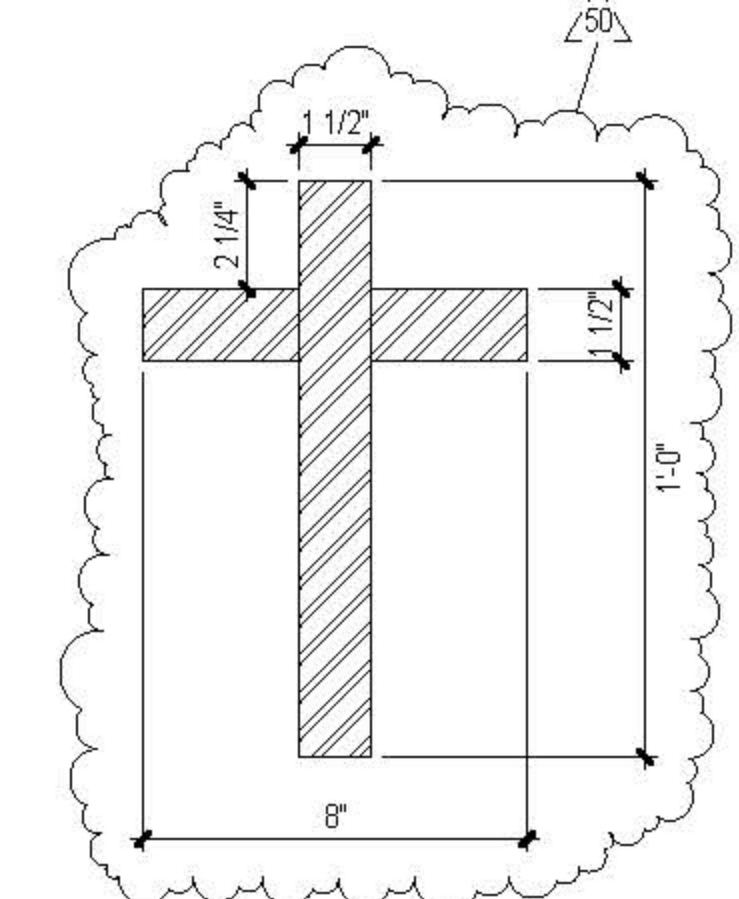


12. EAST WALL - QUAD 5 - MID-SECTION
3/8" = 1'-0"

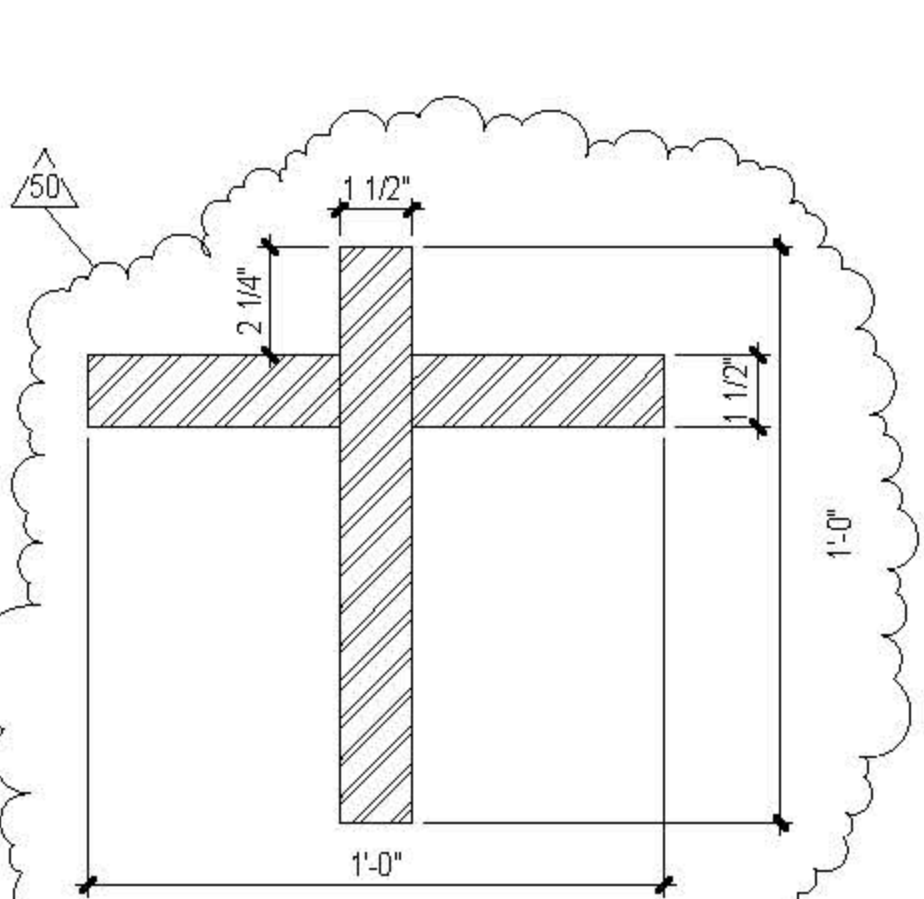

14. EAST WALL - QUAD 6 - MID-SECTION
3/8" = 1'-0"

ALL EAST WALL QUAD ELEMENTS ARE 65 KSI STEEL.

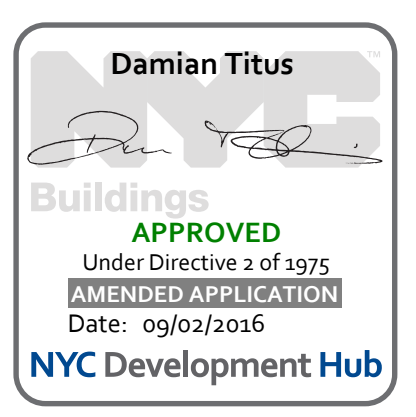

CULTURE SHED
545 West 30th Street
New York, New York 10001

OWNER
CULTURE SHED INC.

ARCHITECTS
Oller Sclafano + Renfro Architects, PC
601 West 26th Street #815
New York, New York 10001
T: 212.260.7971

rockwellgroup
61 Union St. West, 6th Fl.
New York, New York 10003
T: 212.463.0334
F: 212.463.0335

STRUCTURAL ENGINEER
Thornton Tomasetti
51 Madison Avenue
New York, New York 10010
T: 917.861.7800
F: 917.861.7801

MEP ENGINEER
Jans Baum & Bolles
60 Pine Street
New York, New York 10005
T: 212.530.9300
F: 212.266.6944

FACADE CONSULTANT
Thornton Tomasetti
51 Madison Avenue
New York, New York 10010
T: 917.861.7800
F: 917.861.7801

KINETICS ENGINEER
Hardess & Hanover
1501 Broadway
New York, New York 10036
T: 212.944.1150
F: 212.391.0297

LIGHTING DESIGNER
Tilston Design Associates
40 North Street #150
New York, New York 10013
T: 212.675.7760

THEATRE PLANNING & DESIGN
Fisher Dodge Associates
22 West 15th Street
New York, New York 10011
T: 212.691.3001

LIFE SAFETY
Code Consultants, Inc.
215 West 43rd St., 15th Fl.
New York, New York 10018
T: 212.216.9596

ENERGY MODEL/LEED
Vindian
60 Washington Street
Norwalk, CT 06854
T: 203.298.1411

ACOUSTIC/AUDIO-VISUAL
Avalon
53 North Main Street
South Norwalk, CT 06854
T: 347.210.5540

VERTICAL TRANSPORTATION
Van Duusen & Associates
5 Regent Street, Suite 524
Larkington, NJ 07038
T: 973.994.9220


SPECIFICATIONS
Construction Specifications Inc.
PO Box 489
227 Fenwick Road
Morganville, NJ 07751
T: 732.970.0700
F: 732.970.0700

SECURITY
Duchella Venter & Santoro
1100 Sherman Avenue
Hartford, CT 06114
T: 203.286.6490


WATERPROOFING
James R. Gahfort AIA Consulting Architects PC
104 West 27th Street
New York, NY 10001
T: 212.736.3344

FACADE MAINTENANCE
Frank Engineering PLLC
166 Area Street
New York, NY 10005
T: 212.698.3000

BRANDING GRAPHICS
21st Global Design Consultancy
180 Varck Street 15th Floor
New York, NY 10014
T: 212.647.1170

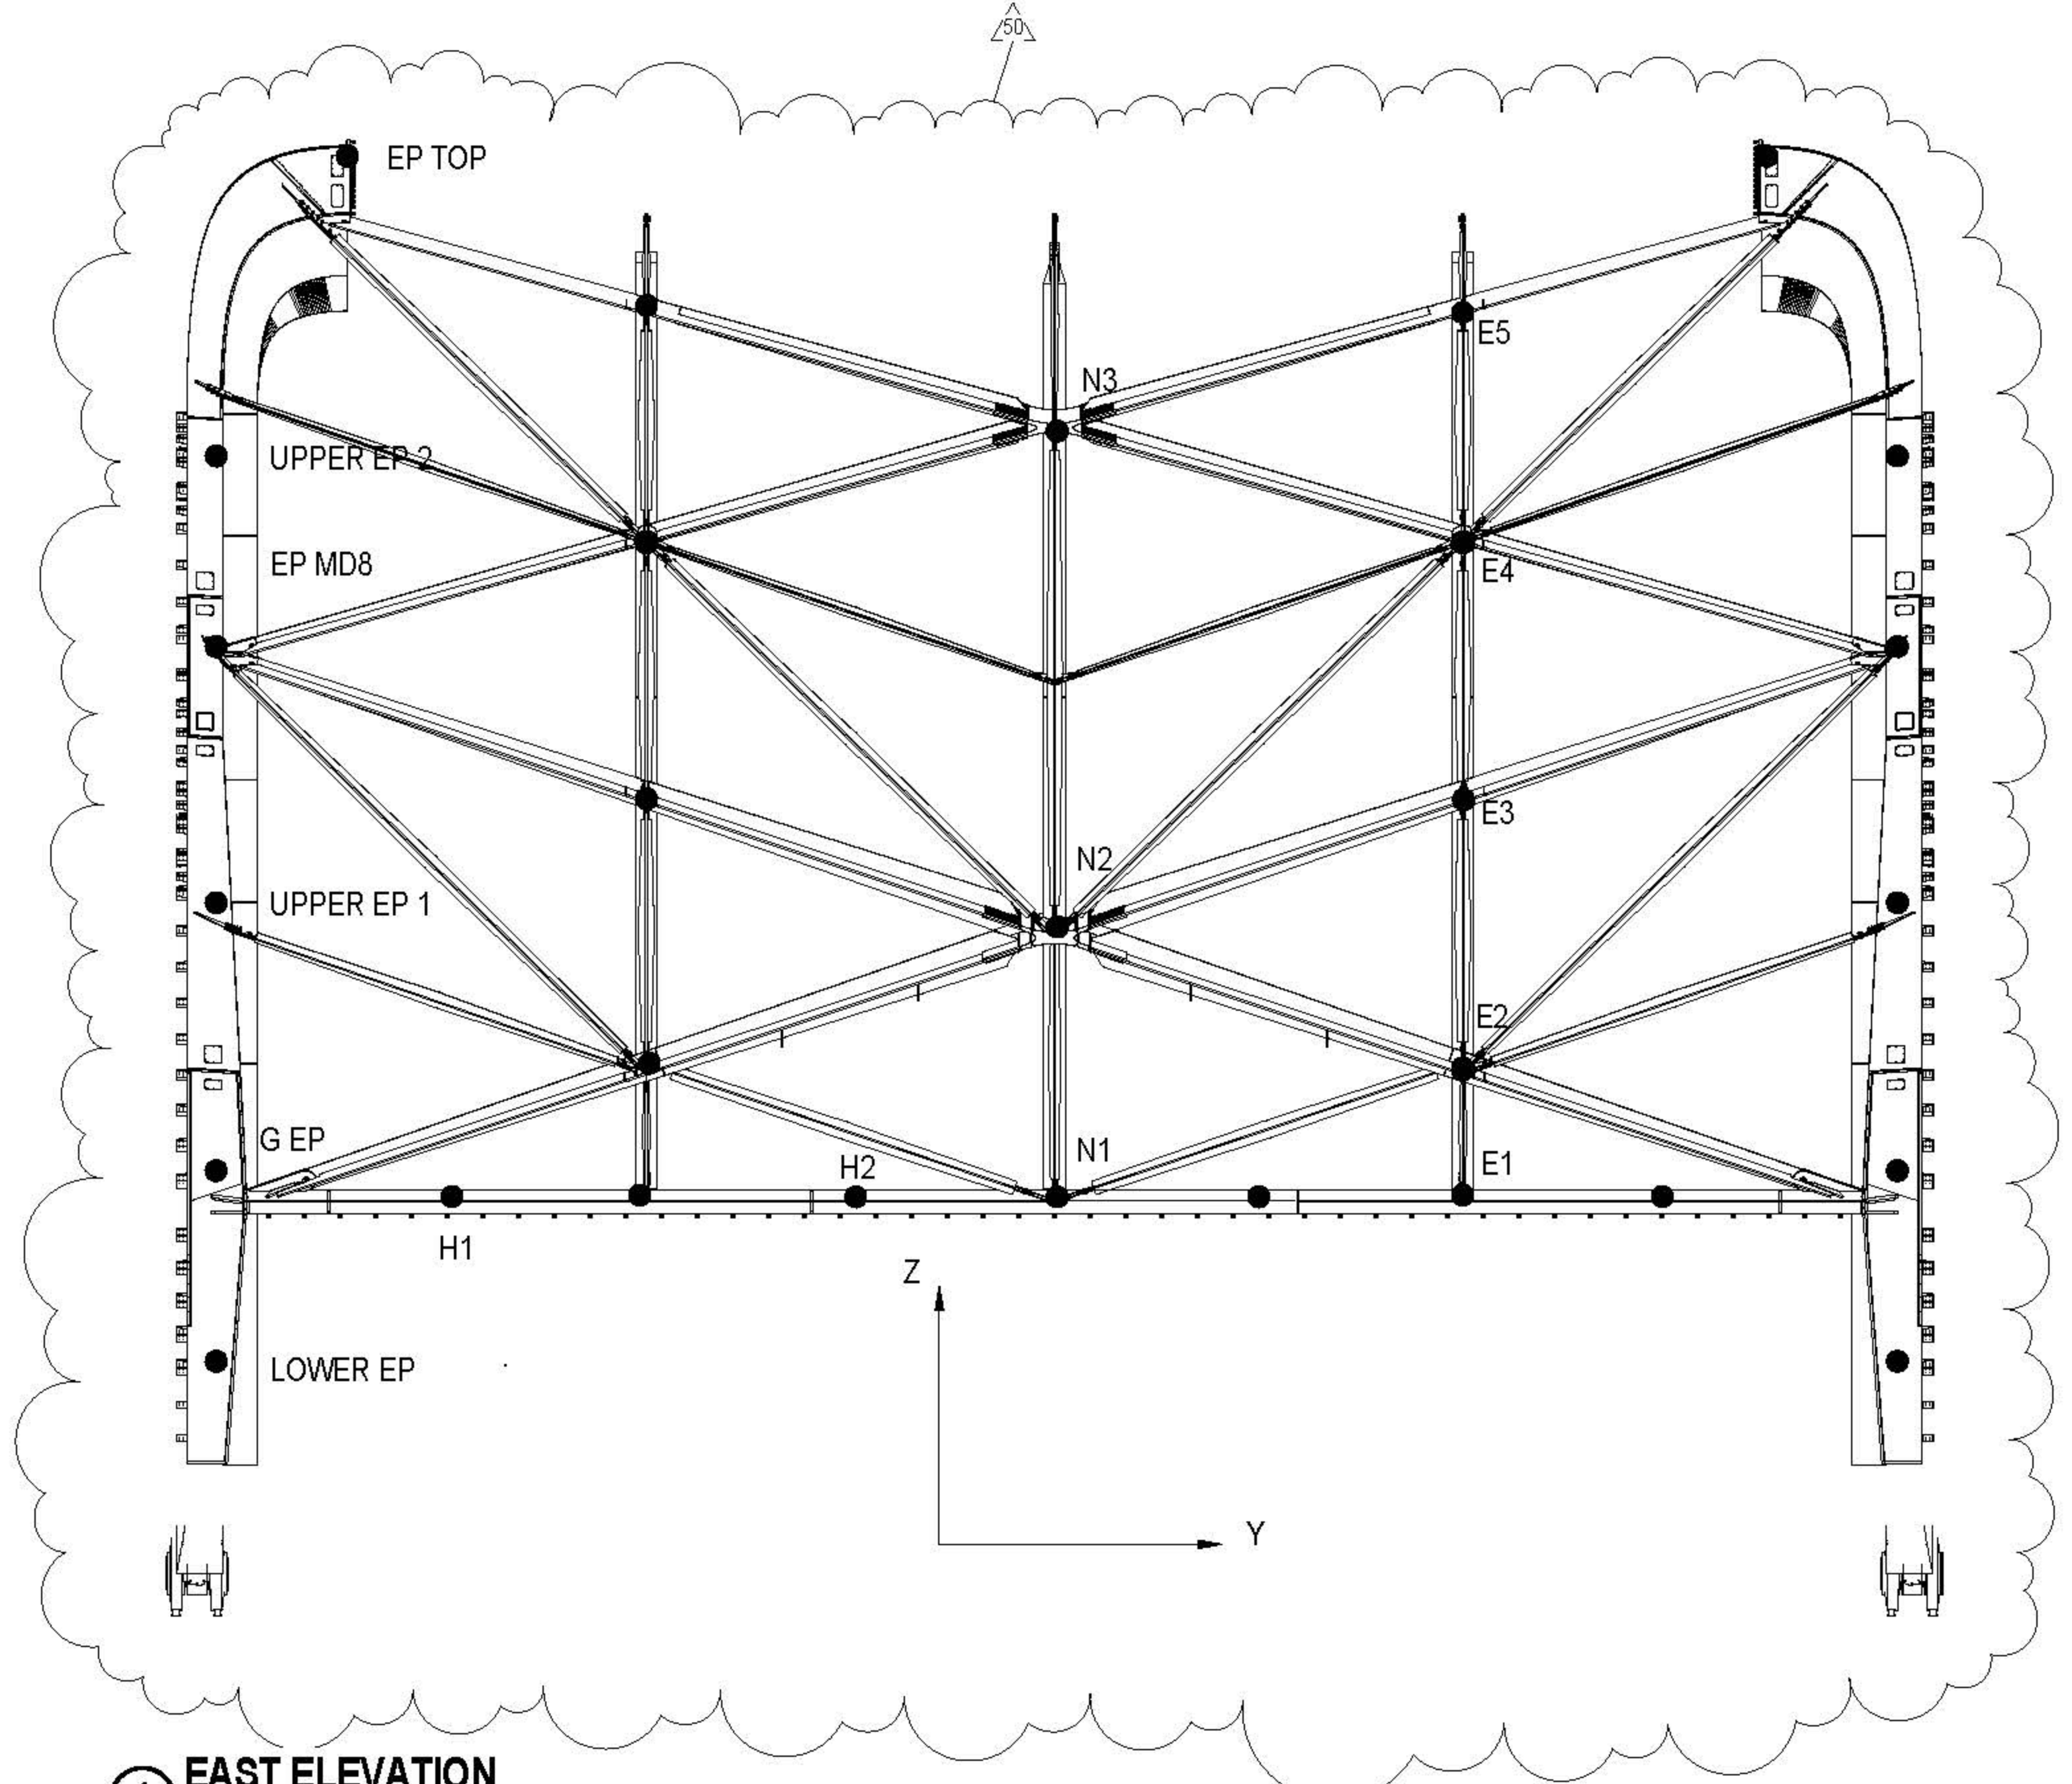

1 EAST ELEVATION
3/32" = 1'-0"

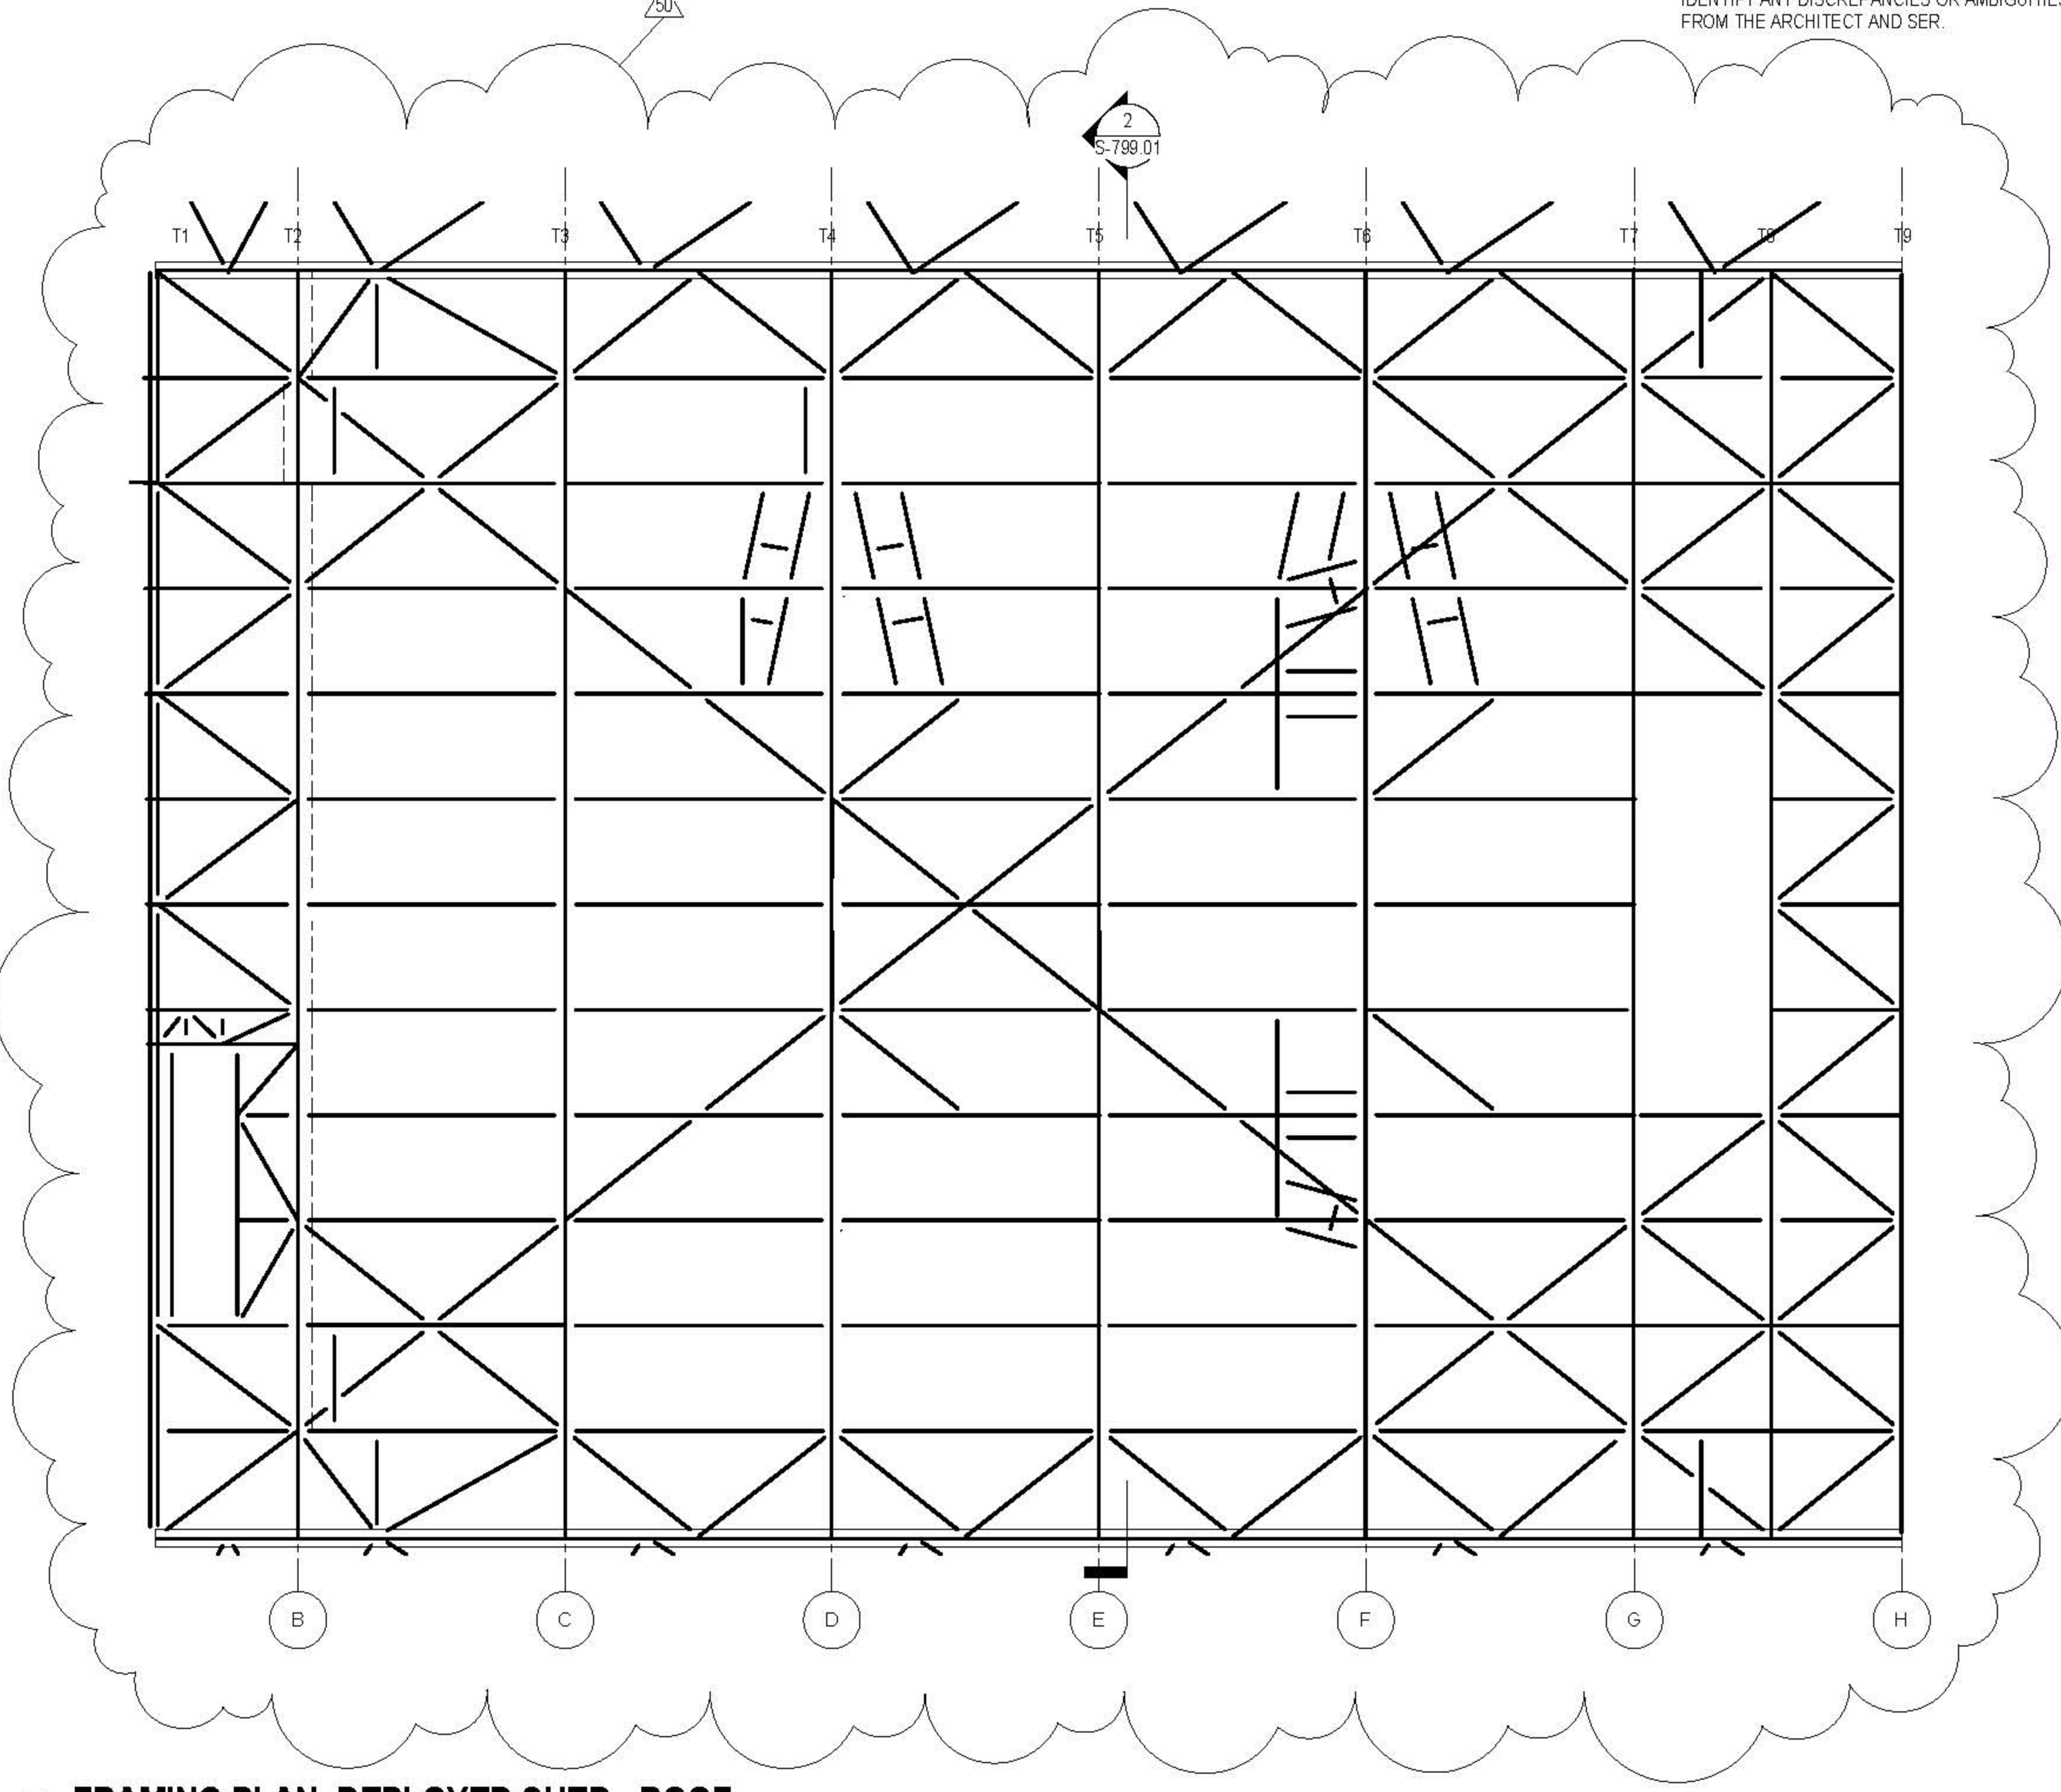

3 FRAMING PLAN, DEPLOYED SHED - ROOF
3/32" = 1'-0"

JOINT	X	Y	Z
	in	in	in
E1 N	-1.5	0.2	-2.7
E1 S	-1.4	0.3	-2.7
E2 N	-1.7	0.2	-0.3
E2 S	-1.9	0.3	-0.2
E3 N	-1.9	0.4	-0.3
E3 S	-2.0	0.1	-0.2
E4 N	-1.6	0.2	-0.9
E4 S	-1.7	0.3	-0.9
E5 N	-0.4	0.7	-1.8
E5 S	-0.5	-0.2	-1.8
EP MD 8 N	-1.8	0.4	-0.1
EP MD 8 S	-1.9	0.1	-0.1
EP TOP N	0.1	0.2	-1.1
EP TOP S	0.1	0.3	-1.2
G EP N	-1.6	0.2	-0.1
G EP S	-1.7	0.3	-0.1
H1 N	-1.6	0.2	-1.4
H1 S	-1.5	0.3	-1.4
H2 N	-1.4	0.2	-3.6
H2 S	-1.3	0.3	-3.6
LOWER EP N	-0.5	0.1	0.0
LOWER EP S	-0.6	0.2	-0.1
N1	-1.3	0.3	-3.8
N2	-1.8	0.2	0.1
N3	-1.2	0.2	-0.6
UPPER EP 1 N	-2.2	0.3	0.1
UPPER EP 1 S	-2.2	0.2	0.0
UPPER EP 2 N	-1.3	0.6	-0.2
UPPER EP 2 S	-1.4	-0.2	-0.2

4 EAST WALL DEFLECTIONS

DEFLECTIONS ARE PROVIDED BASED ON ASSUMED PERMANENT LOADS. PERMANENT DEFLECTIONS ARE PROVIDED TO ASSIST CONTRACTOR IN DETERMINING REQUIRED PRECAMBERS CONSISTENT WITH PROPOSED ERECTION STRATEGY IN ORDER TO ACHIEVE THE FINAL GEOMETRY PER THE ISSUED 3D MODEL AND IN ACCORDANCE WITH THE ALLOWABLE TOLERANCES DESCRIBED IN S-005 THROUGH S-010.

2 TRUSS 05
1/8" = 1'-0"



JOINT	X	Y	Z
	in	in	in
T1-1N	0.4	0.1	-2.3
T1-1S	0.3	0.1	-2.3
T1-2N	0.2	0.2	-2.0
T1-2S	0.2	0.1	-2.1
T1-3N	0.2	0.3	-1.6
T1-3S	0.1	0.2	-1.6
T2-1N	0.1	0.3	-2.4
T2-1S	0.1	0.2	-2.5
T2-2N	0.0	0.3	-2.1
T2-2S	0.0	0.2	-2.2
T2-3N	0.0	0.3	-1.6
T2-3S	0.0	0.2	-1.7
T3-1N	0.1	0.3	-2.5
T3-1S	0.1	0.2	-2.6
T3-2N	0.0	0.3	-2.2
T3-2S	0.0	0.2	-2.2
T3-3N	0.0	0.3	-1.6
T3-3S	0.0	0.1	-1.7
T4-1N	0.0	0.3	-3.2
T4-1S	0.0	0.2	-3.3
T4-2N	0.0	0.4	-2.9
T4-2S	0.0	0.1	-2.9
T4-3N	0.0	0.4	-2.2
T4-3S	0.0	0.1	-2.2
T5-1N	0.0	0.3	-3.4
T5-1S	0.0	0.2	-3.4
T5-2N	0.0	0.4	-3.0
T5-2S	0.0	0.1	-3.1
T5-3N	0.0	0.4	-2.3
T5-3S	0.0	0.1	-2.4

JOINT	X	Y	Z
	in	in	in
T6-1N	0.0	0.3	-3.4
T6-1S	0.0	0.2	-3.4
T6-2N	0.0	0.3	-2.9
T6-2S	0.0	0.2	-3.0
T6-3N	0.1	0.4	-2.2
T6-3S	0.0	0.1	-2.3
T7-1N	-0.2	0.3	-3.3
T7-1S	-0.2	0.2	-3.4
T7-2N	-0.1	0.3	-2.8
T7-2S	-0.1	0.2	-2.8
T7-3N	0.1	0.4	-1.8
T7-3S	0.1	0.1	-1.9
T8-1N	0.8	0.3	-2.6
T8-1S	0.8	0.2	-2.7
T8-2N	0.3	0.4	-2.3
T8-2S	0.3	0.1	-2.4
T8-3N	0.2	0.4	-1.7
T8-3S	0.2	0.1	-1.8
T9-1N	0.8	0.3	-2.6
T9-1S	0.8	0.2	-2.6
T9-2N	0.3	0.3	-2.2
T9-2S	0.3	0.2	-2.2
T9-3N	0.1	0.4	-1.5
T9-3S	0.1	0.1	-1.6


5 TRUSS DEFLECTIONS



DEFLECTIONS ARE UPDATED BASED ON THE ADDITION OF HORIZONTAL CABLES AT 30'. NO OTHER VE ITEM HAS BEEN INCLUDED.

PENDING COORDINATION DURING DESIGN ASSIST.

KEY PLAN

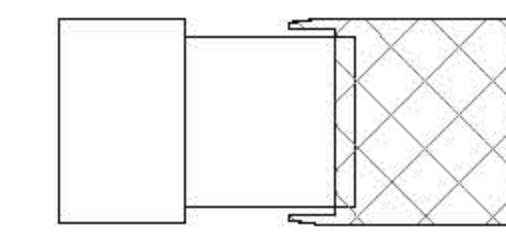

ISSUE PRINTING DATE

ISSUE	DESCRIPTION	DATE
03	DOB AMENDMENT 7	03/29/2016
04	DOB AMENDMENT 6	04/09/2016
21	CONSTRUCTION SET	10/28/2015
10	4 100% CONSTRUCTION DOCUMENTS	03/18/2015
9	90% CONSTRUCTION DOCUMENTS	02/16/2015
6	PRELIMINARY DOB SUBMISSION	12/16/2014
1	ADVANCED PROCUREMENT BID SET	06/16/2014



DRAWN BY: Audrey
CHECKED BY: Chris

PROJECT NUMBER: N11318.00

TITLE: DEPLOYED SHED-DEAD LOAD DEFLECTIONS II

DRAWING NO.: 8-799.01

B.SCAN NO.: S-799.01

CULTURE SHED
545 West 30th Street
New York, New York 10001

OWNER: CULTURE SHED INC
ARCHITECTS: Dilber Scudetto + Ranfro Architects, PC
601 West 30 Street #1515
New York, New York 10001
T: 212.360.7871

STRUCTURAL ENGINEER: Thornton Tomasetti
51 Madison Avenue
New York, New York 10010
T: 917.861.7800
F: 917.861.7801

MEP ENGINEER: Javna Baum & Bolles
50 Pine Street
New York, New York 10005
T: 212.230.0300
F: 212.230.0594

FACADE CONSULTANT: Thornton Tomasetti
51 Madison Avenue
New York, New York 10010
T: 917.861.7800
F: 917.861.7801

KINETICS ENGINEER: Hardisty & Heston
1001 Broadway
New York, New York 10036
T: 212.844.1150
F: 212.267.0297

LIGHTING DESIGNER: Tiltcon Design Associates
40 West Street #1602
New York, New York 10013
T: 212.675.7780

THEATRE PLANNING & DESIGN: Fisher Dodge Associates
22 West 16th Street
New York, New York 10011
T: 212.661.3000

LIFE SAFETY: Code Consultants, Inc.
215 West 40th St, 10th Fl
New York, New York 10018
T: 212.216.8586

ENERGY MODELLED: Veridian
50 Washington Street
Norwalk, CT 06854
T: 203.299.1411

ACOUSTICAL/AUDIO-VISUAL: Alvarillo
93 North Main Street
South Norwalk, CT 06854
T: 947.210.5540

VERTICAL TRANSPORTATION: Van Dusen & Associates
5 Rupert Street, Suite 504
Lithgow, NJ 07039
T: 973.994.8220

SPECIFICATIONS: Construction Specifications Inc.
PO Box 488
22 Tenney Road
Morristown, NJ 07951
T: 732.870.0700
F: 732.870.0700


SECURITY: Duckelle Venter & Santoro
1020 Sherman Avenue
Hamden, CT 06514
T: 203.288.8480

WATERPROOFING: James R. Gelfort AIA Consulting Architects PC
154 West 27th Street
New York, NY 10001
T: 212.736.3344

FACADE MAINTENANCE: Smith Engineering PLLC
160 Arden Street
New York, NY 10006
T: 212.696.3000

BRANDING/GRAPHICS: 204 Global Design Consultancy
180 Vespa Street, 15th Floor
New York, NY 10014
T: 212.647.1170

KEY PLAN

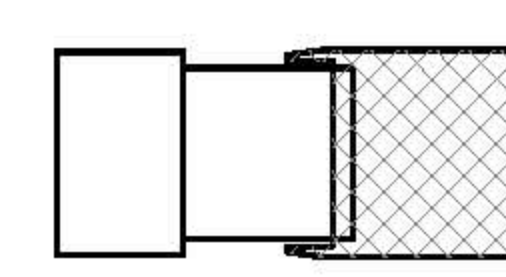

REVISIONS: PRINTING DATE

NO.	DESCRIPTION	DATE
01	50 AMBROSEMENT 7	08.18.2018
10	100% CONSTRUCTION DOCUMENTS	02.18.2019
9	90% CONSTRUCTION DOCUMENTS	02.18.2019
8	PRELIMINARY OBS SUBMISSION	12.10.2014
1	ADVANCED PROCUREMENT BID SET	08.18.2014

FOR BIDDING ONLY
NOT FOR CONSTRUCTION
STAMP




DRAWN BY: MG
CHECKED BY: SL
PROJECT NUMBER: N11318.00

TITLE: DEPLOYED SHED NORTH AND SOUTH DOORS - FRAMING


DRAWING NO.: S-802.01

S-604N NO.


S-802.01

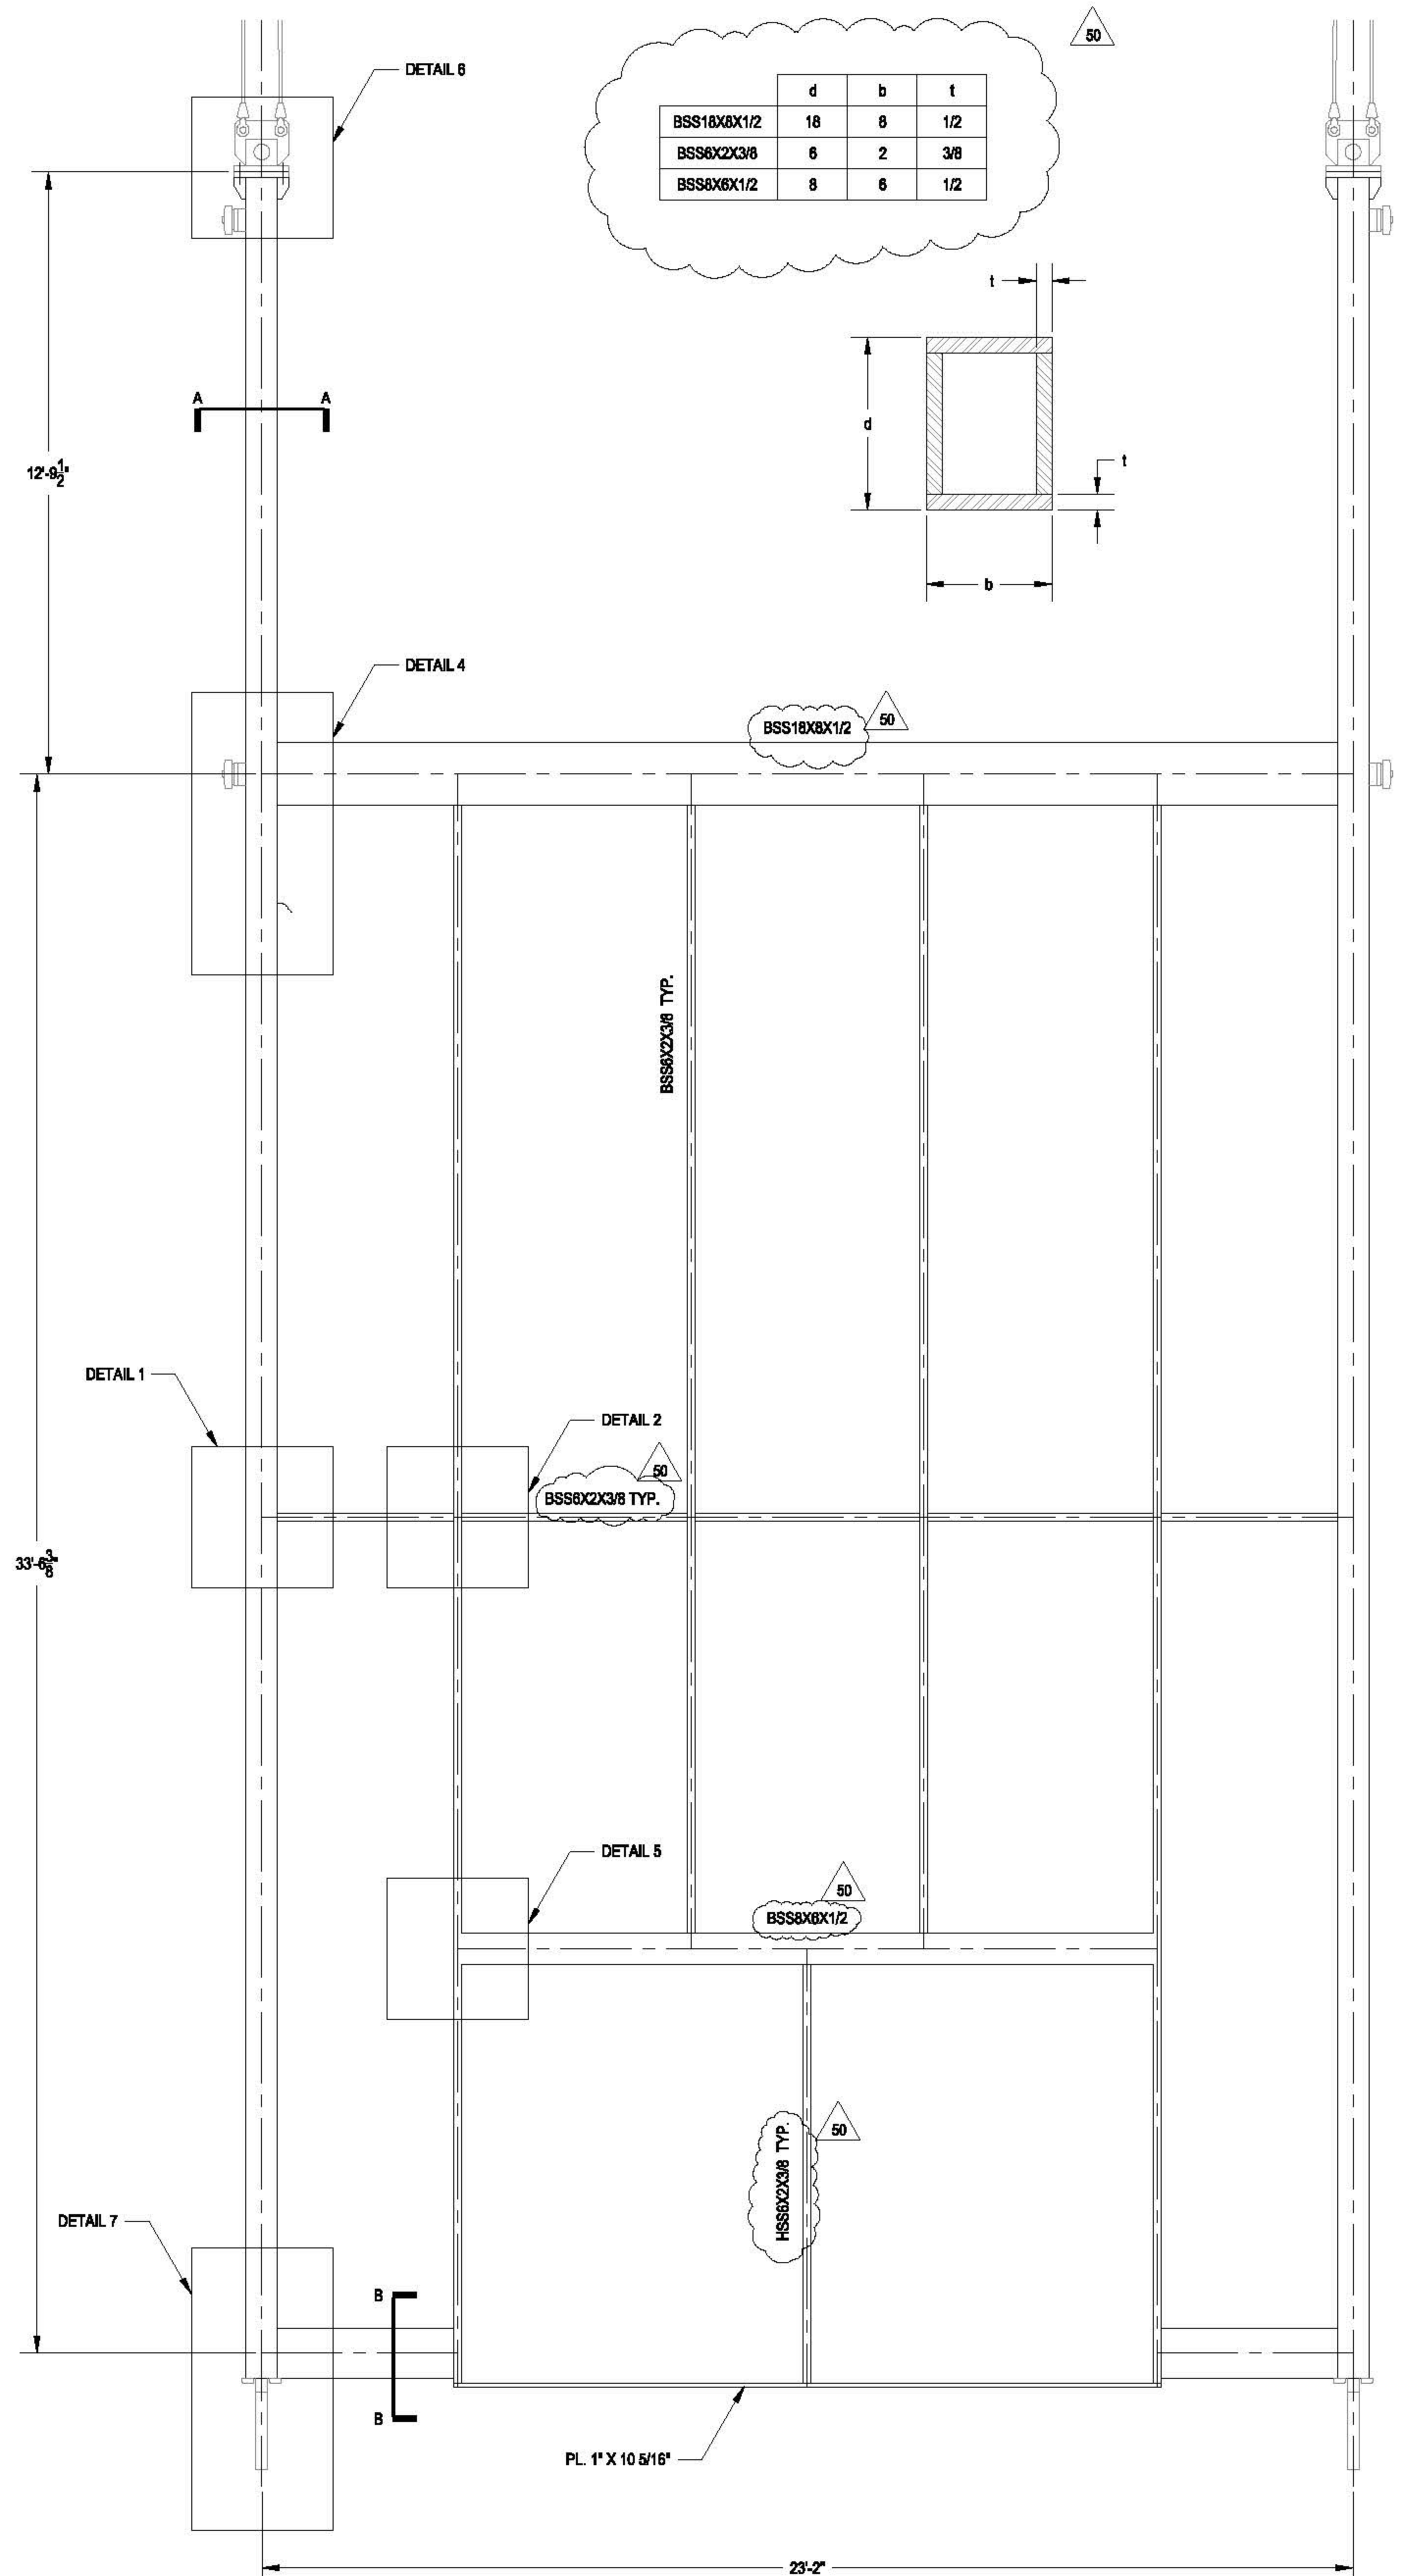


1 OPERABLE WALL PANEL 1S
1/2" = 1'-0"

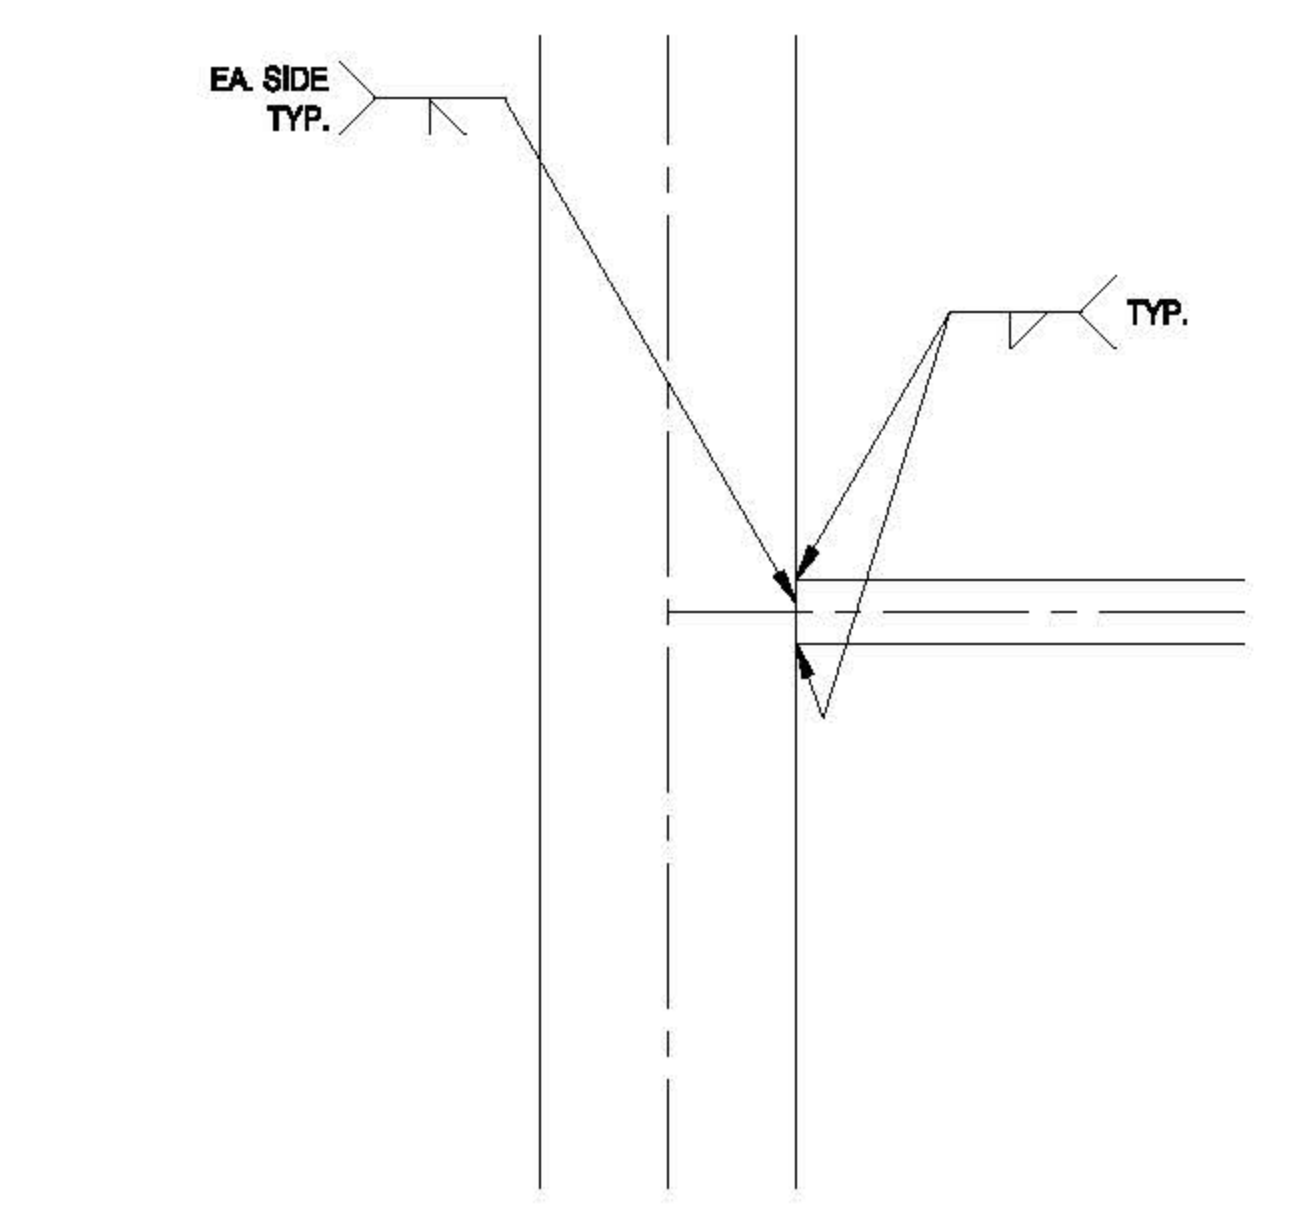


2 DETAIL 1
1" = 1'-0"

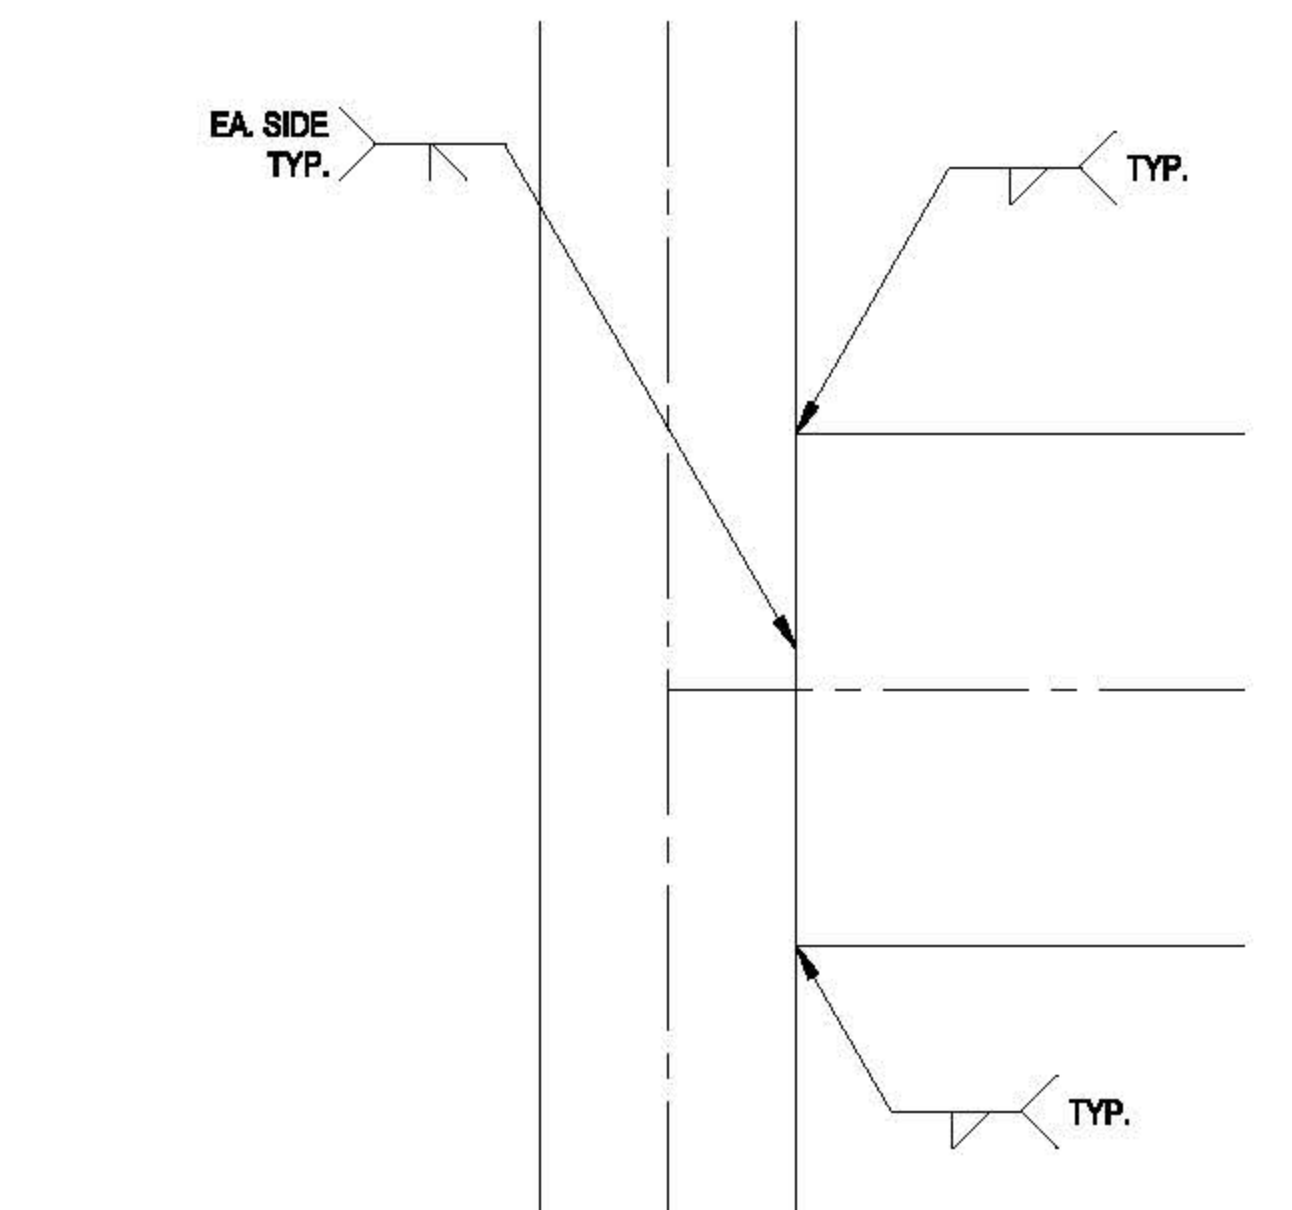


5 DETAIL 4
1" = 1'-0"

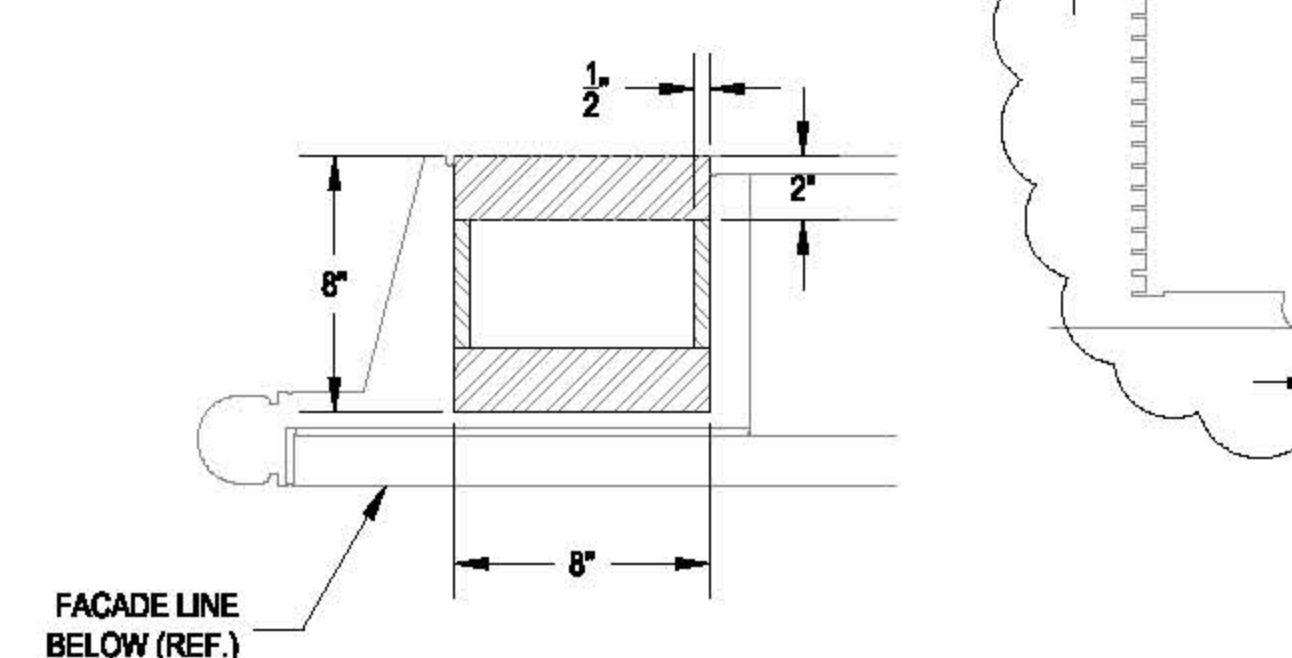


8 SECTION A-A
1" = 1'-0"

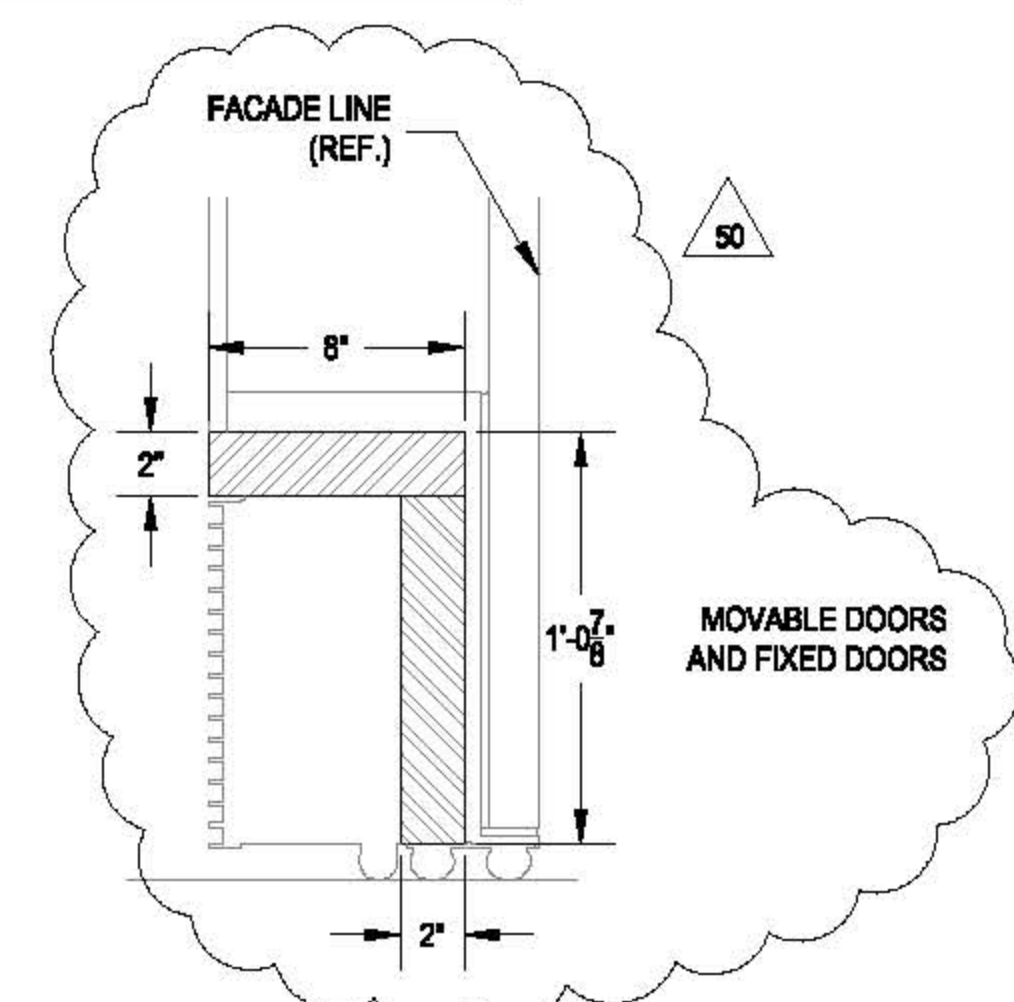


9 SECTION B-B
1" = 1'-0"

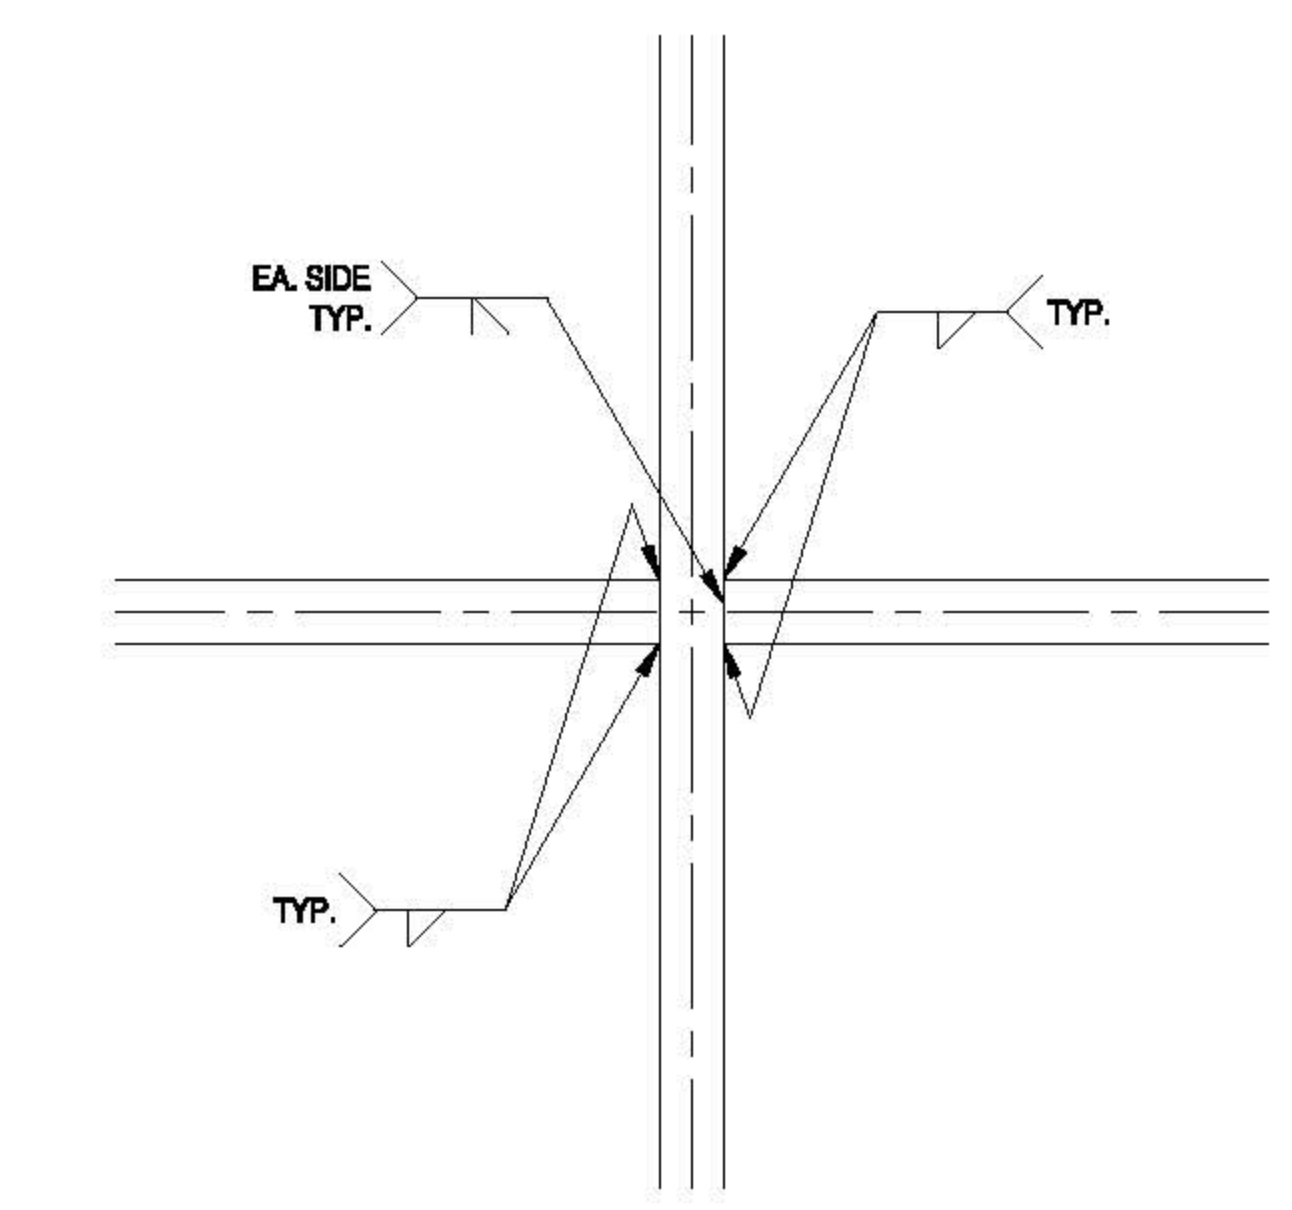


3 DETAIL 2
1" = 1'-0"

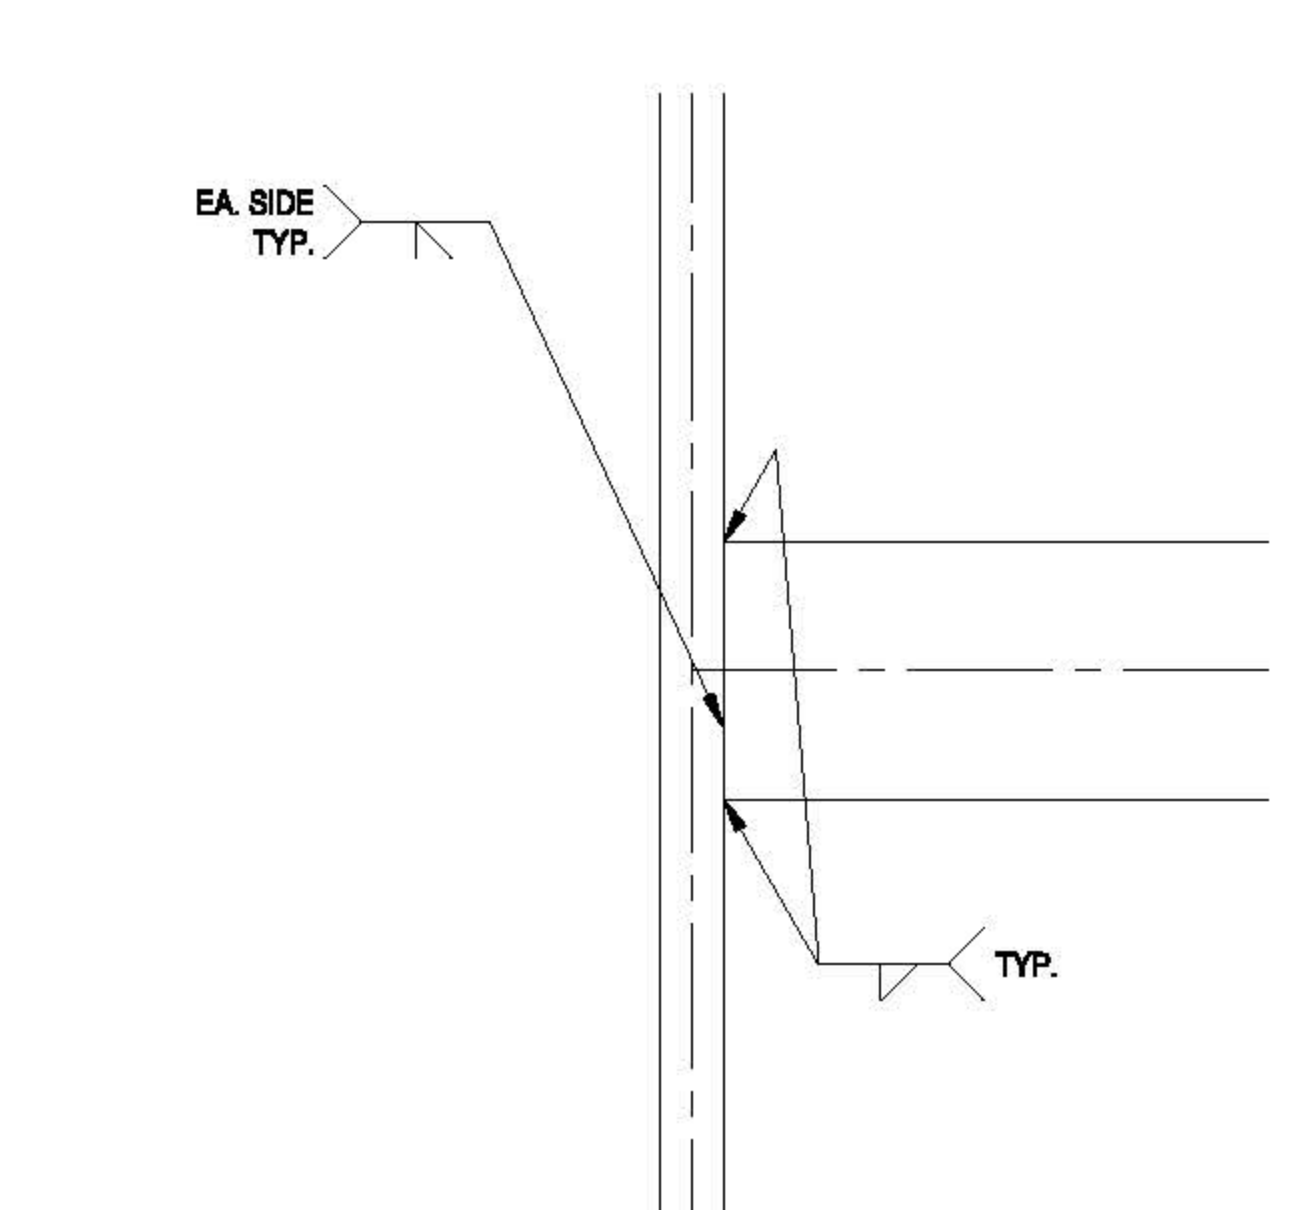


6 DETAIL 5
1" = 1'-0"

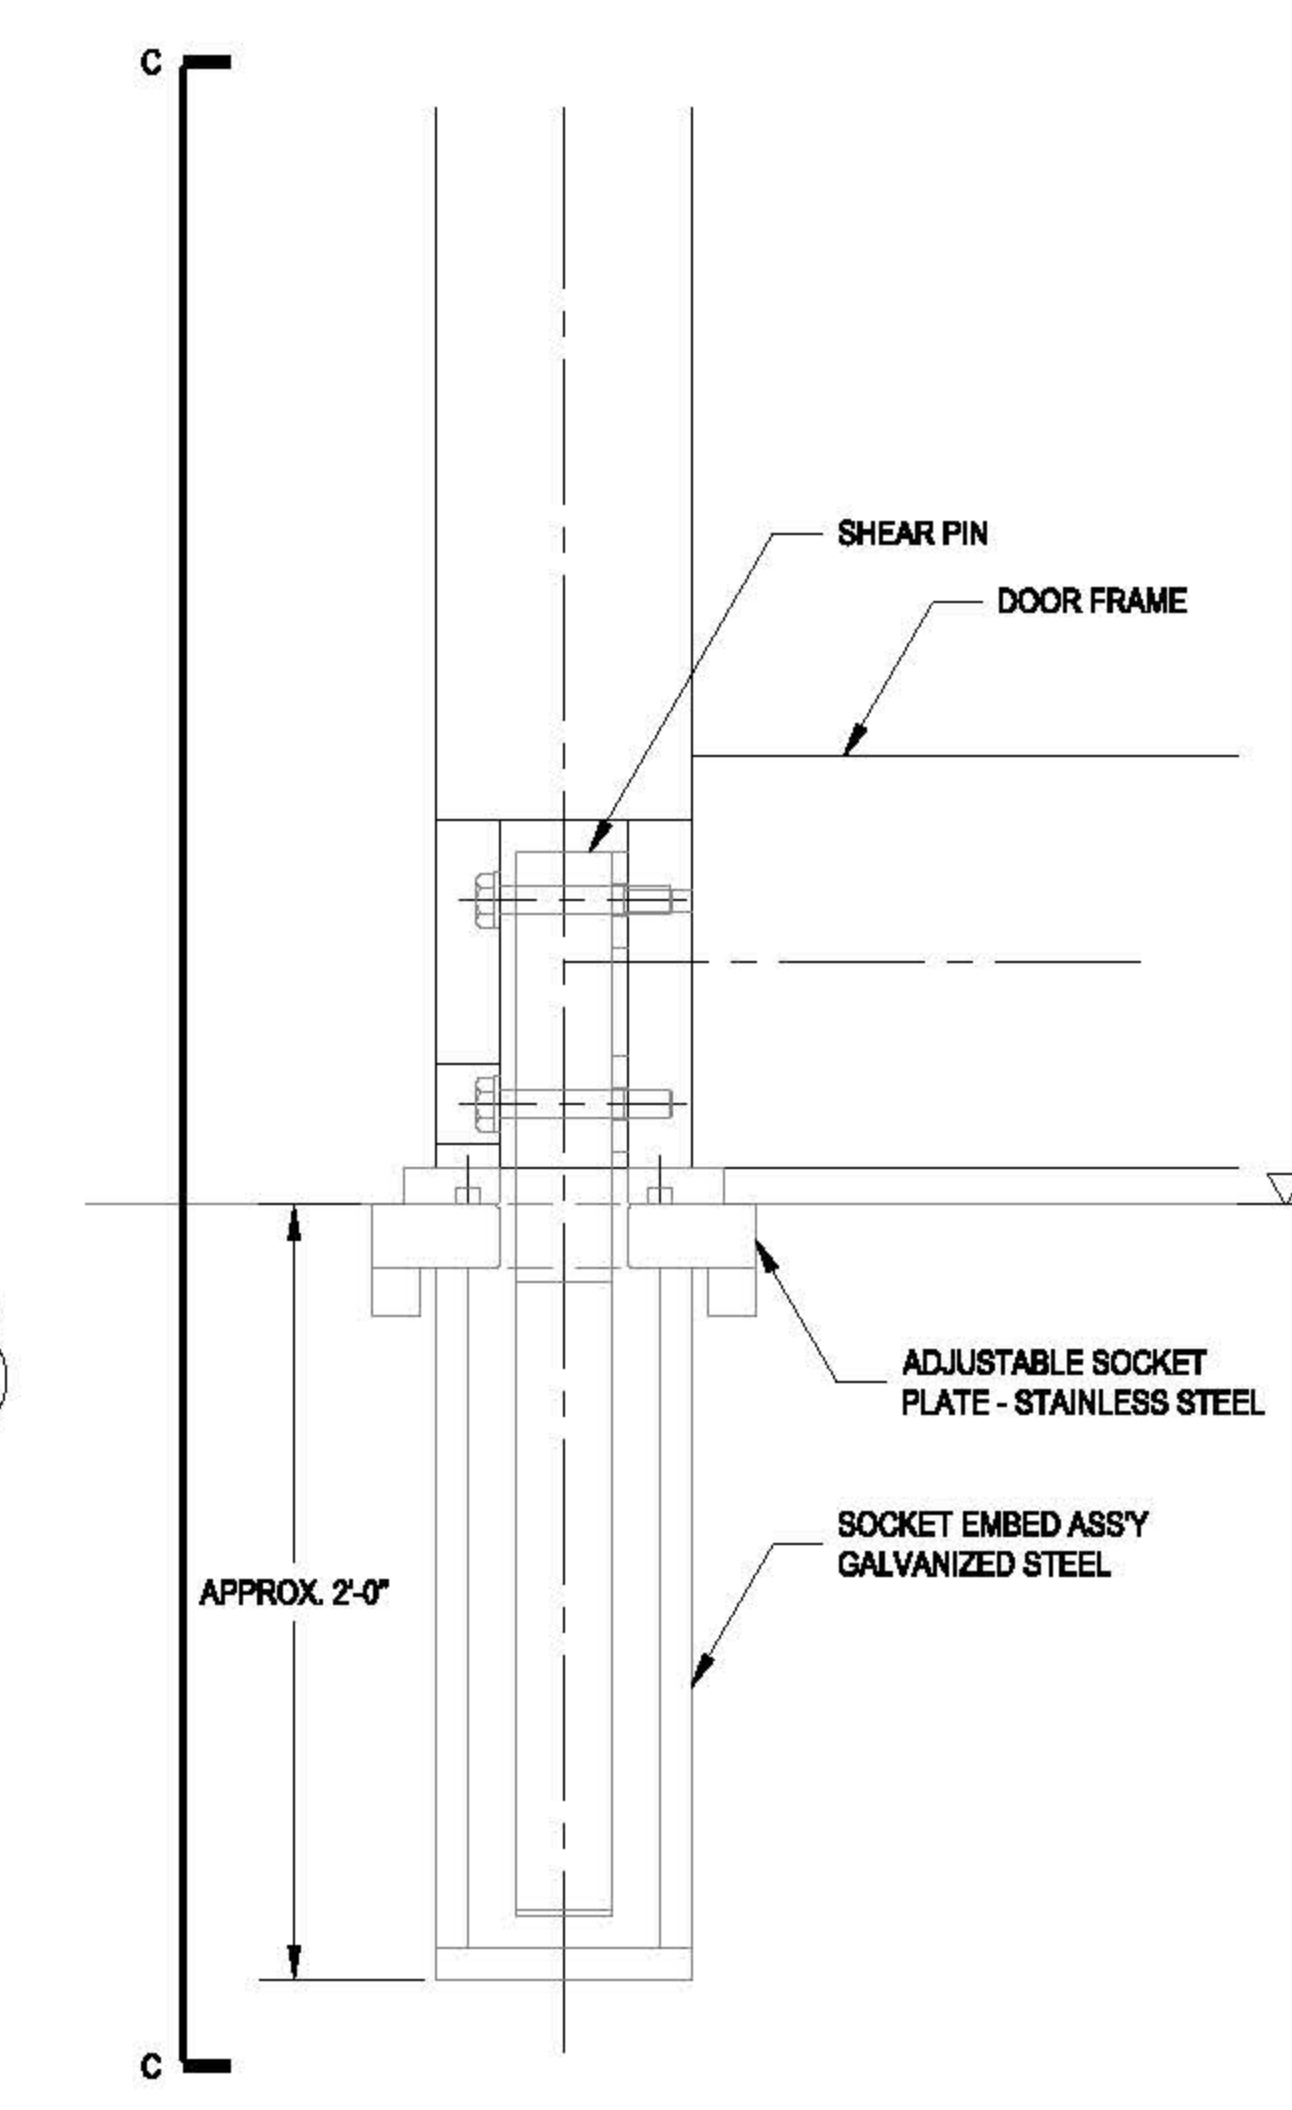


9 DETAIL 7
1" = 1'-0"

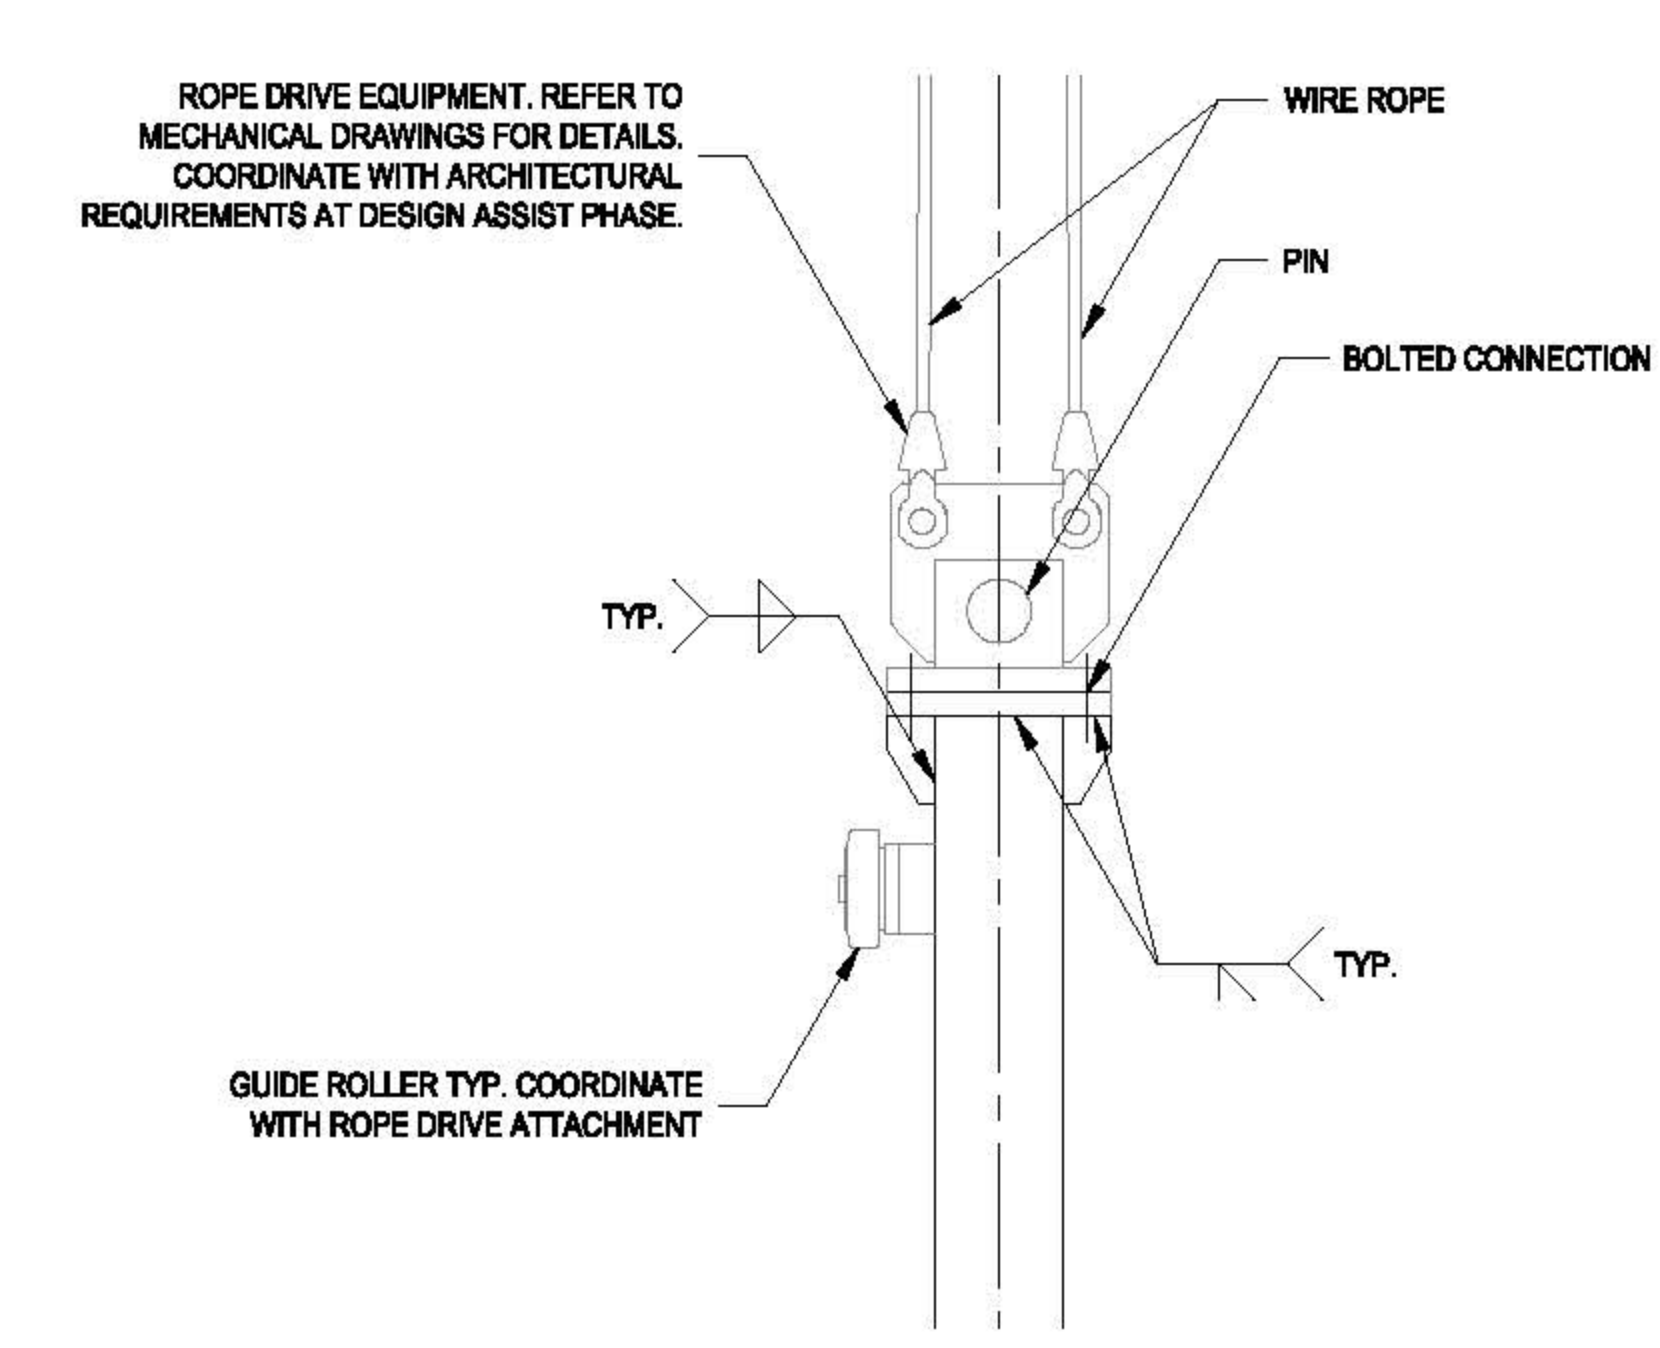

7 DETAIL 6
1" = 1'-0"

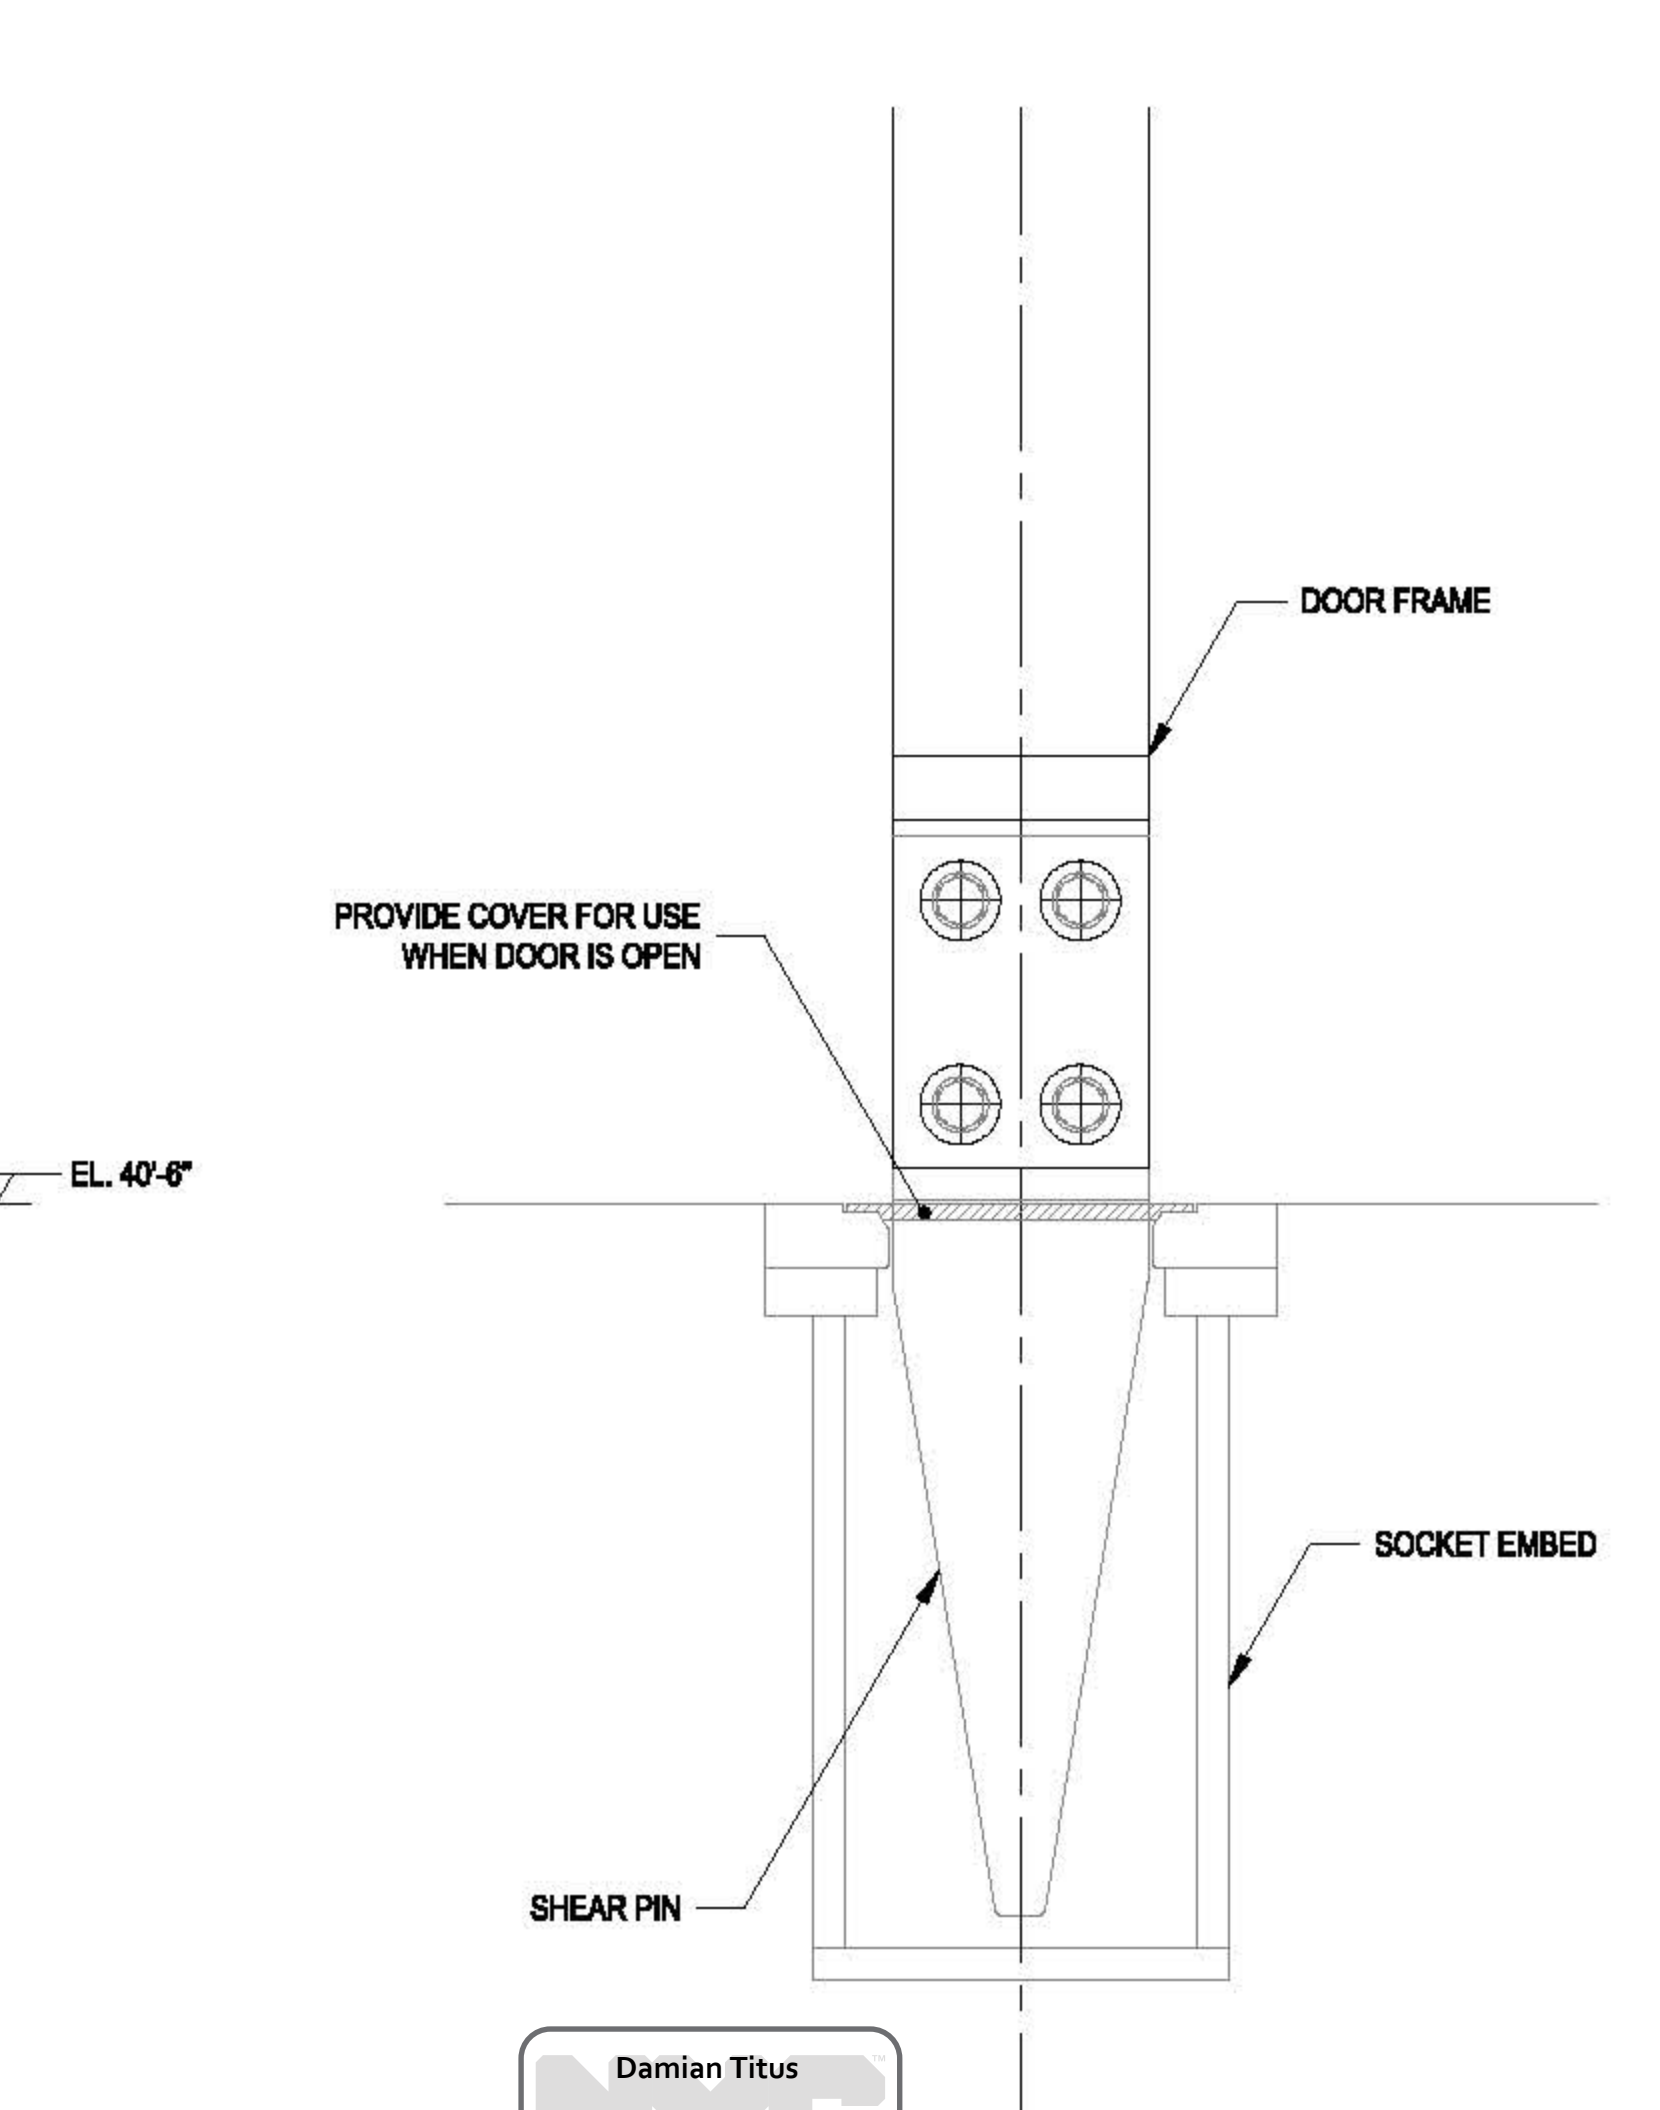

11 SECTION C-C
1" = 1'-0"

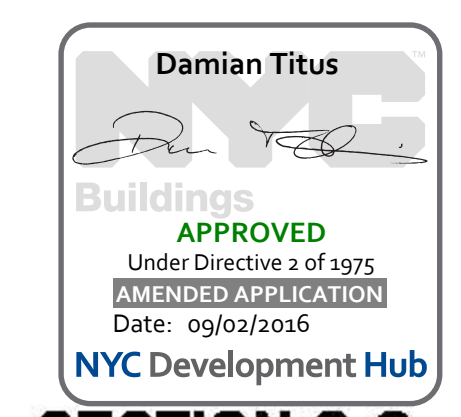

CULTURE SHED
 545 West 30th Street
 New York, New York 10001
 OWNER: CULTURE SHED INC

ARCHITECTS
 Dilber Scudiero + Ranfro Architects, DPC
 601 West 28 Street #1815
 New York, New York 10001
 T: 212.360.7871

STRUCTURAL ENGINEER
 Thornton Tomasetti
 51 Madison Avenue
 New York, New York 10010
 T: 917.861.7800
 F: 917.861.7801

MEP ENGINEER
 Javna Baum & Bolles
 80 Park Street
 New York, New York 10005
 T: 212.236.0900
 F: 212.236.0904

MEP ENGINEER
 Javna Baum & Bolles
 80 Park Street
 New York, New York 10005
 T: 212.236.0900
 F: 212.236.0904


MEP ENGINEER
 Javna Baum & Bolles
 80 Park Street
 New York, New York 10005
 T: 212.236.0900
 F: 212.236.0904

MEP ENGINEER
 Javna Baum & Bolles
 80 Park Street
 New York, New York 10005
 T: 212.236.0900
 F: 212.236.0904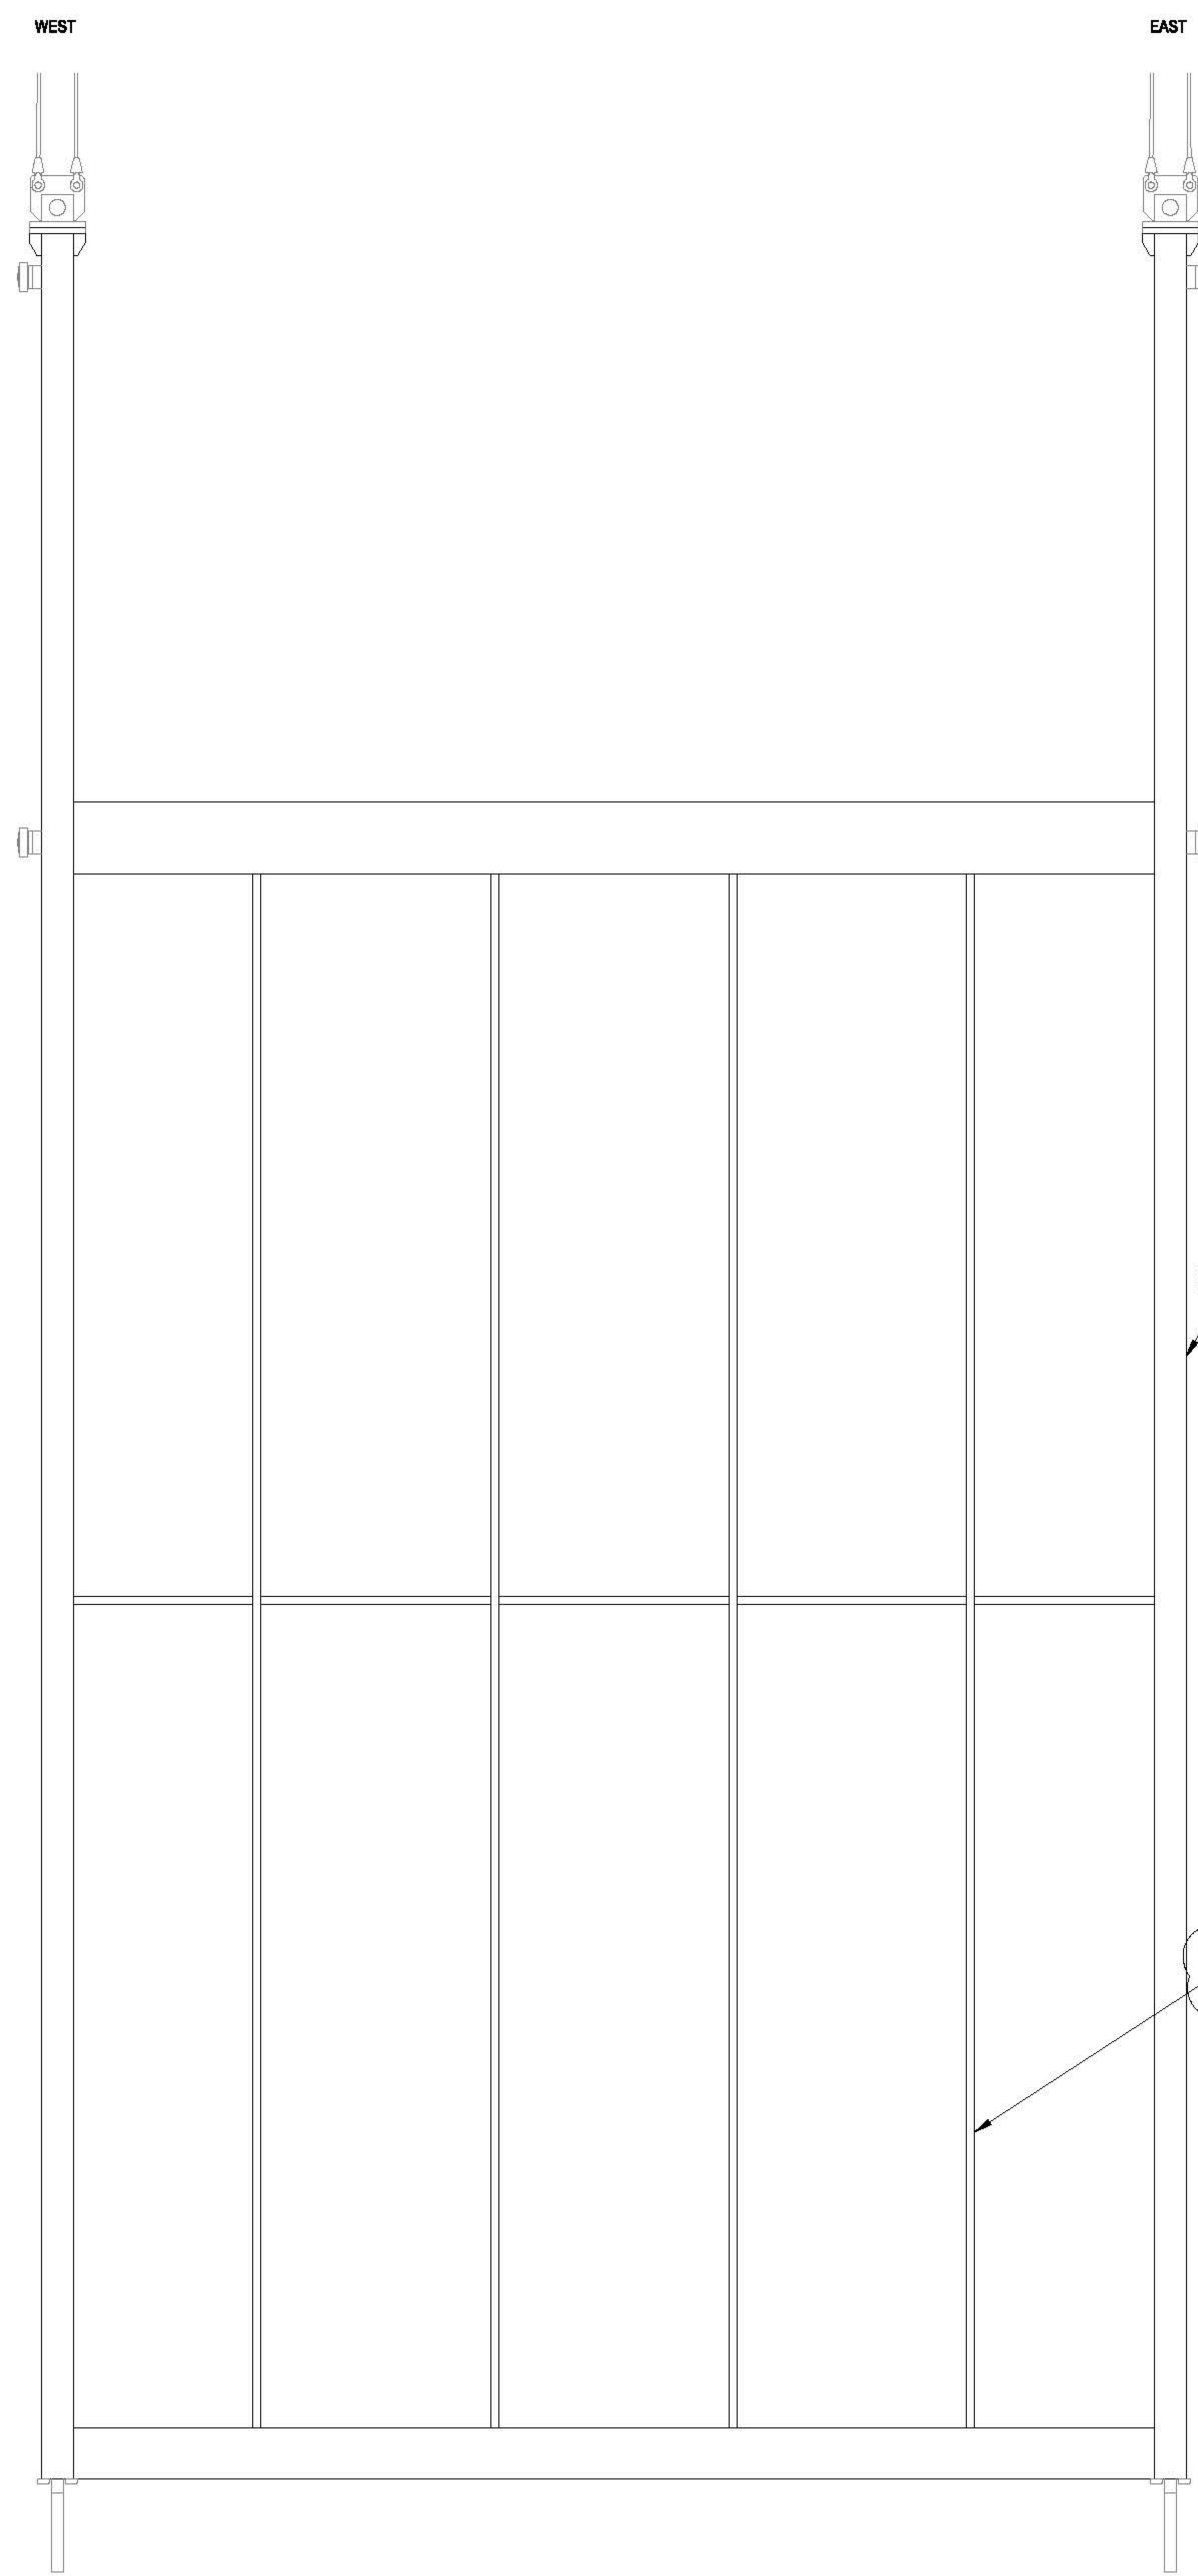


1 OPERABLE WALL PANEL 1N
 1/2" = 1'-0"

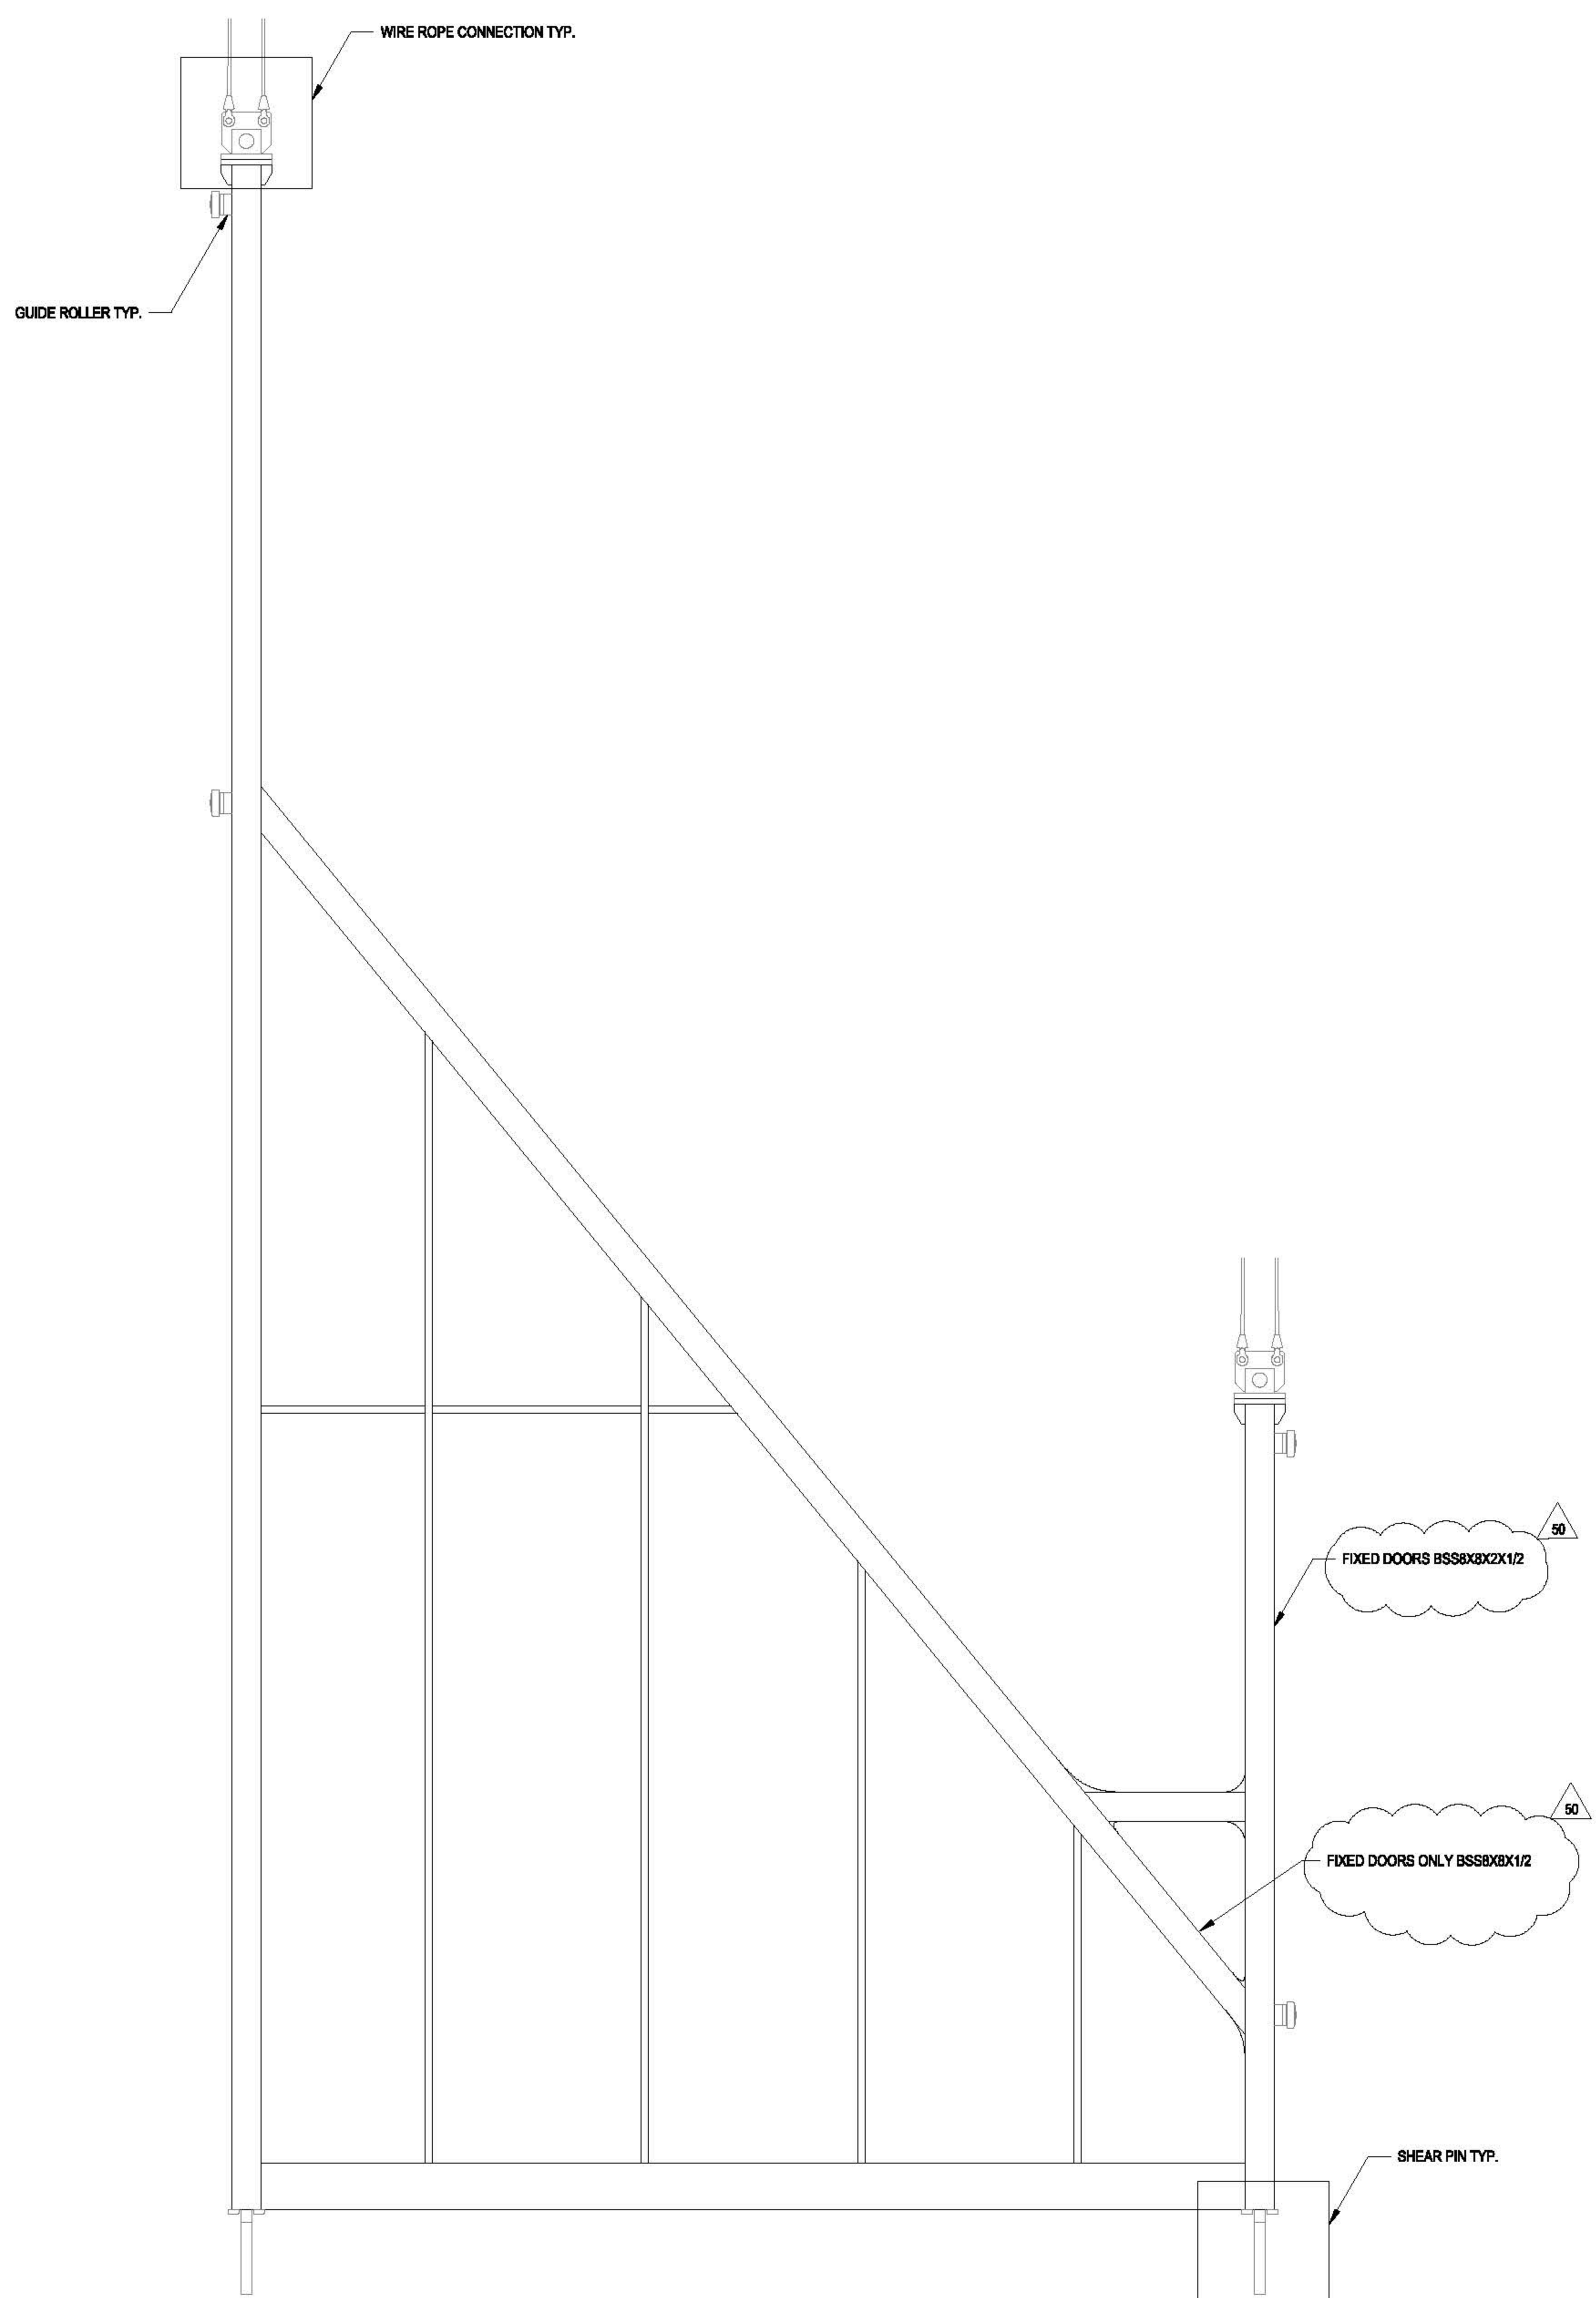


1 OPERABLE WALL PANEL 4S
 1/2" = 1'-0"

REFER TO DRAWING S-802.00 FOR DETAILS

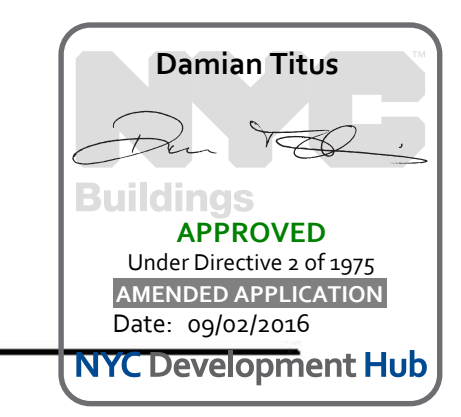

KEY PLAN

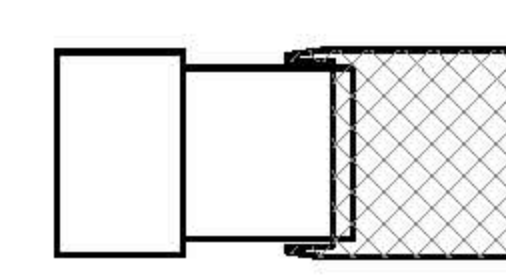

ISSUE PRINTING DATE

ISSUE	PRINTING	DATE
01	00	DOR AMENDMENT 7 08.19.2018
10	00	100% CONSTRUCTION DOCUMENTS 03.18.2015
9	00	90% CONSTRUCTION DOCUMENTS 02.18.2015
8	00	PRELIMINARY DGS SUBMISSION 11.18.2014
1	00	ADVANCED PROCUREMENT BID SET 08.18.2014

FOR BIDDING ONLY
NOT FOR CONSTRUCTION



DRAWN BY: MG
 CHECKED BY: SL
 PROJECT NUMBER: N11318.00

TITLE: DEPLOYED SHED NORTH AND SOUTH DOORS - DETAILS

DRAWING NO. S-803.01

S-803AN NO.

S-803.01

117 of 123

PENDING COORDINATION DURING DESIGN ASSIST

CULTURE SHED
545 West 30th Street
New York, New York 10001

OWNER: CULTURE SHED INC
ARCHITECTS: Diller Scofidio + Renfro Architects, DPC
601 West 30 Street #1515
New York, New York 10001
T: 212.360.7871

STRUCTURAL ENGINEER: Thornton Tomasetti
51 Madison Avenue
New York, New York 10010
T: 917.861.7800
F: 917.861.7801

MEP ENGINEER: Javna Baum & Bolles
50 Pine Street
New York, New York 10005
T: 212.230.0300
F: 212.230.0584

FACADE CONSULTANT: Thornton Tomasetti
51 Madison Avenue
New York, New York 10010
T: 917.861.7800
F: 917.861.7801

KINETICS ENGINEER: Hardaway & Hammer
1001 Broadway
New York, New York 10036
T: 212.844.1150
F: 212.267.0297

LIGHTING DESIGNER: Tiltcon Design Associates
43 West Street #1902
New York, New York 10013
T: 212.875.7780

THEATRE PLANNING & DESIGN: Fisher Dodge Associates
22 West 18th Street
New York, New York 10011
T: 212.861.3000

LIFE SAFETY: Code Consultants, Inc.
215 West 40th St, 10th Flr
New York, New York 10018
T: 212.216.8586

ENERGY MODELLED: Veridian
50 Washington Street
Norwalk, CT 06854
T: 203.295.1411

ACOUSTICAL/AUDIO-VISUAL: Alvarillo
93 North Main Street
South Norwalk, CT 06854
T: 947.210.5540

VERTICAL TRANSPORTATION: Van Dusen & Associates
5 Rupert Street, Suite 504
Lynchburg, NJ 07039
T: 973.984.8220


SPECIFICATIONS: Construction Specifications Inc.
PO Box 488
22 Tenney Road
Morristown, NJ 07951
T: 732.870.0700
F: 732.870.0700

SECURITY: Duckbill Venter & Santora
1020 Sherman Avenue
Hamden, CT 06514
T: 203.288.8480

WATERPROOFING: James R. Gaimfort AIA Consulting Architects PC
154 West 27th Street
New York, NY 10001
T: 212.736.3344

FACADE MAINTENANCE: Smith Engineering PLLC
160 Arden
New York, NY 10006
T: 212.866.3000

BRANDING/GRAPHICS: 204 Global Design Consultancy
180 West Street, 15th Floor
New York, NY 10014
T: 212.647.1170

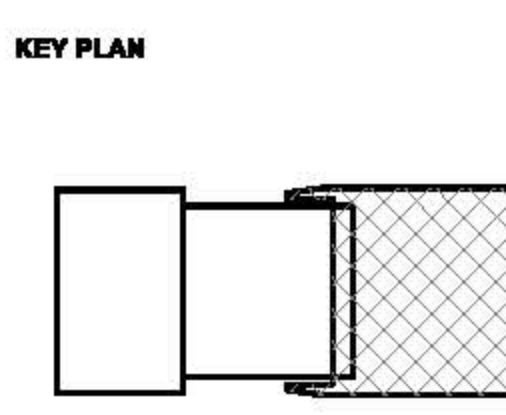

REVISION	PRINTING	DATE	
01	02	DOR AMENDMENT 7	08.18.2014
10	100	CONSTRUCTION DOCUMENTS	03.18.2013
9	900	CONSTRUCTION DOCUMENTS	02.18.2013
8	800	PRELIMINARY DSB SUBMISSION	12.10.2014
1	1	ADVANCED PROCUREMENT BID SET	08.18.2014


FOR BIDDING ONLY
NOT FOR CONSTRUCTION
STAMP

DRAWN BY: MG
CHECKED BY: SL
PROJECT NUMBER: N11318.00


TITLE: DEPLOYED SHED EAST DOORS - FRAMING

DRAWING NO.: S-812.01
S-CAN NO.:


S-812.01

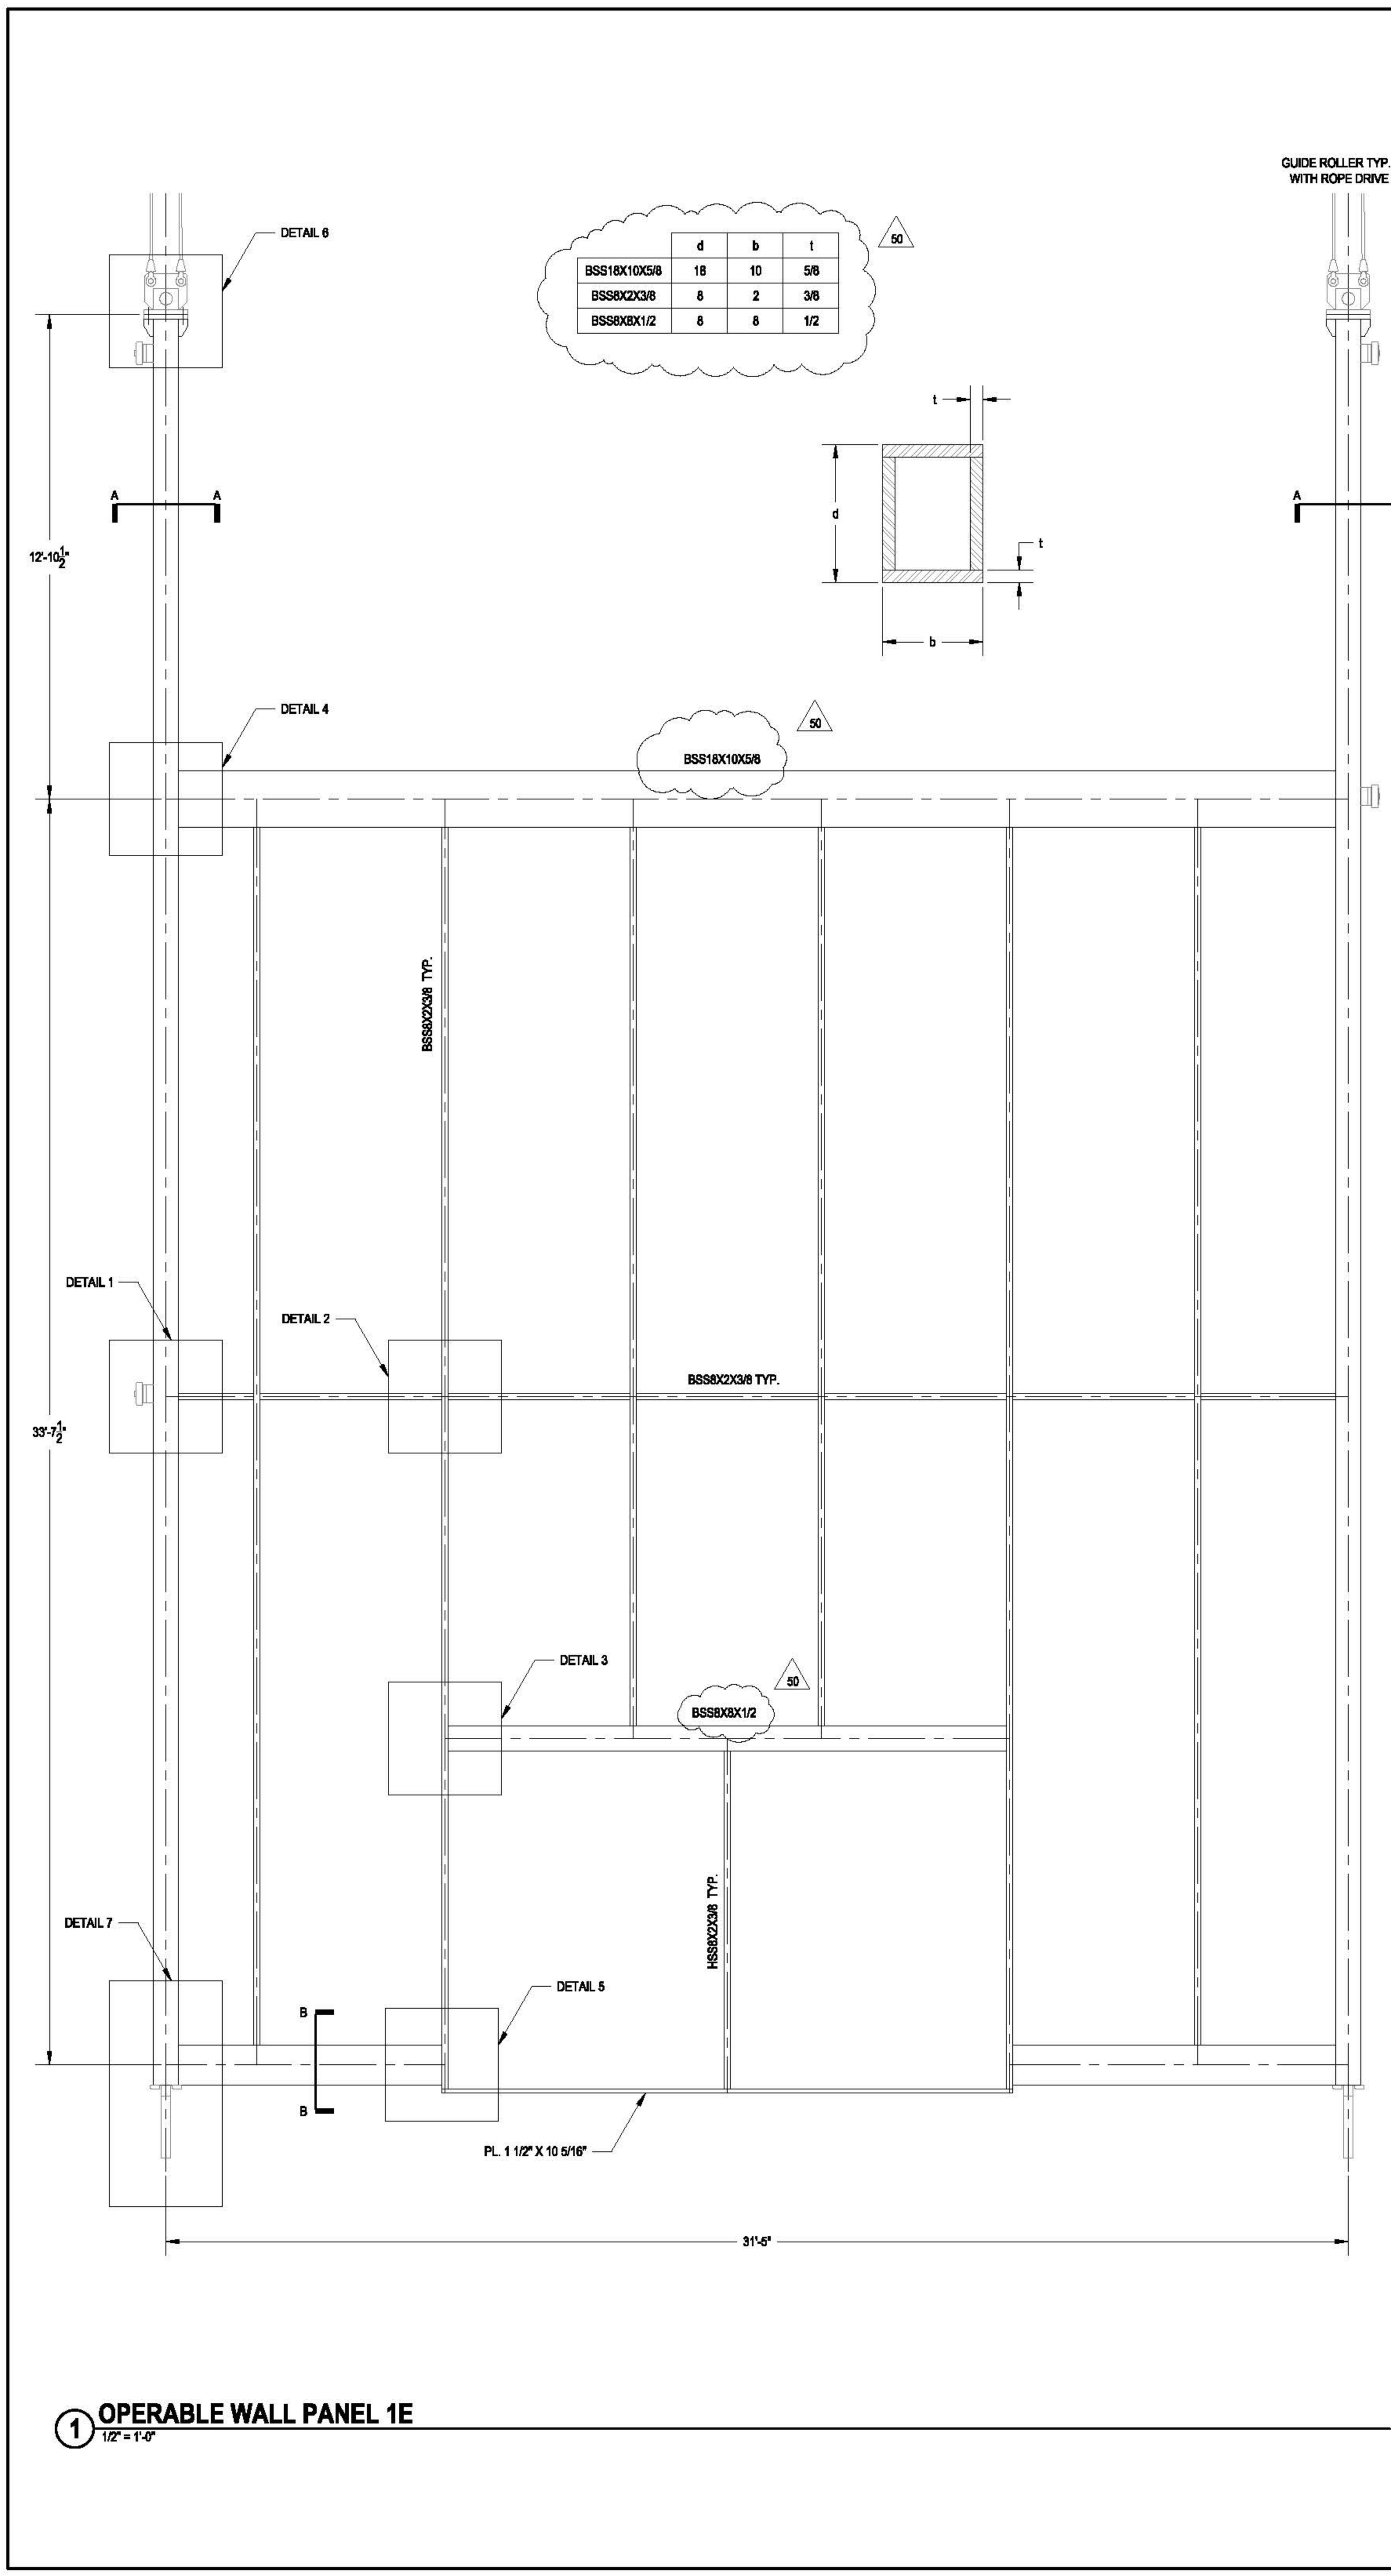


1 OPERABLE WALL PANEL 1E
1/2" = 1'-0"

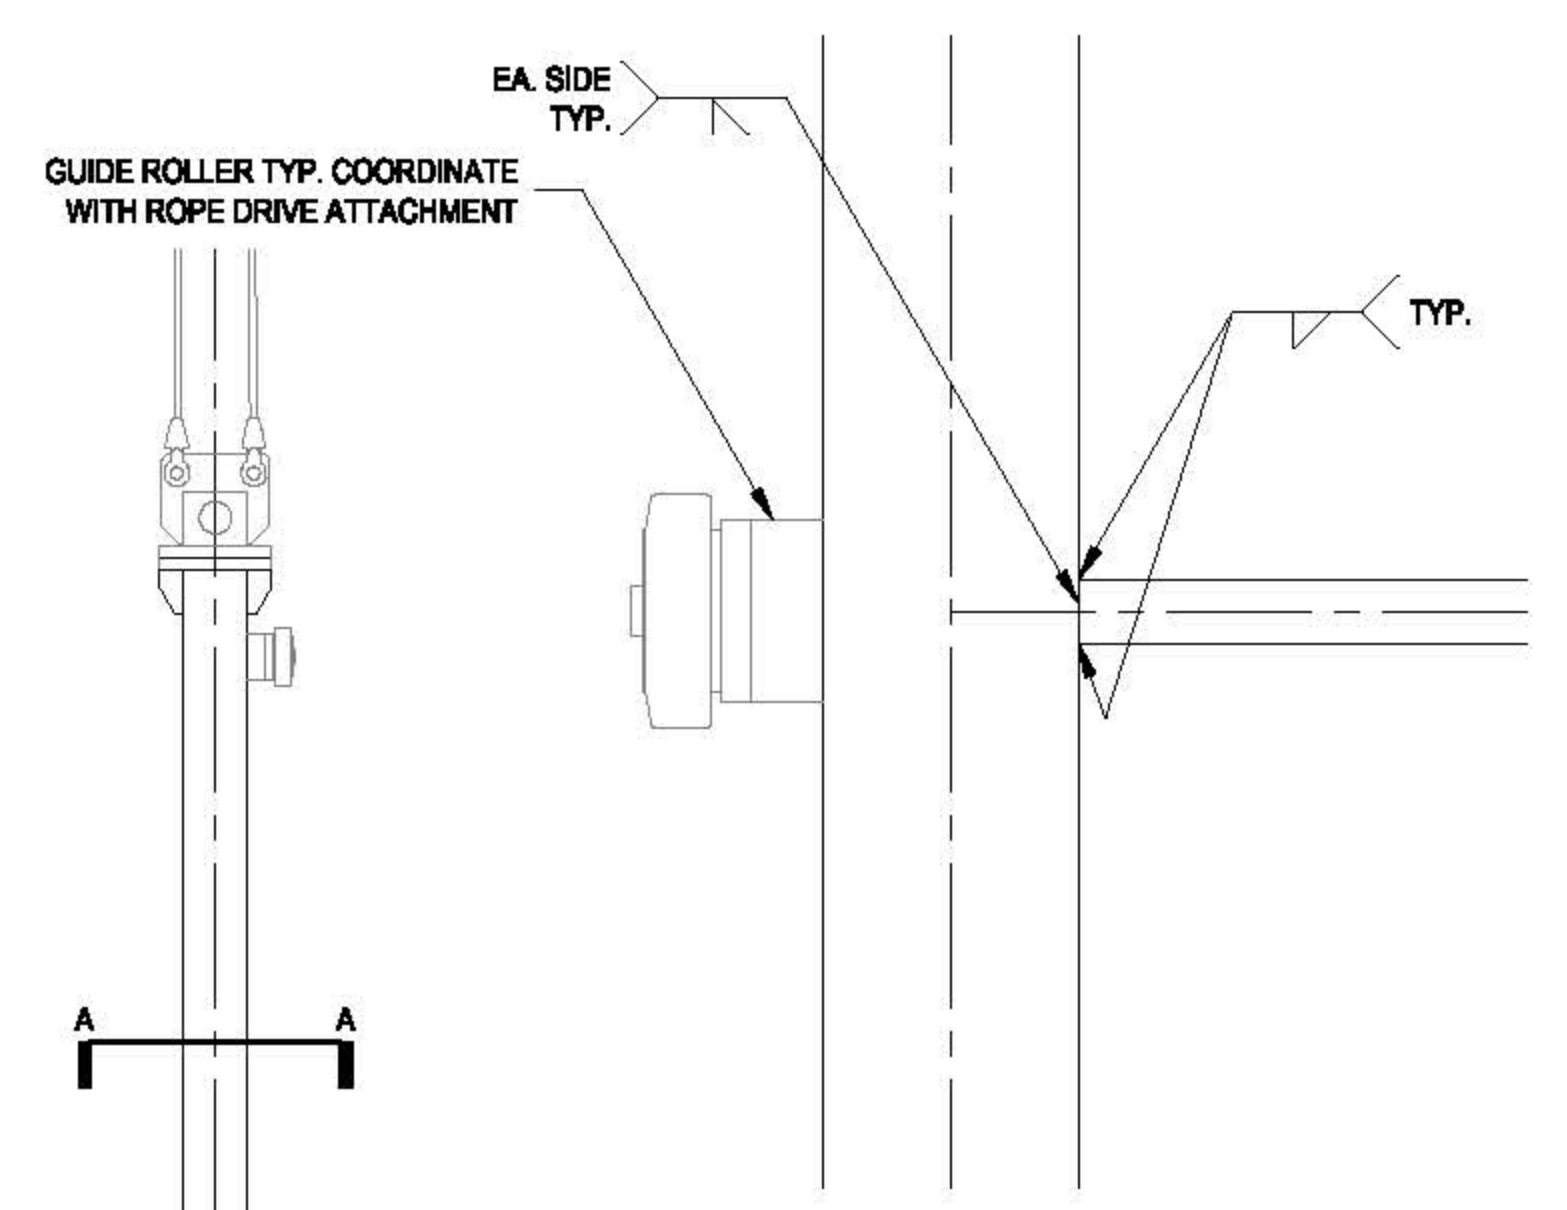


2 DETAIL 2
1" = 1'-0"

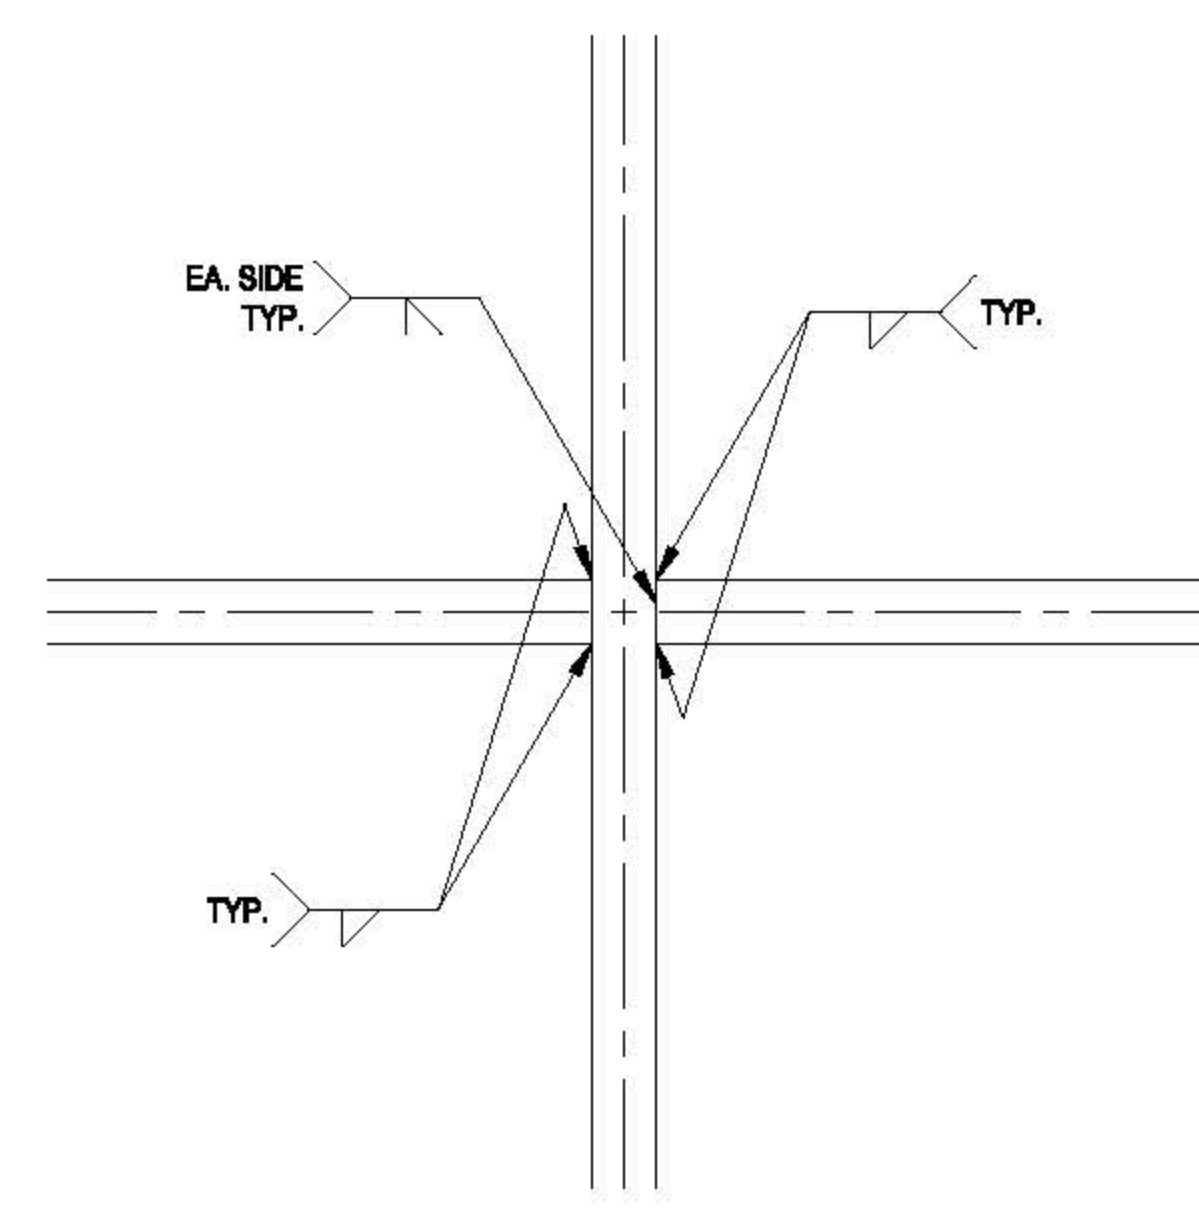


3 DETAIL 3
1" = 1'-0"

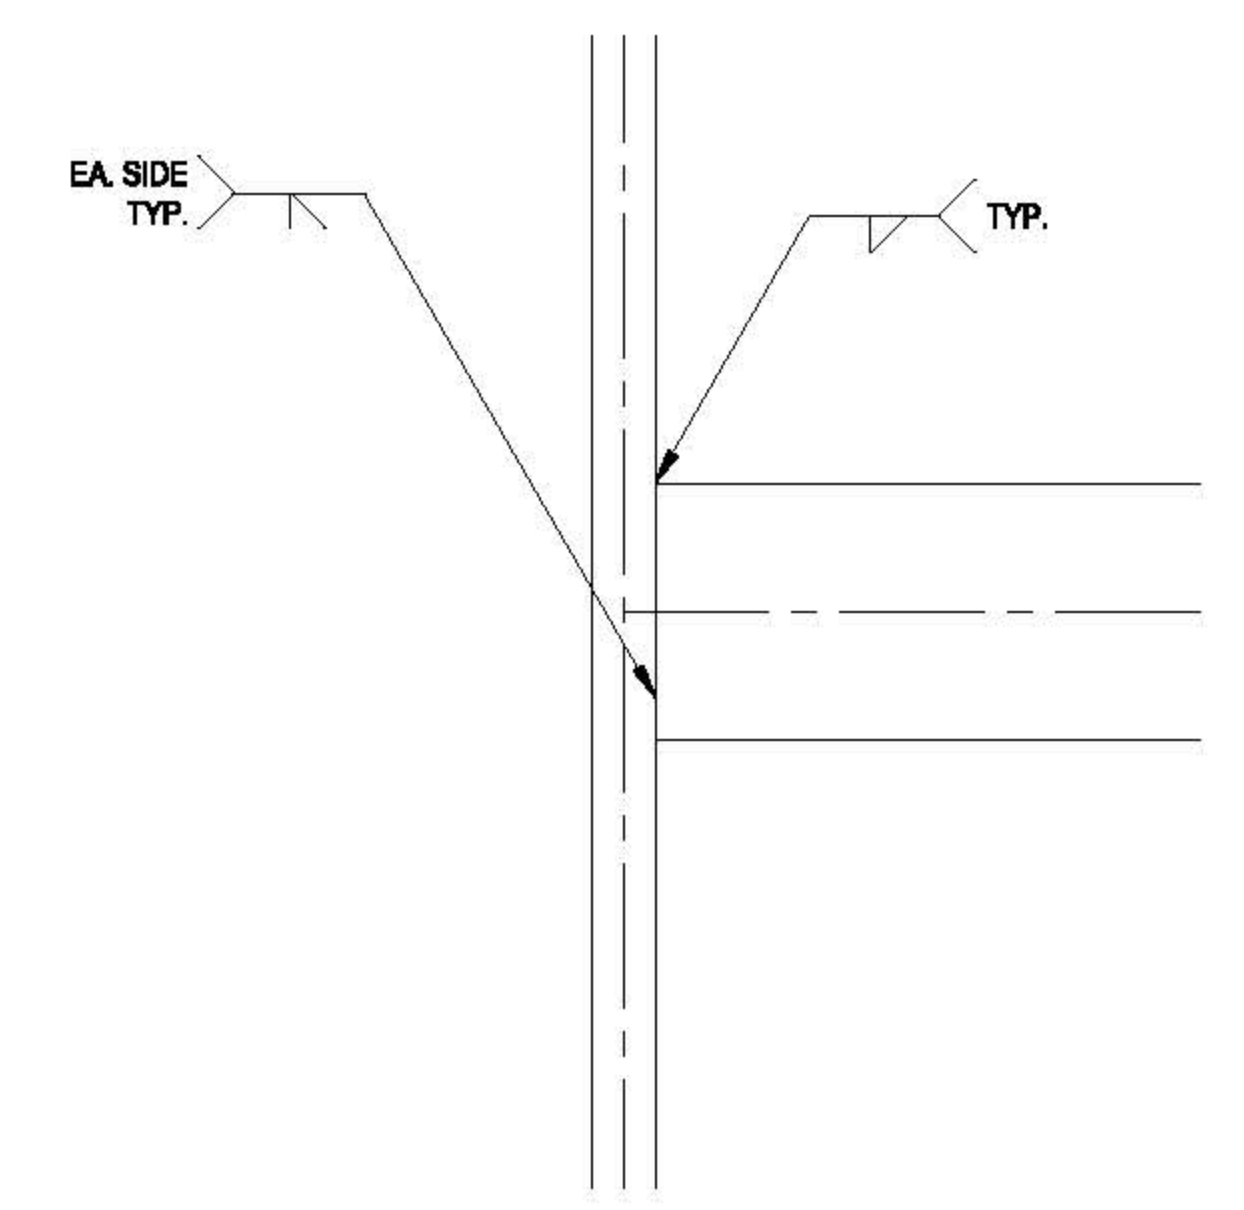


4 DETAIL 4
1" = 1'-0"

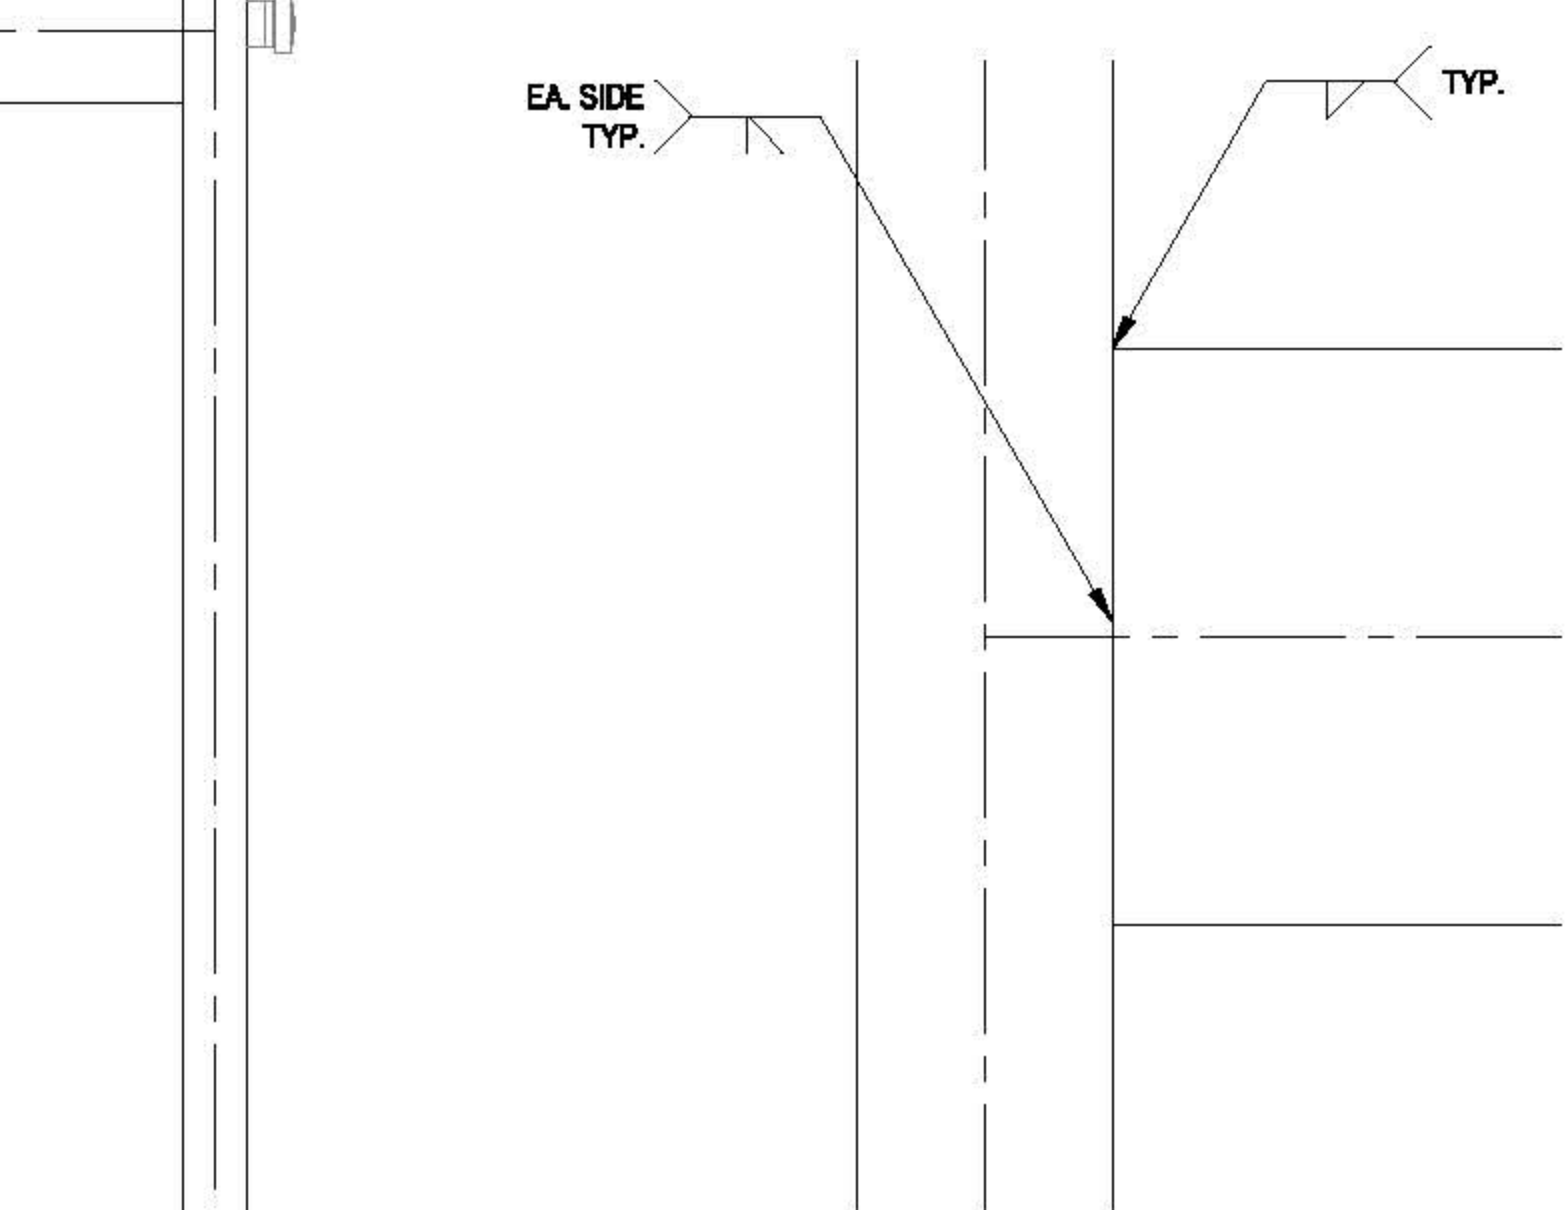


5 DETAIL 5
1" = 1'-0"

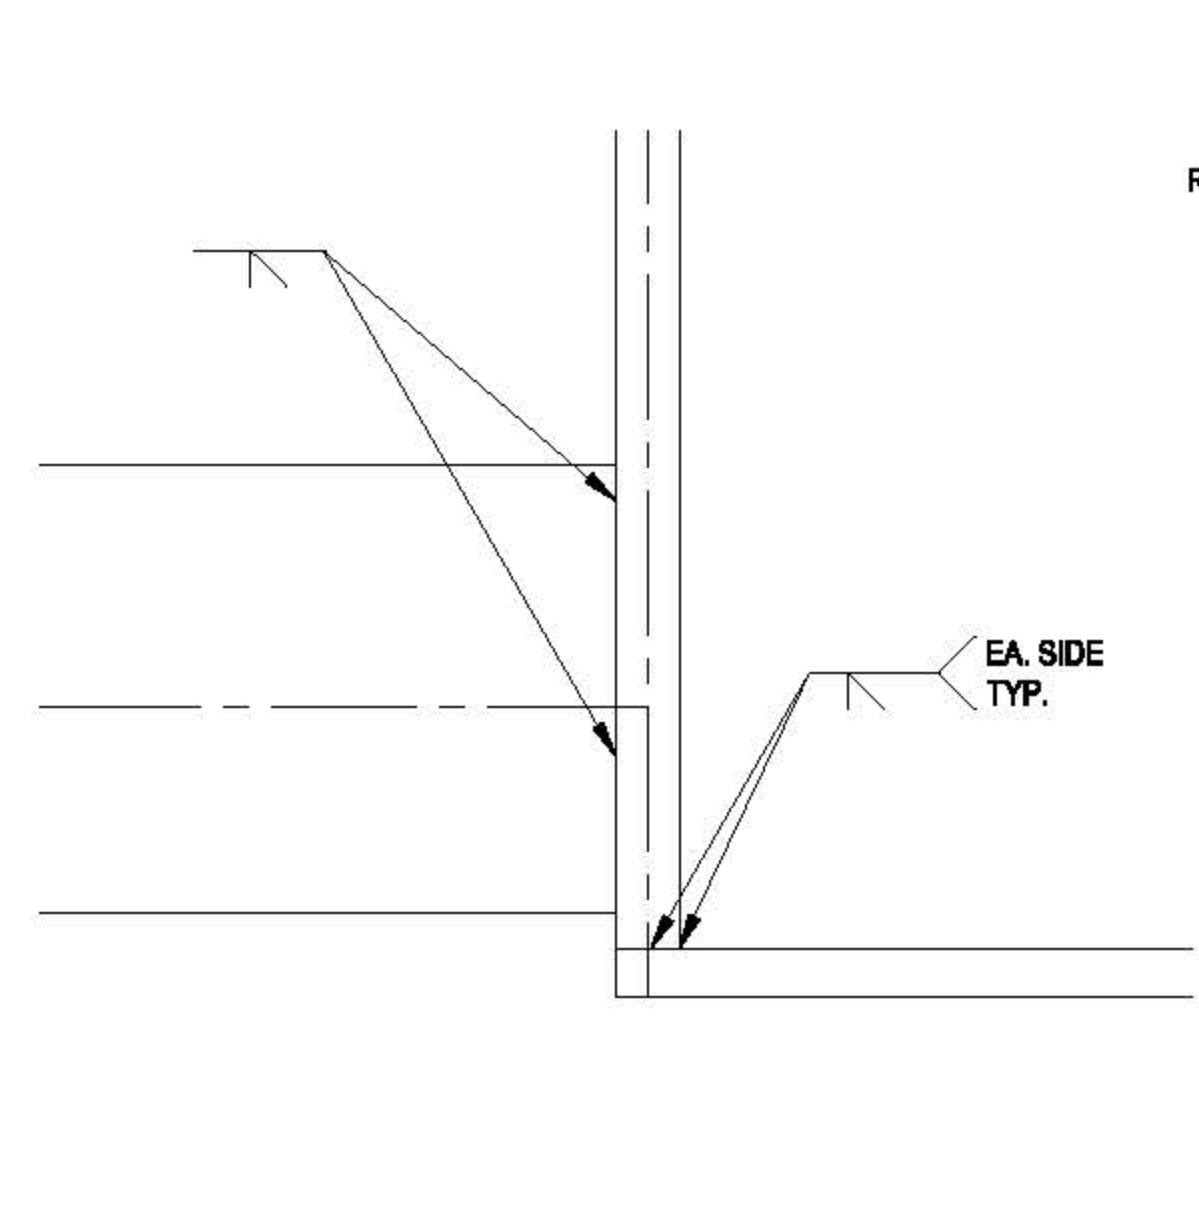


6 DETAIL 6
1" = 1'-0"

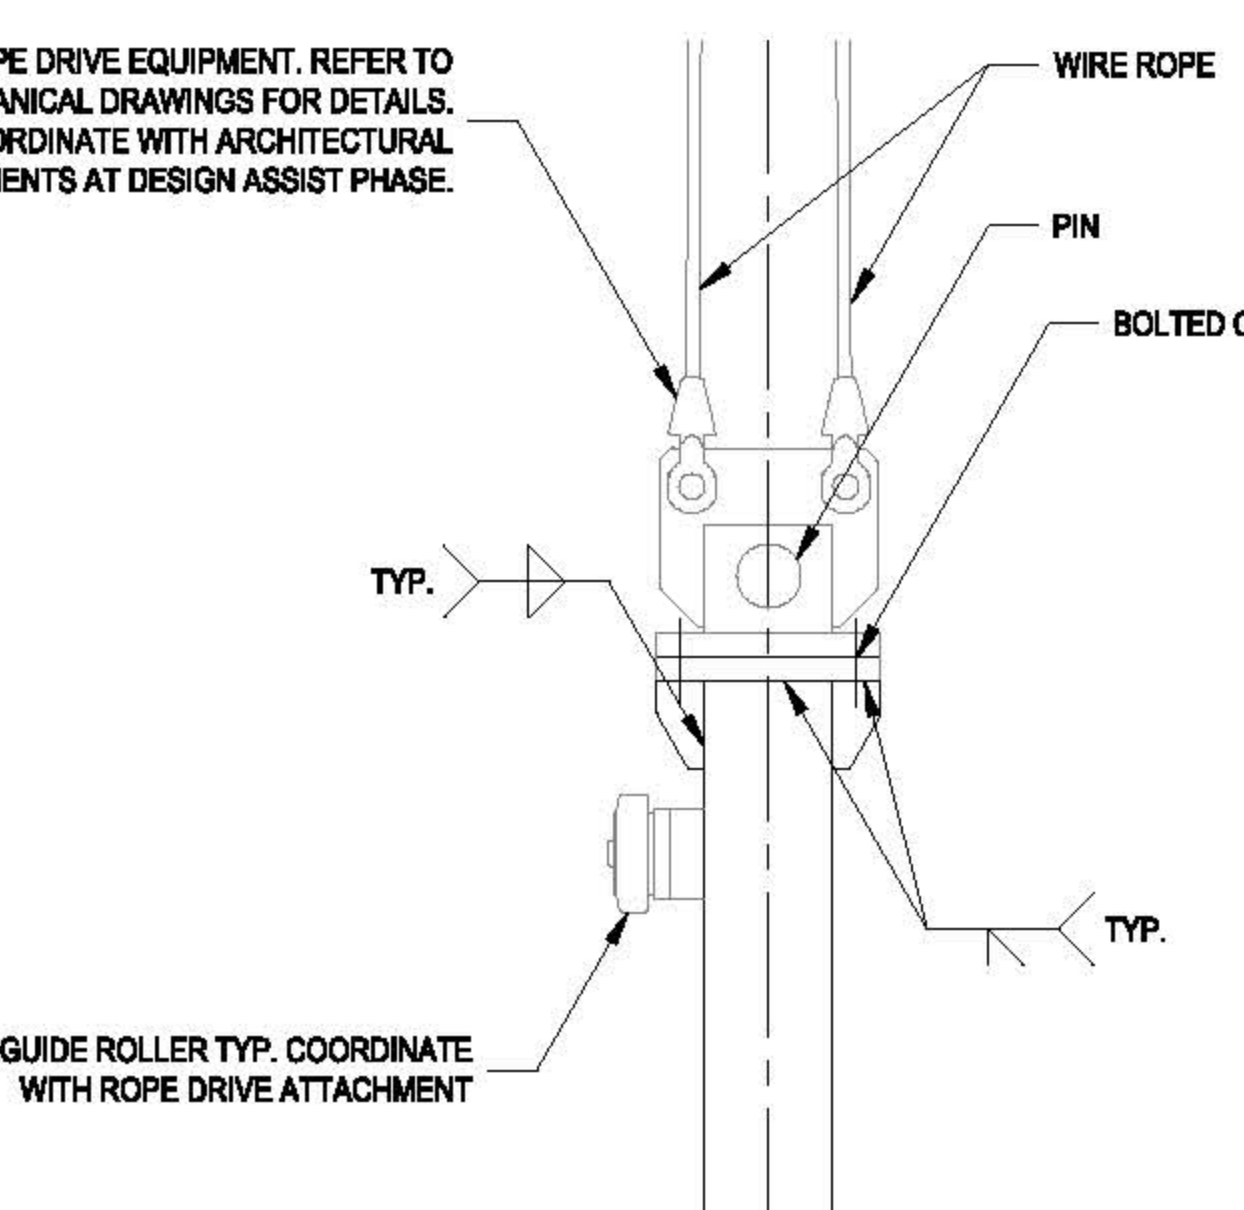


7 DETAIL 7
1" = 1'-0"

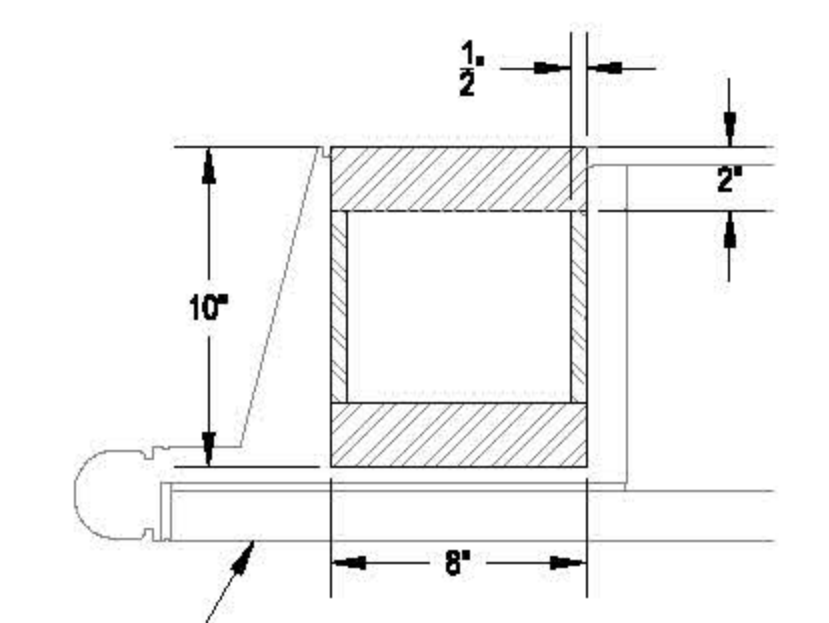


8 SECTION A-A
1" = 1'-0"

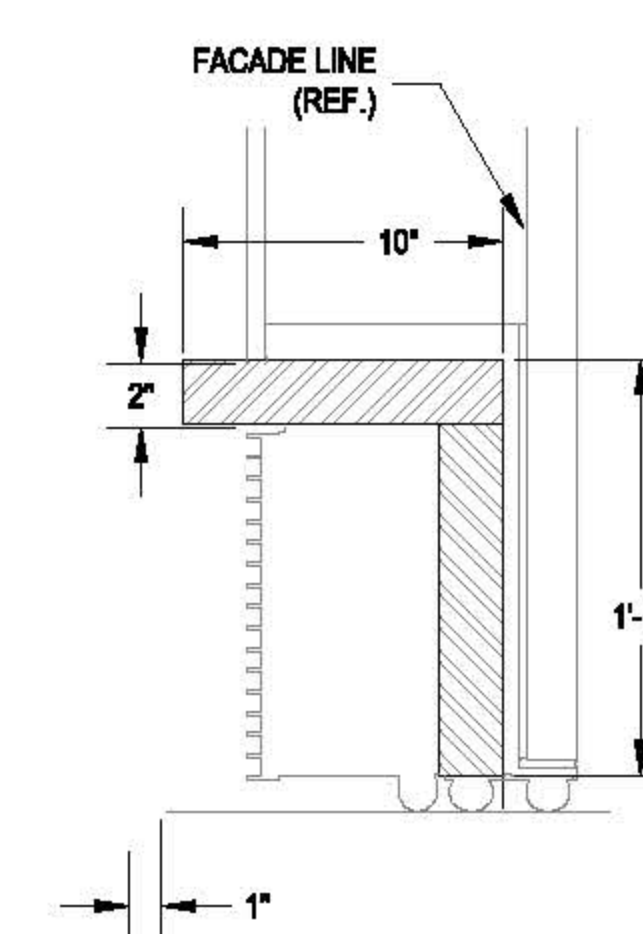

9 SECTION B-B
1" = 1'-0"

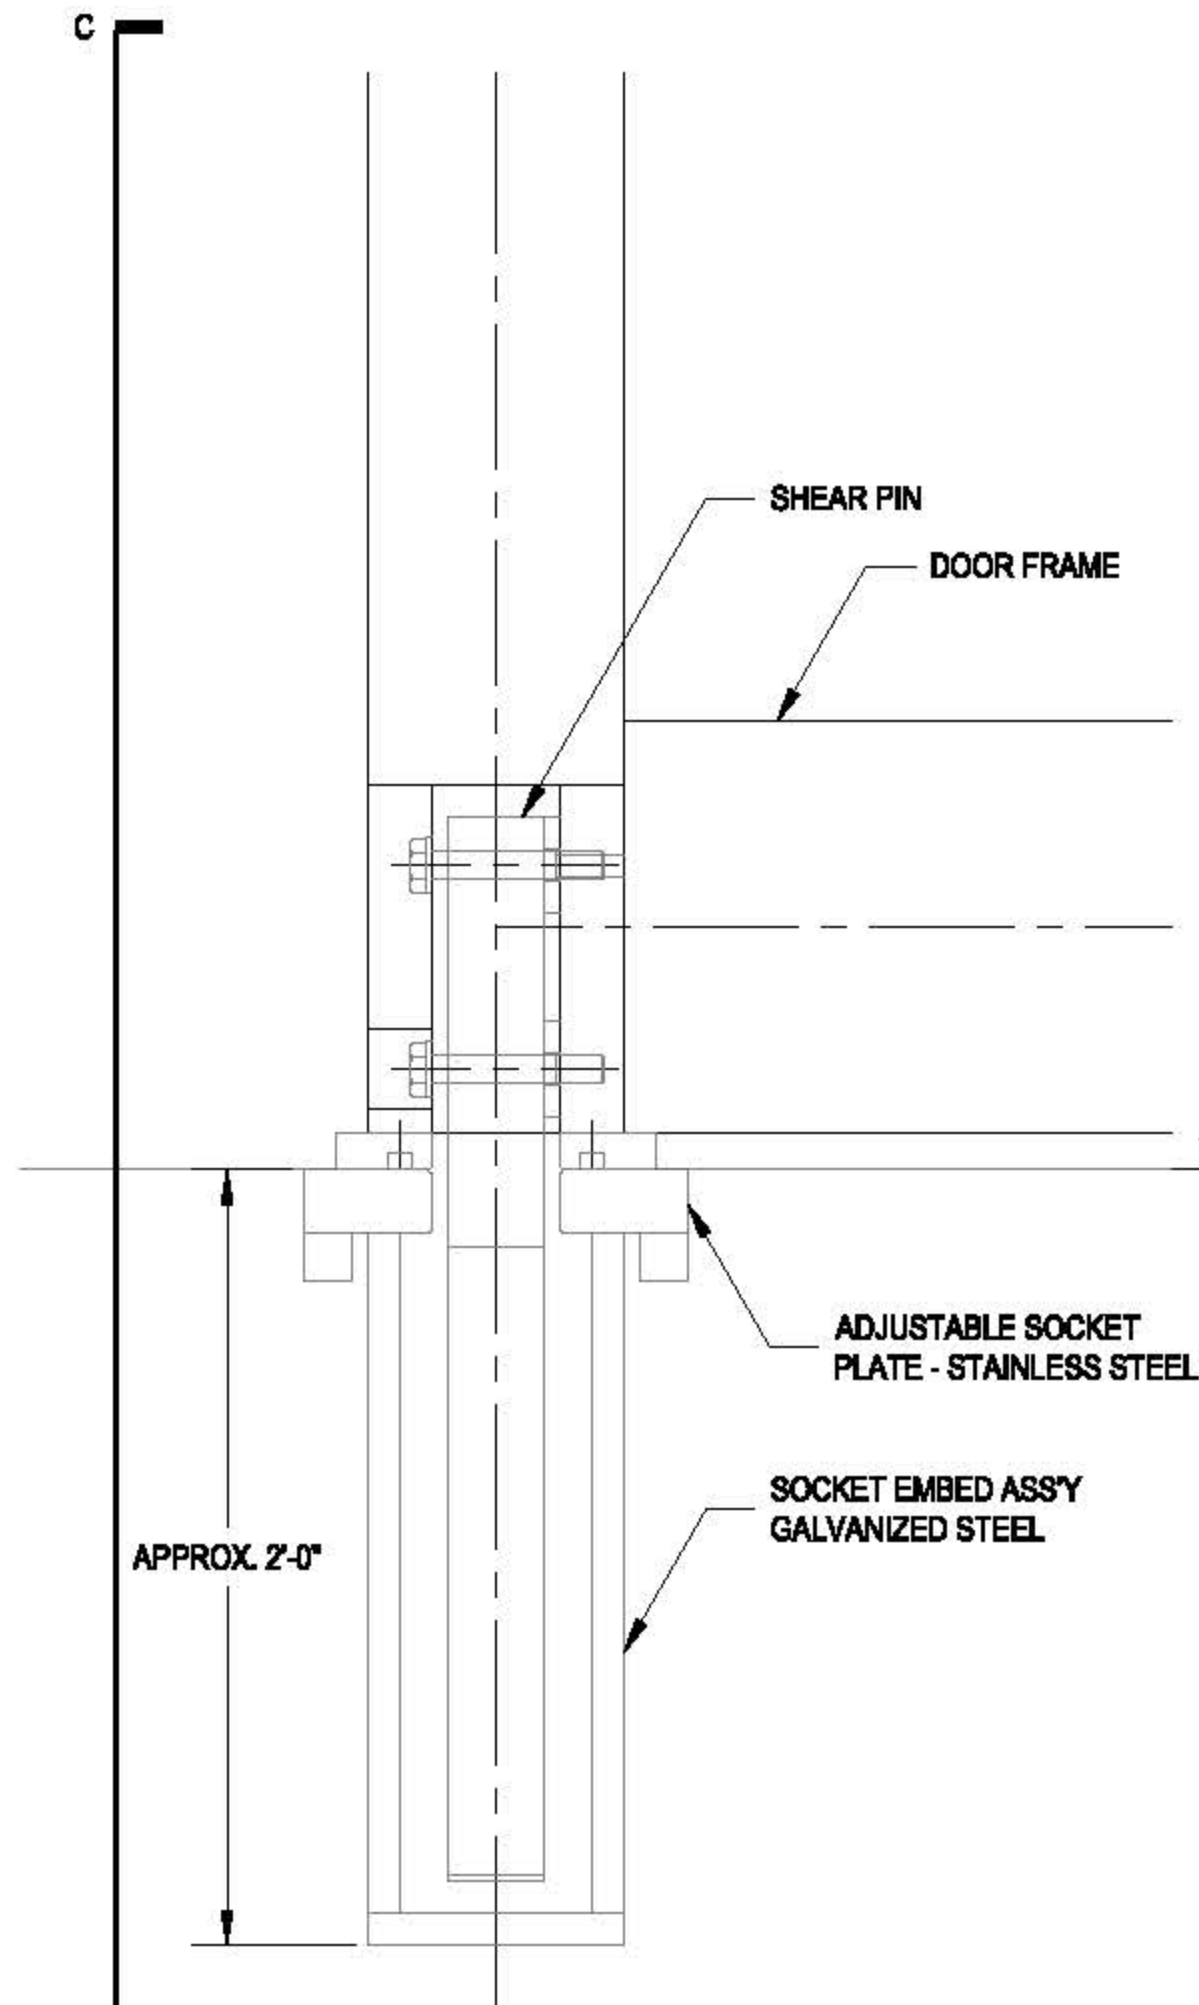

9 DETAIL 8
1" = 1'-0"

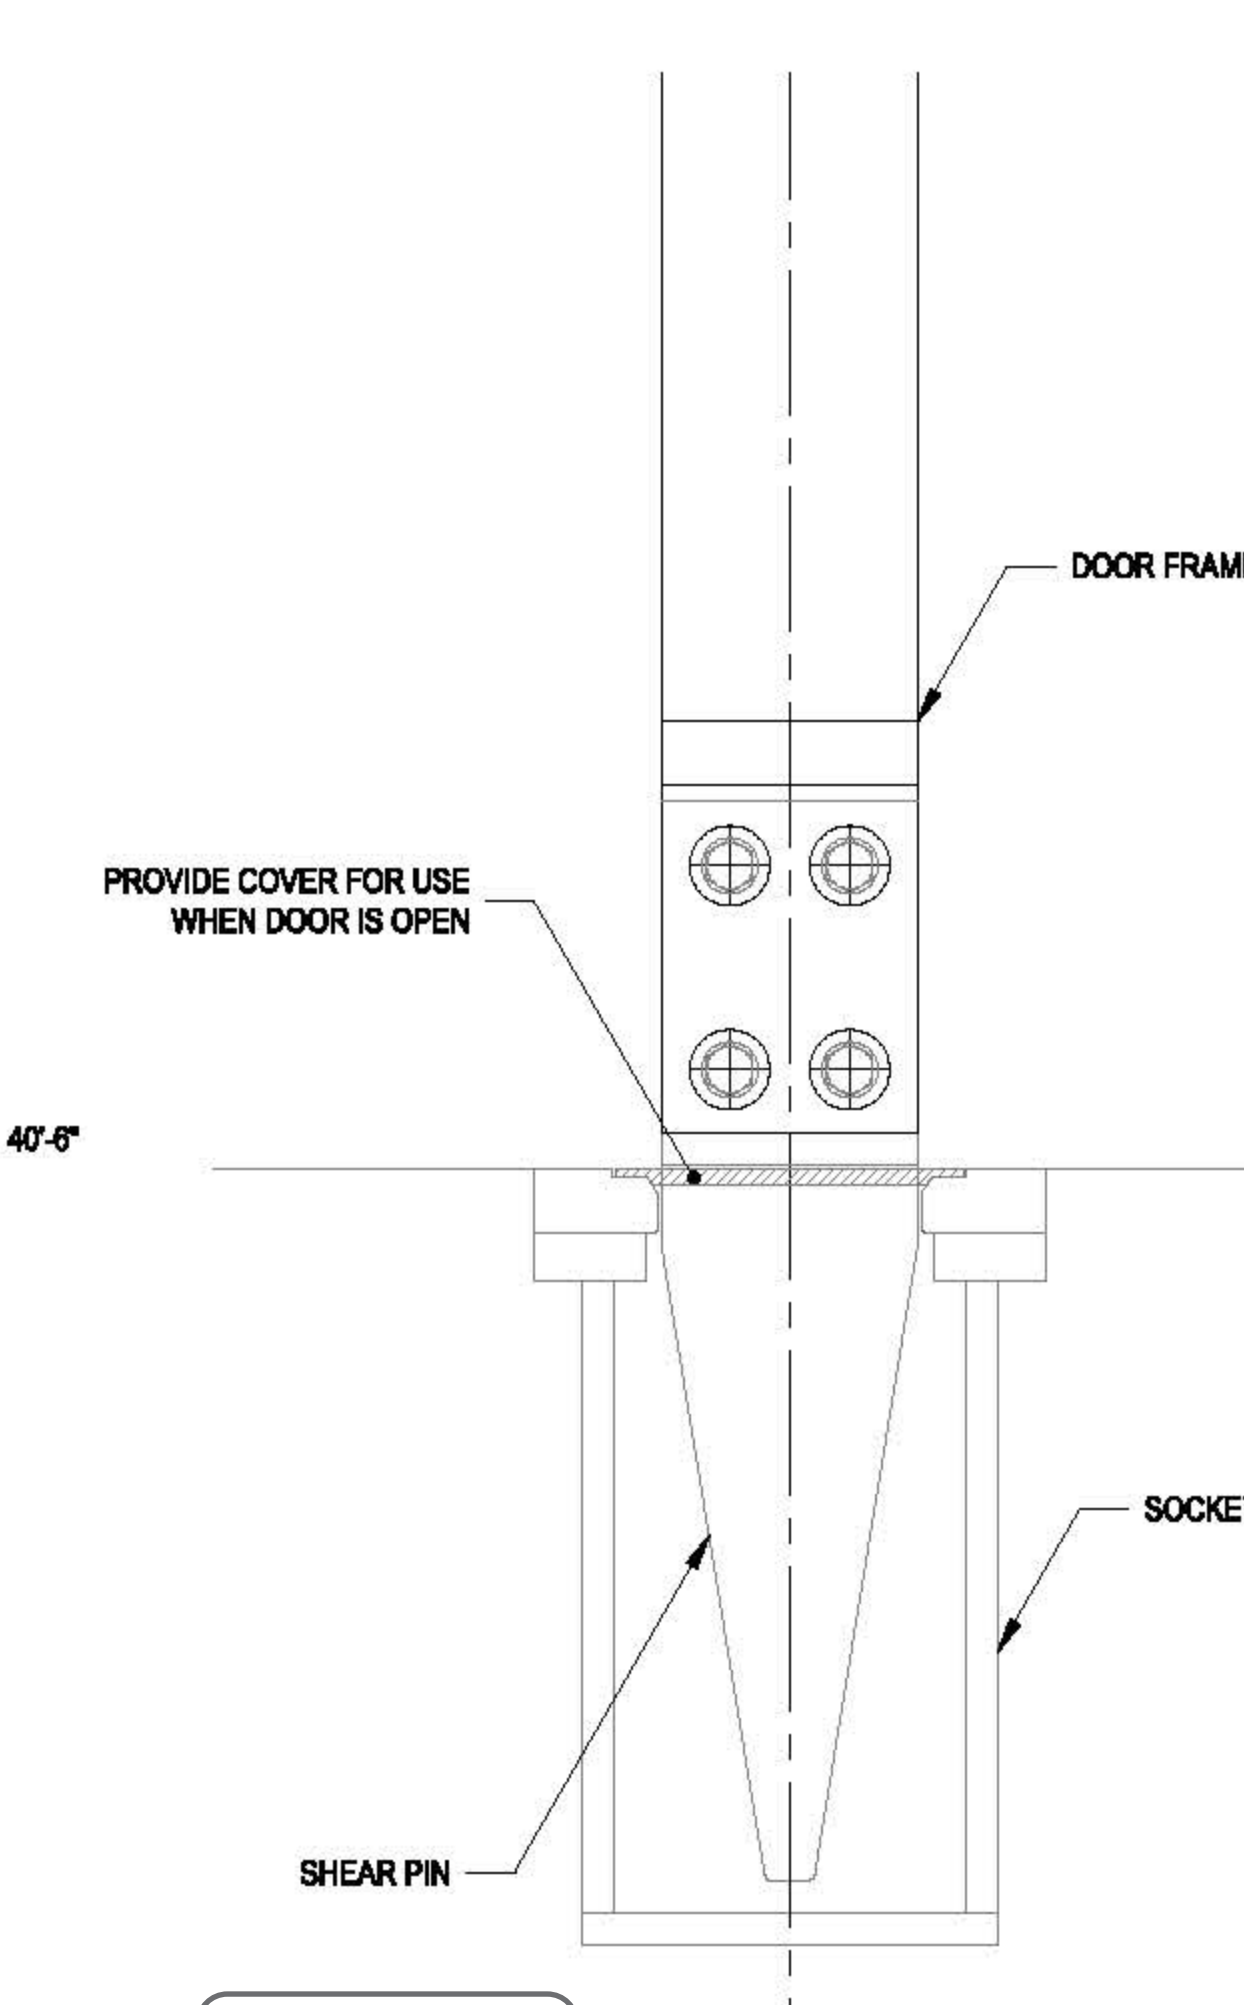

11 SECTION C-C
1" = 1'-0"

Damian Titus
Building Approved
Under Directive 1 of 1995
DATE: 08/18/2014
NYC Development Hub

CULTURE SHED

540 West 30th Street
New York, New York 10001
OWNER
CULTURE SHED INC.
ARCHITECTS
Olin Scaletto + Renfro Architects, DPC
601 West 30th Street #815
New York, New York 10001
T: 212.463.0334
F: 212.463.0335

rockwellgroup
5 Union St. West, 6th Flr
New York, New York 10003
T: 212.463.0334
F: 212.463.0335

STRUCTURAL ENGINEER
Thornton Tomasetti
51 Madison Avenue
New York, New York 10010
T: 917.561.7800
F: 917.661.7811

MEP ENGINEER
Jana Baum & Bolles
63 Pine Street
New York, New York 10005
T: 212.530.9300
F: 212.259.6944

FAÇADE CONSULTANT
Thornton Tomasetti
51 Madison Avenue
New York, New York 10010
T: 917.561.7800
F: 917.661.7811

KINETICS ENGINEER
Hardisty & Hanover
1501 Broadway
New York, New York 10036
T: 212.944.1150
F: 212.391.0297

LIGHTING DESIGNER
Tilston Design Associates
43 North Street #1650
New York, New York 10013
T: 212.675.7760

THEATRE PLANNING & DESIGN
Fisher Dodge Associates
22 West 15th Street
New York, New York 10011
T: 212.691.3000

LIFE SAFETY
Code Consultants, Inc.
215 West 43rd St, 15th Flr
New York, New York 10018
T: 212.216.9596

ENERGY MODEL/LEED
Vindian
63 Washington Street
Norwalk, CT 06854
T: 203.298.1411

ACOUSTIC/AUDIO-VISUAL
Avenille
93 North Main Street
South Norwalk, CT 06854
T: 347.210.5540

VERTICAL TRANSPORTATION
Van Dusen & Associates
5 Regent Street, Suite 524
Livingston, NJ 07039
T: 973.994.9220

SPECIFICATIONS
Construction Specifications Inc.
PO Box 489
227 Tenth Road
Morganville, NJ 07751
T: 732.970.0700
F: 732.970.0750


SECURITY
Duchella Venter & Santoro
1020 Sherman Avenue
Hartford, CT 06114
T: 203.286.6490

WATERPROOFING
James R. Gafford AIA Consulting Architects PC
104 West 27th Street
New York, NY 10001
T: 212.736.3344

FAÇADE MAINTENANCE
Erick Engineering PLLC
362 Ave. Street
New York, NY 10005
T: 212.698.3000

BRANDING/GRAPHICS
Zik Global Design Consultancy
180 York Street 15th Floor
New York, NY 10014
T: 212.647.1170

KEY PLAN

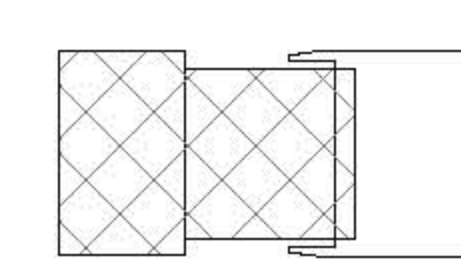

ISSUE	PRINTING	DATE
01	01B AMENDMENT 7	03.29.2014
02	ASB #01	02.12.2014
03	CONSTRUCTION SET	10.29.2013
04	ADV. PROOFREQUIREMENT ACCENDIM 1	04.30.2015
05	100% CONSTRUCTION DOCUMENTS	03.11.2015
06	90% CONSTRUCTION DOCUMENTS	02.18.2015
07	PRELIMINARY DISSEMINATION	12.30.2014
08	ADV. PROOFREQUIREMENT ACCENDIM 1	10.03.2014
09	ADVANCED PROOFREQUIREMENT BID SET	06.16.2014

STAMP



DRAWN BY
Autum
CHECKED BY
Damian Titus
PROJECT NUMBER
N11318.00

TITLE
FIXED BUILDING COLUMN SCHEDULE

DRAWING NO.
S-901.01

B.SCAN NO.
S-901.01

122 of 123

FLOOR	COL MARK	RCL.S-C08	RCL.S-C08.1	RCL.S-C08.2	RCL.S-C08.3	CD.6-C42	CD.6-C43	CD.6-C44	CD.6-C45	CE.6-C42	CE.6-C43	CE.6-C44	CE.6-C776
-------	----------	-----------	-------------	-------------	-------------	----------	----------	-----------	-----------	
